

NOTE: VERIFY LOCATION OF EXISTING MG-1 FIBRE OPTICS LINE IN THIS AREA. MAINTAIN A MINIMUM OF 5' BETWEEN IRRIGATION MAIN LINE AND FIBRE OPTICS LINE. NOTIFY D.A.R.T. OF CONFLICTS.

SLEEVE AS SCHEDULED: SLEEVE AND PIPE MUST BE INSTALLED PRIOR TO CONSTRUCTION OF TRANSIT PLATFORM. COORDINATE WITH OTHER CONTRACTORS. SLEEVE MUST BE EXTENDED 12" MIN. INTO PLANTER.

SPRINKLER HEADS ALONG TRACKS SHALL BE INSTALLED NO LESS THAN 7' FROM NEAREST EDGE OF BALLAST.


INSTALL IRRIGATION CONTROLLER IN MECHANICAL ROOM. (SEE POWER PLAN SHT. EC1-0003)

- POINT OF CONNECTION
- 2" METER
 - 2" DOUBLE CHECK VALVE ASSEMBLY
 - 2" MASTER SHUT OFF VALVE
 - METER AND BACKFLOW PREVENTER TO HAVE 18" SEPARATION.

NOTE: REFER TO DRAWING LC2-0005 FOR LEGEND & SLEEVE SCHEDULE

ARAPAHO ROAD

CONFORMED

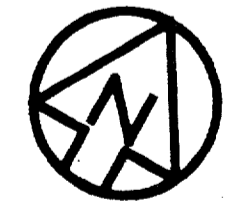

SCALE (IN FEET) 0 5 10 15 20 30 40 60


HALFF ASSOCIATES, INC. IRRIGATION CONSULTANTS

CONTRACT SHEET No. 45 OF 95

ADDISON TRANSIT CENTER IRRIGATION PLAN

SCALE	1"=20'-0"
DRAWN	L. HUGHES
DESIGNED	B. BRISTOW
CHECKED	B. BRISTOW
IN CHARGE	V. STEVENS
DATE	14 AUGUST 07

CONTRACT C-97000136 DWG No. CCS-0012 REV 01

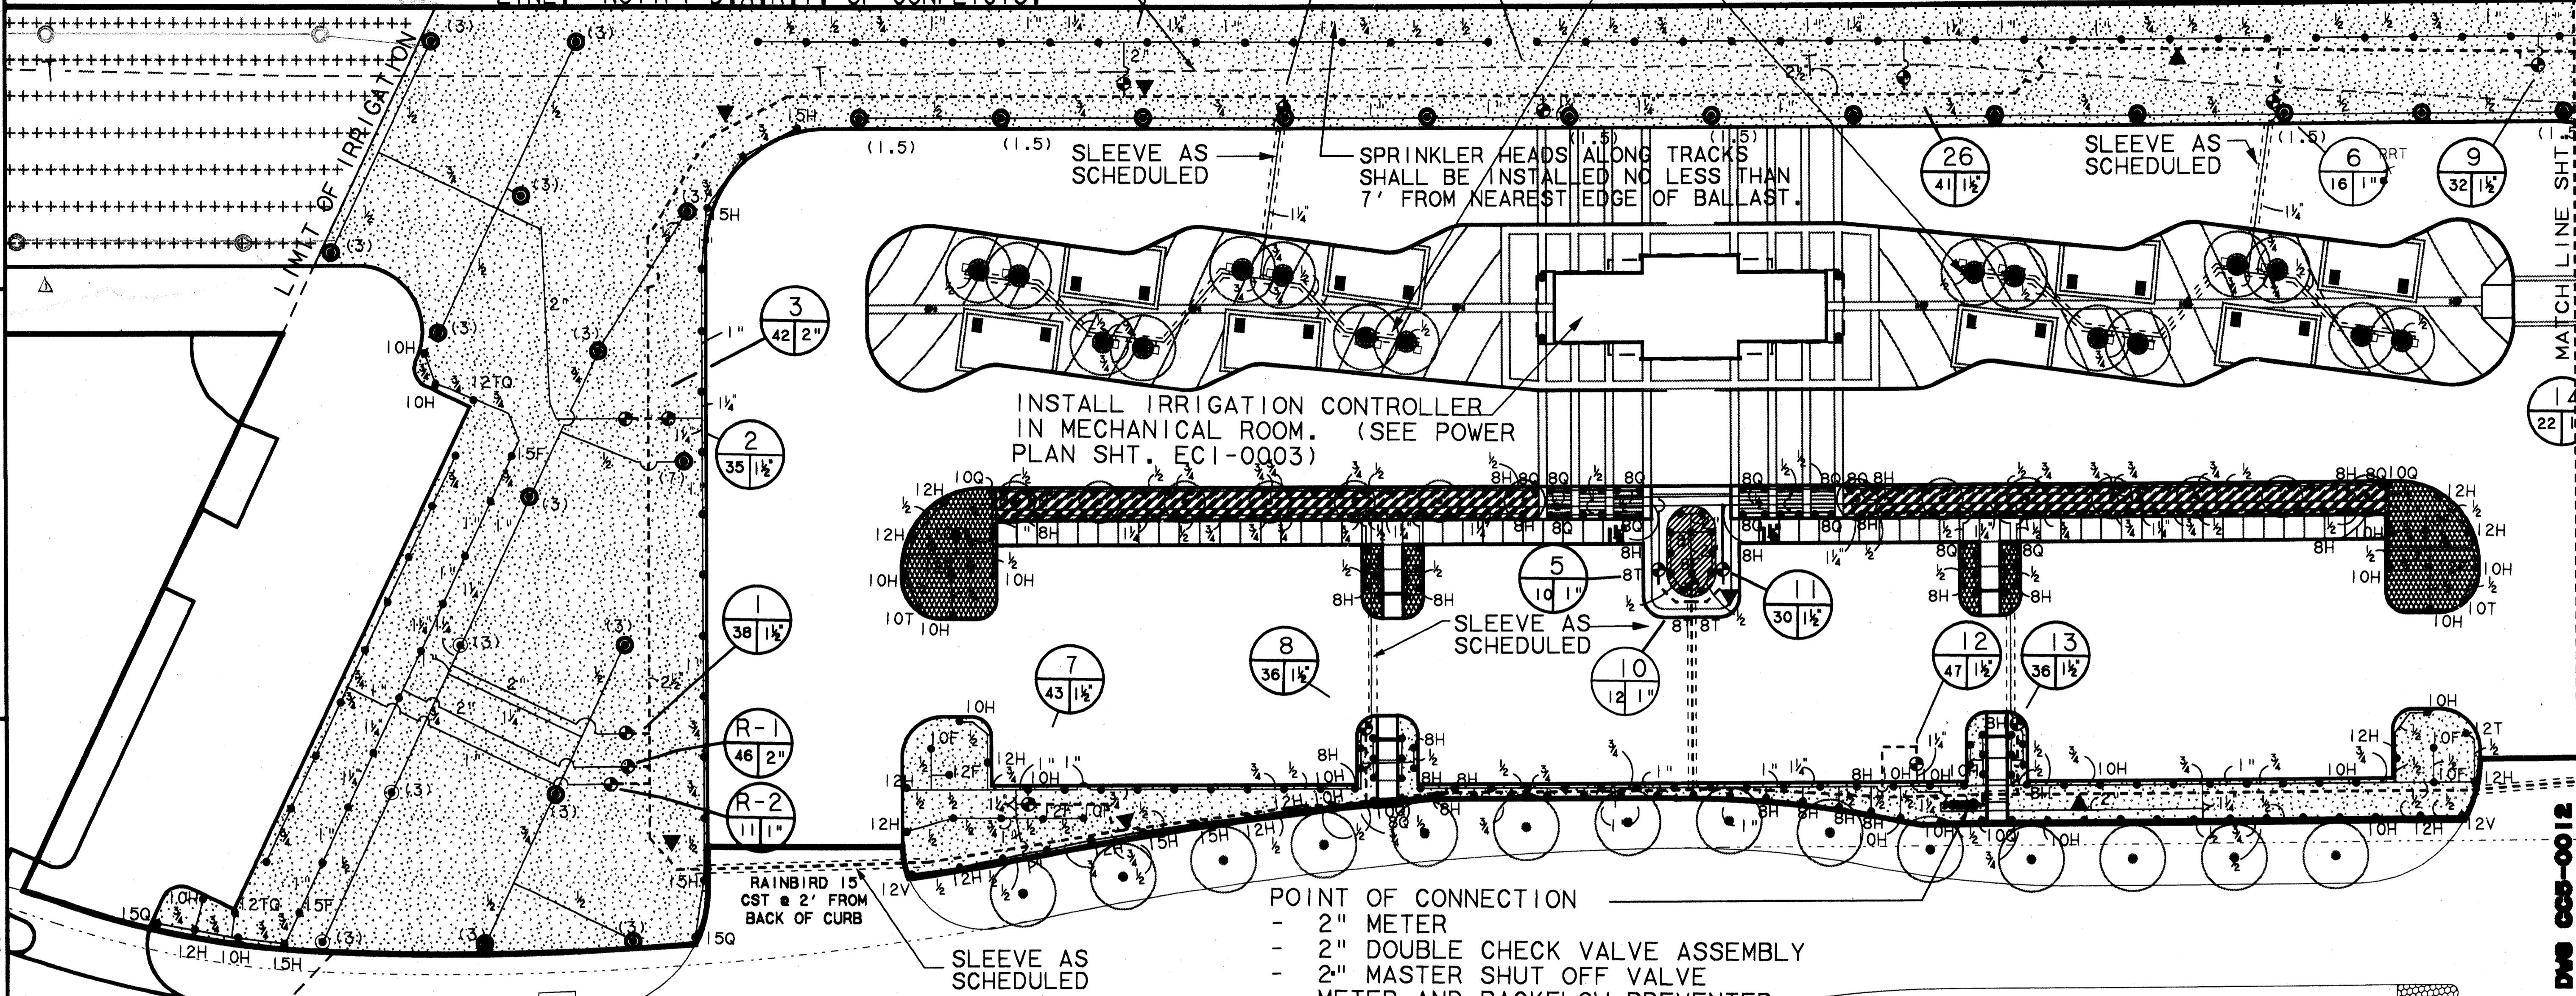

Having checked the submission, we certify that a valid seal and signature of the registered professional engineer, except as otherwise noted, are present on this drawing.

Contract Number: 97000136
 Company Name: HALFF ASSOCIATES, INC.
 Officer of Firm Signature: Tom Kasper
 Date: 7-7-09
 Officer of Firm Name (typed): Tom Kasper
 Title of Officer (typed): PRESIDENT
 Seal of Professional Engineer of Construction - Construction including design and draw, thereby sealing record (as-built) drawings for purposes of law, position reflected herein, must be placed below.

REV	DATE	DESCRIPTION	BY	ENG	CHK	APP	REV	DATE	DESCRIPTION	BY	ENG	CHK	APP
1	8/30/09	RECORD (AS BUILT) DRAWINGS	RDM			SLM							
2													
3													
4													
5													

SWA Group
 2211 North Lamar
 Dallas, Texas 75202
 214-954-0016
 Landscape Architecture
 Site Planning
 Urban Design

WLA
WENDY LOPEZ & ASSOCIATES, INC.
 ENGINEERING • SURVEYING • CONSTRUCTION SERVICES
 302 MARKET CENTER BLVD - SUITE 510
 DALLAS, TEXAS 75207
 (214) 748-7777

DART PROJECT

\$\$\$ ILE1 \$\$\$
 \$\$\$ ILE2 \$\$\$
 \$\$\$ ILE3 \$\$\$
 \$\$\$ ILE4 \$\$\$
 \$\$\$ ILE5 \$\$\$
 \$\$\$ ILE6 \$\$\$
 \$\$\$ ILE7 \$\$\$
 \$\$\$ ILE8 \$\$\$
 \$\$\$ ILE9 \$\$\$
 \$\$\$ ILE10 \$\$\$
 \$\$\$ ROT \$\$\$
 \$\$\$ PEN \$\$\$
 \$\$\$ USER NAME \$\$\$

MATCH LINE SHT. DWG CCS-0012
 MATCH LINE SHT. DWG CCS-0014