


\$\$\$SPECIFICATION\$\$\$
 \$\$\$SYTIME\$\$\$
 \$\$\$PRF\$\$\$
 \$\$\$USERNAME\$\$\$

\$\$\$ROT\$\$\$
 \$\$\$PEN\$\$\$


\$\$\$FILE6\$\$\$
 \$\$\$FILE7\$\$\$
 \$\$\$FILE8\$\$\$
 \$\$\$FILE9\$\$\$
 \$\$\$FILE10\$\$\$

\$\$\$FILE1\$\$\$
 \$\$\$FILE2\$\$\$
 \$\$\$FILE3\$\$\$
 \$\$\$FILE4\$\$\$
 \$\$\$FILE5\$\$\$

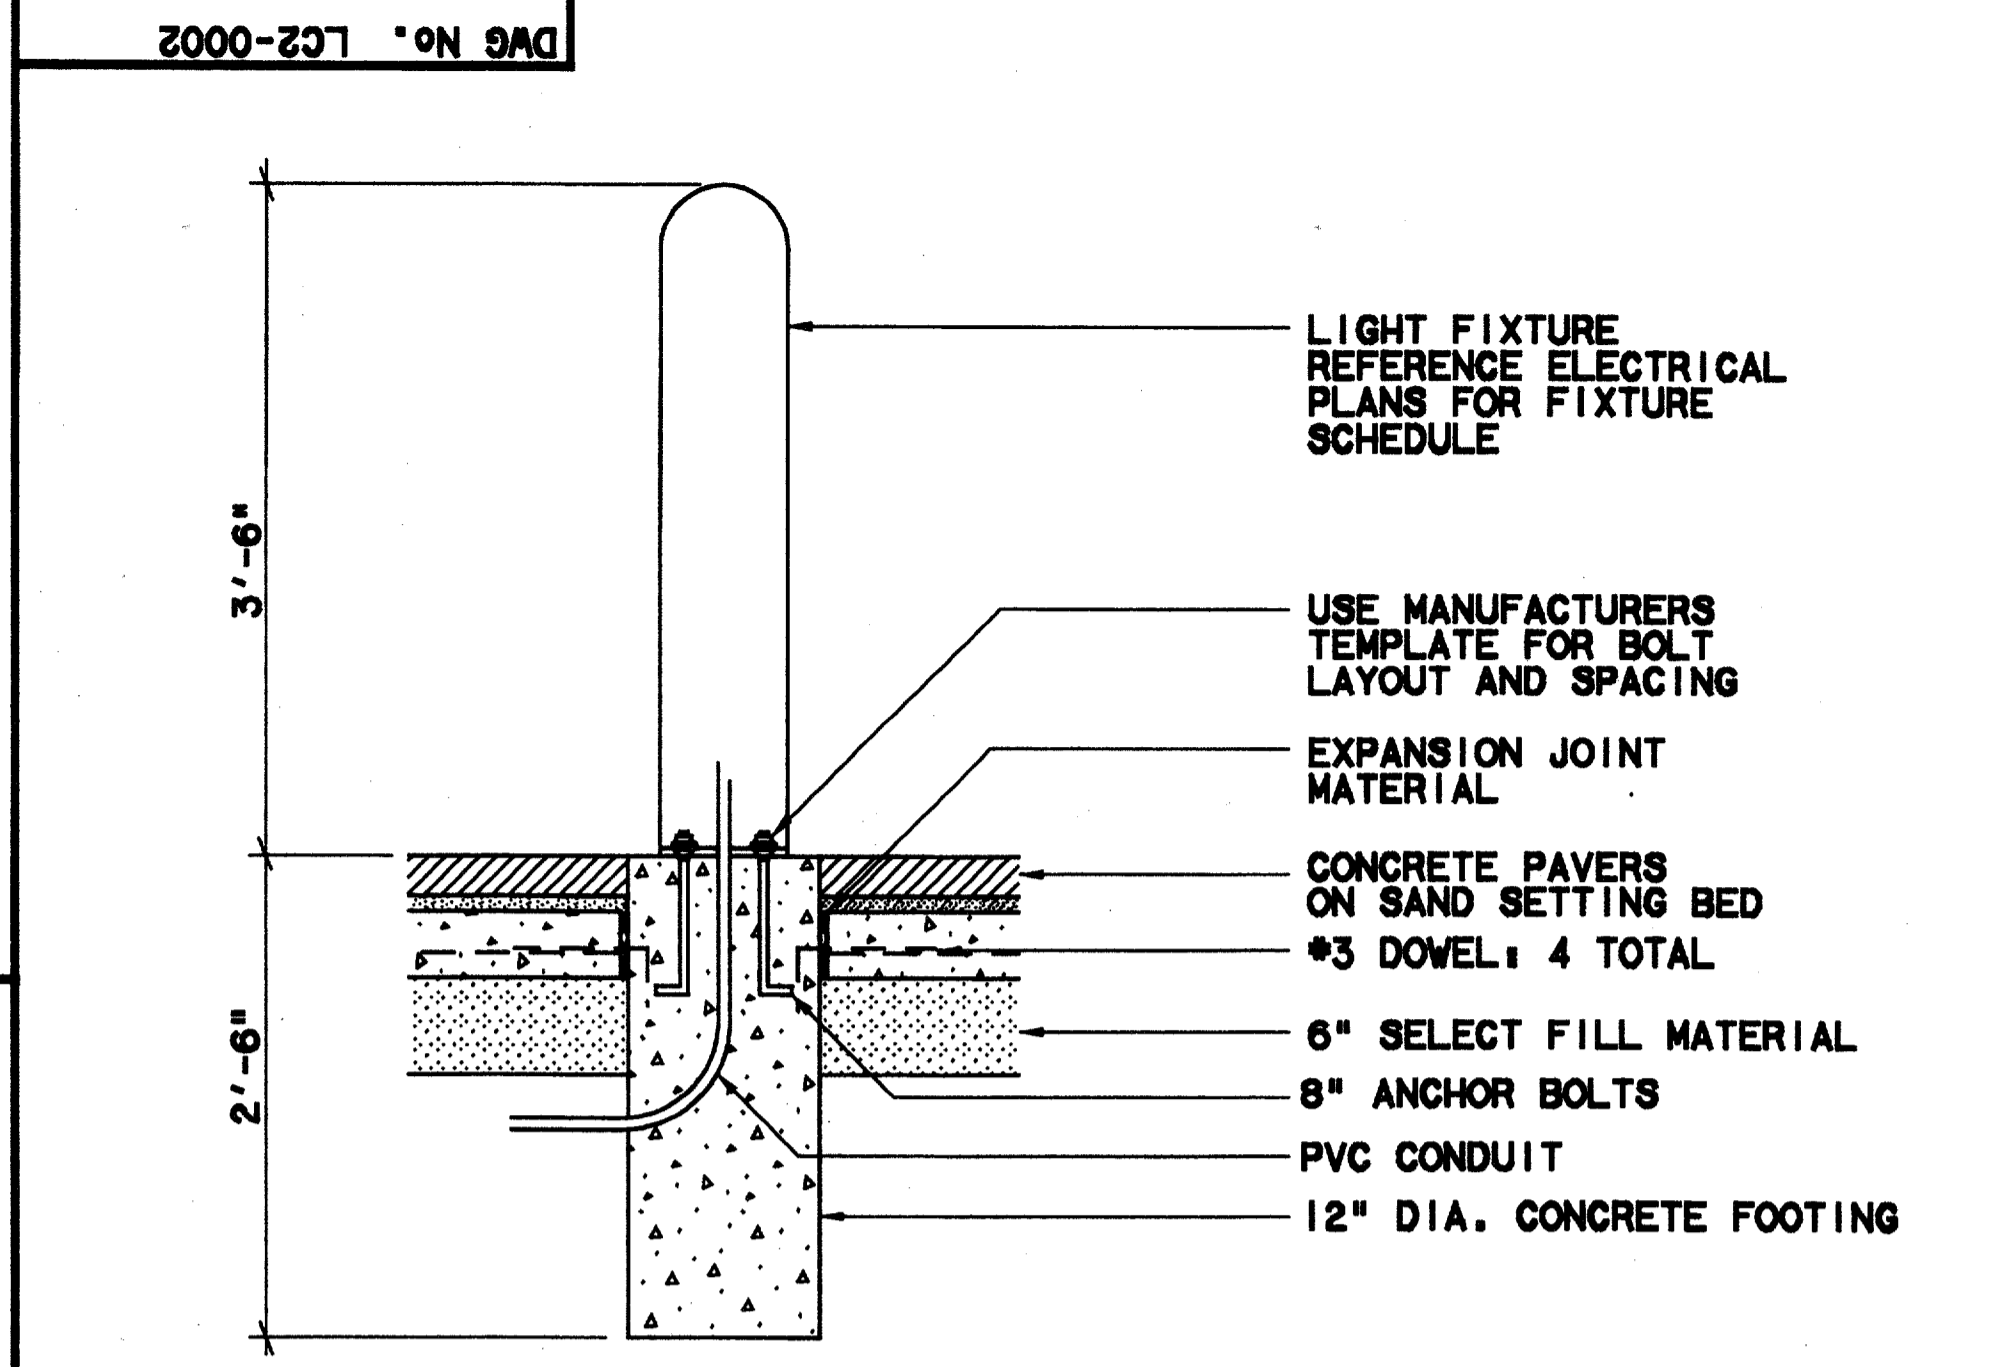


PAVERS @ LIGHT BOLLARD - SECTION
 SCALE: 1"=1'-0"
 CC5-0009


Record (As-built) Certification
 "Having checked this submission, we certify that it conforms to the requirements of the contract in all respects, except as otherwise indicated."
 Contract Number: 97000136
 Company Name: DEDALCO
 Officer of Firm Signature: [Signature]
 Date: [Date]
 Title of Officer (typed): TOM KADEK, PRESIDENT
 Seal of Professional Engineer of Construction Contractor, including signature and date, thereby sealing (and making) drawings for accuracy of work, conditions reflected herein, must be placed below.

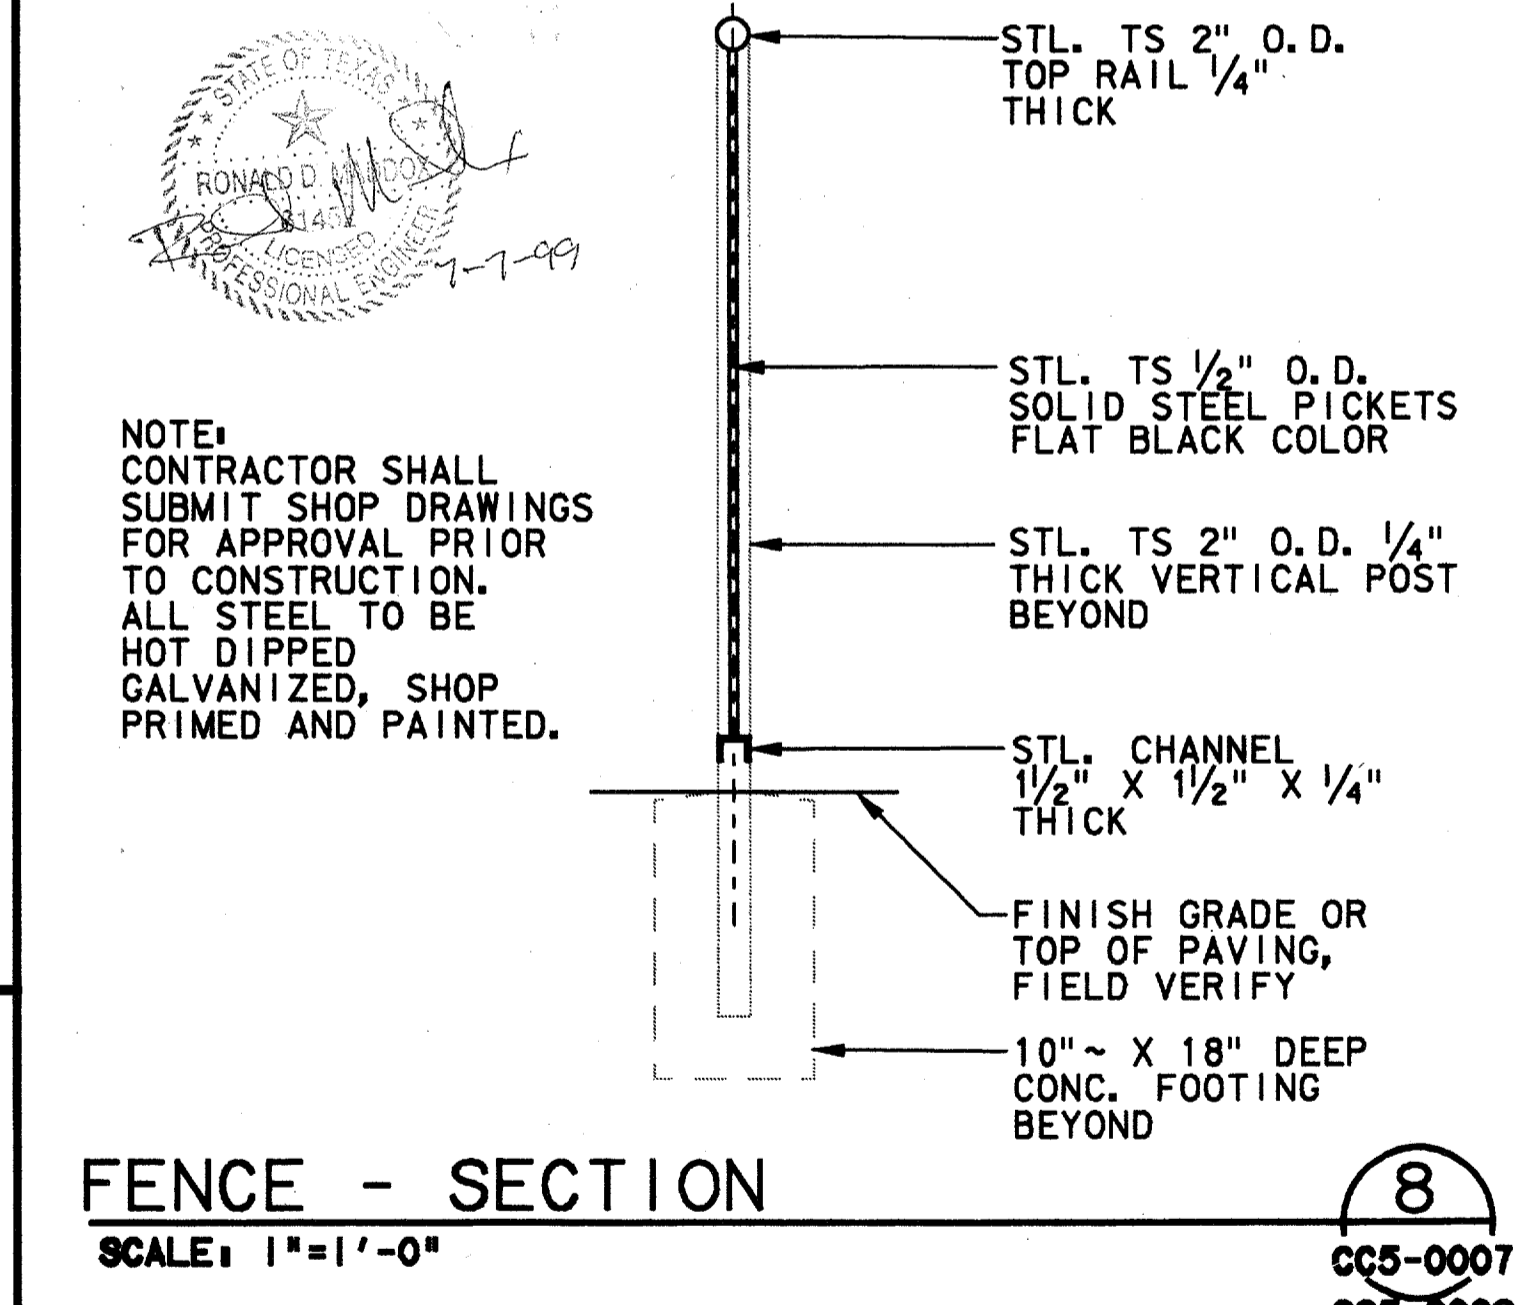


FENCE - SECTION
 SCALE: 1"=1'-0"
 CC5-0007
 CC5-0009

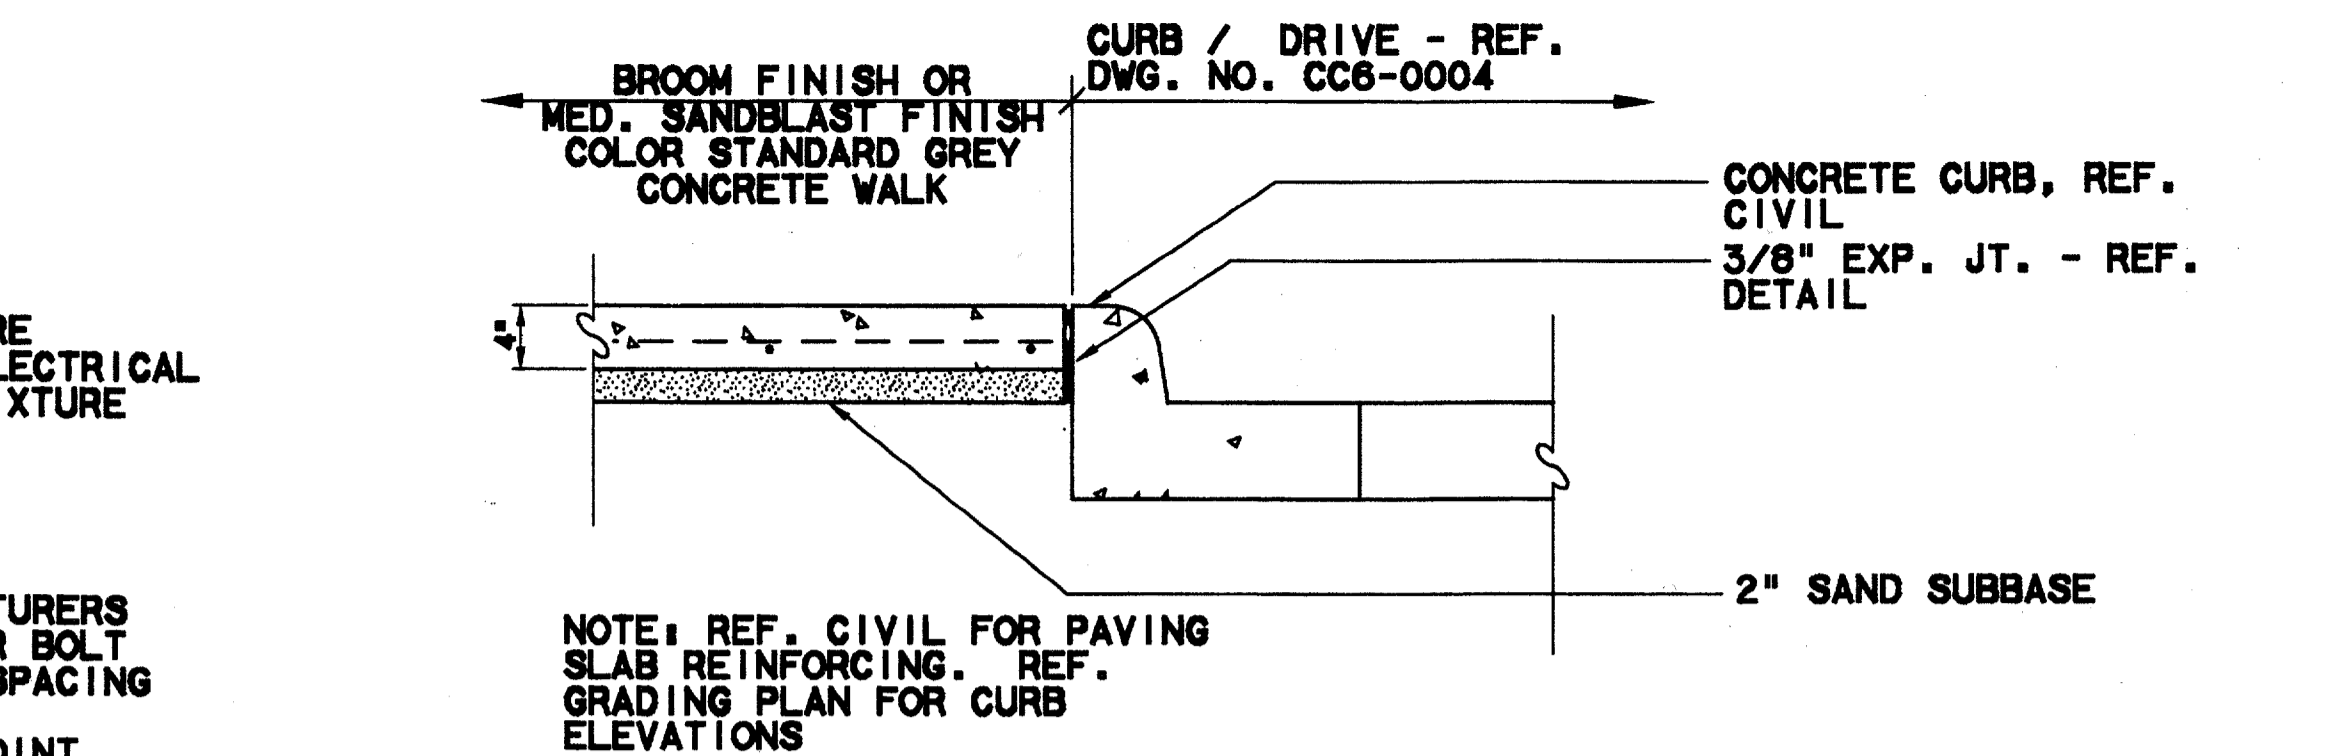


CONC. WALK @ CURB - SECTION
 SCALE: 1"=1'-0"
 CC5-0007
 CC5-0010

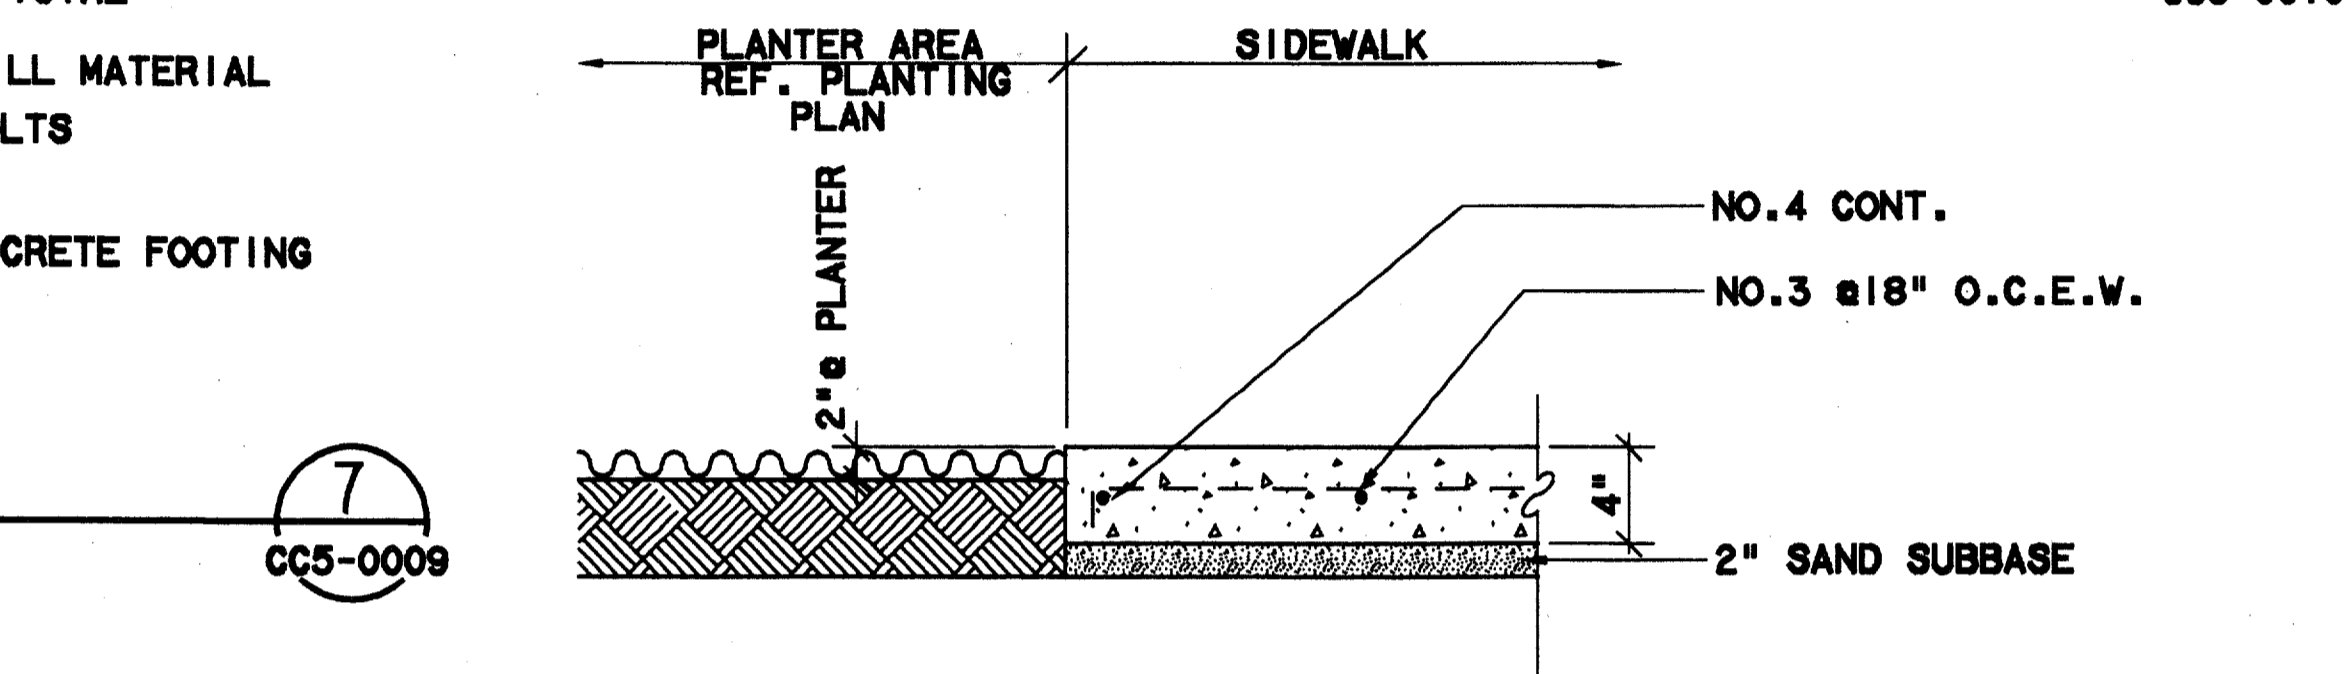


CONC. WALK @ PLANTER - SECTION
 SCALE: 1"=1'-0"
 CC5-0007
 CC5-0010

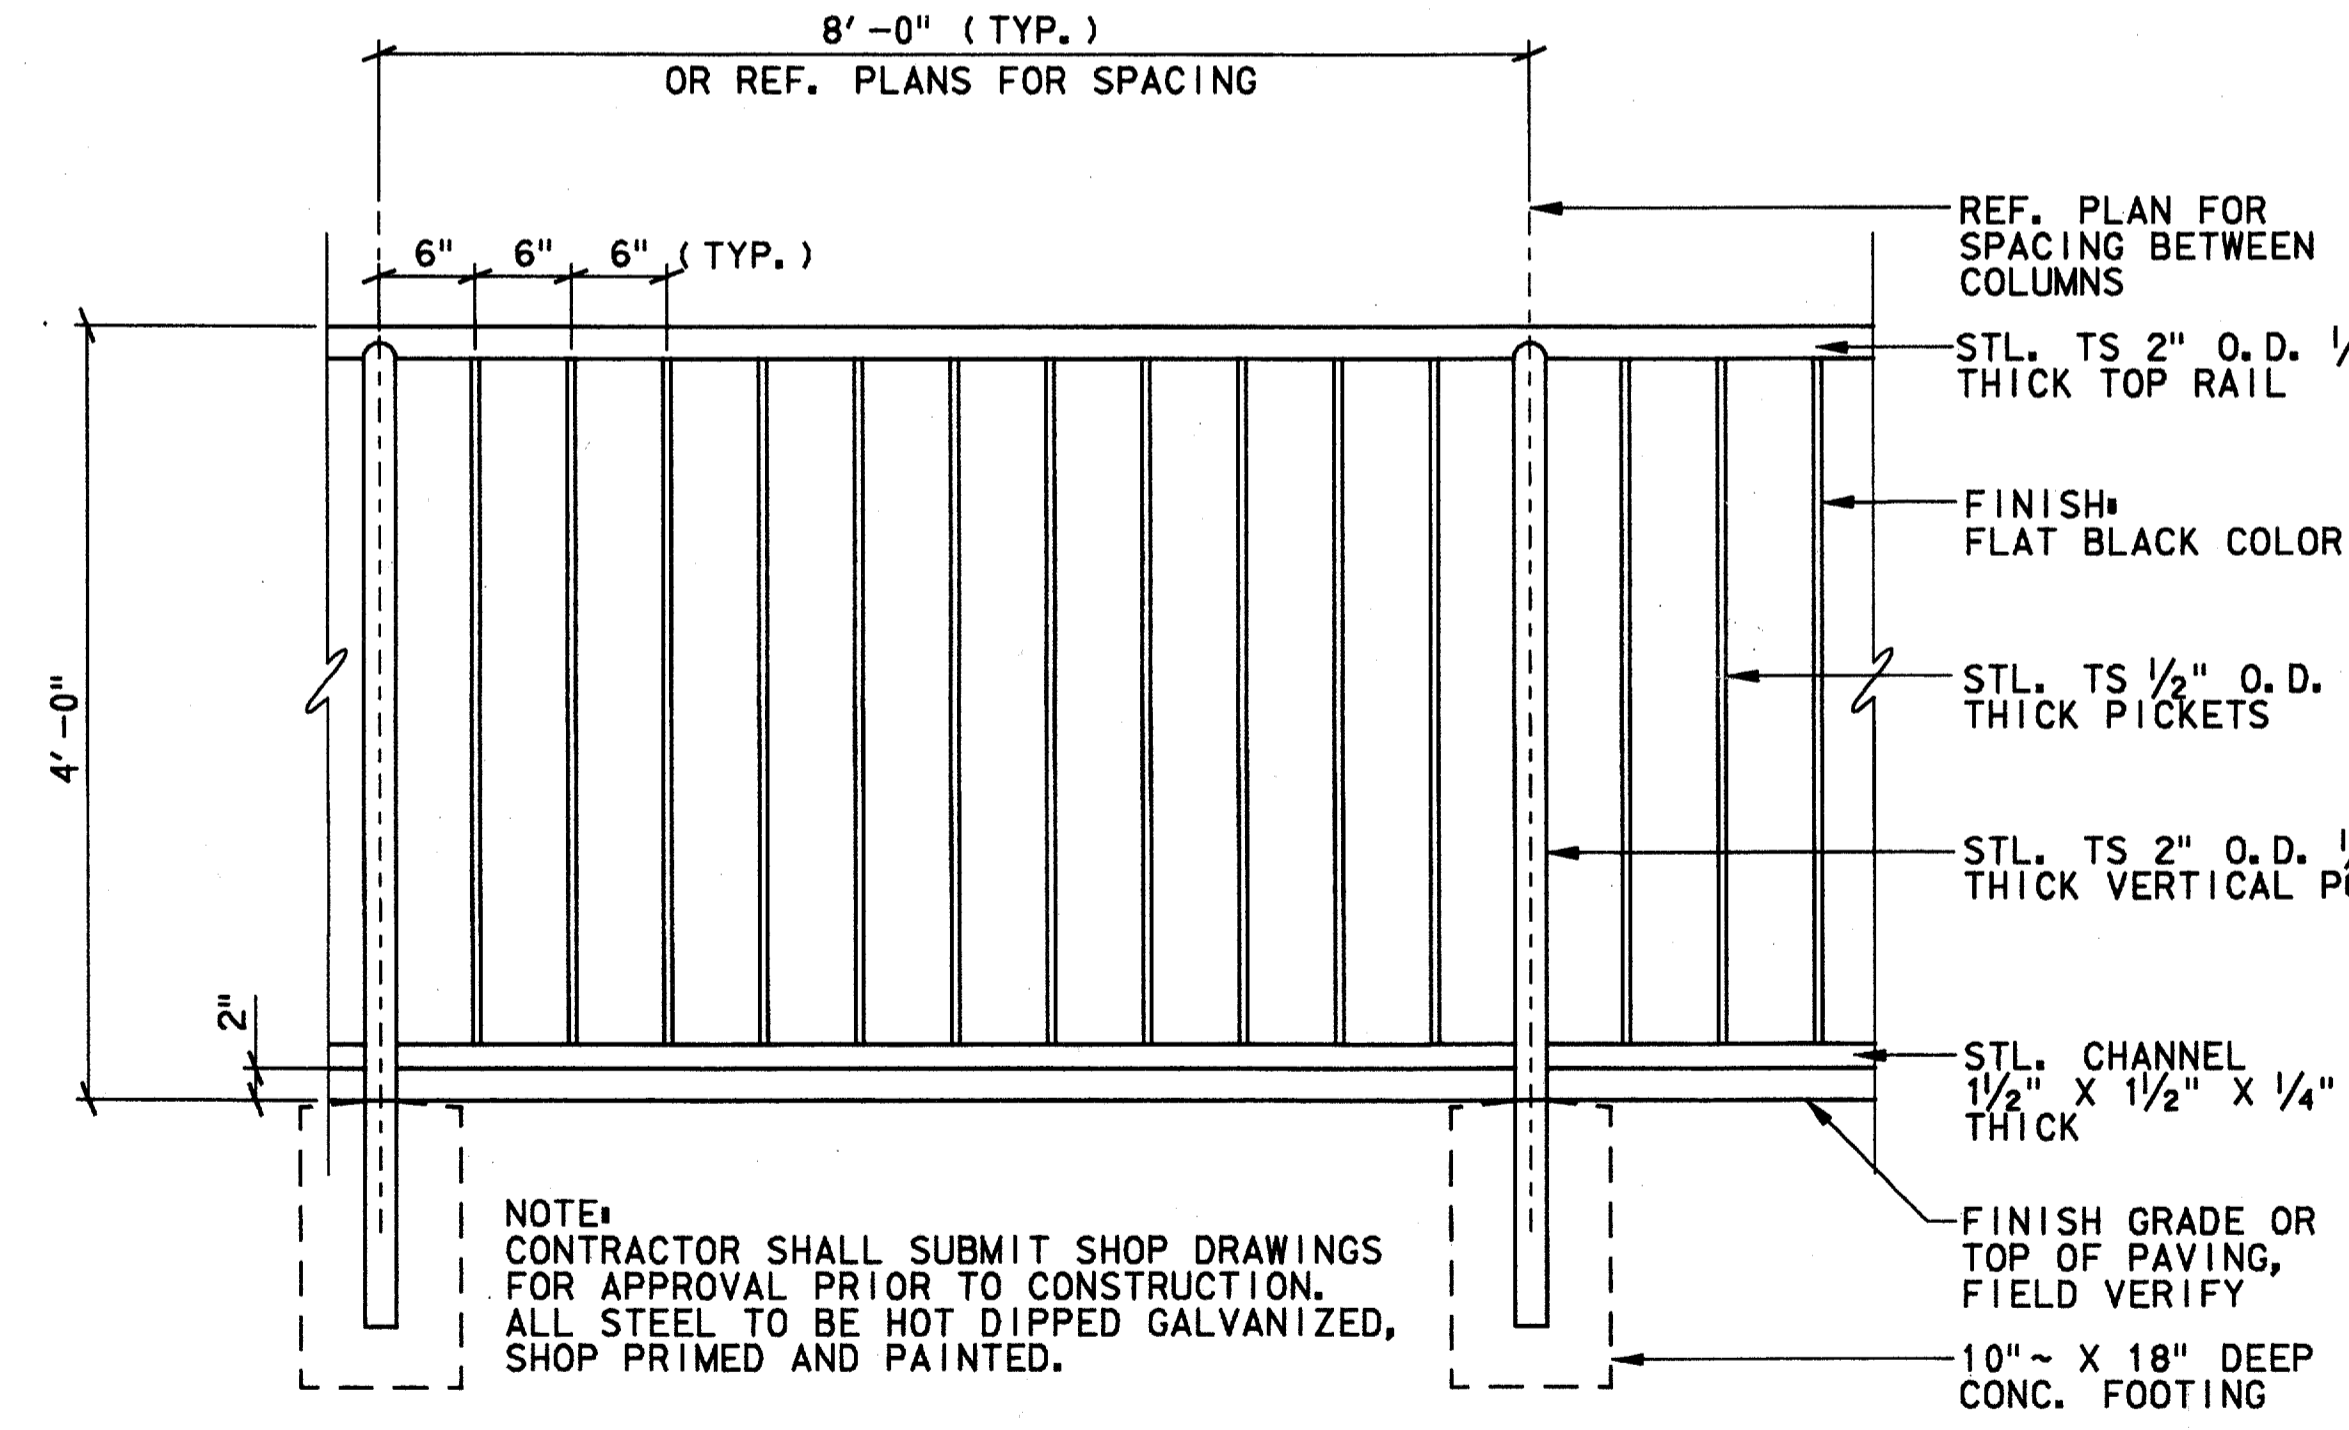


FENCE - ELEVATION
 SCALE: 1"=1'-0"
 CC5-0007
 CC5-0009

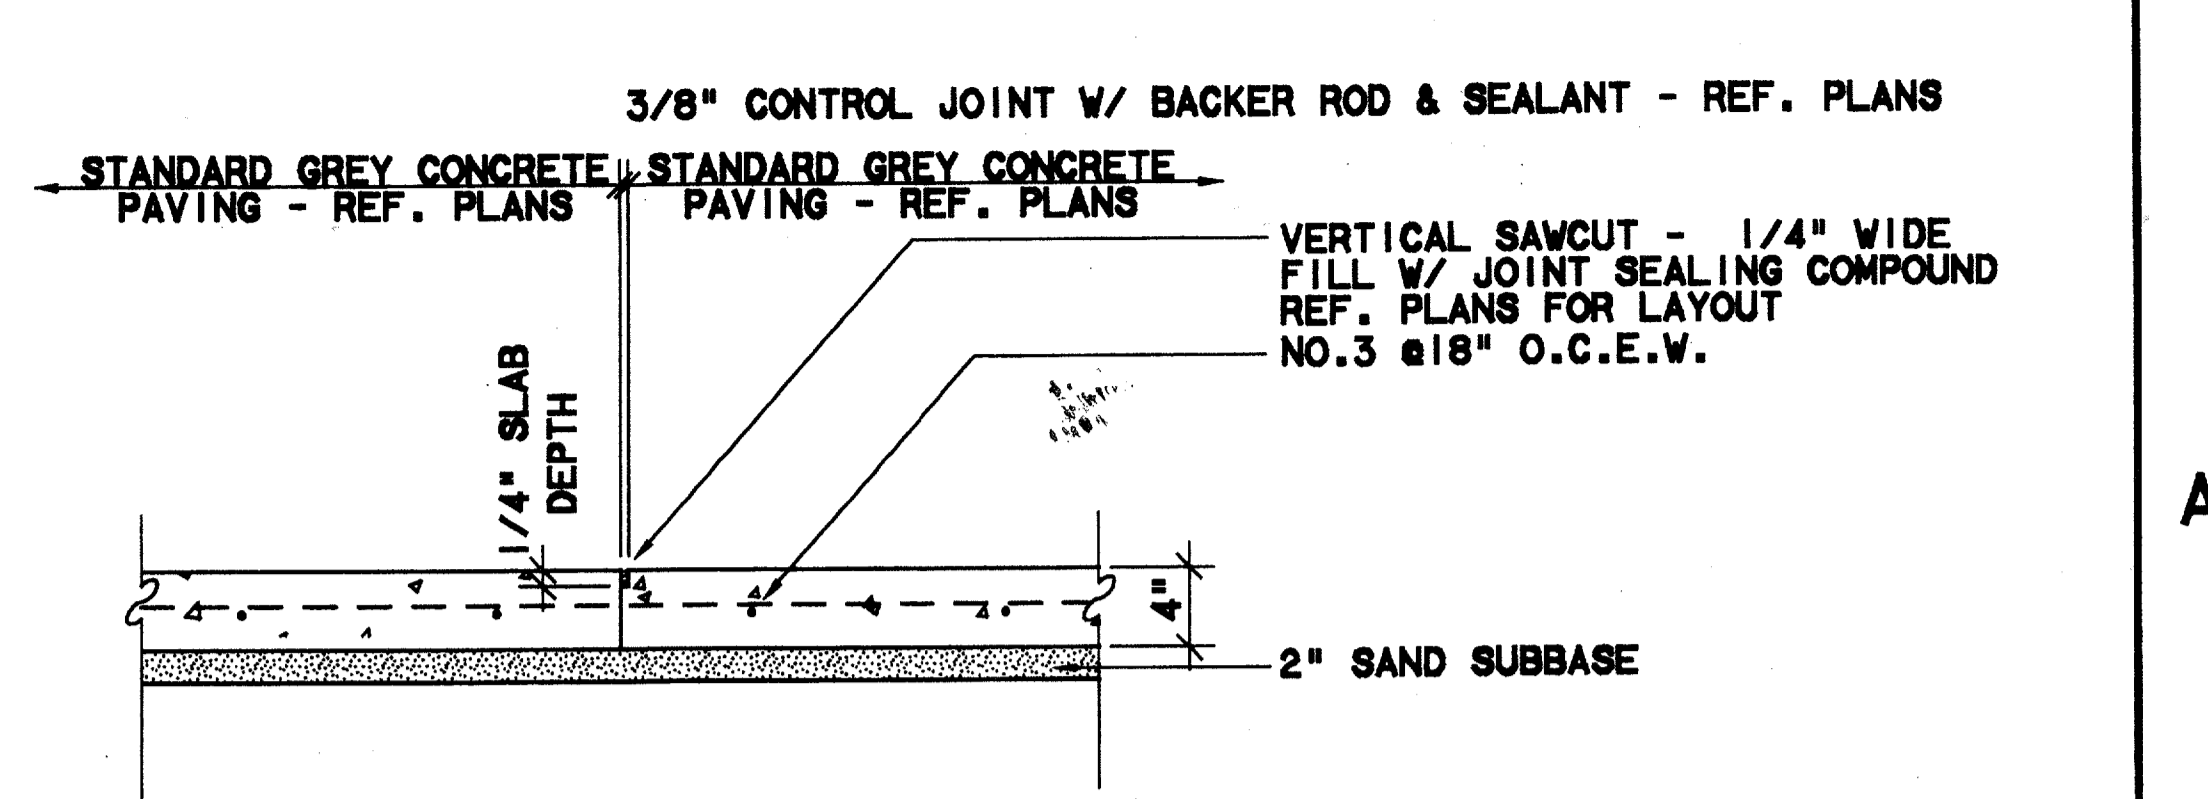

CONSTRUCTION JOINT - SECTION
 SCALE: 1"=1'-0"
 CC5-0007

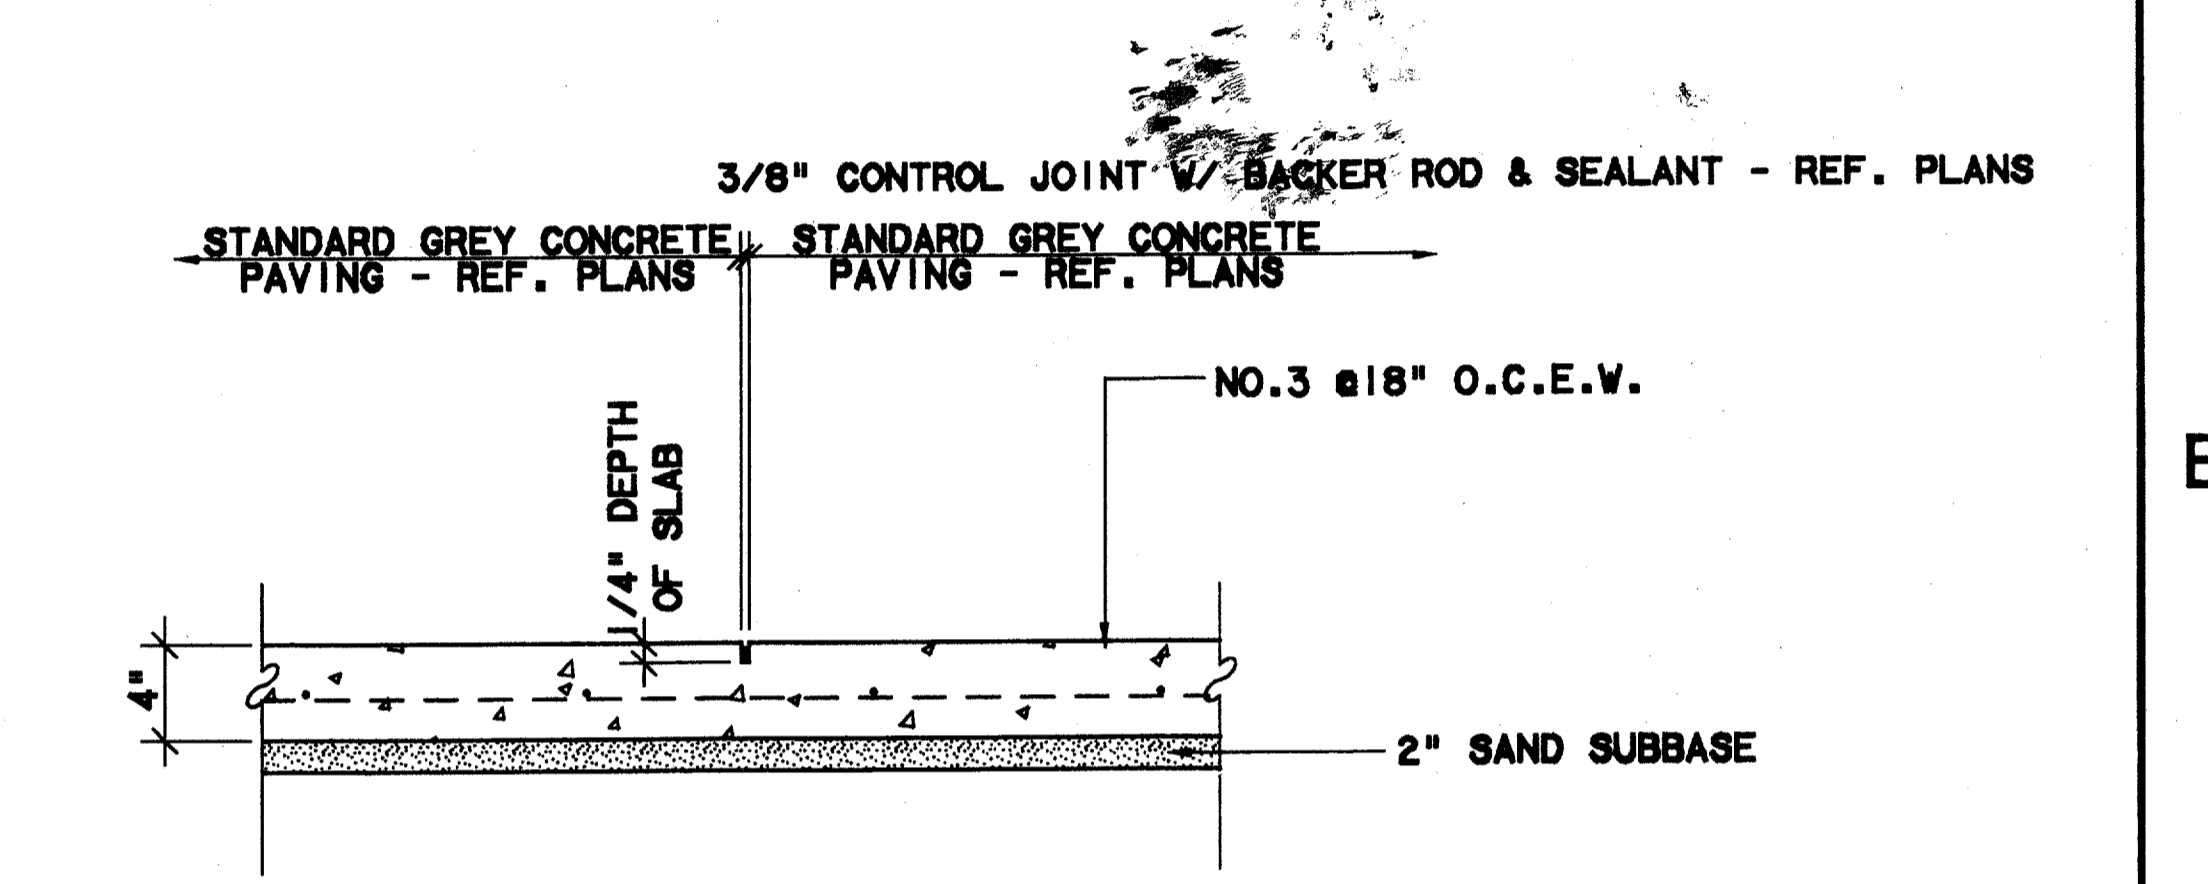

CONTROL JOINT - SECTION
 SCALE: 1"=1'-0"
 CC5-0007

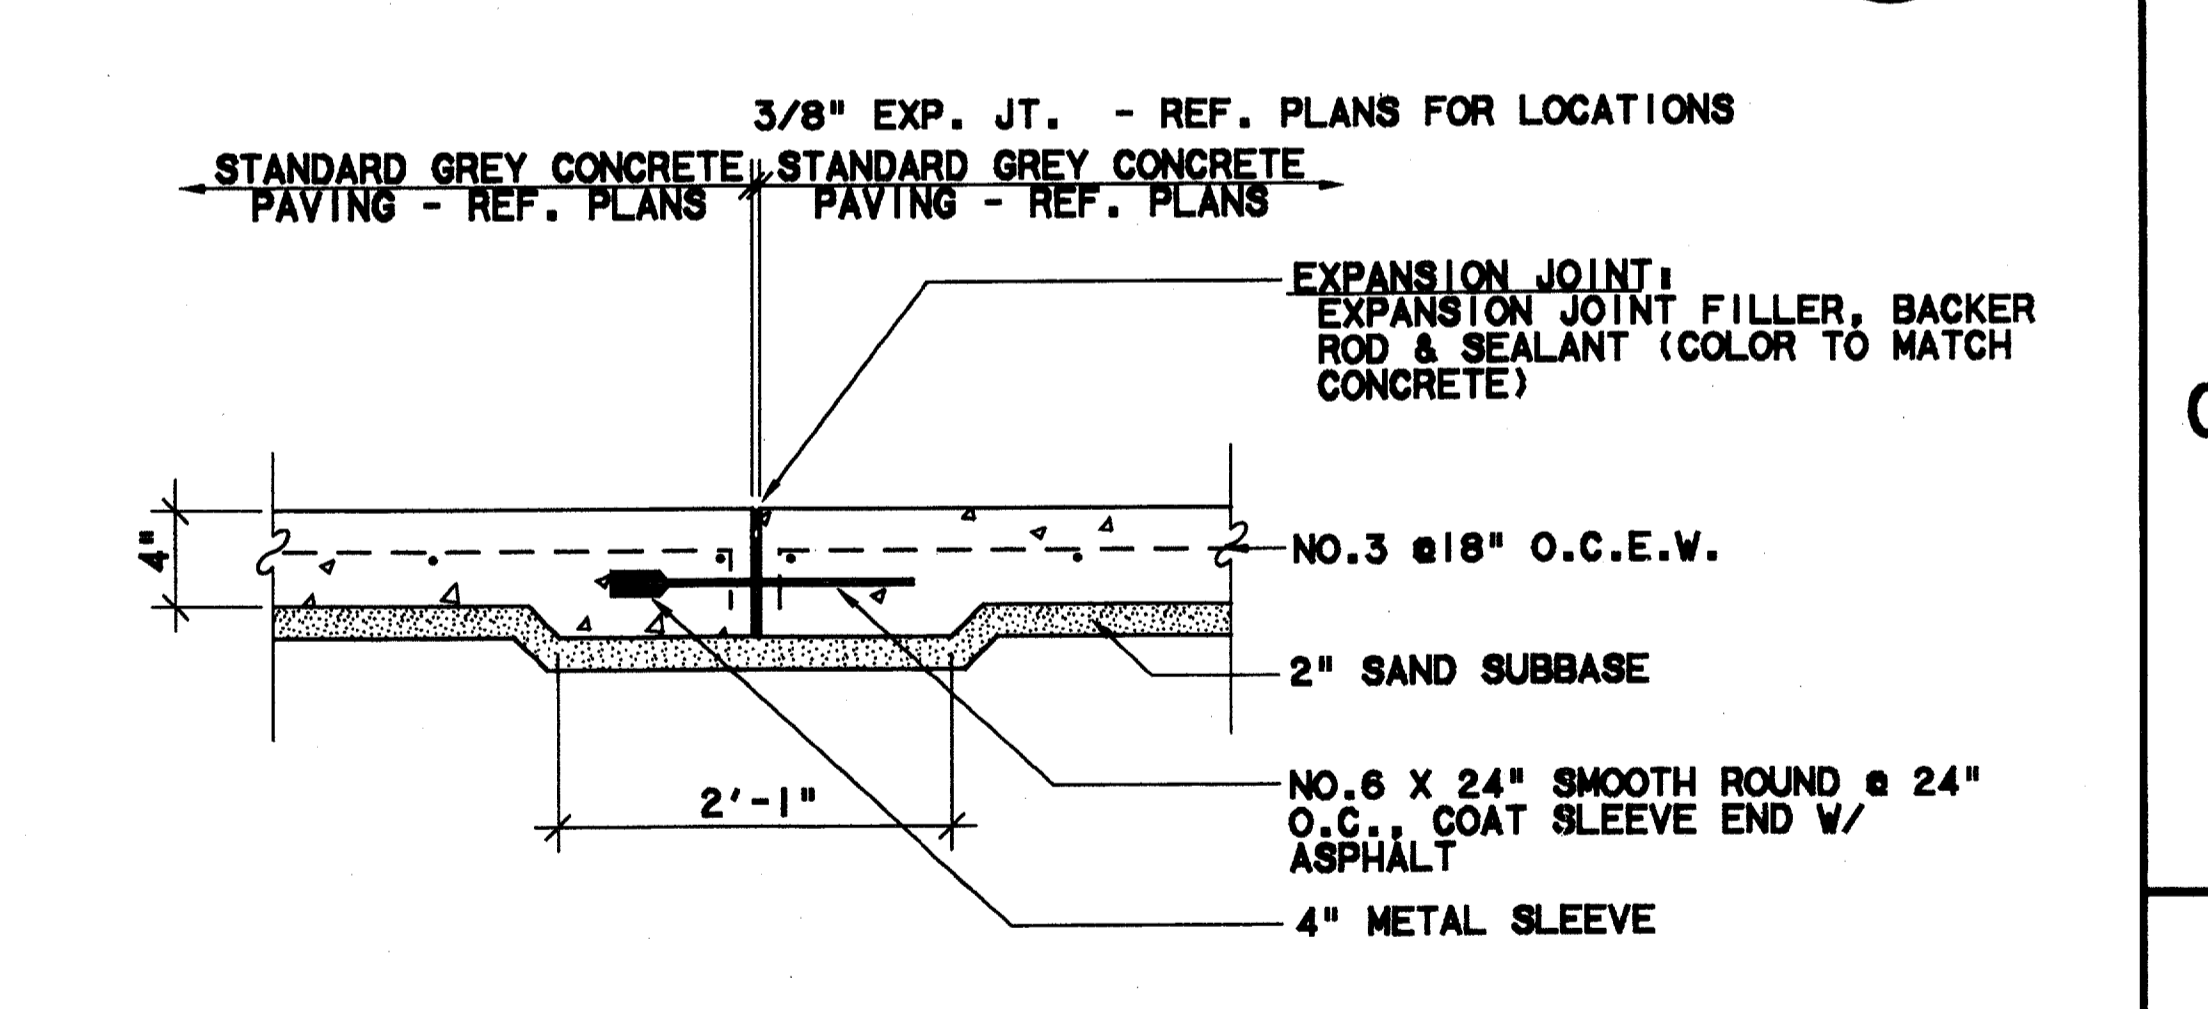

EXPANSION JOINT - SECTION
 SCALE: 1"=1'-0"
 CC5-0007

CONFORMED
 CONTRACT SHEET No. 48 OF 95

REV	DATE	DESCRIPTION	BY	ENG	CHK	APP	REV	DATE	DESCRIPTION	BY	ENG	CHK	APP

 2211 North Lamar Dallas, Texas 75202 214-954-0016	 WENDY LOPEZ & ASSOCIATES, INC. ENGINEERING • SURVEYING • CONSTRUCTION SERVICES 1825 MARKET CENTER BLVD - SUITE 510 DALLAS, TEXAS 75207 (214) 748-7777	 DART	SCALE: AS NOTED	ADDISON TRANSIT CENTER HARDSCAPE DETAILS
			DRAWN: M. AVETON DESIGNED: G. MILLER CHECKED: G. MILLER IN CHARGE: V. STEVENS DATE: 14 AUGUST 97	
				CONTRACT: C-97000136 DWG No.: LC2-0002 REV: 0