




\$\$\$DGN SPECIFICATIONS\$\$\$
 \$\$\$SYTIME\$\$\$
 \$\$\$PRF\$\$\$
 \$\$\$USER NAME\$\$\$
 \$\$\$PRF ROT\$\$\$
 \$\$\$PEN\$\$\$
 \$\$\$FILE 6\$\$\$
 \$\$\$FILE 7\$\$\$
 \$\$\$FILE 8\$\$\$
 \$\$\$FILE 9\$\$\$
 \$\$\$FILE 10\$\$\$
 \$\$\$FILE 1\$\$\$
 \$\$\$FILE 2\$\$\$
 \$\$\$FILE 3\$\$\$
 \$\$\$FILE 4\$\$\$
 \$\$\$FILE 5\$\$\$

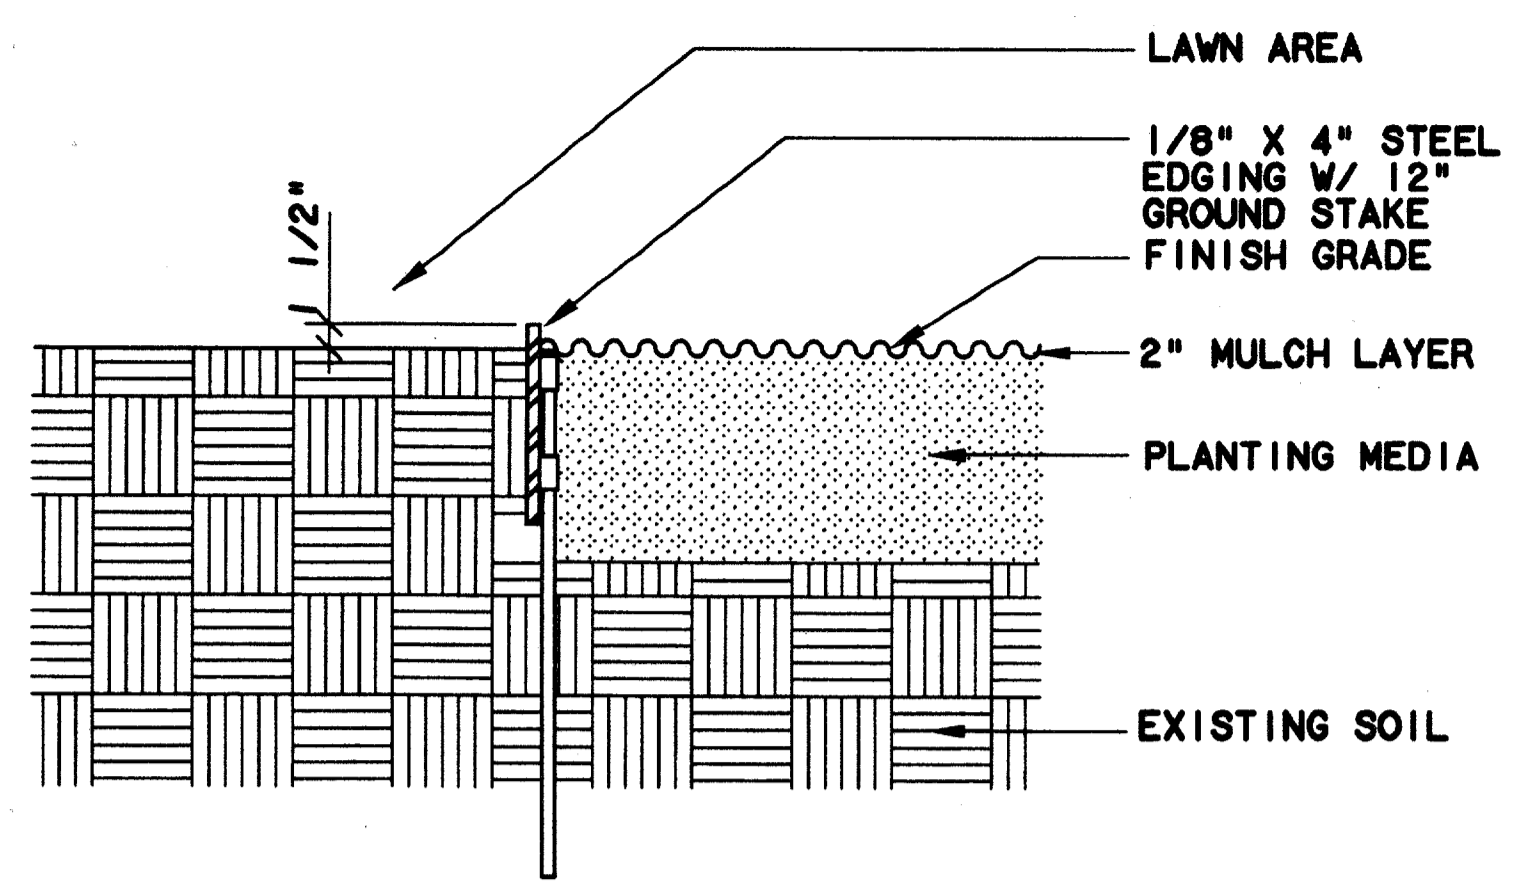


STEEL EDGING - SECTION
N.T.S.

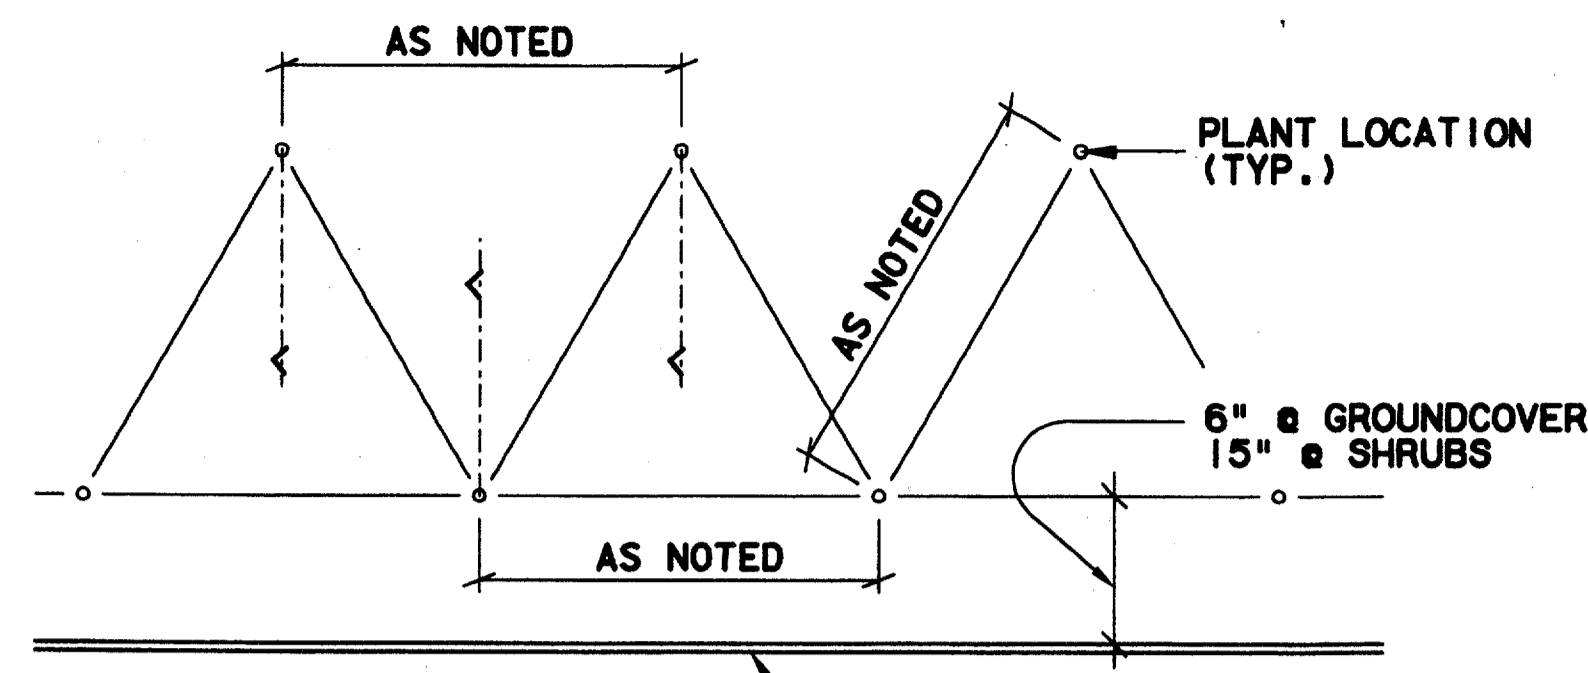


TRIANGULAR SPACING - PLAN
N.T.S.

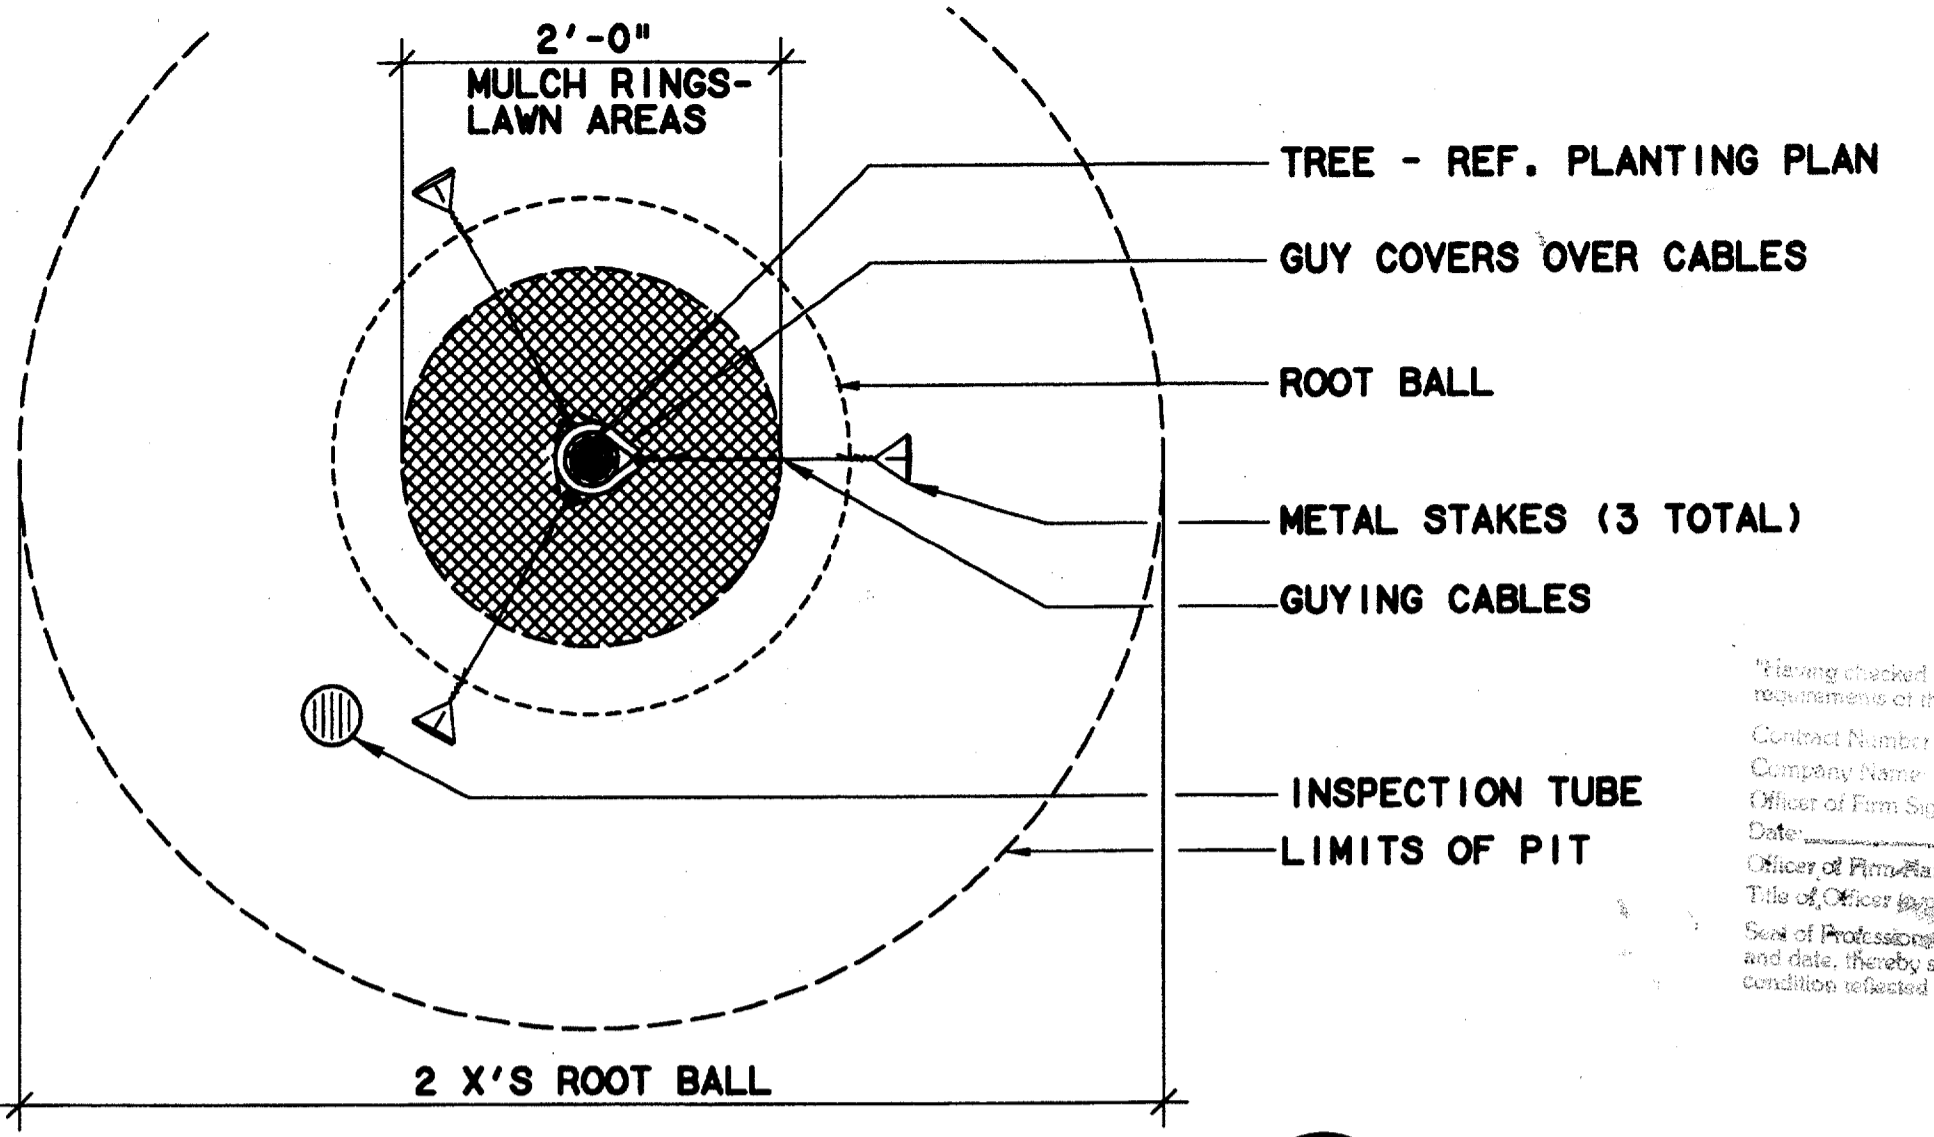


TYPICAL TREE STAKING - PLAN
N.T.S.

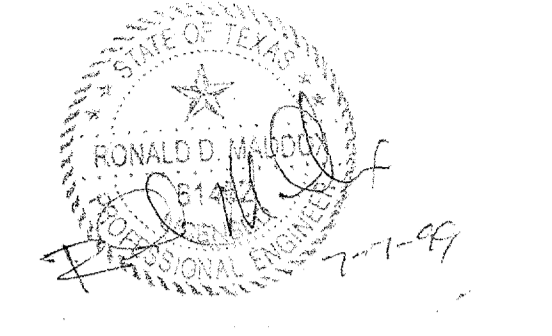


Record (As-built) Certificate
 Having checked this submission, we certify that it conforms to the requirements of the contract as all suggestions and other changes are noted.
 Contract Number: 97000136
 Company Name: WEA
 Officer of Firm Signature: Tom Kader
 Title of Officer: President
 Date: 14 AUGUST 97
 Scale of Professional Seal: Wendy Lopez & Associates, Inc., including registration and date, thereby certifying that the drawings for recording are in full compliance with the requirements of the contract as noted below.

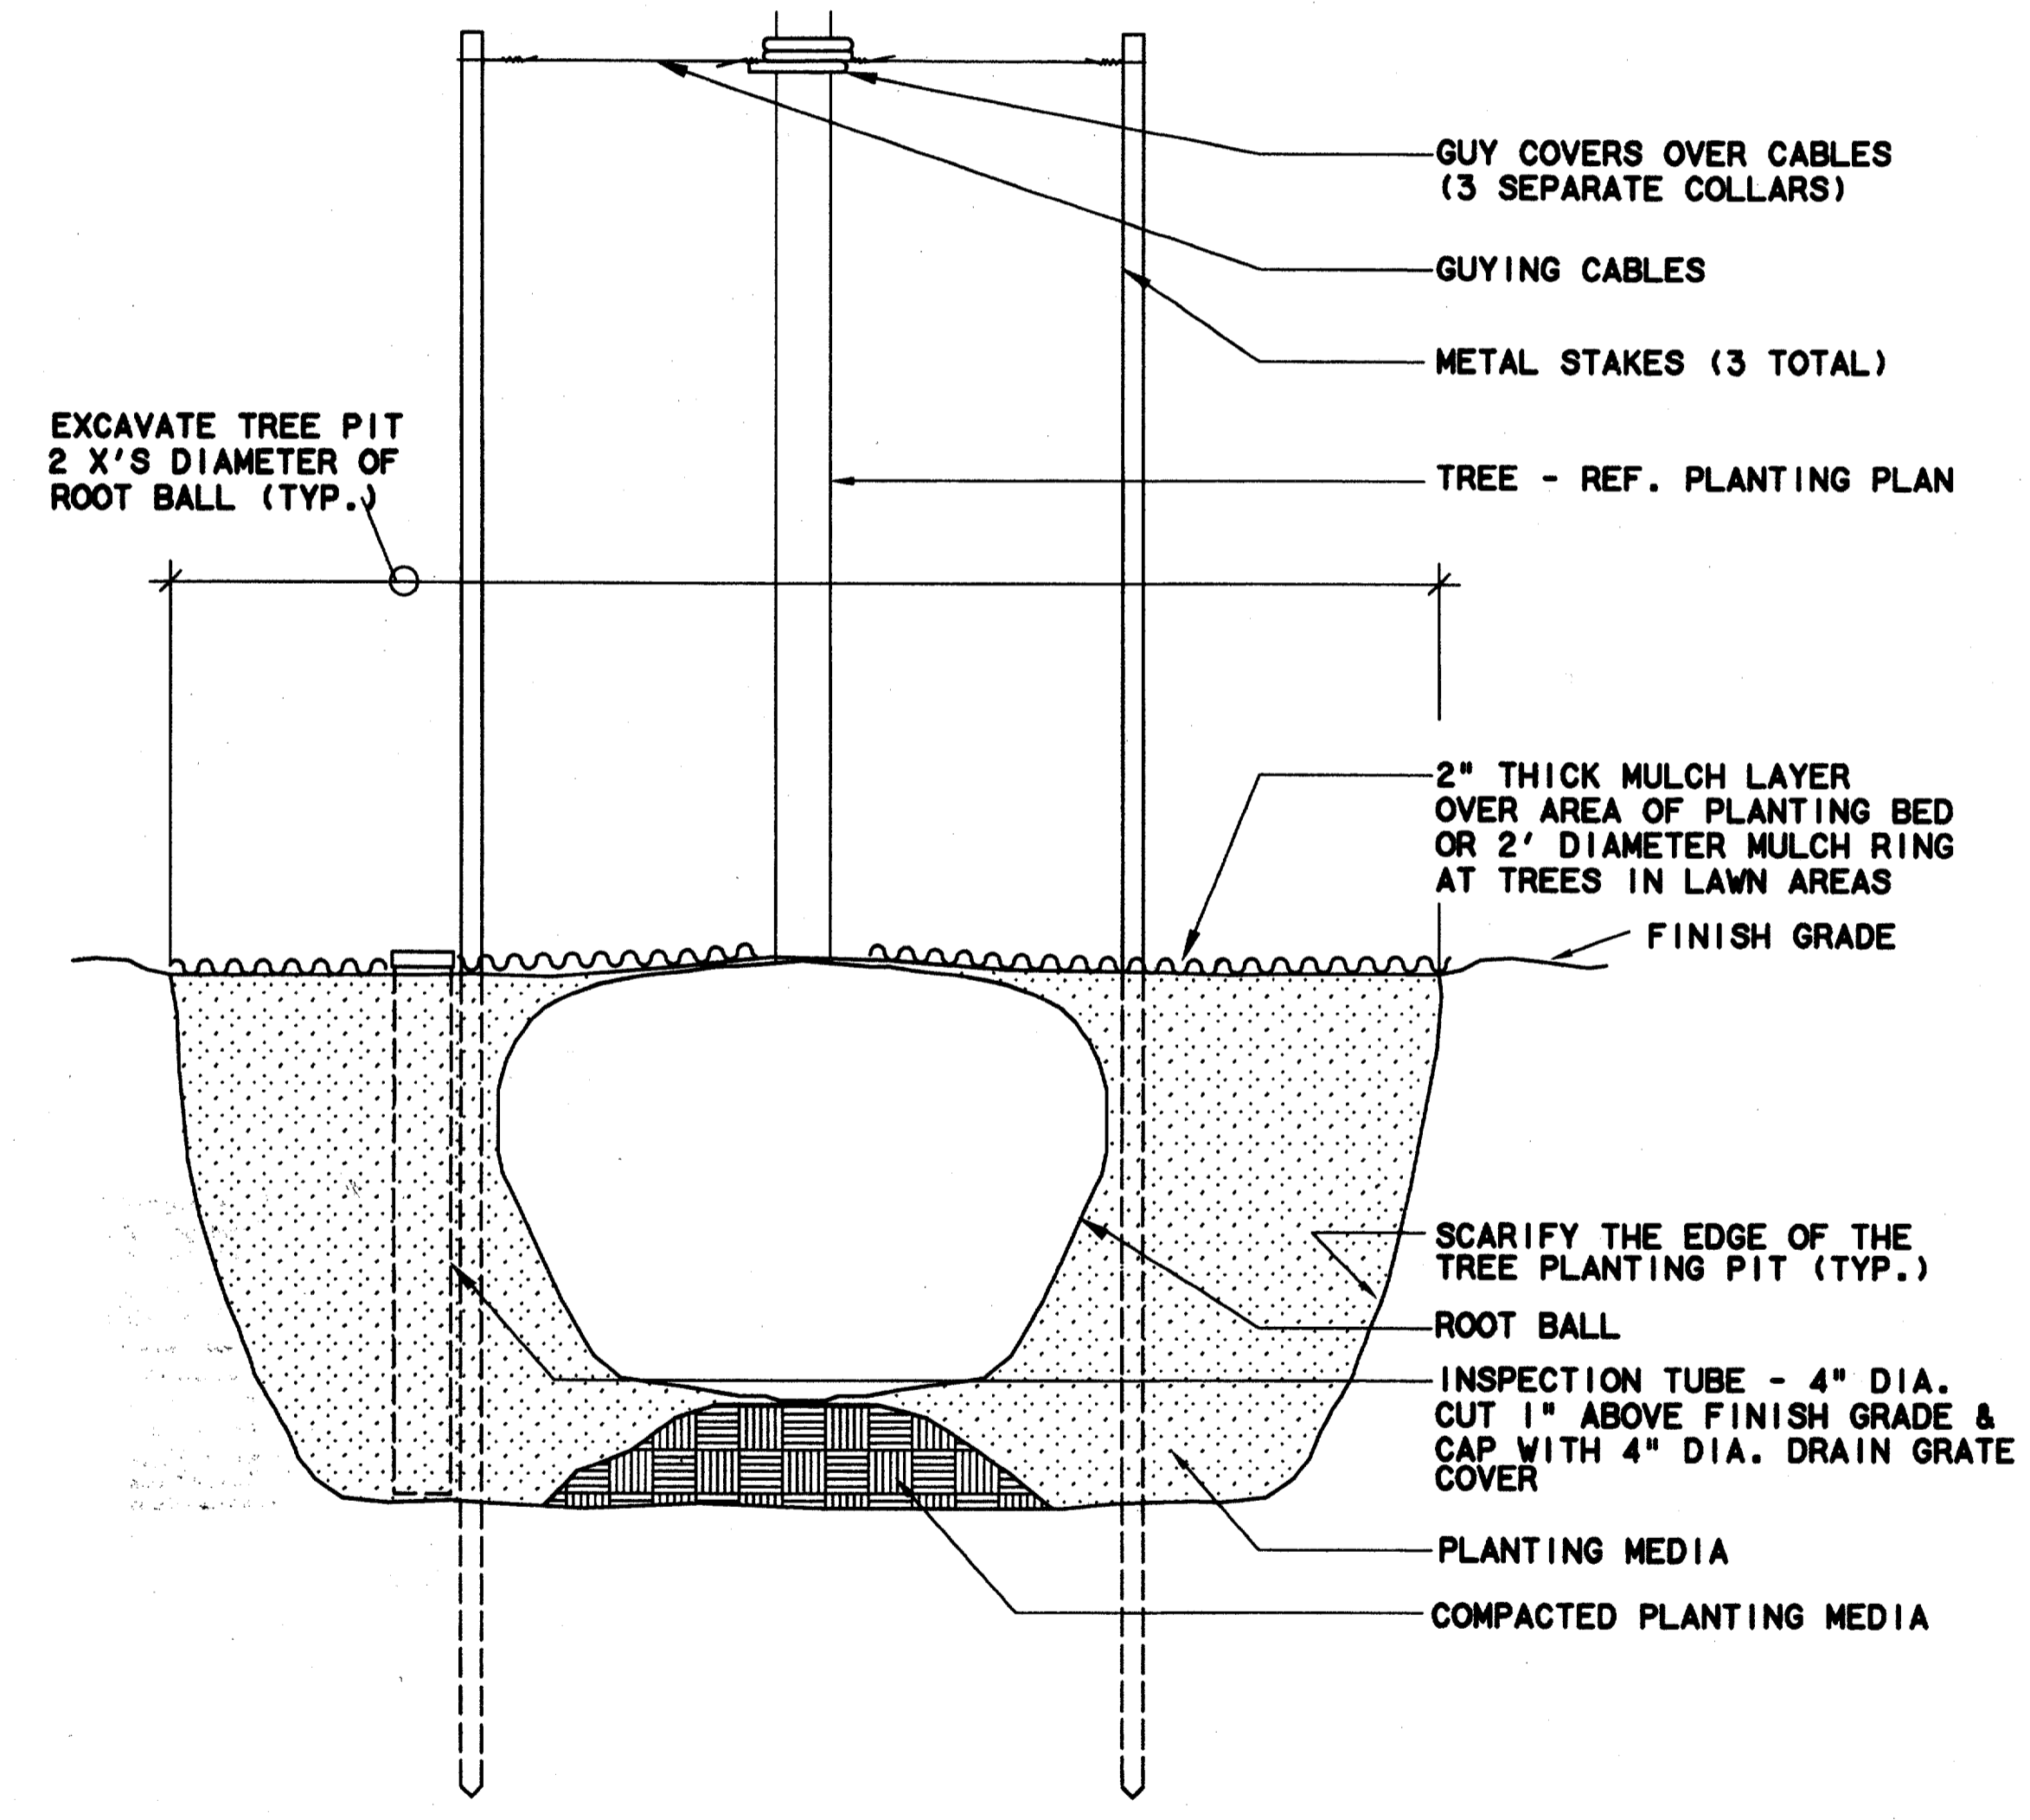


TREE STAKING @ LAWN - SECTION
N.T.S.

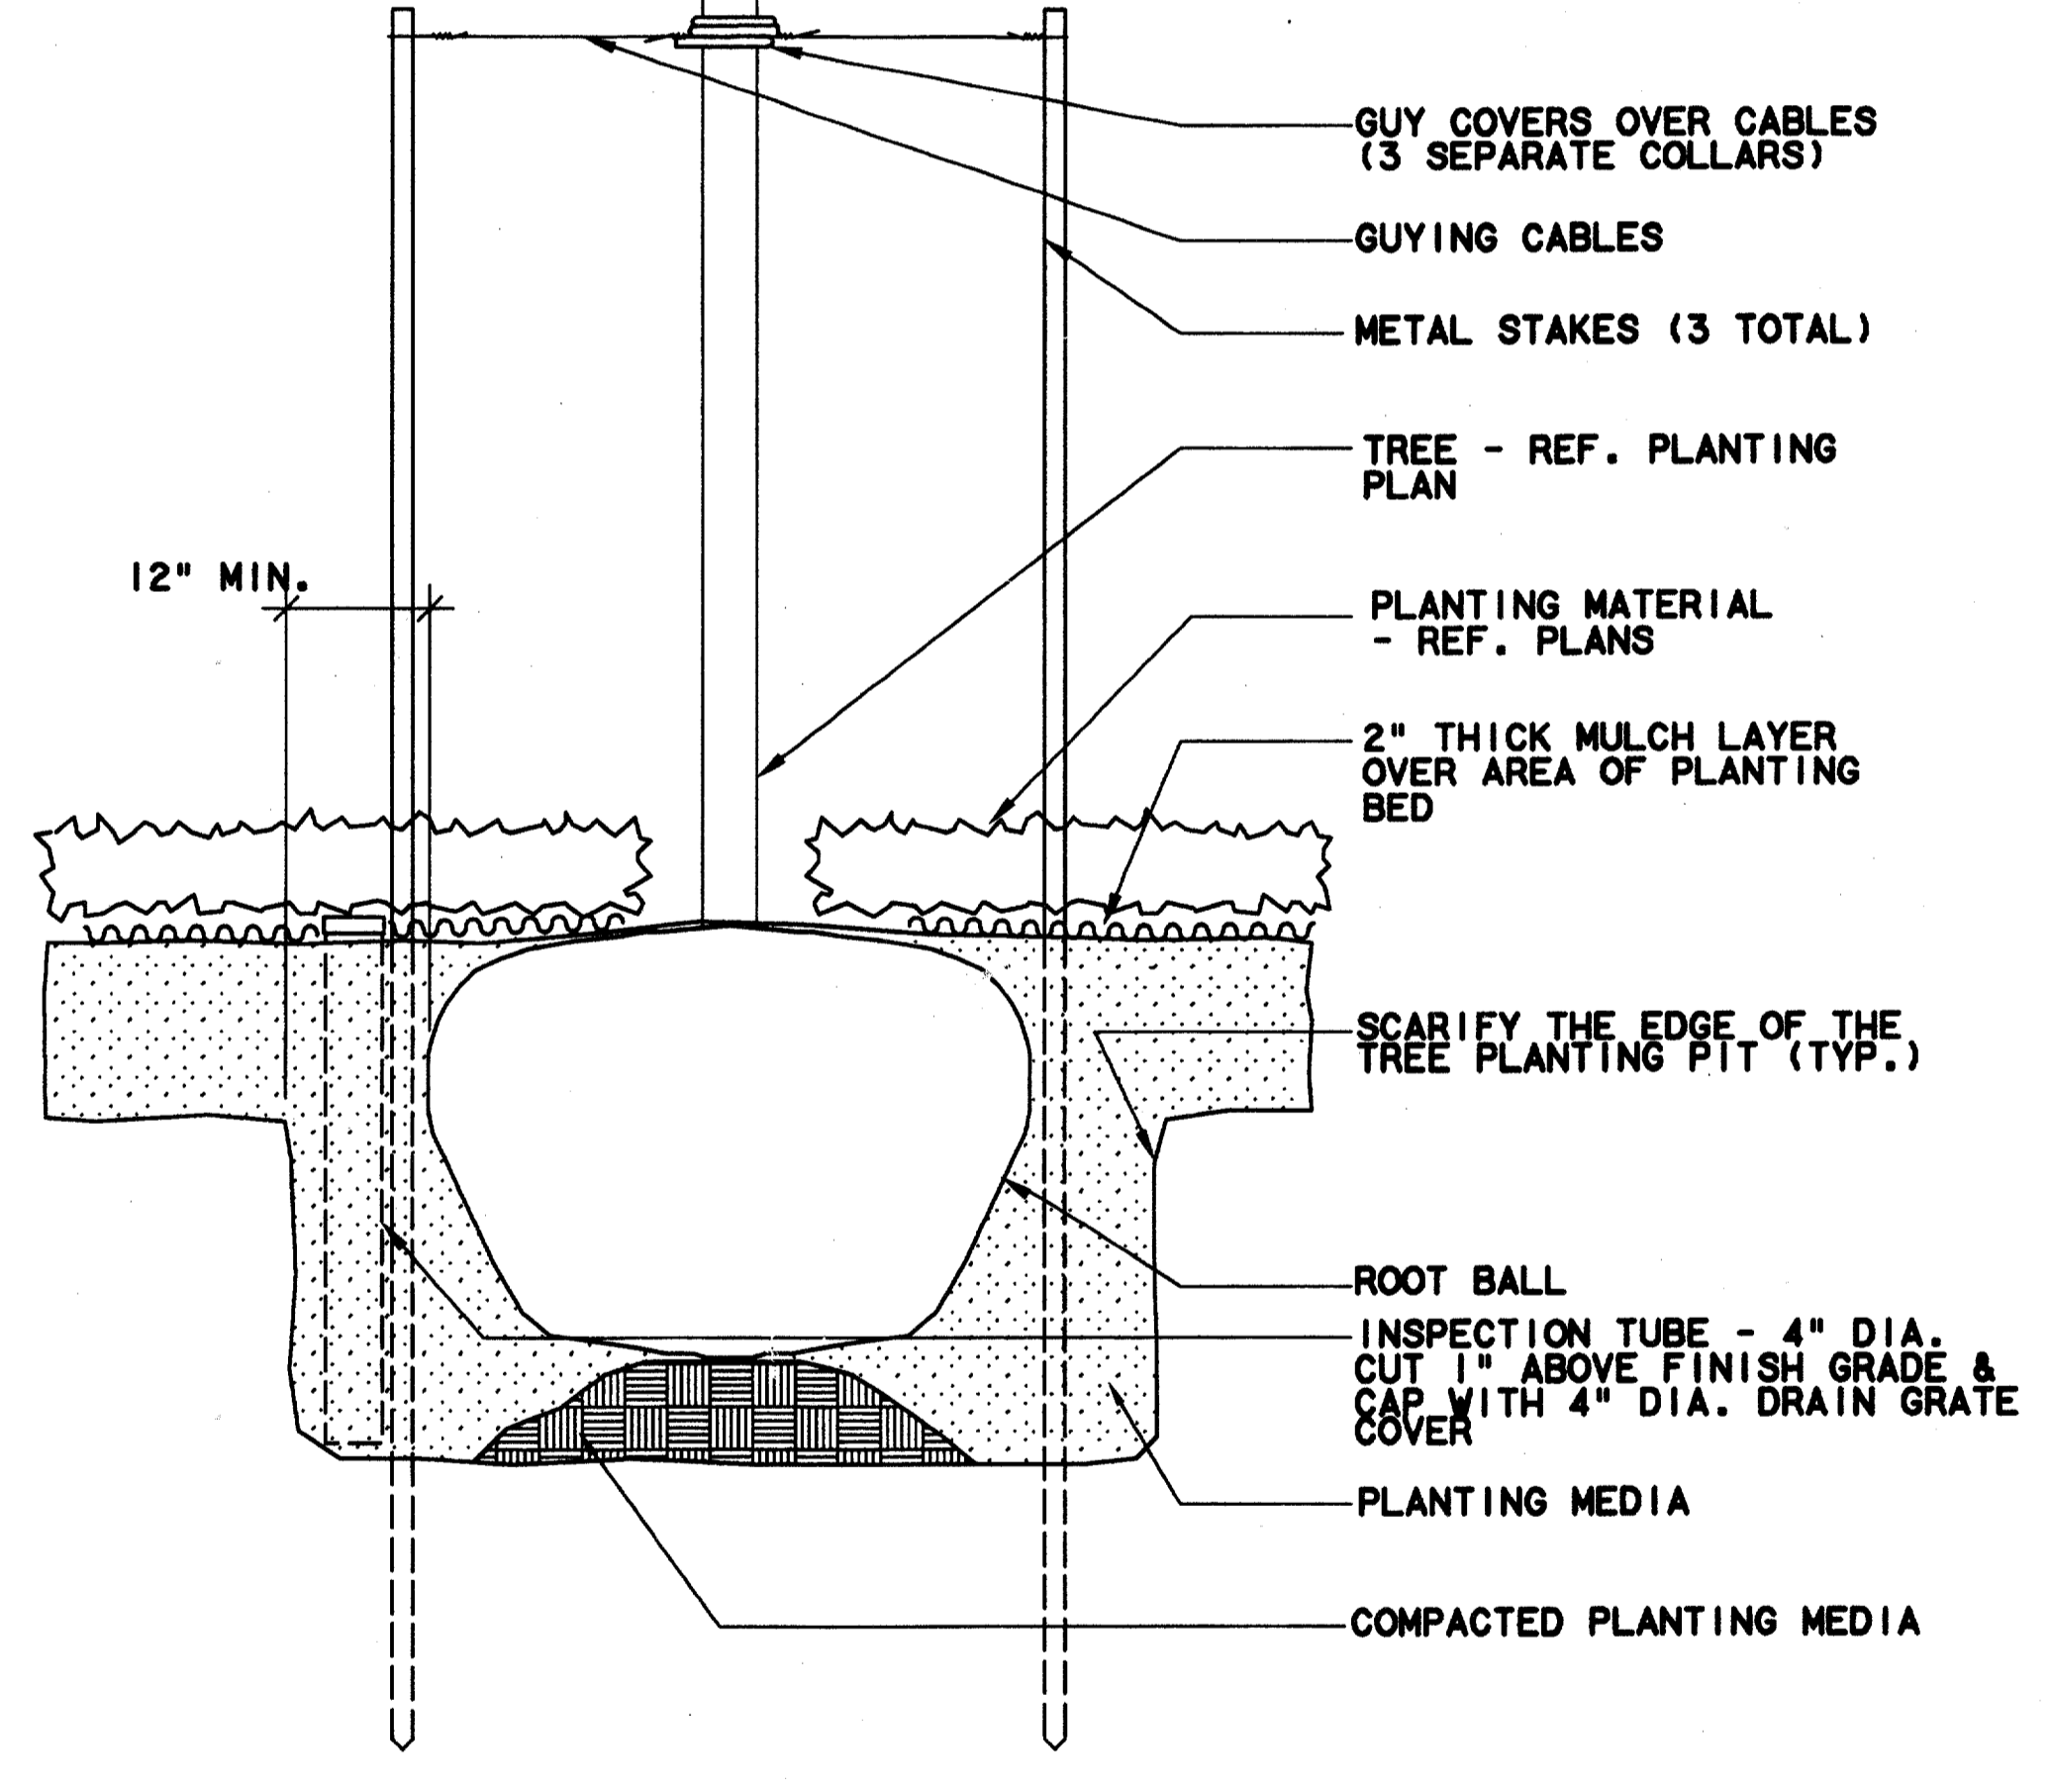

TREE STAKING @ PLANTER - SECTION
N.T.S.

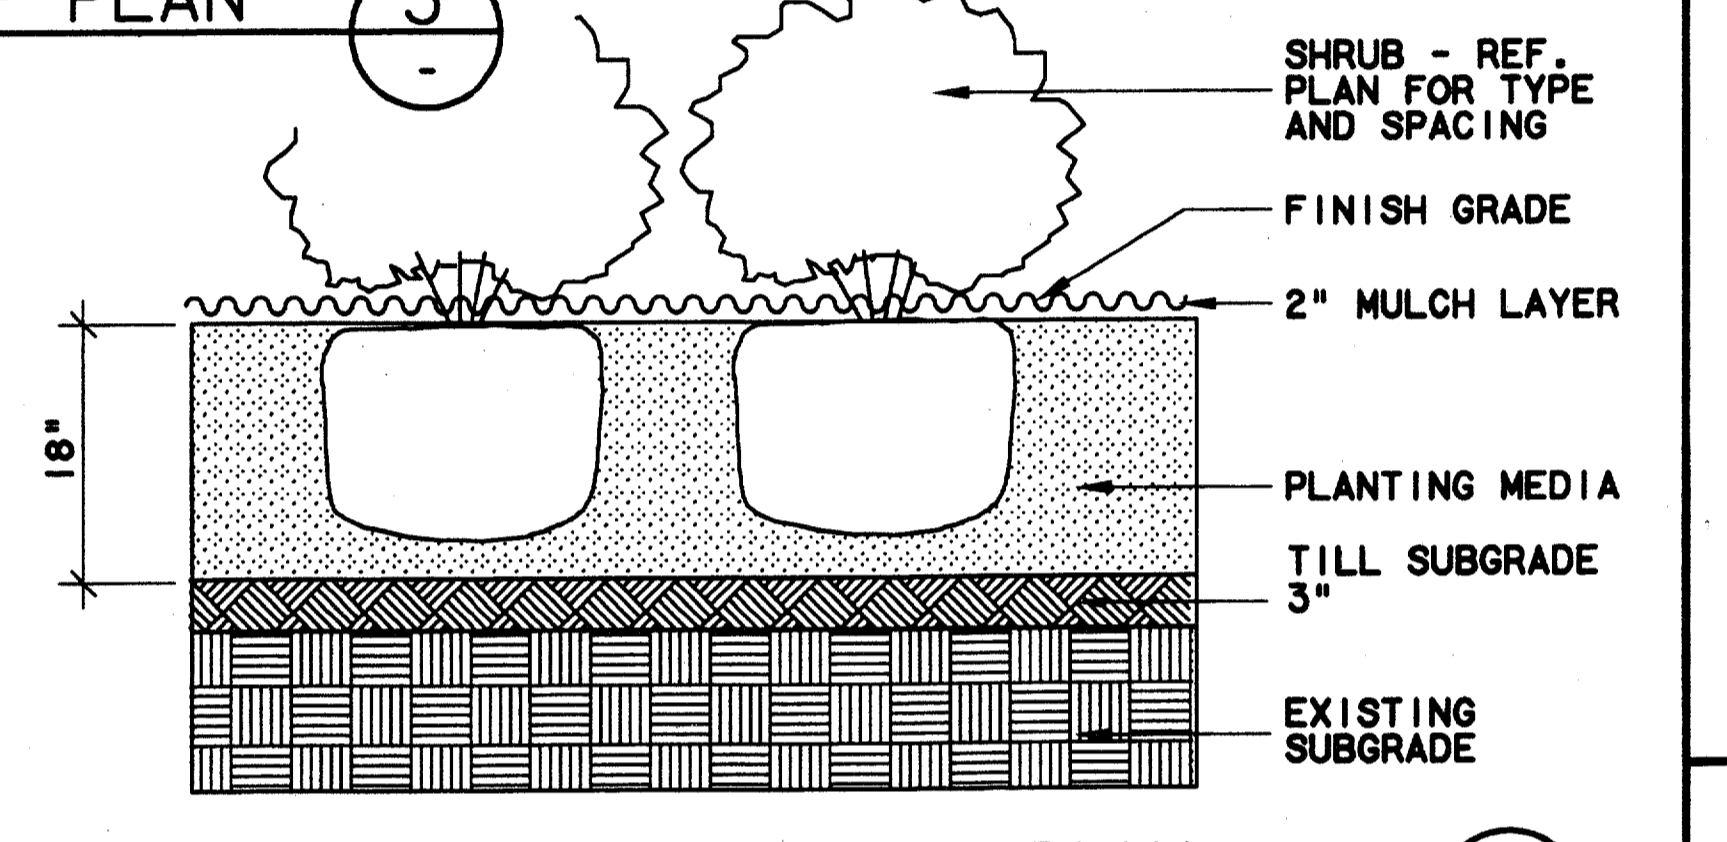

SHRUB PLANTING - SECTION
N.T.S.

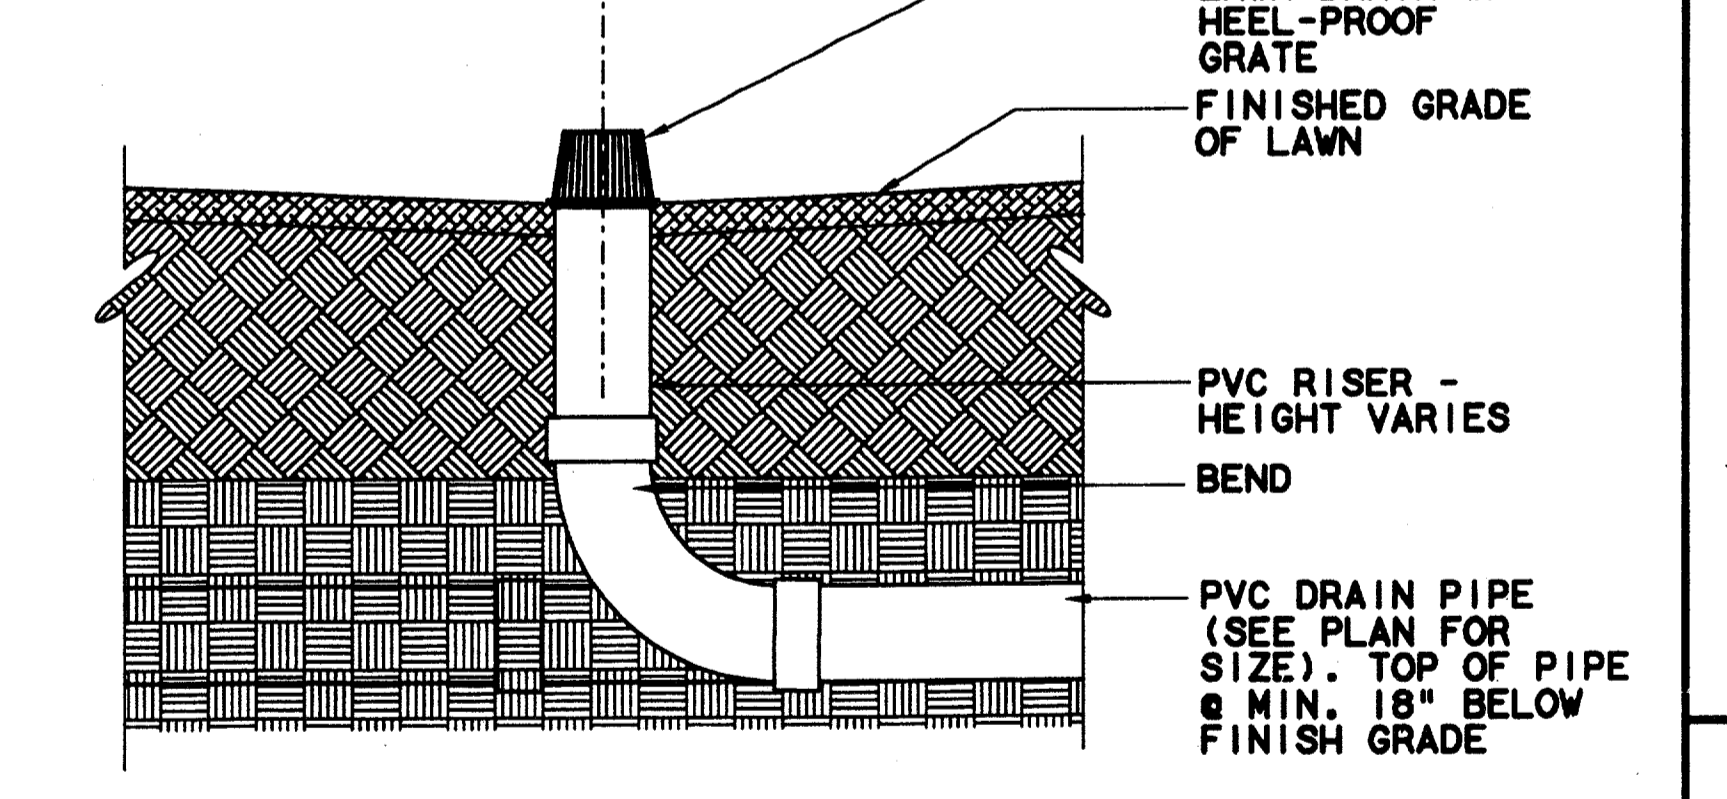

PLANTER DRAIN - SECTION
N.T.S.

CONFORMED

CONTRACT SHEET No. 49 OF 95

**ADDISON
TRANSIT CENTER
PLANTING DETAILS**

REV	DATE	DESCRIPTION	BY	ENG	CHK	APP	REV	DATE	DESCRIPTION	BY	ENG	CHK	APP

 SWA Group 227 North Lamar Dallas, Texas 75202 214-954-8210	 WENDY LOPEZ & ASSOCIATES, INC. ENGINEERING • SURVEYING • CONSTRUCTION SERVICES 1825 MARKET CENTER BLVD - SUITE 310 DALLAS, TEXAS 75207 (214) 741-7777	 DART PROJECT	SCALE: AS NOTED	CONTRACT C-97000136	DWG No. LC2-0003	REV 0
			DRAWN: N. AVETON DESIGNED: C. MILLER CHECKED: C. MILLER IN CHARGE: V. STEVENS DATE: 14 AUGUST 97			
			CONTRACT SHEET No. 49 OF 95			
			ADDISON TRANSIT CENTER PLANTING DETAILS			
CONTRACT C-97000136			DWG No. LC2-0003			
REV 0			REV 0			