


\$\$\$\$\$SPECIFICATION\$\$\$\$\$
 \$\$\$SYTIME\$\$\$\$\$
 \$\$\$PRF\$\$\$
 \$\$\$SERNAME\$\$\$

\$\$\$PRF ROT\$\$\$
 \$\$\$PEN\$\$\$


\$\$\$FILE03\$\$\$
 \$\$\$FILE7\$\$\$
 \$\$\$FILE8\$\$\$
 \$\$\$FILE9\$\$\$
 \$\$\$FILE10\$\$\$

\$\$\$FILE1\$\$\$
 \$\$\$FILE2\$\$\$
 \$\$\$FILE3\$\$\$
 \$\$\$FILE4\$\$\$
 \$\$\$FILE5\$\$\$

8000-20V
 ON DMD

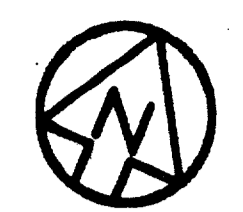

- NOTE:
- CONTRACTOR TO ENSURE ALIGNMENT OF EXTERIOR PATTERN W/ BUILDING. PLACE SETTING BED MORTAR OVER PREPARED SUBSTRATE, AND SPREAD, COMPACT AND SCREED TO UNIFORM THICKNESS CONTRACTOR TO ENSURE ELEVATION DEVIATION WITHIN 1/8" OF ELEVATION SHOWN AND LIPPING MAXIMUM 1/16" OVER THE ENTIRE LENGTH OF JOINTS.

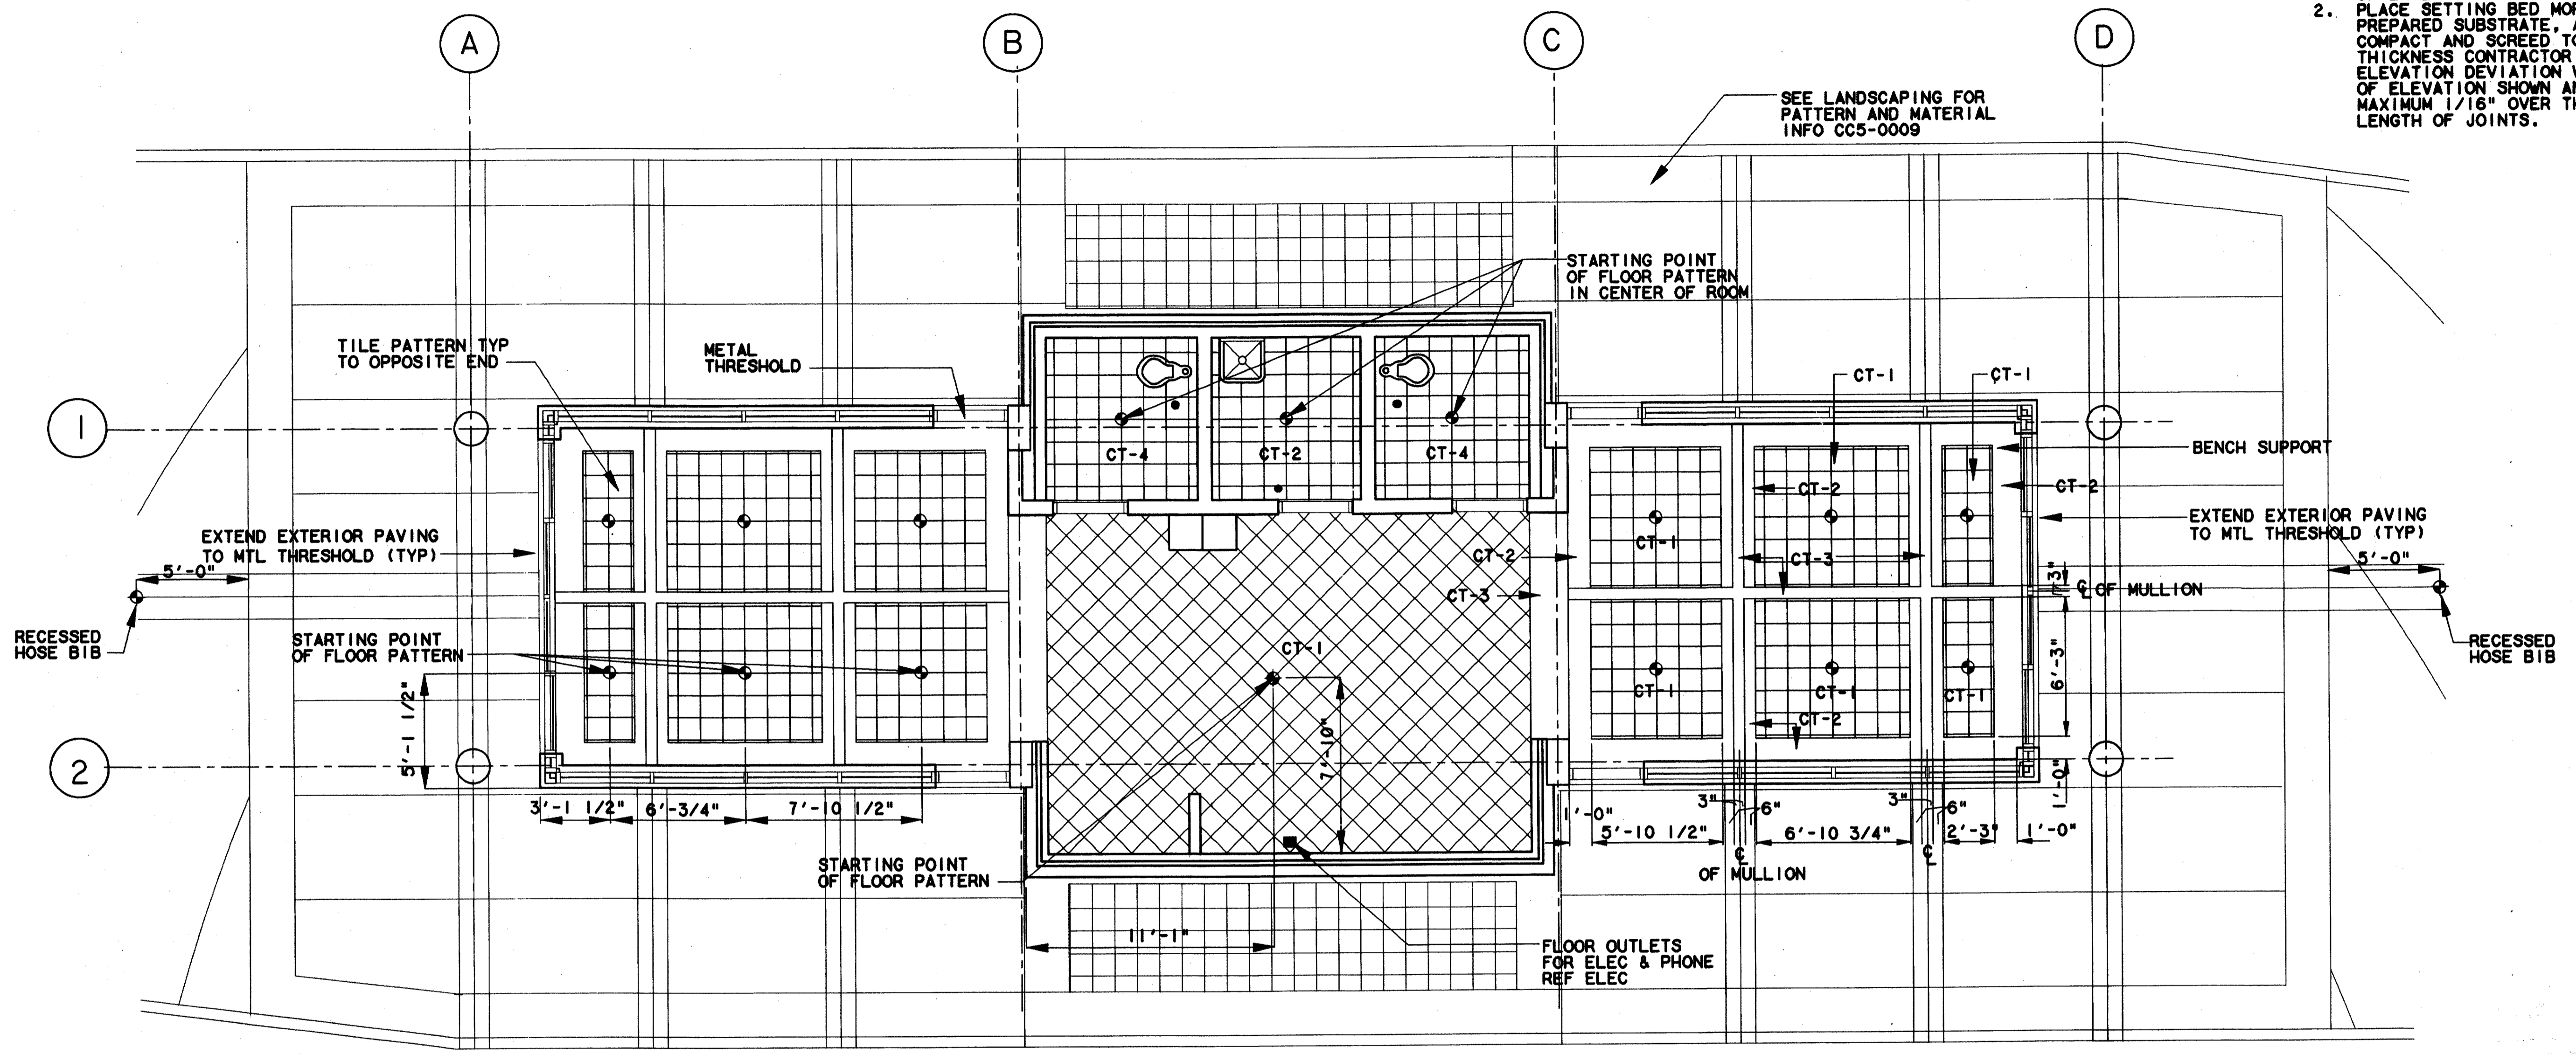

SEE LANDSCAPING FOR PATTERN AND MATERIAL INFO CC5-0009

STARTING POINT OF FLOOR PATTERN IN CENTER OF ROOM

TILE PATTERN TYP TO OPPOSITE END

METAL THRESHOLD

BENCH SUPPORT

EXTEND EXTERIOR PAVING TO MTL THRESHOLD (TYP)

EXTEND EXTERIOR PAVING TO MTL THRESHOLD (TYP)

STARTING POINT OF FLOOR PATTERN

RECESSED HOSE BIB

STARTING POINT OF FLOOR PATTERN

FLOOR OUTLETS FOR ELEC & PHONE REF ELEC

ENCLOSURE FLOOR PATTERN PLAN
 SCALE: 1/4"=1'-0"


Record (As-built) Certification
 "Having checked this submission, we certify that it conforms to the requirements of the contract in all respects, except as otherwise noted."
 Contract Number: 97000136
 Company Name: WLA
 Officer or Firm Signature: [Signature]
 Date: 7-7-99
 Officer of Firm Name (typed): Tom Kader
 Title of Officer (typed): PRESIDENT
 Seal of Professional Engineer of Construction Contractor, including signature and date, thereby setting record (as-built) drawings for accuracy of as-built condition reflected herein, must be placed below.

- LEGEND:
- CT-1 12X12 ANGELFIRE FLAGSTONE
 - CT-2 6X6 MAYFLOWER RED QUARTZITE
 - CT-3 6X6 SERENGETI FLAGSTONE
 - CT-4 6X6 ANGELFIRE FLAGSTONE
 - ◊ CENTER

CONFORMED


CONTRACT SHEET No. 60 OF 95

REV	DATE	DESCRIPTION	BY	ENG	CHK	APP	REV	DATE	DESCRIPTION	BY	ENG	CHK	APP

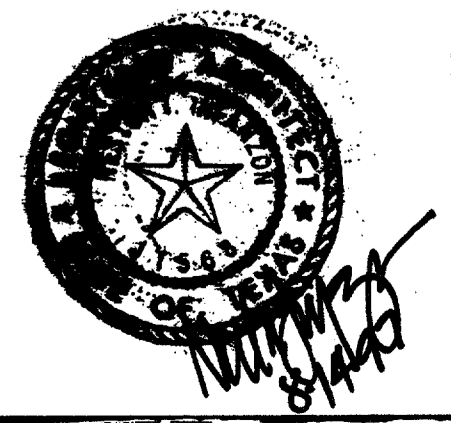

WLA
 Lockwood, Andrews & Newnam, Inc.
 A SUBSIDIARY OF LEO A DALY

WLA
 WENDY LOPEZ & ASSOCIATES, INC.
 ENGINEERING • SURVEYING • CONSTRUCTION SERVICES
 125 MARKET CENTER BLVD - SUITE 500
 DALLAS, TEXAS 75201
 (214) 74-7777

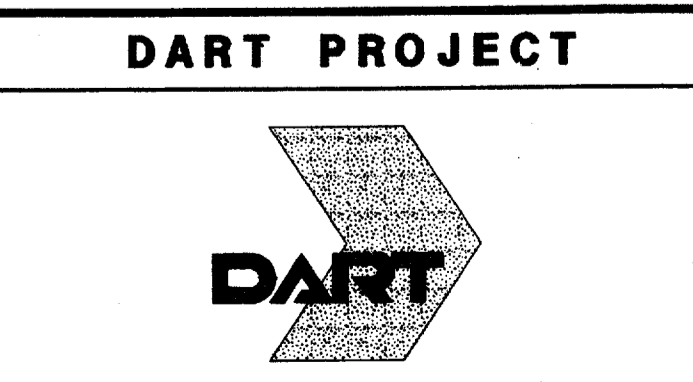

SCALE: 1/4"=1'-0"
 DRAWN: K. DEAN
 DESIGNED: W. INFANZON/K. DEAN
 CHECKED: W. INFANZON/ROM BOLTON
 IN CHARGE: V. STEVENS
 DATE: 14 AUGUST 97

ADDISON TRANSIT CENTER ENCLOSURE FLOOR PATTERN PLAN

CONTRACT C-97000136	DWG No. AC2-0006	REV 0
---------------------	------------------	-------