
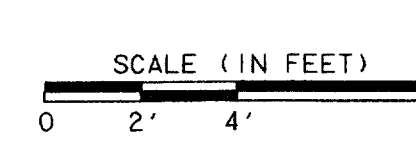
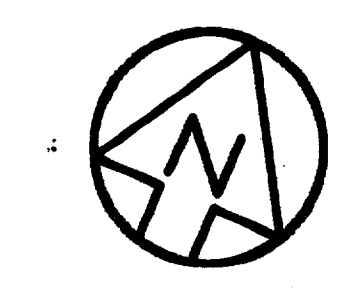


\$\$\$DGN SPECIFICATION\$\$\$  
 \$\$\$SYTIME\$\$\$  
 \$\$\$PRF\$\$\$  
 \$\$\$SERNAME\$\$\$

\$\$\$PRF ROT\$\$\$  
 \$\$\$PEN\$\$\$

\$\$\$ILEG\$\$\$  
 \$\$\$ILE7\$\$\$  
 \$\$\$ILE8\$\$\$  
 \$\$\$ILE9\$\$\$  
 \$\$\$ILE10\$\$\$

\$\$\$ILE1\$\$\$  
 \$\$\$ILE2\$\$\$  
 \$\$\$ILE3\$\$\$  
 \$\$\$ILE4\$\$\$  
 \$\$\$ILE5\$\$\$

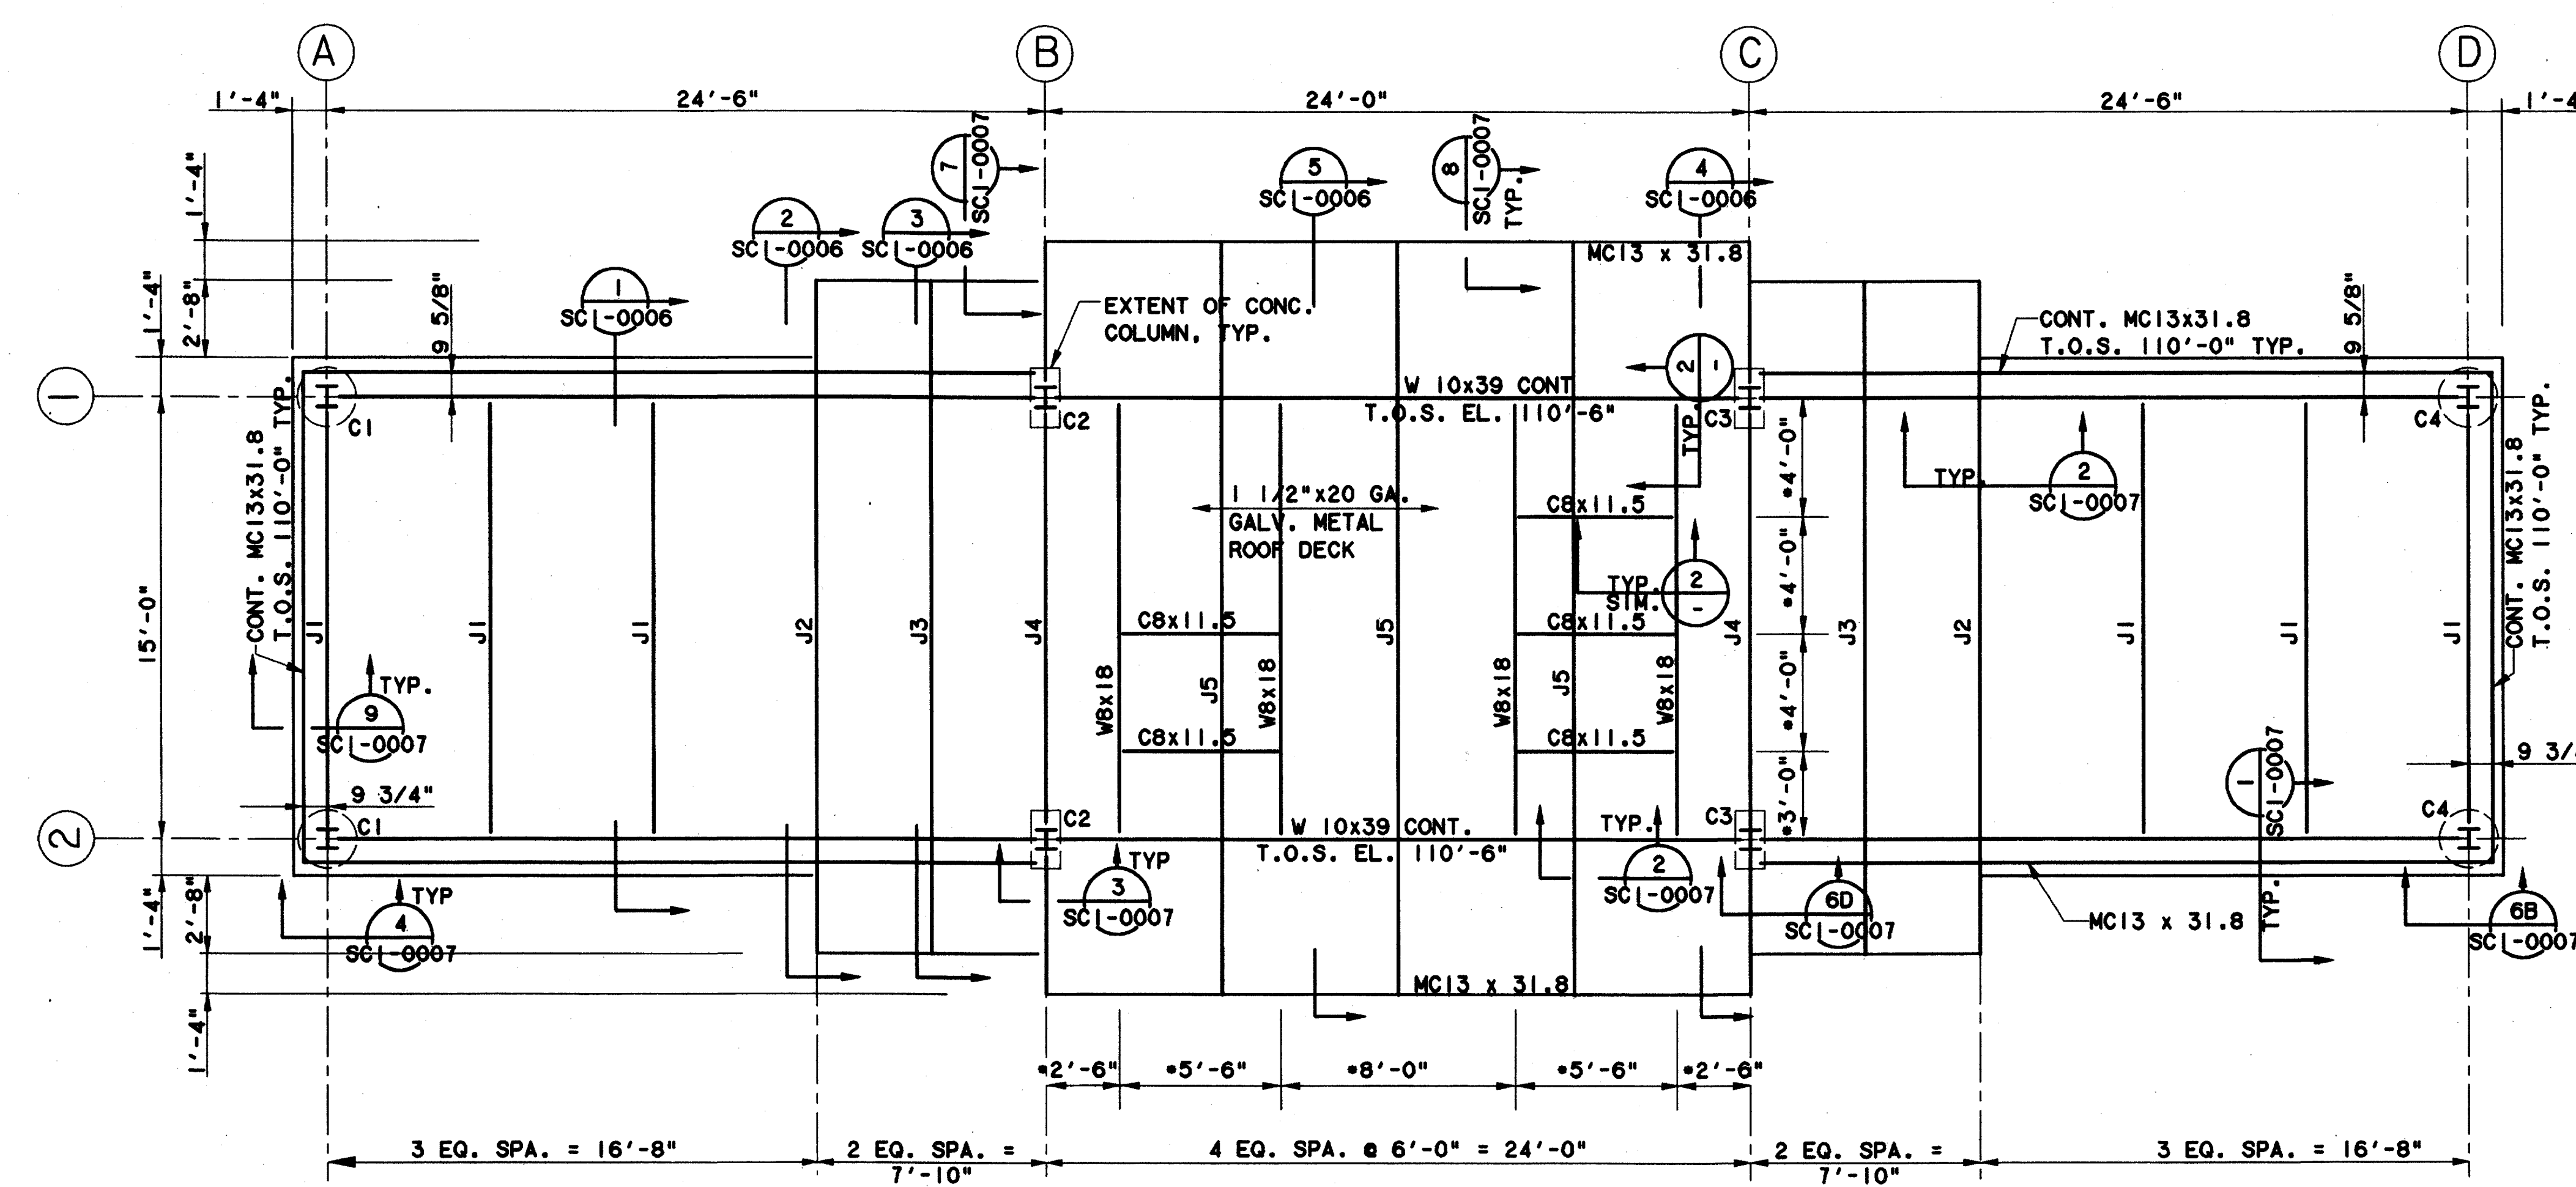


- NOTES:**
1. FINISHED FLOOR EL. = 100'-0"
  2. T.O.S. EL. = TOP OF STEEL ELEVATION
  3. REFER TO MECHANICAL DRAWINGS FOR EQUIPMENT SIZES, LOCATIONS, AND OTHER REQUIREMENT.
  4. T.O.S. EL. = 110'-6" UNLESS NOTED OTHERWISE.

**ENCLOSURE ROOF FRAMING PLAN**  
 SCALE: 1/4" = 1'-0"

COLUMN SCHEDULE			REFERENCE
MARK	SIZE	BOTT. BASE E. EL.	
C1	W 8x35	98.83	DET. 05/SCI-0007
C2	W 8x35	98.92	DET. 05/SCI-0007
C3	W 8x35	98.92	DET. 05/SCI-0007
C4	W 8x35	98.83	DET. 05/SCI-0007


JOIST SCHEDULE			REFERENCE
MARK	SIZE	T.O. STEEL	
J1	TS 4x4x3/16	10'-6"	DET. 1/SCI-0006
J2	TS 4x4x3/16	10'-6"	DET. 2/SCI-0006
J3	TS 4x4x3/16	10'-6"	DET. 3/SCI-0006
J4	TS 4x4x3/16	10'-6"	DET. 4/SCI-0006
J5	TS 4x4x3/16	10'-6"	DET. 5/SCI-0006

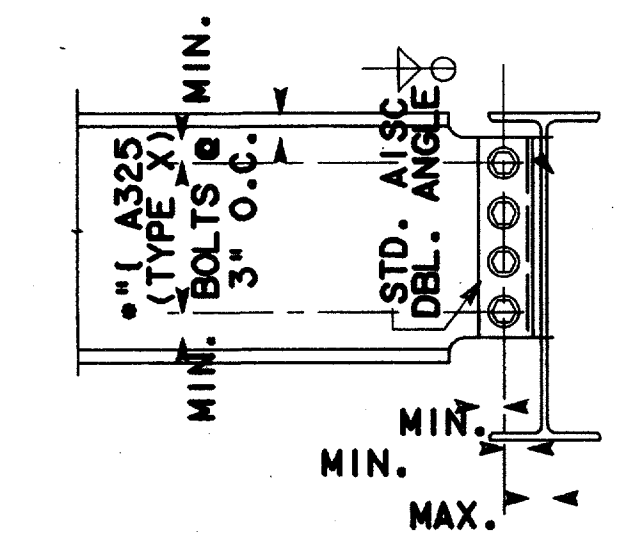

STANDARD BEAM END CONNECTIONS	
BEAM SIZE	NUMBER OF BOLTS
W8, W10	2
C8	2

**SHEAR CONNECTION DETAILS**  
 N.T.S.

Record (As-built) Certification  
 I have checked this submission, we certify that it conforms to the requirements of the contract in all respects, except as otherwise indicated.  
 Contract Number: 97000136  
 Company Name: WLA  
 Officer of Firm Signature: [Signature]  
 Date: 7-2-99  
 Title of Officer (Typed): PRESIDENT  
 Seal of Professional Engineer of Construction Contractors including signature and title, shall be placed below this certification. If the seal is not placed below this certification, it shall be considered invalid.

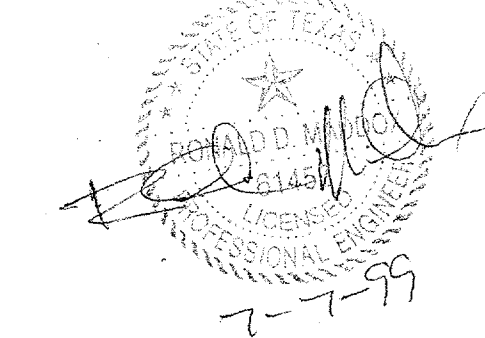


**CONFORMED**

CONTRACT SHEET No. 76 OF 95


**ADDISON  
 TRANSIT CENTER  
 ENCLOSURE ROOF  
 FRAMING PLAN**

REV	DATE	DESCRIPTION	BY	ENG	CHK	APP	REV	DATE	DESCRIPTION	BY	ENG	CHK	APP

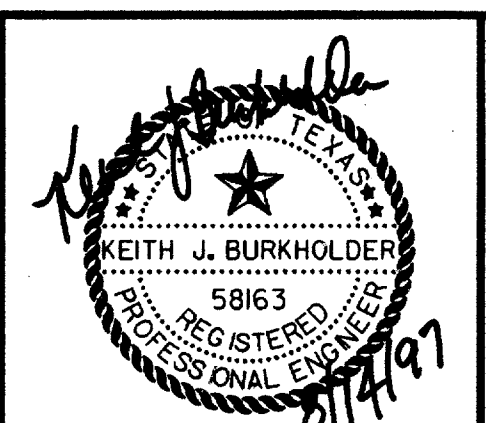

**lan**  
 Lockwood, Andrews & Newnam, Inc.  
 A SUBSIDIARY OF LEO A DALY

**WLA**  
 WENDY LOPEZ & ASSOCIATES, INC.  
 ENGINEERING • SURVEYING • CONSTRUCTION SERVICES  
 102 MARKET CENTER BLVD - SUITE 310  
 DALLAS, TEXAS 75207  
 (214) 741-7777

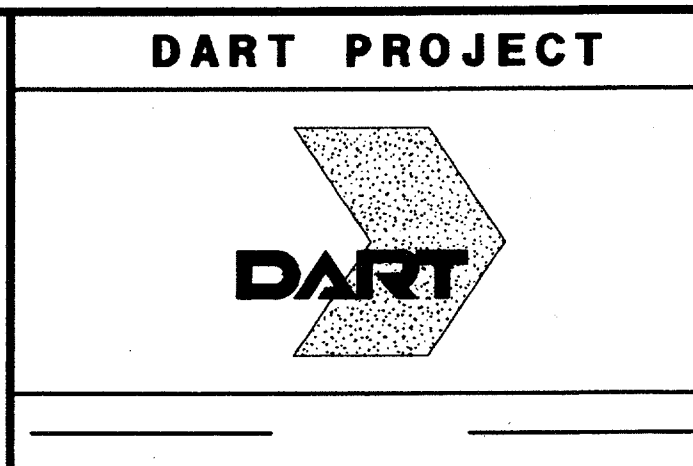

SCALE: 1/4" = 1'-0"  
 DRAWN: V. BAND  
 DESIGNED: V. BAND  
 CHECKED: K. BURKHOLDER  
 IN CHARGE: V. STEVENS  
 DATE: 14 AUGUST 97

CONTRACT C-97000136 DWG No. SCI-0005 REV 0