




\$\$\$DGN\$\$\$SPECIFICATION\$\$\$\$\$\$\$  
\$\$\$SYTIME\$\$\$\$\$\$\$  
\$\$\$PRF\$\$\$  
\$\$\$PEN\$\$\$  
\$\$\$USERNAME\$\$\$  
\$\$\$PRF ROT\$\$\$  
\$\$\$PEN\$\$\$  
\$\$\$USERNAME\$\$\$  
\$\$\$FILE6\$\$\$  
\$\$\$FILE7\$\$\$  
\$\$\$FILE8\$\$\$  
\$\$\$FILE9\$\$\$  
\$\$\$FILE10\$\$\$  
\$\$\$FILE6\$\$\$  
\$\$\$FILE7\$\$\$  
\$\$\$FILE8\$\$\$  
\$\$\$FILE9\$\$\$  
\$\$\$FILE10\$\$\$  
\$\$\$FILE1\$\$\$  
\$\$\$FILE2\$\$\$  
\$\$\$FILE3\$\$\$  
\$\$\$FILE4\$\$\$  
\$\$\$FILE5\$\$\$

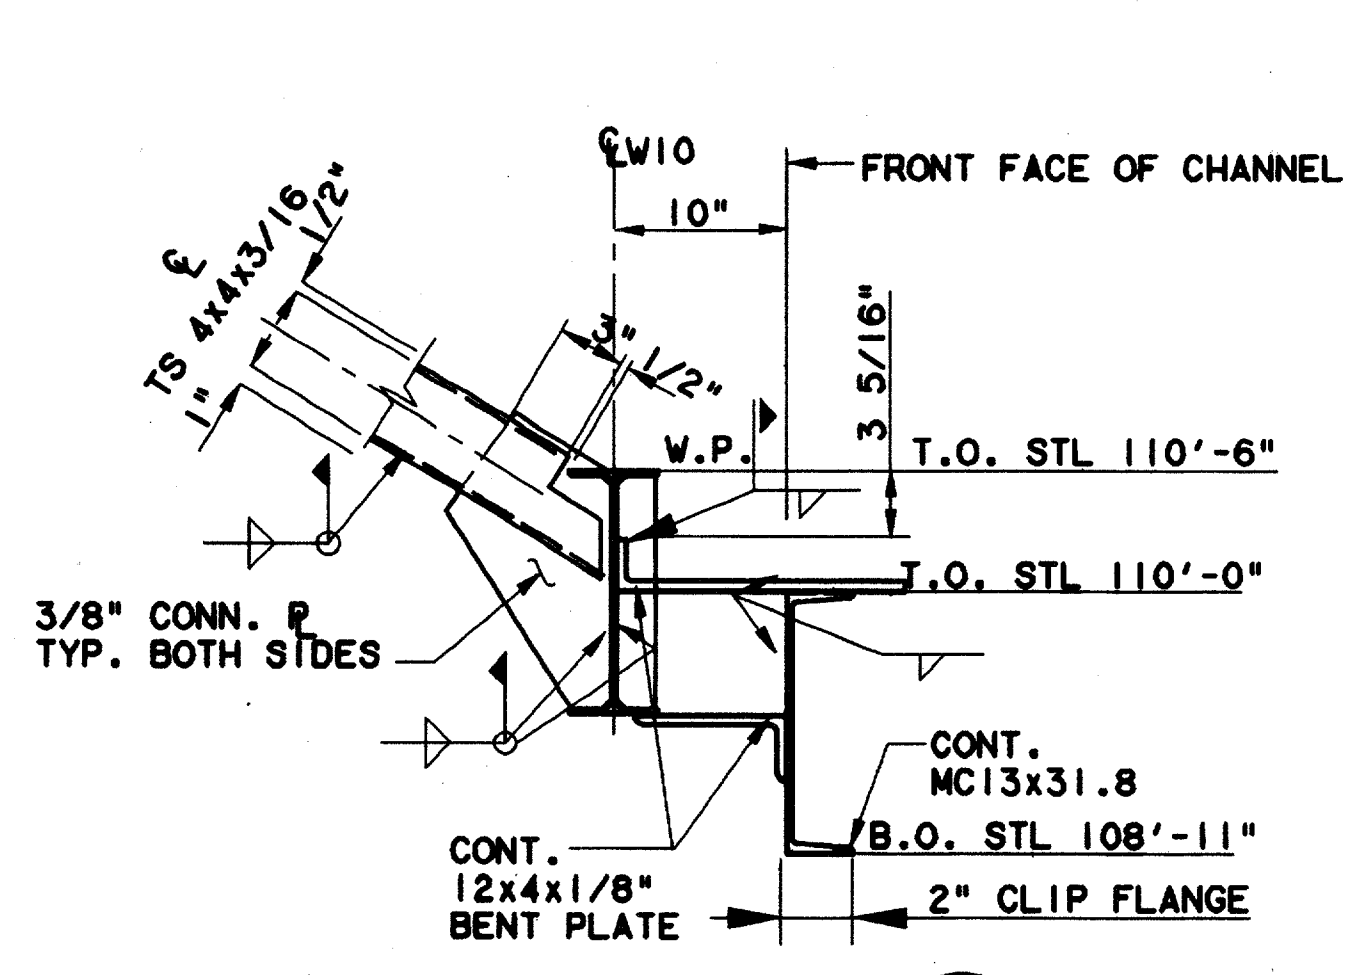


DETAIL 1  
SCALE: 1 1/2"=1'-0"  
SCI-0006

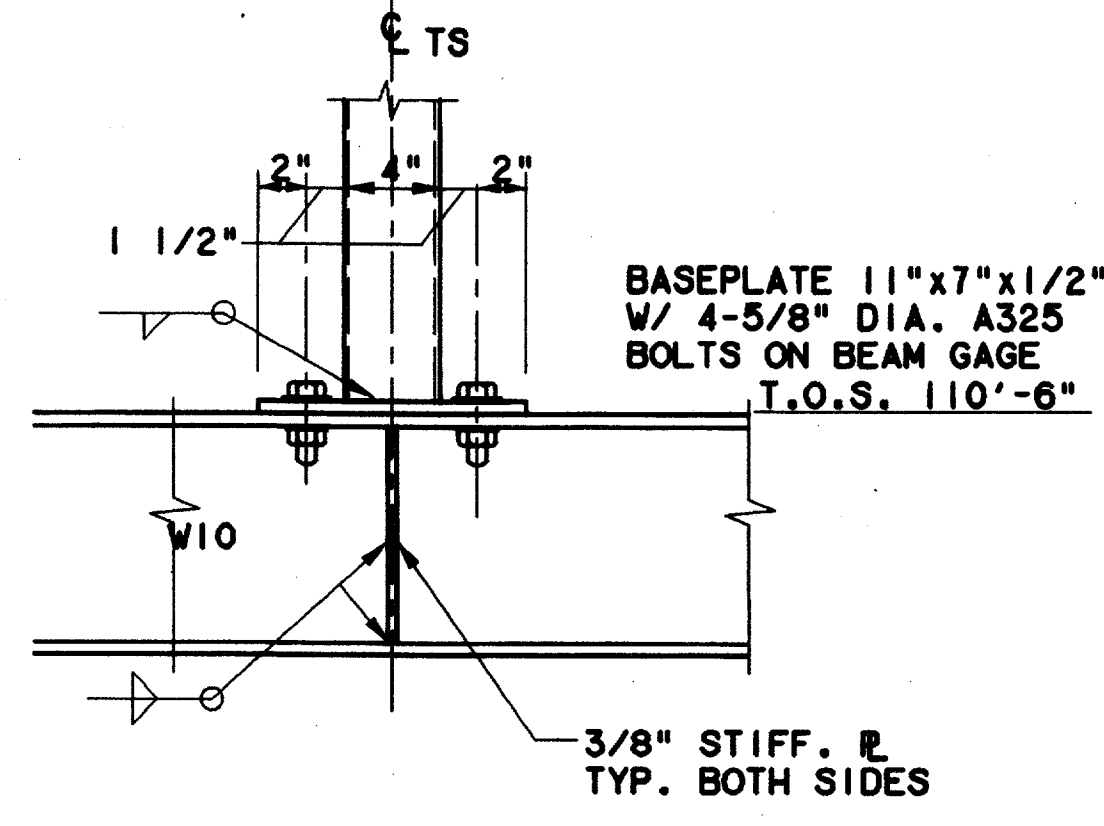



DETAIL 2  
SCALE: 1 1/2"=1'-0"  
SCI-0005

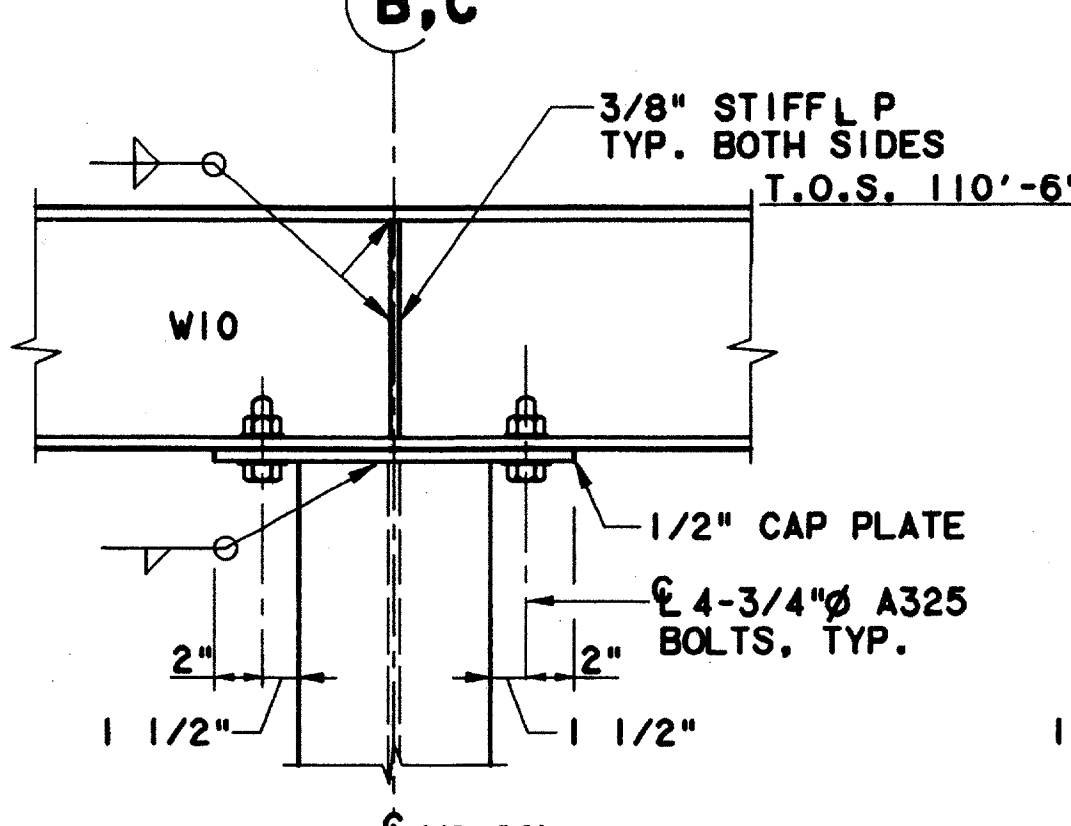


DETAIL 3  
SCALE: 1 1/2"=1'-0"  
SCI-0005

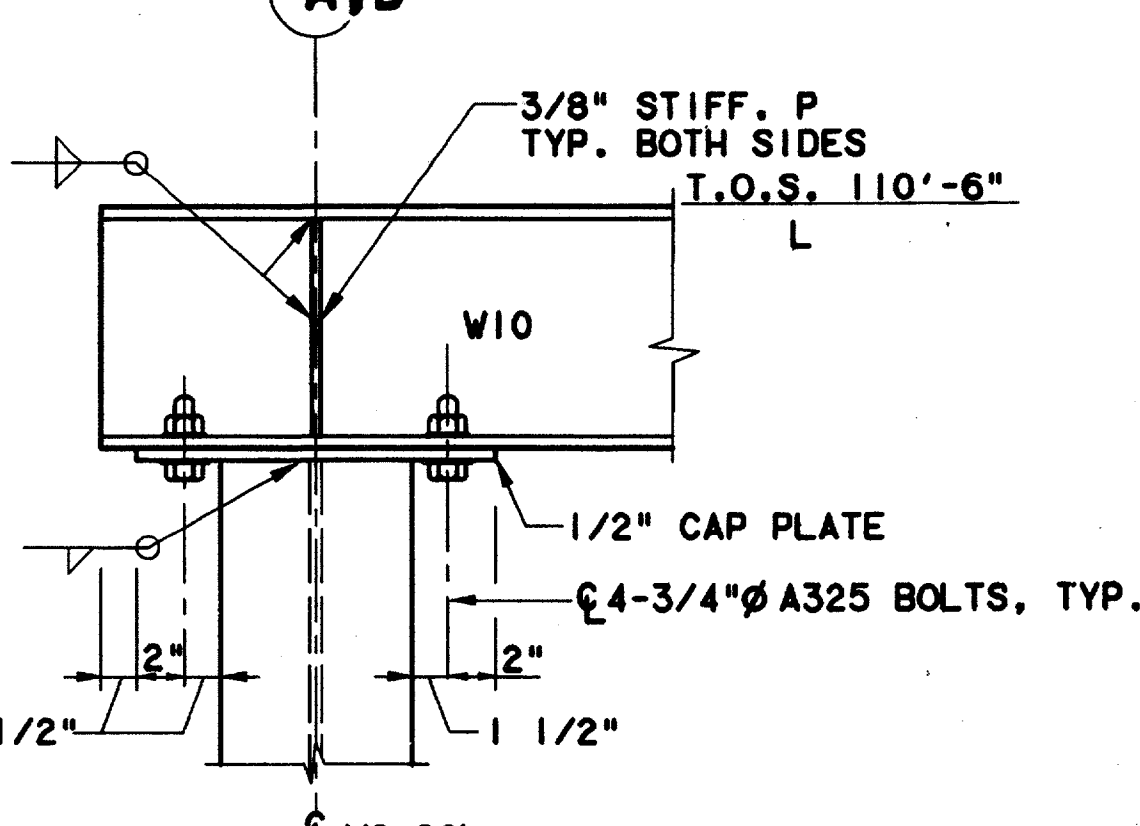


DETAIL 4  
SCALE: 1 1/2"=1'-0"  
SCI-0005

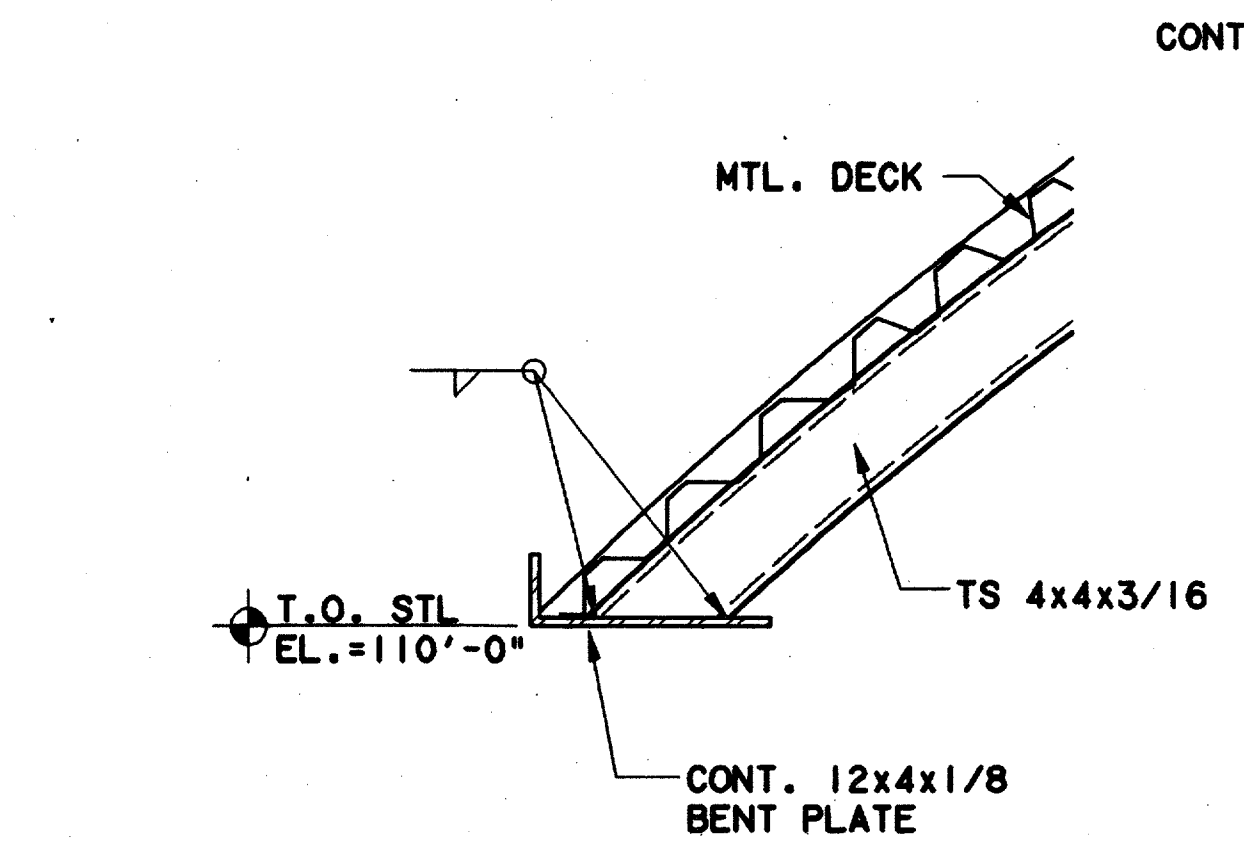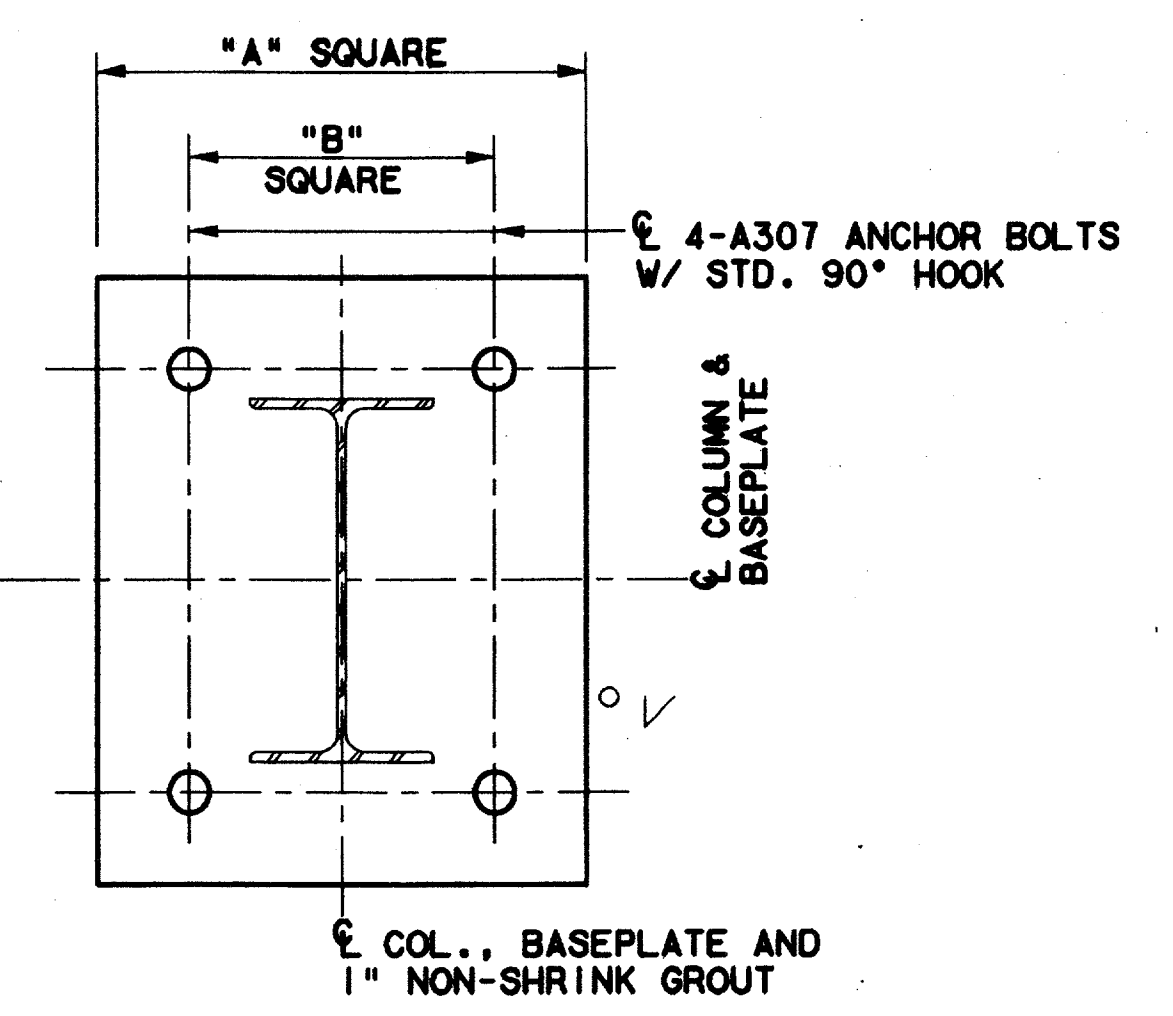


DETAIL 7  
SCALE: 1 1/2"=1'-0"  
SCI-0006

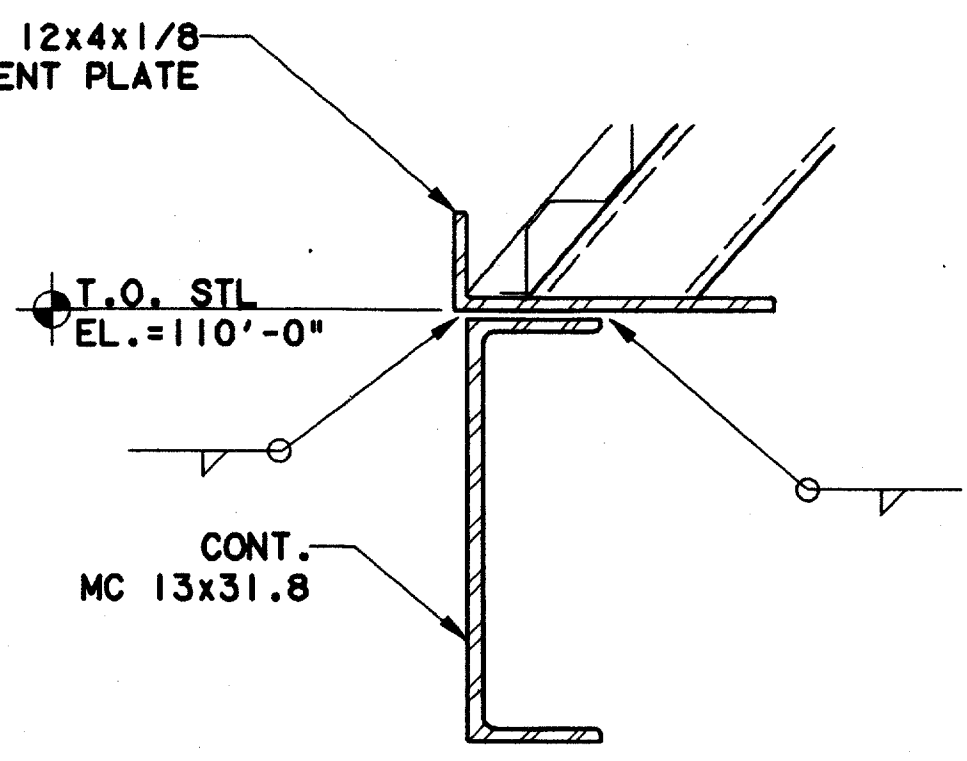



DETAIL 8  
SCALE: 1 1/2"=1'-0"  
SCI-0006

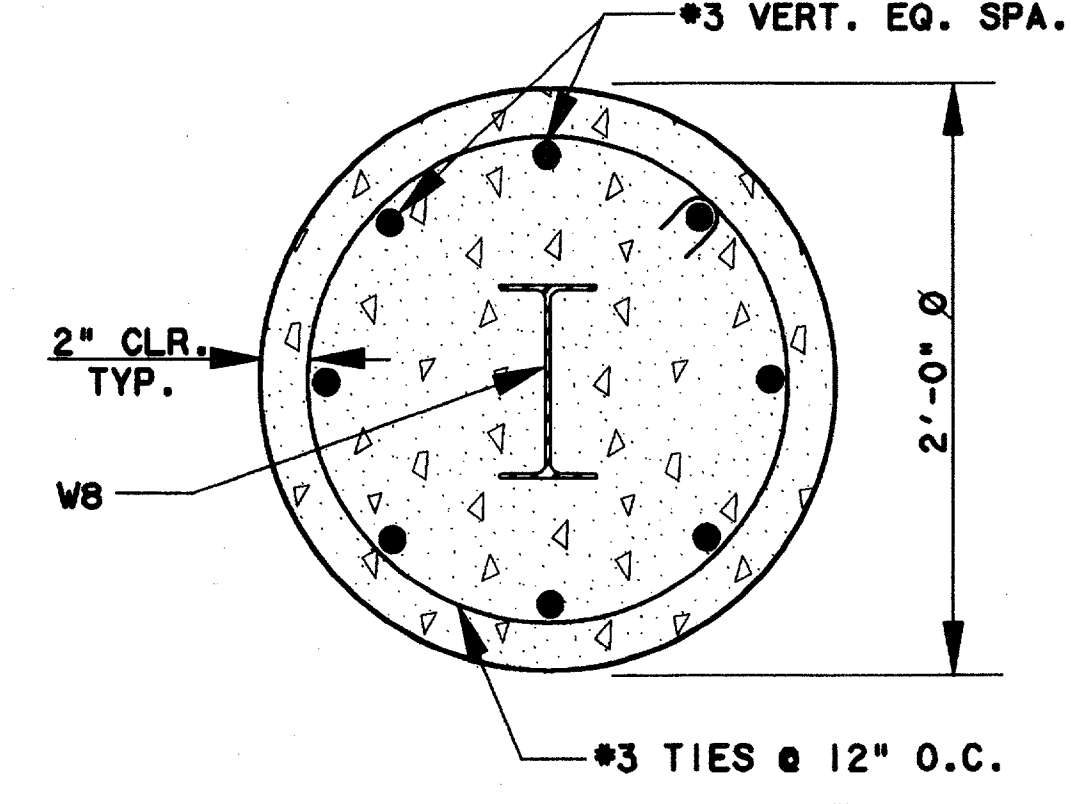

CIRC. SECTION 6A  
SECTION: 1 1/2"=1'-0"  
SCI-0005


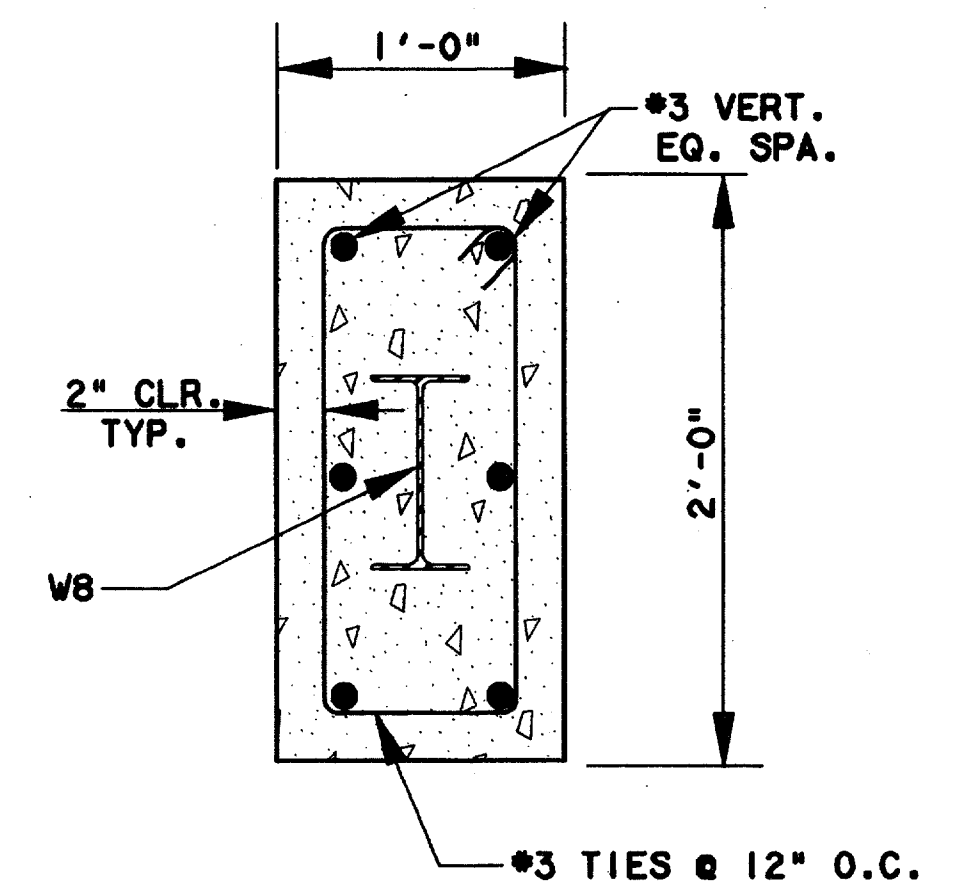


RECT. SECTION 6C  
SECTION: 1 1/2"=1'-0"  
SCI-0005

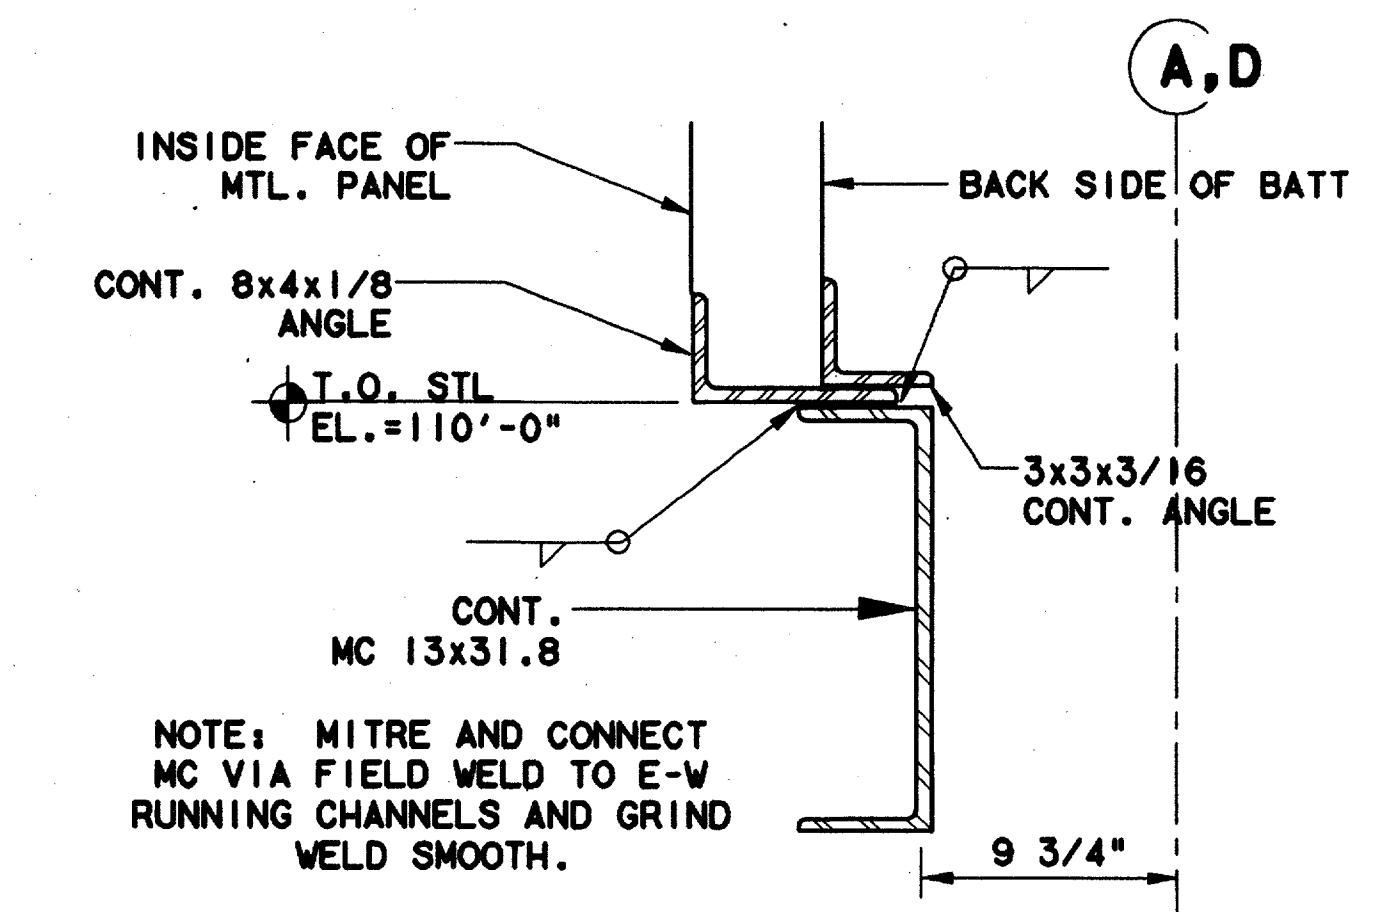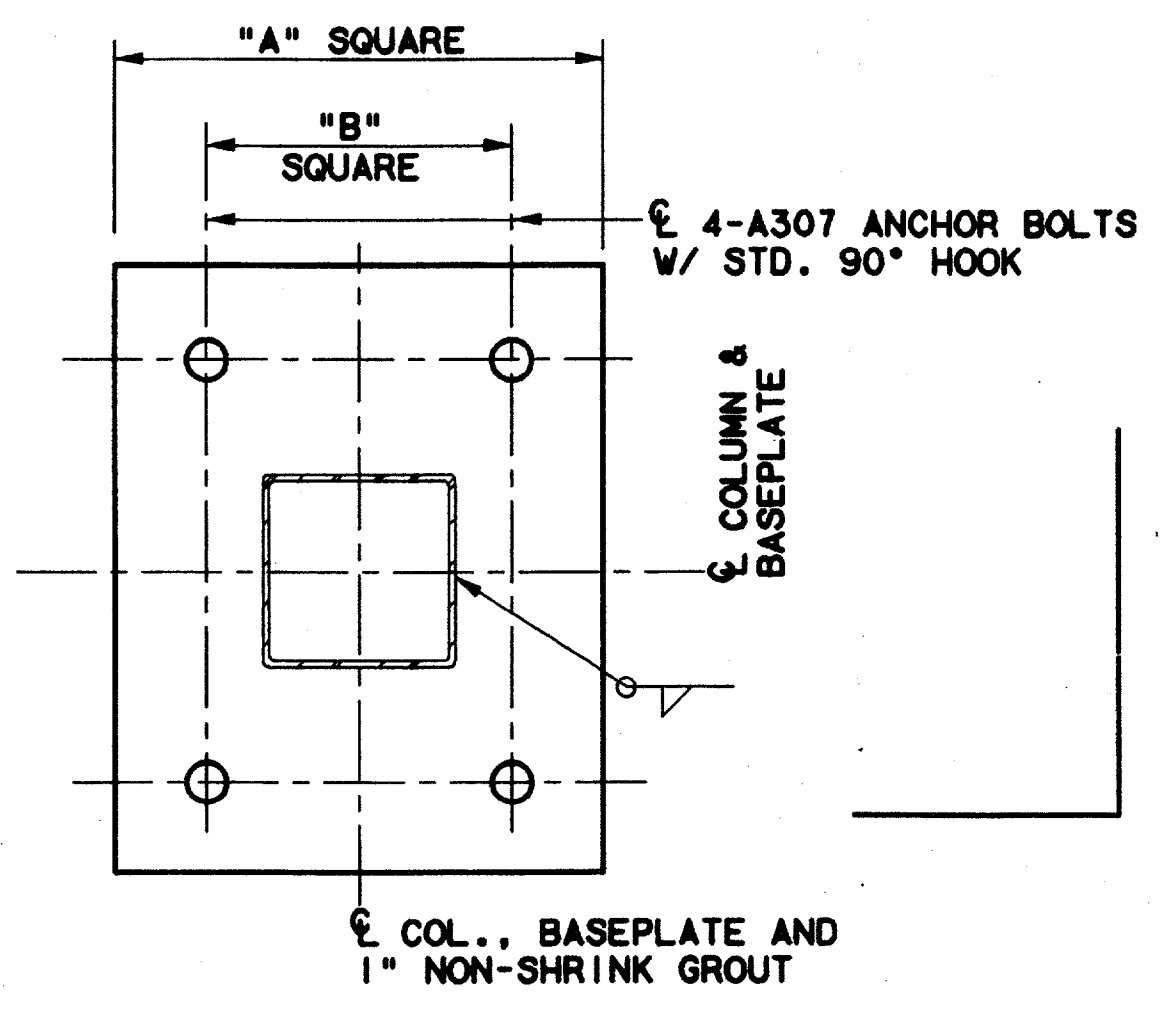


DETAIL 9  
SCALE: 1 1/2"=1'-0"  
SCI-0006

Record (As-Built) Certification  
"Having checked this submission, we certify that it conforms to the requirements of the contract in all respects, except as otherwise indicated."  
Contract Number: 97000135  
Company Name: WLA  
Title of Engineer: Tom Kader, PRESIDENT  
Date: \_\_\_\_\_  
Signature: \_\_\_\_\_  
Title of Professional Engineer of Construction Contractor, including signature and date, thereby sending record (as-built) drawings for accuracy of as-built conditions reflected herein, must be placed below.

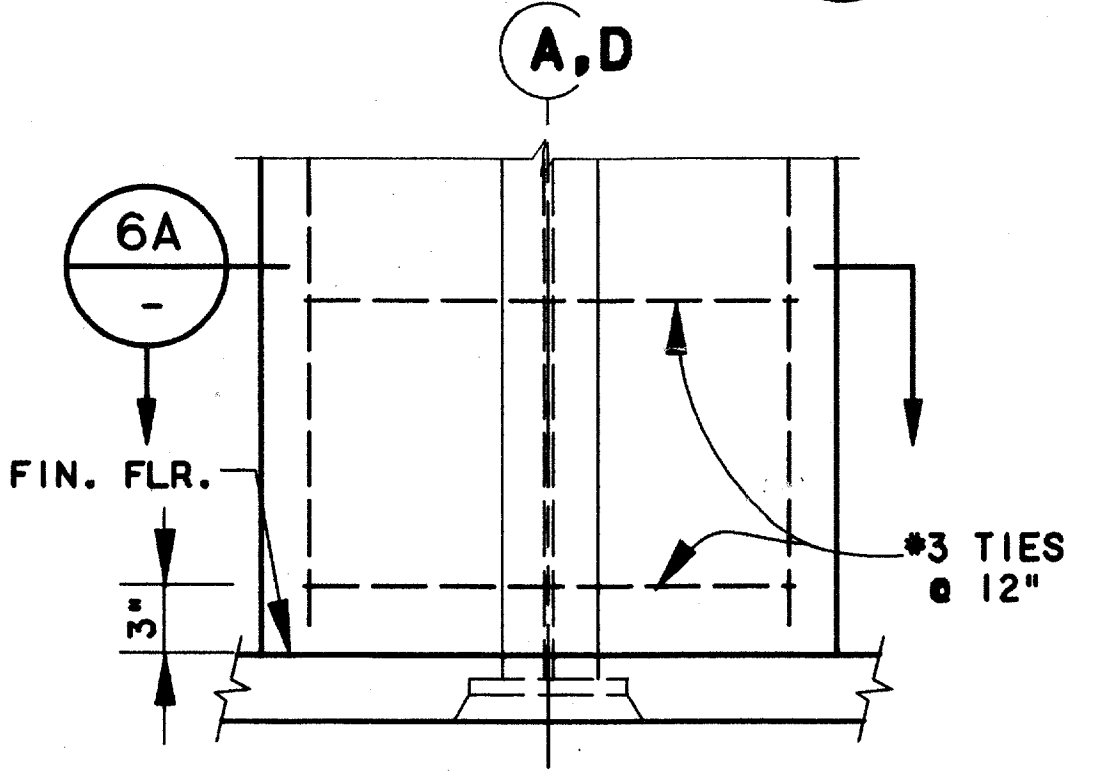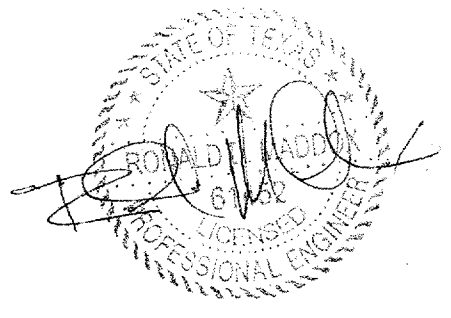

ELEVATION 6B  
SECTION: 1 1/2"=1'-0"  
SCI-0005

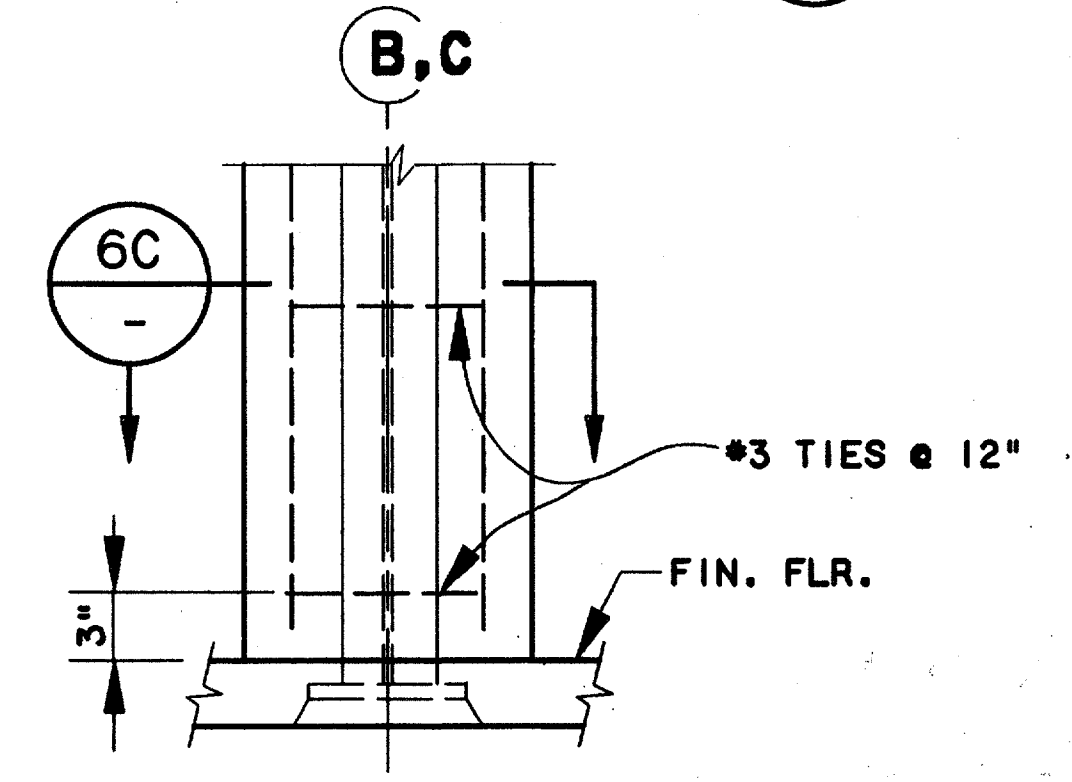





ELEVATION 6D  
SECTION: 1 1/2"=1'-0"  
SCI-0005

COL.	"A"	"B"	BOLT SIZE	BOLT PROJ. LENGTH	BOLT LENGTH
WB	1'-3"	11"	1"	3"	11"
TS5x5	1'-0"	8"	5/8"	3"	11"

DETAIL 5  
NTS  
SCI-0005 SCI-0003  
SCI-0008 SCI-0004

CONFORMED

REV	DATE	DESCRIPTION	BY	ENG	CHK	APP	REV	DATE	DESCRIPTION	BY	ENG	CHK	APP

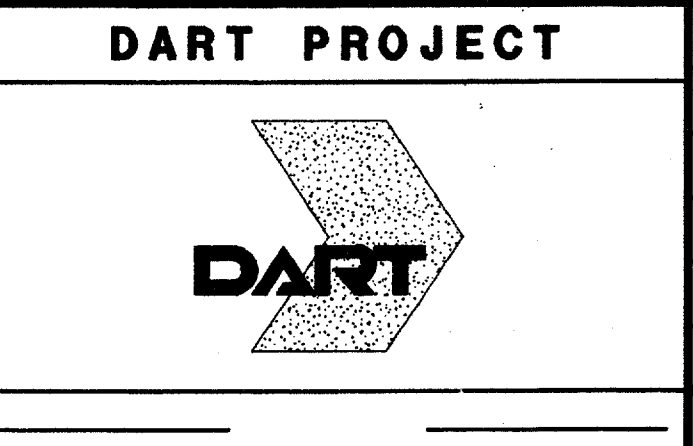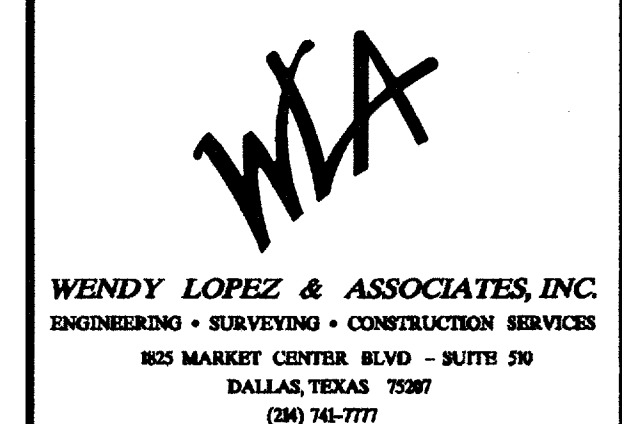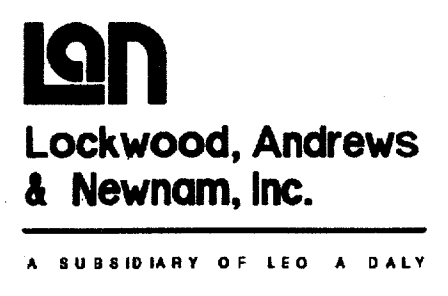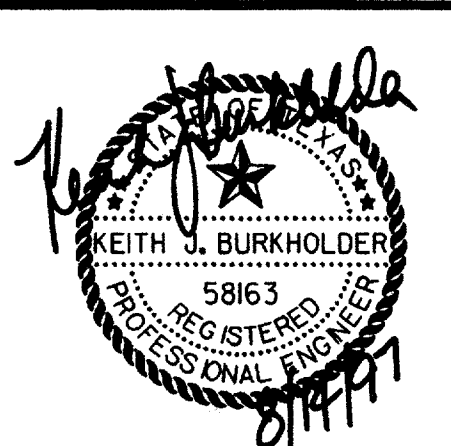

SCALE: 1/4" = 1'-0"	ADDISON TRANSIT CENTER ENCLOSURE STEEL DETAILS		
DRAWN: P.R. MASON			
DESIGNED: V. BAND			
CHECKED: K. BURKHOLDER			
IN CHARGE: V. STEVENS			
DATE: 14 AUGUST 97	CONTRACT C-97000135	DWG No. SCI-0007	REV 0
CAES			