


LEGEND:
 Horizontal Curve Number
 Inlet Designation
 Existing Light Pole
 Existing Power/Telephone Pole
 Existing Tree
 Existing Fence
 Existing Building
 Storm Sewer Manhole

NOTES:
 1. See Sheet A23 for N.B. Dallas Pkwy Profile
 2. " " R25 for S.B. Dallas Pkwy Profile
 3. " " R27 for Ramp SPV-N Profile
 4. " " R27 for Ramp I-SPV Profile
 5. " " R4 for Additional Horizontal Geometrics
 6. " " R43 for Storm Sewer Plan
 7. " " R30 for Ramp SPV-N Details & Noise Sta.
 8. " " R31 for Ramp N-SPV Details & Noise Sta.
 9. " " R10 for Retaining Wall
 10. " " R78 for Typical Roadway Sections
 11. See Volume 2 Plans for Retaining Wall Details

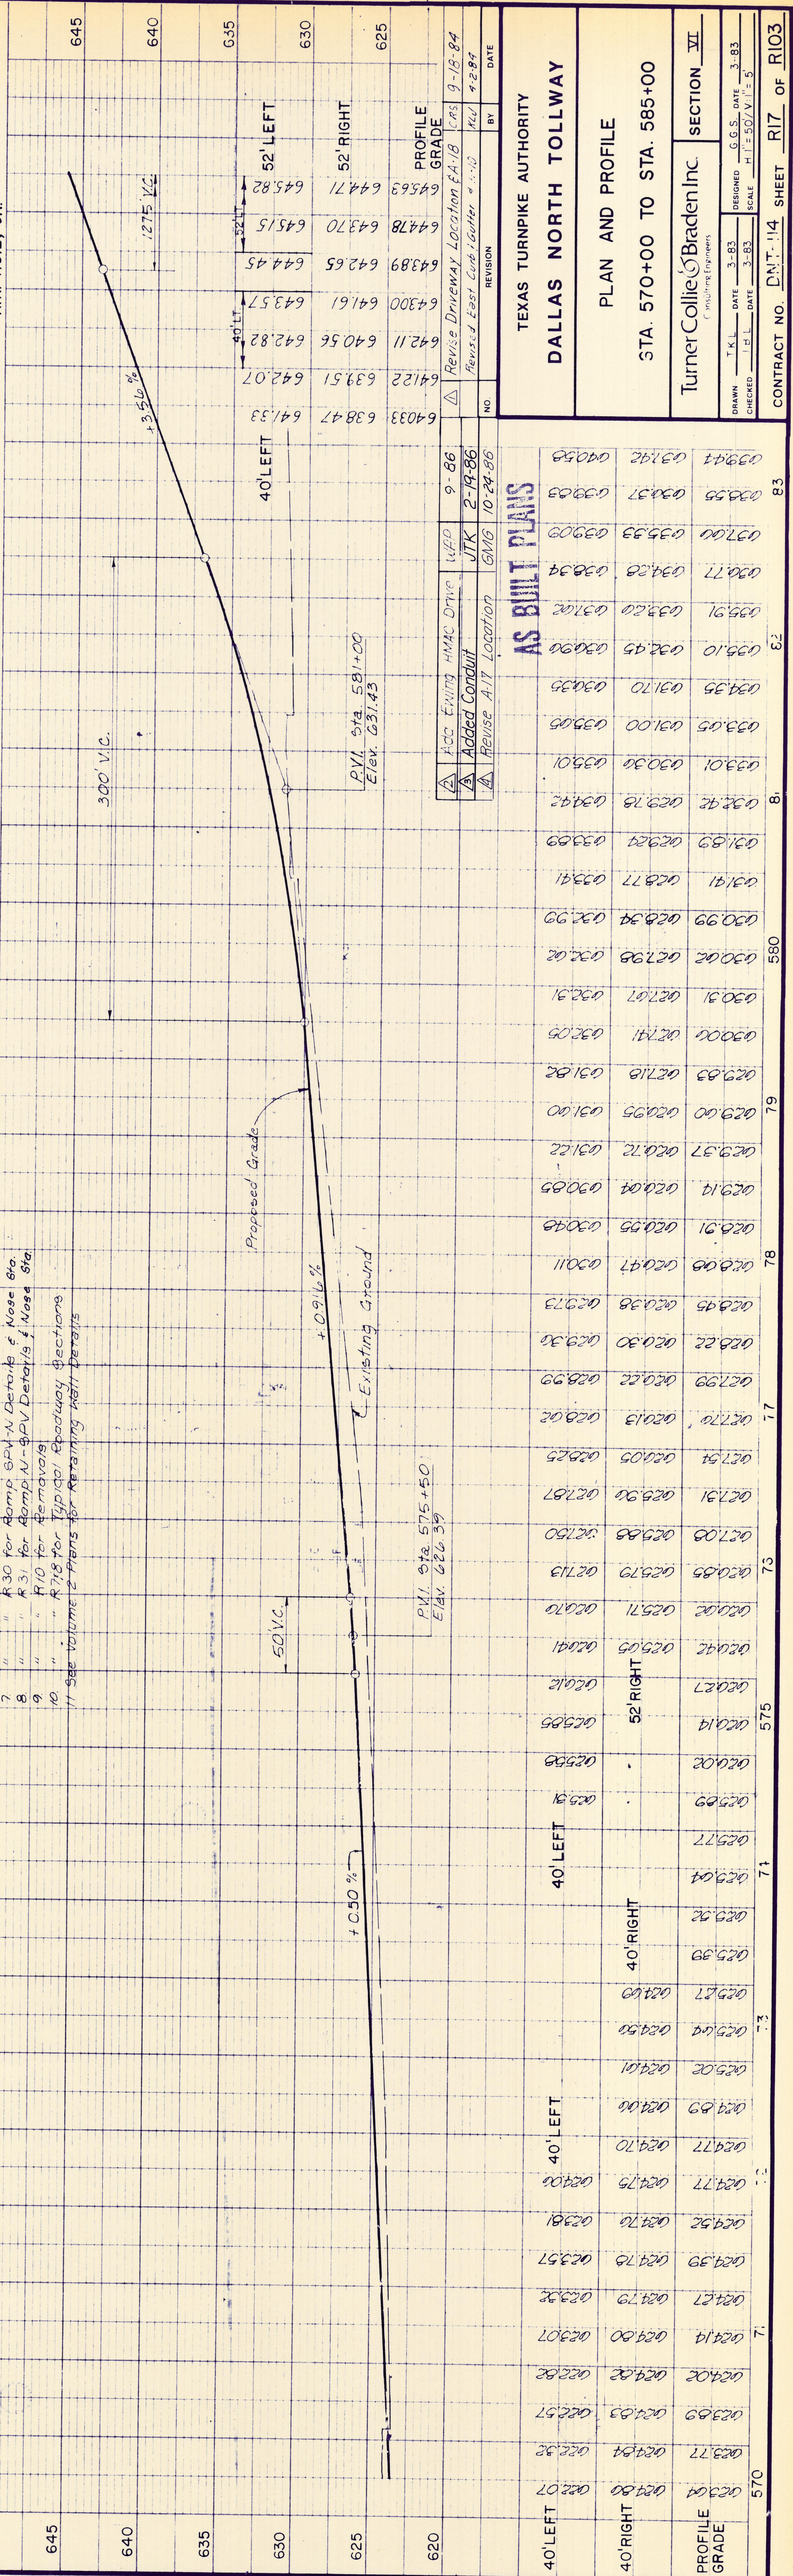

NO.	REVISION	DATE	BY
64033	63847	64133	64033
64211	64056	64282	64211
64300	64161	64357	64300
64389	64265	64445	64389
64478	64370	64515	64478
64563	64471	64582	64563

DATE	BY	NO.
9-18-84	REVISED	DRIVEWAY LOCATION E.A.B.
9-18-84	REVISED	EAST CURB LOCATION #1-10
9-28-87	REVISED	REVISED

PROFILE GRADE	STATION	PROFILE GRADE	STATION
645	570	645	570
645	571	645	571
645	572	645	572
645	573	645	573
645	574	645	574
645	575	645	575
645	576	645	576
645	577	645	577
645	578	645	578
645	579	645	579
645	580	645	580
645	581	645	581
645	582	645	582
645	583	645	583
645	584	645	584
645	585	645	585

AS BUILT PLANS

DATE	NO.	DESCRIPTION
9-86	9-86	ADD EXISTING H/MAC DRIVE
2-19-86	JTK	ADDED CONDUIT
10-24-86	GMG	REVISED A-17 LOCATION