


- (RI) Horizontal Curve Number
- ATI Inlet Designation
- Existing Light Pole
- Existing Power/Telephone Pole
- Existing Tree
- Existing Fence
- Existing Building
- Storm Sewer Manhole

NOTES

- 1 See Sheet
- 2 " " " "
- 3 " " " "
- 4 " " " "
- 5 " " " "
- 6 " " " "
- 7 " " " "
- 8 See Volume 2 Plans for Approach Slab details
- 9 See Volume 2 Plans for Approach Slab details
- 10 See Volume 2 Plans for Approach Slab details
- 11 See Sheet
- 12 " " " "
- 13 " " " "
- 14 Retaining Walls 109 & 110 To Be Constructed By Others
- 15 See Volume 2 Plans for Retaining Wall Details
- 16 See Sheet

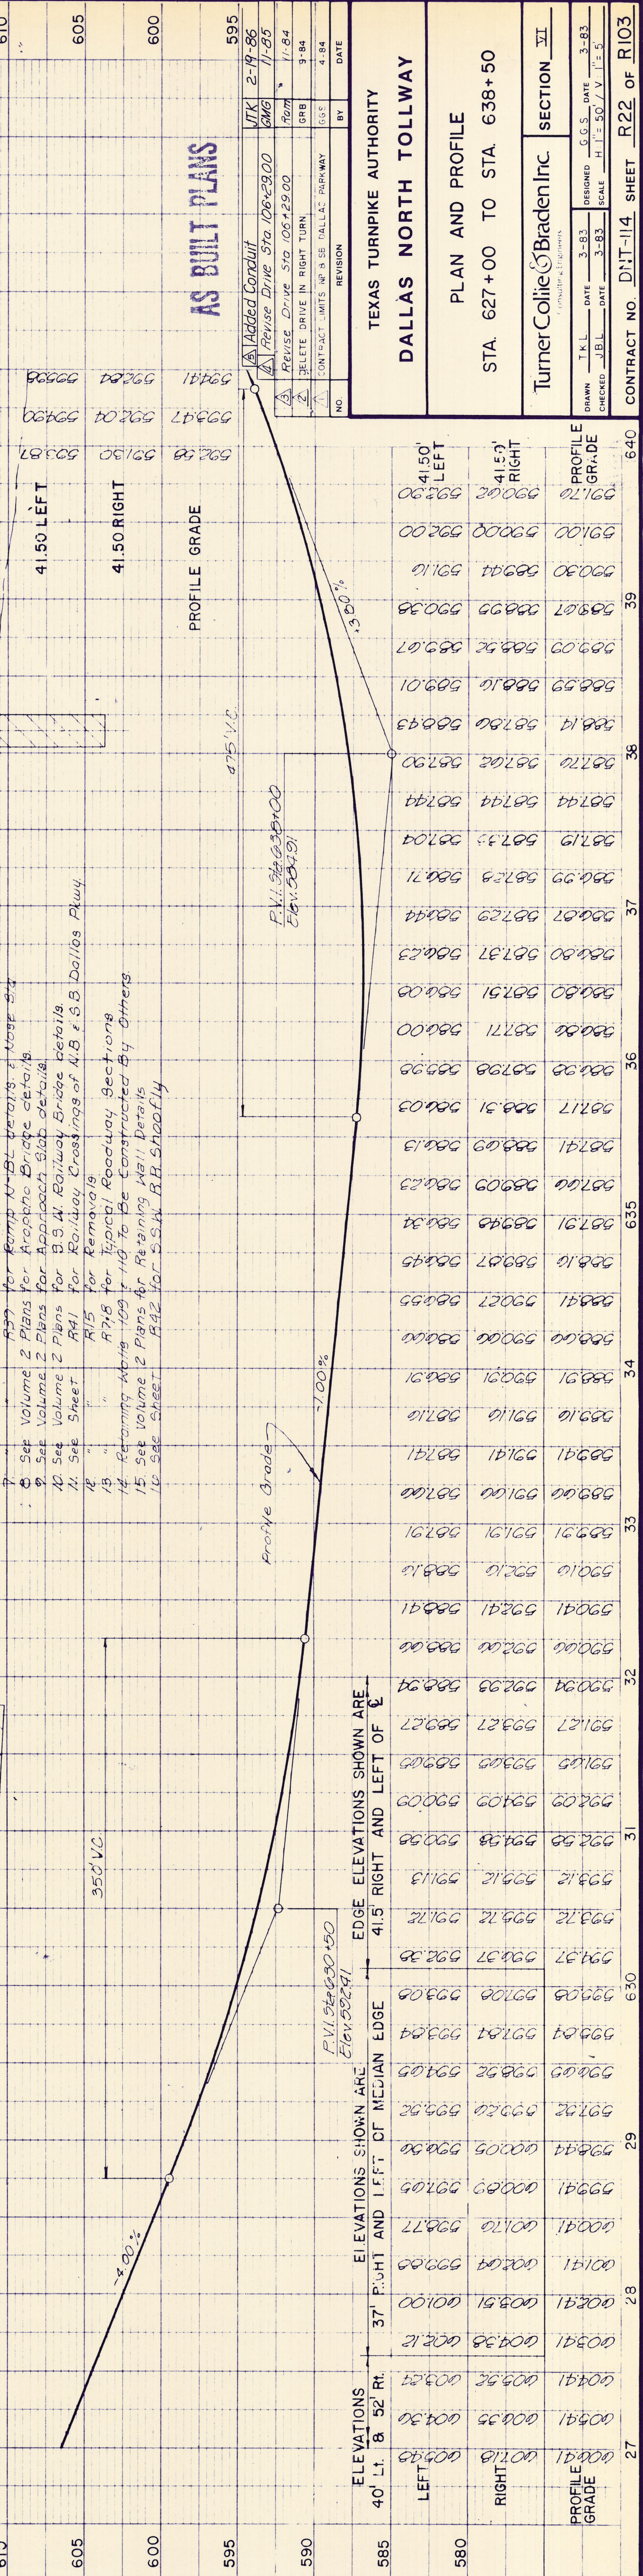

JK	2-19-86
CMG	11-85
SRB	11-84
SRB	3-84
SRB	4-84

NO.	REVISION	BY	DATE
1	Added Conduit		
2	Revise Drive Sta 106+29.00		
3	Revise Drive Sta 106+29.00		
4	DELETE DRIVE IN RIGHT TURN		
5	CONTRACT LIMITS IN S.B. DALLAS PARKWAY		

ELEVATIONS	ELEVATIONS SHOWN ARE		EDGE ELEVATIONS SHOWN ARE
	40' LT. & 52' RT.	37' RIGHT AND LEFT OF MEDIAN EDGE	
615	594.41	594.41	594.41
610	593.87	593.87	593.87
605	593.33	593.33	593.33
600	592.79	592.79	592.79
595	592.25	592.25	592.25
590	591.71	591.71	591.71
585	591.17	591.17	591.17
580	590.63	590.63	590.63
640	590.09	590.09	590.09