

S.B. Dallas Pkwy. @ Sta. 671+08.17
 @ Belt Line Rd. Elev. 632.42


PVI Sta. 671+52.31
 Elev. 632.14

44' Rt. @ Sta. 671+74.77



PVI Sta. 671+52.31
 Elev. 632.14

55' Rt. @ Sta. 671+52.31
 Elev. 632.14

Pavement Width Varies
 55' Rt. @ Sta. 671+52.31
 TO
 44' Rt. @ Sta. 671+74.77

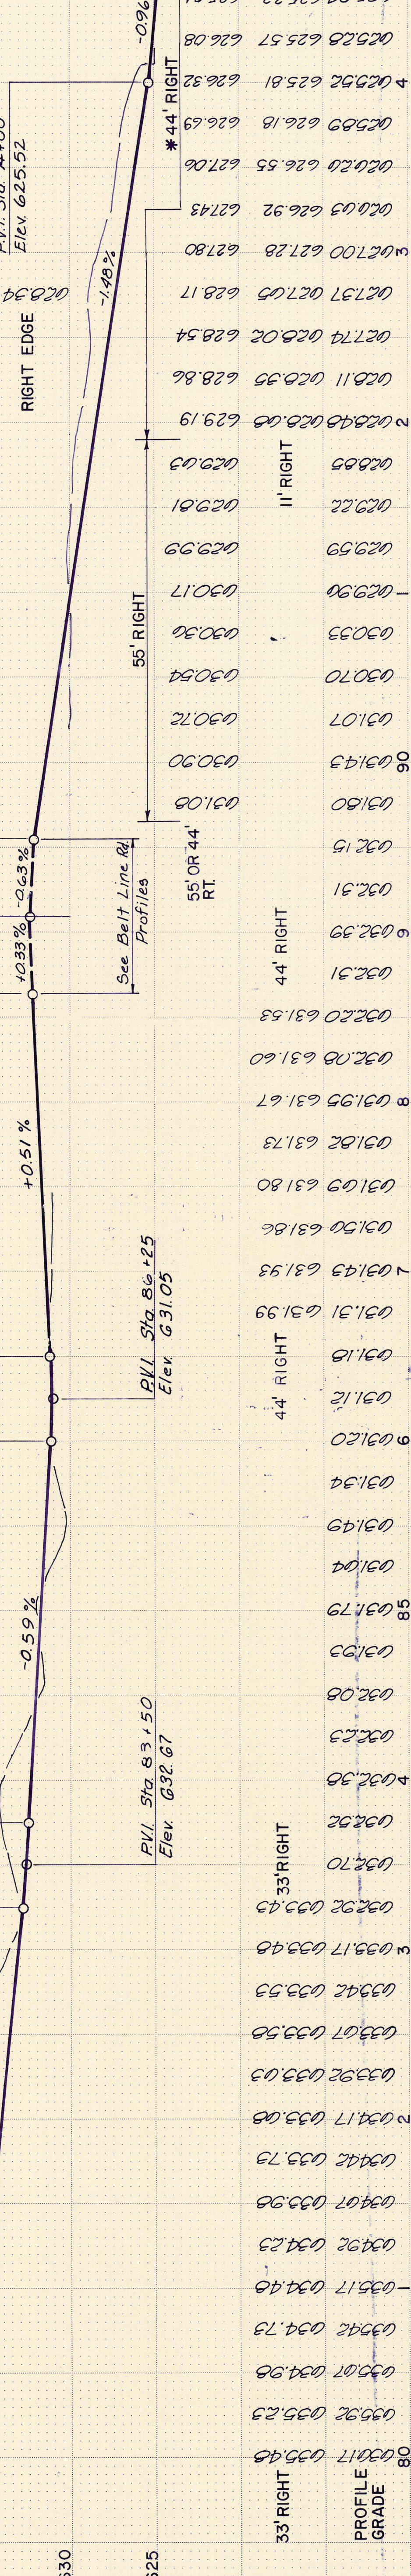

* Extend Pavement Cross Slope of +3/16" / FT.
 From Elevations Shown At 44' Right to Right
 Edge Of Proposed Southbound Dallas Parkway.

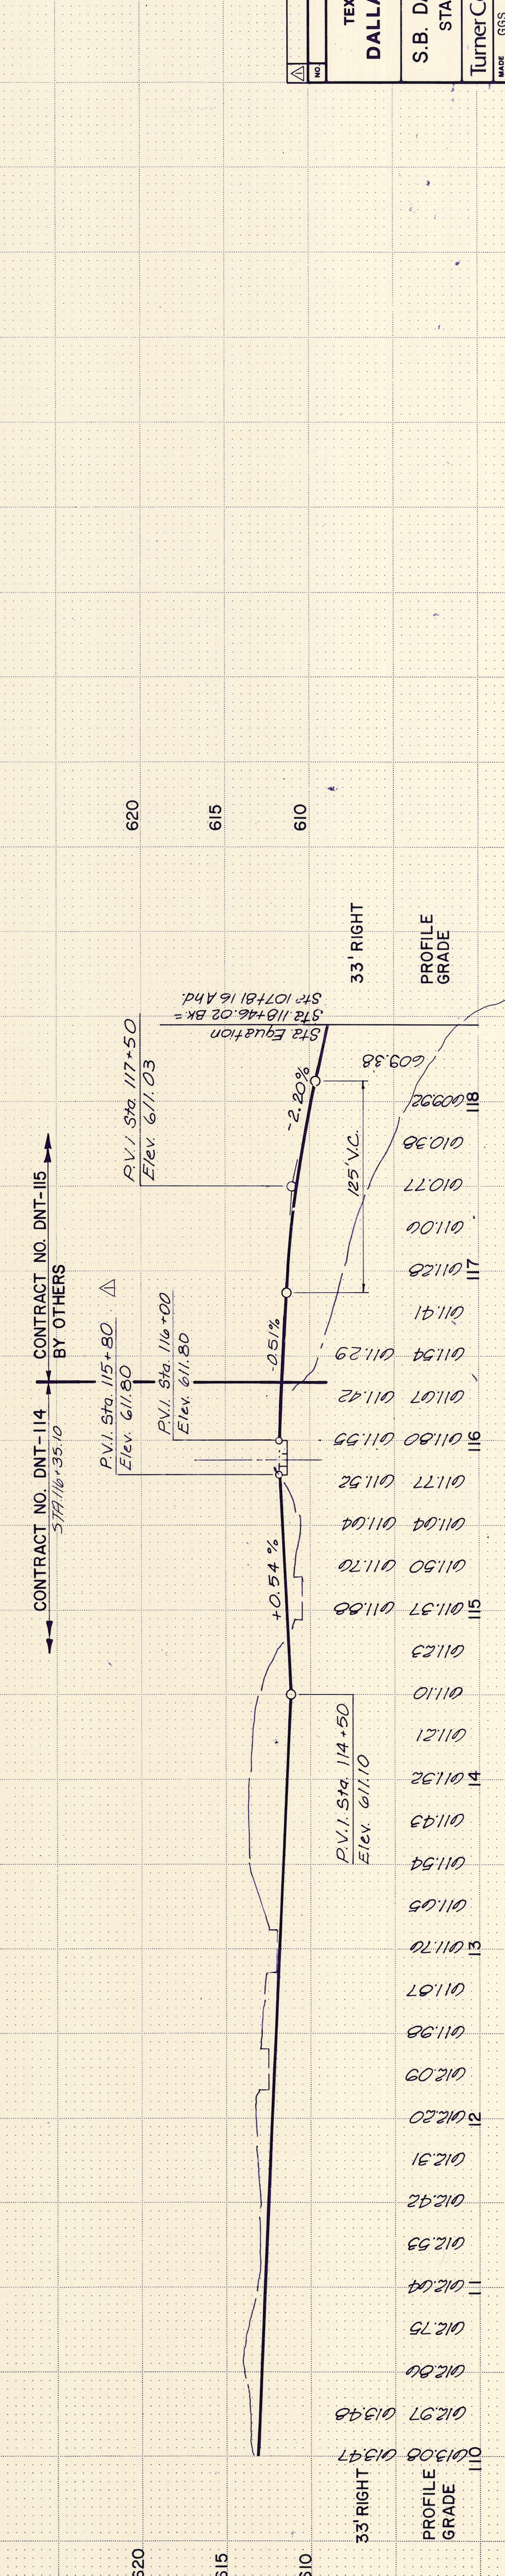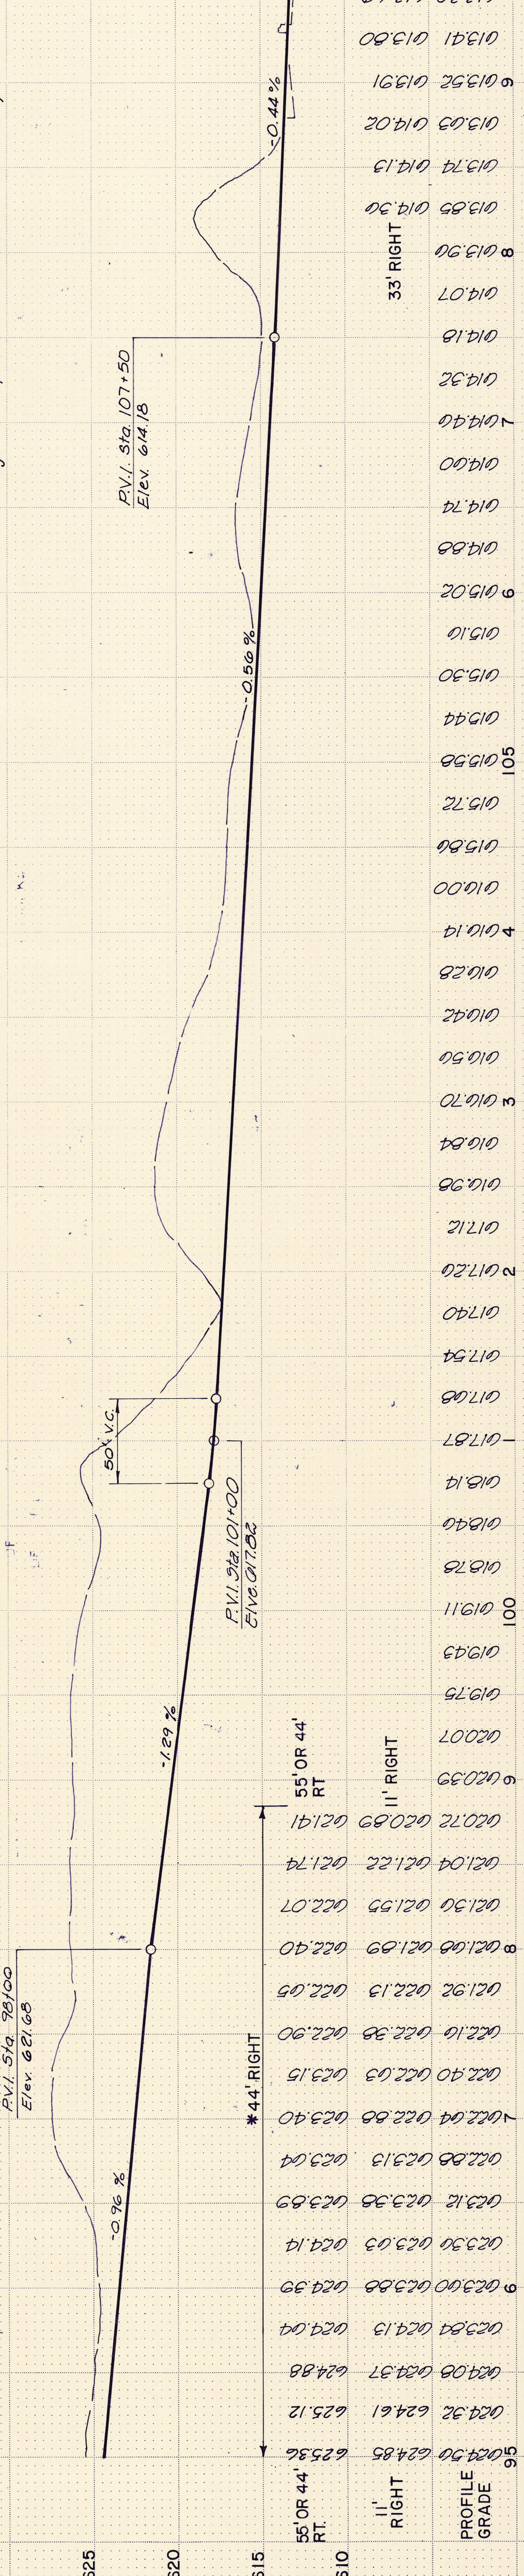

NO.	REVISION	DATE

CONTRACT LIMITS: 4-84

TEXAS TURNPIKE AUTHORITY
DALLAS NORTH TOLLWAY

S.B. DALLAS PKWY. PROFILE
 STA. 80+00 TO STA. 116+25

TurnerCollie/Braden Inc. SECTION VII

DATE: 2-83
 CHECKED: JBL
 SCALE: H₁" = 50'
 H₂" = 5'

CONTRACT NO. DNT-114 SHEET R26 OF R103

AS BUILT PLANS