
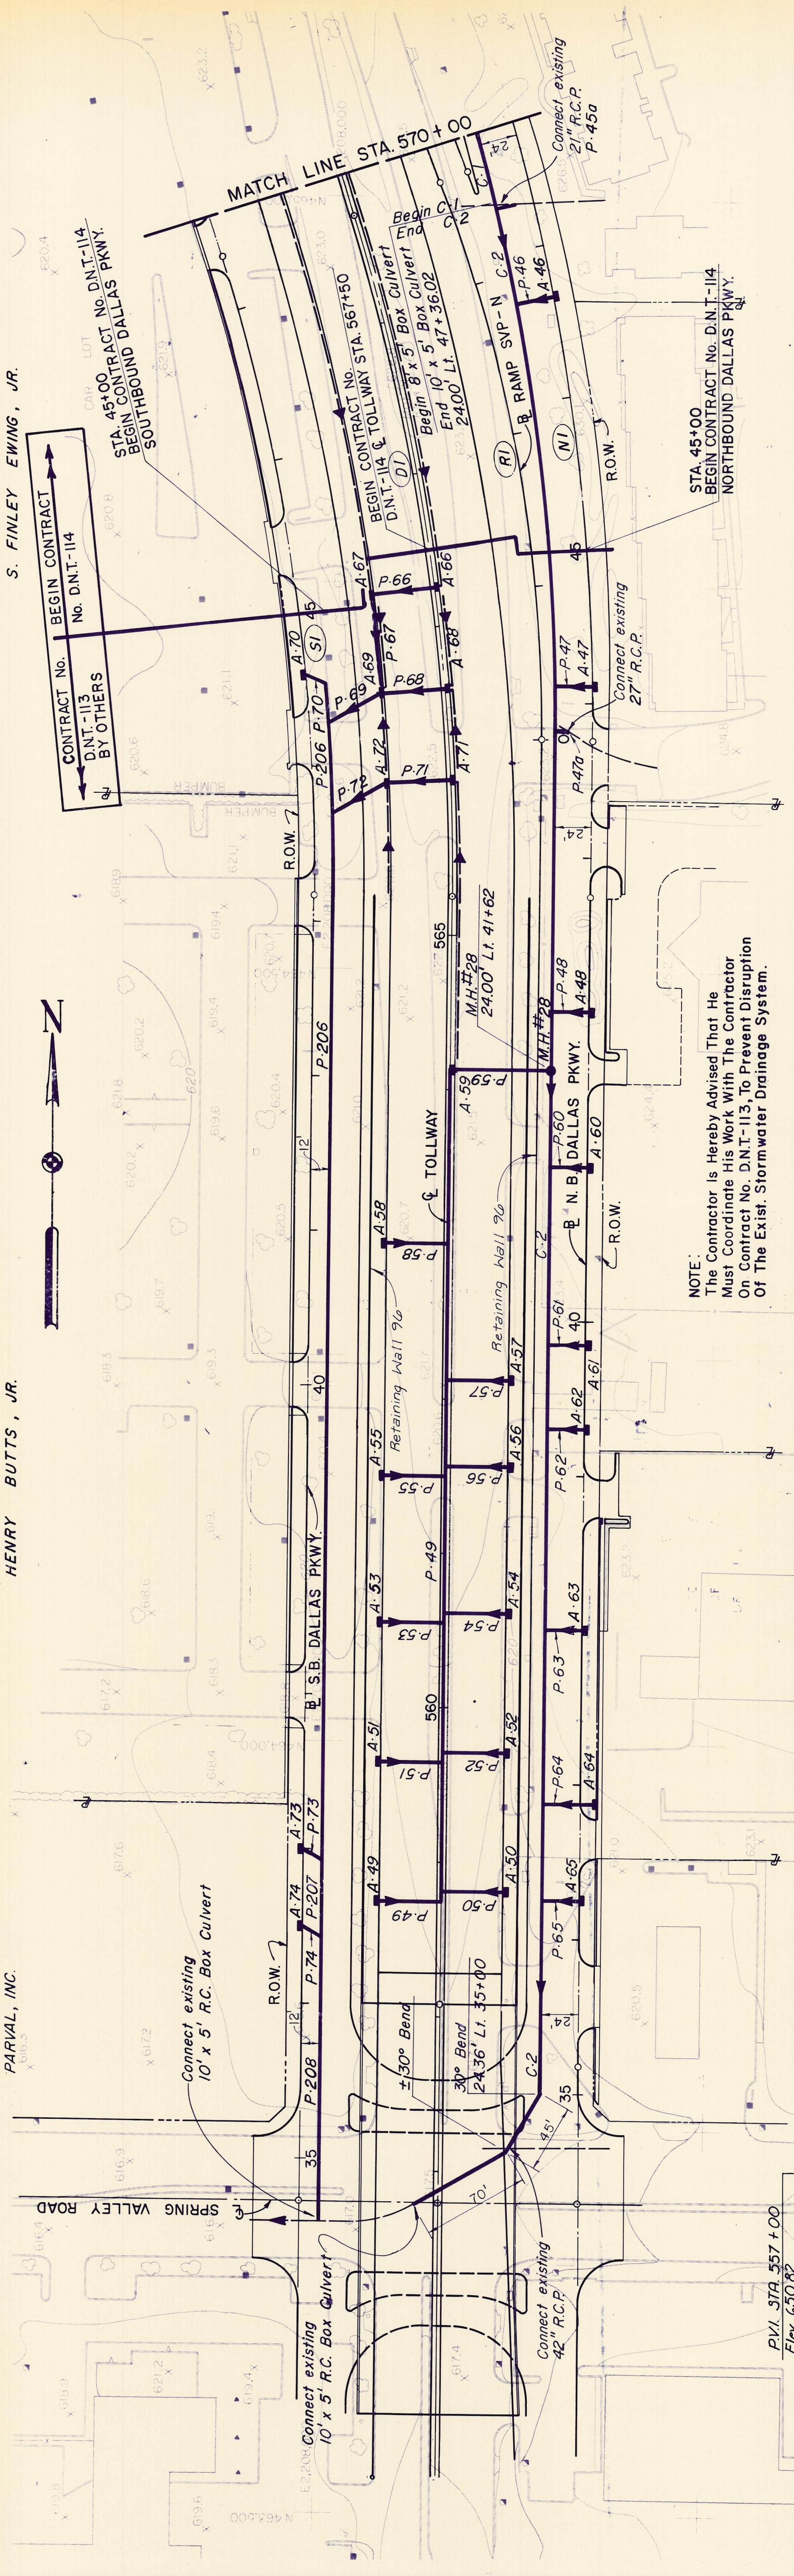



PARVAL, INC.

HENRY BUTTS, JR.

S. FINLEY EWING, JR.

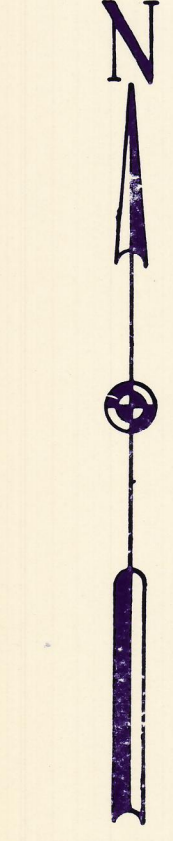

NOTE:
The Contractor is Hereby Advised That He
Must Coordinate His Work With The Contractor
On Contract No. D.N.T.-113, To Prevent Disruption
Of The Exist. Stormwater Drainage System.

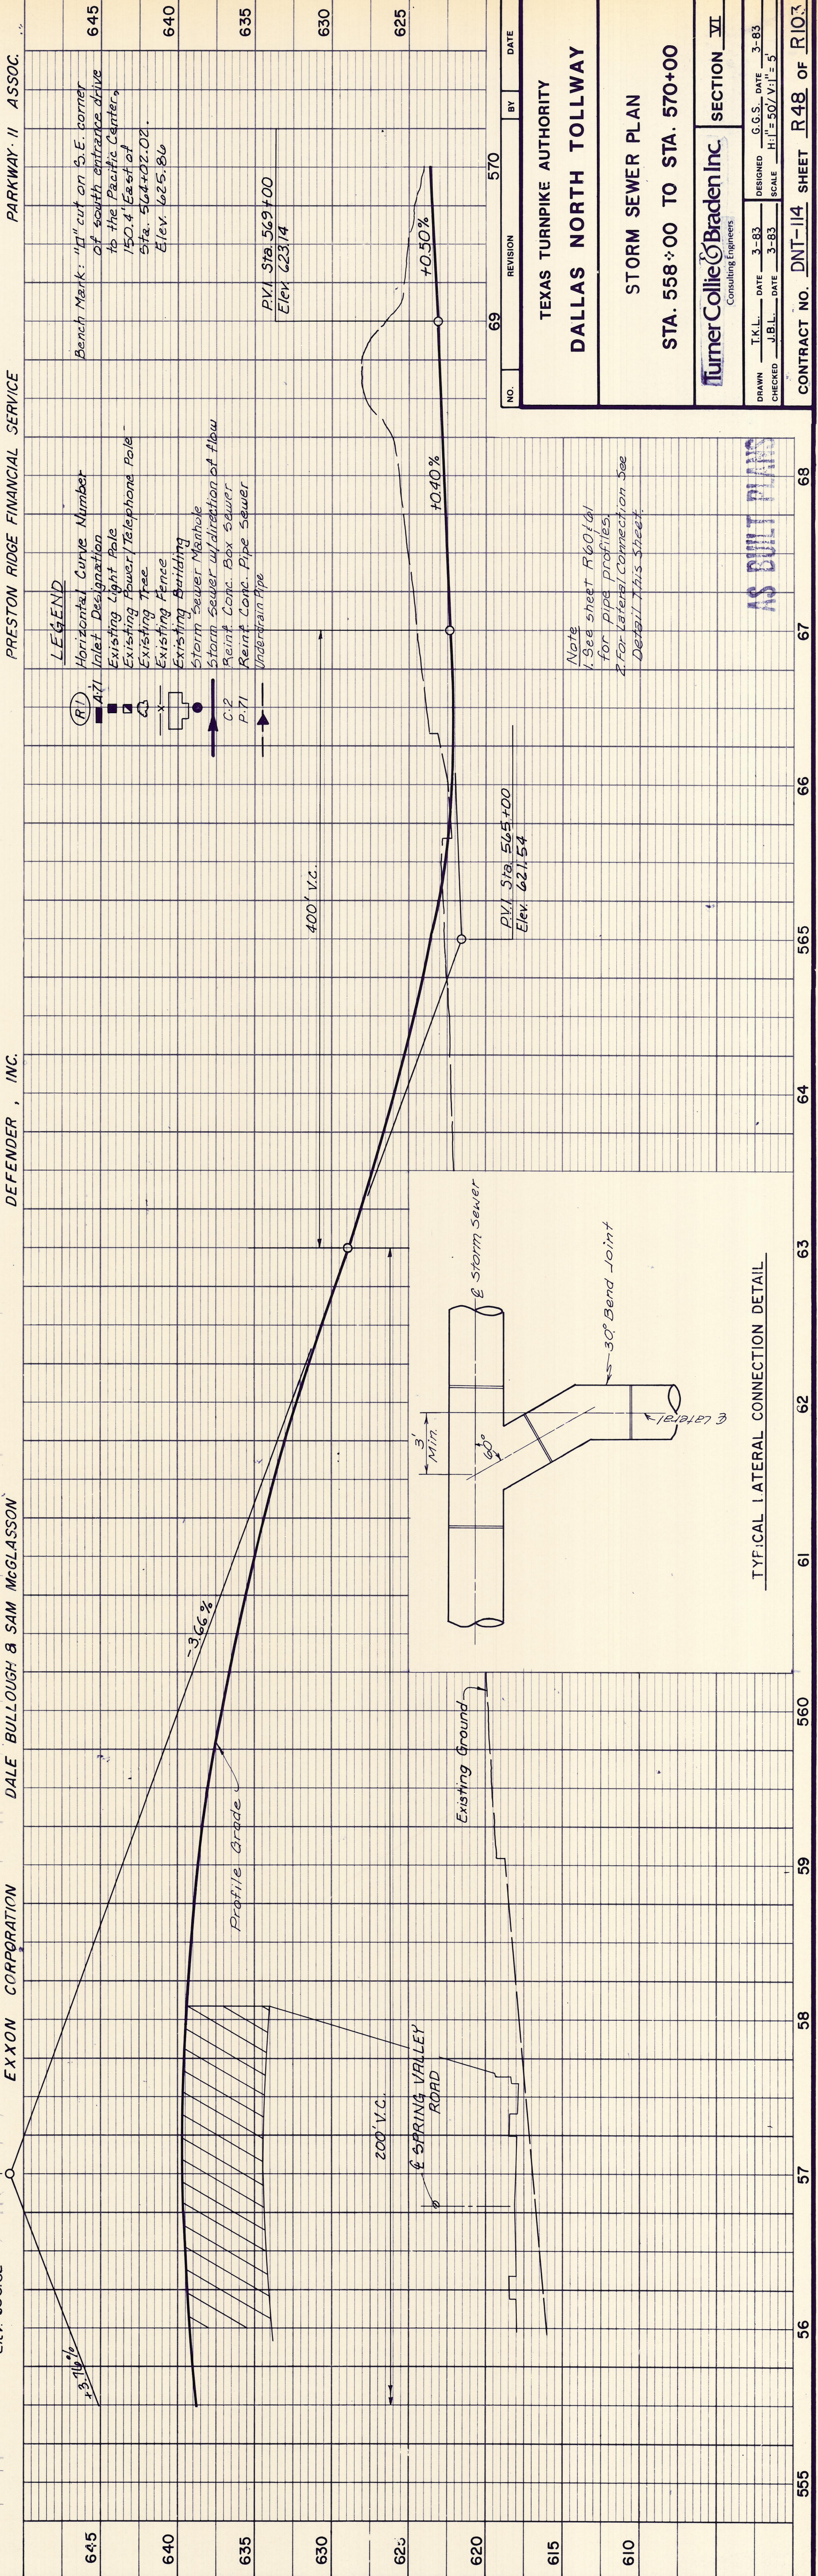

DALE BULLOUGH & SAM MCGLOSSON
DEFENDER, INC.

PRESTON RIDGE FINANCIAL SERVICE
PARKWAY II ASSOC.

NO.	REVISION	BY	DATE
645			
640			
635			
630			
625			

NO.	REVISION	BY	DATE
645			
640			
635			
630			
625			

NO.	REVISION	BY	DATE
645			
640			
635			
630			
625			
620			
615			
610			

TYF:CAL LATERAL CONNECTION DETAIL

TEXAS TURNPIKE AUTHORITY
DALLAS NORTH TOLLWAY

STORM SEWER PLAN

STA. 558+00 TO STA. 570+00

TurnerCollie & Braden Inc.
Consulting Engineers

SECTION VII

CONTRACT NO. DNT-114 SHEET R4B OF R103

AS BUILT PLANS

TYF:CAL LATERAL CONNECTION DETAIL

CONTRACT NO. DNT-114 SHEET R4B OF R103