



HOTEL INVESTORS TRUST

FIRST TEXAS SAVINGS ASSOC.

PLAZA AT THE QUORUM ASSOC.

LEGEND

- (R1) Horizontal Curve Number
- (A71) Inlet Designation
- Existing Light Pole
- Existing Power/Telephone Pole
- Existing Fence
- Existing Building
- Storm Sewer Manhole
- Reinf. Conc. Box Sewer
- Underdrain Pipe

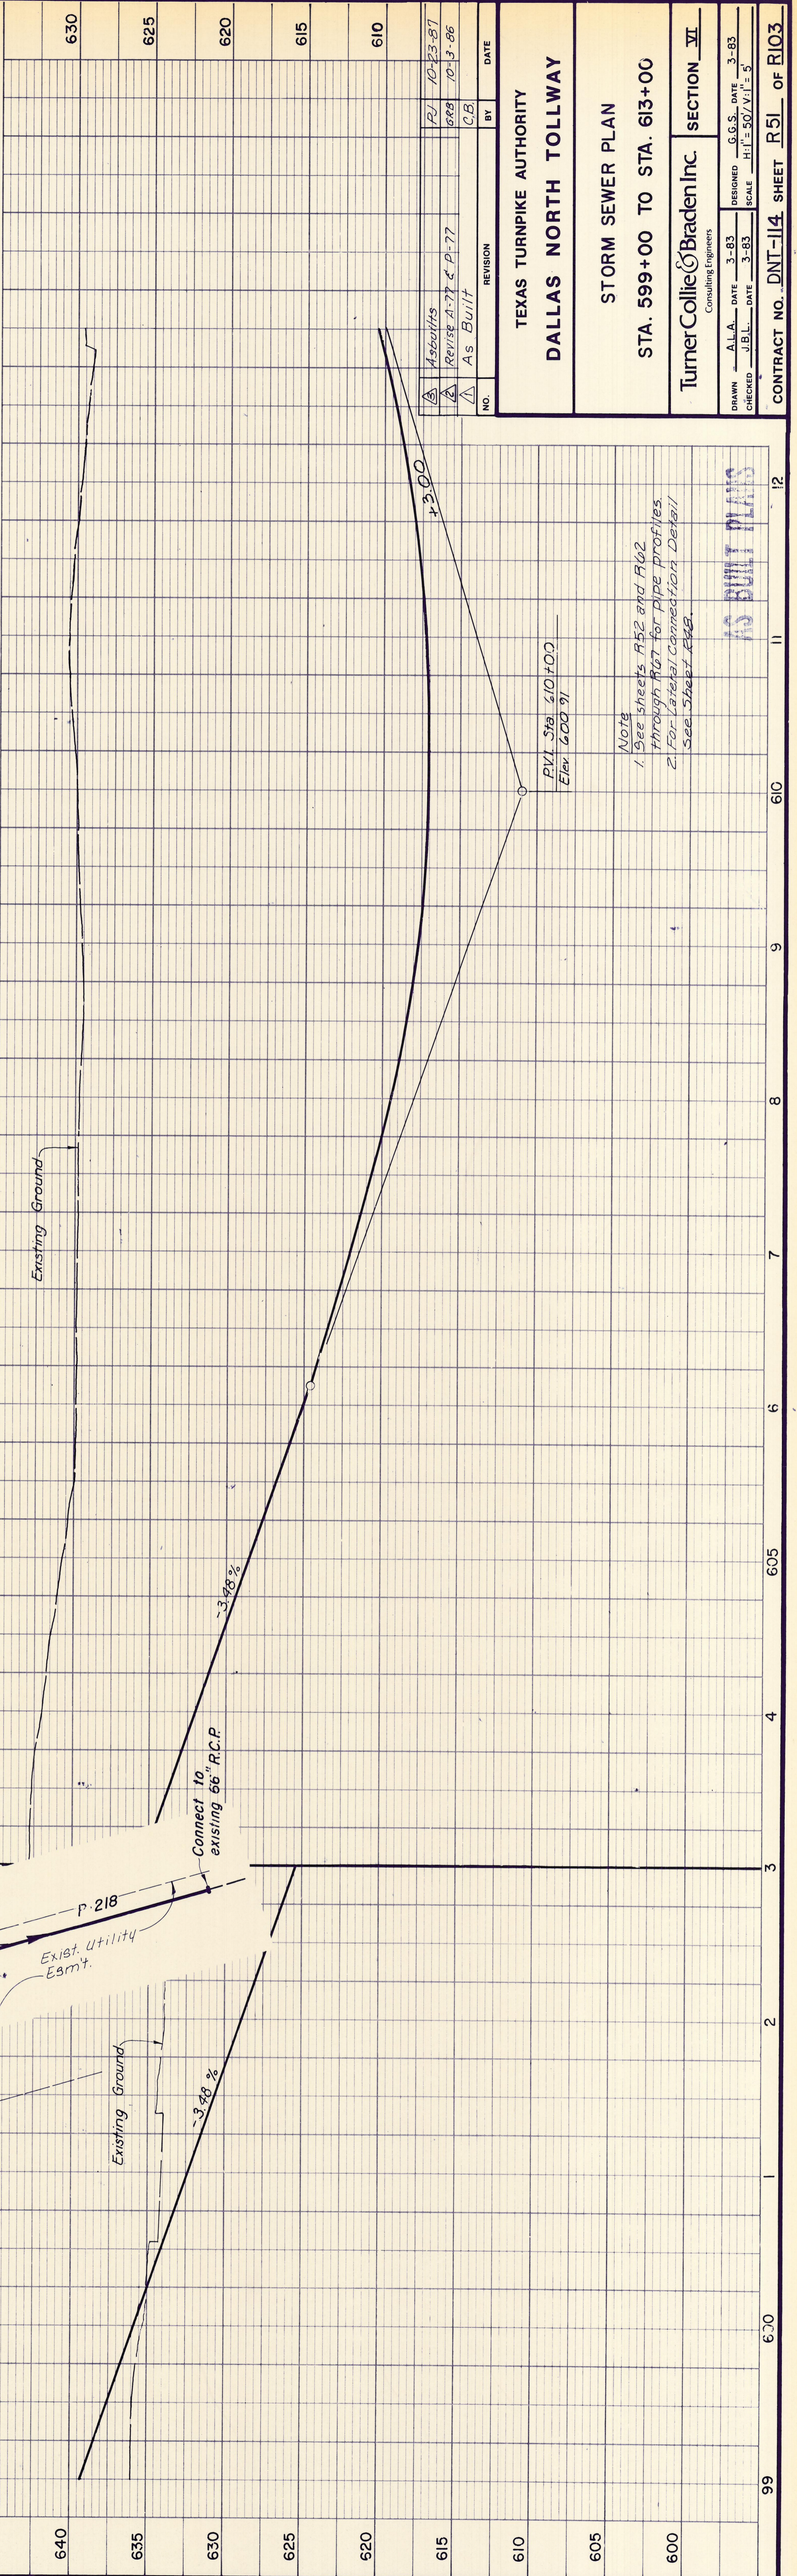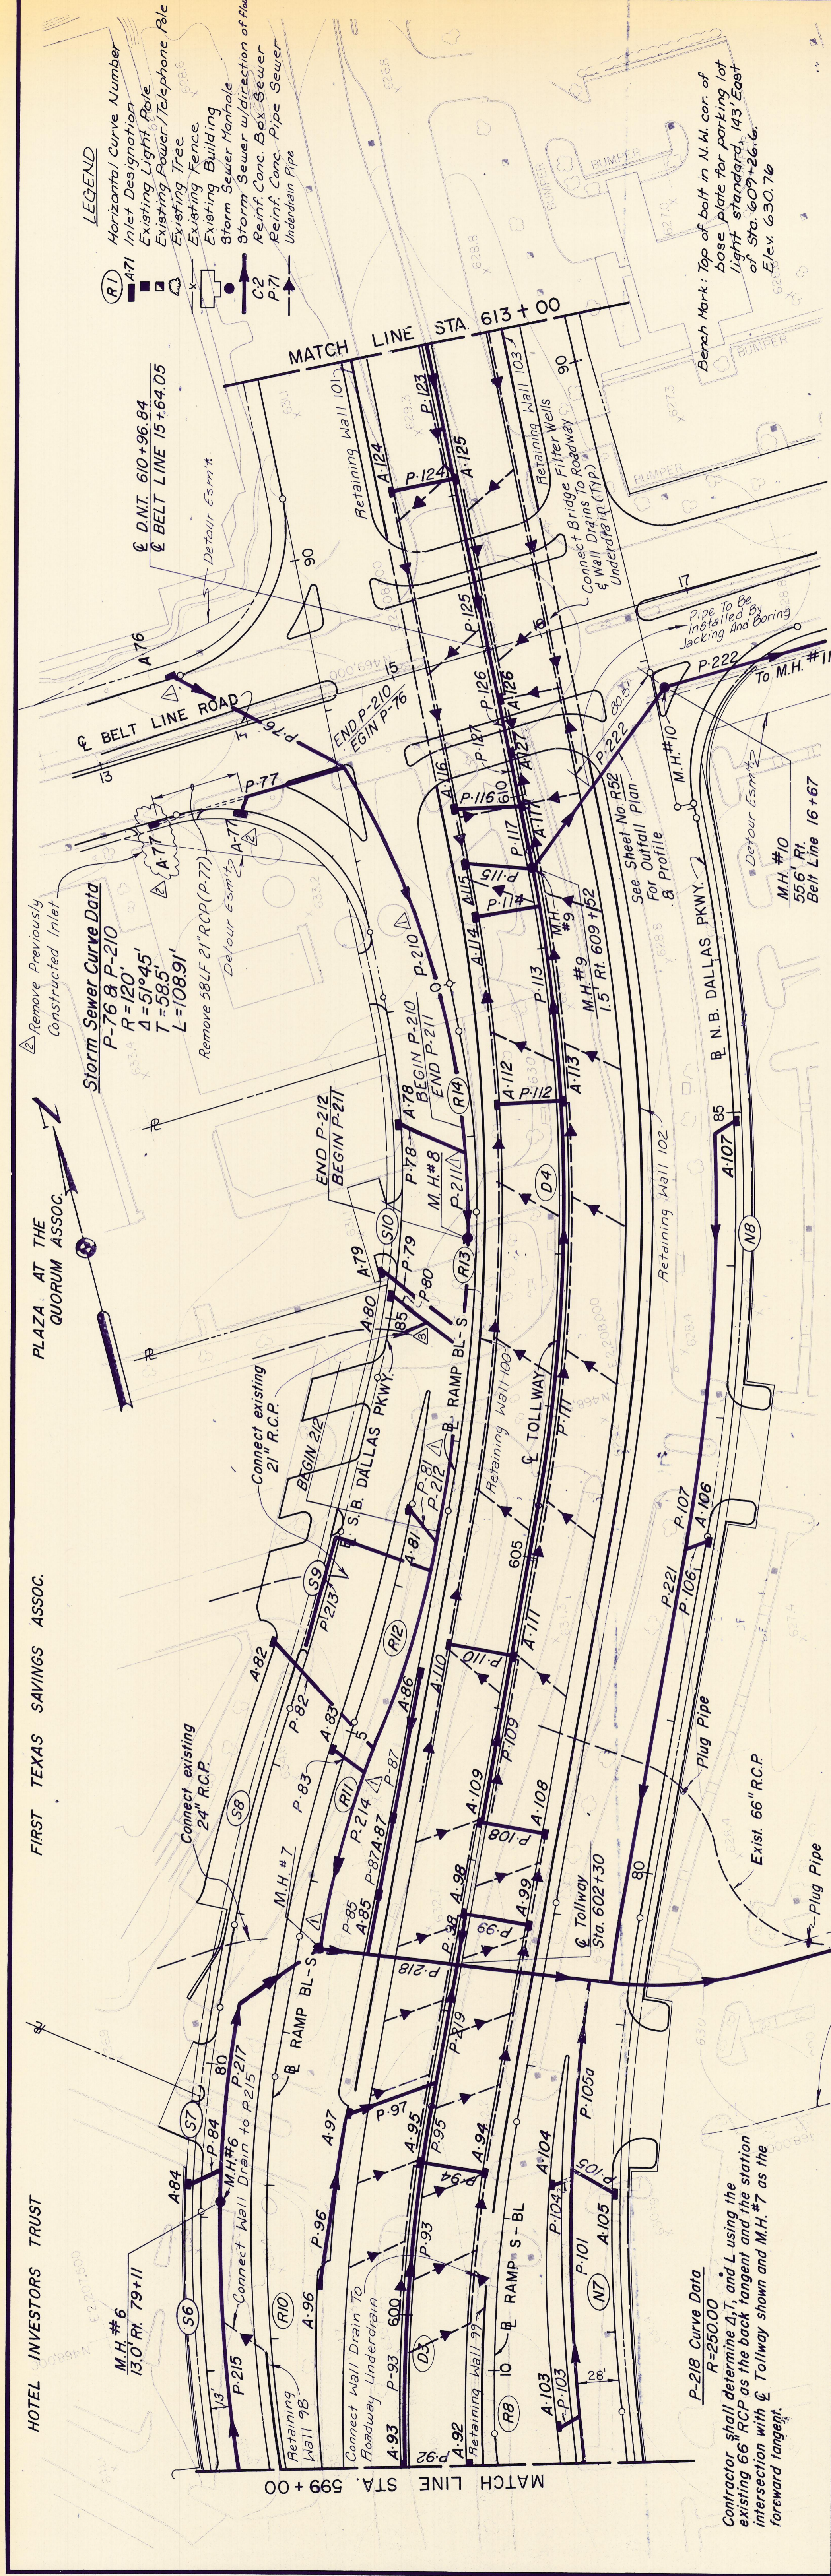

NOTE  
 1. See sheets R52 and R62 through R67 for pipe profiles.  
 2. For lateral connections Detail See Sheet R48.

TEXAS TURNPIKE AUTHORITY  
 DALLAS NORTH TOLLWAY

STORM SEWER PLAN  
 STA. 599+00 TO STA. 613+00

Turner Collier & Braden Inc.  
 Consulting Engineers  
 SECTION VII

NO.	REVISION	BY	DATE
1	As Built	C.B.	10-23-87
2	Revise A-77 & P-77		10-3-86
3	As Built		

CONTRACT NO. DNT-114 SHEET R51 OF R103