


Storm Sewer Curve Data
 $\Delta = 16^\circ 29' 36''$
 $R = 164.0'$
 $T = 23.77'$
 $L = 47.21'$

Bench Mark: Top of bolt in N.W. cor of base plate for parking lot light standard, 143' East of Sta. 609+26.6 Elev. 630.76

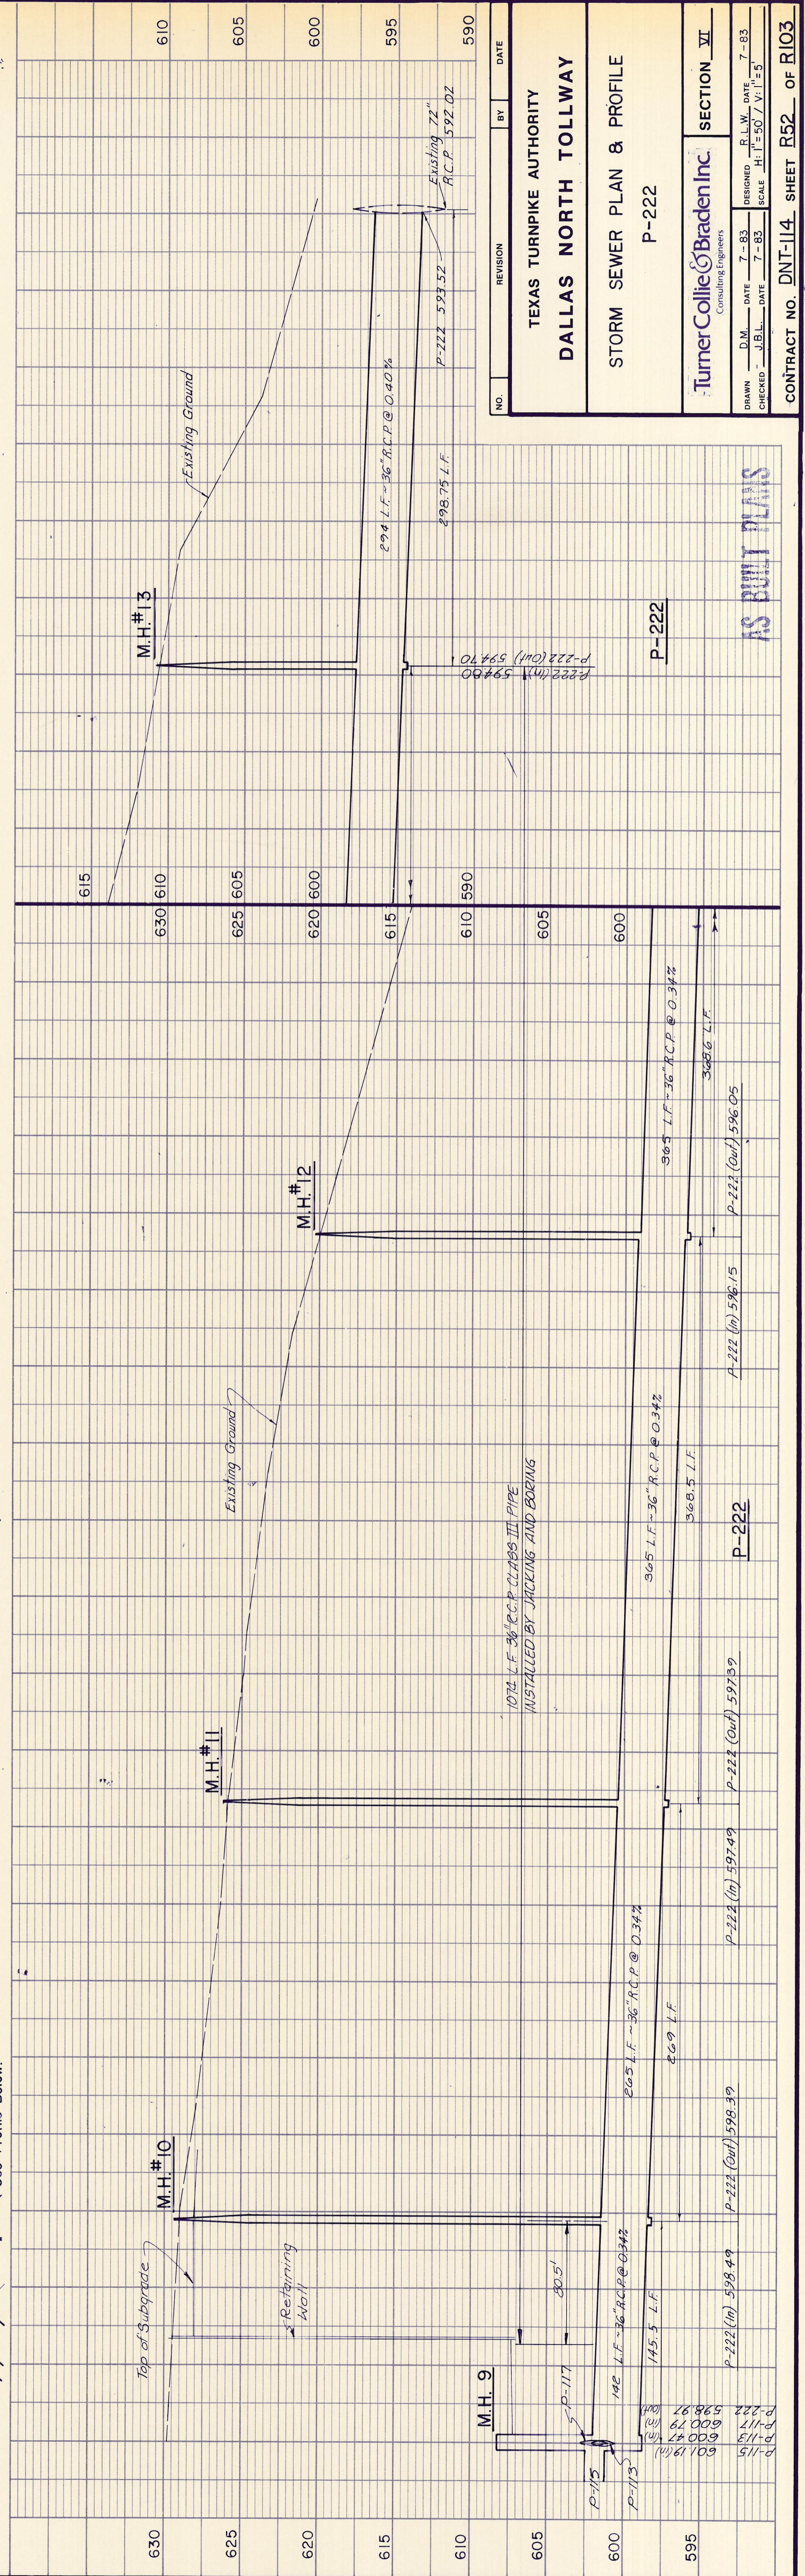

NO.	REVISION	BY	DATE
TEXAS TURNPIKE AUTHORITY DALLAS NORTH TOLLWAY STORM SEWER PLAN & PROFILE P-222			
Turner Collie & Braden Inc. Consulting Engineers			SECTION VII
DRAWN: D.M. CHECKED: J.B.L.	DATE: 7-83 DATE: 7-83	DESIGNED: R.L.W. SCALE: H: 1" = 50' / V: 1" = 5'	CONTRACT NO. DNT-114 SHEET R52 OF R103

AS BUILT PLANS