

Note: All R.C.P. to be Class III unless noted. See sheets R201, R251 for horizontal location of pipes.

ASBUILTS  
 REVISION NO. DATE

TEXAS TURNPIKE AUTHORITY  
 DALLAS NORTH TOLLWAY





STORM SEWER PROFILE

Turner Collier Braden Inc. SECTION VII  
 MADE R.L.W. DATE 7-83 TRACED A.L.A. DATE 7-83  
 CHECKED J.E.L. DATE 7-83 SCALE H11=20' V11=5'

CONTRACT NO. DNT-114 SHEET 563 OF R103

M.H.#5  
 P-84  
 M.H.#6  
 P-85  
 M.H.#7  
 P-86  
 P-87  
 P-88  
 P-89  
 P-90  
 P-91  
 P-92  
 P-93

AS BUILT PLANS

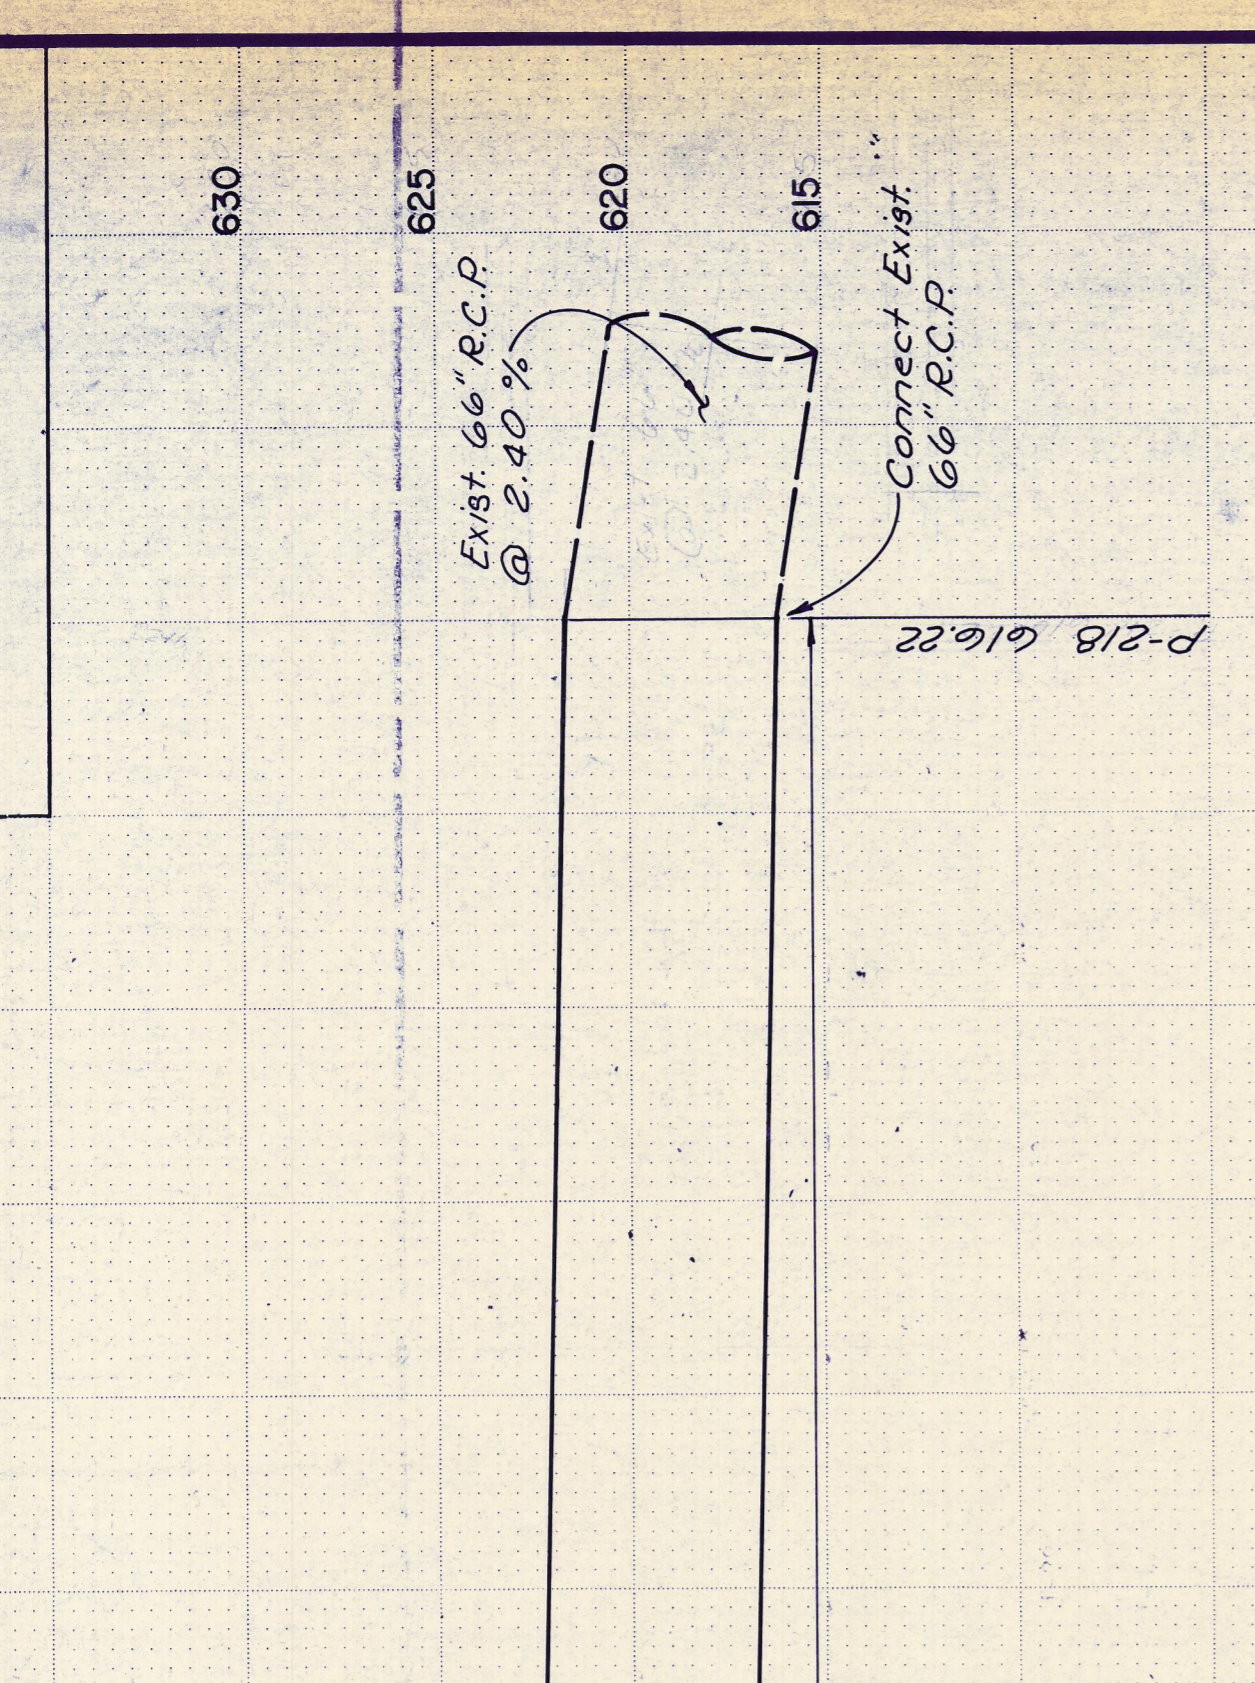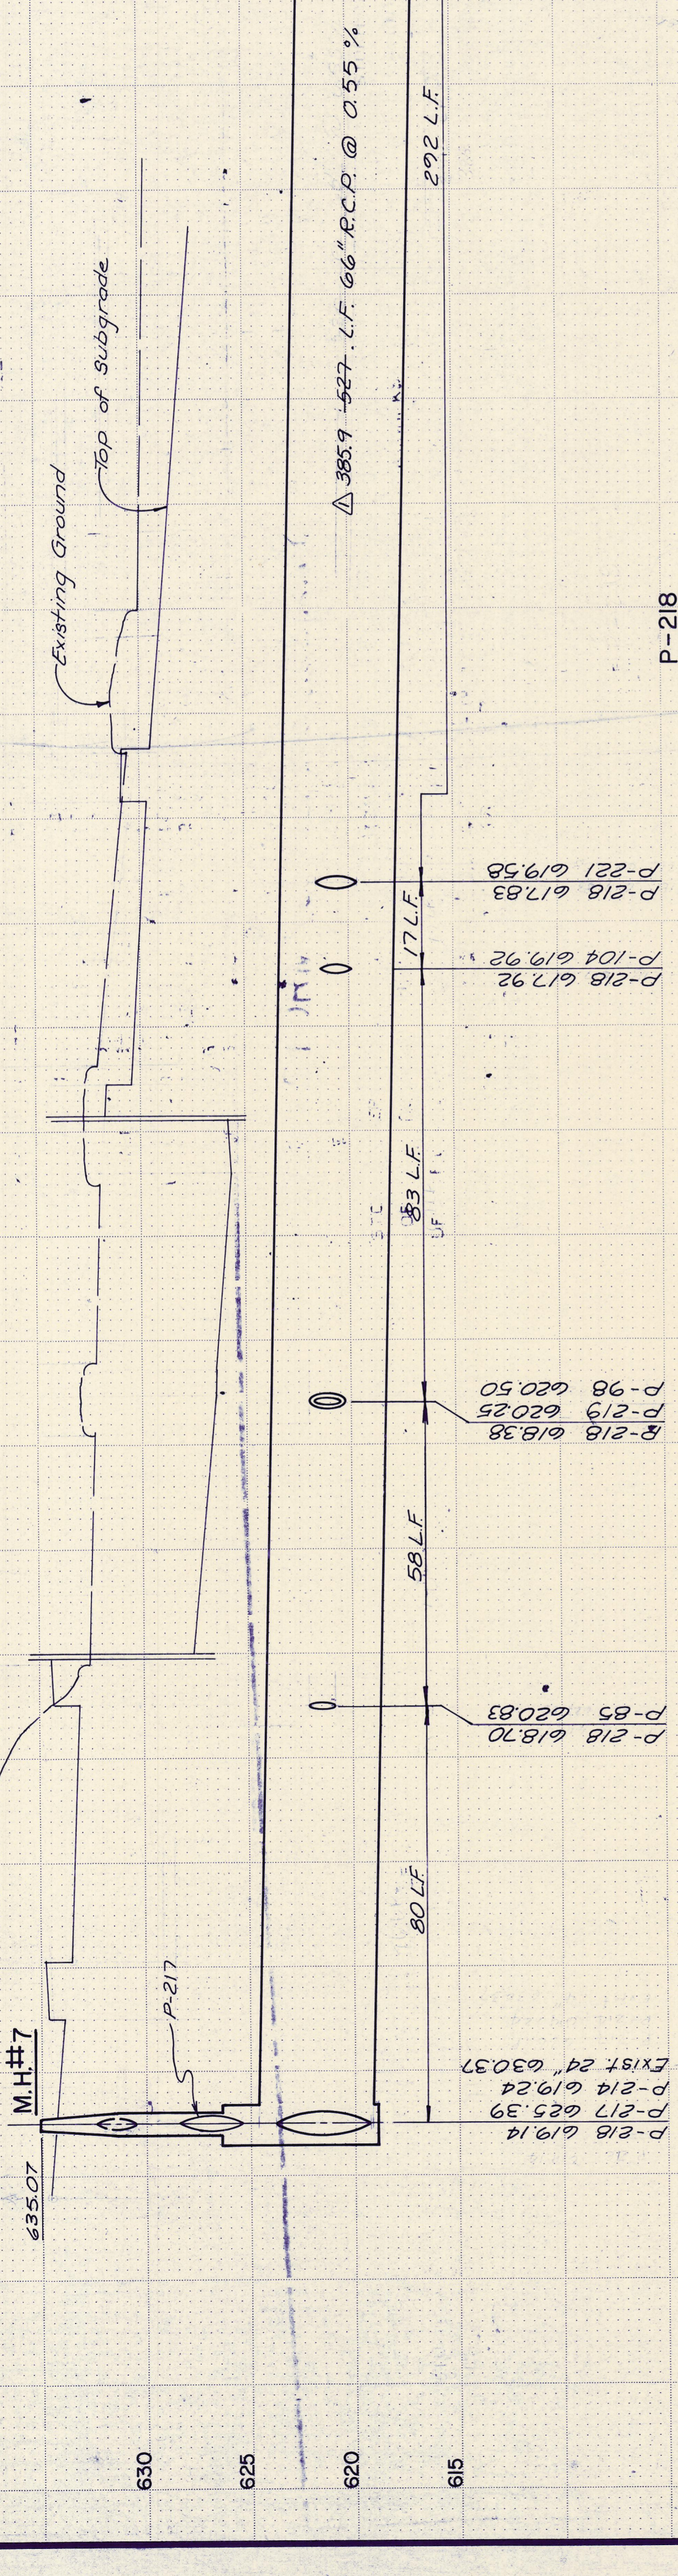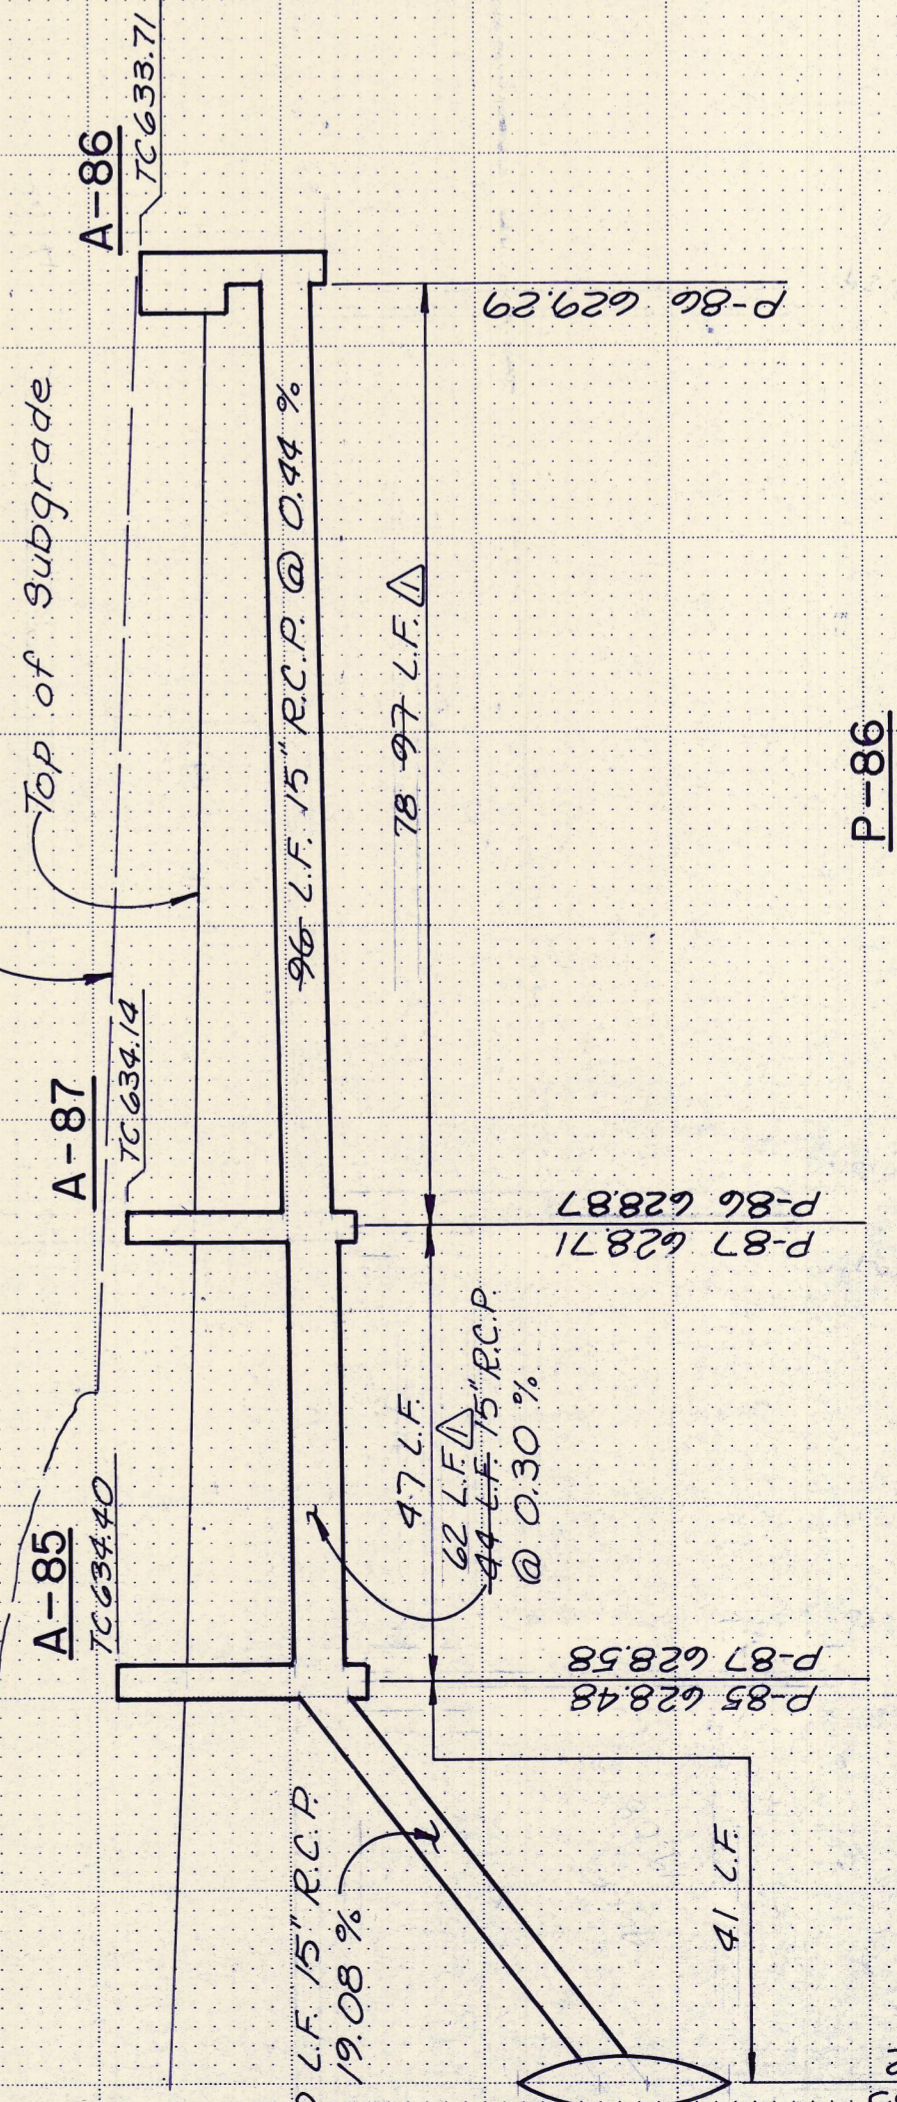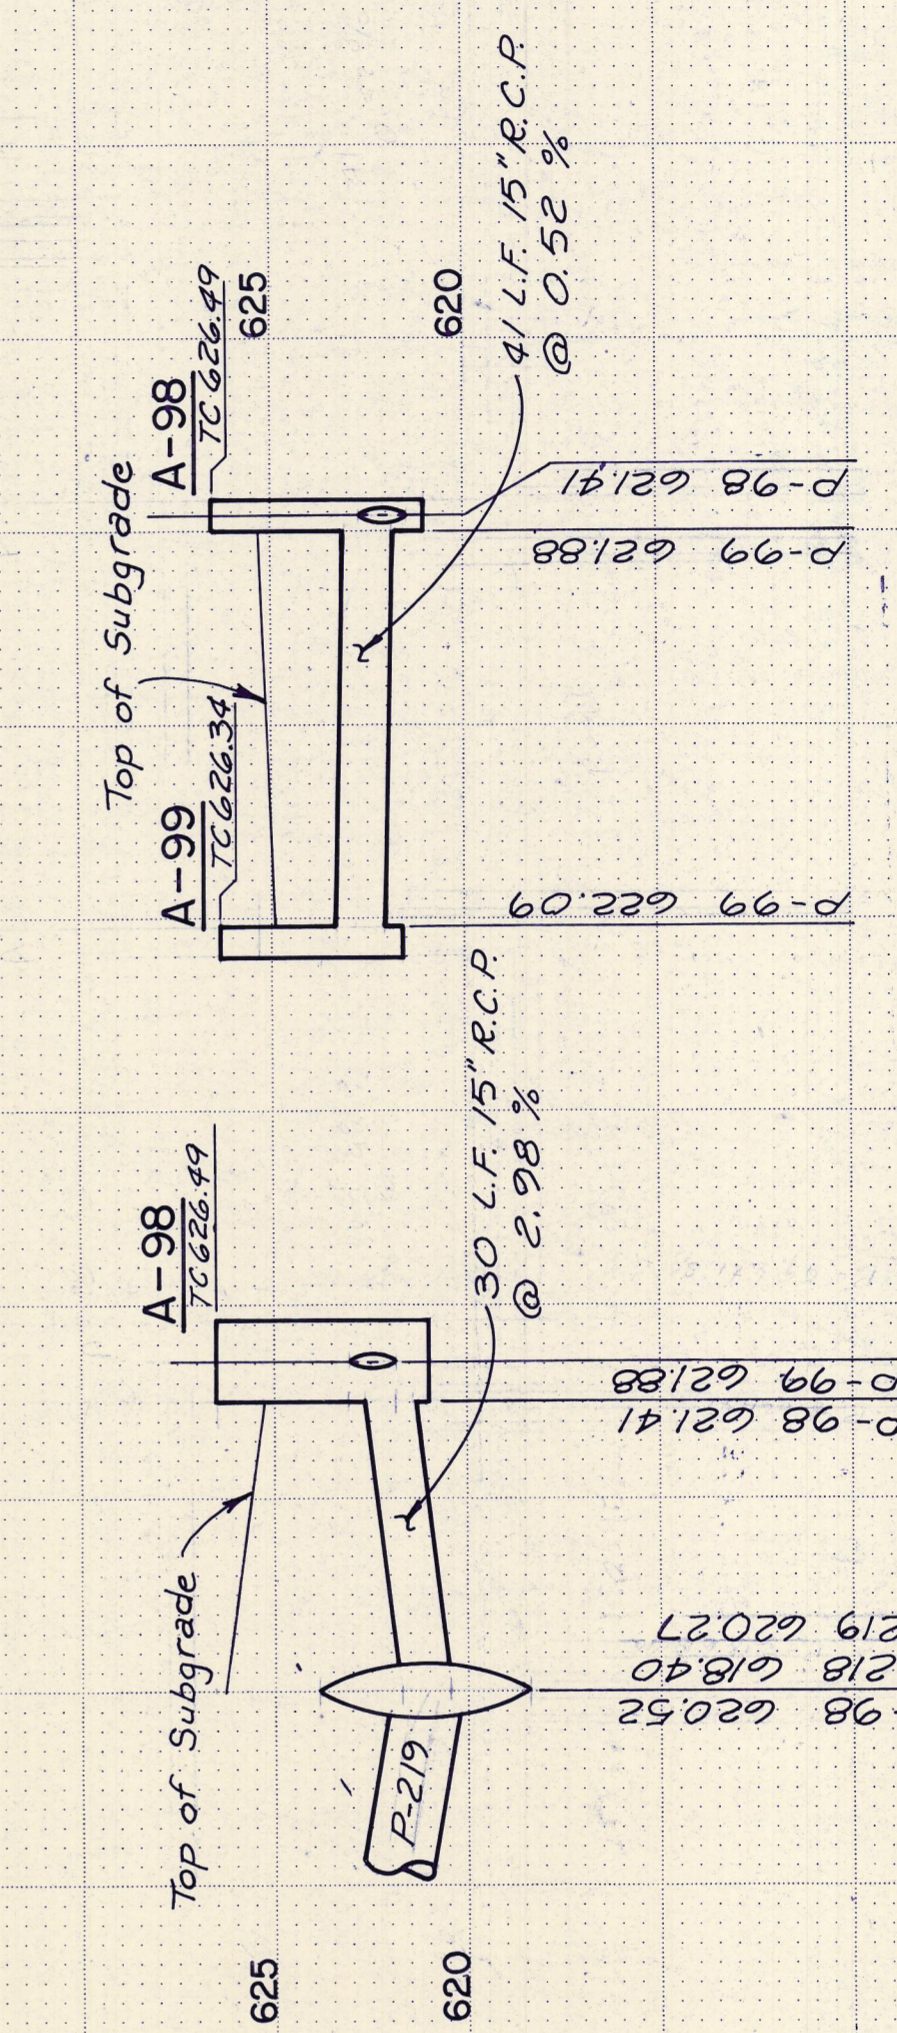

AS BUILT PLANS