


AS BUILT PLANS

CONTRACT NO. DNT-114 SHEET R72 OF R103	
TURNER COLLIER & BRADEN INC.	SECTION VII
DATE 7-83	TRACED M.D.L. DATE 7-83
CHECKED J.B.L.	SCALE H ₁ = 20', V ₁ = 5'

TEXAS TURNPIKE AUTHORITY
DALLAS NORTH TOLLWAY
STORM SEWER PROFILE

NO.	REVISION	BY	DATE
1	Asbuilts	RJ	10-87
2	CHANGE PIPE CLASS TO IV	655	4-88

Note: 1. All R.C.P. to be Class III unless noted
2. See sheet 54 for horizontal location of pipes.

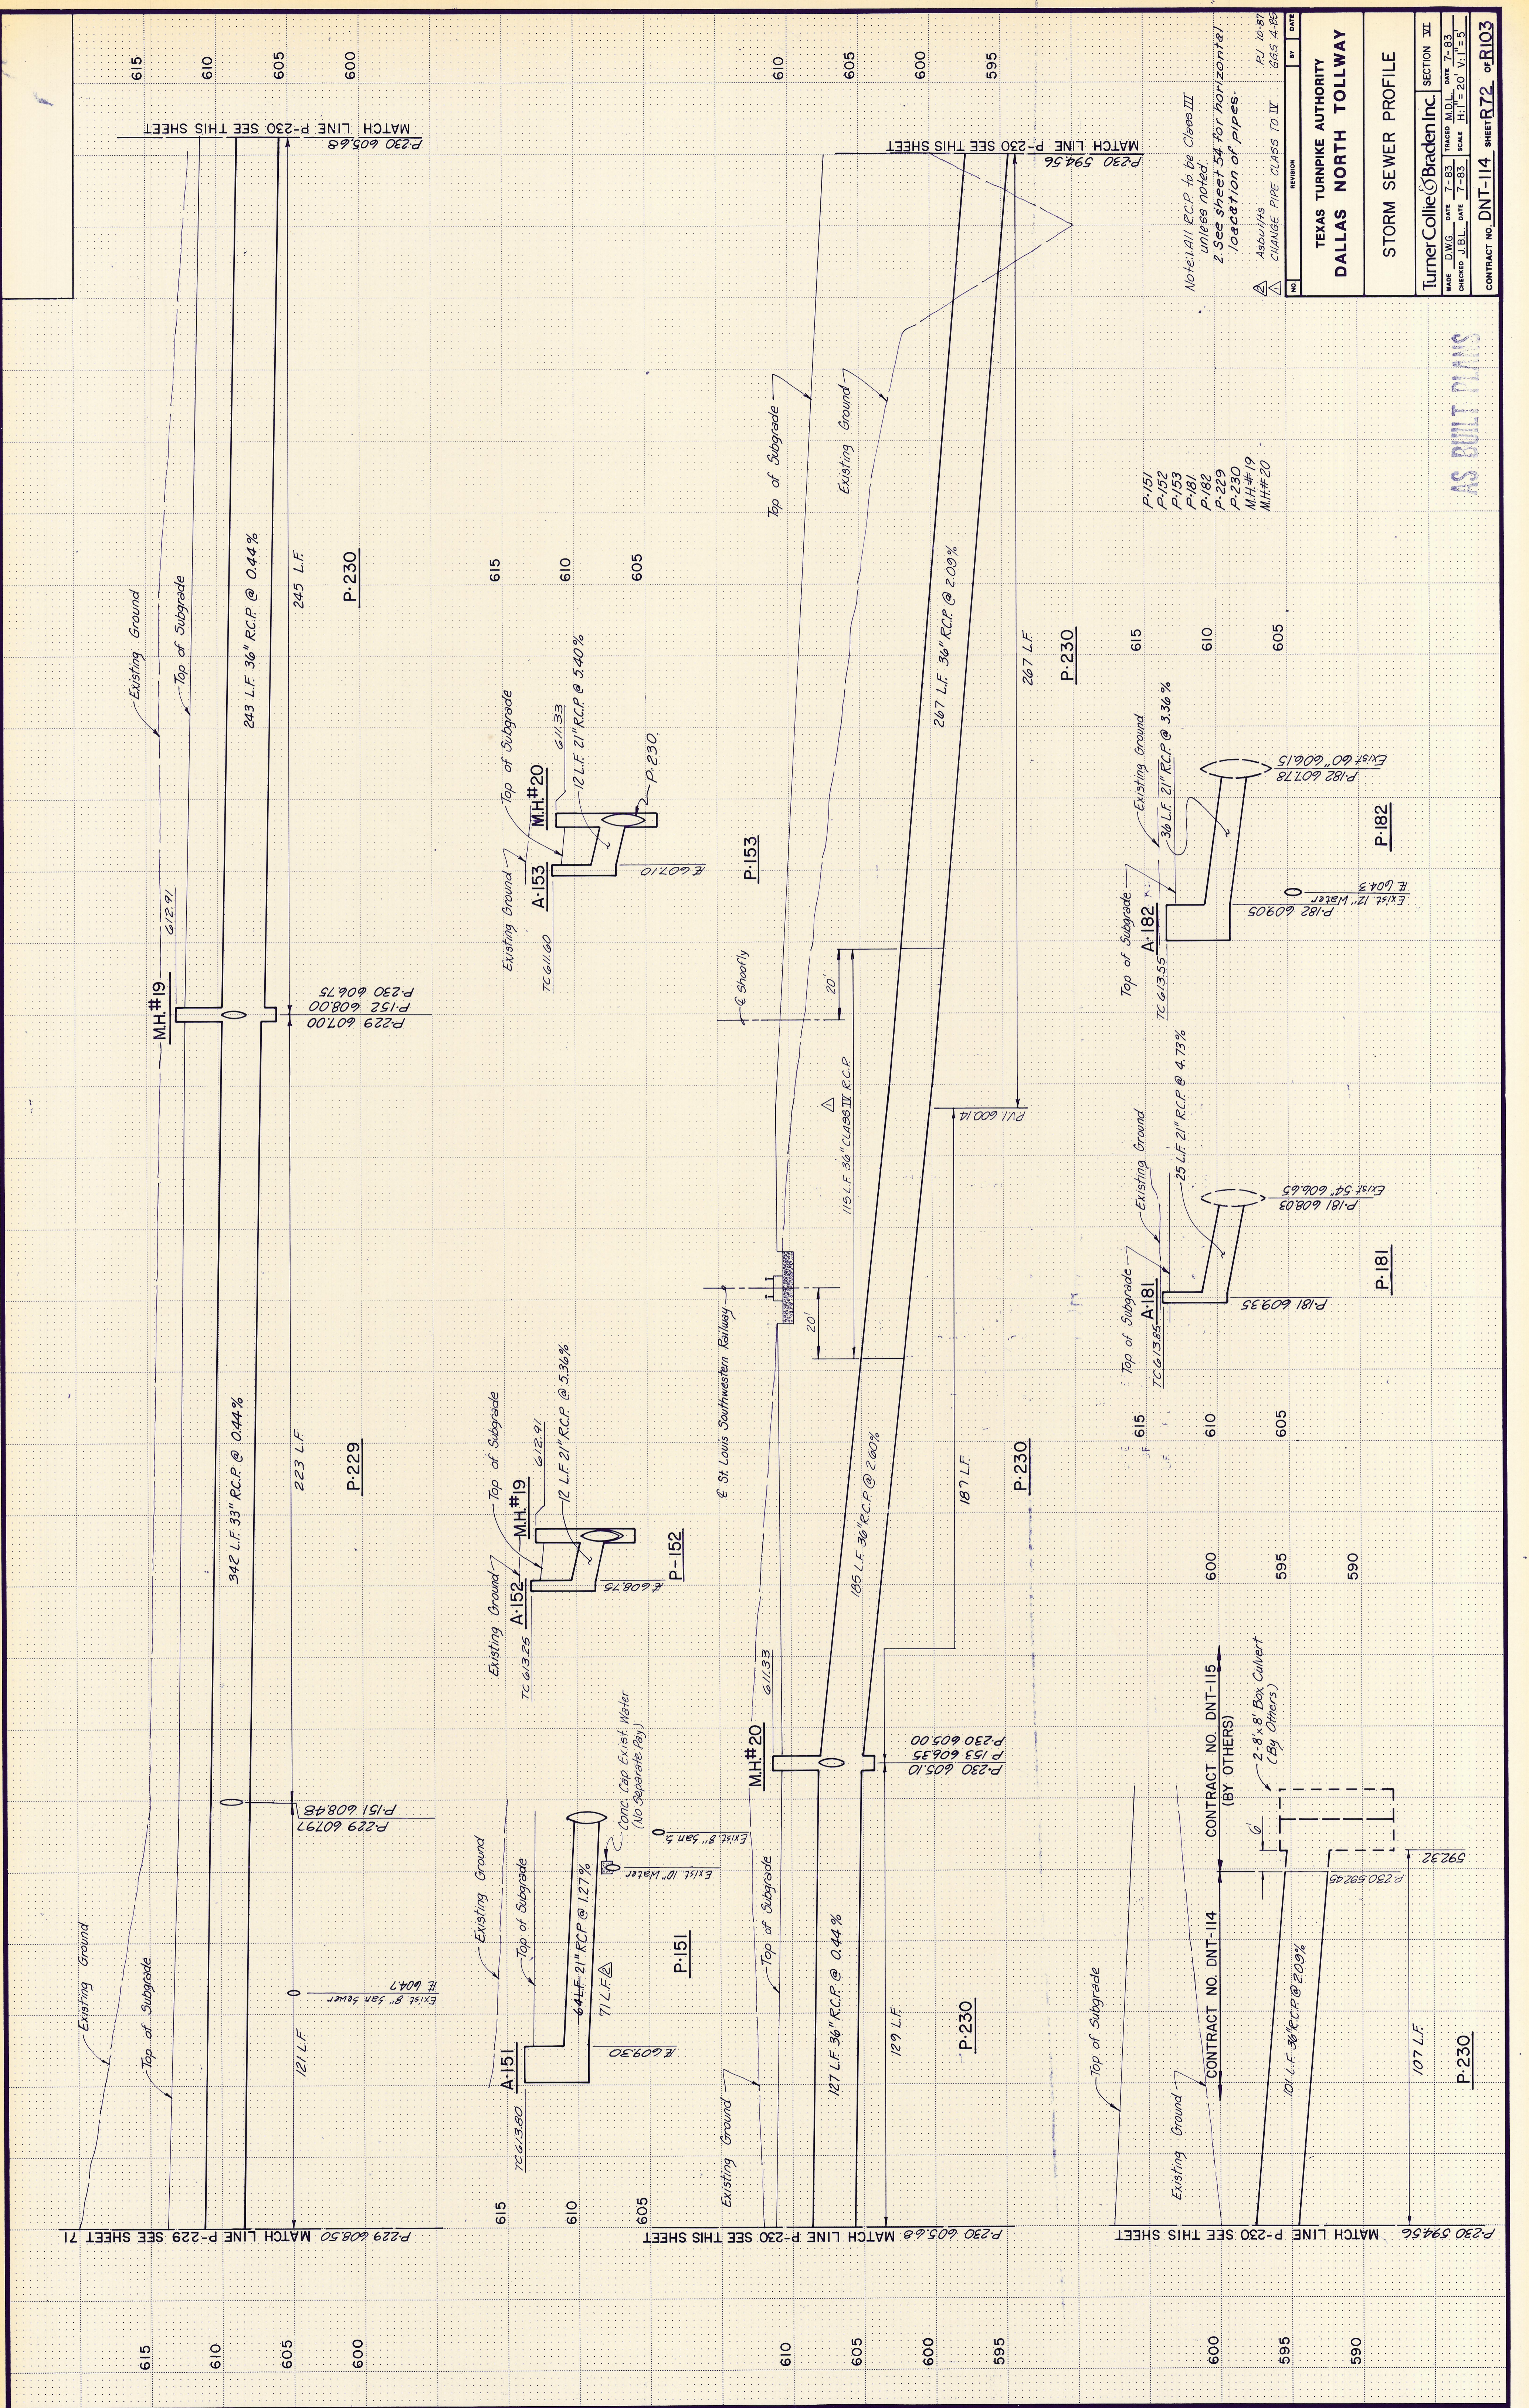

CONTRACT NO. DNT-114

CONTRACT NO. DNT-115

CONTRACT NO. DNT-114 (BY OTHERS)

2-8' x 8' Box Culvert (By Others)

EXIST. 8" SAN SEWER

EXIST. 10" WATER

CONC. CAP EXIST. WATER (NO SEPARATE FEE)

EXIST. 8" SAN 5'

EXIST. 10" WATER

EXIST. 12" WATER

EXIST. 60" WATER

EXIST. 60" WATER

