

CONTRACT NO. DNT-114
(BY OTHERS)


CONTRACT NO. DNT-115
(BY OTHERS)

Note: All R.C.P. to be Class III
unless noted.
See sheet R54 for horizontal
location of pipes.

NO.	REVISION	DATE
1	STORM SEWER AND LATERALS FROM M.H.#22 TO M.H.#23	6/25/84

MADE	DWG.	DATE	TRACED	D.W.G.	DATE	SECTION
TURNER COLLETT	J.B.L.	7-83	TURNER COLLETT	J.B.L.	7-83	VI
CHECKED	J.B.L.	7-83	SCALE	1"=20' V.L.=5'		

TEXAS TURNPIKE AUTHORITY	
DALLAS NORTH TOLLWAY	
STORM SEWER PROFILE	
Turner Collett/Braden Inc	
PROJECT NO.	DNT-114
SHEET NO.	R74 OF R103

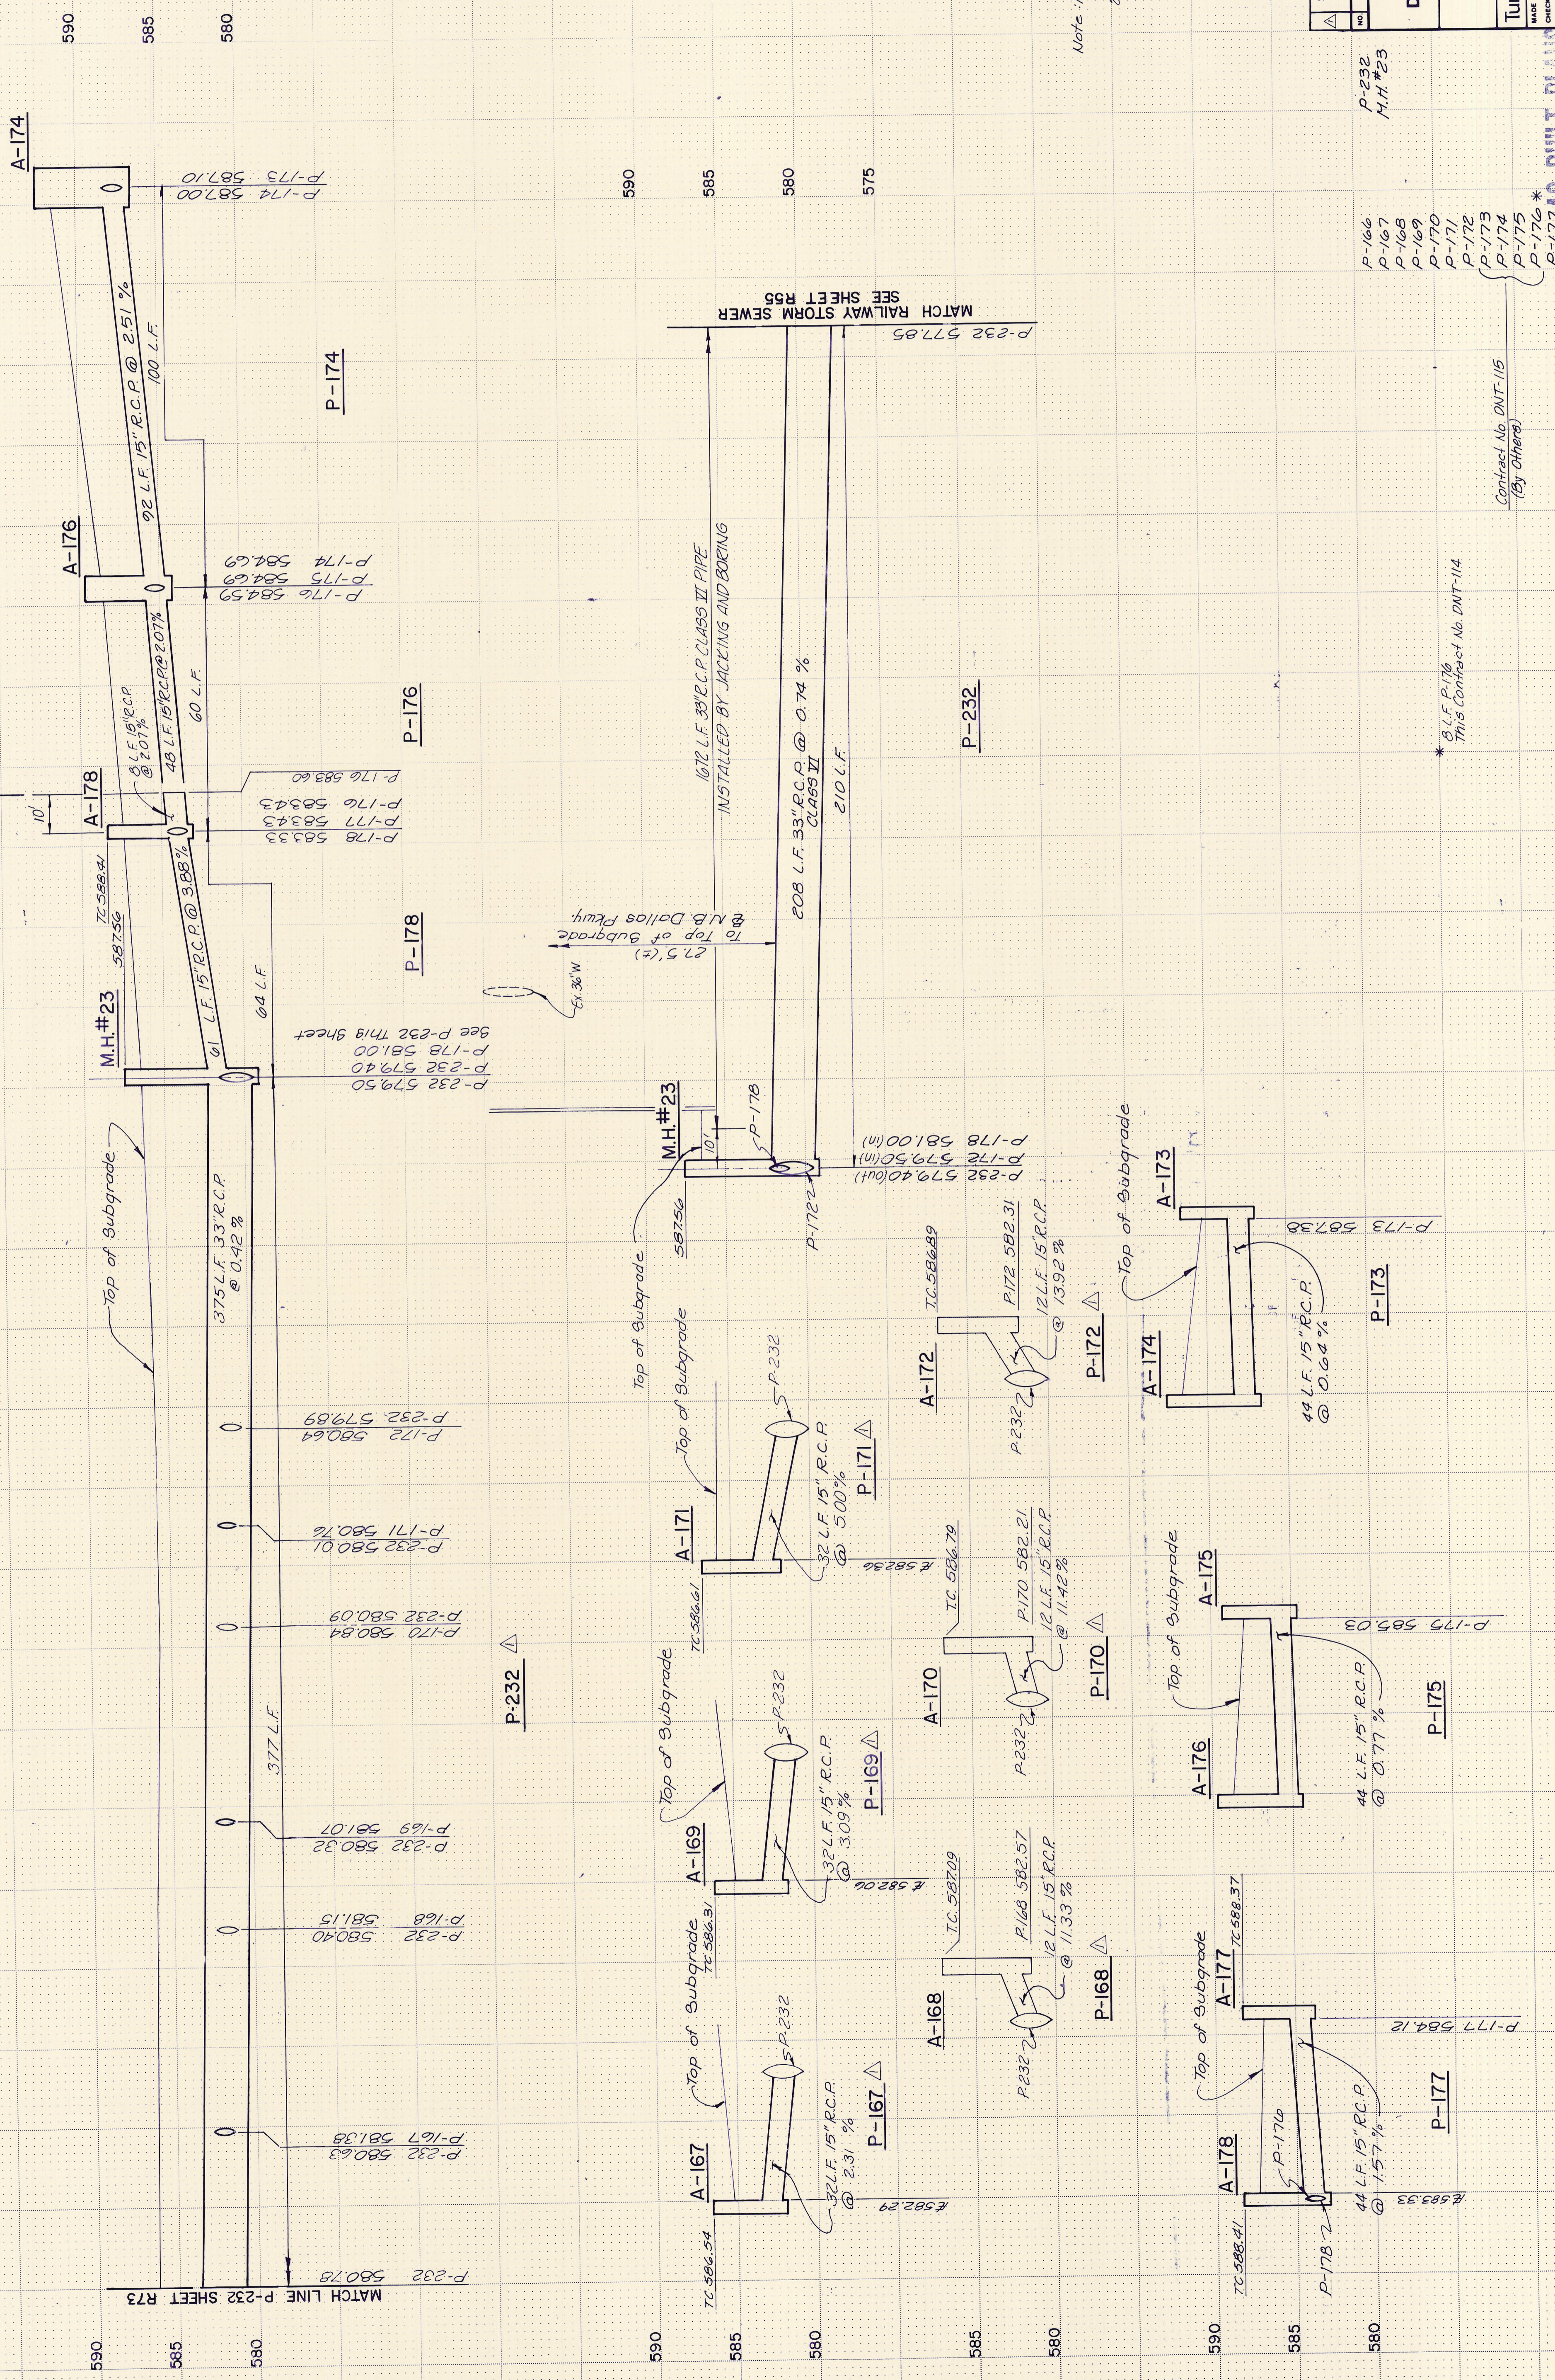

- P-166
- P-167
- P-168
- P-169
- P-170
- P-171
- P-172
- P-173
- P-174
- P-175
- P-176
- P-177
- P-178

M.H.#23
P-232

* 8 L.F. P-176
This Contract No. DNT-114
(By Others)

Contract No. DNT-115
(By Others)

AS BUILT PLANS