

**LEGEND**  
 Horizontal Curve Number  
 Inlet Designation  
 Existing Light Pole  
 Existing Power / Telephone Pole  
 Existing Tree  
 Existing Fence  
 Existing Building  
 Storm Sewer Manhole

**NOTES**  
 1 See Sheet R23 for N.B. Dallas Pkwy. Profile  
 2 " " R25 for S.B. Dallas Pkwy. Profile  
 3 " " R22 for Ramp SPV-N Profile  
 4 " " R27 for Ramp N-SPV Profile  
 5 " " R4 for Additional Horizontal Geometrics  
 6 " " R33 for Storm Sewer Plan  
 7 " " R30 for Ramp SPV-N Details & Nose Slope  
 8 " " R31 for Ramp N-SPV Details & Nose Slope  
 9 " " R10 for Retainments  
 10 " " R78 for Typical Roadway Sections  
 11 See Volume Plans for Retaining Wall Details


**AS BUILT PLANS**

NO.	DATE	BY	REVISION
9-86	9-86	WFP	9-86
2-19-86	2-19-86	JTK	2-19-86
10-24-86	10-24-86	GMG	10-24-86

**DALLAS TOLLWAY PARTNERS**

**PARKWAY II ASSOC.**

**H.K. HUJE, JR.**

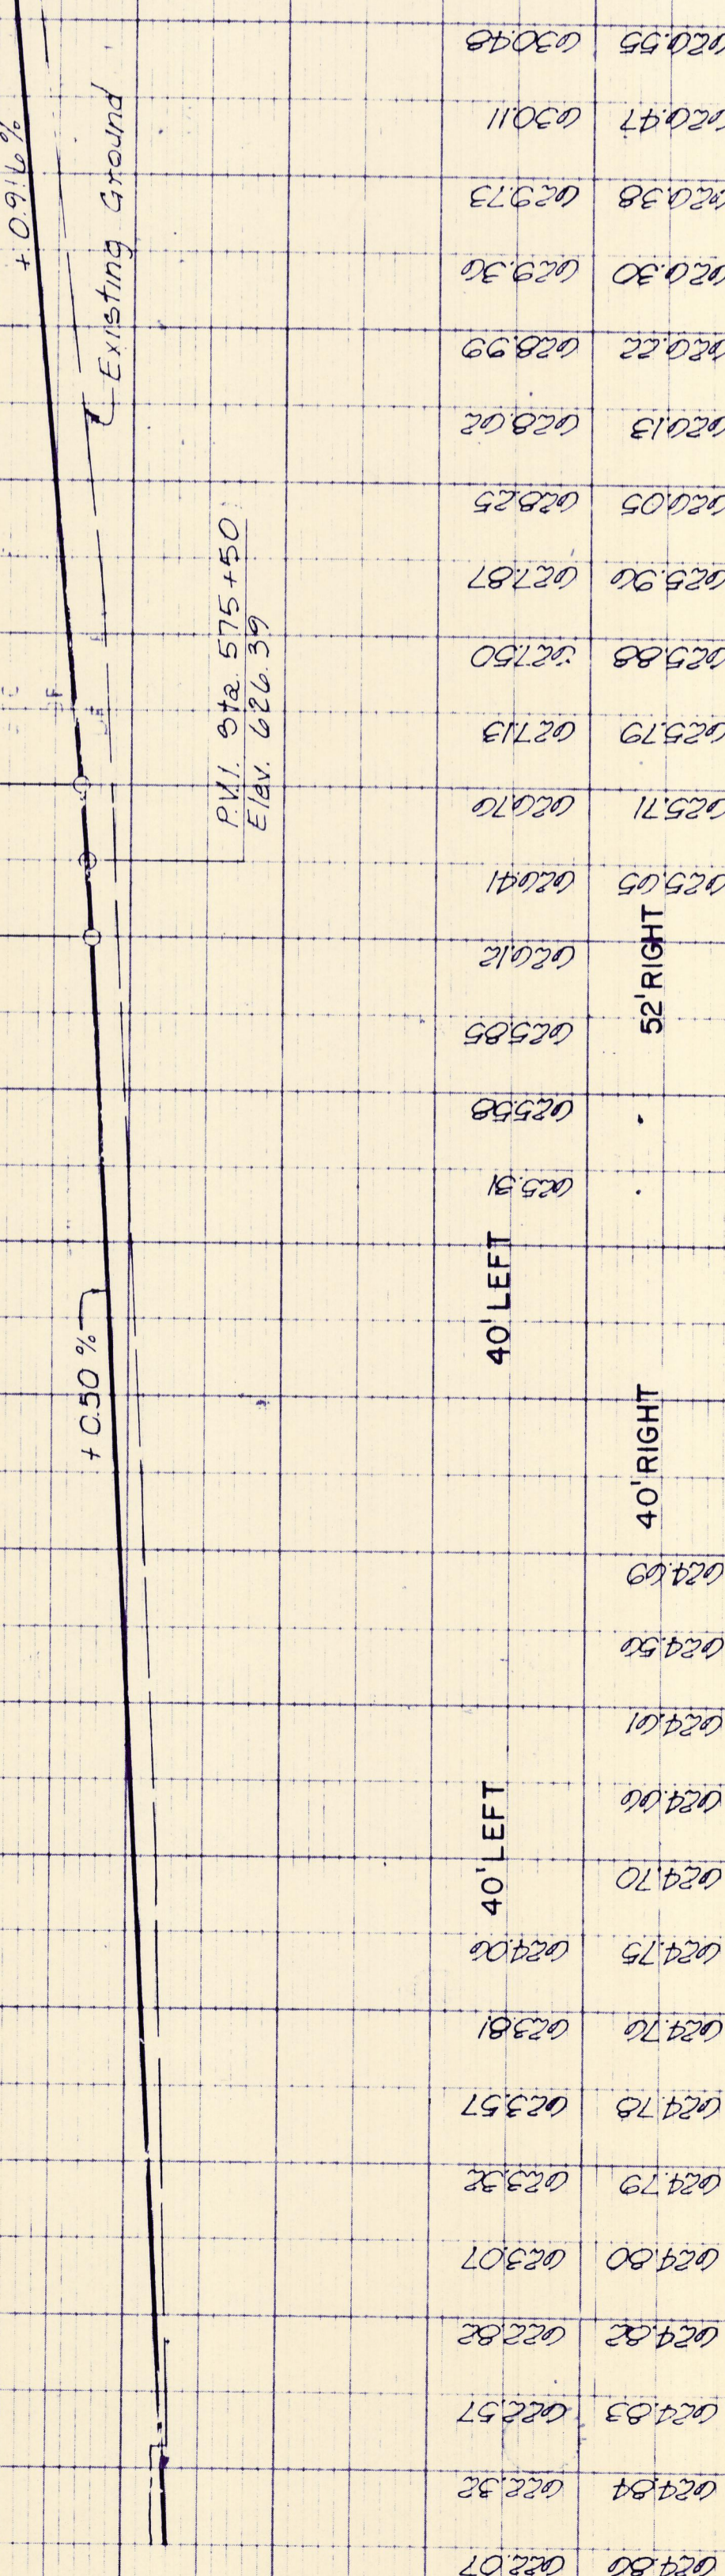

PROFILE GRADE	STATION
624.02	570+00
624.92	571+00
625.82	572+00
626.72	573+00
627.62	574+00
628.52	575+00
629.42	576+00
630.32	577+00
631.22	578+00
632.12	579+00
633.02	580+00
633.92	581+00
634.82	582+00
635.72	583+00
636.62	584+00
637.52	585+00

NO.	DATE	BY	REVISION
9-86	9-86	WFP	9-86
2-19-86	2-19-86	JTK	2-19-86
10-24-86	10-24-86	GMG	10-24-86

**PROFILE GRADE**

**STATION**

645  
640  
635  
630  
625  
620

40' LEFT  
52' RIGHT  
40' LEFT  
52' RIGHT  
40' RIGHT