


LEGEND

- Type A Curb
- ▬ 2' Curb & Gutter
- ▨ Remove Existing Concrete Pavement
- ▩ Remove and Replace 6" Concrete Pavement
- ▧ New 6" Concrete Pavement
- ▦ Remove Ramp and Replace with 4" Sidewalk

GENERAL NOTES:

New parking lot pavement shall be 6" reinforced concrete with No. 3 Bars @ 24" on centers, each way. All new islands and medians shall be backfilled with suitable earth. Saw cut at existing parking lot islands shall be 2'-0" from face of existing curb. 2'-0" of existing reinforcing shall remain in place beyond the saw cut. The existing reinforcing shall be cleaned and tied to the new reinforcing prior to concrete placement. New sidewalk shall be 4" reinforced concrete with No. 3 bars @ 24" on centers, each way. 1/2" pre-formed joint material shall be provided between the back of curb & gutter and sidewalk. Handicap ramp shall be concrete and shall taper from top of curb and gutter to a height of 3/8" over a length of 6'-0". The width of the ramp shall be 4'-0".

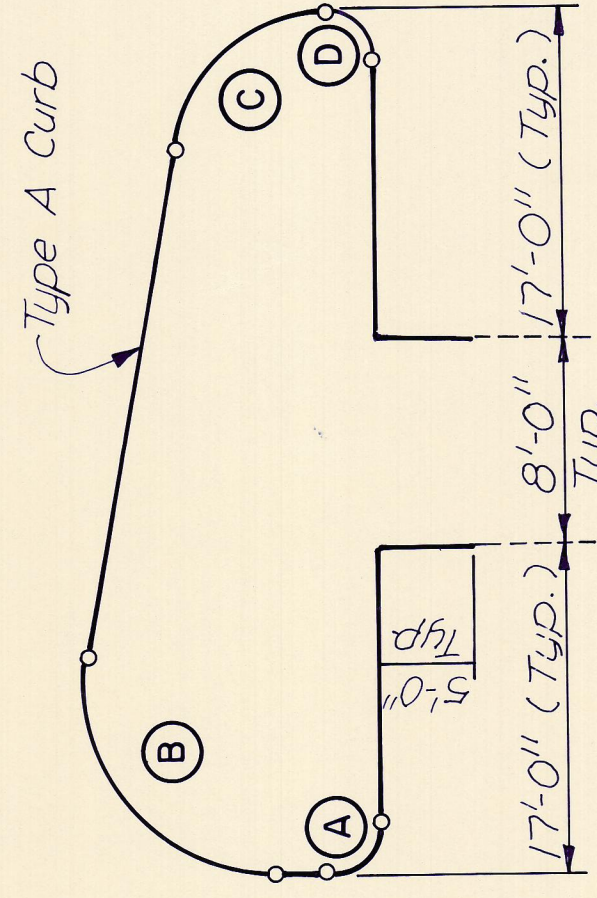

PARKING ISLAND PLAN LAYOUT

Not to Scale

PARKING ISLAND CURVE RADII				
ISLAND NO.	(1)	(2)	(3)	(4)
A	2.5'	2.5'	2.5'	2.5'
B	10.0'	8.0'	12.5'	
C	8.0'	10.0'	37.5'	
D	2.5'	2.5'	2.5'	2.5'

SPECIAL NOTE Δ
Existing Handicap Ramps shall be removed and replaced with 4" concrete sidewalk.

NO.	REVISION	BY	DATE
1	Add Special Note	WAP	3-14-85

TEXAS TURNPIKE AUTHORITY
DALLAS NORTH TOLLWAY
 SAKOWITZ VILLAGE
 PARKING LOT RENOVATIONS

HINTB
 HOWARD NEEDLES TAMMEN & BERGENDOFF
 DRAWN: W.A.P. DATE: 3-27-85 DESIGNED: H.K.M. DATE: 3-26-85
 CHECKED: G.A.L. DATE: 3-28-85 SCALE: 1"=50'
 CONTRACT NO. DNT-114 SHEET R19A OF

AS BUILT PLANS