



PARVAL, INC.

HENRY BUTTS, JR.

S. FINLEY EWING, JR.

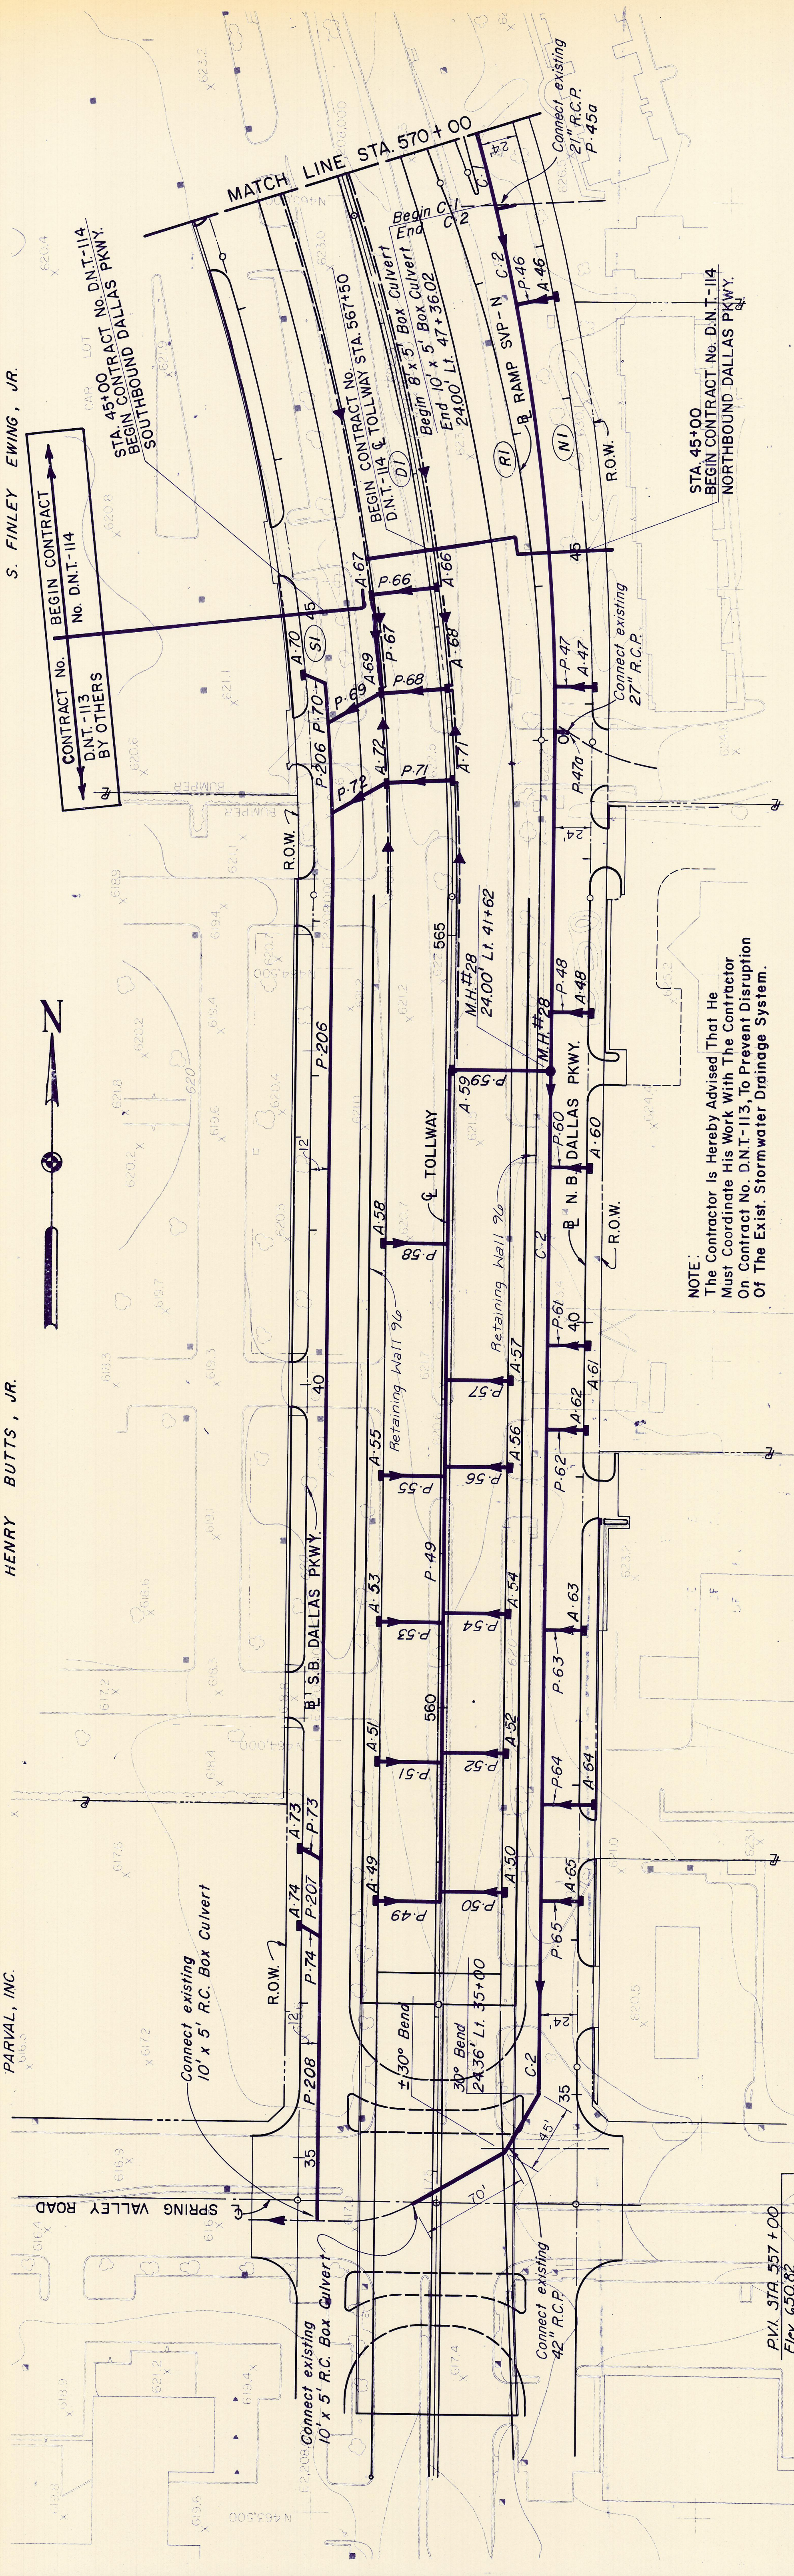

NOTE:
The Contractor is Hereby Advised That He Must Coordinate His Work With The Contractor On Contract No. D.N.T.-113, To Prevent Disruption Of The Exist. Stormwater Drainage System.

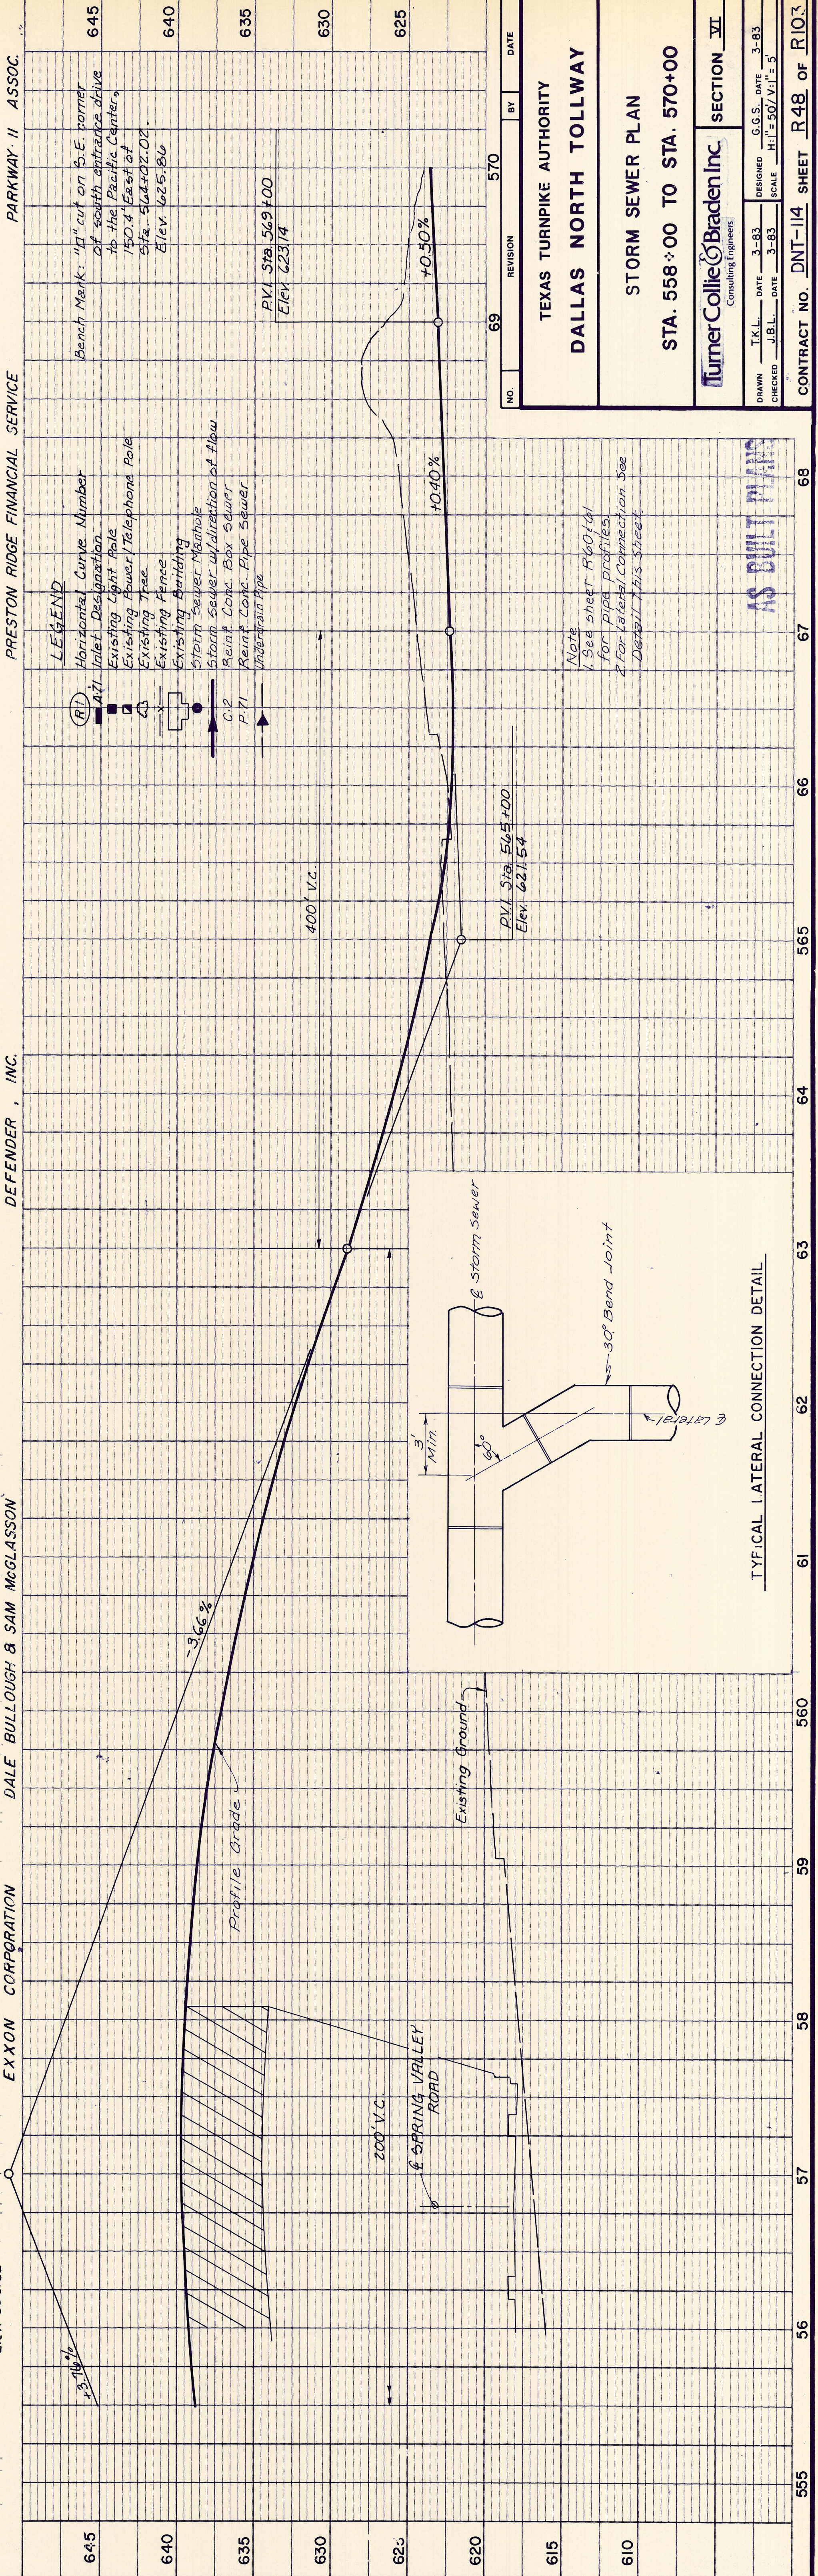

LEGEND

- (R) Horizontal Curve Number
- (A) Inlet Designation
- Existing Light Pole
- Existing Power/Telephone Pole
- Existing Tree
- Existing Fence
- Existing Building
- Storm Sewer Manhole
- Storm Sewer Valuation at Flow
- Reint. Conc. Box Sewer
- P-71 Underdrain Pipe

REVISION

NO.	REVISION	BY	DATE
645			
640			
635			
630			
625			
620			
615			
610			

DALE BULLOUGH & SAM McGLASSON

EXXON CORPORATION

DEFENDER, INC.

PRESTON RIDGE FINANCIAL SERVICE

PARKWAY-II ASSOC.

TEXAS TURNPIKE AUTHORITY

DALLAS NORTH TOLLWAY

STORM SEWER PLAN

STA. 558+00 TO STA. 570+00

TurnerCollie & Braden Inc. Consulting Engineers

SECTION VII

CONTRACT NO. DNT-114 SHEET R48 OF R103

AS BUILT PLANS

TYPICAL LATERAL CONNECTION DETAIL