


**LEGEND**  
 Horizontal Curve Number  
 Inlet Designation  
 Existing Light Pole  
 Existing Power / Telephone Pole  
 Existing Tree  
 Existing Fence  
 Existing Building  
 Storm Sewer Manhole  
 Storm Sewer w/ direction of flow  
 Reinf. Conc. Box Sewer  
 C-1  
 P-21 Reinf. Conc. Pipe Sewer  
 Underdrain Pip.

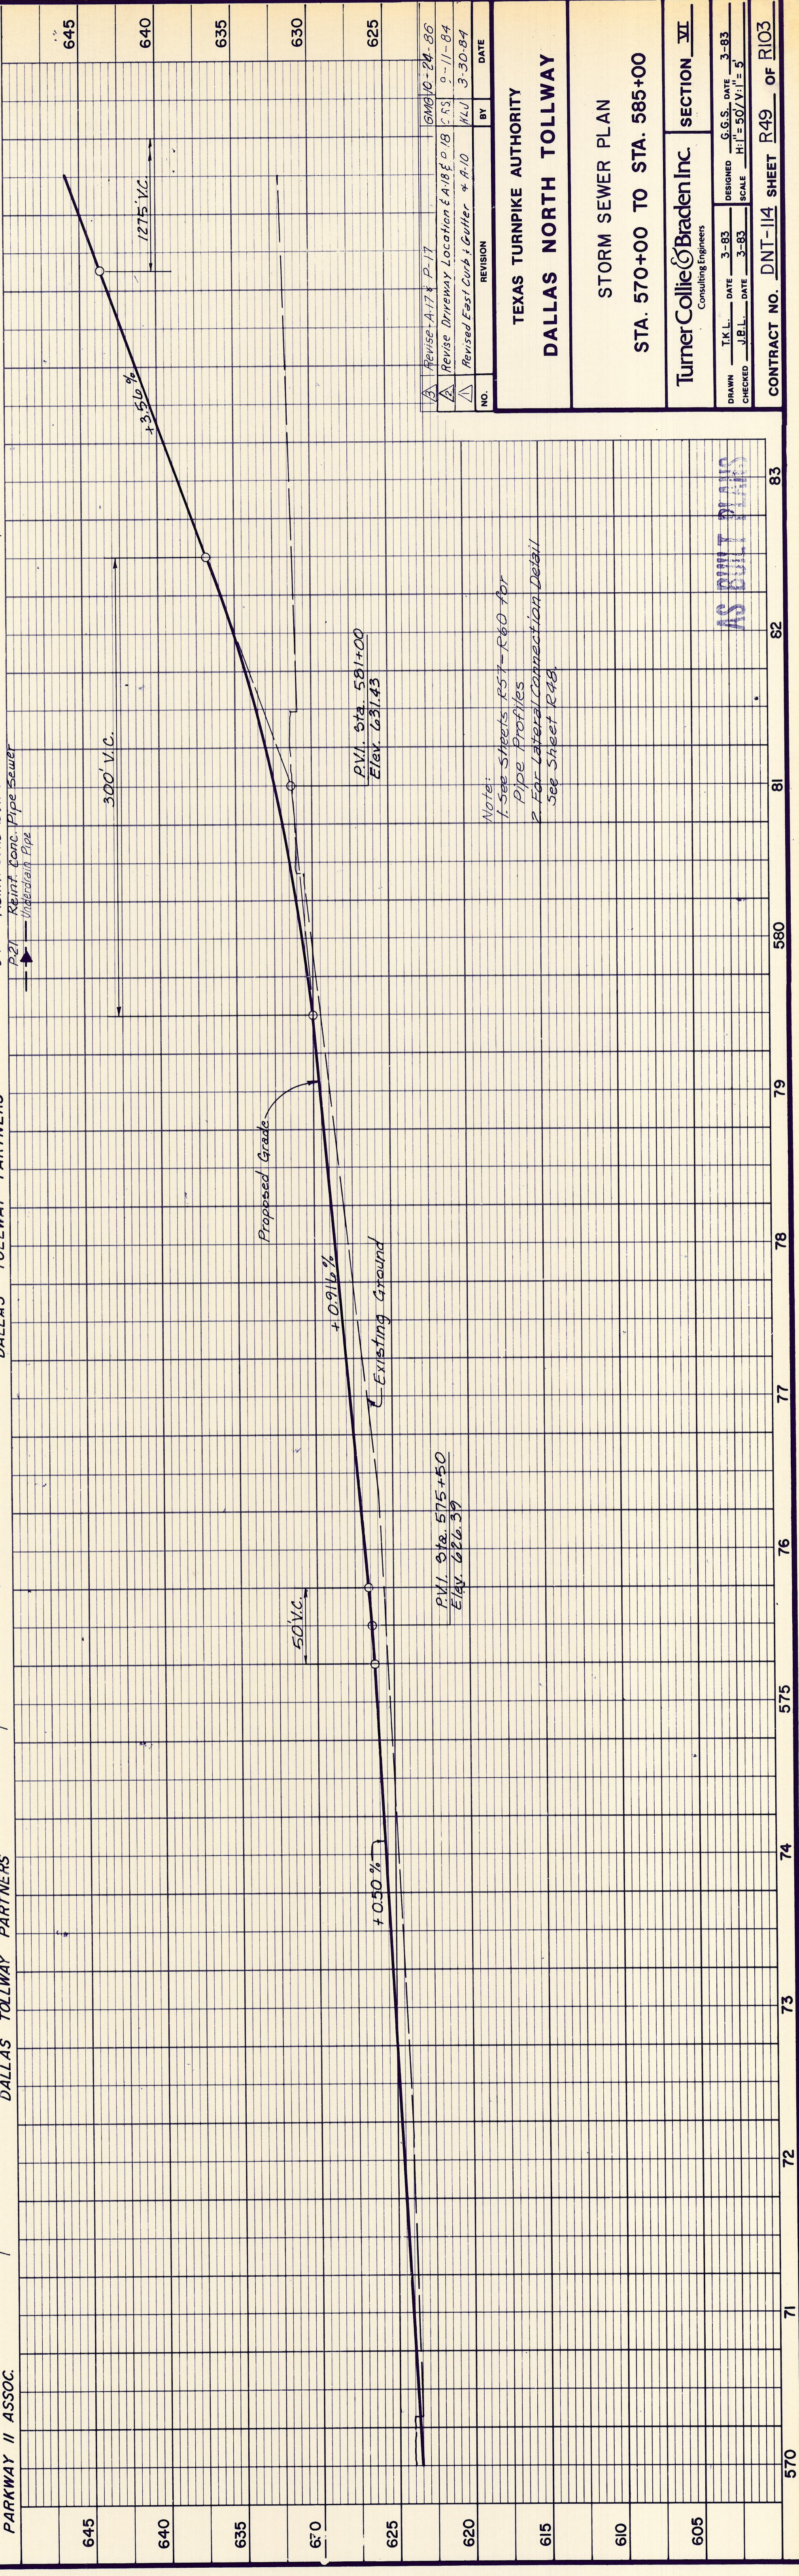

NO.	REVISION	DATE	BY
1	Revise A-17 & P-17	10/10/04	PL
2	Revise Driveway Location & A-18 & P-18	9-11-04	PL
3	Revise East Curb, Gutter, & P-10	3-30-04	PL

TEXAS TURNPIKE AUTHORITY  
**DALLAS NORTH TOLLWAY**  
 STORM SEWER PLAN  
 STA. 570+00 TO STA. 585+00  
 TurnerCollie & Braden Inc  
 Consulting Engineers  
 SECTION VI  
 CONTRACT NO. DNT-114 SHEET R49 OF R103

**Notes:**  
 1. See Sheets R57-R60 for Pipe Profiles  
 2. For Lateral Connection Detail See Sheet R45

AS BUILT PLANS