
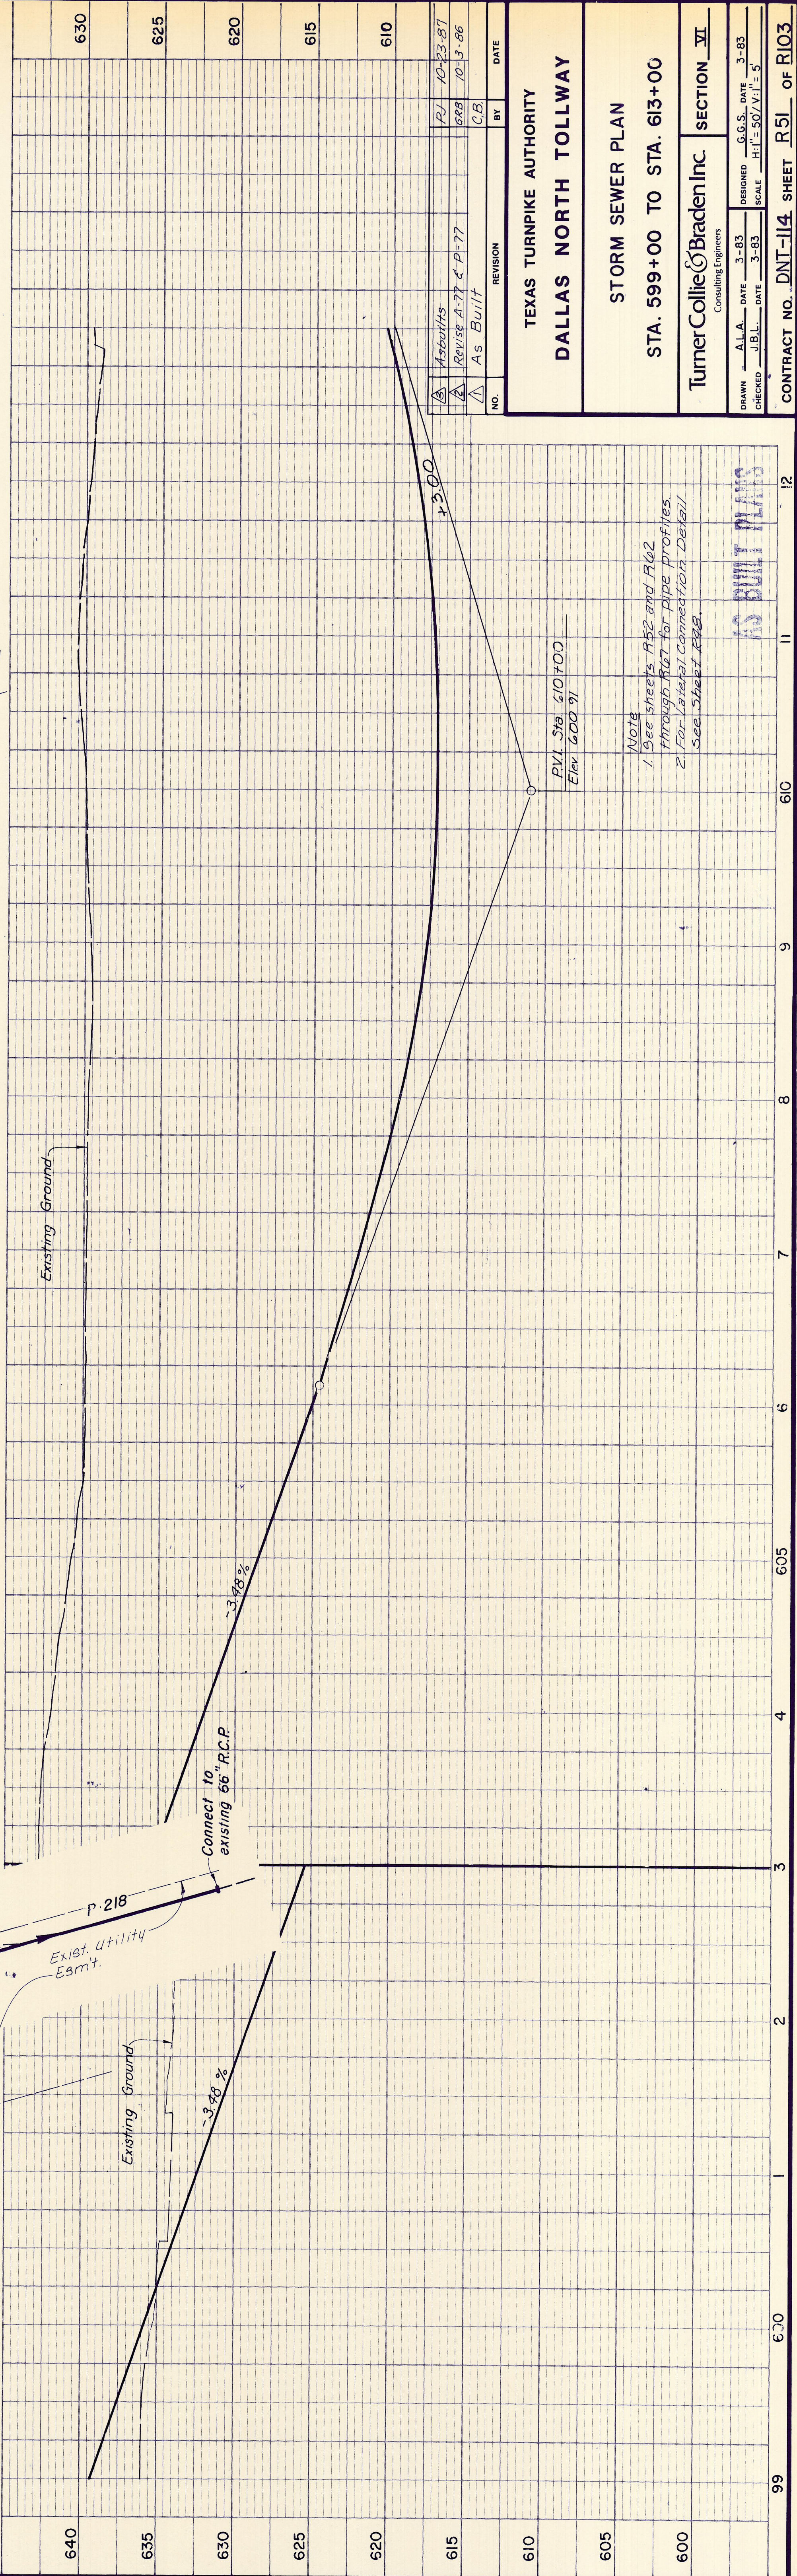


HOTEL INVESTORS TRUST  
FIRST TEXAS SAVINGS ASSOC.  
PLAZA AT THE  
QUORUM ASSOC.

LEGEND  
Horizontal Curve Number  
Inlet Designation  
Existing Light Pole  
Existing Power/Telephone Pole  
Existing Tree  
Existing Fence  
Existing Building  
Storm Sewer Manhole  
Reinf. Conc. Box Sewer  
Reinf. Conc. Pipe Sewer  
Underdrain Pipe

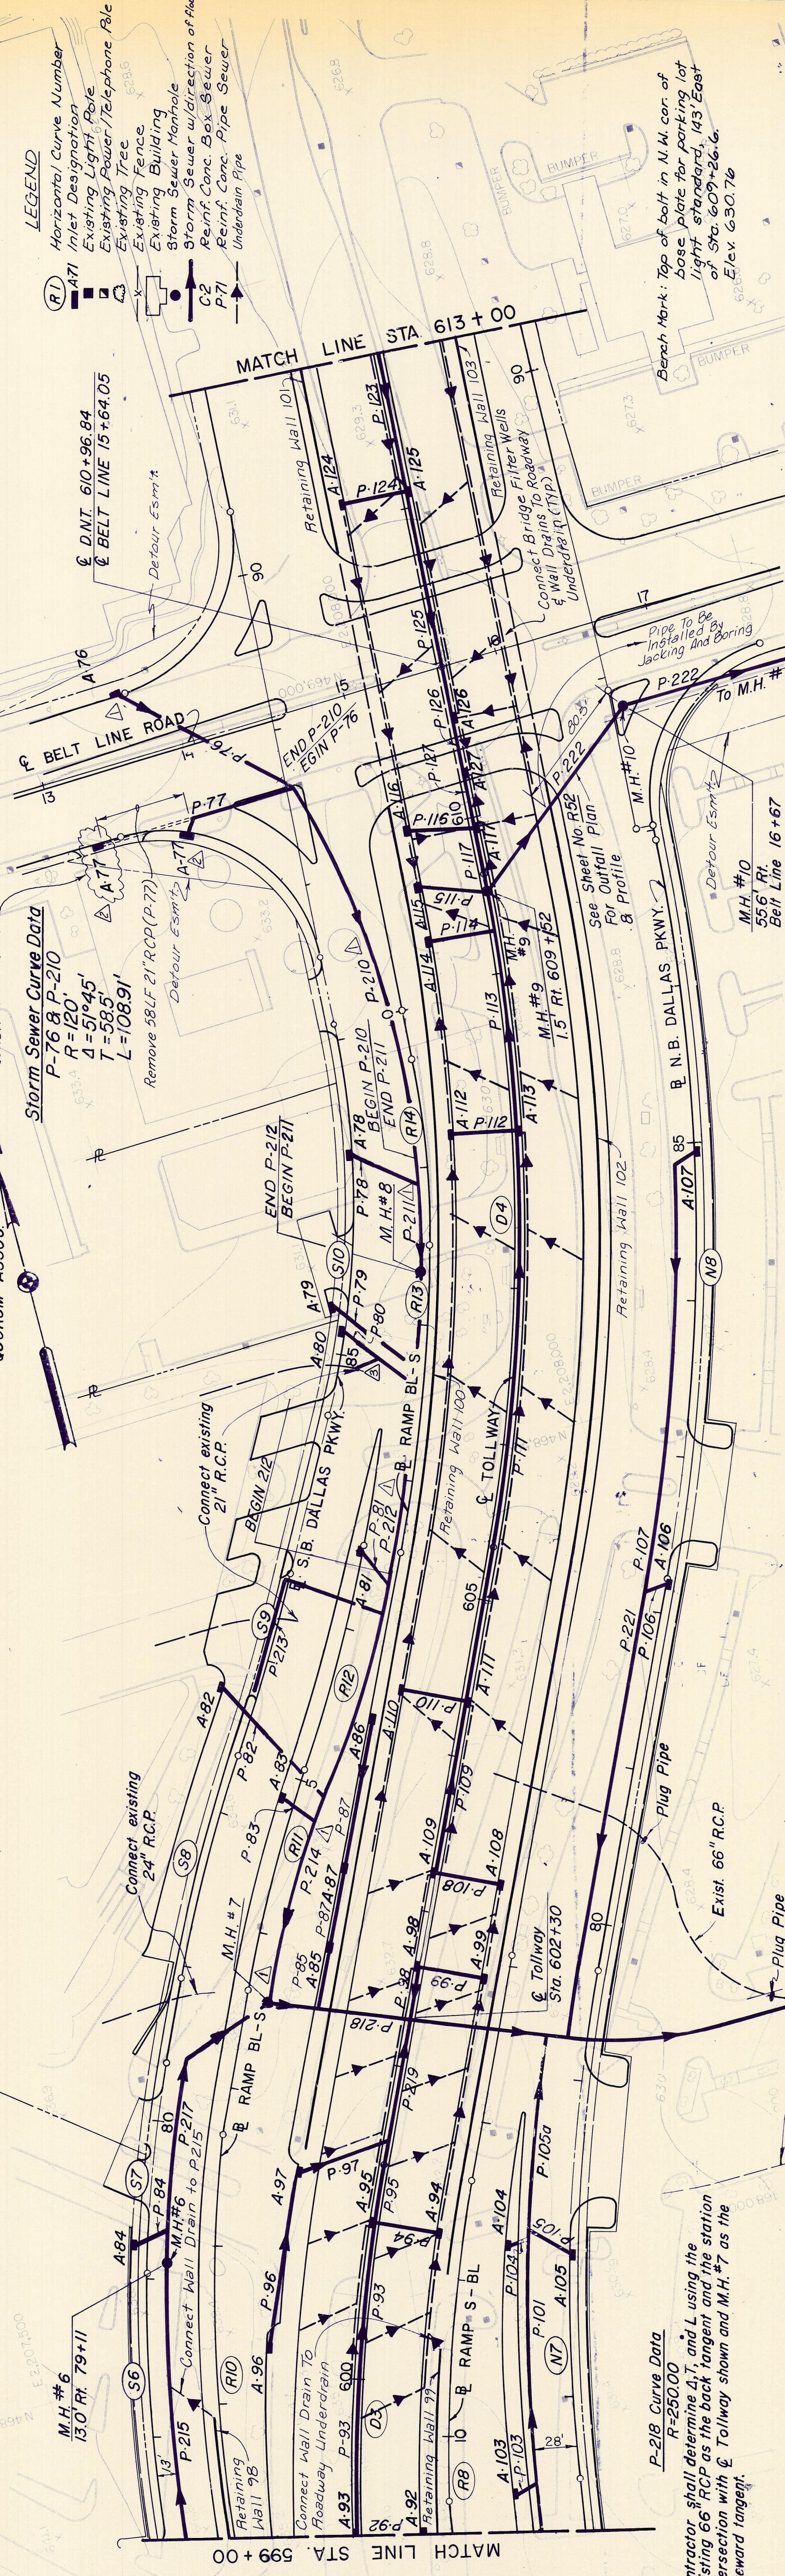

Notes:  
1. See sheets R52 and R62 through R67 for pipe profiles.  
2. For lateral connections Detail 11 See Sheet R48.

REVISION		BY	DATE
1	As Built	C.B.	10-13-86
2	Revise A-77 & P-77		10-23-87
3	As Built		

TEXAS TURNPIKE AUTHORITY  
DALLAS NORTH TOLLWAY

STORM SEWER PLAN  
STA. 599+00 TO STA. 613+00

Turner Collie & Braden Inc  
Consulting Engineers  
SECTION VII

CONTRACT NO. DNT-114 SHEET R51 OF R103  
DRAWN: A.L.A. DATE: 3-83 DESIGNED: G.S.S. DATE: 3-83  
CHECKED: J.B.L. DATE: 3-83 SCALE: H1=50'/V1=5'