


Storm Sewer Curve Data
 $A = 16^{\circ}29'36''$
 $R = 164.0'$
 $T = 23.77'$
 $L = 47.21'$

Bench Mark: Top of bolt in N.W. cor. of base plate for parking lot light standard, 145 East of Sta 600+26.6 Elev. 6307.6

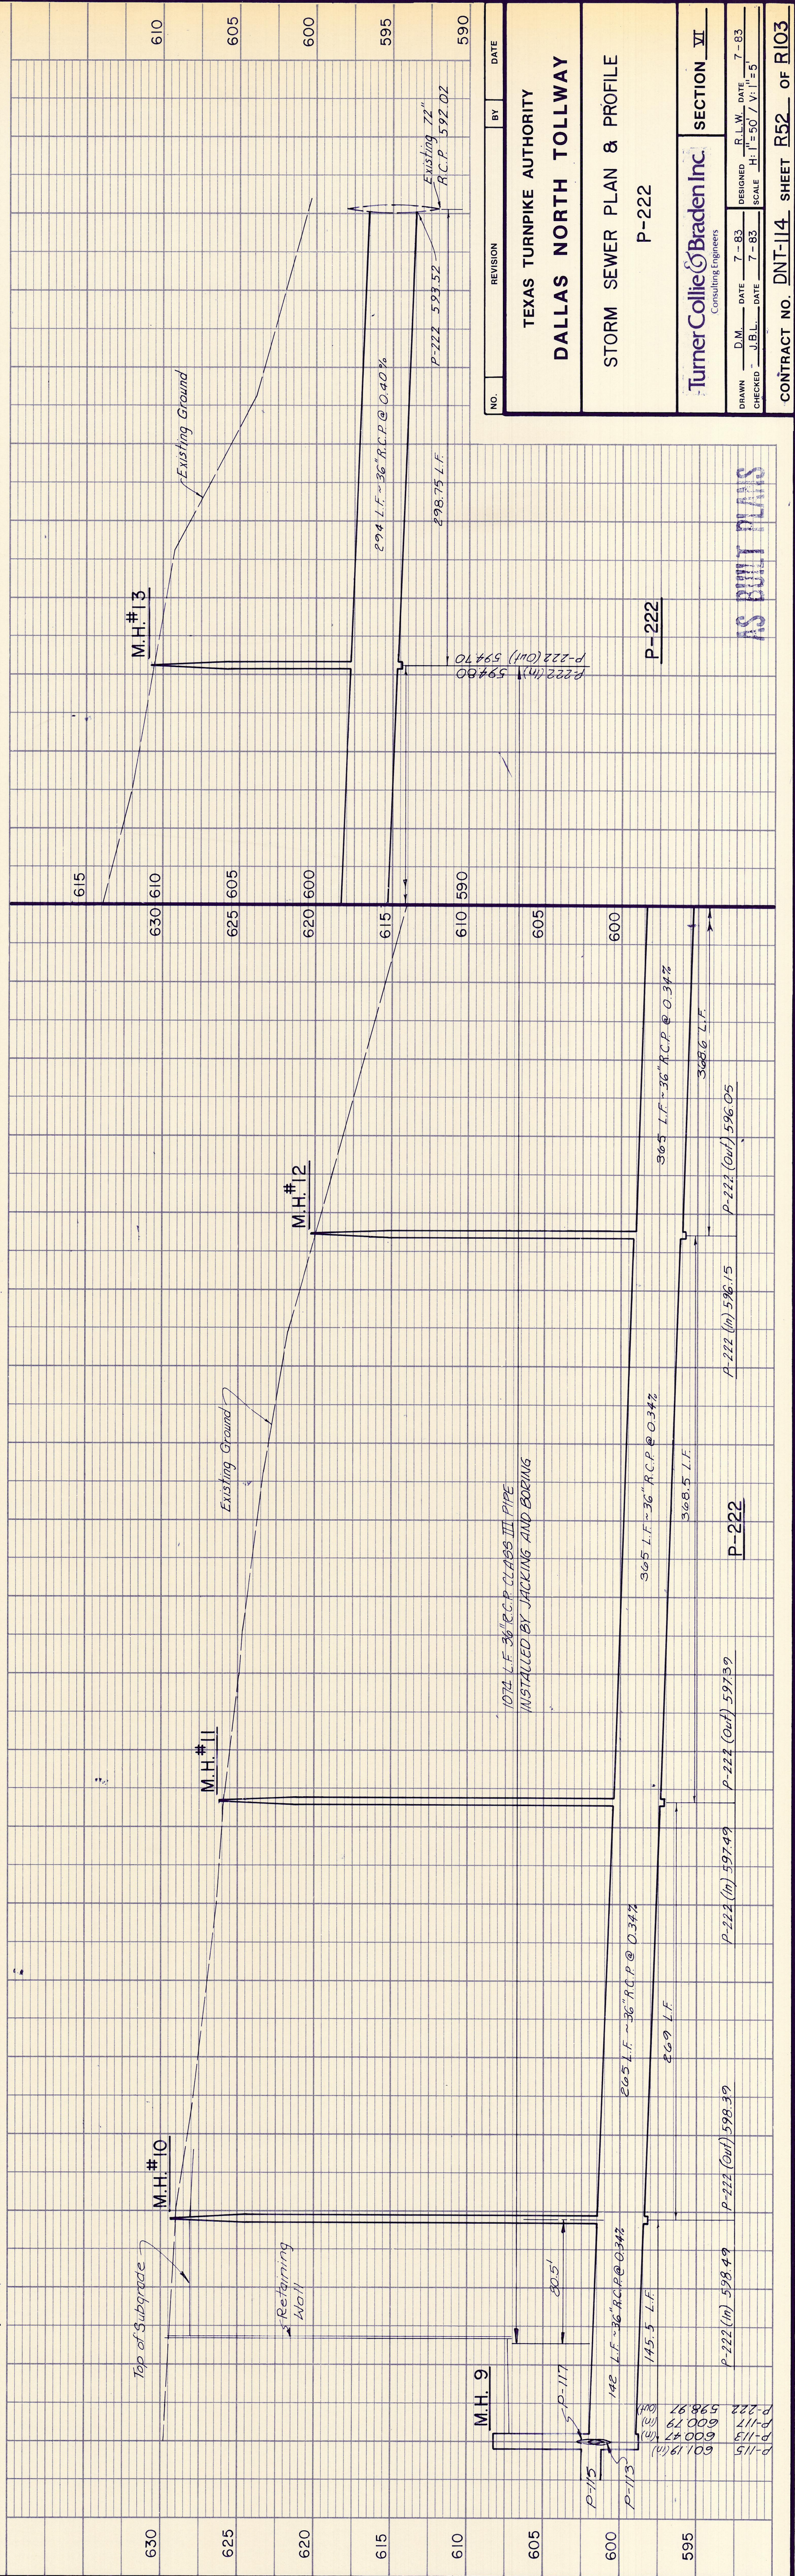

| NO. | REVISION | BY | DATE |
|-----|----------|----|------|
| | | | |

TEXAS TURNPIKE AUTHORITY
DALLAS NORTH TOLLWAY
 STORM SEWER PLAN & PROFILE
 P-222

TurnerCollie & Braden Inc.
 Consulting Engineers
 SECTION VII

DRAWN: J.B.L. DATE: 7-83
 CHECKED: J.B.L. DATE: 7-83
 DESIGNER: R.L.W. DATE: 7-83
 SCALE: H: 1"=50' V: 1"=5'

CONTRACT NO. DNT-114 SHEET R52 OF R103

AS BUILT PLANS