
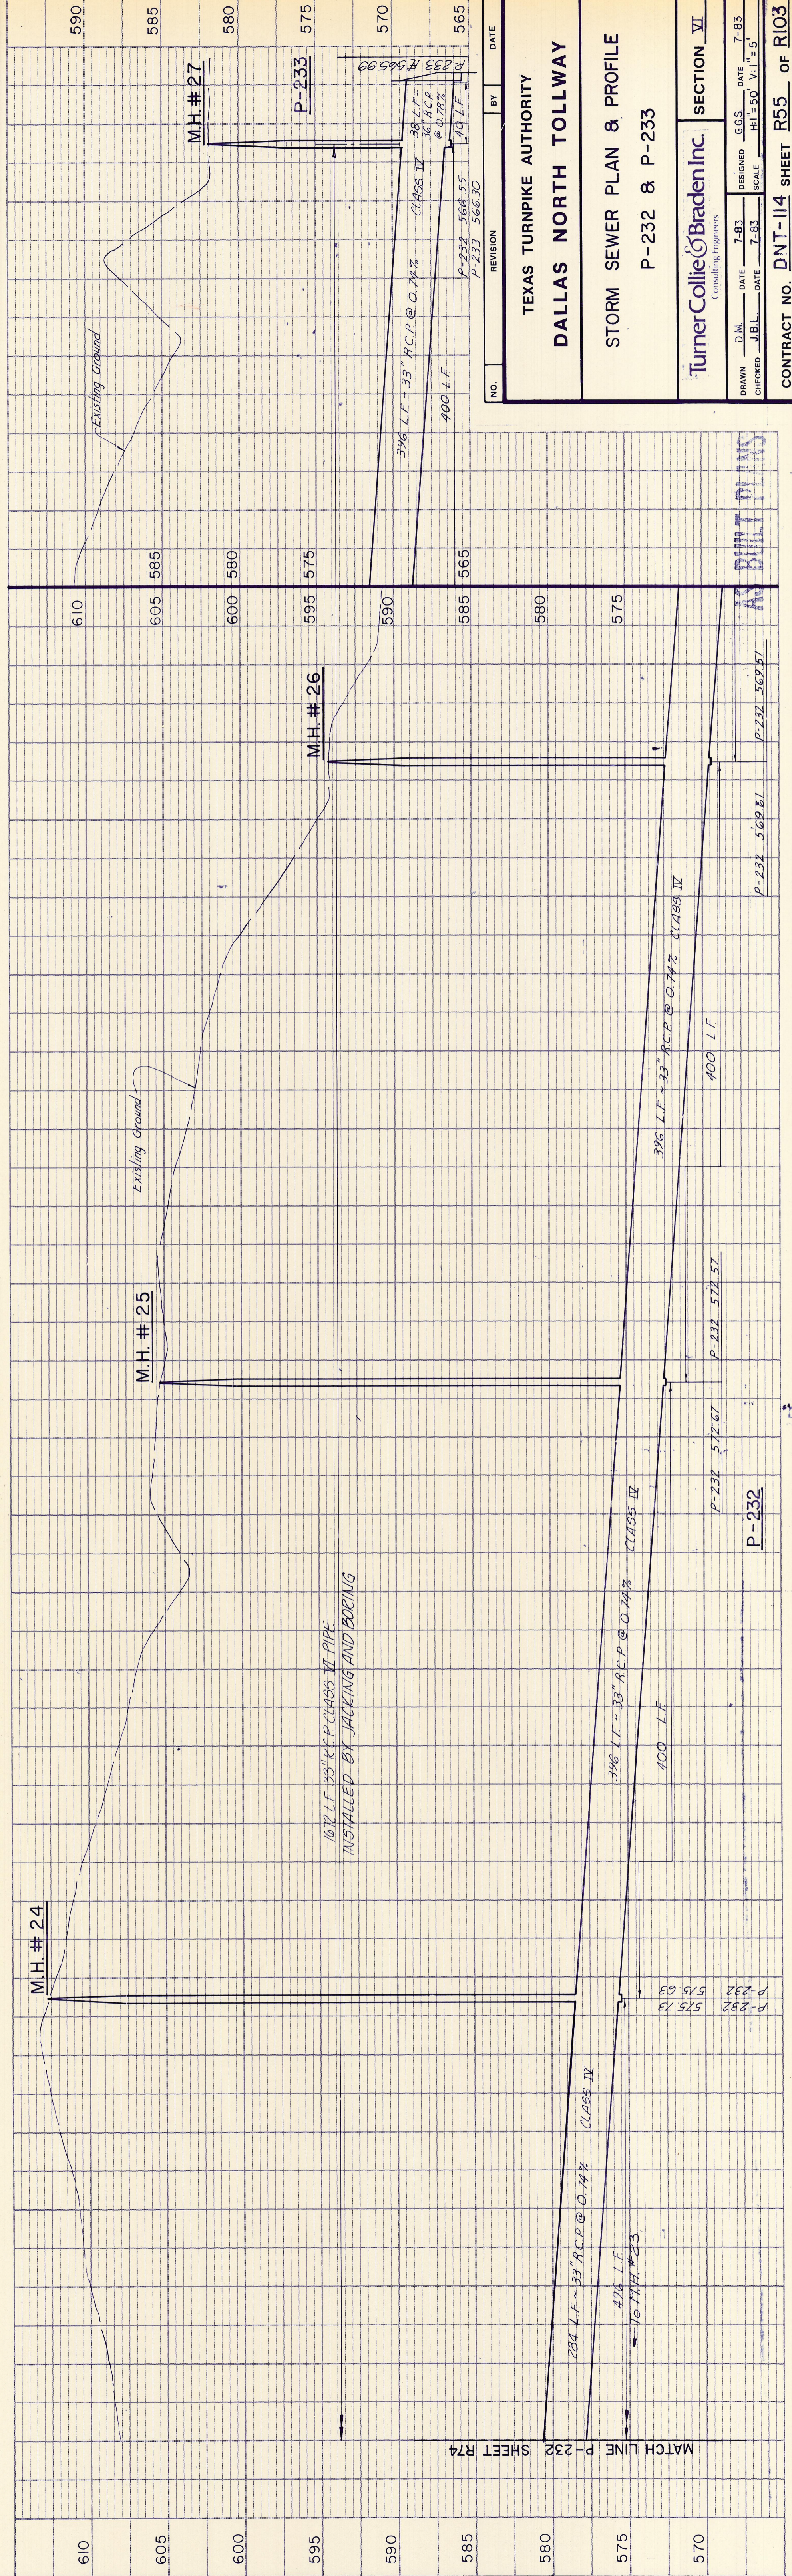


SEE SHEET R54
MATCH LINE STA. 6244+00

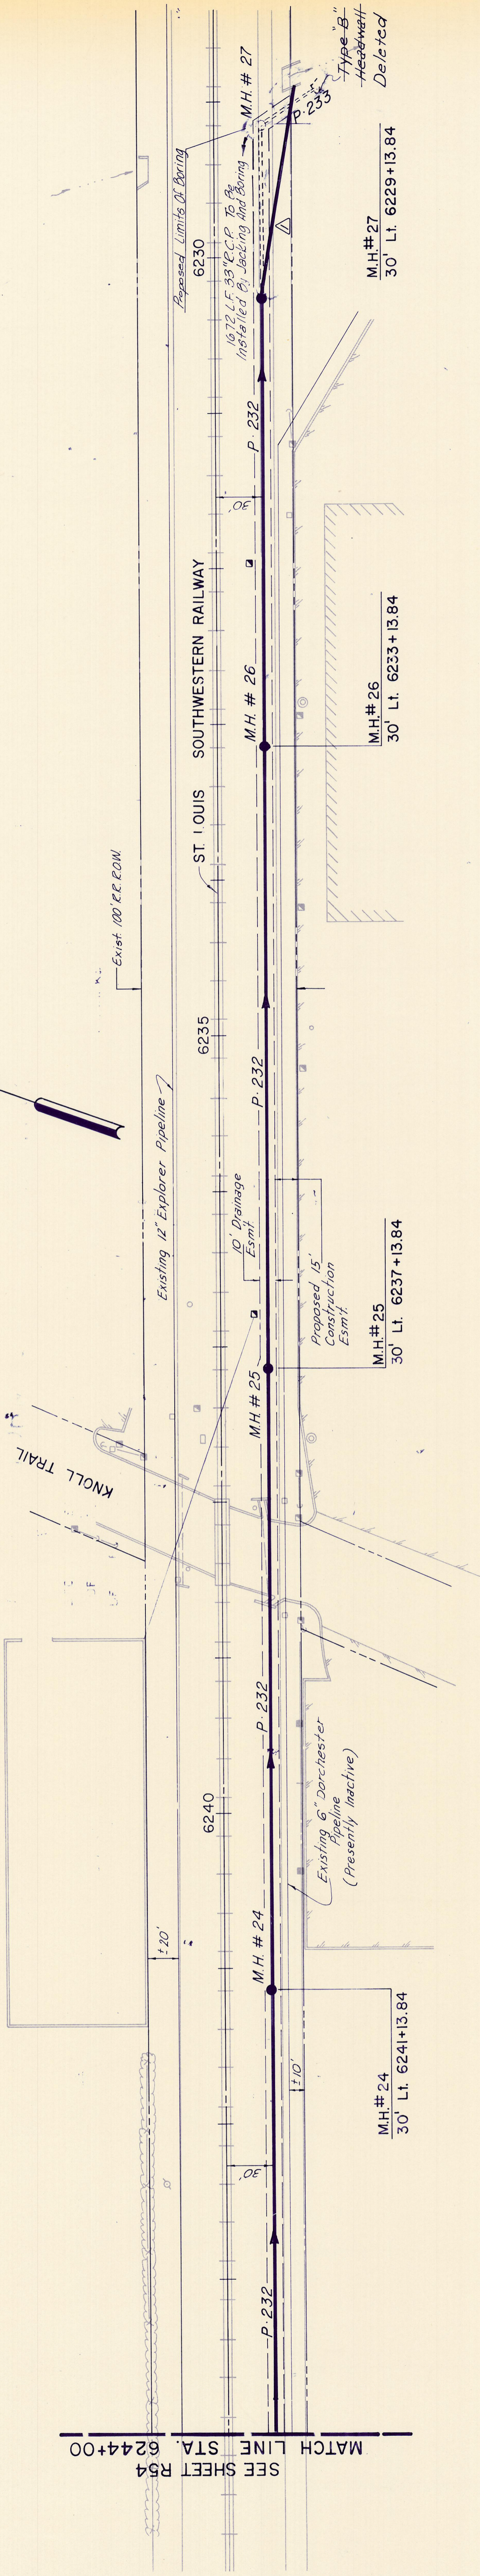

NO.	REVISION	BY	DATE

TEXAS TURNPIKE AUTHORITY
DALLAS NORTH TOLLWAY

STORM SEWER PLAN & PROFILE
P-232 & P-233

TurnerCollieBraden Inc. SECTION VI

DRAWN	D.M.	DATE	7-83	DESIGNED	G.G.S.	DATE	7-83
CHECKED	J.B.L.	DATE	7-83	SCALE	1"=50'	V.I.=5'	

CONTRACT NO. DNT-114 SHEET R55 of R103

AS BUILT PINS