
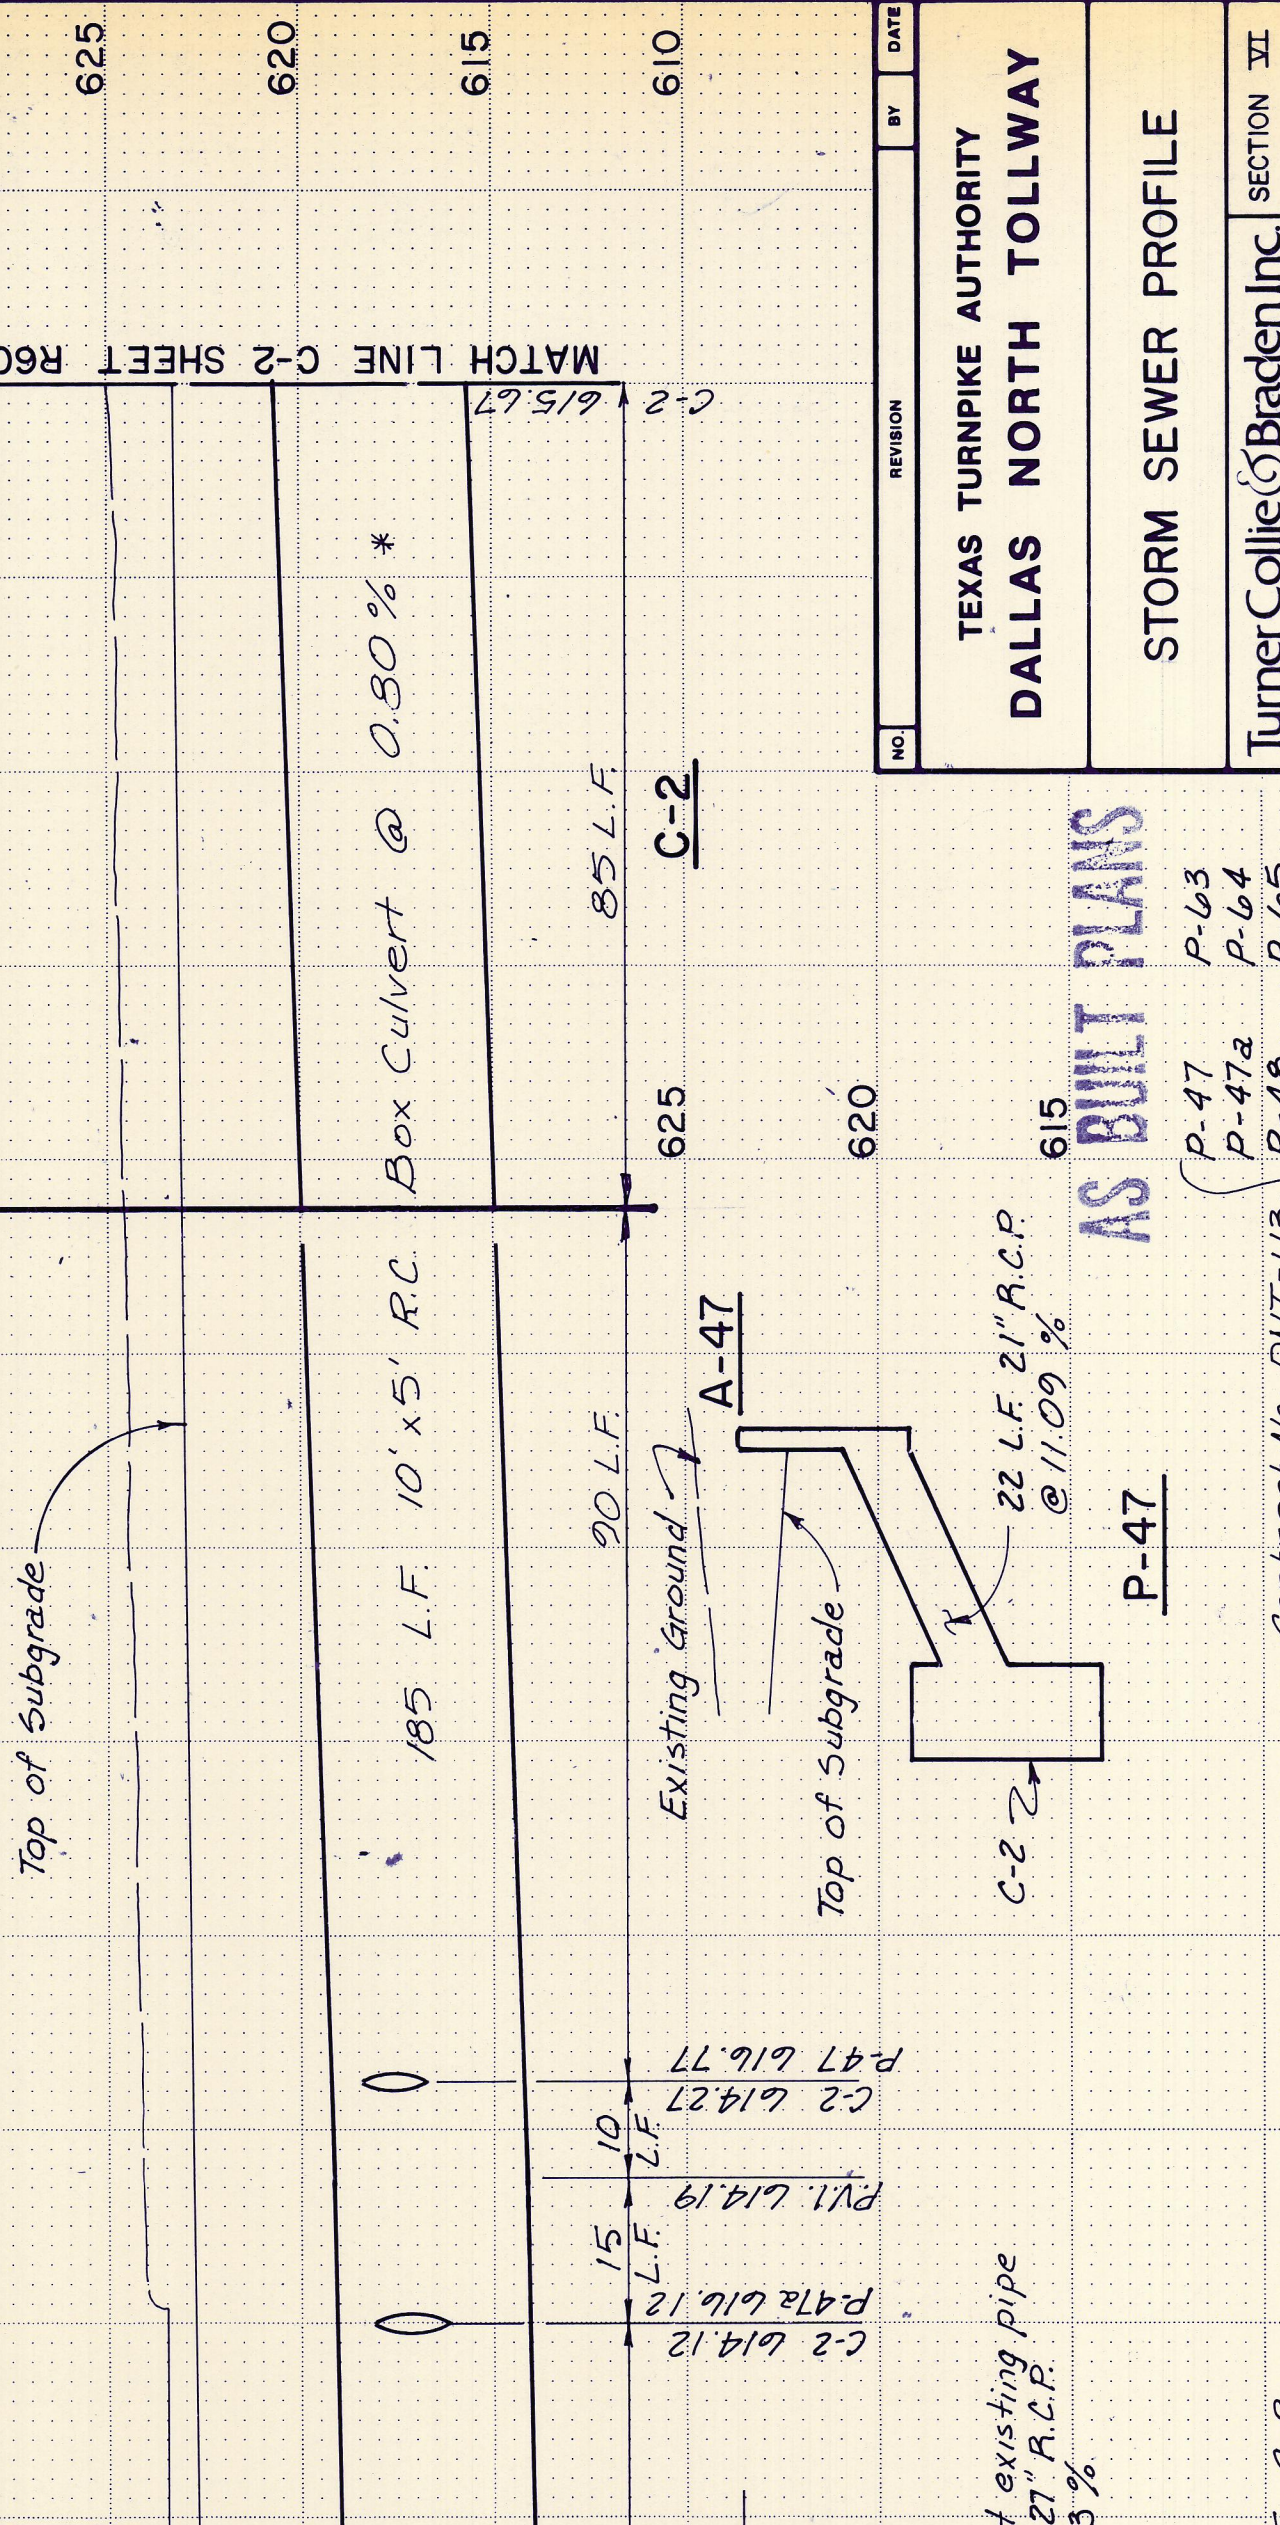


Note: 1. All R.C.P. to be Class III unless noted.
 2. See sheet R40 for horizontal location of pipes.

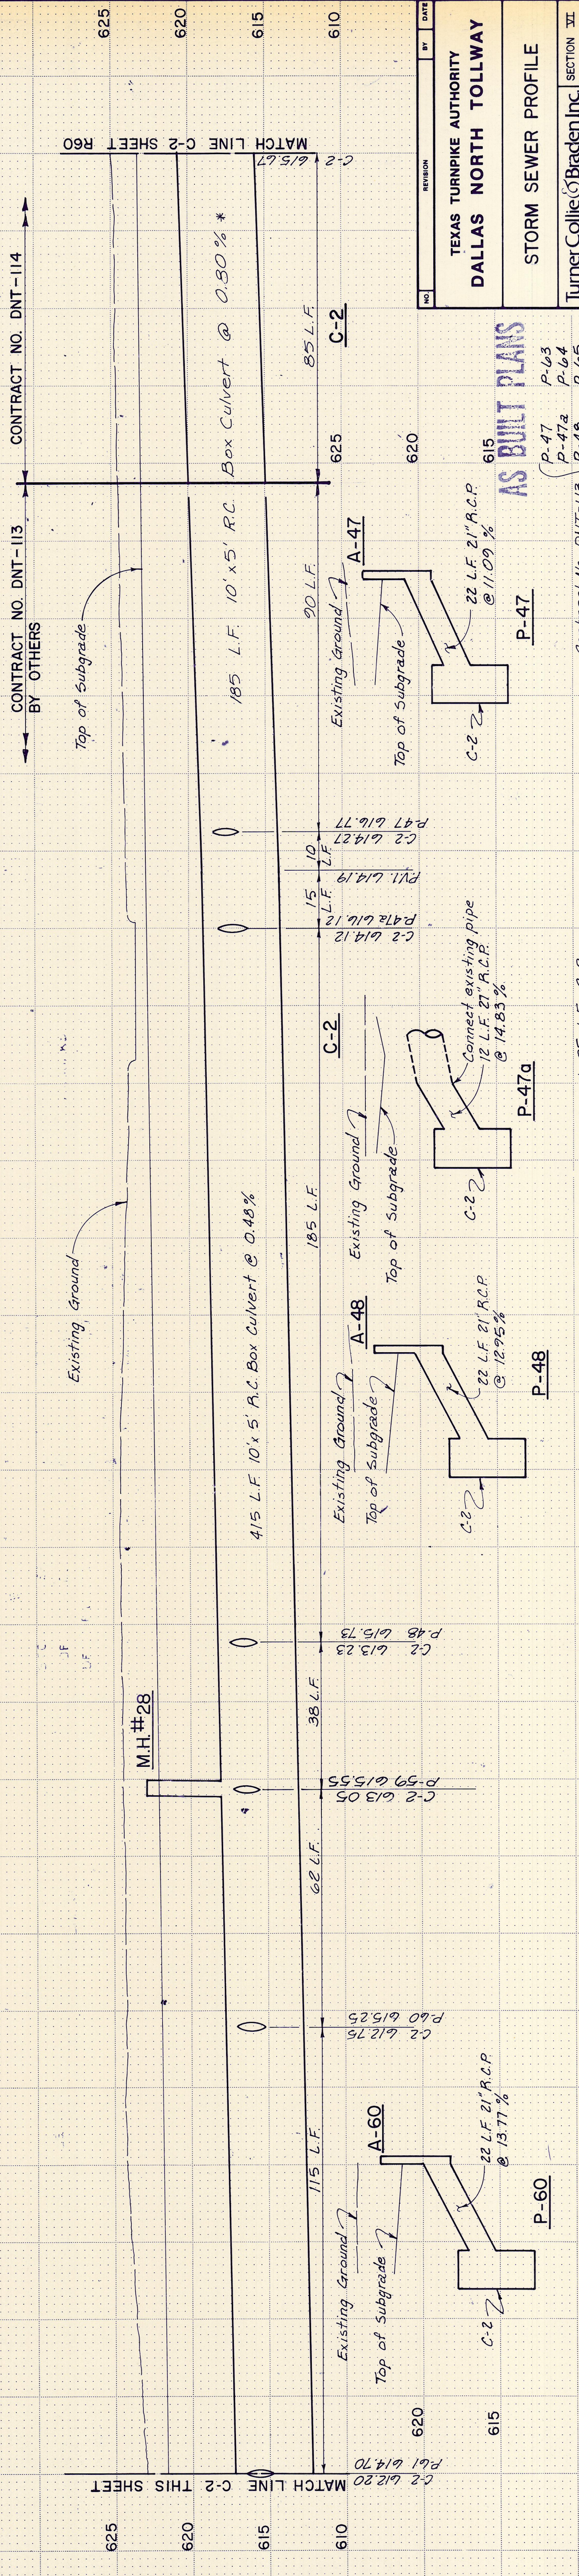

AS BUILT PLANS

TEXAS TURNPIKE AUTHORITY
DALLAS NORTH TOLLWAY
 STORM SEWER PROFILE
 TurnerCollie/Bladen Inc. SECTION VII
 DRAWN: G.G.S. DATE: 7-83
 CHECKED: J.B.L. DATE: 7-83
 REVISION: J.B.L. DATE: 7-83
 CONTRACT NO. DNT-114 SHEET R61 OF R103

- P-47
- P-63
- P-47a
- P-64
- P-48
- P-65
- P-60
- P-61
- P-62
- M.H.#28

* 85 L.F. C-2
 This Contract No. DNT-114

Contract No. DNT-113
 By Others