


Existing Ground

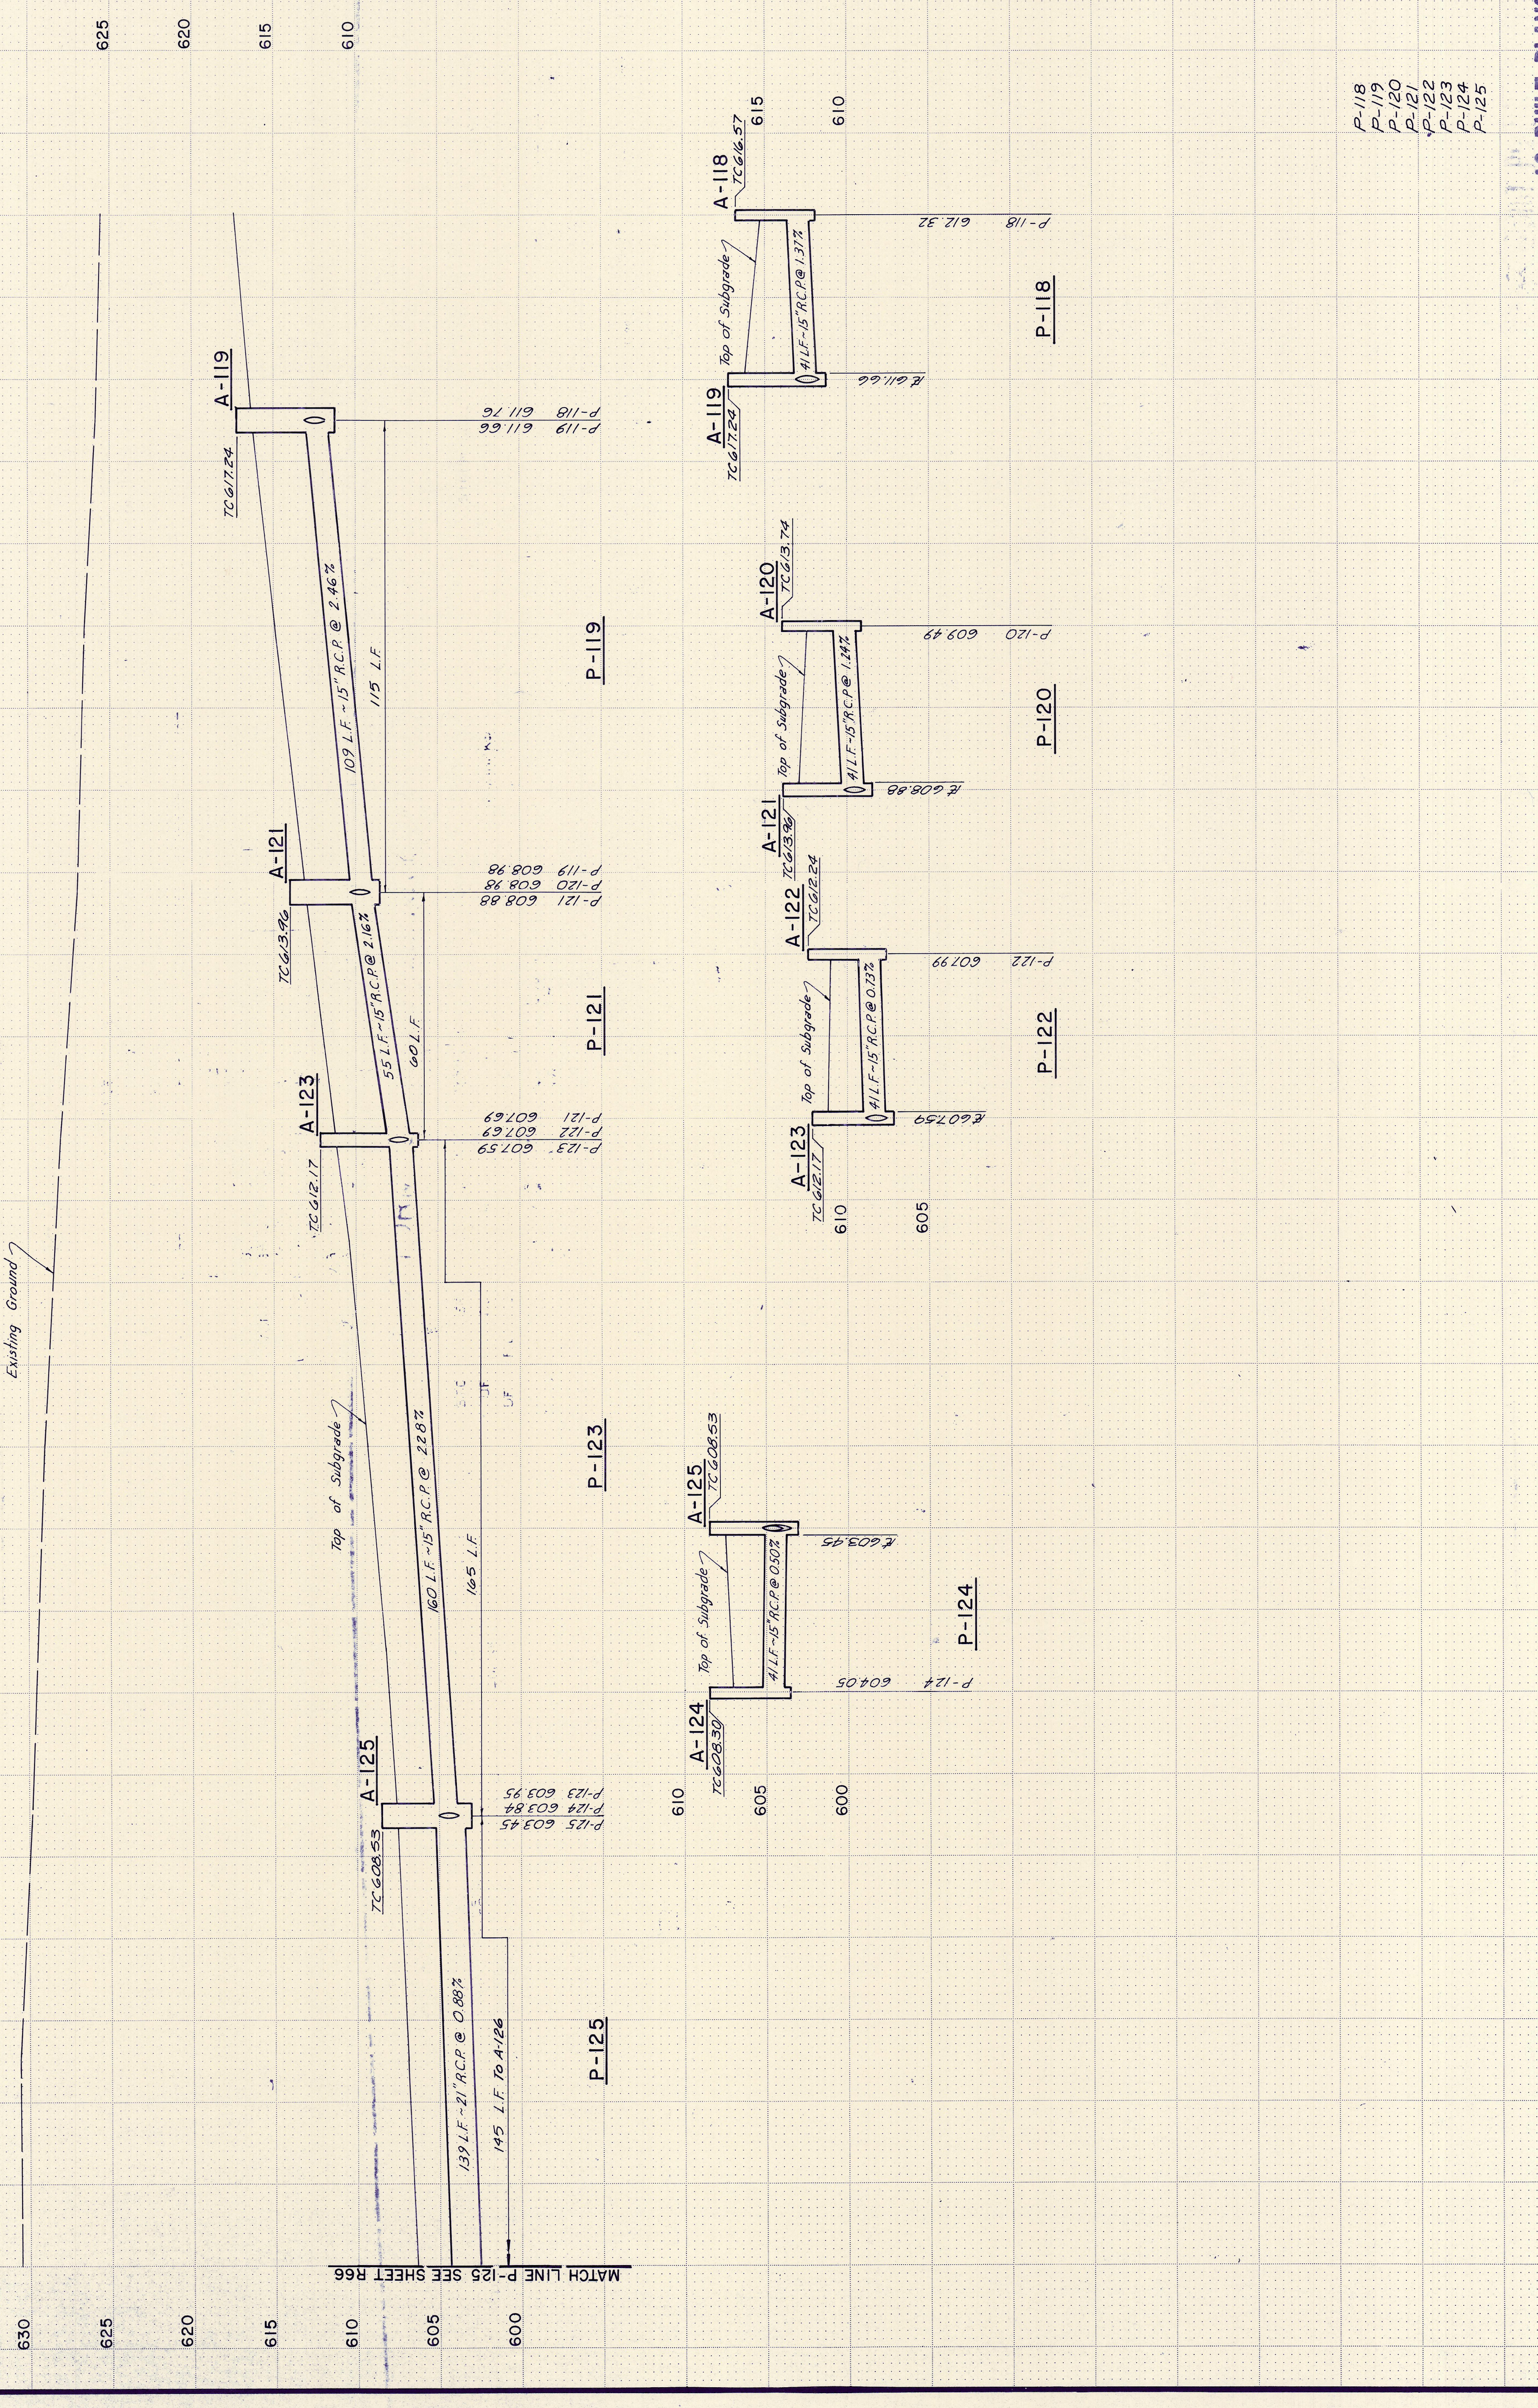

MATCH LINE P-125 SEE SHEET R66

Note: 1. All R.C.P. to be Class III unless noted.
 2. See sheets 51 & 53 for horizontal location of pipes.

NO.	REVISION	BY	DATE
TEXAS TURNPIKE AUTHORITY DALLAS NORTH TOLLWAY STORM SEWER PROFILE			
Turner Collicott/Bradley Inc.			SECTION VII
MADE	BY	DATE	DATE
7-83	7-83	7-83	7-83
CHIEF	SCALE	H.I. = 20' / V.I. = 5'	
J.B.L.	7-83	CONTRACT NO. DNT-114 SHEET R67 of R103	

- P-118
- P-119
- P-120
- P-121
- P-122
- P-123
- P-124
- P-125

AS BUILT PLANS