
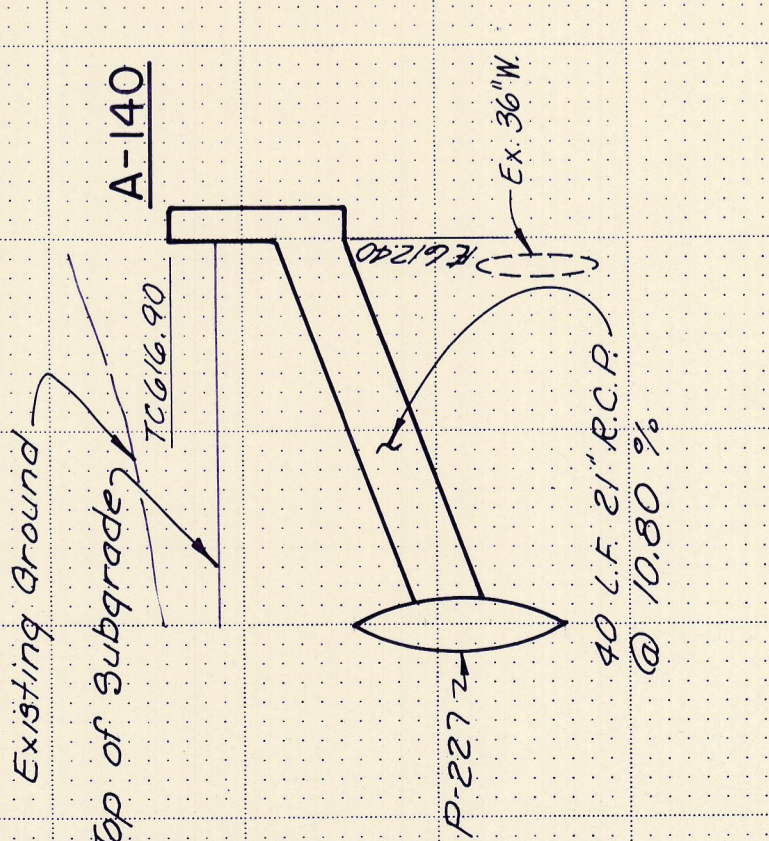
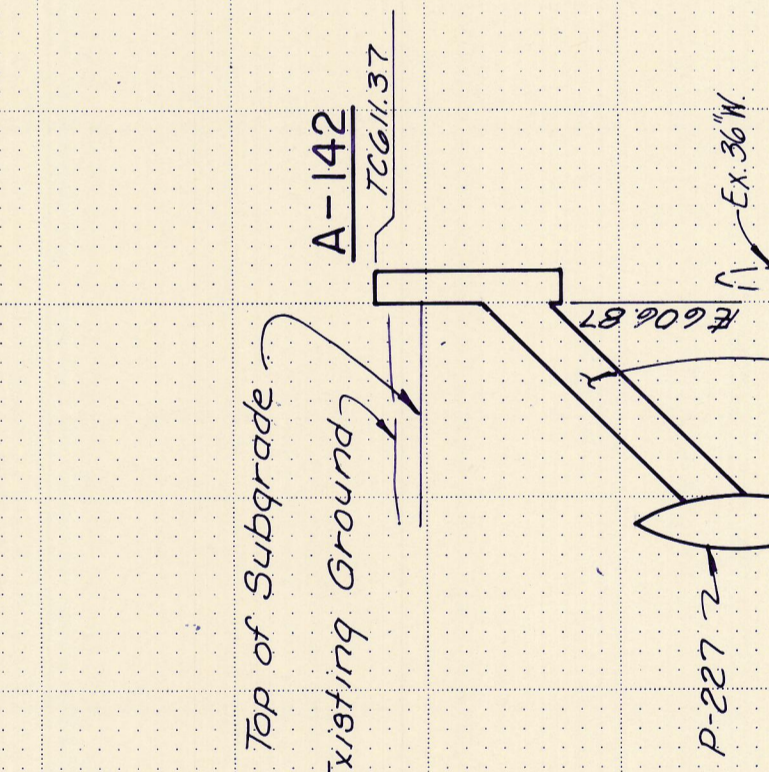
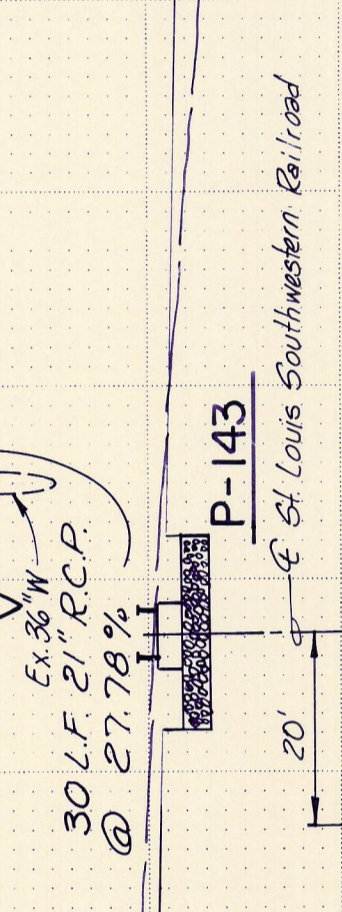


MATCH LINE P-227 THIS SHEET  
 P-227 601.77 (out)  
 P-141 603.64 (in)  
 P-227 601.87 (in)  
 MH#16  
 612.12  
 28 L.F. 66" R.C.P. @ 1.20%  
 30 L.F.




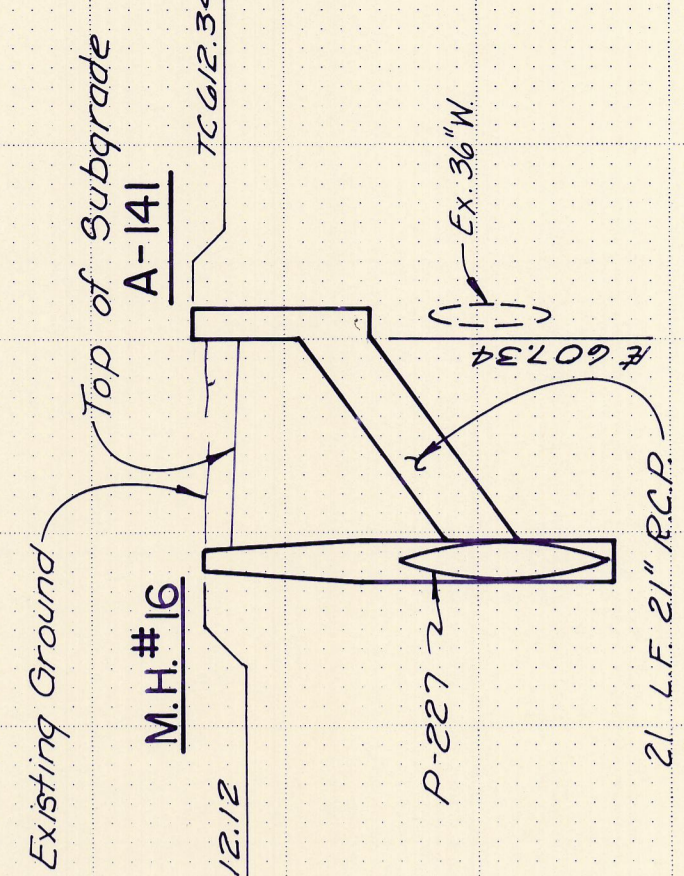


Note:  
 1. All R.C.P. to be Class III unless noted.  
 2. See sheet R69 for horizontal location of pipes.

- P-140
- P-141
- P-142
- P-143
- P-227
- M.H. #16

NO.	REVISION	BY	DATE
1	CHANGED PIPE CLASS TO III		6/25/85

TEXAS TURNPIKE AUTHORITY  
 DALLAS NORTH TOLLWAY  
 STORM SEWER PROFILE  
 TurnerCollie/Braden Inc. SECTION II  
 MADE D.W.L. DATE 7-83 TRACED A.L.A. DATE 7-83  
 CHECKED J.B.L. DATE 7-83 SCALE H1-E20 V1-E-S  
 CONTRACT NO. DNT-114 SHEET R70 OF R103

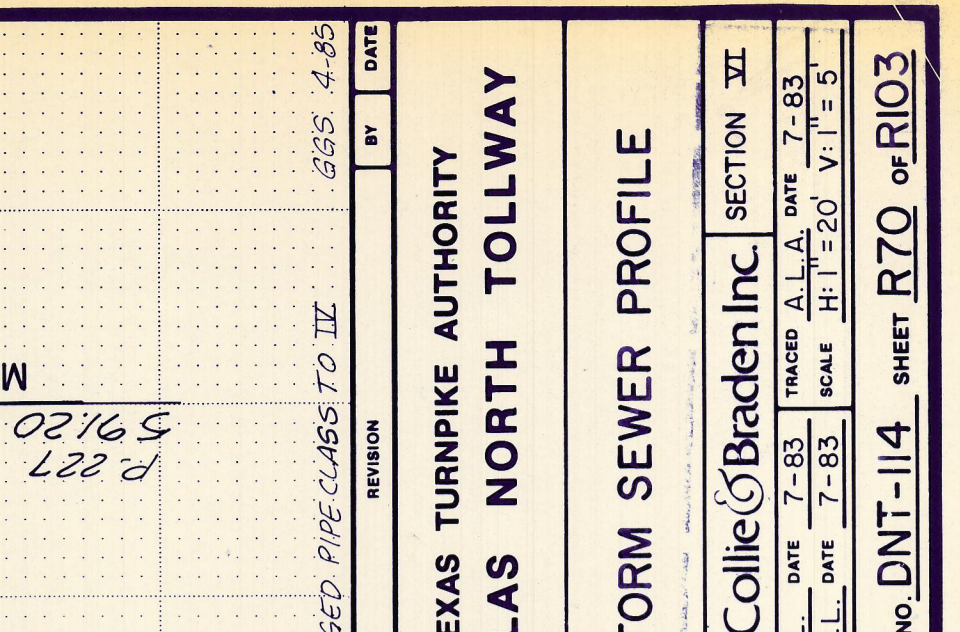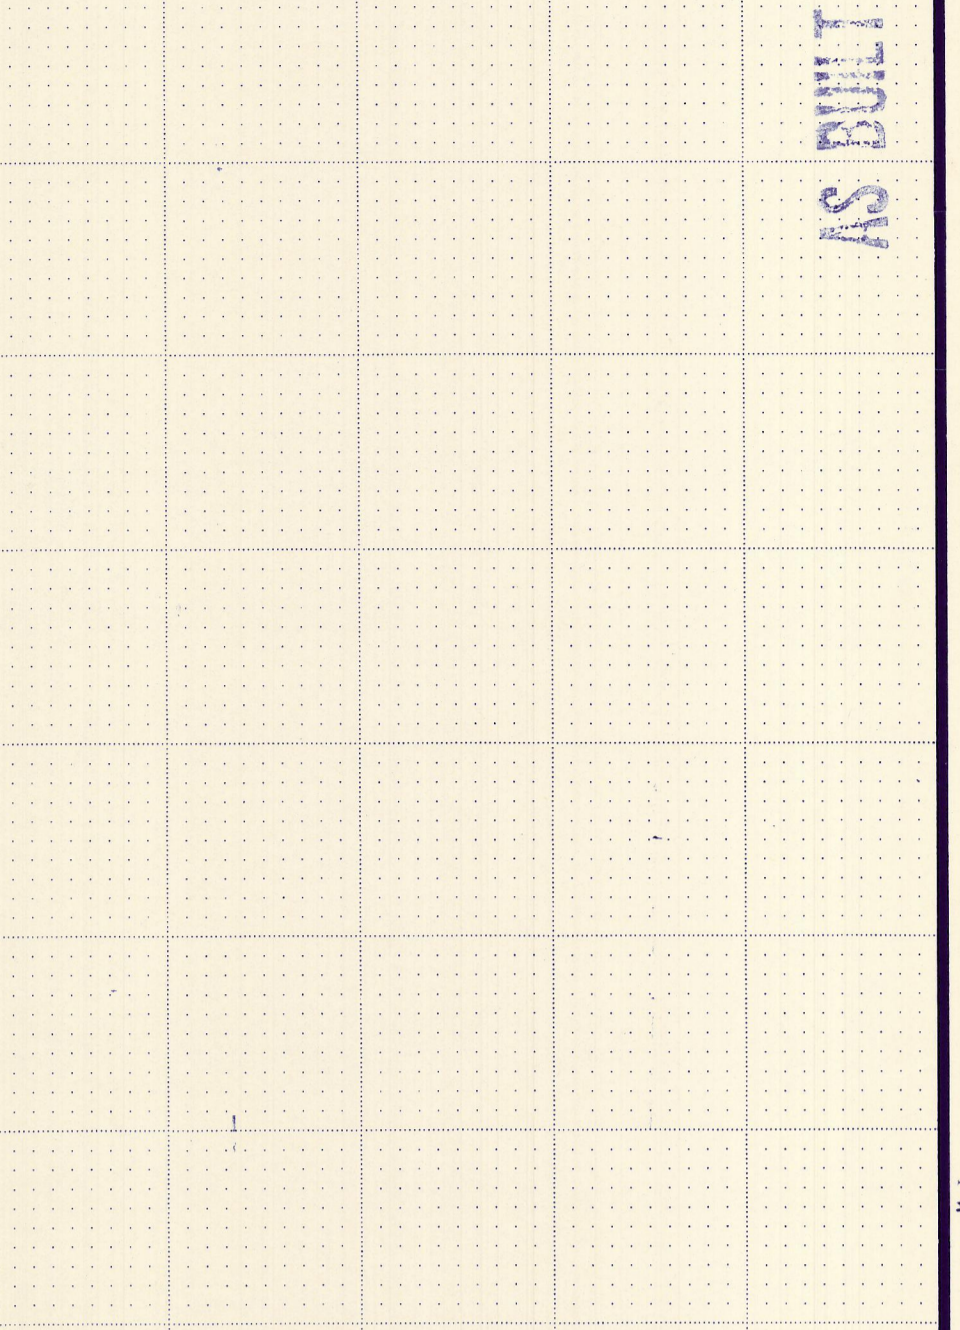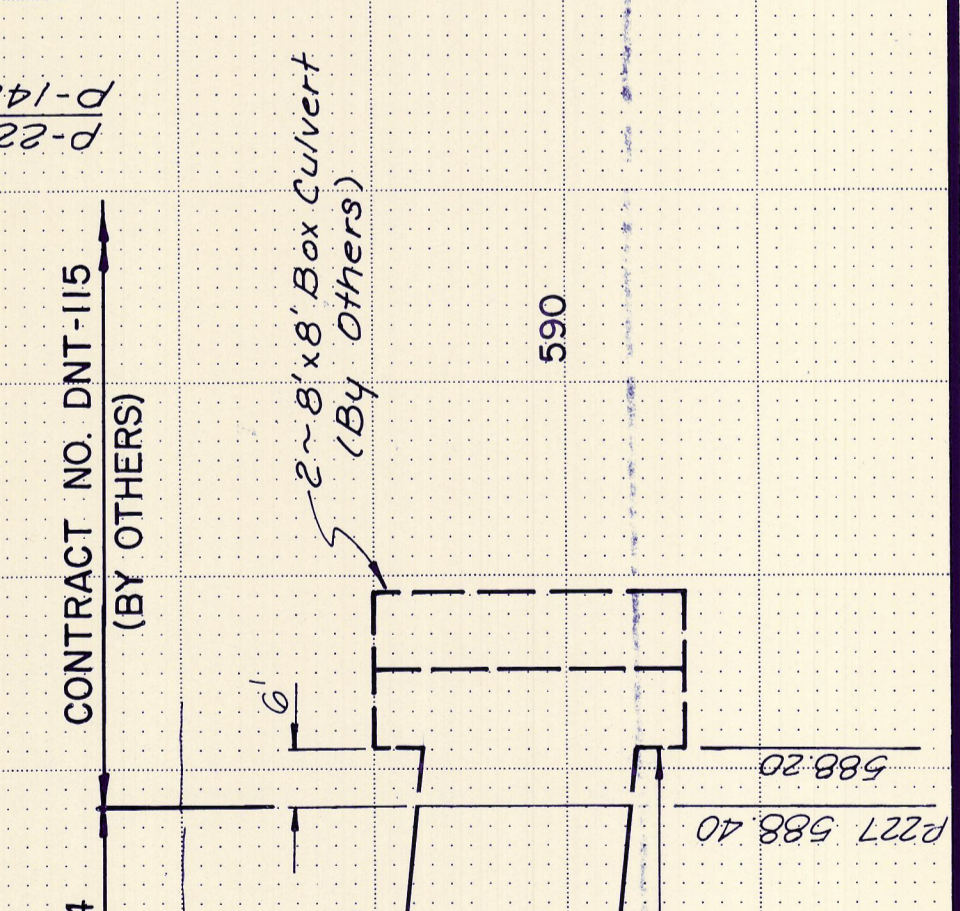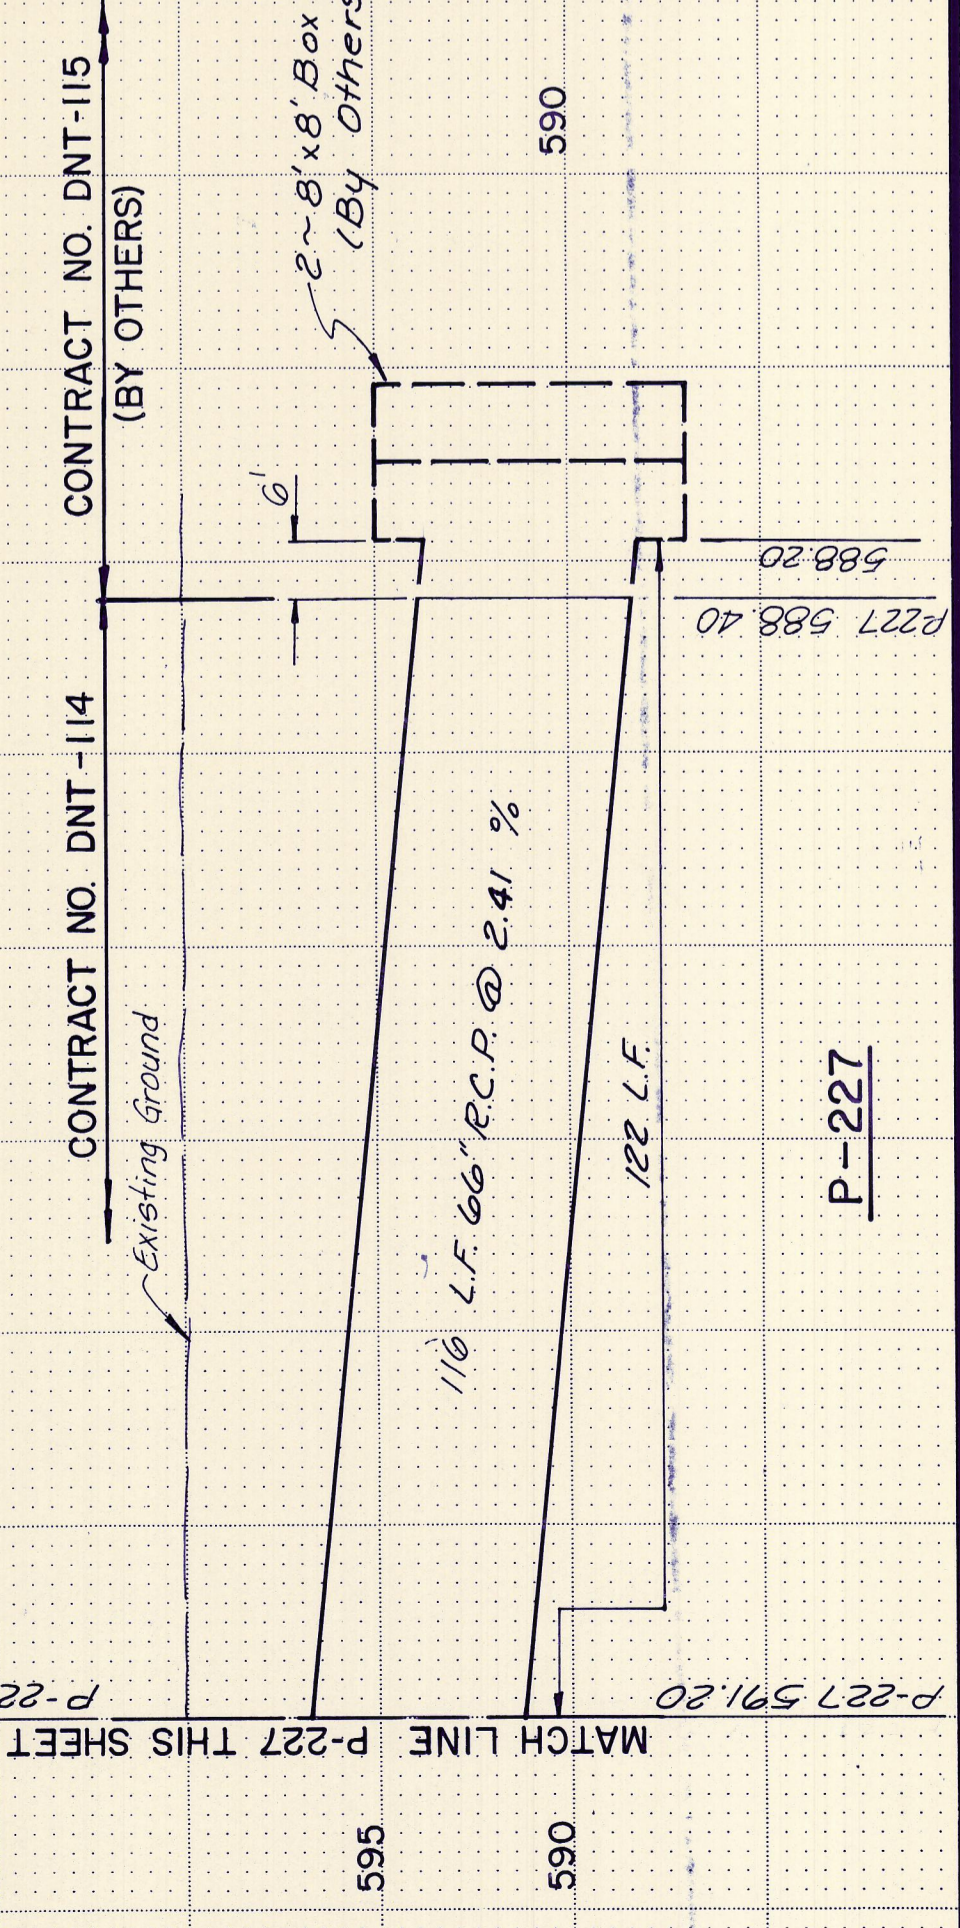

AS BUILT PLANS