


CONTRACT NO. DNT-114
(BY OTHERS)

CONTRACT NO. DNT-115
(BY OTHERS)

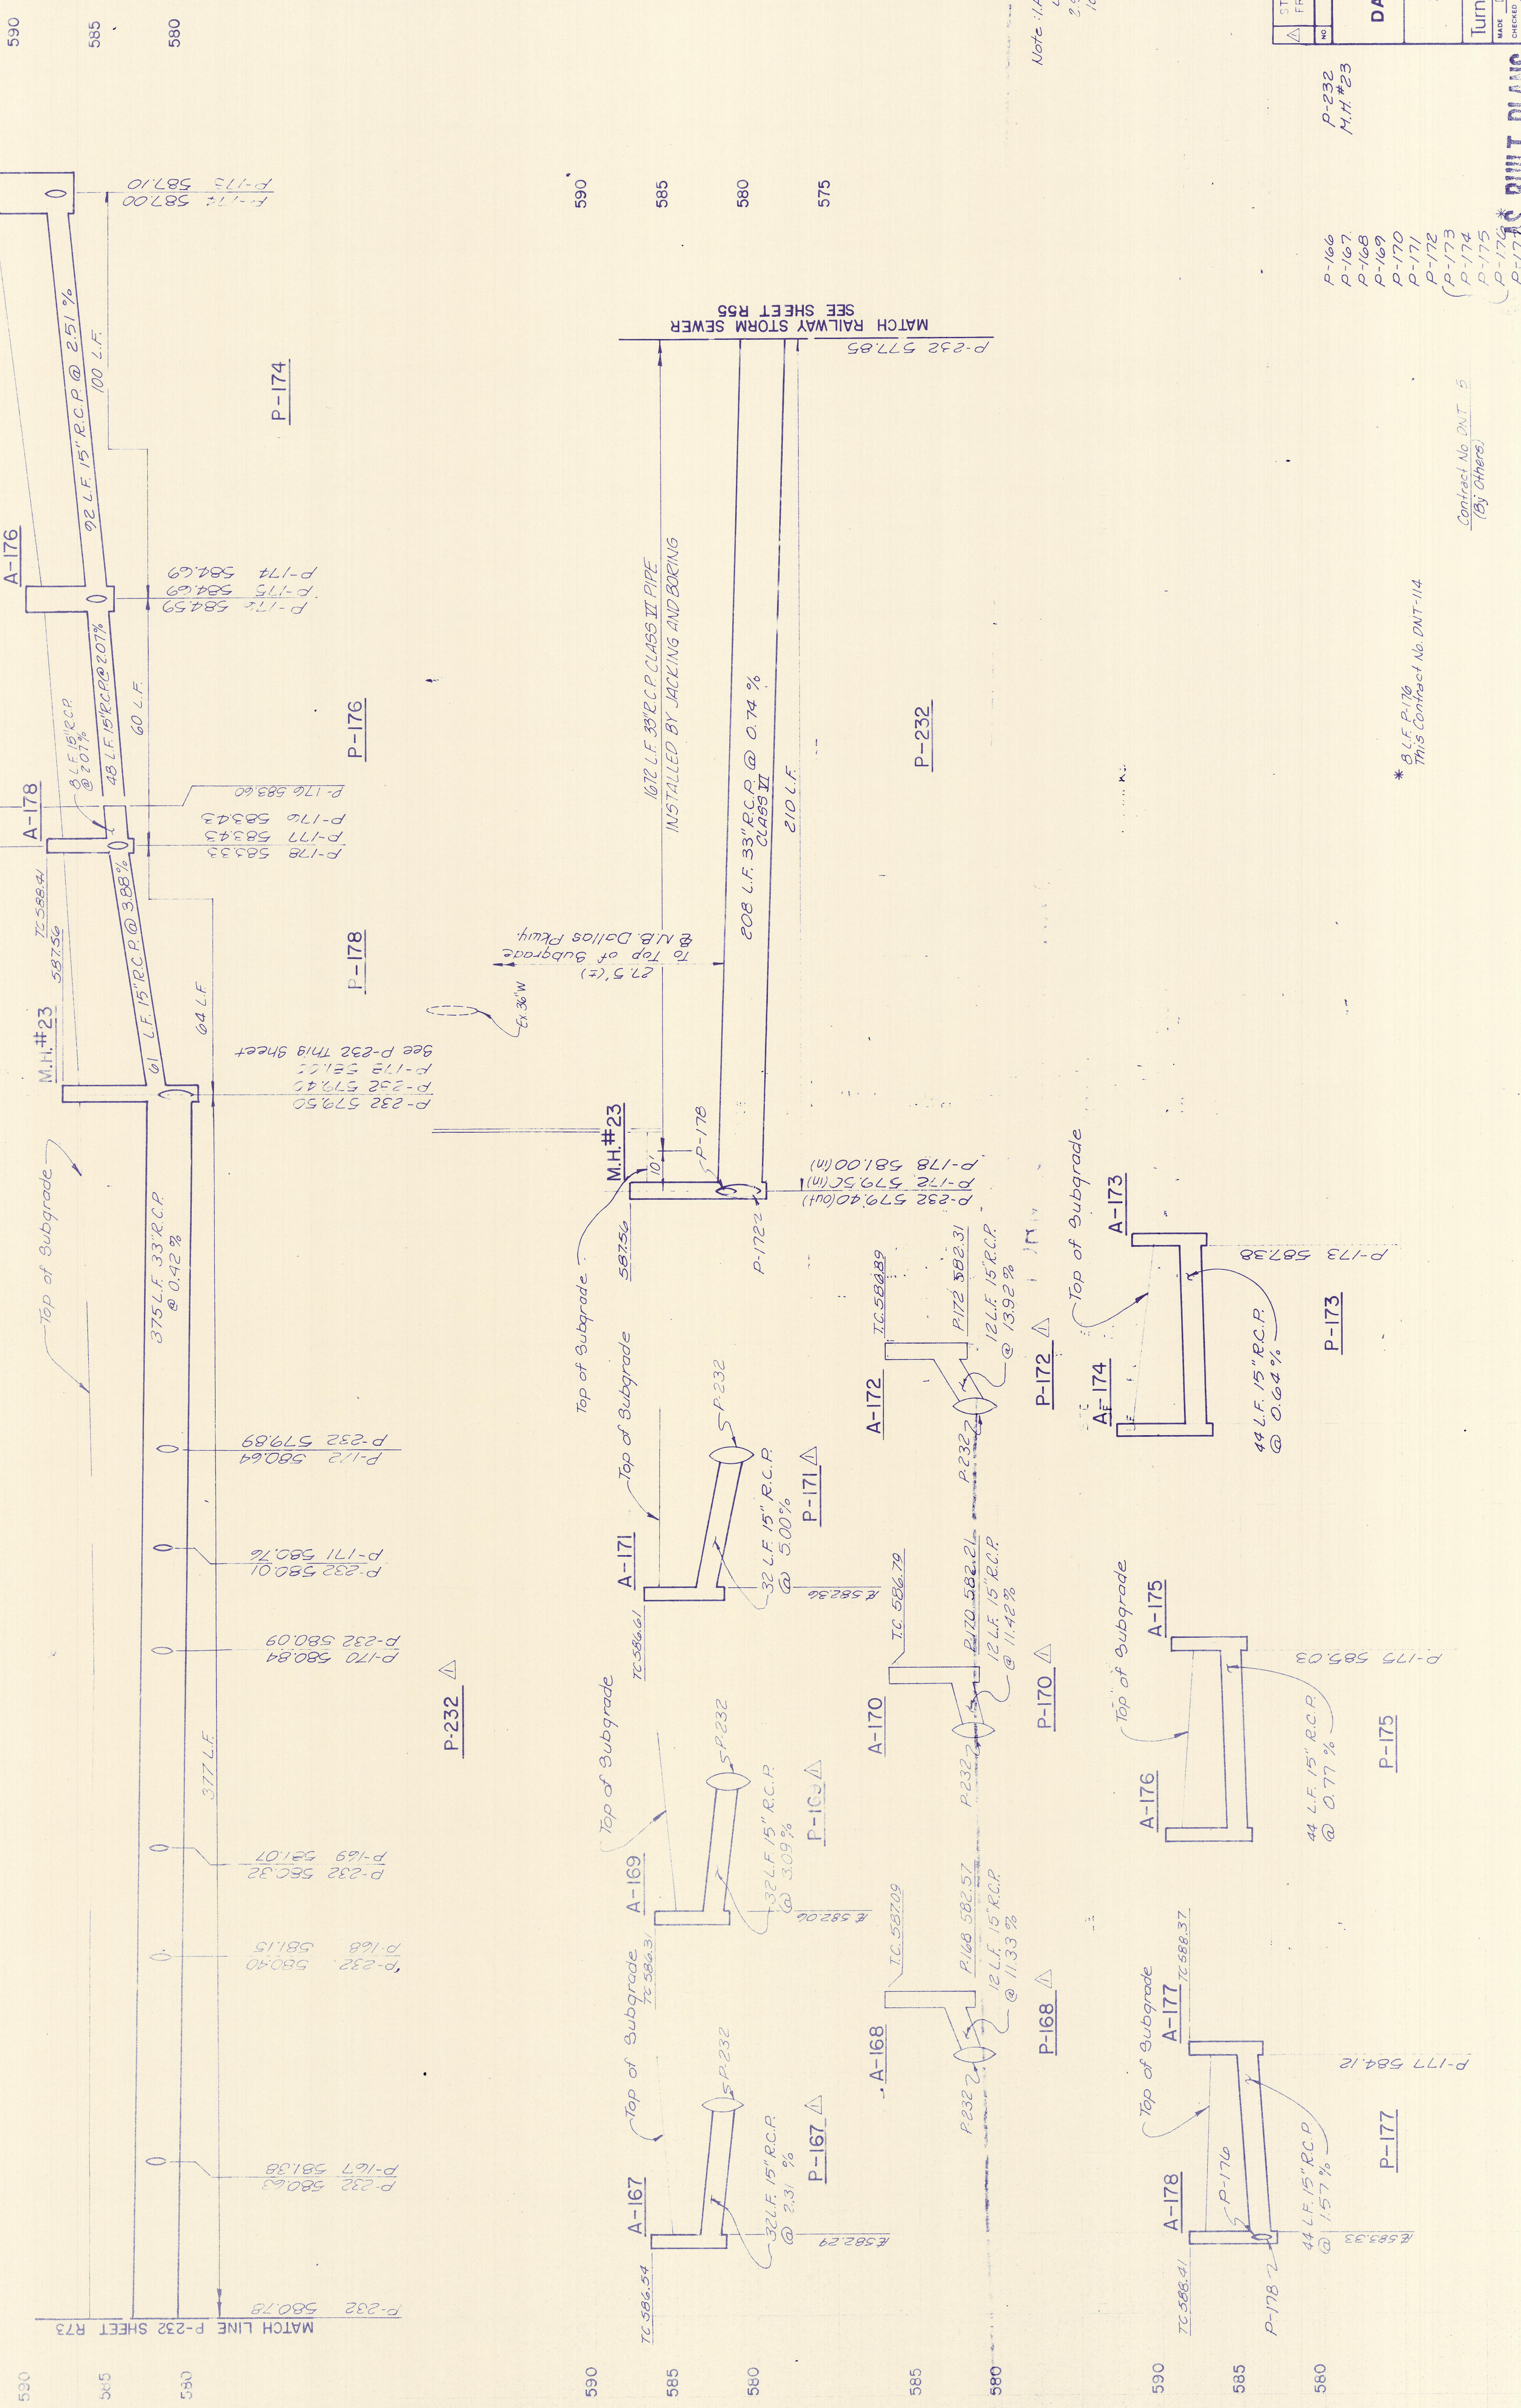

Note: 1411 R.C.P. to be Class III unless noted.
 See sheet R54 for horizontal location of pipes.

P-232
M.H.#23

- P-166
- P-167
- P-168
- P-169
- P-170
- P-171
- P-172
- (P-173)
- P-174
- P-175
- P-176
- P-177
- P-178

* S.L.F. P-176
This Connects to DNT-114

Contract No. DNT-114
(By Others)

NO.	REVISION	DATE	BY
1	STORM SEWER AND LATERALS FROM M.H.#22 TO M.H.#23	6/3/15	5/94

TEXAS TURNPIKE AUTHORITY
DALLAS NORTH TOLLWAY

STORM SEWER PROFILE

TurnerCollie/Braden Inc. SECTION XII

MADE: D.W.G. DATE: 7-83
 CHECKED: J.B.L. DATE: 7-83
 SCALE: H.I. = 20' / V.I. = 5'

CONTRACT NO. DNT-114 SHEET R74 OF R103

BUILT PLANS