

- Notes:
1. Removal Items are shown on Sheet R-22.
  2. Ditch elevations are shown on the cross sections.
  3. Curb Terminal Details are shown on Standard Drawing No. 11.

C-201 4-5'x5' MULTIPLE BOX CULVERT


CURVE DATA

PI Sta. 3+27.33 @ M.B.C. = 82.89 Rt. Sta. 501+31.93 @ Tollway  
 $\Delta = 48^{\circ}34'26''$   
 $R = 150.00'$   
 $T = 67.69'$   
 $L = 127.17'$

PI Sta. 6+12.90 @ M.B.C. = 6.00 Rt. Sta. 46+13.51 @ Ramp W-S  
 $\Delta = 32^{\circ}13'16''$   
 $R = 150.00'$   
 $T = 43.32'$   
 $L = 84.35'$

PI Sta. 9+00.38 @ M.B.C. = 29.78 Rt. Sta. 43+28.81 @ Ramp W-S  
 $\Delta = 11^{\circ}36'04''$   
 $R = 150.00'$   
 $T = 15.24'$   
 $L = 30.37'$

- Notes:
1. Horizontal control and curve data are shown on Sheets No. R-14 & R-15.
  2. Profiles for Southbound Inwood and Northbound Inwood Road are shown on Sheet No. R-50.
  3. Profiles for Ramp W-S are shown on Sheet No. R-37.
  4. Profiles for Ramp S-E are shown on Sheet No. R-38.
  5. Profiles for Ramp E-N are shown on Sheet No. R-40.
  6. Profile for Ramp N-W are shown on Sheet No. R-41.
  7. Profiles for South Frontage Road and Ramp SBI-S are shown on Sheet No. R-51.
  8. Profiles for North Frontage Road and Ramp S-NBI are shown on Sheet No. R-52.
  9. Dallas Power and Light poles and foundations are shown for information only.
  10. Paving plan for Loop Ramps is shown on Sheet No. R-60.

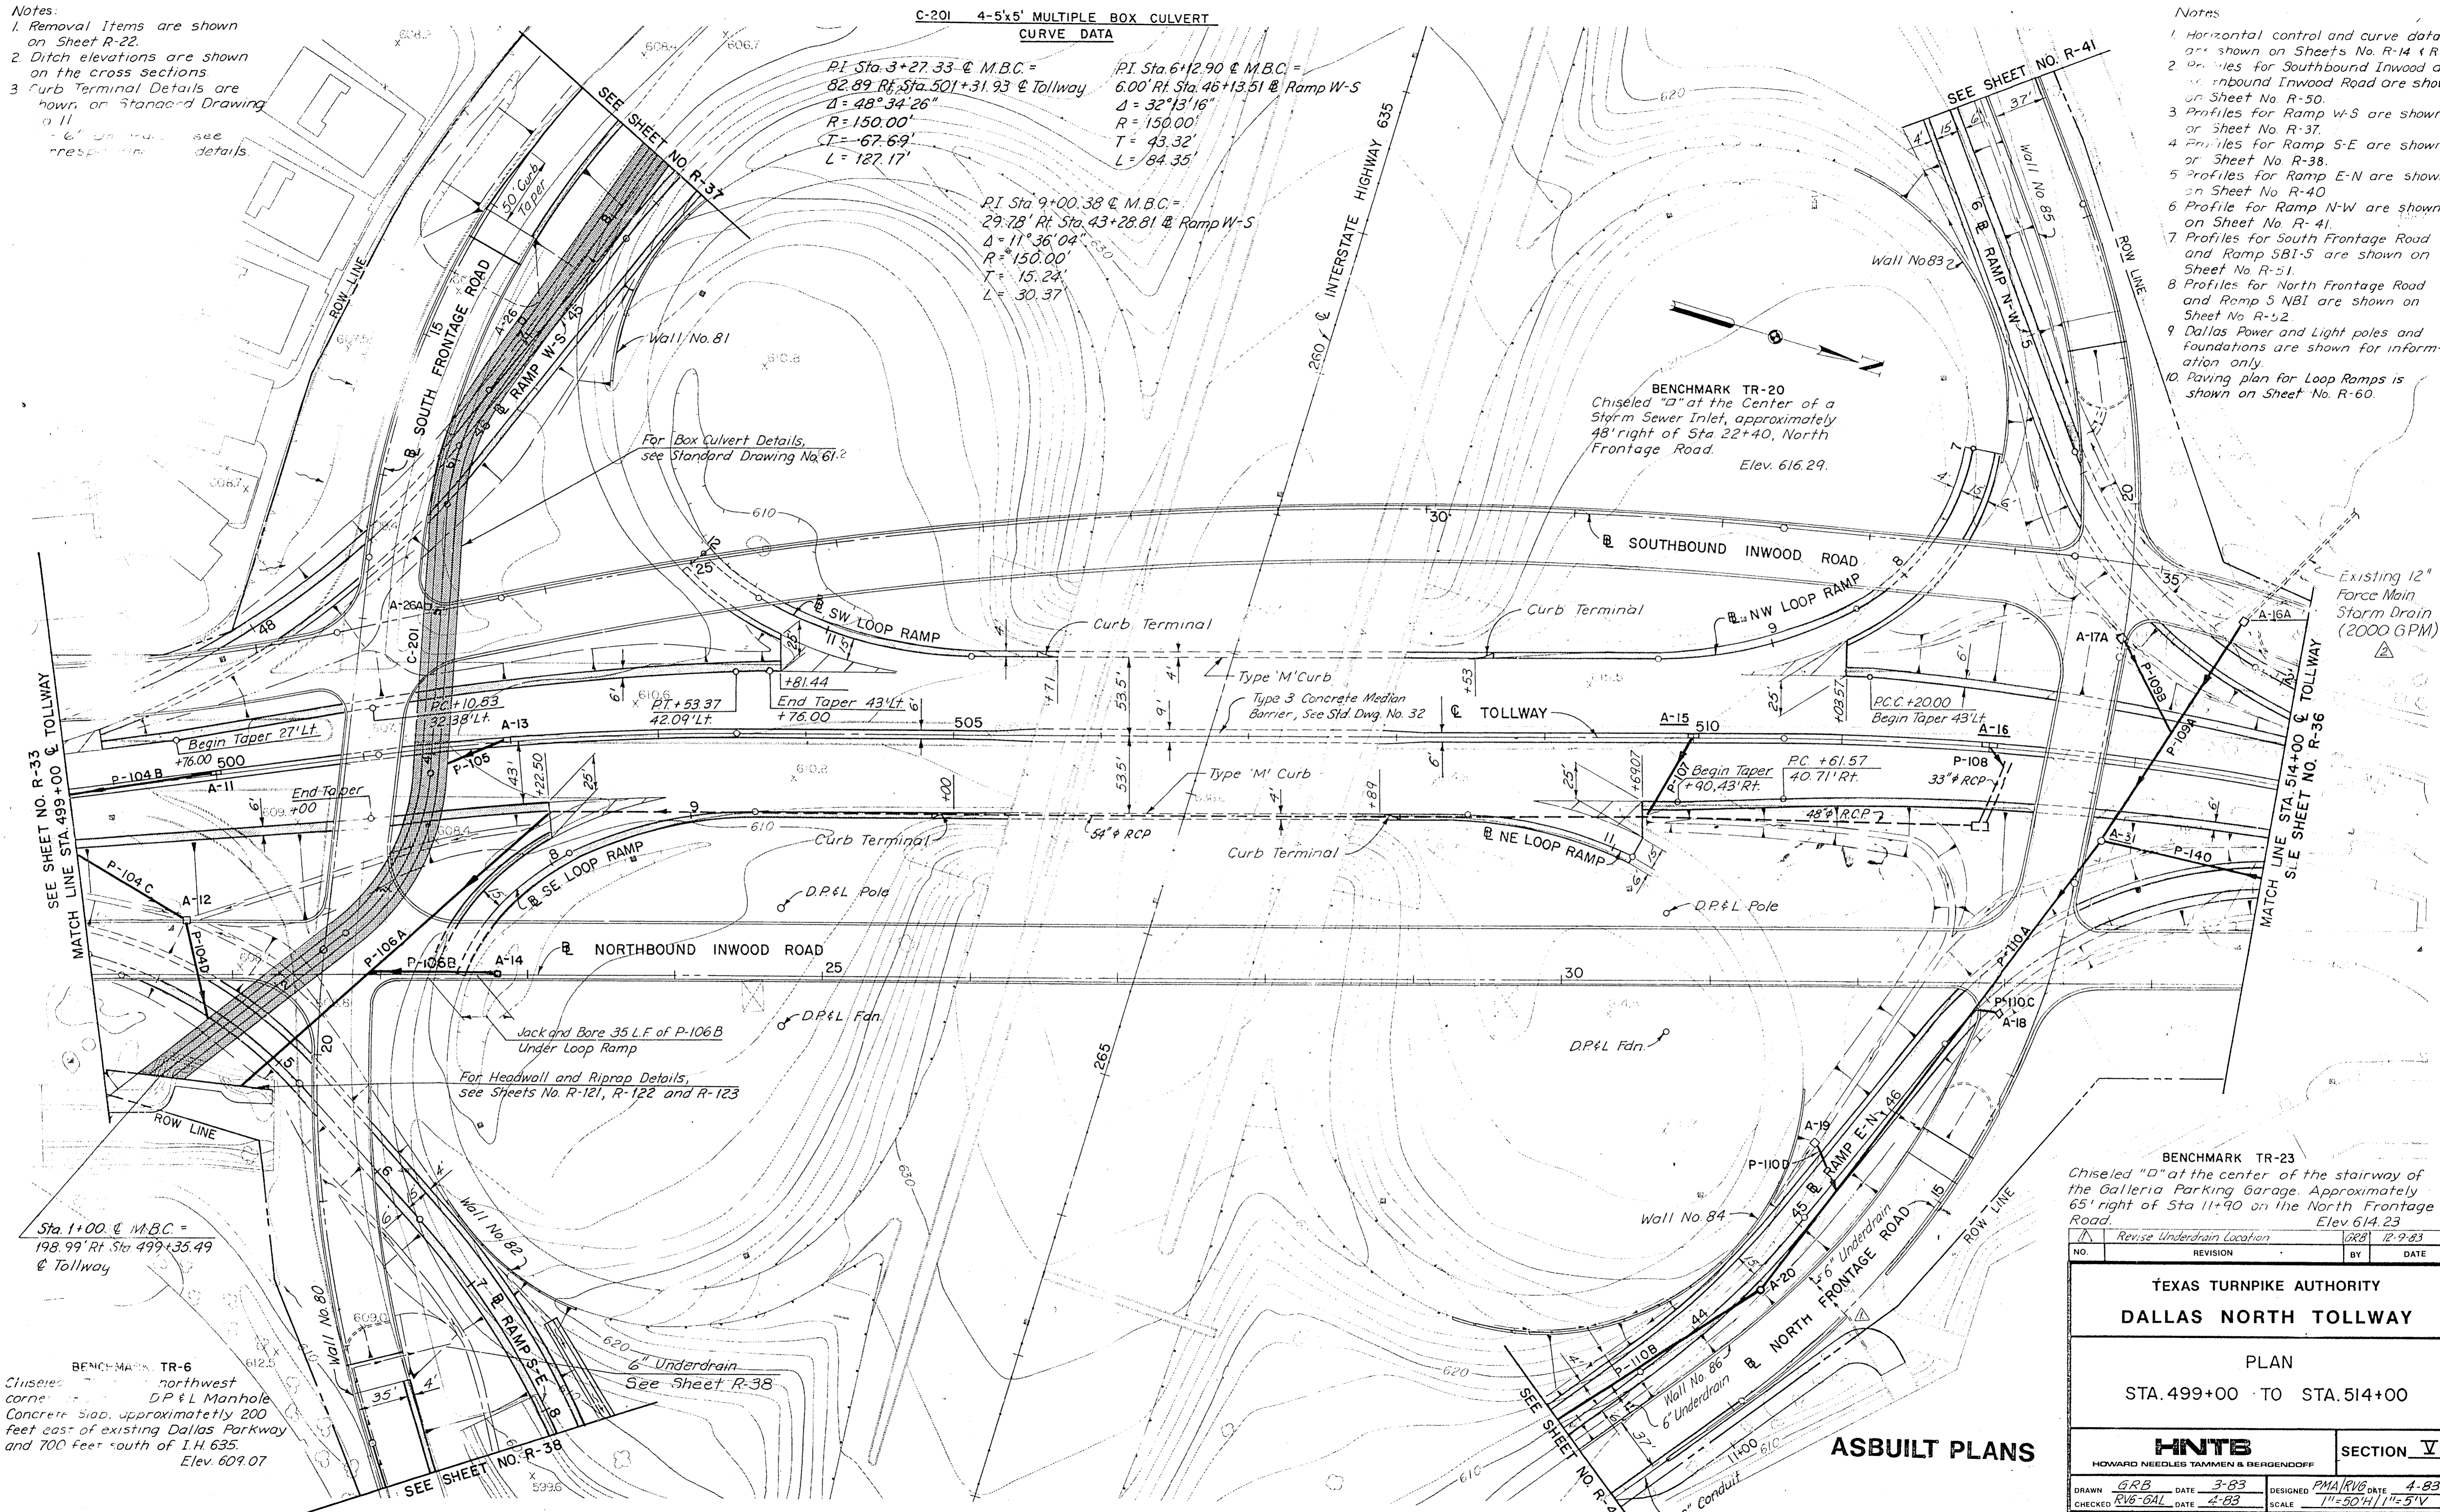

BENCHMARK TR-20  
 Chiseled "D" at the Center of a Storm Sewer Inlet, approximately 48' right of Sta 22+40, North Frontage Road.  
 Elev. 616.29.

BENCHMARK TR-23  
 Chiseled "D" at the center of the stairway of the Galleria Parking Garage. Approximately 65' right of Sta 11+90 on the North Frontage Road.  
 Elev. 614.23

Sta. 1+00 @ M.B.C. = 198.99 Rt. Sta. 499+35.49 @ Tollway

BENCHMARK TR-6  
 Chiseled "D" at northwest corner of DP&L Manhole. Concrete Slab, approximately 200 feet east of existing Dallas Parkway and 700 feet south of I.H. 635.  
 Elev. 609.07

NO.	REVISION	BY	DATE
1	Revise Underdrain Location	GRB	12-9-83

TEXAS TURNPIKE AUTHORITY  
 DALLAS NORTH TOLLWAY

PLAN  
 STA. 499+00 TO STA. 514+00

HNTB  
 HOWARD NEEDLES TAMMEN & BERGENDOFF SECTION V

DRAWN GRB DATE 3-83 DESIGNED PMA/RVB DATE 4-83  
 CHECKED RVB-GAL DATE 4-83 SCALE 1"=50'H/1"=5'V

CONTRACT NO. DNT-113 SHEET R-34 OF R-149

ASBUILT PLANS

Force Main By Others RJ 2/27/89