
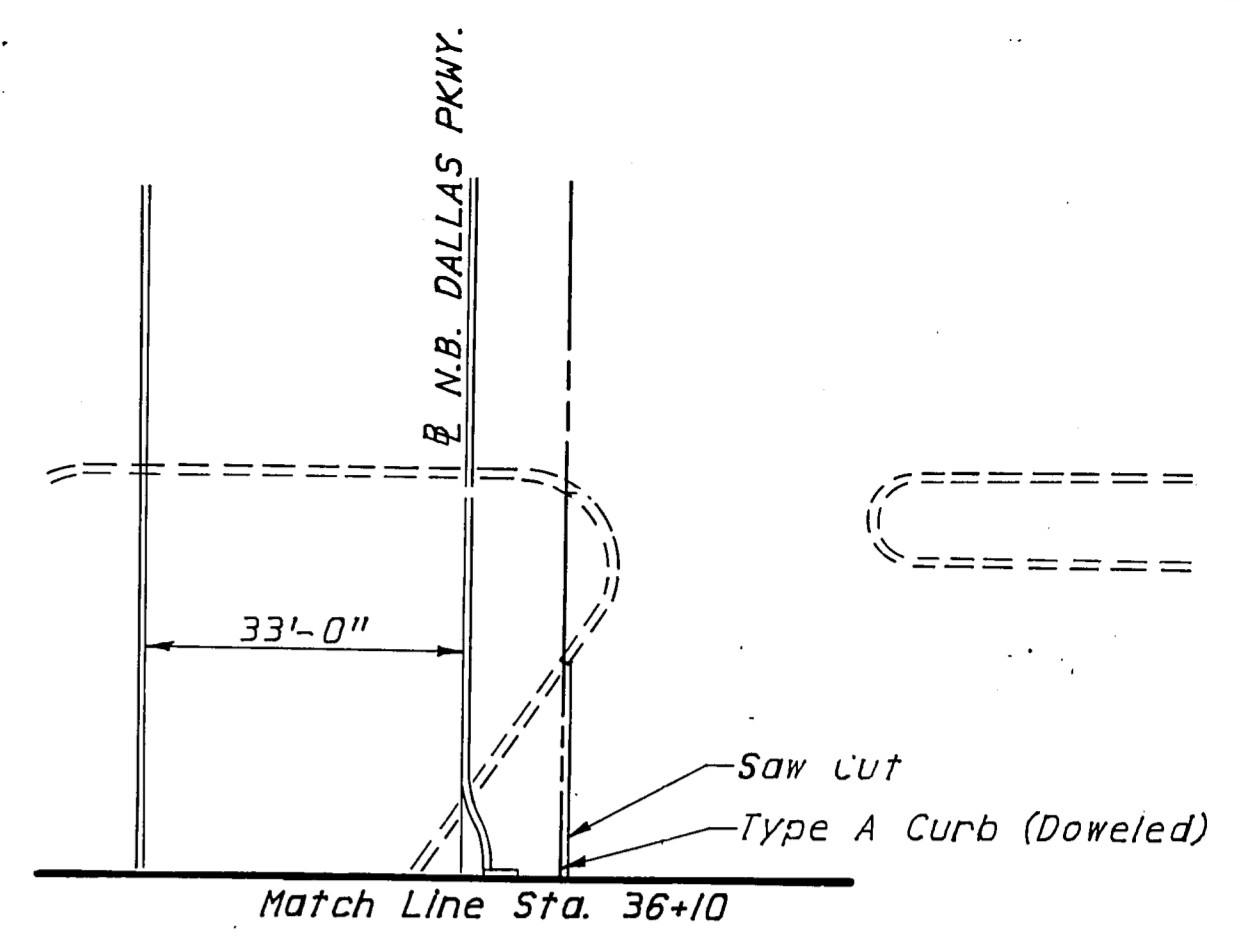


Note:  
 63 Designates Curve Numbers. See  
 Roadway Geometry, Sheet No. R-17 & R-18.

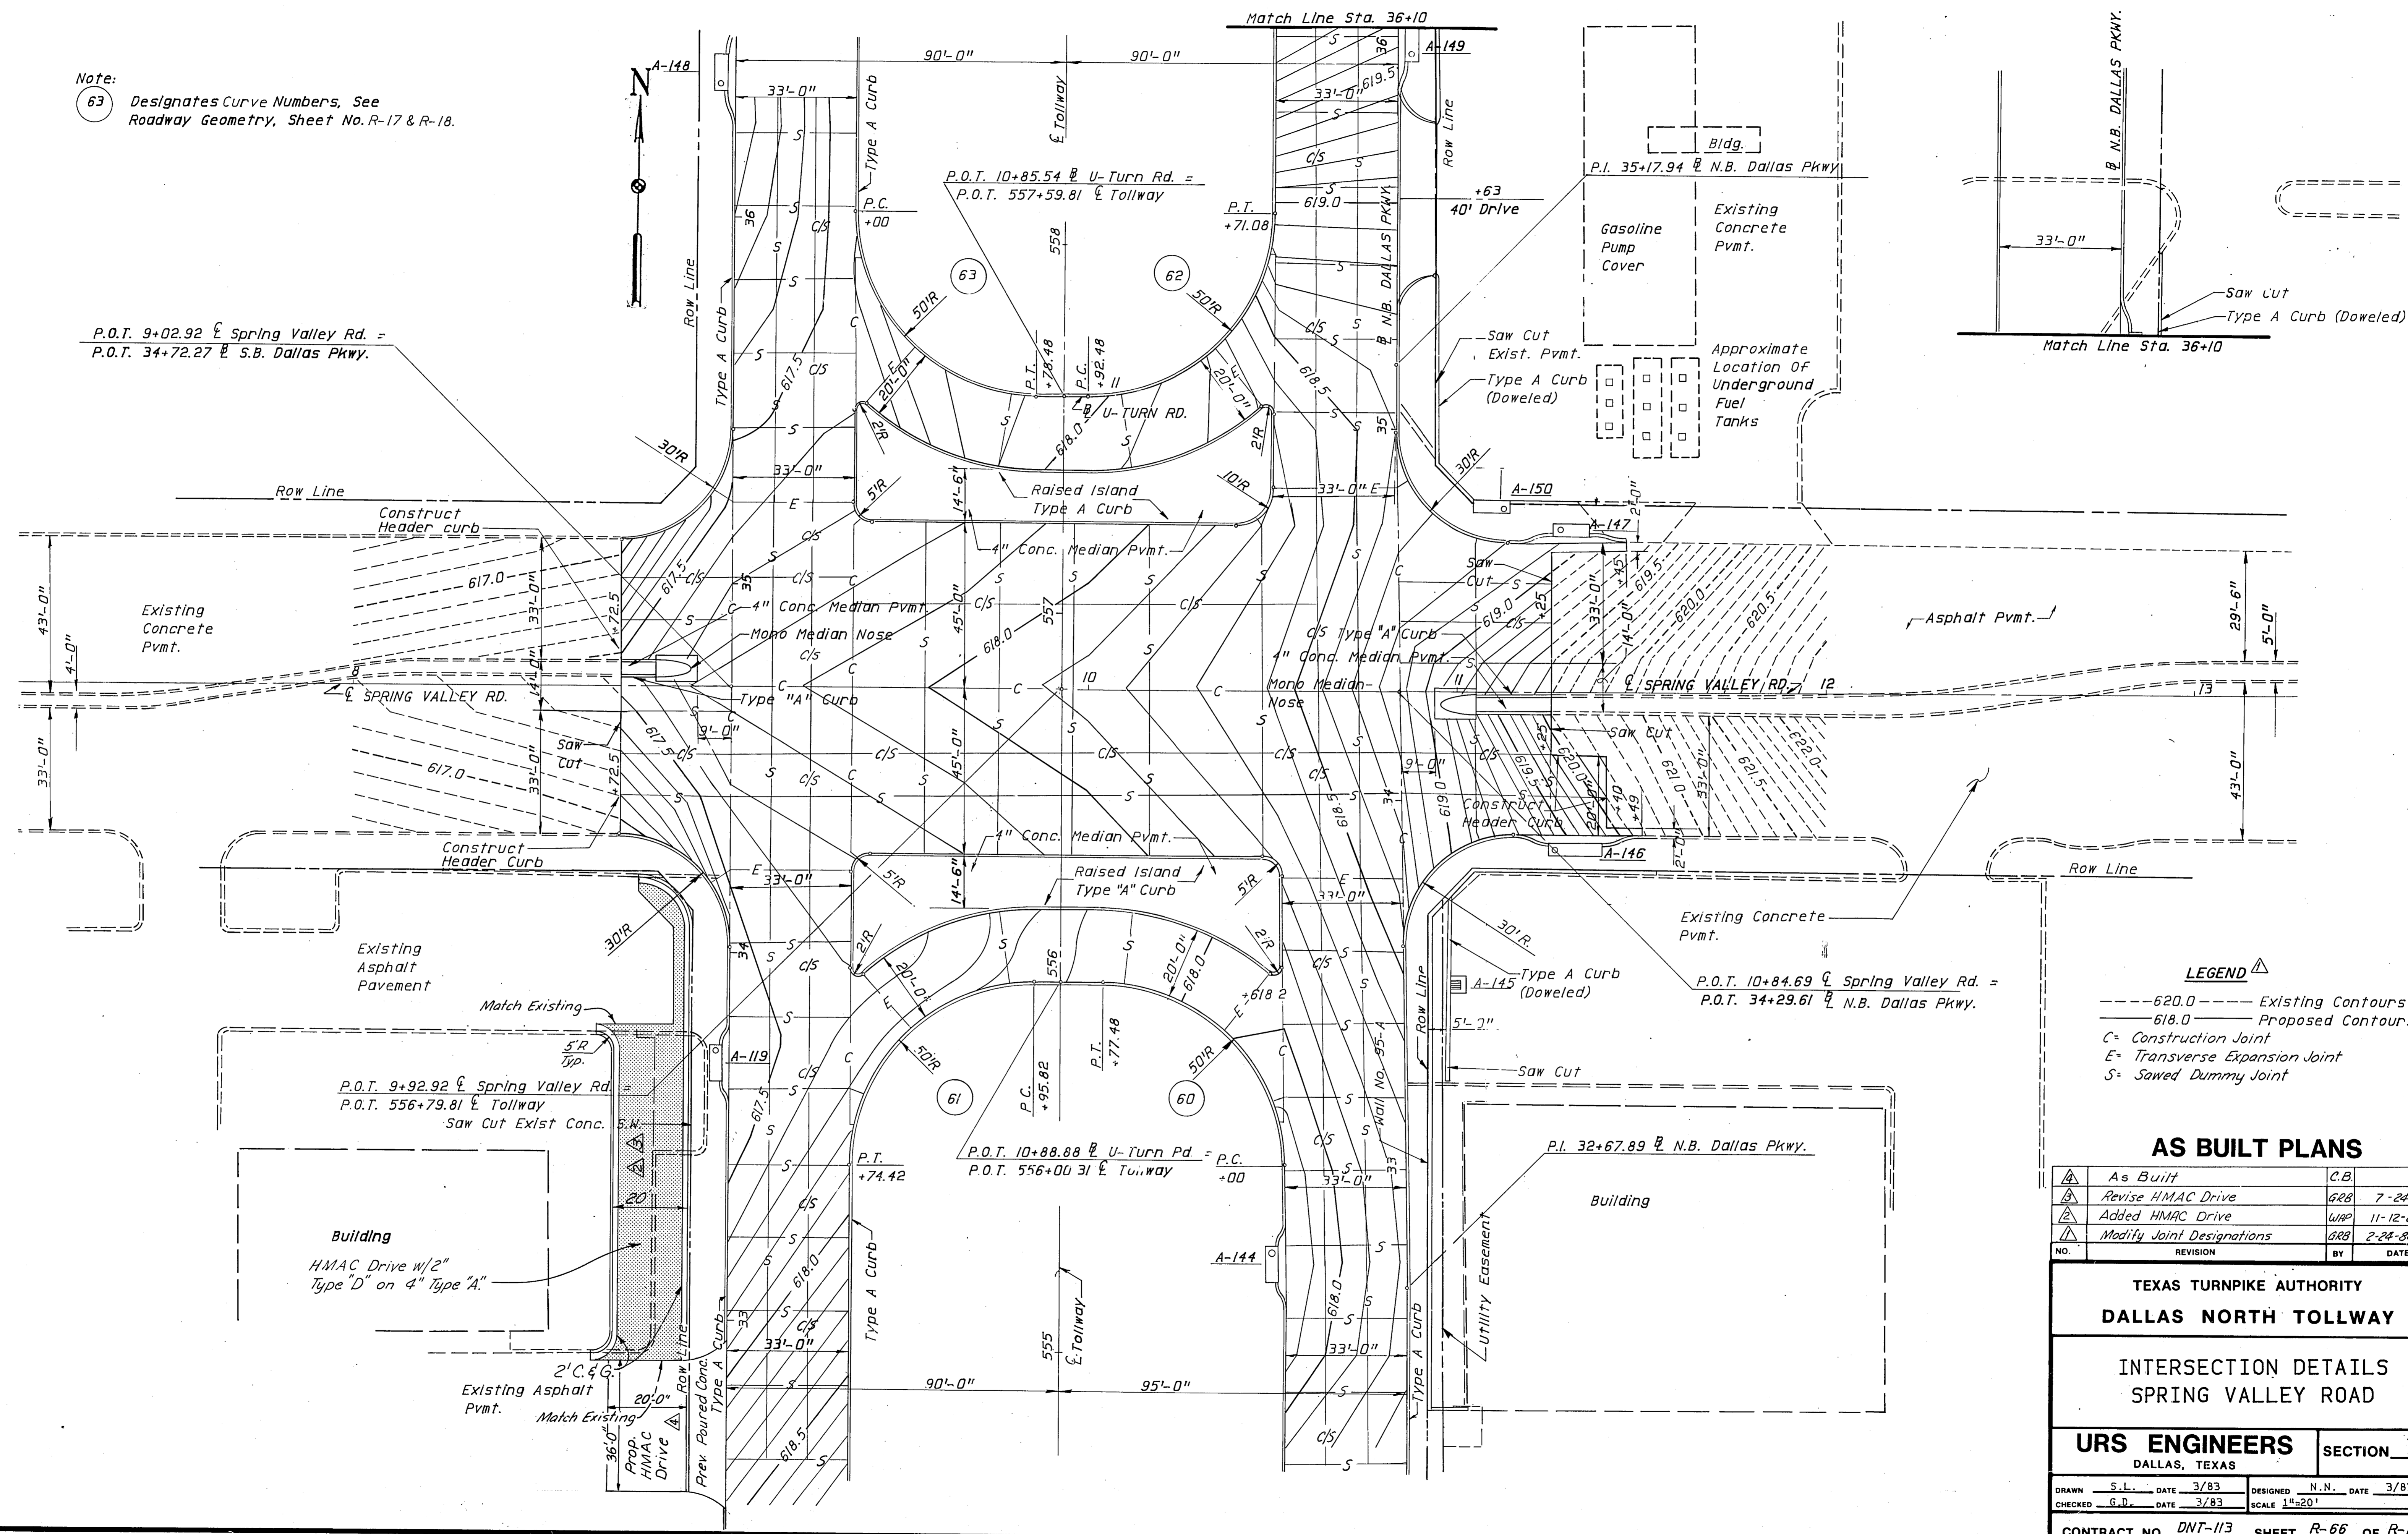

**LEGEND**

- 620.0 --- Existing Contours
- 618.0 --- Proposed Contours
- C= Construction Joint
- E= Transverse Expansion Joint
- S= Sawed Dummy Joint

**AS BUILT PLANS**

NO.	REVISION	BY	DATE
1	As Built	C.B.	
2	Revise HMAC Drive	GRB	7-24-85
3	Added HMAC Drive	WRP	11-12-84
4	Modify Joint Designations	GRB	2-24-84

TEXAS TURNPIKE AUTHORITY  
 DALLAS NORTH TOLLWAY

INTERSECTION DETAILS  
 SPRING VALLEY ROAD

**URS ENGINEERS** SECTION V  
 DALLAS, TEXAS

DRAWN S.L. DATE 3/83 DESIGNED N.N. DATE 3/83  
 CHECKED G.D. DATE 3/83 SCALE 1"=20'

CONTRACT NO. DNT-113 SHEET R-66 OF R-149