

INDEX OF SHEETS

SHT. NO.	TITLE
R1	COVER SHEET
R2 - R3	ESTIMATED QUANTITY SUMMARY
R4 - R6	GEOMETRIC CONTROLS AND TRAVERSE TIES
R7 - R8	TYPICAL ROADWAY SECTIONS
R9 - R15	ROADWAY REMOVALS
R16 - R22	PLAN AND PROFILE
R23 - R26	N.B. AND S.B. DALLAS PARKWAY PROFILES
R27 - R29	RAMP PROFILES
R30 - R40	PAVING PLANS
R41	S.S.W. RAILWAY CROSSING DETAIL
R42	S.S.W. RAILWAY SHOOFLY PLAN AND PROFILE
R43	DRAINAGE AREA MAP
R44 - R45	DRAINAGE SUMMARY - MANHOLES AND INLETS
R46 - R47	DRAINAGE SUMMARY - PIPES
R48 - R55	STORM SEWER PLANS
R56 - R74	STORM SEWER PROFILES
R75 - R76	S.S.W. RAILWAY SHOOFLY CULVERT PLAN AND PROFILE
R77 - R83	EXISTING UTILITIES
R84 - R99	SUGGESTED CONSTRUCTION SEQUENCE
R100	MISCELLANEOUS DRAINAGE DETAILS
R101	7' x 7' PRECAST CONCRETE CULVERT DETAILS
R102 - R102A	MISCELLANEOUS DETAILS
R103	CONSTRUCTION WARNING SIGNS

S1-582 STRUCTURES (SEE VOLUME 2 PLANS)
 1-46 CROSS SECTIONS (SEE VOLUME 3 PLANS)

STANDARD DRAWINGS

STD. NO.	TITLE
1	TOLLWAY INLET TYPE C
2	TOLLWAY MEDIAN INLET TYPE M
4	STANDARD INLET TYPE "CDR"-3,4 & 5'
5	STANDARD INLET TYPE "CDR"-6,8 & 10'
6	STANDARD INLET TYPE "CDR"-14'
7	RECESSED AND "Y" INLETS
8	STANDARD TOLLWAY MANHOLES TYPE I, II & III
9	MANHOLE DETAILS
10	STANDARD UNDERDRAINS
11	MISCELLANEOUS DETAILS TOLLWAY
12	TOLLWAY PAVEMENT DETAILS JOINTED REINFORCED
13	CONCRETE PAVEMENT DETAILS JOINT SEALS
14 & 15	MISCELLANEOUS DETAILS SERVICE ROADS
17 & 18	CURB & GUTTER INLET TYPE I
31	CONCRETE TRAFFIC BARRIER TYPE 1
32	CONCRETE TRAFFIC BARRIER TYPE 2 & 3
35	PRECAST CONCRETE BOX CULVERTS
50-56	BARRICADE & CONSTRUCTION STANDARDS
57	CONCRETE BARRIER RAIL (PORTABLE & PRECAST)
62	CONCRETE HEADWALLS

TEXAS TURNPIKE AUTHORITY


CONTRACT NO. DNT 114

GRADING, DRAINAGE AND PAVING

SECTION VI

VOLUME 1

DALLAS NORTH TOLLWAY

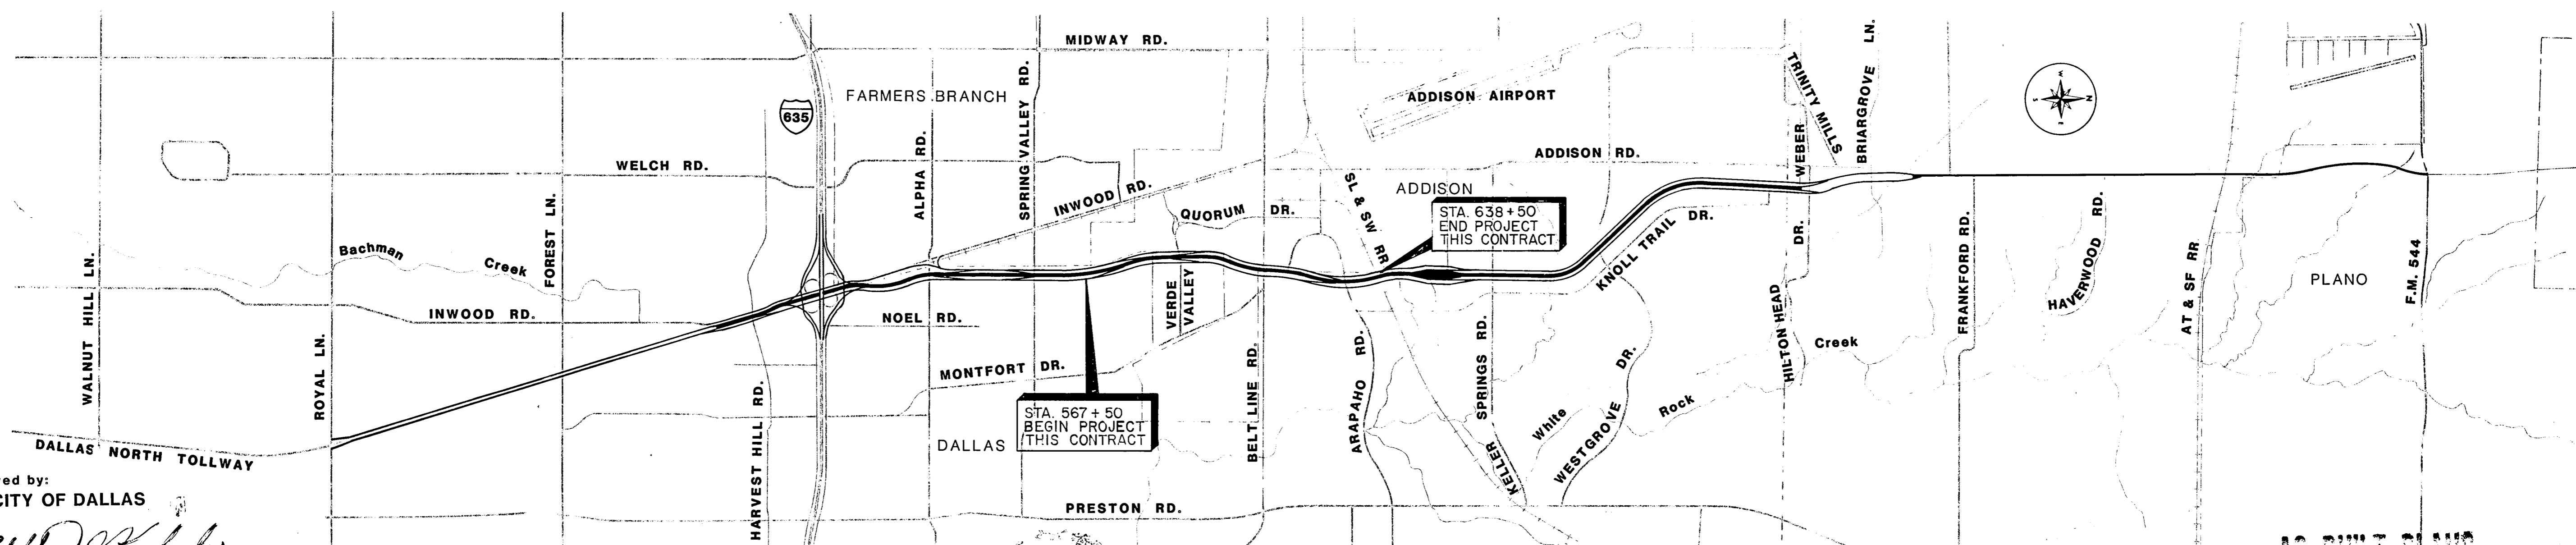

Approved by:
 THE CITY OF DALLAS

Clifford V. Kehely
 Date: 3/20/84

Approved by:
 TOWN OF ADDISON

[Signature]
 Date: 5-15-84

Approved by:
 THE CITY OF FARMERS BRANCH

[Signature]
 City Manager
 Date: _____

Prepared by:
 TURNER COLLIE AND BRADEN, INC.

Lawrence D. Bragg, Jr.
 Date: 1-10-84

Recommended by:
 HOWARD, NEEDLES, TAMMEN & BERGENDOFF

Daniel T. Baker
 Engineer in Charge
 Date: February 9, 1984

Recommended by:
 TEXAS TURNPIKE AUTHORITY

James W. Driffen
 Director, Engineering & Maintenance
 Date: February 9, 1984

Approved by:
 TEXAS TURNPIKE AUTHORITY

[Signature]
 Engineer Manager
 Date: _____

AS BUILT PLANS