


H.K. HUIE, JR.  
 NOTES  
 1. See Sheet R23 for N.B. Dallas Pkwy. Profile  
 2. " " R25 for S.B. Dallas Pkwy. Profile  
 3. " " R28 for Ramp S-BL Profile  
 4. " " R28 for Ramp BL-S Profile  
 5. " " R5 for Additional Horizontal Geometrics  
 6. " " R32 for Verde Valley and Quorum Dr. Details  
 7. " " R3134 for Ramp S-BL Details & Nose Sta.  
 8. " " R3136 for Ramp BL-S Details & Nose Sta.  
 9. " " R11 for Retaining Walls  
 10. " " R118 for Typical Roadway Section  
 11. " " R50 for Storm Sewer Plan  
 12. See Volume 2 Plans for Bridge and Approach Slab Details  
 13. See Volume 2 Plans for Retaining Wall Details  
 14. Transition Height of Curb & Gutter to Match Driveway Curb in U.H.

COMMERCE SOUTHWEST, INC.

PARKWAY ASSOCIATES, LTD

VILLAGE PARKWAY VENTURE  
 Dench Mark: Top R.R. spike in W. face of transformer pole located between the N. curb of Parkway Place N. Apts. & S. curb of parking lot to village on the Parkway at 136.4' East of Sta. 585+00.00 Elev. 630.39  
 Sta. 8+75.5 to 9+52 Ramp S-BL Pavement reaveout for Toll Plaza (by others). Grading & Subgrade to be included in this contract. Base by others.

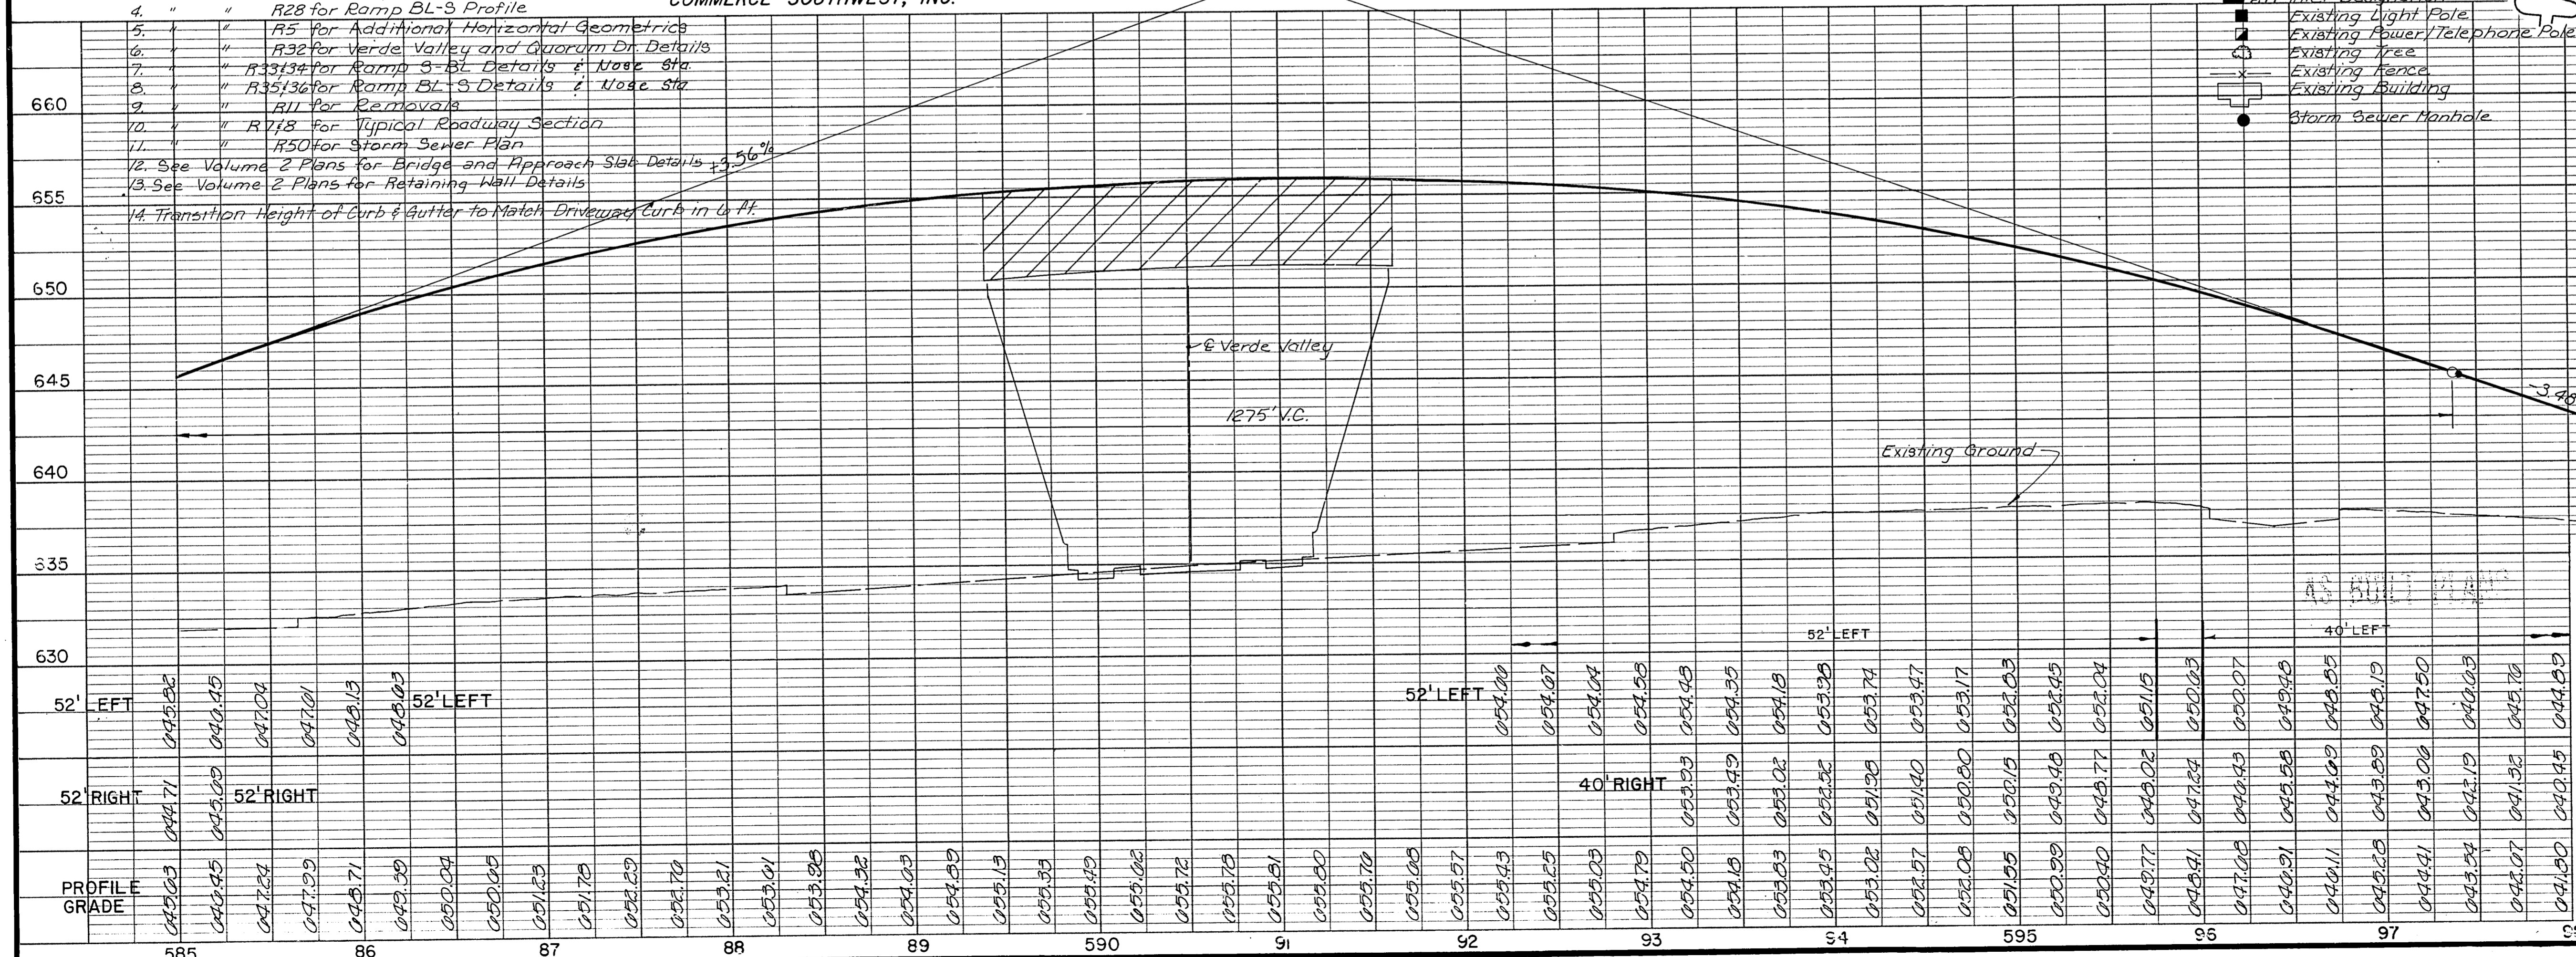

LEGEND

(Symbol)	Horizontal Curve Number
(Symbol)	Inlet Designation
(Symbol)	Existing Light Pole
(Symbol)	Existing Power/Telephone Pole
(Symbol)	Existing Tree
(Symbol)	Existing Fence
(Symbol)	Existing Building
(Symbol)	Storm Sewer Manhole

(Symbol)	Add Retaining Wall W-97A	GRB 2-20-86
(Symbol)	Add Retaining Wall W-98A	GMG 12-19-85
(Symbol)	40' LEFT	
(Symbol)	40' RIGHT	
(Symbol)	PROFILE GRADE	
(Symbol)	Revised Drive Entrance	GMG 7-14-85 645
(Symbol)	Add Drive Entrances	GMG 10-01-85
(Symbol)	Base Note	AMN 7-19-85
(Symbol)	Revised Drive Entrance	WAP 7-11-85 34
(Symbol)	Revised Sakowitz Village Park Lot	RM 3-15-85
(Symbol)	Toll Plaza Stations	JPK 1-7-85
(Symbol)	Revised Driveway Location	C.R.S. 9-18-84
(Symbol)	Toll Plaza - Begin Station	AMN 5-18-84
(Symbol)	Revised Eas' Curb & Gutter	KW 4-3-84

TEXAS TURNPIKE AUTHORITY  
**DALLAS NORTH TOLLWAY**  
 PLAN AND PROFILE  
 STA. 585+00 TO STA. +599+00  
 TurnerCollie & Braden Inc. SECTION VI  
 Consulting Engineers  
 DRAWN A.L.A. DATE 3-83 DESIGNED G.G.S. DATE 1-83  
 CHECKED J.B.L. DATE 3-83 SCALE H:V = 50':1" = 5'  
 CONTRACT NO. DNT-114 SHEET R18 OF R103