


LEGEND

- (R2) Horizontal Curve Number
- A-21 Inlet Designation
- Existing Light Pole
- Existing Power / Telephone Pole
- Existing Tree
- Existing Fence
- Existing Building
- Storm Sewer Manhole
- Storm Sewer w/ direction of flow
- Reint. Conc. Box Sewer
- P-21 Reint. Conc. Pipe Sewer
- Underdrain Pipe

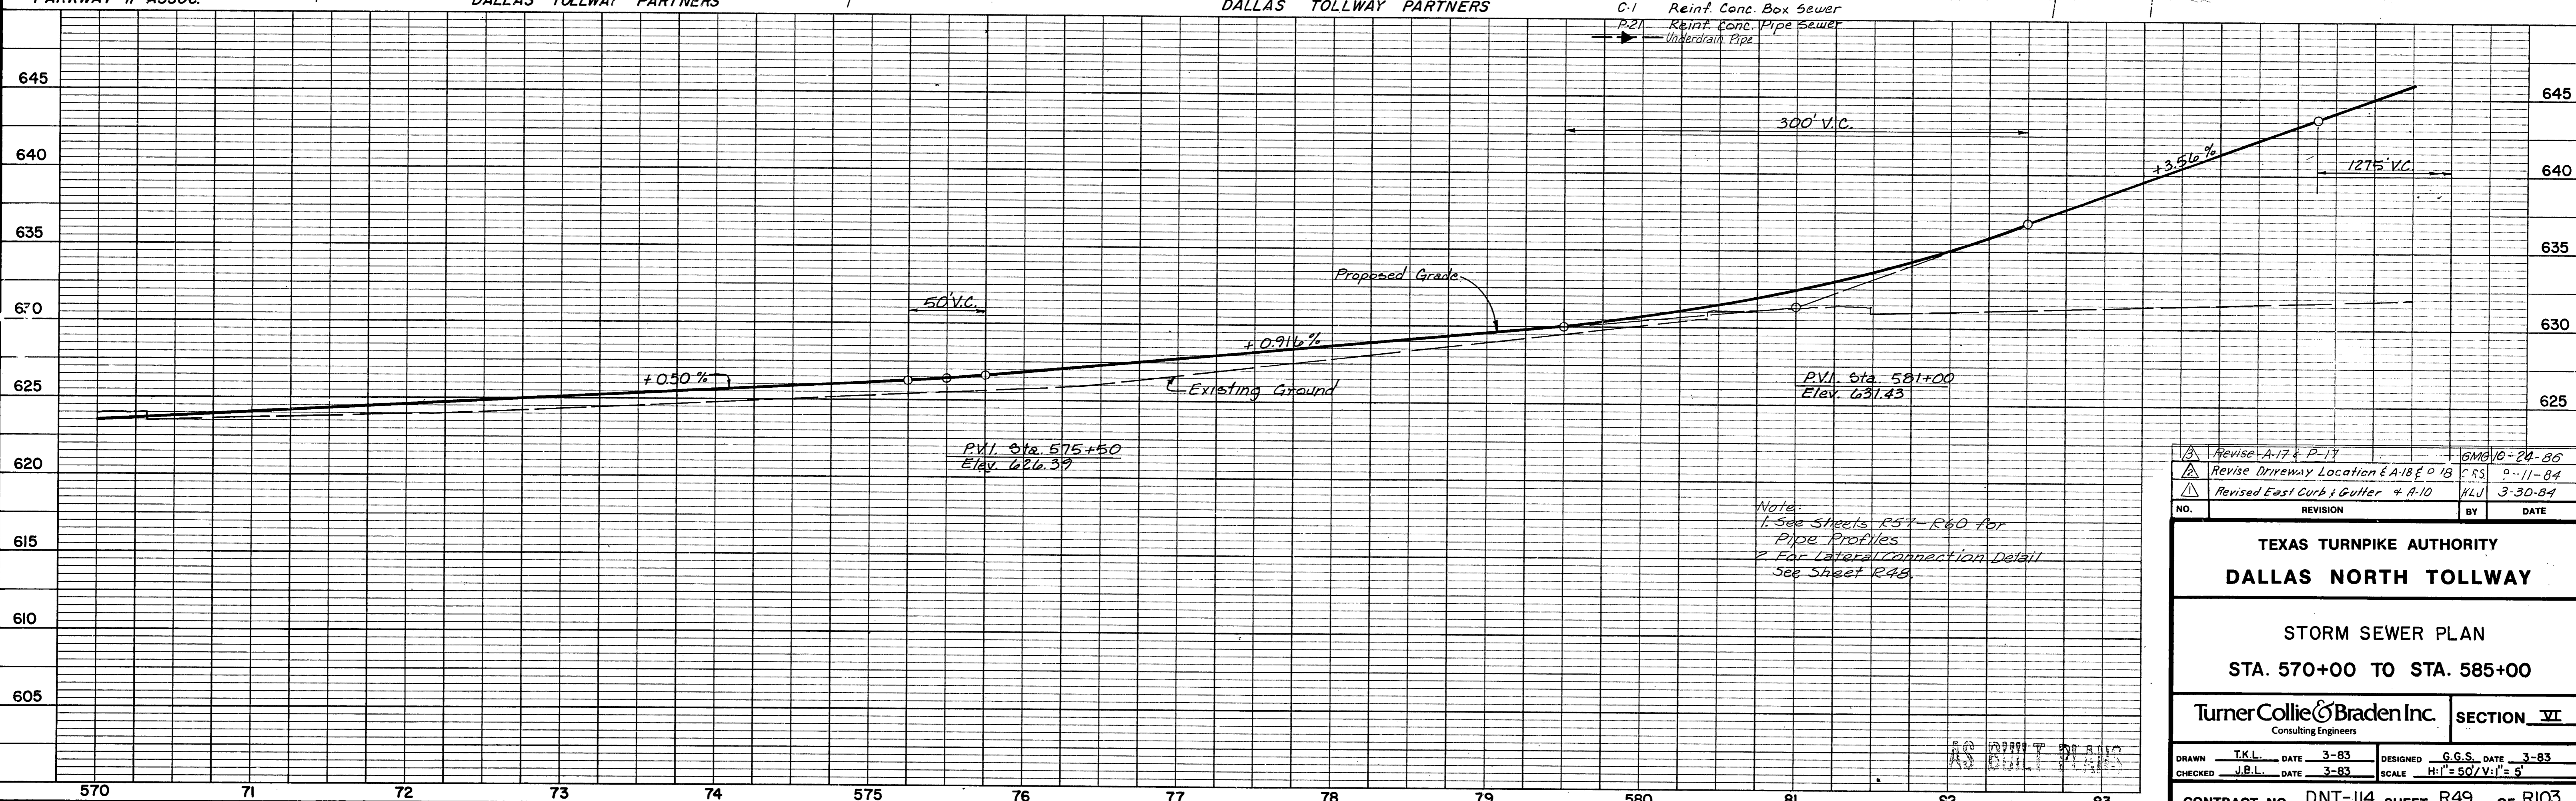

△	Revise A-17 & P-17	GMB/IO-24-86	
△	Revise Driveway Location & A-18 & P-18	5/83 9-11-84	
△	Revised East Curb & Gutter & A-10	HLJ 3-30-84	
NO.	REVISION	BY	DATE

Note:
 1. See Sheets R57-R60 for Pipe Profiles
 2. For Lateral Connection Detail See Sheet R48.

TEXAS TURNPIKE AUTHORITY
DALLAS NORTH TOLLWAY

STORM SEWER PLAN
STA. 570+00 TO STA. 585+00

TurnerCollie & Braden Inc. **SECTION VI**
 Consulting Engineers

DRAWN	T.K.L.	DATE	3-83	DESIGNED	G.G.S.	DATE	3-83
CHECKED	J.B.L.	DATE	3-83	SCALE	H:V = 50:1	V:V = 5	

CONTRACT NO. DNT-114 SHEET R49 OF R103