
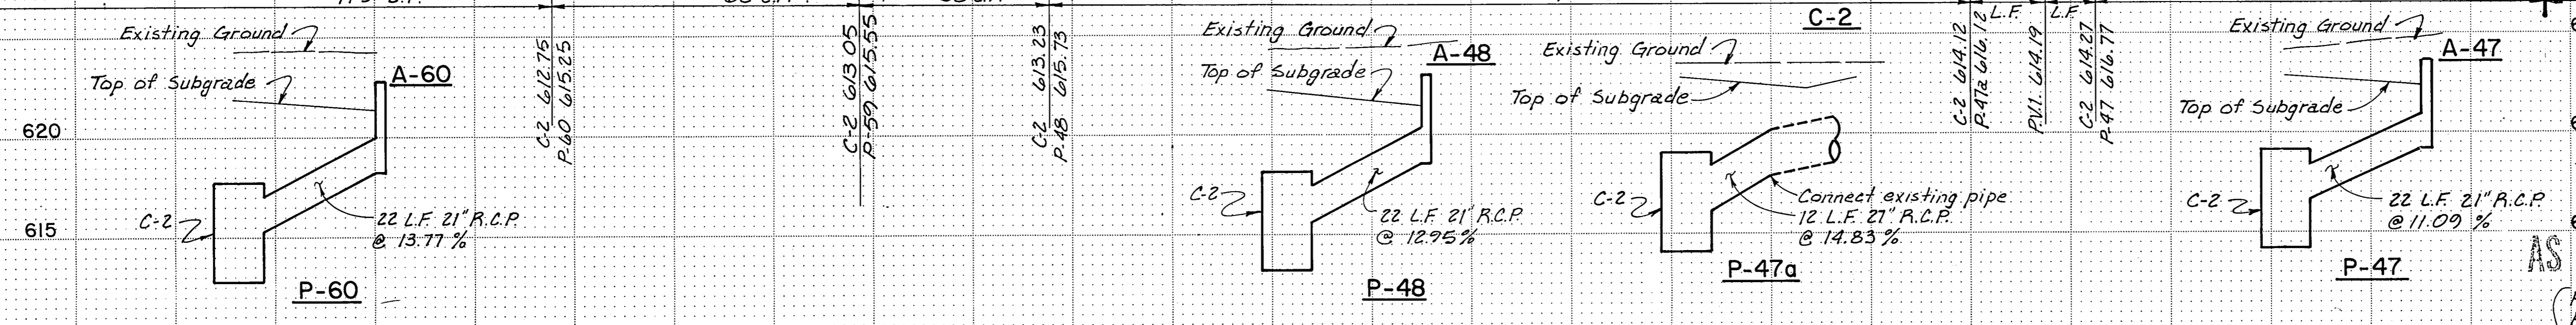


Note: 1. All R.C.P. to be Class III unless noted.  
 2. See sheet R48 for horizontal location of pipes.

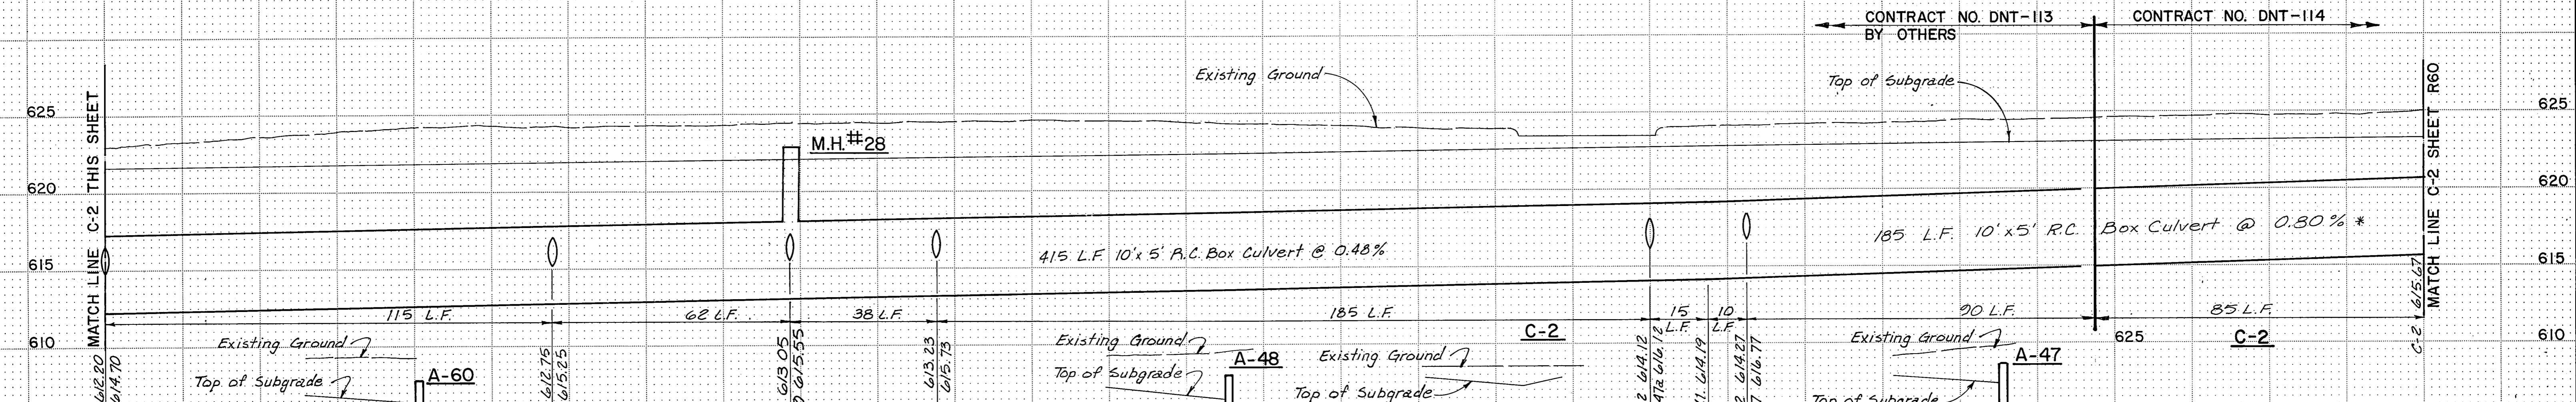

\* 85 L.F. C-2 This Contract No. DNT-114

AS BUILT PLANS  
 Contract No. DNT-113 By Others  
 P-47 P-63  
 P-47a P-64  
 P-48 P-65  
 P-60 \*C-2  
 P-61  
 P-62 M.H.#28

NO.		REVISION		BY		DATE	
TEXAS TURNPIKE AUTHORITY DALLAS NORTH TOLLWAY							
STORM SEWER PROFILE							
Turner Collie & Braden Inc.				SECTION VII			
MADE G.B.S.	DATE 7-83	TRACED J.B.L.	DATE 7-83				
CHECKED J.B.L.	DATE 7-83	SCALE H:1"=20'/V:1"=5'					
CONTRACT NO. DNT-114 SHEET R61 OF R103							