


MATCH LINE P-125 SEE SHEET R66

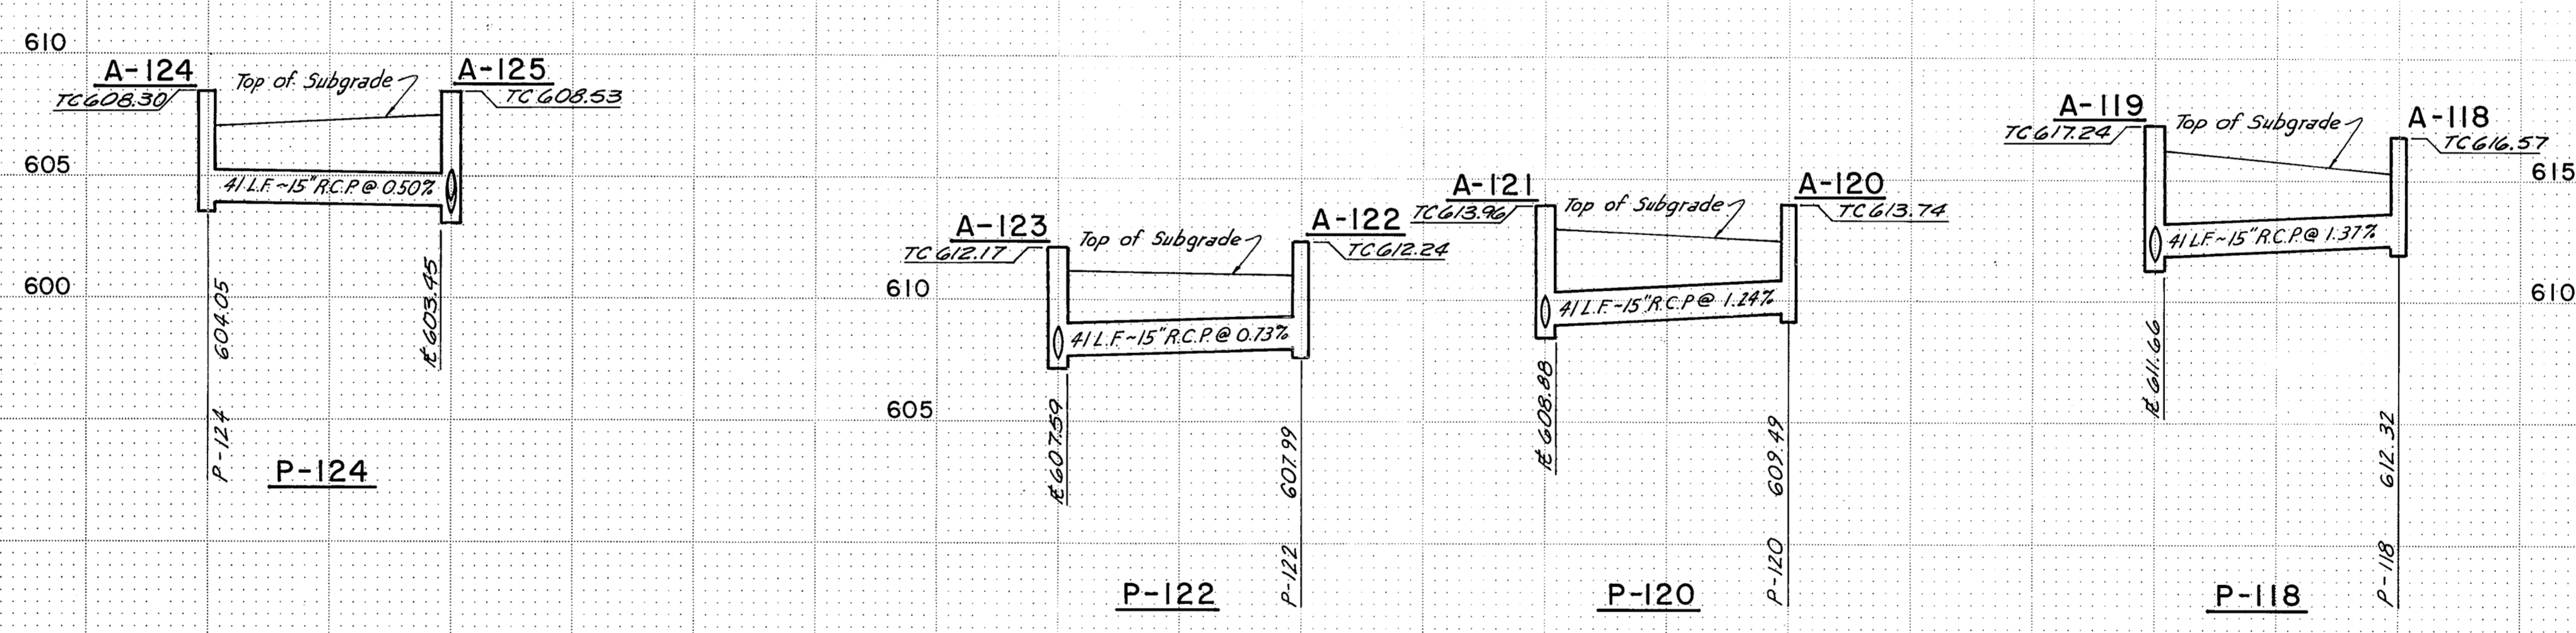

Note: 1. All R.C.P. to be Class III unless noted.  
2. See sheets 51 & 53 for horizontal location of pipes.

P-118  
P-119  
P-120  
P-121  
P-122  
P-123  
P-124  
P-125

AS BUILT PLANS

|  |           |                         |             |
|--|-----------|-------------------------|-------------|
| NO.  | REVISION  | BY                      | DATE        |
| TEXAS TURNPIKE AUTHORITY<br>DALLAS NORTH TOLLWAY |           |                         |             |
| STORM SEWER PROFILE                              |           |                         |             |
| Turner Collie & Braden Inc.                      |           |                         | SECTION VII |
| MADE R.L.W.                                      | DATE 7-83 | TRACED D.M.             | DATE 7-83   |
| CHECKED J.B.L.                                   | DATE 7-83 | SCALE H:1 = 20/V:1 = 5' |             |
| CONTRACT NO. DNT-114 SHEET R67 OF R103           |           |                         |             |