


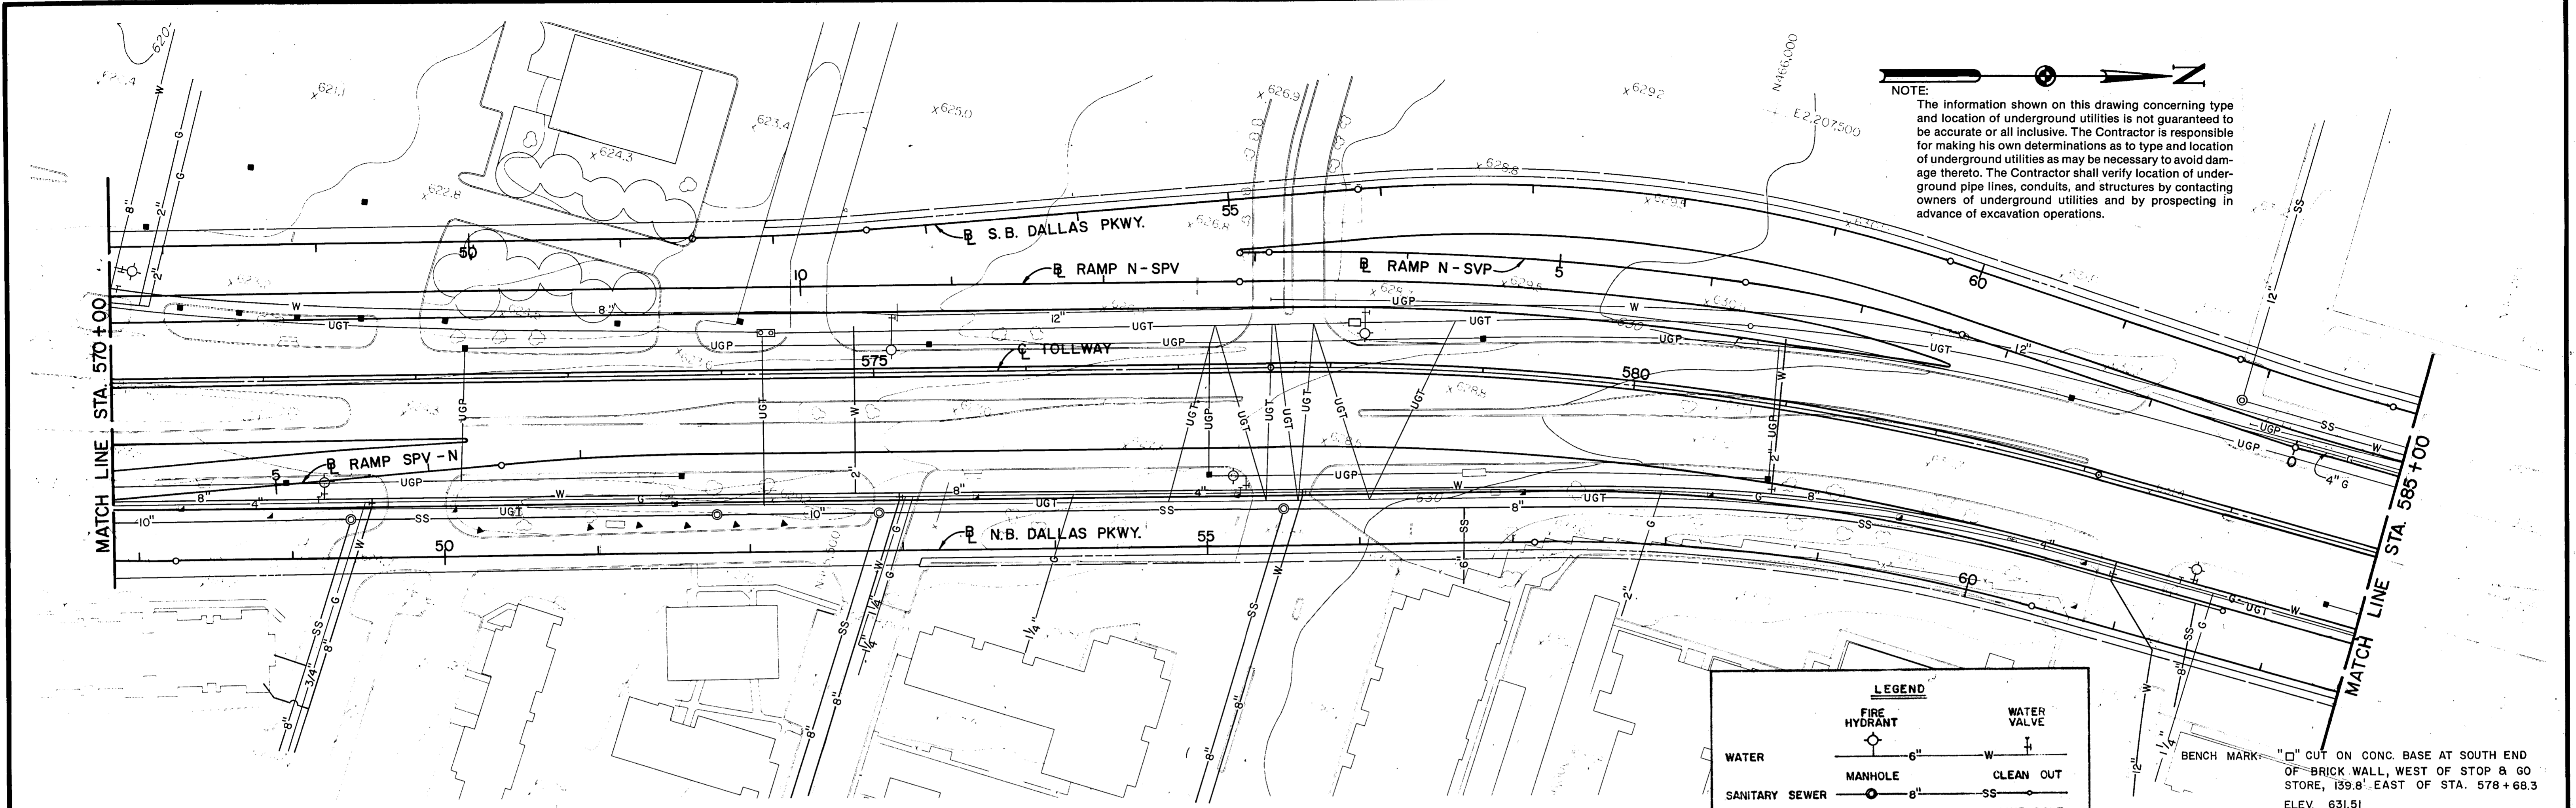


NOTE:
 The information shown on this drawing concerning type and location of underground utilities is not guaranteed to be accurate or all inclusive. The Contractor is responsible for making his own determinations as to type and location of underground utilities as may be necessary to avoid damage thereto. The Contractor shall verify location of underground pipe lines, conduits, and structures by contacting owners of underground utilities and by prospecting in advance of excavation operations.



LEGEND	
WATER	6" W
SANITARY SEWER	8" SS
POWER	UGP
TELEPHONE	UGT
GAS	4" G
FIRE HYDRANT	Symbol
MANHOLE	Symbol
POWER POLE	Symbol
TELE. VAULT	Symbol
WATER VALVE	Symbol
CLEAN OUT	Symbol
LIGHT POLE	Symbol
MANHOLE	Symbol

BENCH MARK: "□" CUT ON CONC. BASE AT SOUTH END OF BRICK WALL, WEST OF STOP & GO STORE, 139.8' EAST OF STA. 578+68.3
 ELEV. 631.51

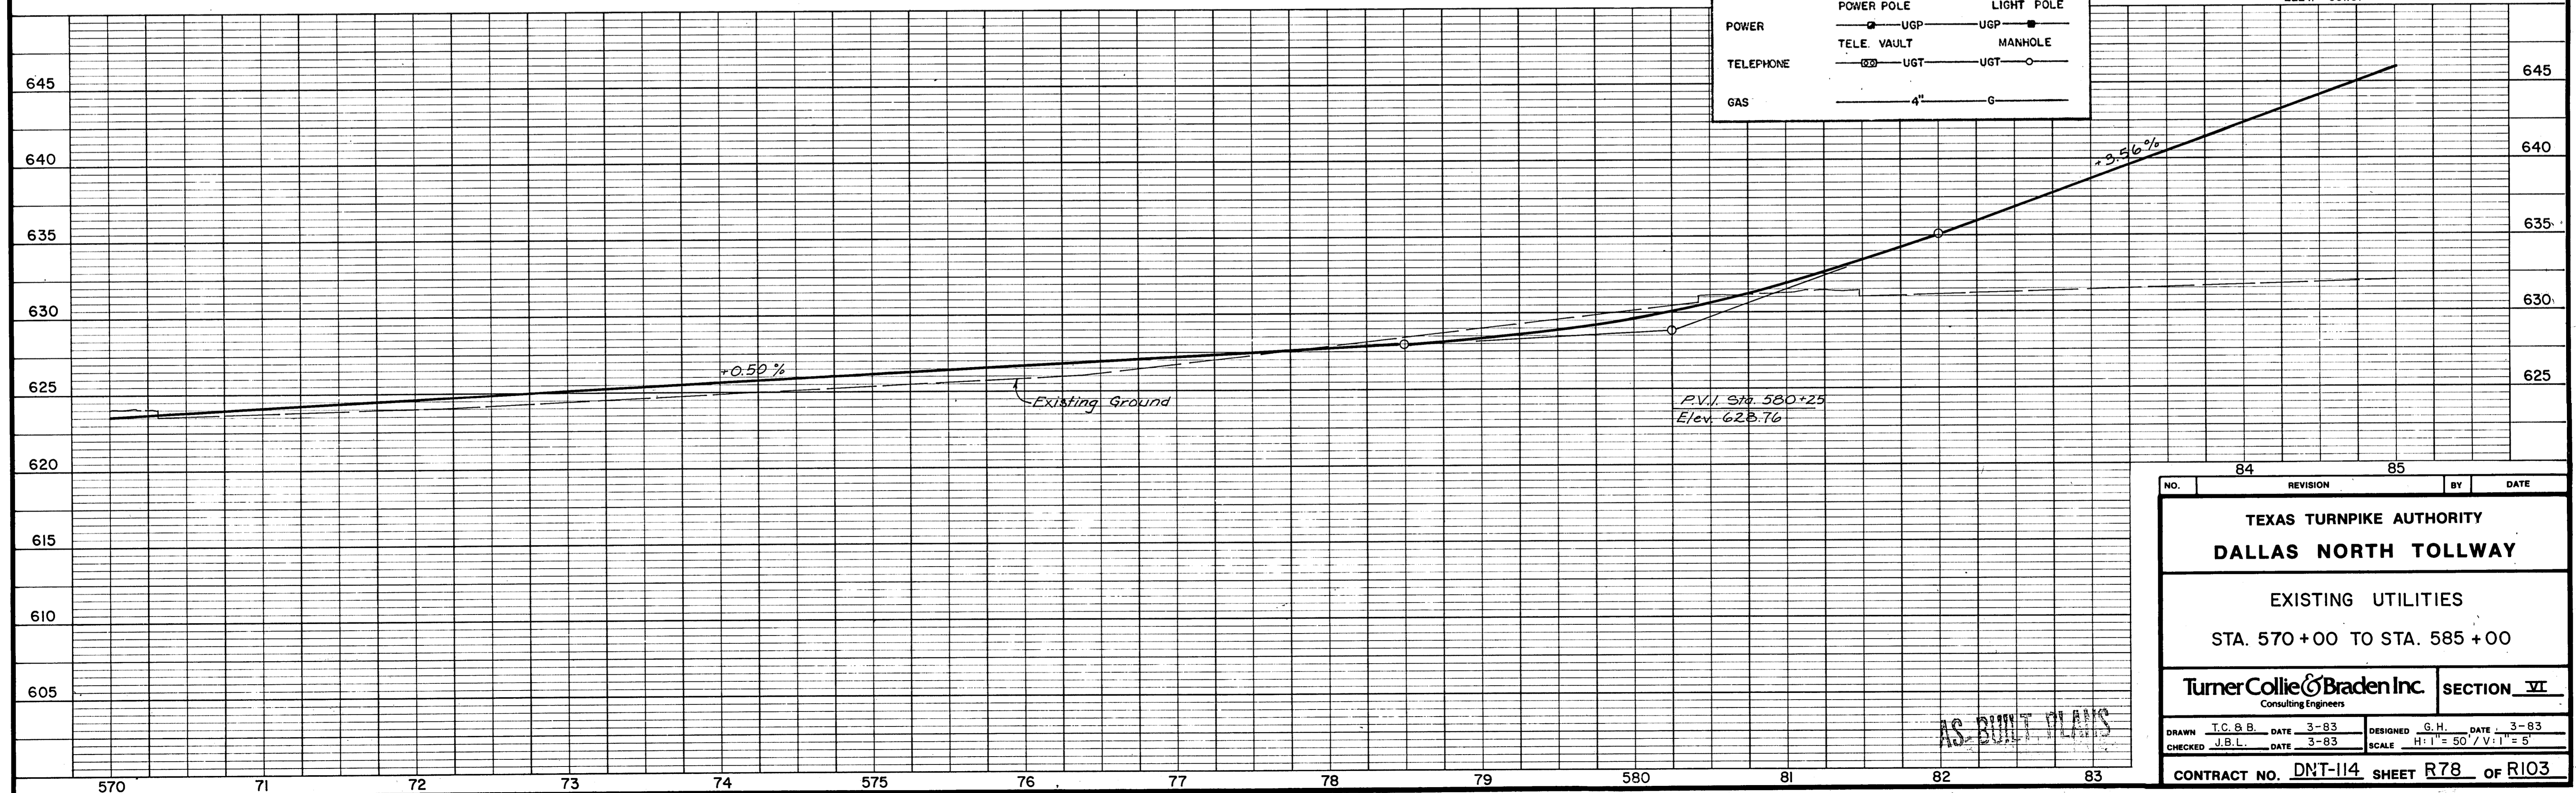

NO.	84	85	REVISION	BY	DATE
TEXAS TURNPIKE AUTHORITY					
DALLAS NORTH TOLLWAY					
EXISTING UTILITIES					
STA. 570+00 TO STA. 585+00					
TurnerCollie & Braden Inc. Consulting Engineers					SECTION VI
DRAWN	T.C.B.	DATE	3-83	DESIGNED	G.H.
CHECKED	J.B.L.	DATE	3-83	SCALE	H:V = 50':1" = 5'
CONTRACT NO. DNT-114 SHEET R78 OF R103					

AS-BUILT PLANS