



NOTE:
The information shown on this drawing concerning type and location of underground utilities is not guaranteed to be accurate or all inclusive. The Contractor is responsible for making his own determinations as to type and location of underground utilities as may be necessary to avoid damage thereto. The Contractor shall verify location of underground pipe lines, conduits, and structures by contacting owners of underground utilities and by prospecting in advance of excavation operations.

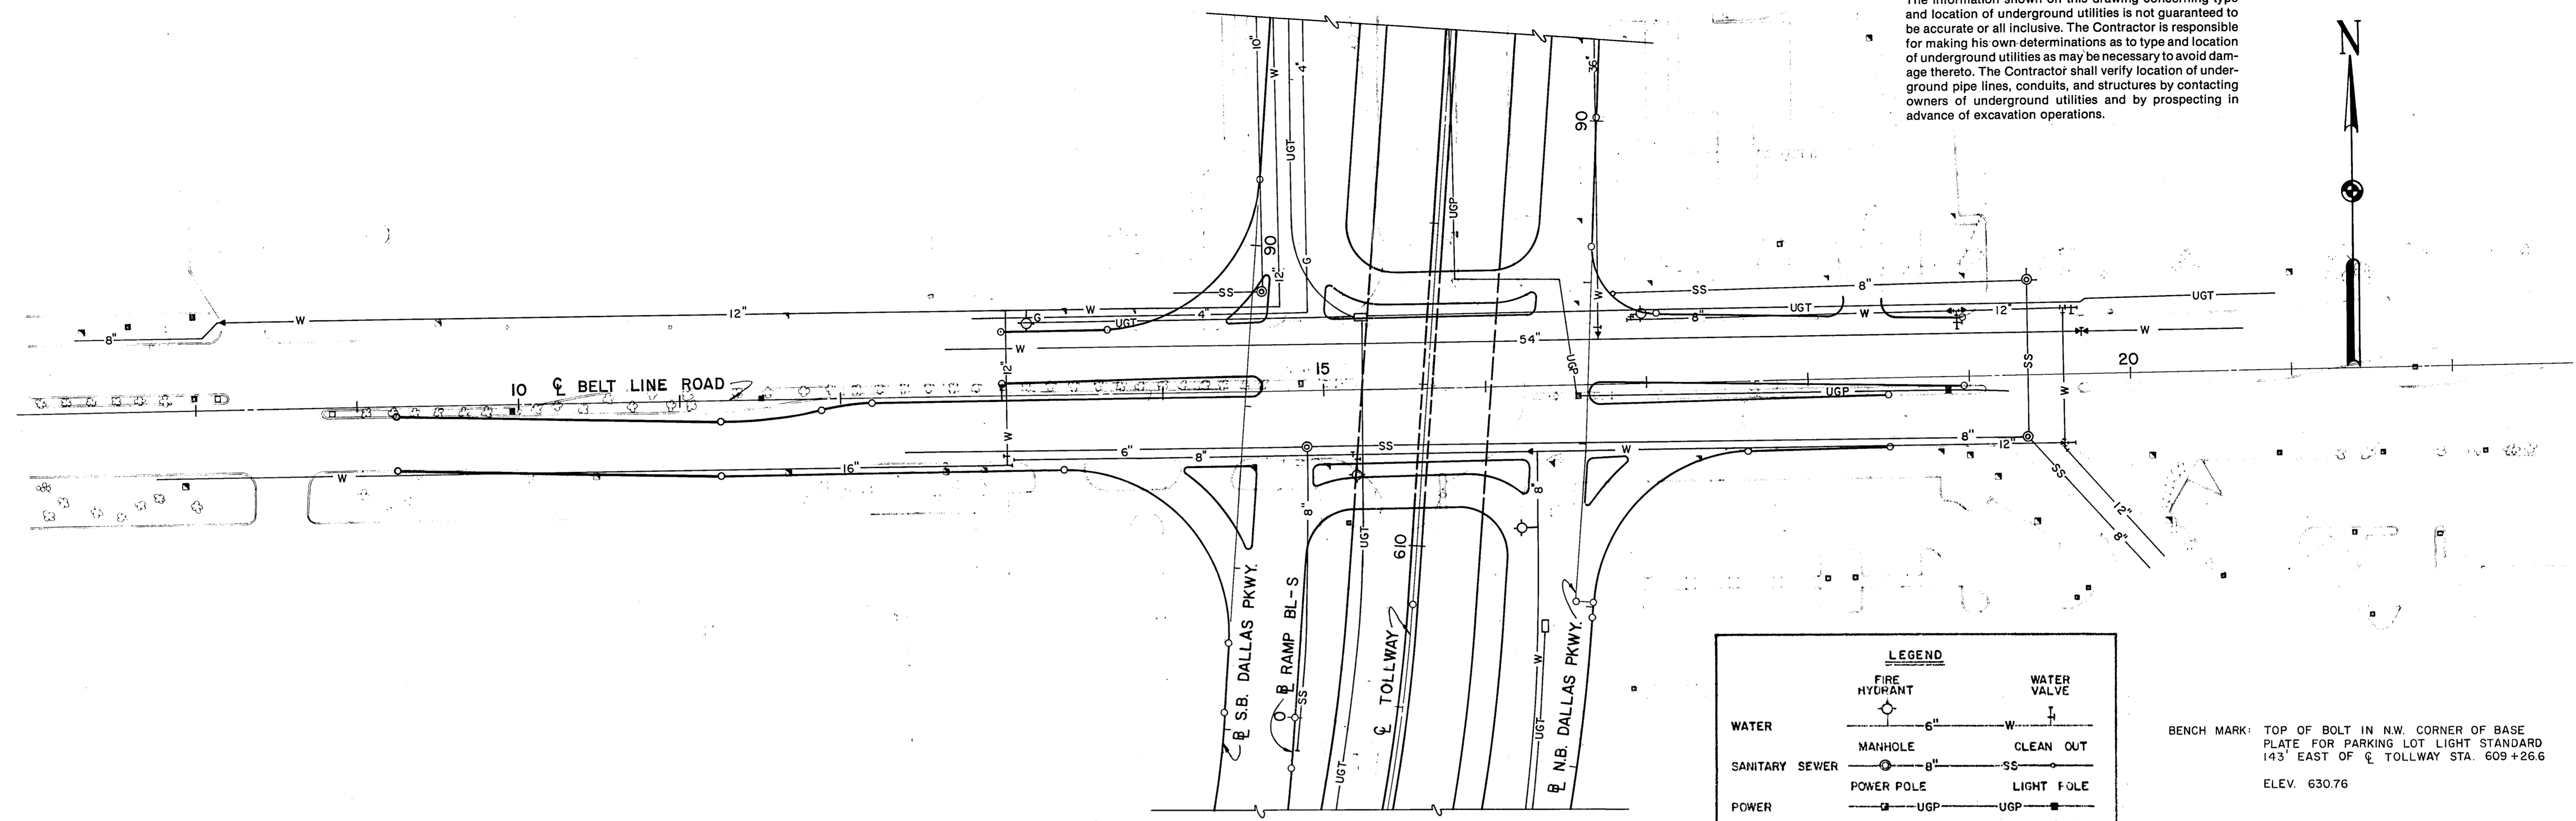

LEGEND	
WATER	6" W
SANITARY SEWER	8" SS
POWER	UGP
TELEPHONE	UGT
GAS	4" G
FIRE HYDRANT	○
MANHOLE	○
POWER POLE	□
TELE. VAULT	⊗
WATER VALVE	⊥
CLEAN OUT	○
LIGHT POLE	□
MANHOLE	○

BENCH MARK: TOP OF BOLT IN N.W. CORNER OF BASE PLATE FOR PARKING LOT LIGHT STANDARD 143' EAST OF ♀ TOLLWAY STA. 609+26.6
ELEV. 630.76

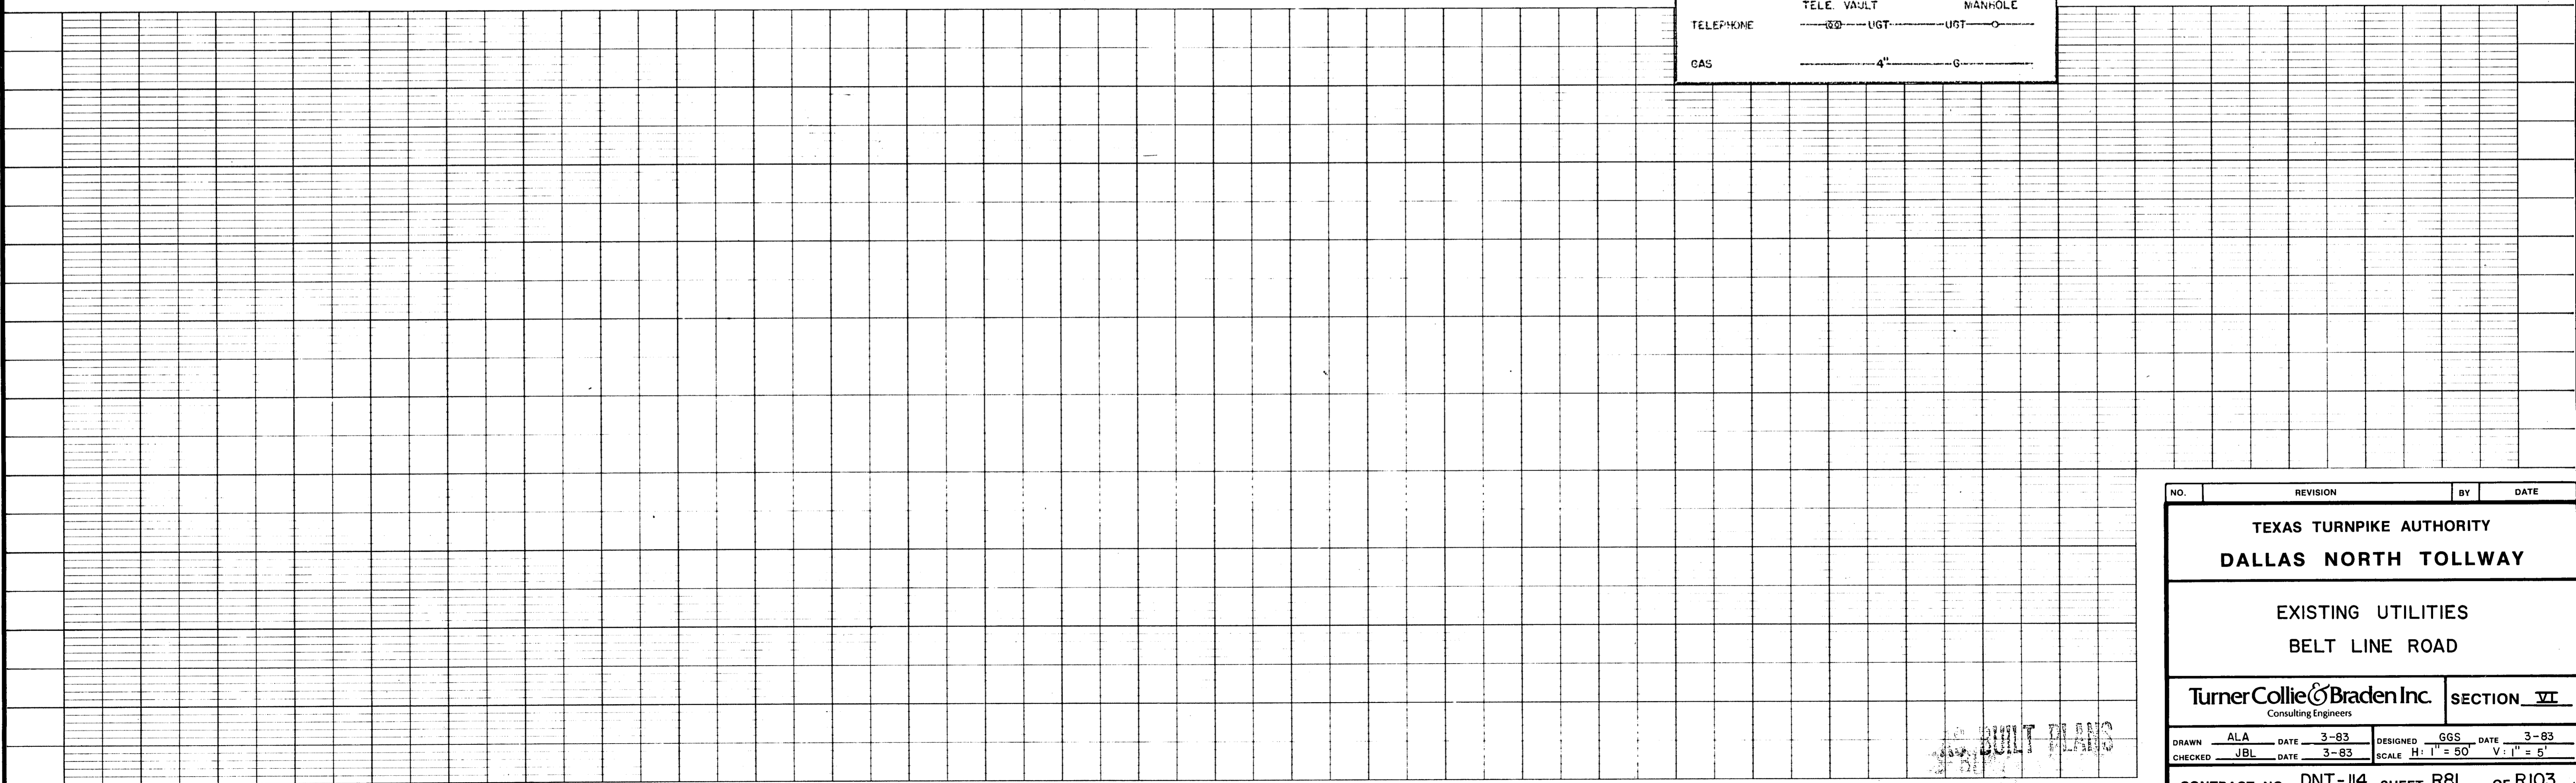

NO.	REVISION	BY	DATE
TEXAS TURNPIKE AUTHORITY			
DALLAS NORTH TOLLWAY			
EXISTING UTILITIES BELT LINE ROAD			
Turner Collie & Braden Inc. Consulting Engineers			SECTION VI
DRAWN ALA	DATE 3-83	DESIGNED GGS	DATE 3-83
CHECKED JBL	DATE 3-83	SCALE H: 1" = 50'	V: 1" = 5'
CONTRACT NO. DNT-114 SHEET R81 OF R103			

BUILT PLANS