


GENERAL NOTES:  
 FOR RETAINING WALL DESIGN AND DETAILS, SEE STANDARD DRAWING NUMBERS 42 AND 43.  
 FOR ABUTMENT DETAILS, SEE SHEET NUMBER  
 EXPANSION JOINTS ARE NOTED. ALL OTHER JOINTS SHALL BE CONTRACTION.  
 ○ DENOTES PANEL NUMBER.  
 □ DENOTES MATCH POINT.  
 FOR TYPE C4 RAILING DETAILS, SEE STANDARD DRAWING NUMBER 33.

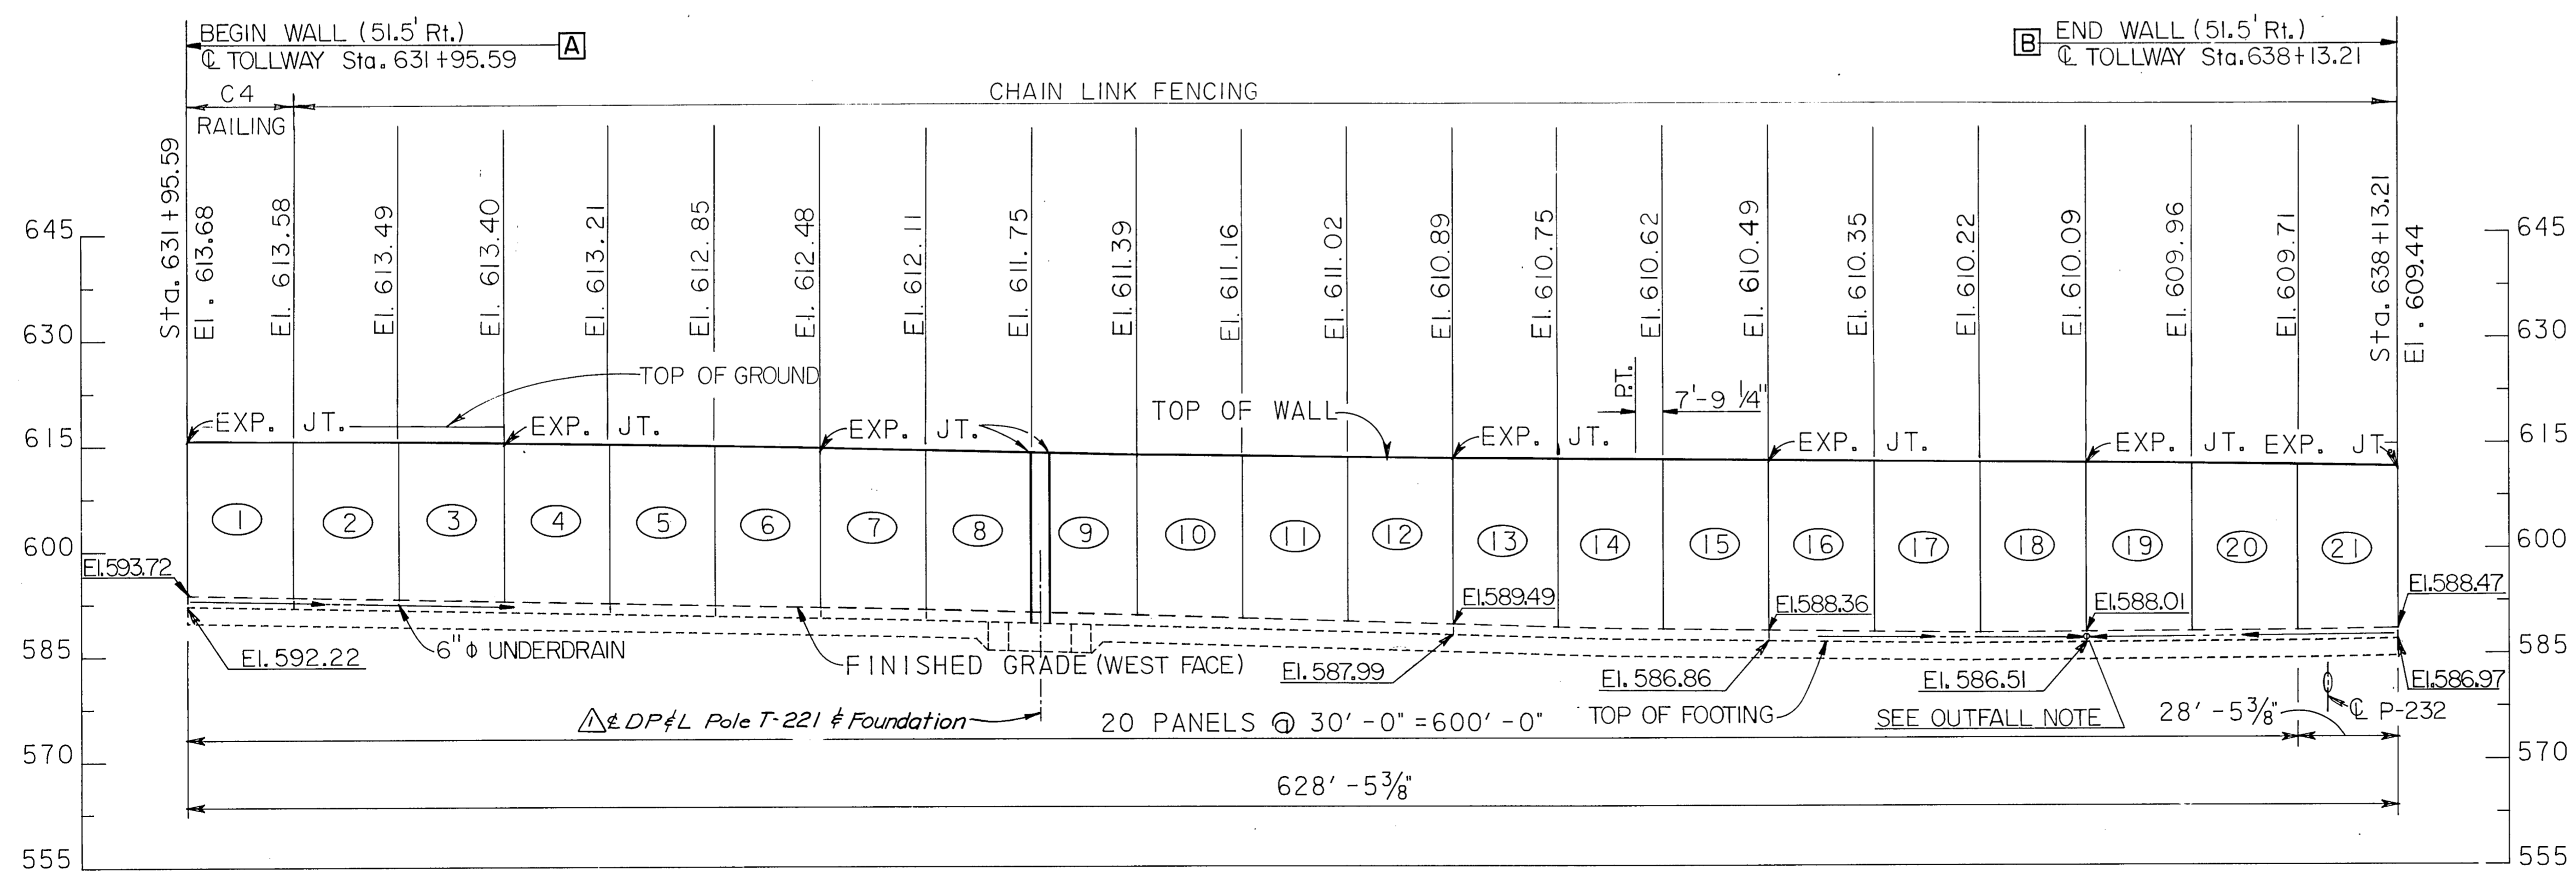

**ASBUILT PLANS**

NO.	REVISION	BY	DATE
	Add DP&L Pole & Foundation	AMM	7-20-85
<b>TEXAS TURNPIKE AUTHORITY</b> <b>DALLAS NORTH TOLLWAY</b>			
ARAPAHO ROAD - S.S.W. RAILWAY - EAST RETAINING WALLS PLAN AND ELEVATION			
Turner Collie & Braden Inc. <small>Consulting Engineers</small>			SECTION VI
DRAWN	RGD	DATE	8-83
CHECKED	TJR	DATE	8-83
DESIGNED	TJR	DATE	7-83
SCALE	AS NOTED		
CONTRACT NO. DNT-114 SHEET S-82 OF S-85			

ESTIMATED QUANTITY SUMMARY

ITEM NO.	DESCRIPTION	UNIT	QUANTITY
423	RETAINING WALL (OPTIONAL)	S.F.	13,581
450	RAILING (WALL) (TYPE C4)	L.F.	30.0
450	RAILING (WALL) (PARAPET ONLY)	L.F.	598.4
556	PIPE UNDERDRAIN (6") (N.R.C.P)	L.F.	11

WALL NO. W-108