
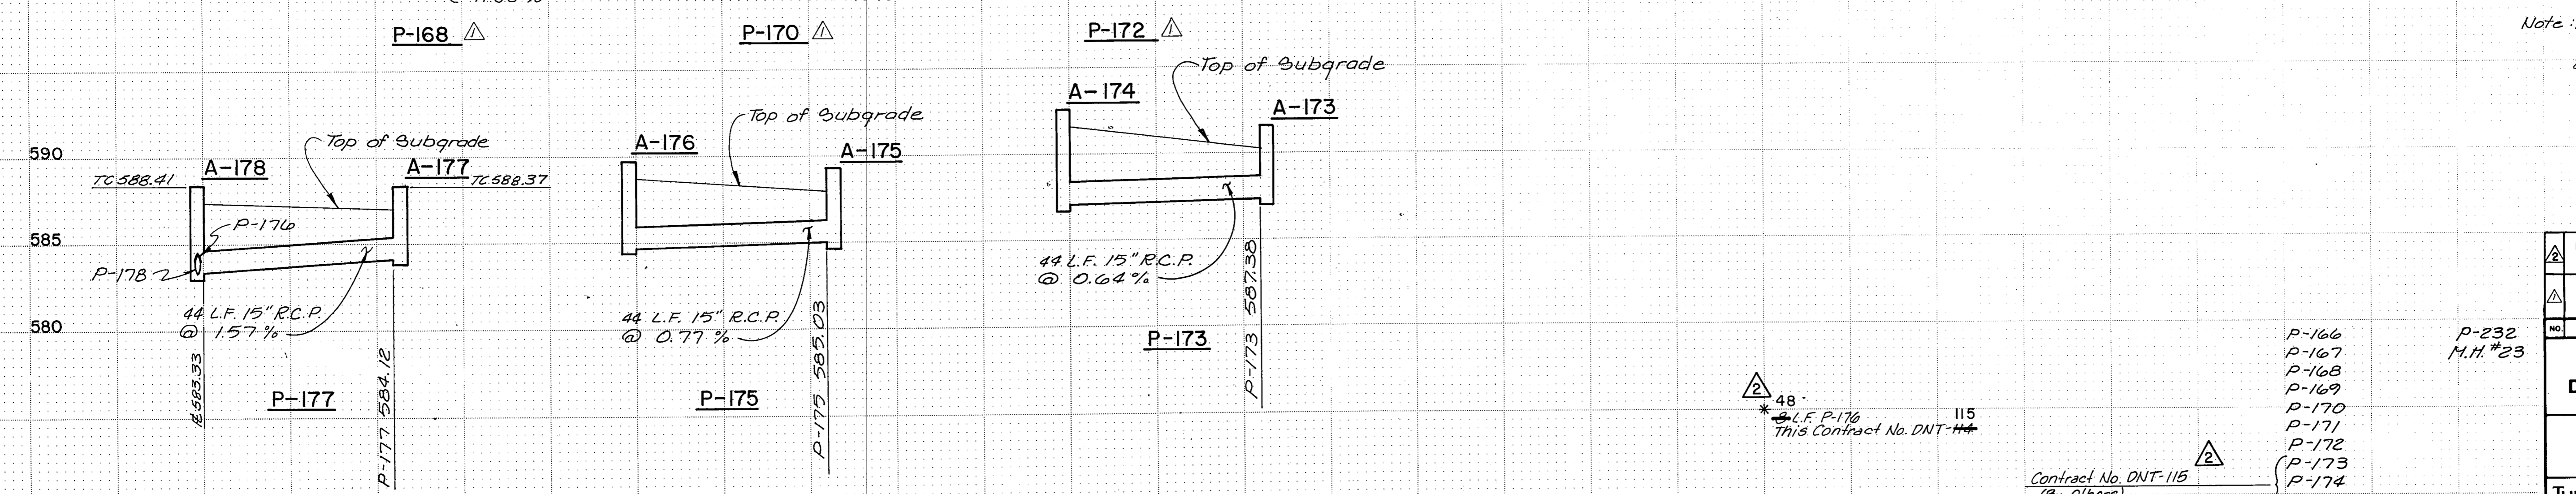
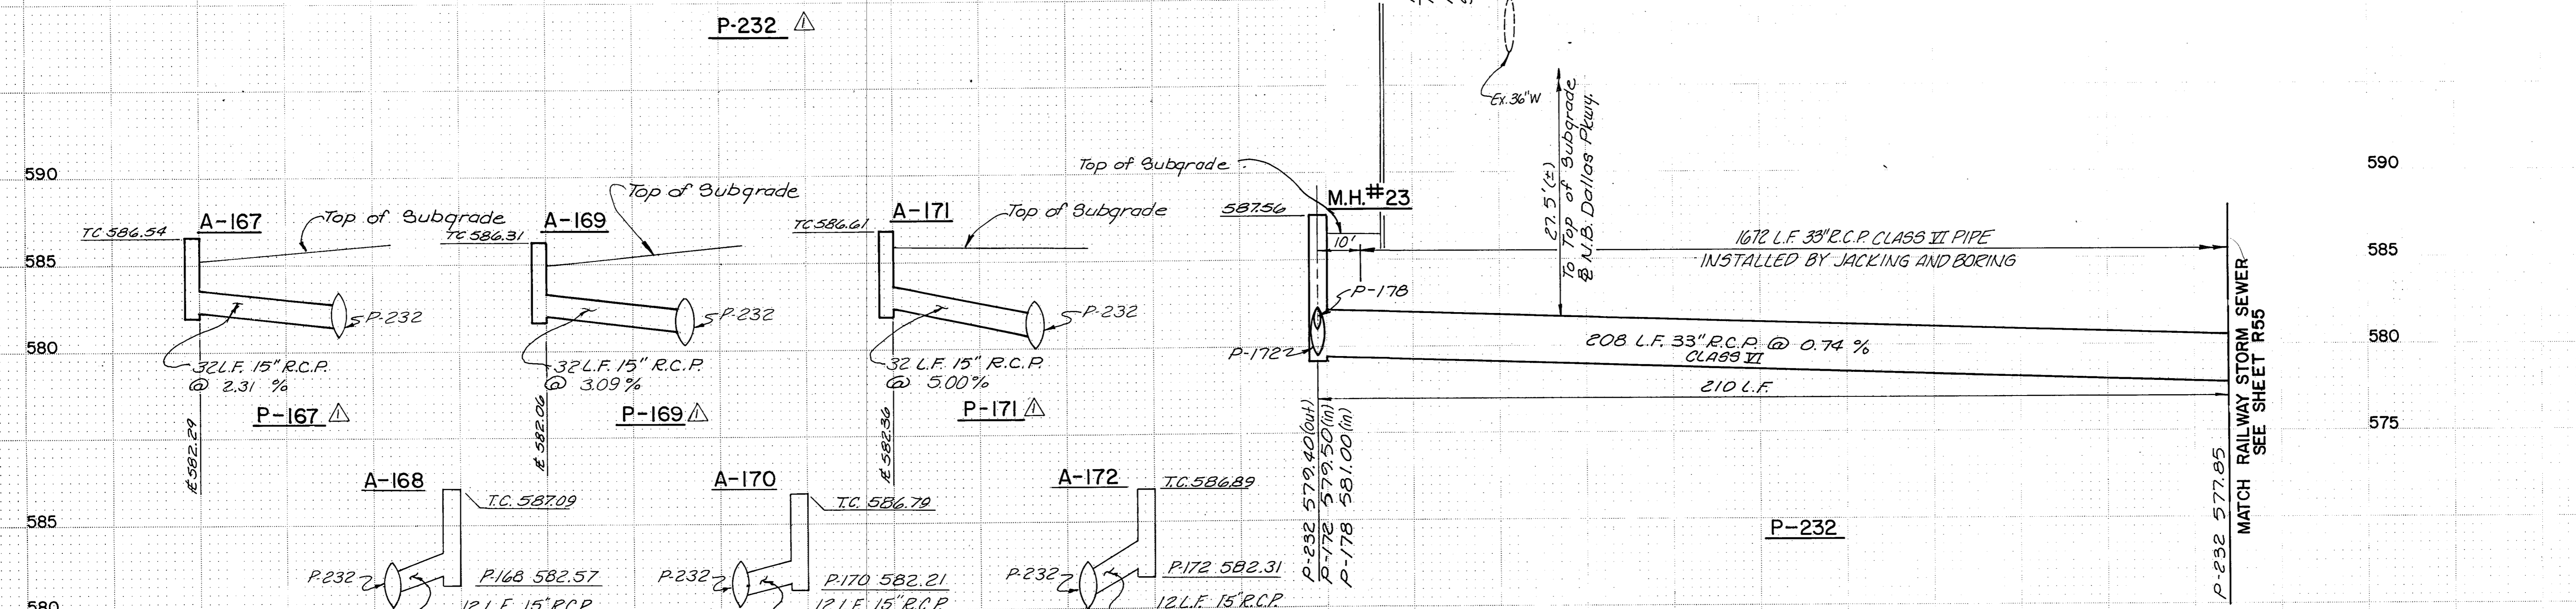


CONTRACT NO. DNT-114 (BY OTHERS) CONTRACT NO. DNT-115 (BY OTHERS)

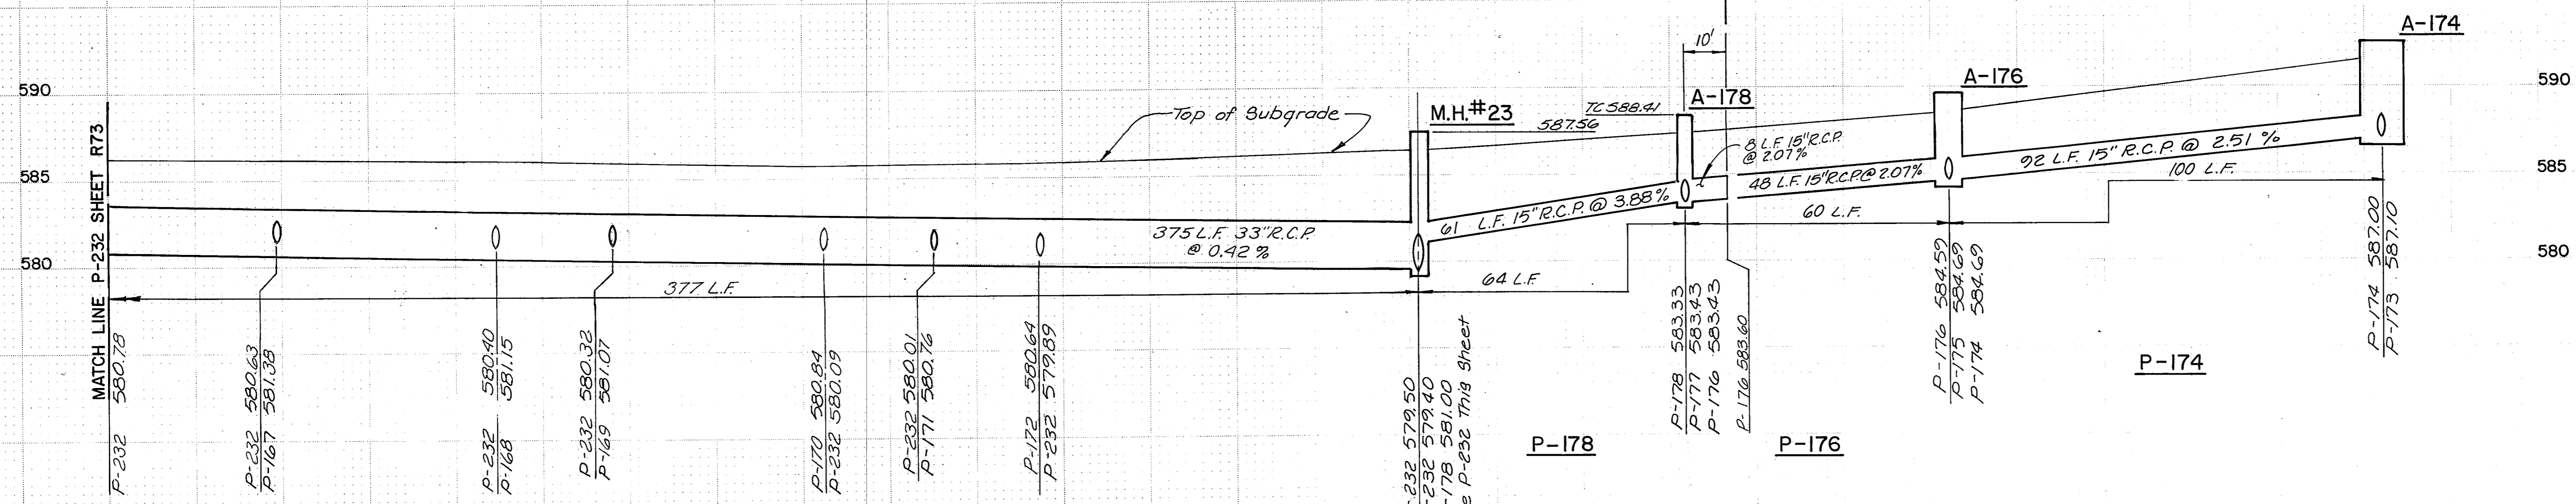

Note: 1. All R.C.P. to be Class III unless noted, R15  
 2. See sheet R44 for horizontal location of pipes.

- P-166
- P-167
- P-168
- P-169
- P-170
- P-171
- P-172
- P-173
- P-174
- P-175
- P-176 \*
- P-177
- P-178

48' \* L.F. P-176 This Contract No. DNT-114

Contract No. DNT-115 (By Others)

REVISION	BY	DATE
TEXAS TURNPIKE AUTHORITY DALLAS NORTH TOLLWAY		
STORM SEWER PROFILE		
Turner Collier & Braden Inc.		SECTION VII
MADE D.W.G. DATE 7-83	TRACED A.L.A. DATE 7-83	
CHECKED J.B.L. DATE 7-83	SCALE H11 = 20' / V11 = 5'	
CONTRACT NO. DNT-115 SHEET R49 OF R85		