

**INDEX OF SHEETS**

SHEET No.	TITLE
1	TITLE SHEET
C1 - C3	GEOMETRIC CONTROLS & TRAVERSE TIES
R1 - R2	TYPICAL SECTION
R3 - R4	ESTIMATED QUANTITY SUMMARY
R5 - R14	PAVING & GRADING - DALLAS PARKWAY
R15 - R24	PAVING & GRADING - TOLLWAY
R25	RAMP PROFILES
R26 - R28	PAVING PLAN - TOLL PLAZA AREA
R29 - R33	PAVING PLAN - INTERSECTIONS AND RAMPS
R34 - R40	SUGGESTED CONSTRUCTION SEQUENCE AND TRAFFIC CONTROL
R41 - R43	DRAINAGE AREA MAP
R44 - R48	DRAINAGE SUMMARY
R49 - R67	STORM SEWER PROFILES
R68 - R69	BOX CULVERT - STATION 642+50
R70 - R72	BOX CULVERT - STATION 678+20
R73	PIPE HEADWALL AND RIPRAP DETAILS - STATION 737+50
R74	MISCELLANEOUS DETAILS
R75 - R84	EXISTING UTILITIES
R85	MISCELLANEOUS DETAILS - SIGNING & STRIPING
<b>RETAINING WALLS</b>	
W1 - W5	SSW RAILWAY UNDERPASS
W6 - W10	KELLER SPRINGS ROAD OVERPASS
W11 - W12	WEST GROVE DRIVE OVERPASS
*	STATION 669+50 TO STATION 714+50 * W13 - W22 TRINITY MILLS/BRIARGROVE
<b>KELLER SPRINGS ROAD OVERPASS</b>	
S1	GENERAL PLAN AND ELEVATION
S2	FOUNDATION PLAN
S3	SOUTH ABUTMENT DETAILS
S4	NORTH ABUTMENT DETAILS
S5 - S6	BENT DETAILS
S7 - S8	SLAB DETAILS
S9	SLAB ELEVATIONS
<b>WEST GROVE DRIVE OVERPASS</b>	
S10	GENERAL PLAN AND ELEVATION
S11	FOUNDATION PLAN
S12	SOUTH ABUTMENT DETAILS
S13	NORTH ABUTMENT DETAILS
S14 - S15	BENT DETAILS
S16 - S17	SLAB DETAILS
S18 - S20	SLAB ELEVATIONS
S21	PRESTRESSED CONCRETE BEAMS - DESIGN DETAILS

**TEXAS TURNPIKE AUTHORITY**

**CONTRACT NO. DNT 115**


**GRADING, DRAINAGE,  
PAVING AND STRUCTURES**

**SECTION VII  
VOLUME 1**

**STANDARD DRAWINGS**

STD. No.	TITLE
1	TOLLWAY INLET TYPE "C"
2	TOLLWAY MEDIAN INLET TYPE "M"
3	TOLLWAY GUTTER INLET TYPE "G"
4	STANDARD INLET TYPE "CDR" - 3', 4' & 5'
5	STANDARD INLET TYPE "CDR" - 6', 8' & 10'
6	RECESSED AND "Y" INLET DETAILS
7	STANDARD TOLLWAY MANHOLES TYPE I, II & III
8	MANHOLE DETAILS
9	STANDARD UNDERDRAINS
10	MISCELLANEOUS DETAILS - TOLLWAY
11	TOLLWAY PAVEMENT DETAILS - JOINTED REINFORCED
12	CONCRETE PAVING DETAILS - JOINT SEALS
13	MISCELLANEOUS DETAILS - SERVICE ROADS
14 & 15	CONCRETE RIPRAP SLOPE PROTECTION WITH WALLS
16	APPROACH SLAB DETAILS
17	PRESTRESSED CONCRETE BEAMS - BEAM DETAILS
18	PRESTRESSED CONCRETE BEAMS - BEAM ENDS & BEARINGS
19	PRESTRESSED CONCRETE BEAMS - MINIMUM ERECTION AND BRACING REQUIREMENTS - TYPE "C" BEAMS
20	INTERIOR DIAPHRAGM AND PRECAST RAIL ANCHORAGE DETAILS
21	ARMOR JOINT DETAILS
22	BRIDGE PROTECTIVE ASSEMBLY
23	CONCRETE TRAFFIC RAIL TYPE T5
24	CONCRETE TRAFFIC BARRIER - TYPE 1
25	CONCRETE TRAFFIC BARRIER TYPE 2 & 3
26-27	MISCELLANEOUS ELECTRICAL DETAILS
28	ELEVATED ROADWAY SECTION - CAST-IN-PLACE CONCRETE
29	RETAINING WALL DETAILS
30	DEPRESSED ROADWAY SECTION - CAST-IN-PLACE CONCRETE
31	RETAINING WALL DETAILS
32	BARRICADES AND CONSTRUCTION STANDARDS
33	CONCRETE BARRIER RAIL (PORTABLE & PRECAST)
34	MULTIPLE BOX CULVERTS - MC 8-3
35	MULTIPLE BOX CULVERTS - MC 10-2
36	MULTIPLE BOX CULVERTS - MC 10-3
37	PRECAST CONCRETE BOX CULVERTS - PC-3
38	FLARED WINGWALLS FOR MULTIPLE CULVERTS - MCW-F2
39	PARALLEL WINGS FOR MULTIPLE BOX CULVERTS - MCW-P-45
40	MULTIPLE BOX CULVERT - 45 DEGREE SKEW

**DALLAS NORTH TOLLWAY**

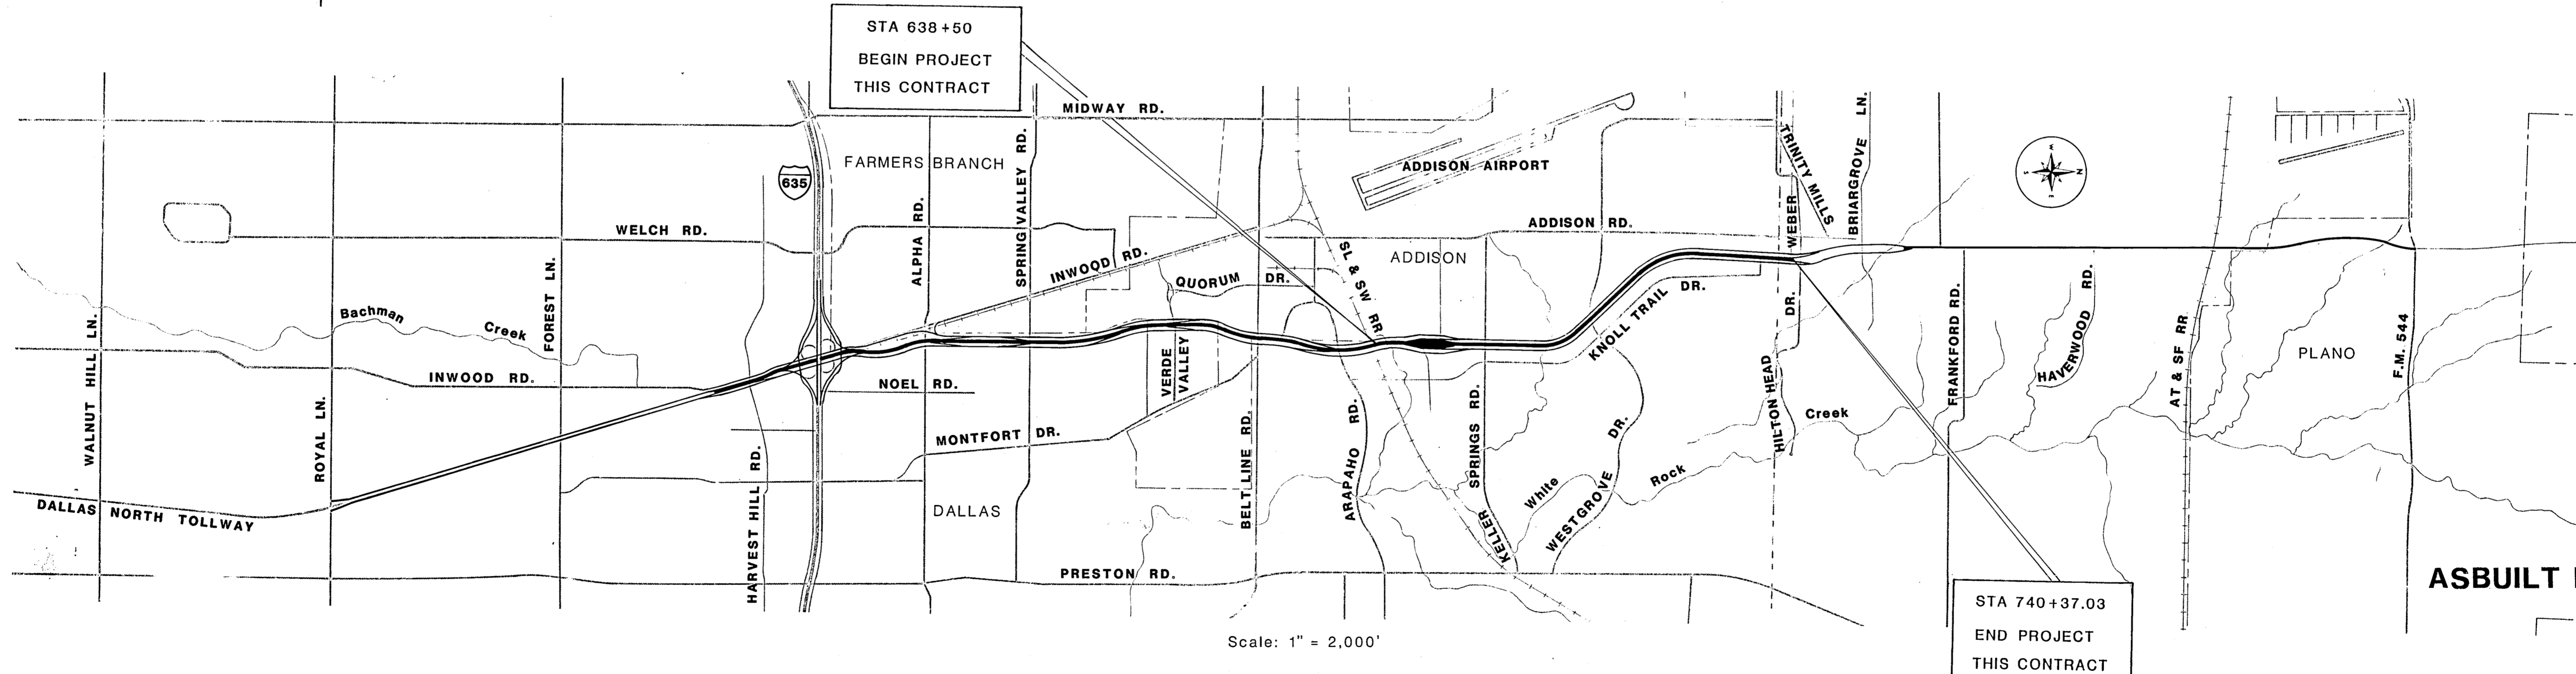

APPROVED by:  
CITY of DALLAS  
*Clifford J. Kelly*  
DIRECTOR of PUBLIC WORKS

APPROVED by:  
*[Signature]*

Prepared by:  
GIBBS & HILL, INC./BRIDGEFARMER & ASSOCIATES, INC.  
*David W. Clay*

Recommended by:  
HOWARD, NEEDLES, TAMMEN & BERGENDOFF  
*Daniel F. Becker*  
Engineer in Charge

Recommended by:  
TEXAS TURNPIKE AUTHORITY  
*James W. Duffin*  
Director, Engineering & Maintenance

Approved by:  
TEXAS TURNPIKE AUTHORITY  
*[Signature]*  
Engineer Manager

DATE: 3/20/84

DATE:

Date: September 6, 1984

Date: Sept 6, 1984


Date: Sept. 6, 1984

Date: 9-7-84

FF-13

FF-13



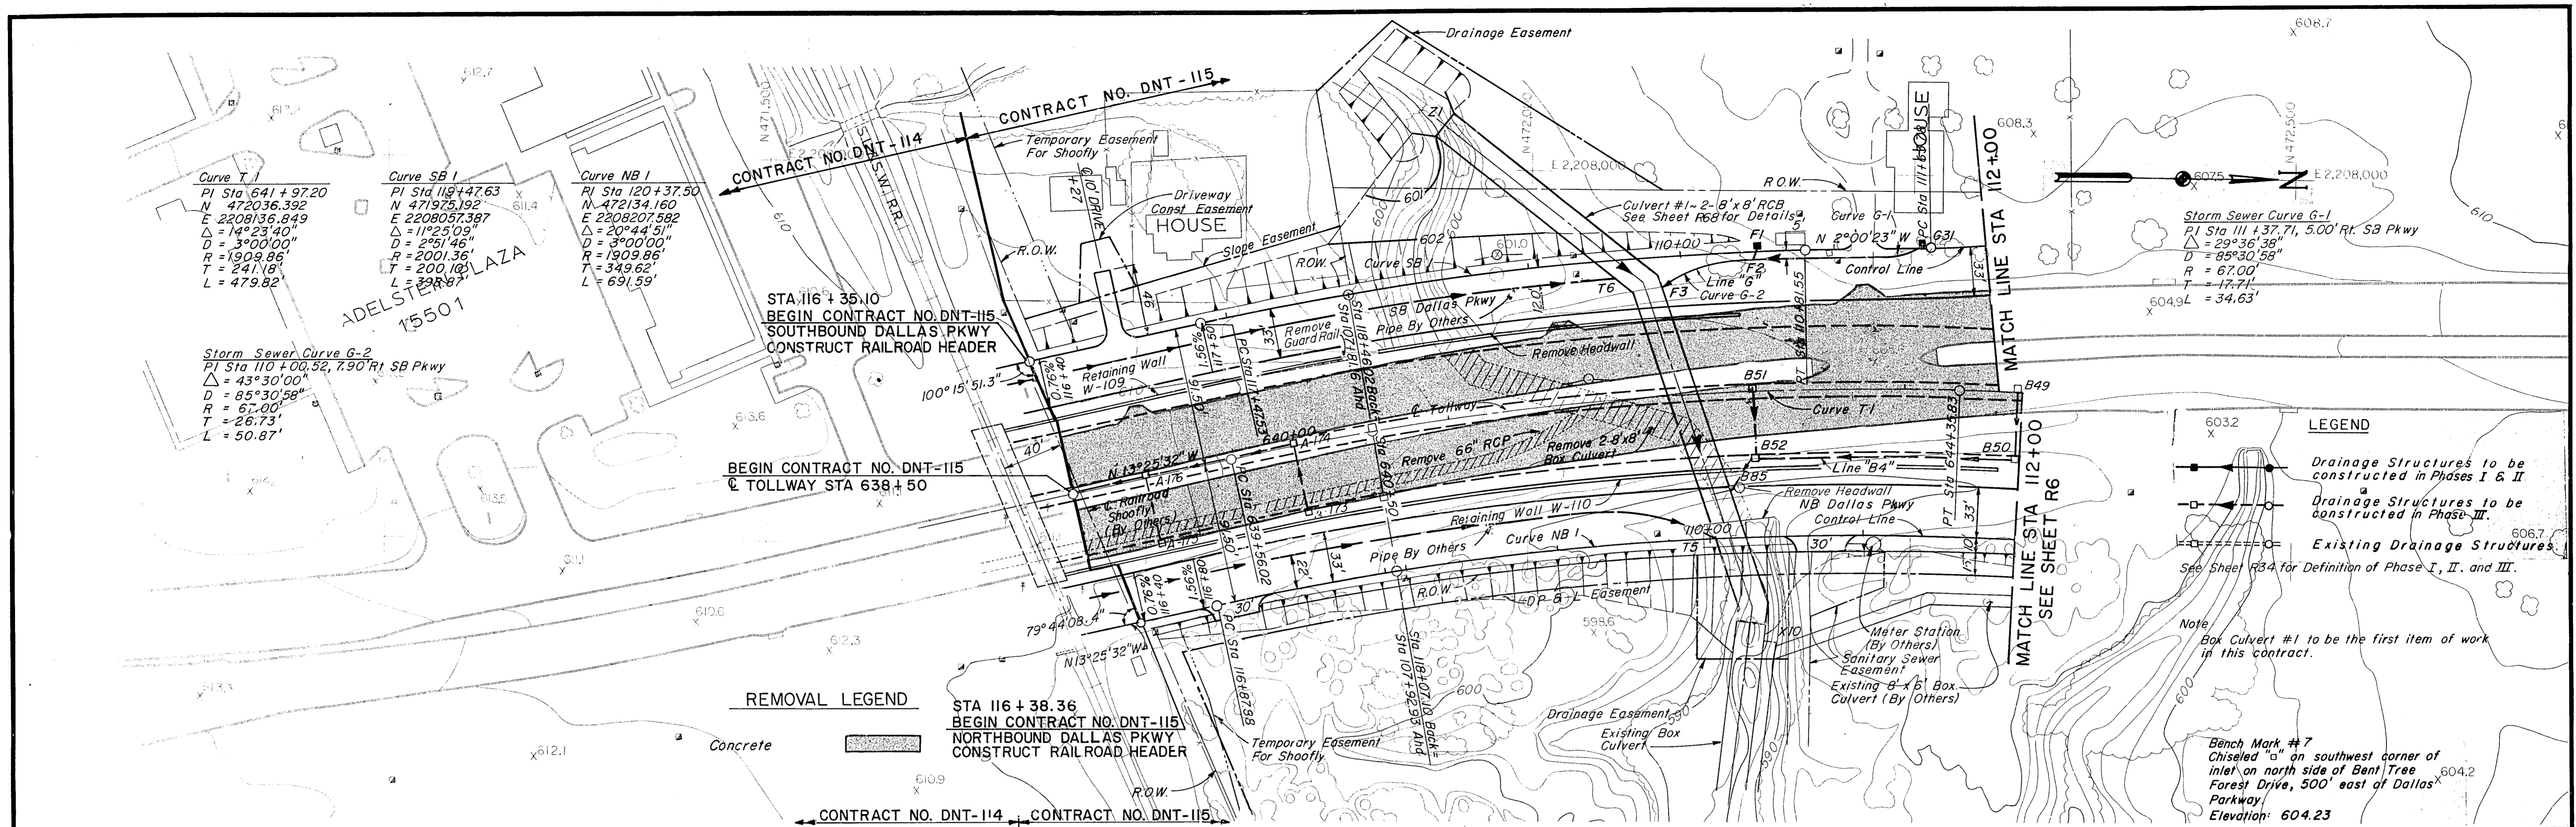

Curve T-1  
 PI Sta 641+97.20  
 N 472036.392  
 E 2208136.849  
 Δ = 14°23'40"  
 D = 3°00'00"  
 R = 1909.86'  
 T = 241.18'  
 L = 479.82'

Curve SB 1  
 PI Sta 119+47.63  
 N 471975.192  
 E 2208057.387  
 Δ = 11°25'09"  
 D = 2°51'46"  
 R = 2001.36'  
 T = 200.162'  
 L = 39.87'

Curve NB 1  
 PI Sta 120+37.50  
 N 472134.160  
 E 2208207.582  
 Δ = 20°44'51"  
 D = 3°00'00"  
 R = 1909.86'  
 T = 349.62'  
 L = 691.59'

Storm Sewer Curve G-2  
 PI Sta 110+00.52, 7.90' R<sub>1</sub> SB Pkwy  
 Δ = 43°30'00"  
 D = 85°30'58"  
 R = 67.00'  
 T = 26.73'  
 L = 50.87'

Storm Sewer Curve G-1  
 PI Sta 111+37.71, 5.00' R<sub>1</sub> SB Pkwy  
 Δ = 29°36'38"  
 D = 85°30'58"  
 R = 67.00'  
 T = 17.71'  
 L = 34.63'


REMOVAL LEGEND  
 Concrete

LEGEND  
 Drainage Structures to be constructed in Phases I & II  
 Drainage Structures to be constructed in Phase III  
 Existing Drainage Structures  
 See Sheet R34 for Definition of Phase I, II, and III.

Note  
 Box Culvert #1 to be the first item of work in this contract.

Bench Mark #7  
 Chiseled "o" on southwest corner of inlet on north side of Bent Tree Forest Drive, 500' east of Dallas Parkway  
 Elevation: 604.23



Notes:  
 1. See Sheet R15 for Tollway Plan & Profile.  
 2. See Sheet R50 for Line "B" Storm Sewer Profile.  
 3. See Sheets R68 and R69 for Box Culvert Details.  
 4. See Sheet R2 for Railroad Header Details.  
 5. See Cross Sections for Slopes.  
 6. See Sheets R15 and W1 and cross sections for temporary shoring details.

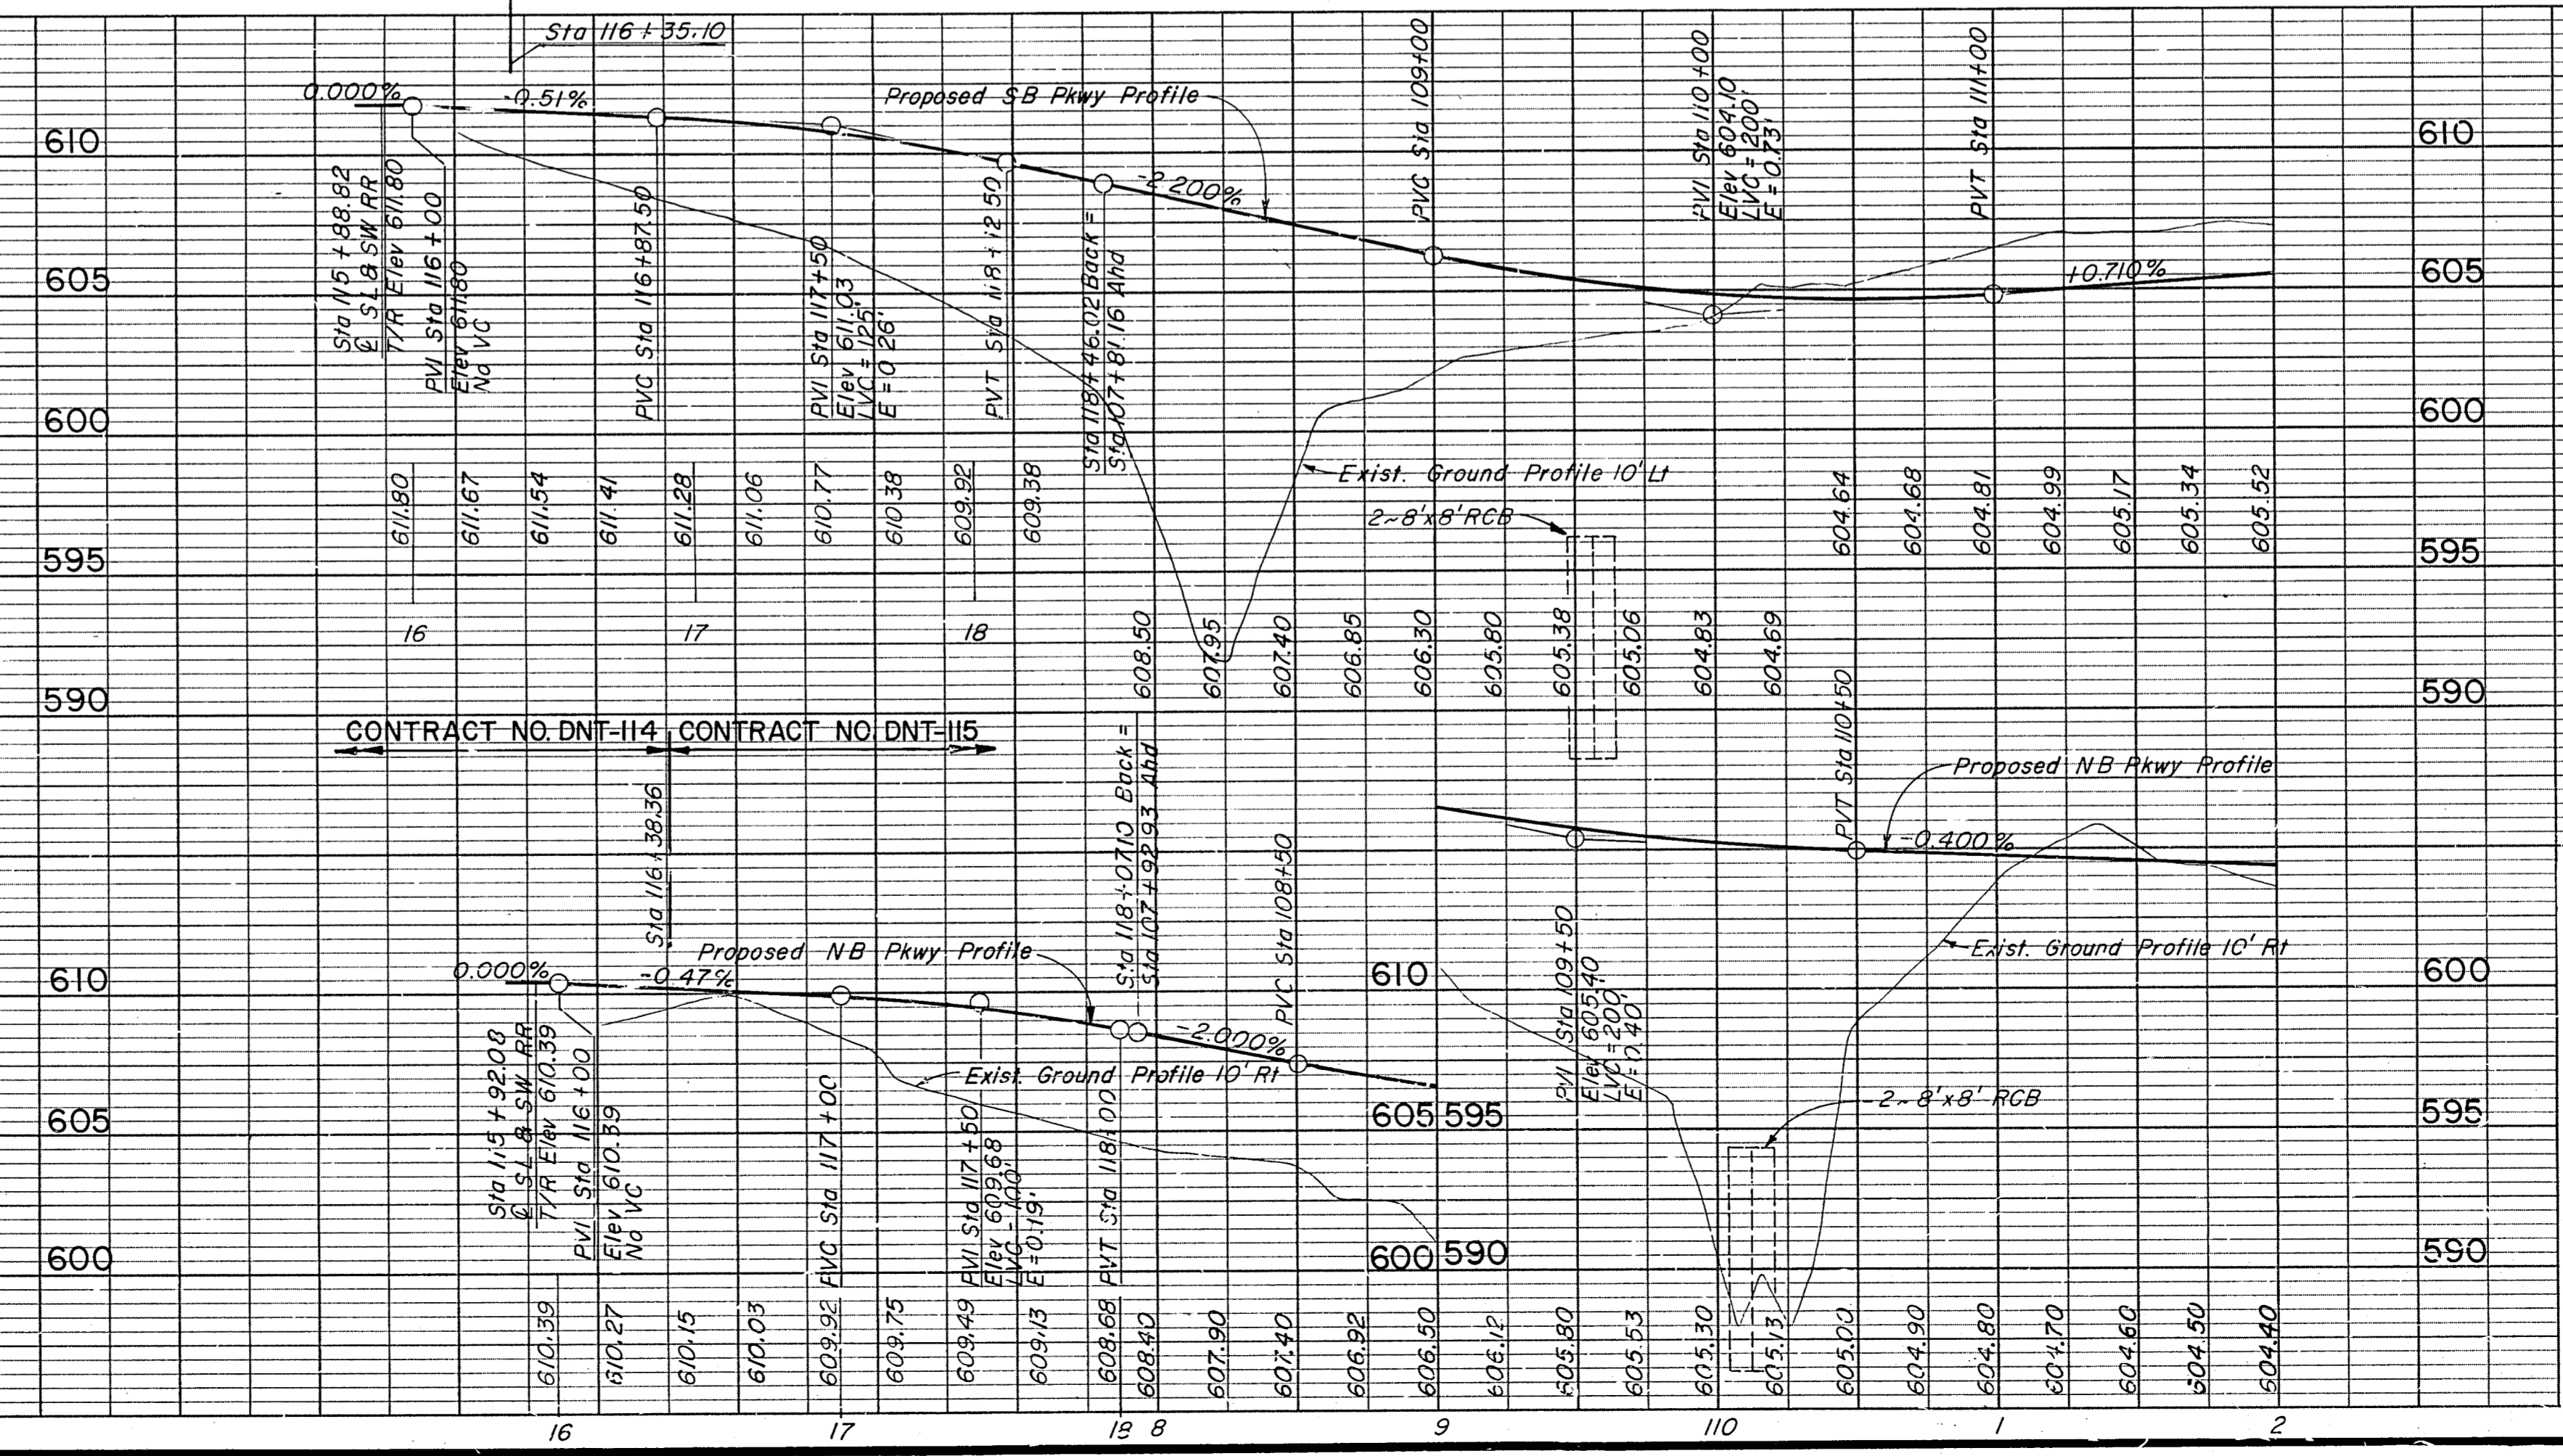

ASBUILT PLANS

NO.	REVISION	BY	DATE
<b>TEXAS TURNPIKE AUTHORITY</b> <b>DALLAS NORTH TOLLWAY</b> PAVING AND GRADING DALLAS PARKWAY STA 107+81.16 TO STA 112+00 <b>Gibbs &amp; Hill, Inc.</b> ENGINEERS DESIGNERS CONSTRUCTORS DALLAS			
SECTION VII			DATE 4/1/83
DRAWN CJB		DATE 4/1/83	DESIGNED DWG
CHECKED DWG		DATE 5/4/84	SCALE 1"=50' Hor 1"=5' Vert
CONTRACT NO. DNT-115 SHEET R5 OF R85			



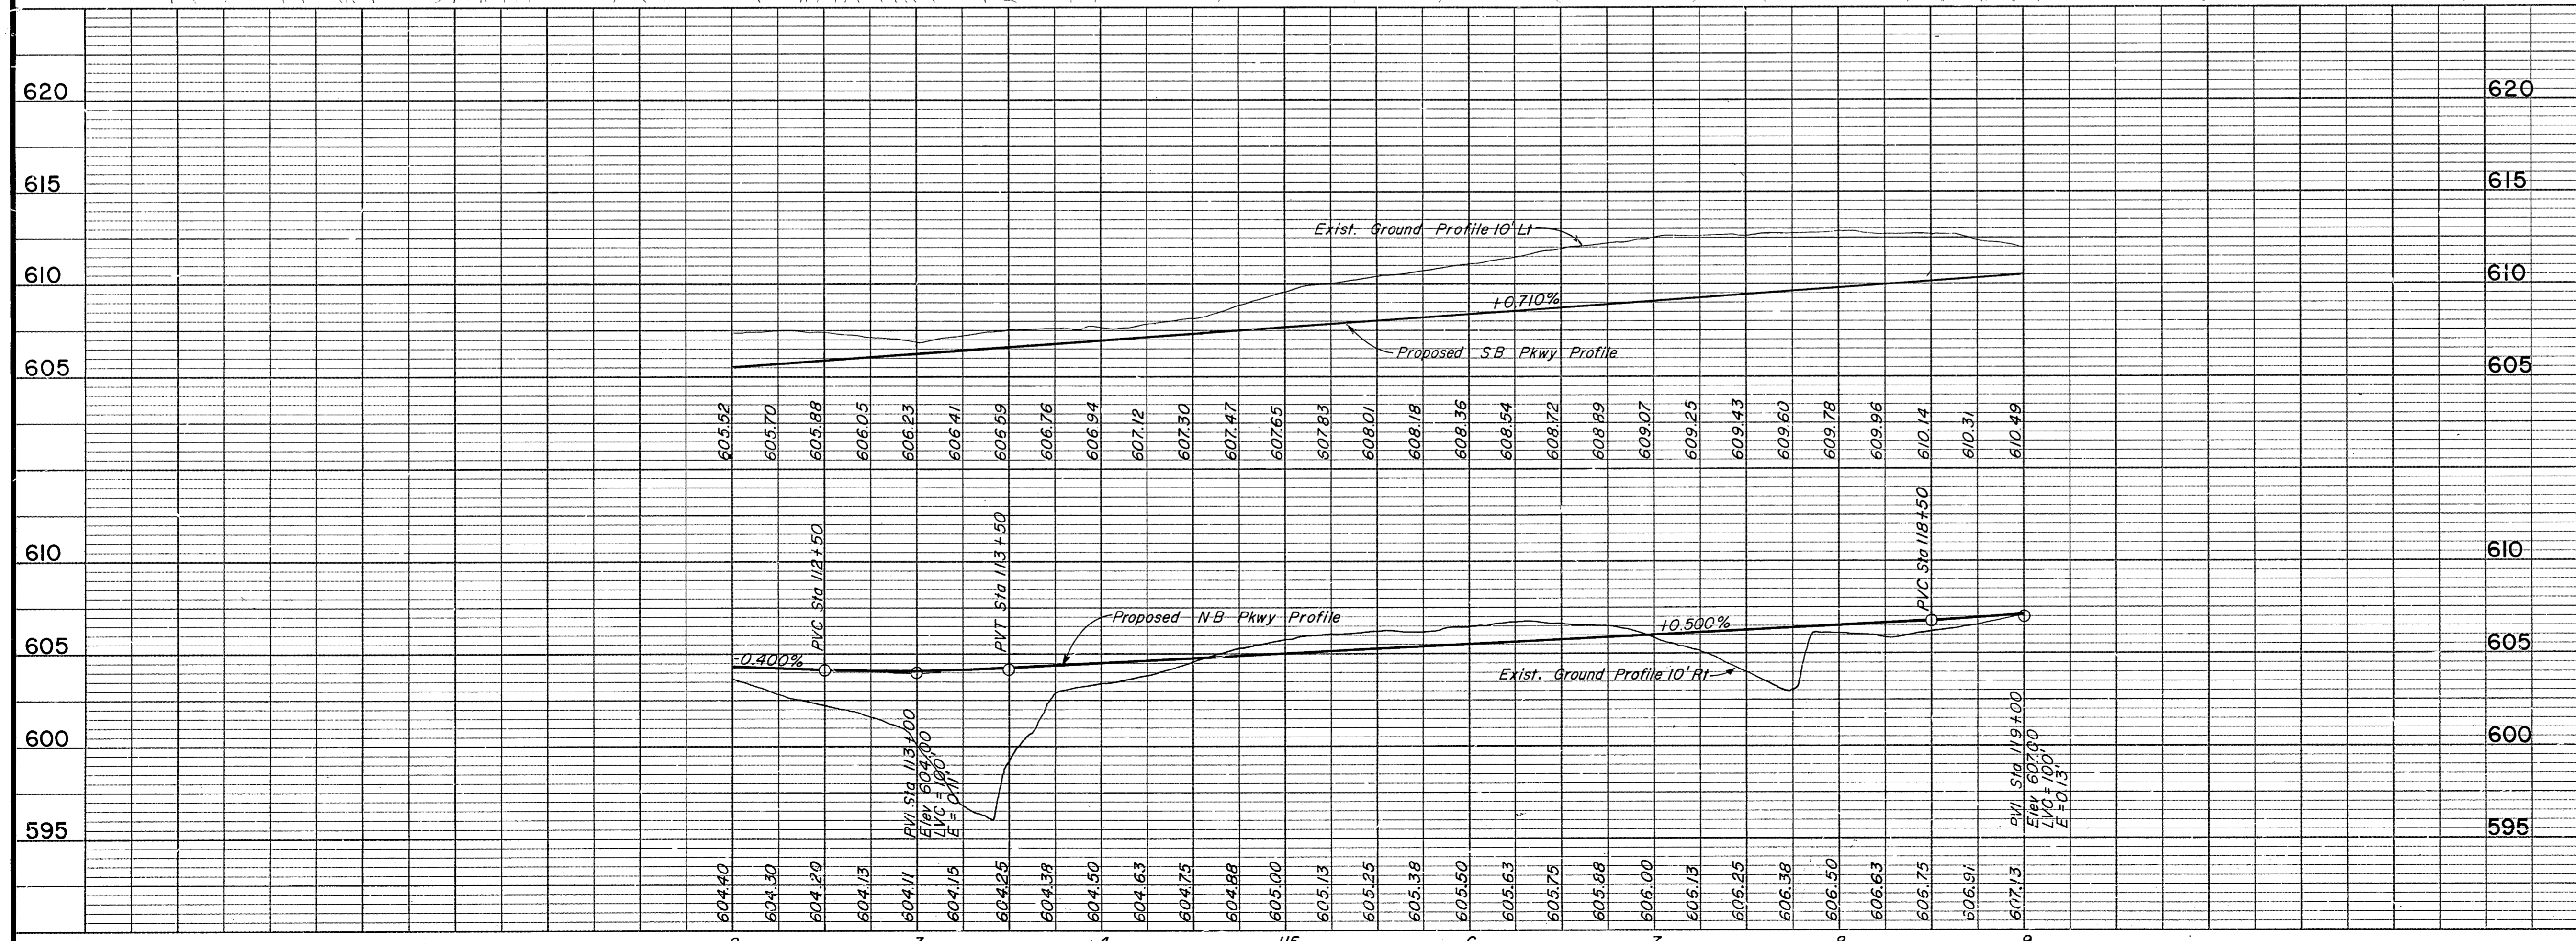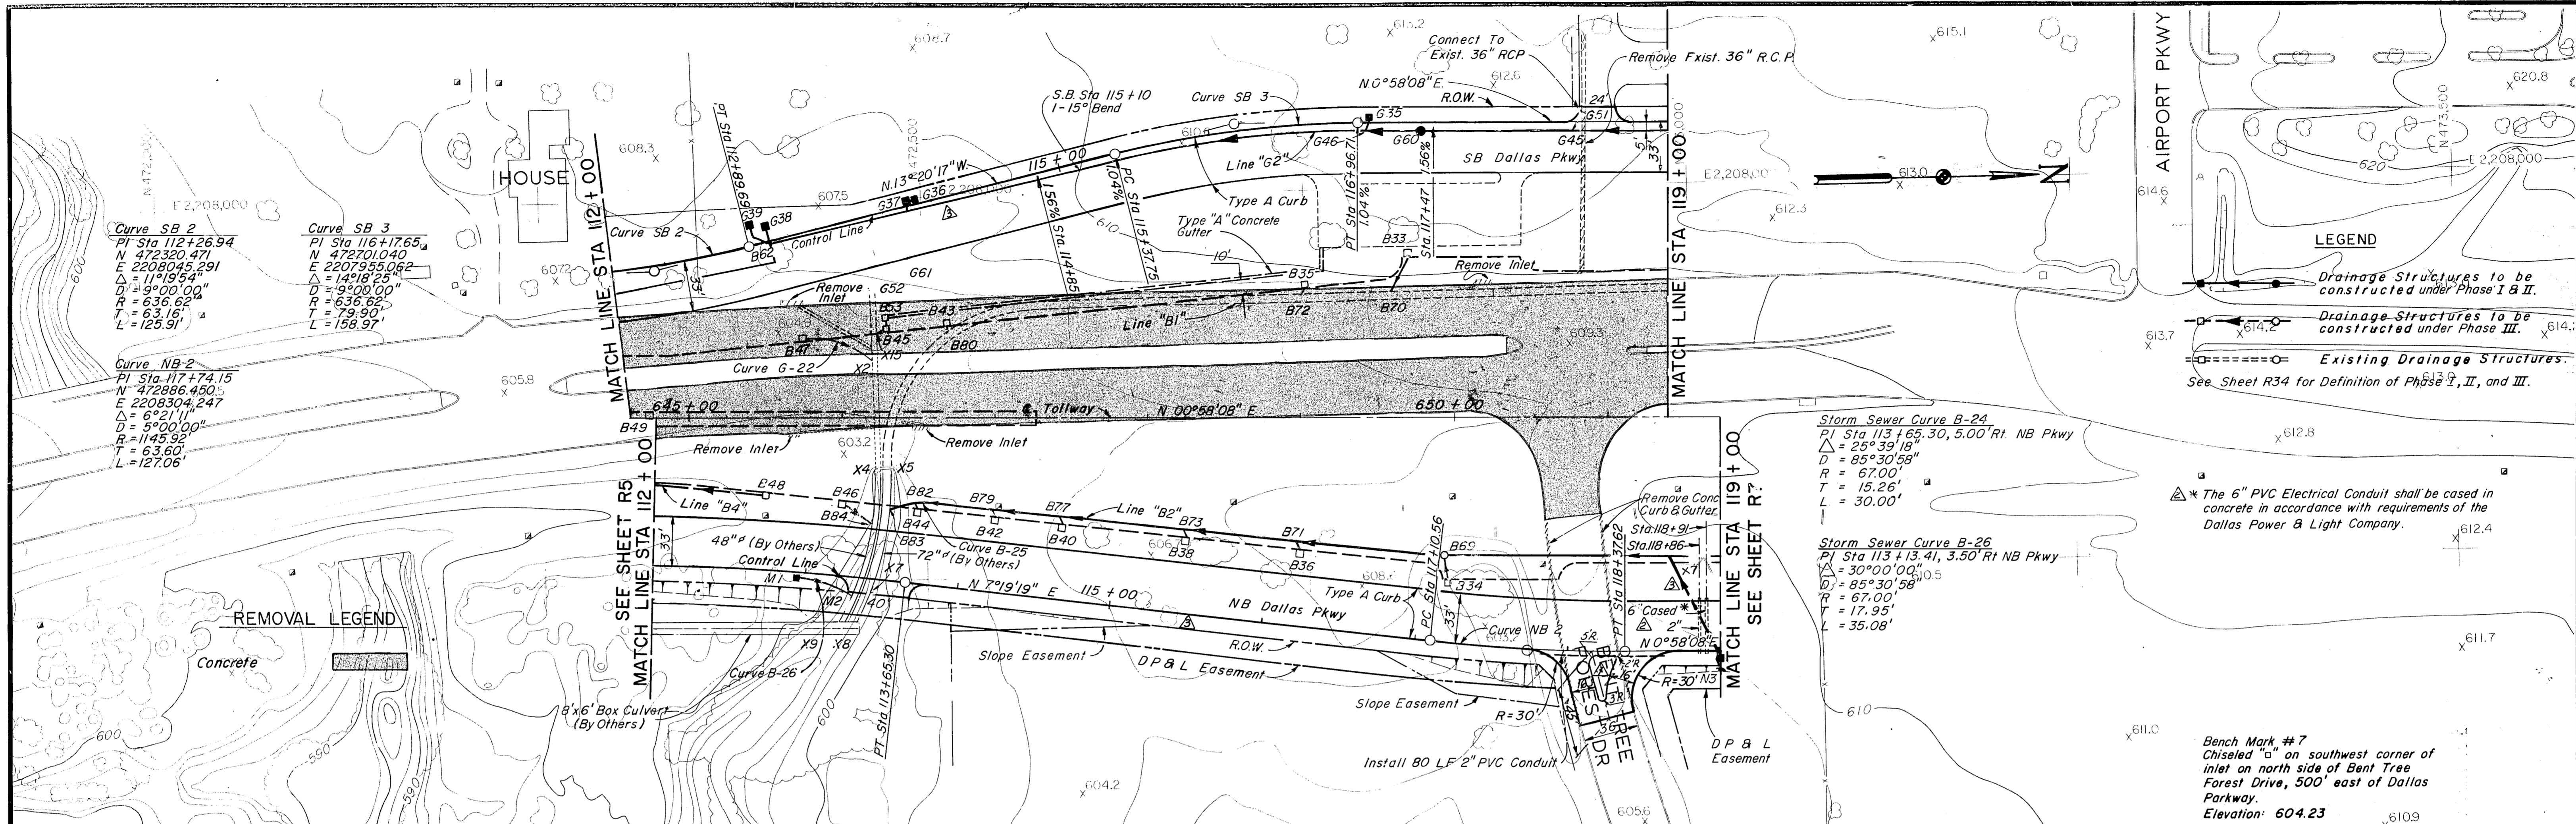

- Notes**
- See Sheet R16 for Tollway Plan & Profile.
  - See Sheets R26 & R27 for Paving Plans.
  - See the following sheets for Storm Sewer Profiles:  

Line	Sheet
G, G2, B4	R30
B2	R32
Lot N3, M1	R31
  - For Slopes See Cross Sections.
  - See Sheets R26 and R27 for Toll Plaza Building Project Limits.

**ASBUILT PLANS**

NO.	REVISION	BY	DATE
1	As Built	C.B.	
2	Add Conduit	PHM	2-7-86
3	Add Island @ Bent Tree Forest Dr.	GBB	1-15-85

**TEXAS TURNPIKE AUTHORITY**  
**DALLAS NORTH TOLLWAY**

**PAVING AND GRADING**  
**DALLAS PARKWAY**  
**STA 112+00 TO STA 119+00**



**Gibbs & Hill, Inc.**  
 ENGINEERS DESIGNERS CONSTRUCTORS  
 DALLAS

**SECTION VII**

DRAWN CJB DATE 4/4/83 DESIGNED DWC DATE 4/1/83  
 CHECKED DWC DATE 5/1/84 SCALE 1"=50' Hor. 1"=5' Vert.

CONTRACT NO. DNT-115 SHEET R6 OF R85



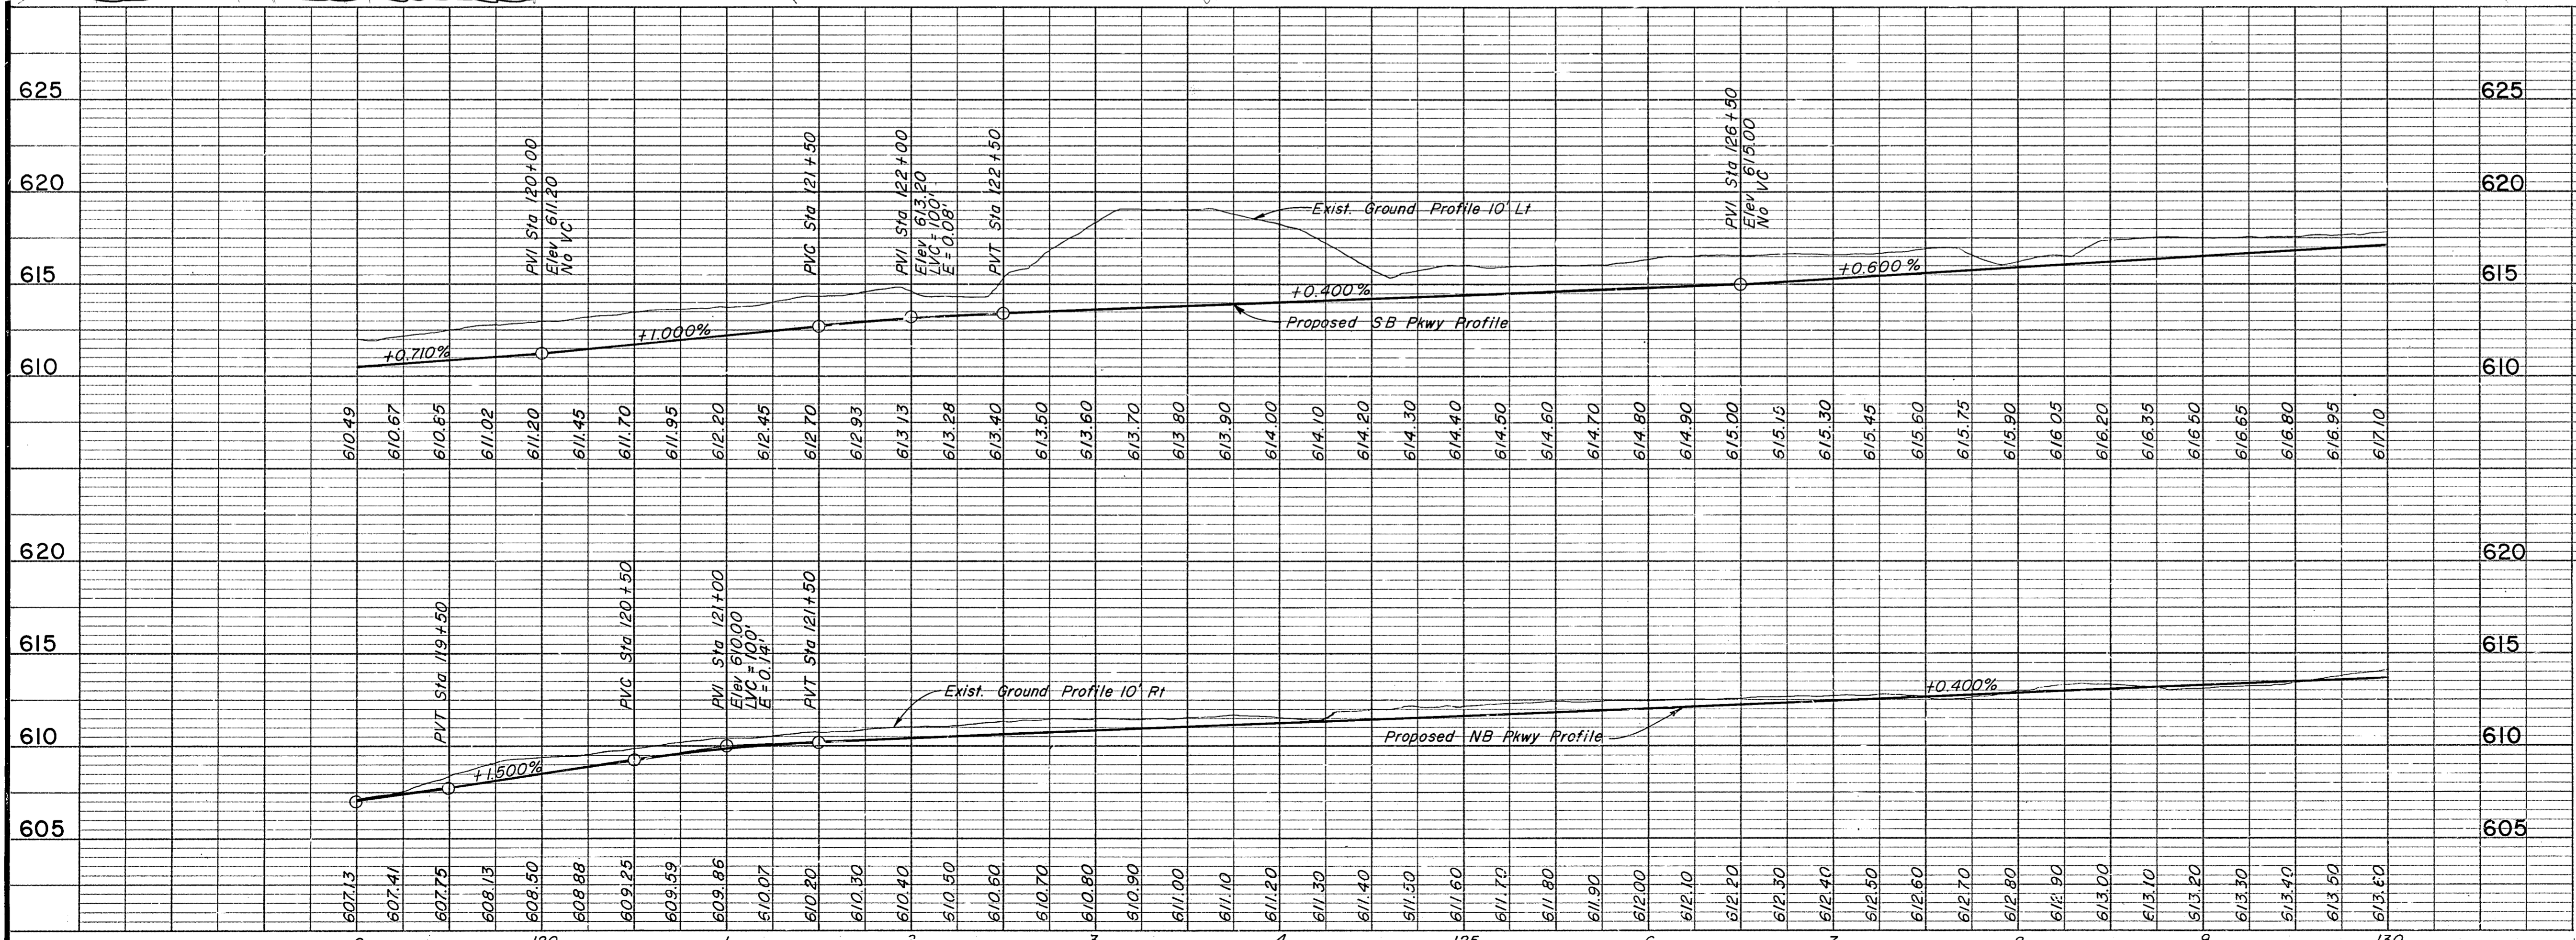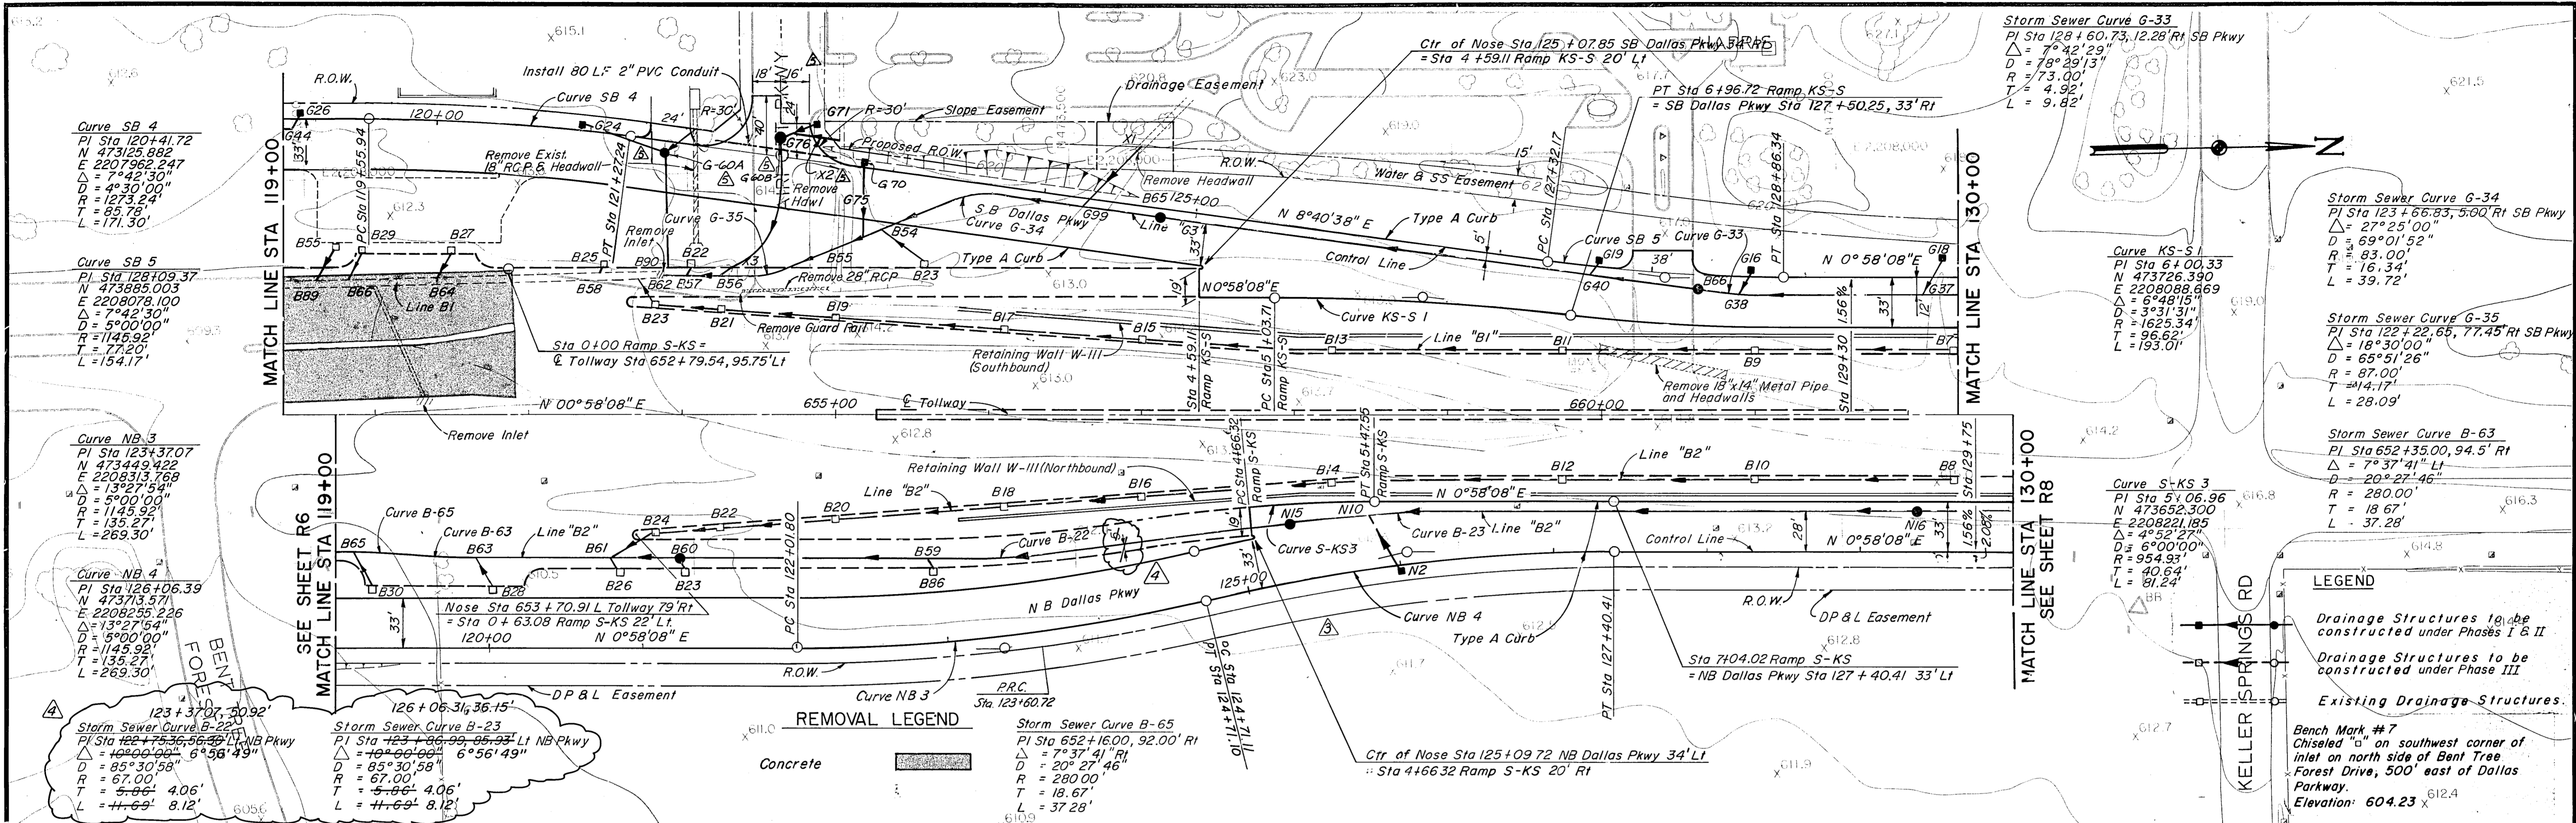

- NOTES:**
- See Sheet R17 for Tollway Plan & Profile
  - See Sheets R27 & R23 for Paving Plans.
  - See the following sheets for Storm Sewer Profiles:
 

Line	Sheet
B2	R50
B3	R54
B2	R53
  - See Sheets W2 & W3 for Retaining Wall Details.
  - See Sheet R34 for Definition of Phase I, II, and III.
  - See Sheets R26 and R27 for Toll Plaza Building Project Limits.

**ASBUILT PLANS**

As Built	C/B
Revise Storm Sewer Line B-2	REF March 24, 1985
Delete Revisions	GMB Dec 31, 1985
Revise Right Turn Lane NB Dallas Pkwy.	GRB March 26, 1985
Add Right Turn Lane NB Dallas Pkwy.	GRB Jan 11, 1985

**TEXAS TURNPIKE AUTHORITY**  
**DALLAS NORTH TOLLWAY**

PAVING AND GRADING  
 DALLAS PARKWAY  
 STA 119+00 TO STA 130+00



**Gibbs & Hill, Inc.**  
 ENGINEERS DESIGNERS CONSTRUCTORS  
 DALLAS

**SECTION VII**

DRAWN CJB	DATE 4/5/83	DESIGNED DWK	DATE 4/1/83
CHECKED DWK	DATE 5/1/84	SCALE 1"=50' Hor 1"=5' Vert	

**CONTRACT NO. DNT-115 SHEET R7 OF R85**



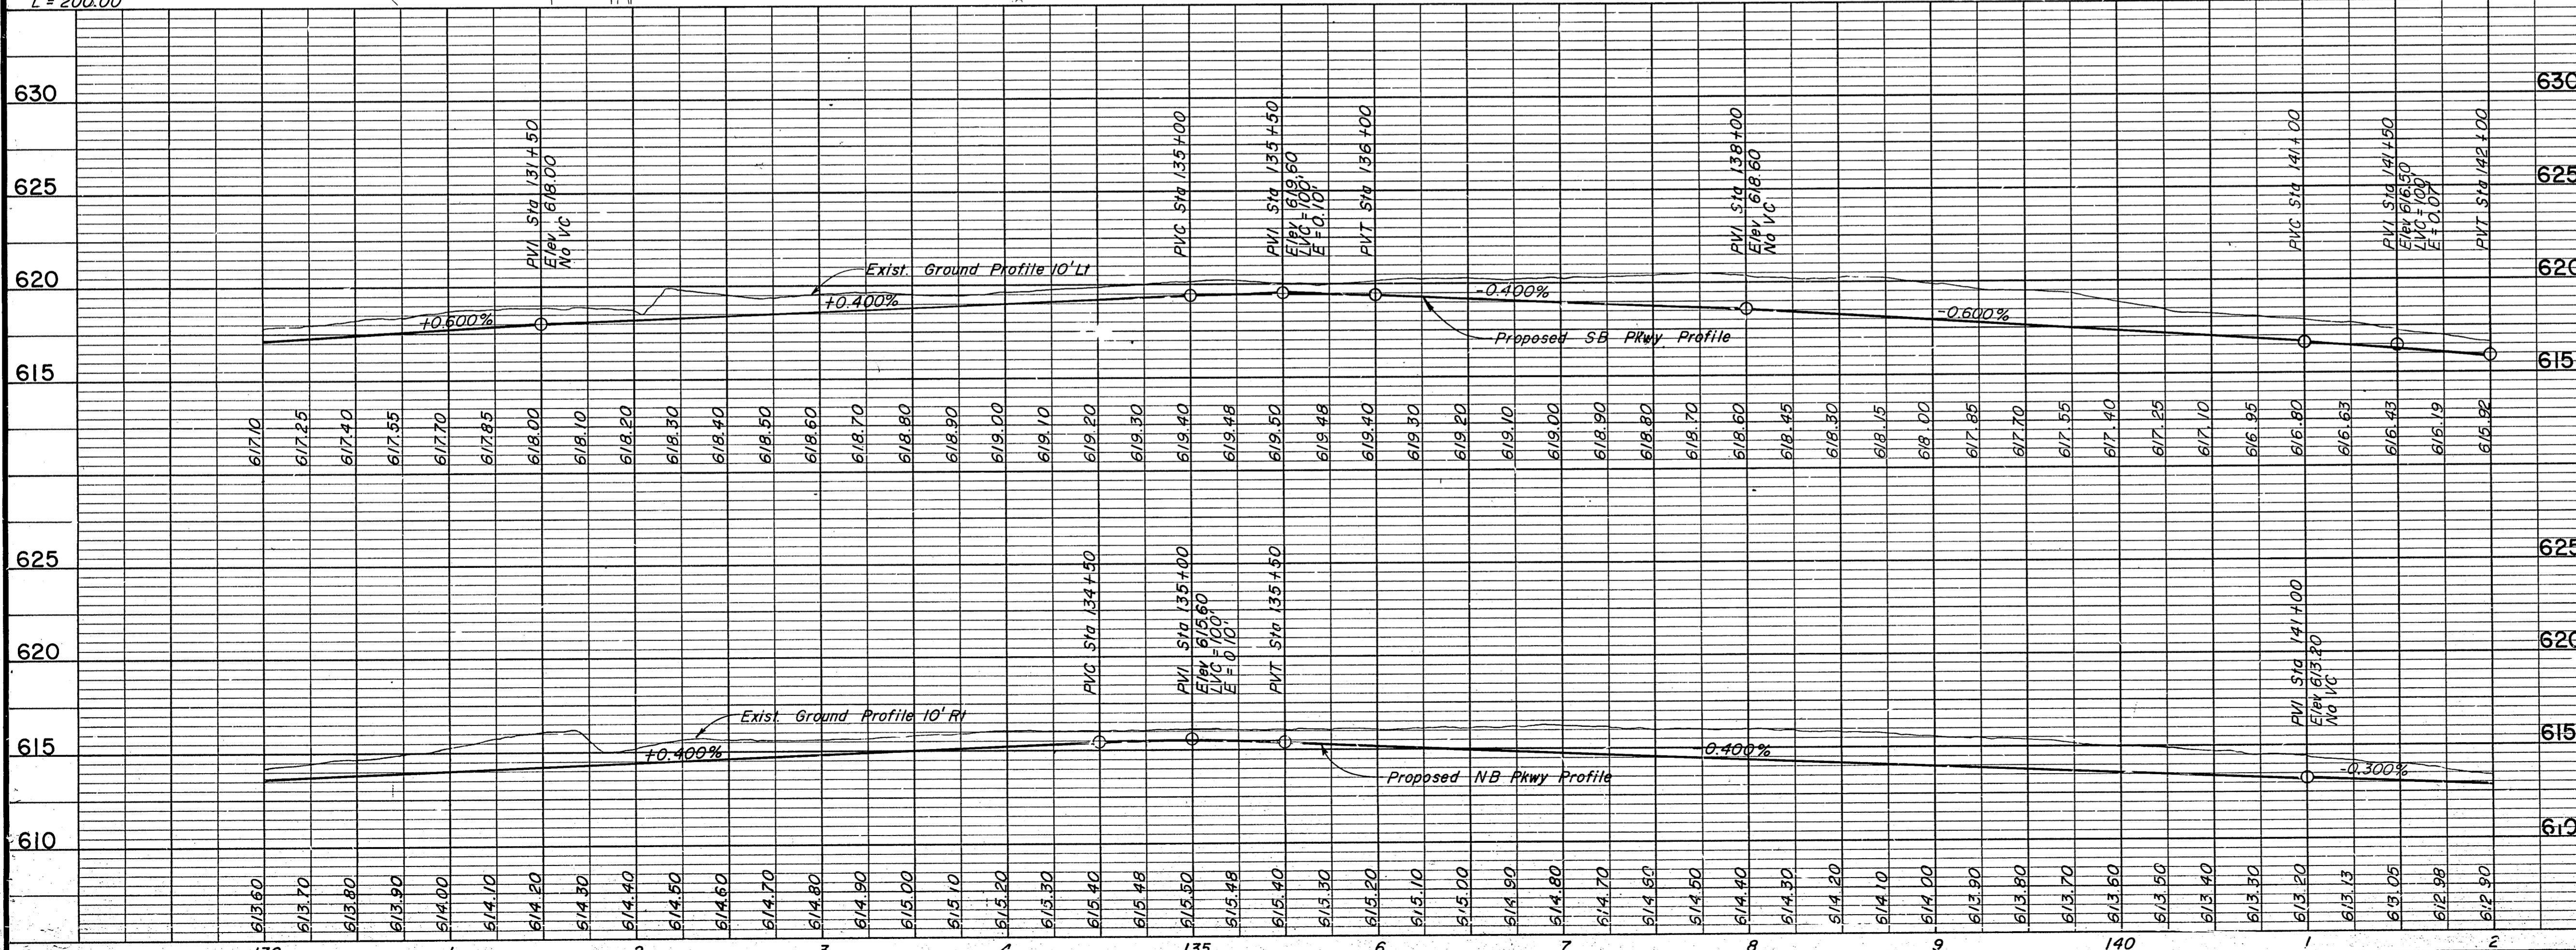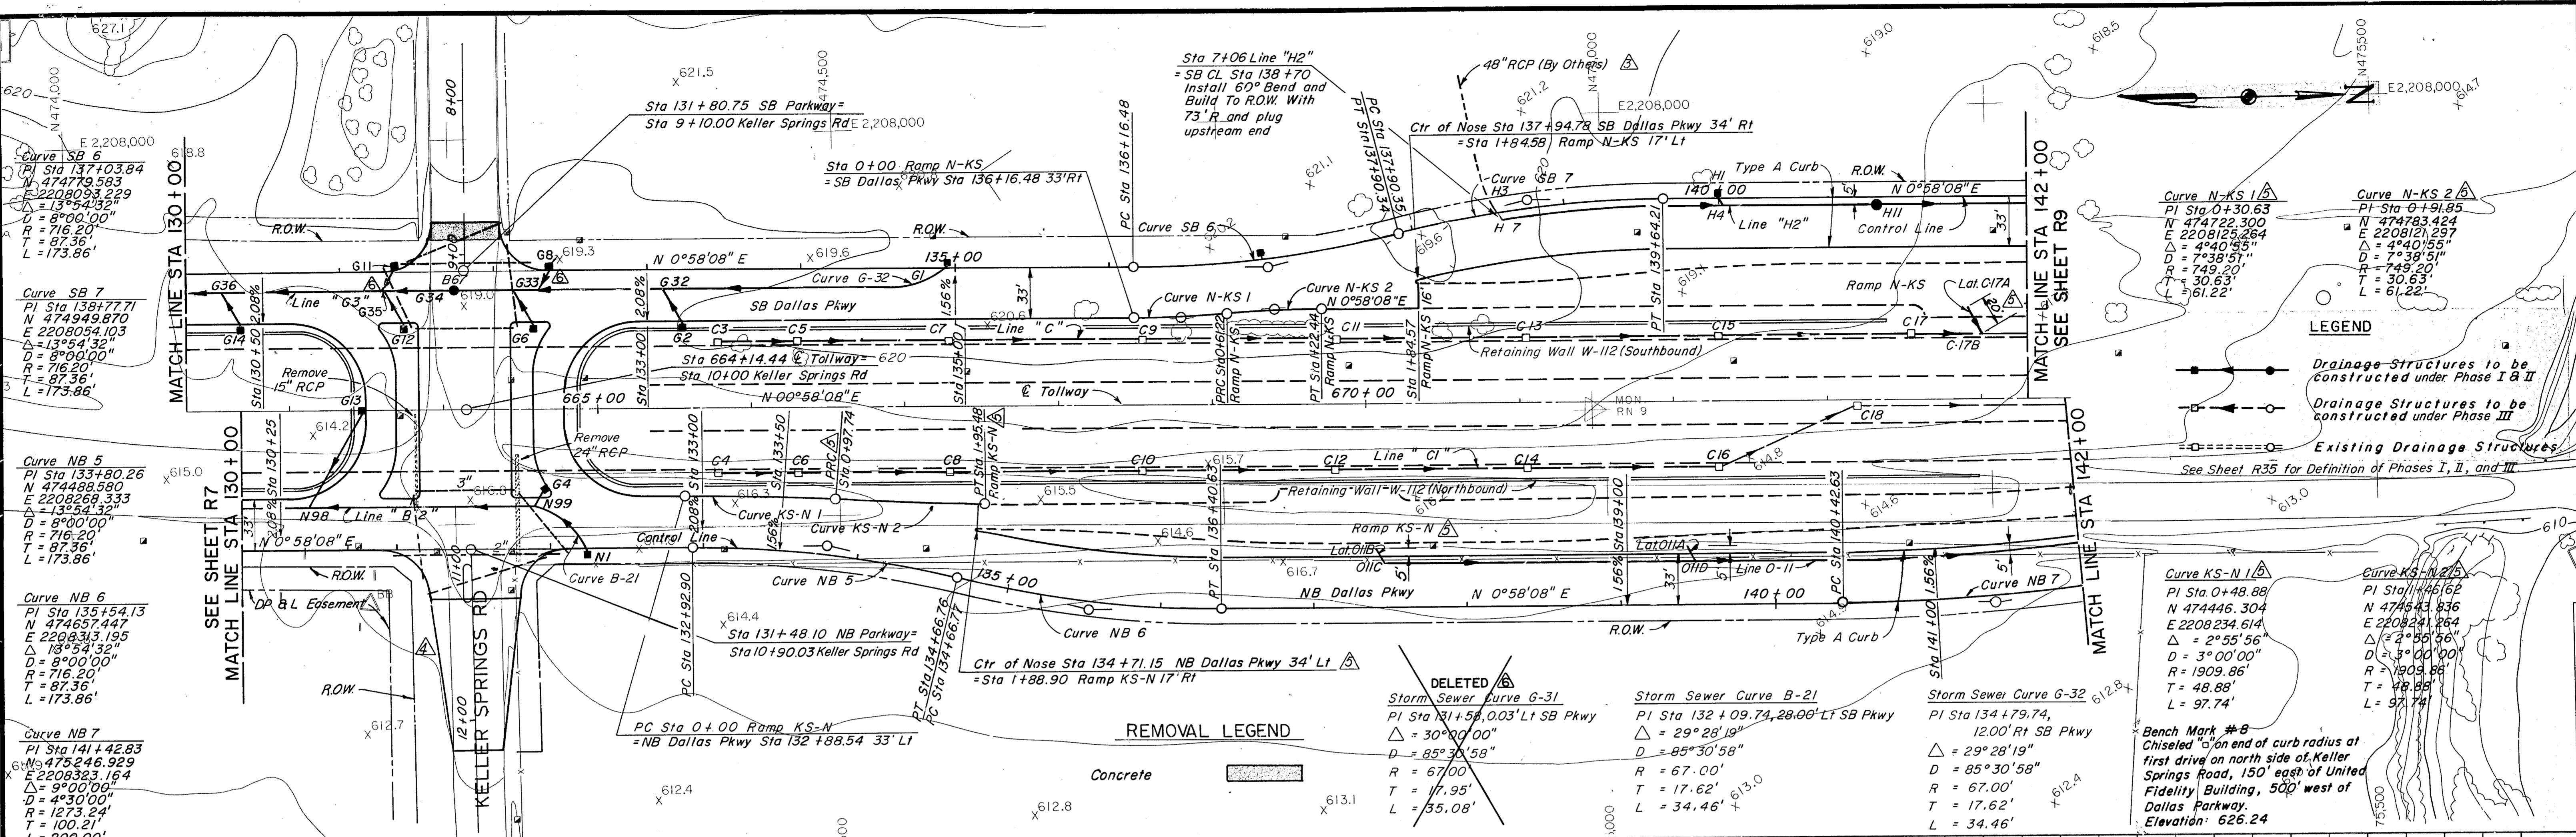

- Notes:**
- See Sheet R18 for Tollway Plan & Profile.
  - See Sheet R29 for Paving Plan of Keller Springs Road.
  - See Sheet R30 for Paving Plan of Ramp KS-N.
  - See Sheet R31 for Paving Plan of Ramp N-KS.
  - See the following sheets for Storm Sewer Profiles:
 

Line	Sheet
G3	R54
B2	R52
H2	R56
  - See Sheets S1 - S9 for Keller Springs Road Bridge Details.
  - See Sheets W2 - W5 for Retaining Wall Details.
  - For Slopes See Cross Sections.

**ASBUILT PLANS**

NO.	REVISION	BY	DATE
1	AS BUILT PLANS	PJ	JAN. 11, 1988
2	Revise Drainage & Ramps	GAB	June 26, 1985
3	Delete Revision	GMC	Dec. 31, 1985
4	Revised Storm Sewer Line H-2	RAB	Feb. 7, 1986
5	Add ROW Corner CIP @ NE Cor. Keller Springs	GRB	Jan. 15, 1985
6	Revised Intersections NB Pkwy & Keller Springs	GRB	Jan. 11, 1985

**TEXAS TURNPIKE AUTHORITY**  
**DALLAS NORTH TOLLWAY**

PAVING AND GRADING  
 DALLAS PARKWAY  
 STA 130+00 TO STA 142+00



**Gibbs & Hill, Inc.**  
 ENGINEERS DESIGNERS CONSTRUCTORS  
 DALLAS

SECTION VII

DRAWN	CJB	DATE	4/5/83	DESIGNED	DWC	DATE	4/1/83
CHECKED	DWC	DATE	5/1/84	SCALE	1"=50' Hor 1"=5' Vert		

CONTRACT NO. DNT-115 SHEET R8 OF R85



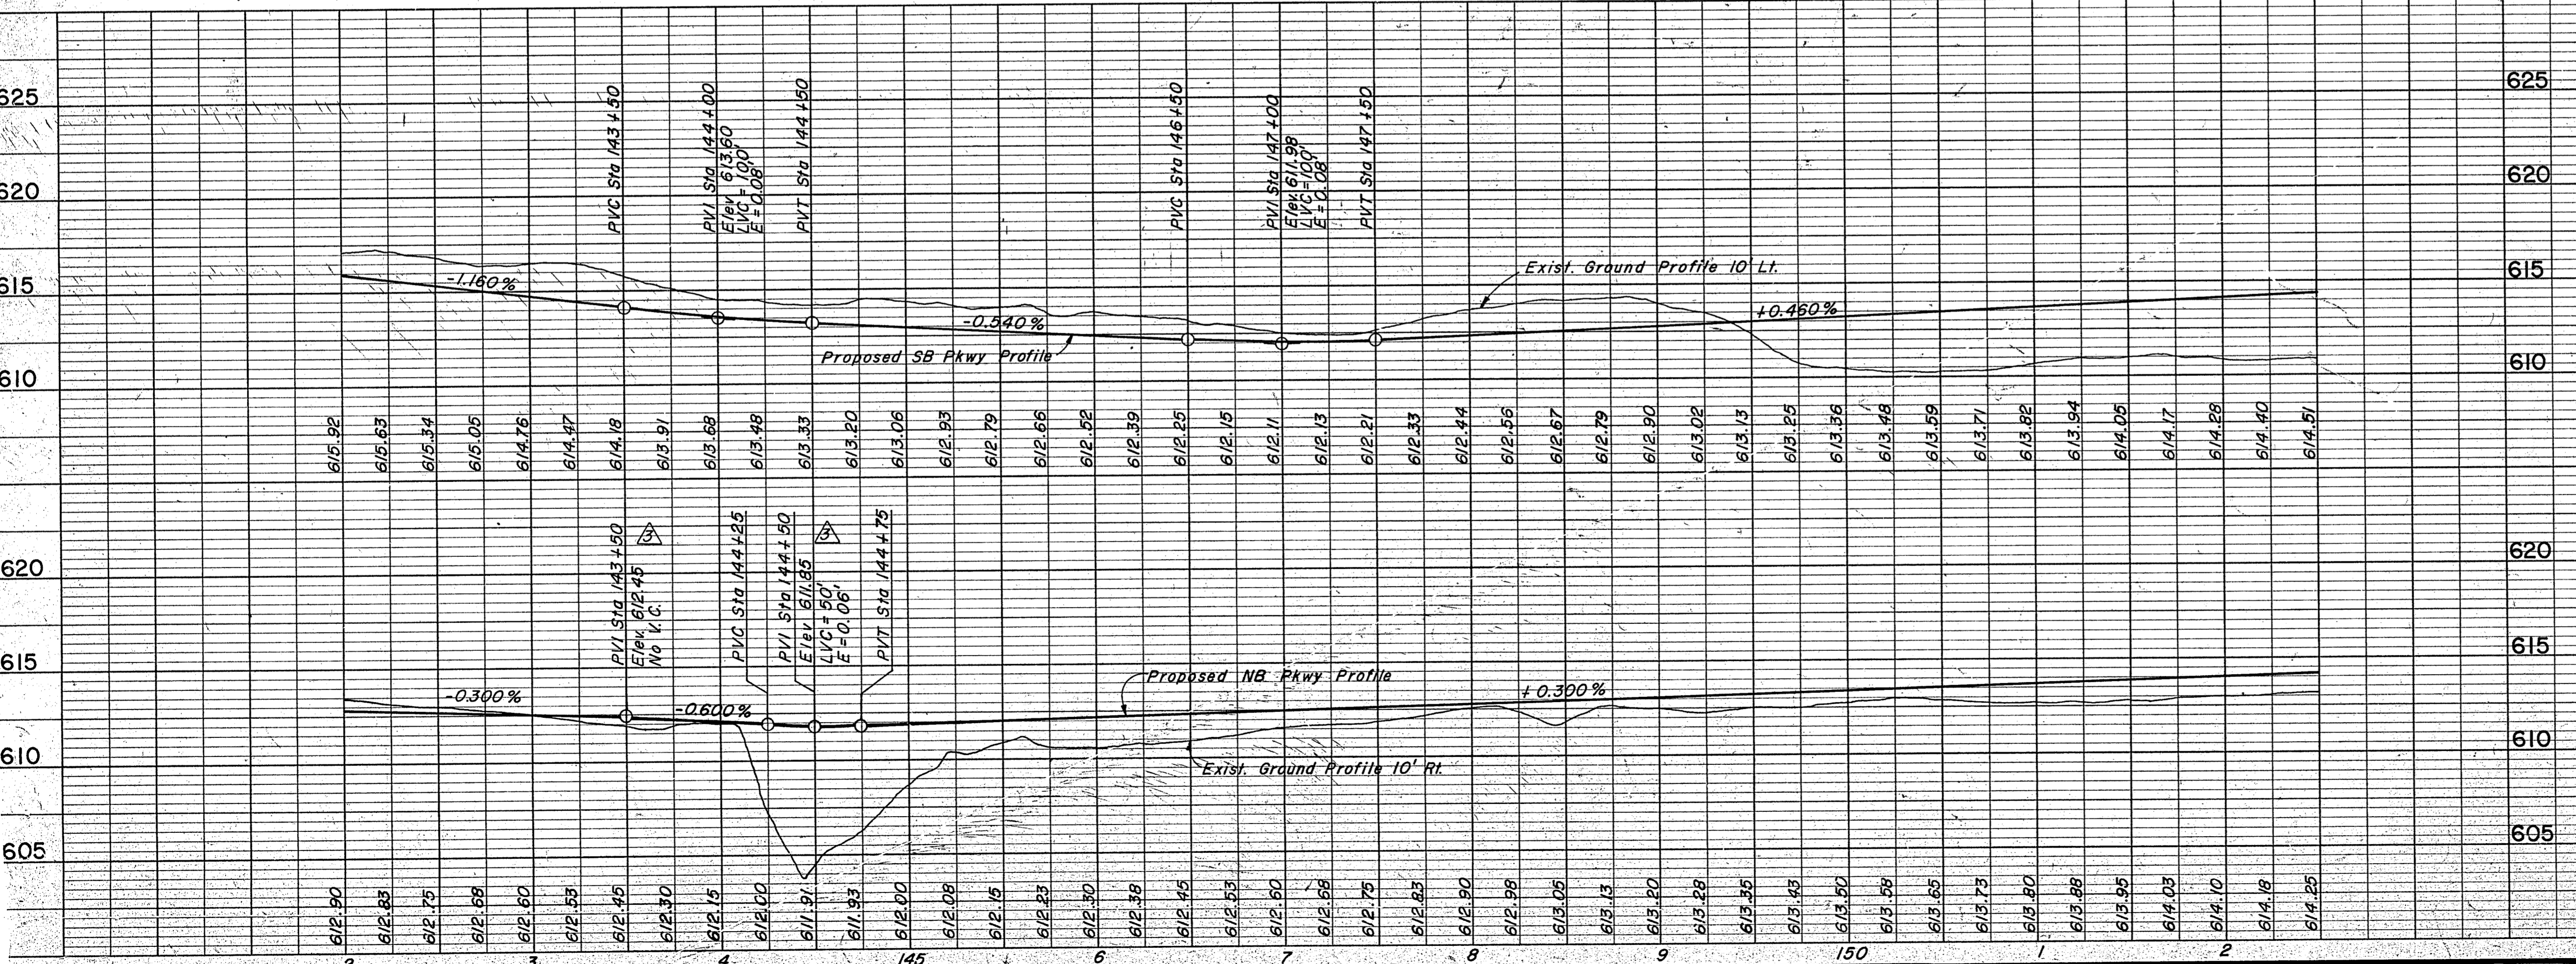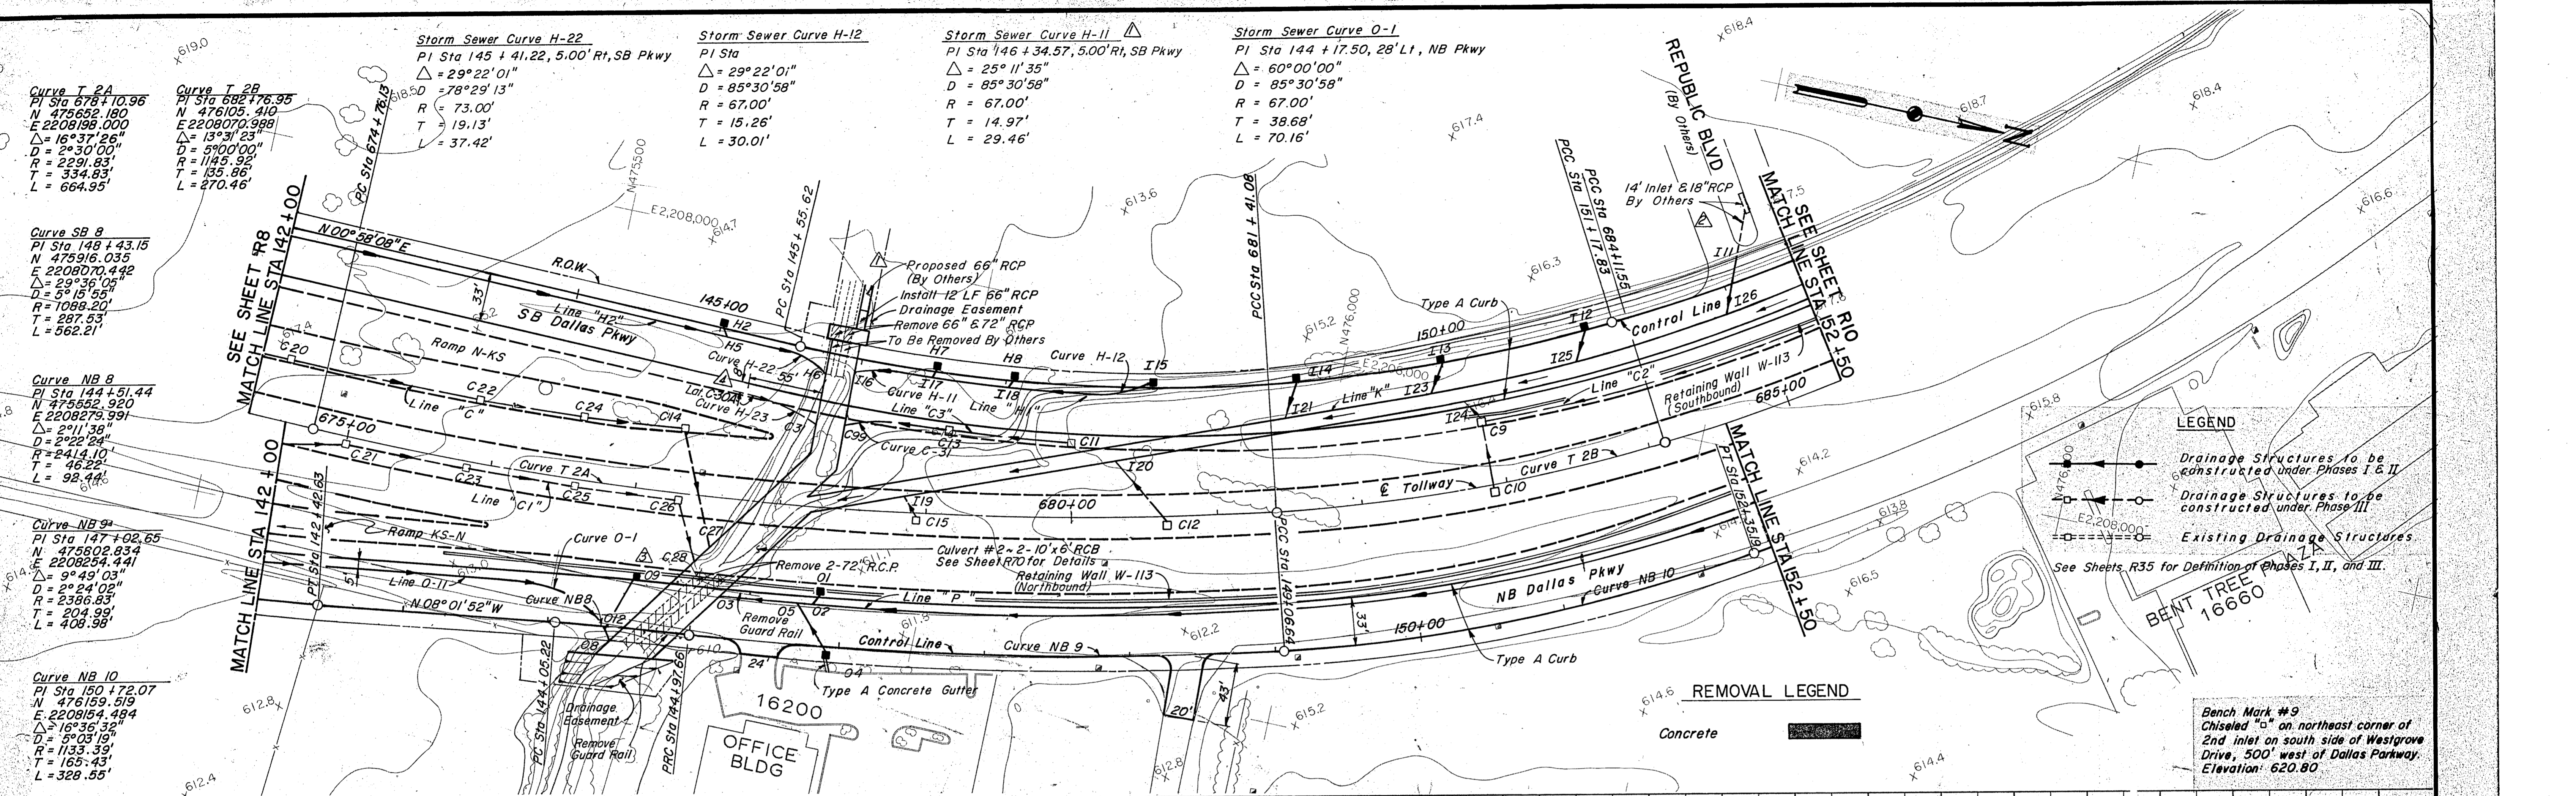

- NOTES:**
- Refer to Sheet R19 for Tollway Plan & Profile.
  - See Sheet R30 for Paving Plan - Ramp K5-N.
  - See Sheet R31 for Paving Plan - Ramp N-KS.
  - See Sheets R70 - R72 for Box Culvert Details.
  - See the following Sheets for Storm Sewer Profiles:
 

Line	Sheet
H1, H2	R56
K	R58
P	R57
  - See Sheets W6 - WB for Retaining Wall Details.
  - For Slopes See Cross Sections.

**ASBUILT PLANS**

NO.	REVISION	BY	DATE
1	Revise Drainage	GMC	6-26-86
2	Change Cross-Slopes on N.B. Dallas Parkway	MGB	5-16-86
3	Replaced Inlet I-II with Inlet and Lateral by Others	MGB	2-7-85
4	Junction Box Widened & 2-10'x6' Conc Box Extended to North	MGB	2-7-85

**TEXAS TURNPIKE AUTHORITY**  
**DALLAS NORTH TOLLWAY**

PAVING AND GRADING  
 DALLAS PARKWAY  
 STA 142 + 00 TO STA 152 + 50



**Gibbs & Hill, Inc.**  
 ENGINEERS DESIGNERS CONSTRUCTORS

**SECTION VII**

DRAWN	VER	DATE	9-13-83	DESIGNED	DWC	DATE	8-5-83
CHECKED	DWC	DATE	9-13-83	SCALE	1" = 30' Hor. 1" = 5' Vert.		

CONTRACT NO. DNT-115 SHEET R9 OF R85



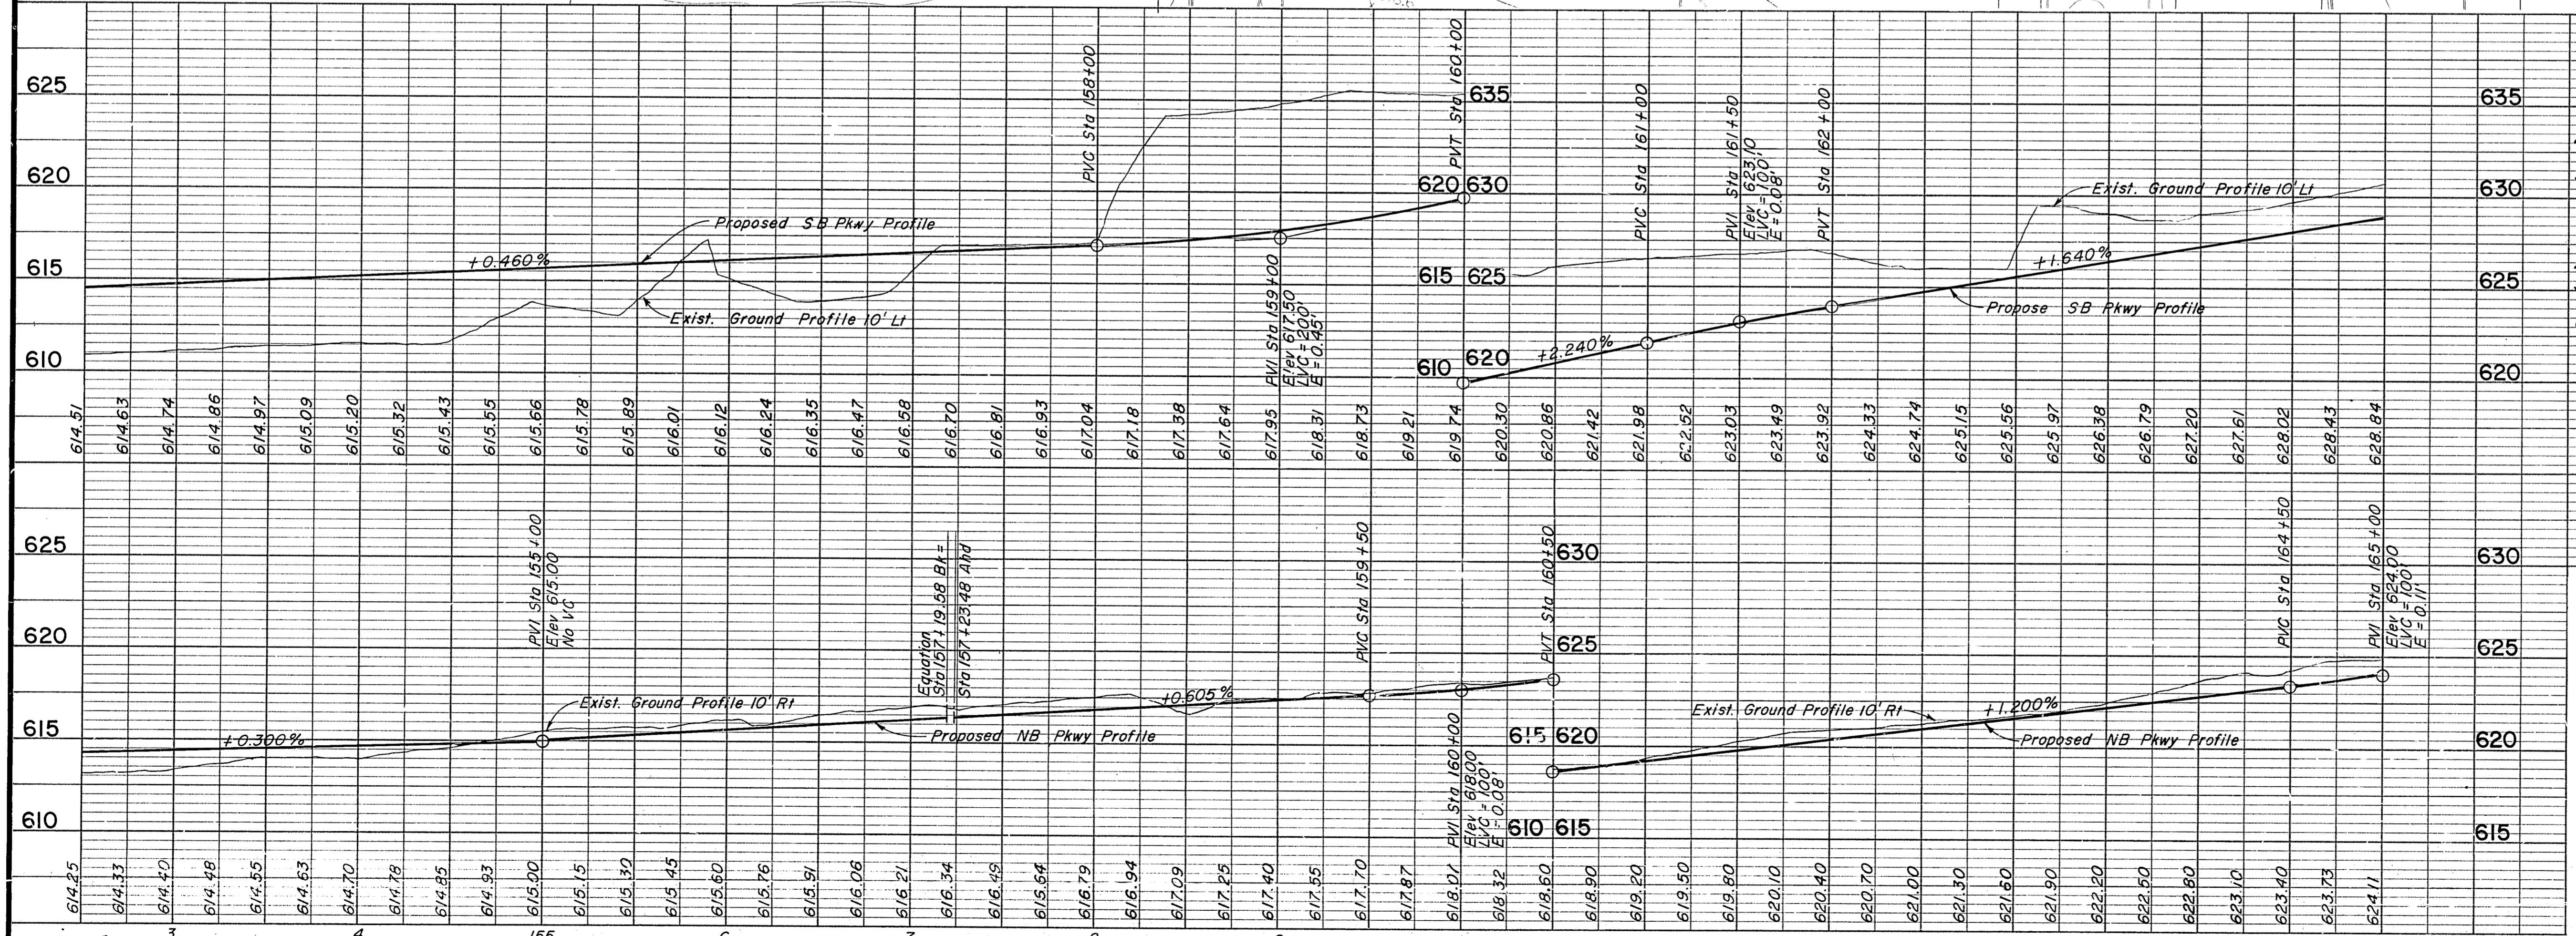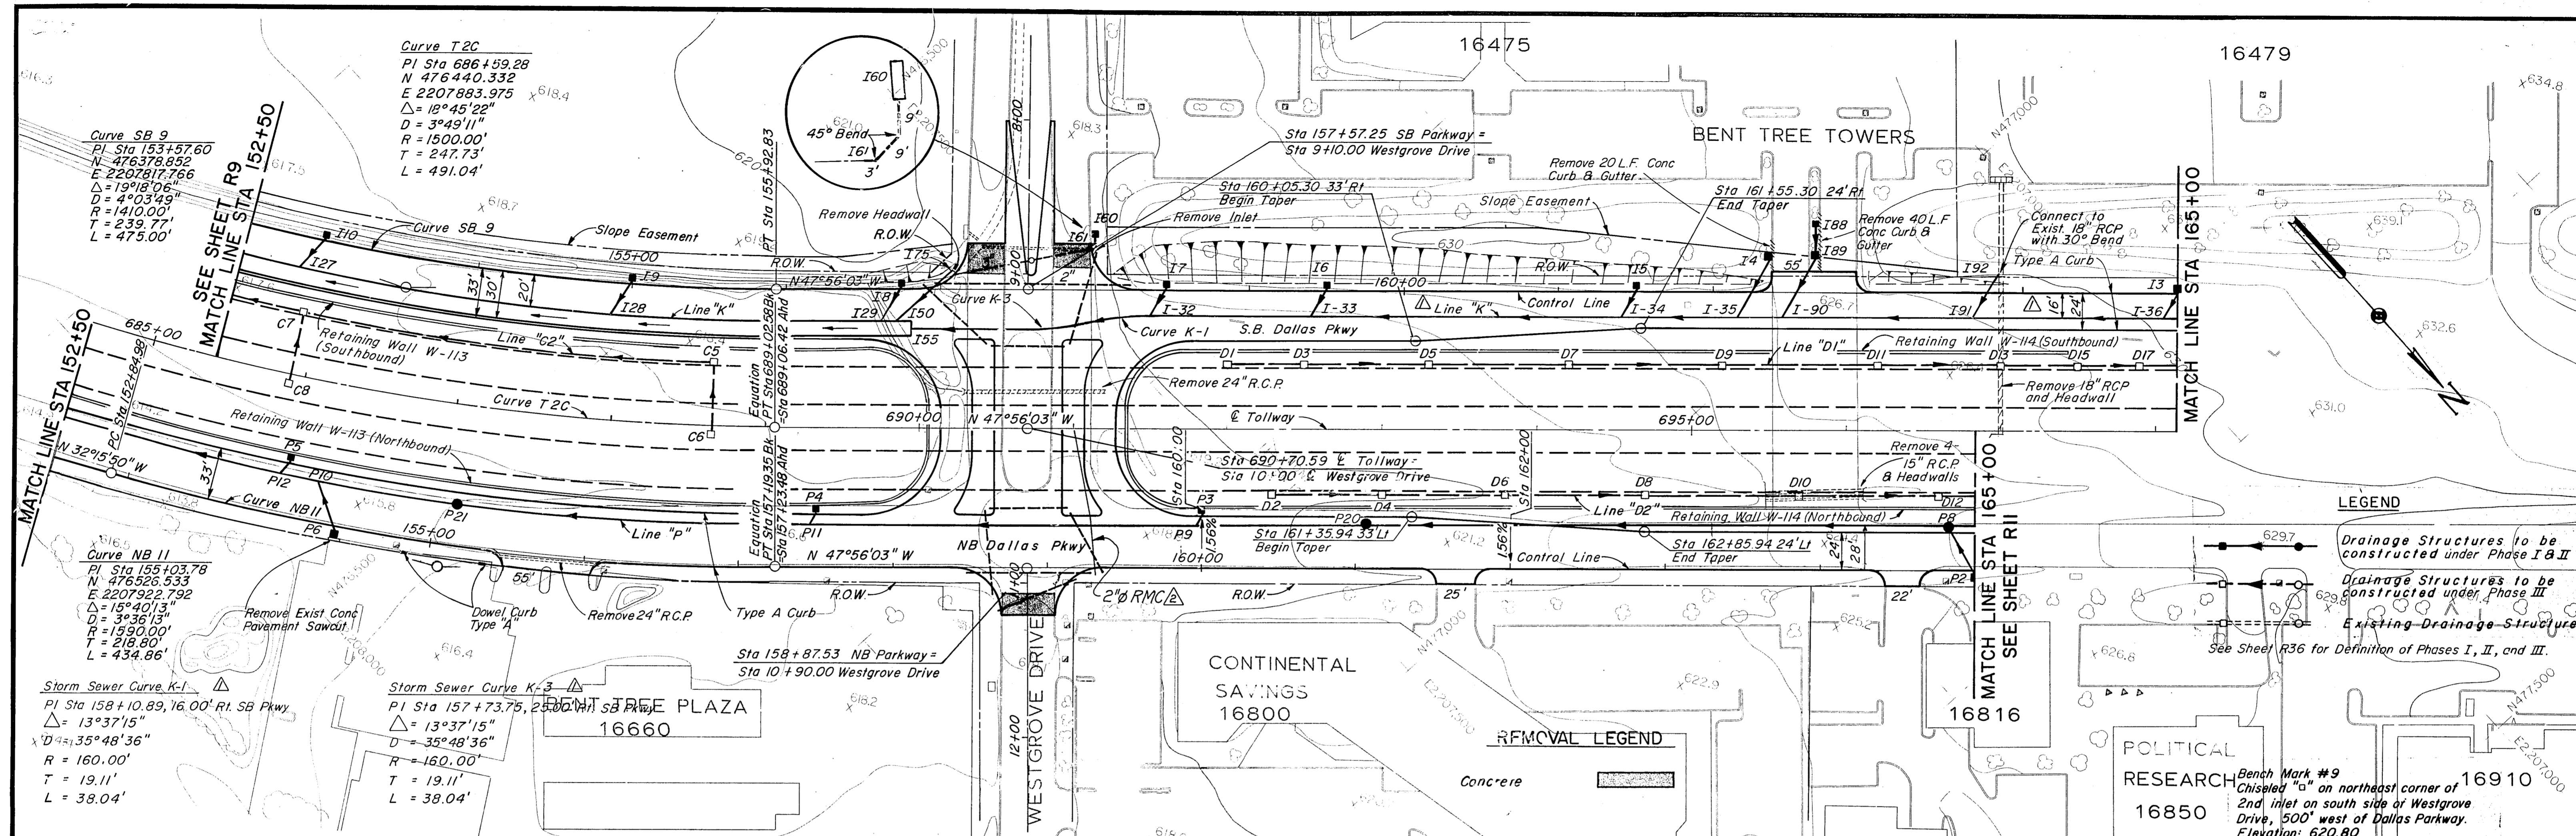

**LEGEND**

- Drainage Structures to be constructed under Phase I & II
- Drainage Structures to be constructed under Phase III
- Existing Drainage Structures

See Sheet R36 for Definition of Phases I, II, and III.

**REMOVAL LEGEND**

Concrete

**Notes:**

- See Sheet R20 for Tollway Plan & Profile
- See Sheet R32 for Paving Plan for Westgrove Drive
- See the following Sheets for Storm Sewer Profiles:
 

Line	Sheet
K	R58, R59
P	R57
- See Sheets W6 - W10 for Retaining Wall Details
- See Sheets S10 - S20 for Westgrove Drive Bridge Details
- For Slopes See Cross Sections

**Bench Mark #9**  
Chiseled "a" on northeast corner of 2nd inlet on south side of Westgrove Drive, 500' west of Dallas Parkway. Elevation: 620.80

**ASBUILT PLANS**

NO.	REVISION	BY	DATE
1	Added Conduit	JTK	2-19-86
2	Revised Storm Sewer Line "K" Alignment	MBB	3/14/85

**TEXAS TURNPIKE AUTHORITY**  
**DALLAS NORTH TOLLWAY**

**PAVING AND GRADING**  
**DALLAS PARKWAY**  
**STA 152+50 TO STA 165+00**


**Gibbs & Hill, Inc.**  
ENGINEERS DESIGNERS CONSTRUCTORS DALLAS

**SECTION VII**

DRAWN CJB	DATE 4/5/83	DESIGNED DWG	DATE 4/1/83
CHECKED DWG	DATE 5/2/84	SCALE 1"=50' Hor 1"=5' Vert	

CONTRACT NO. DNT-115 SHEET RIO OF R85



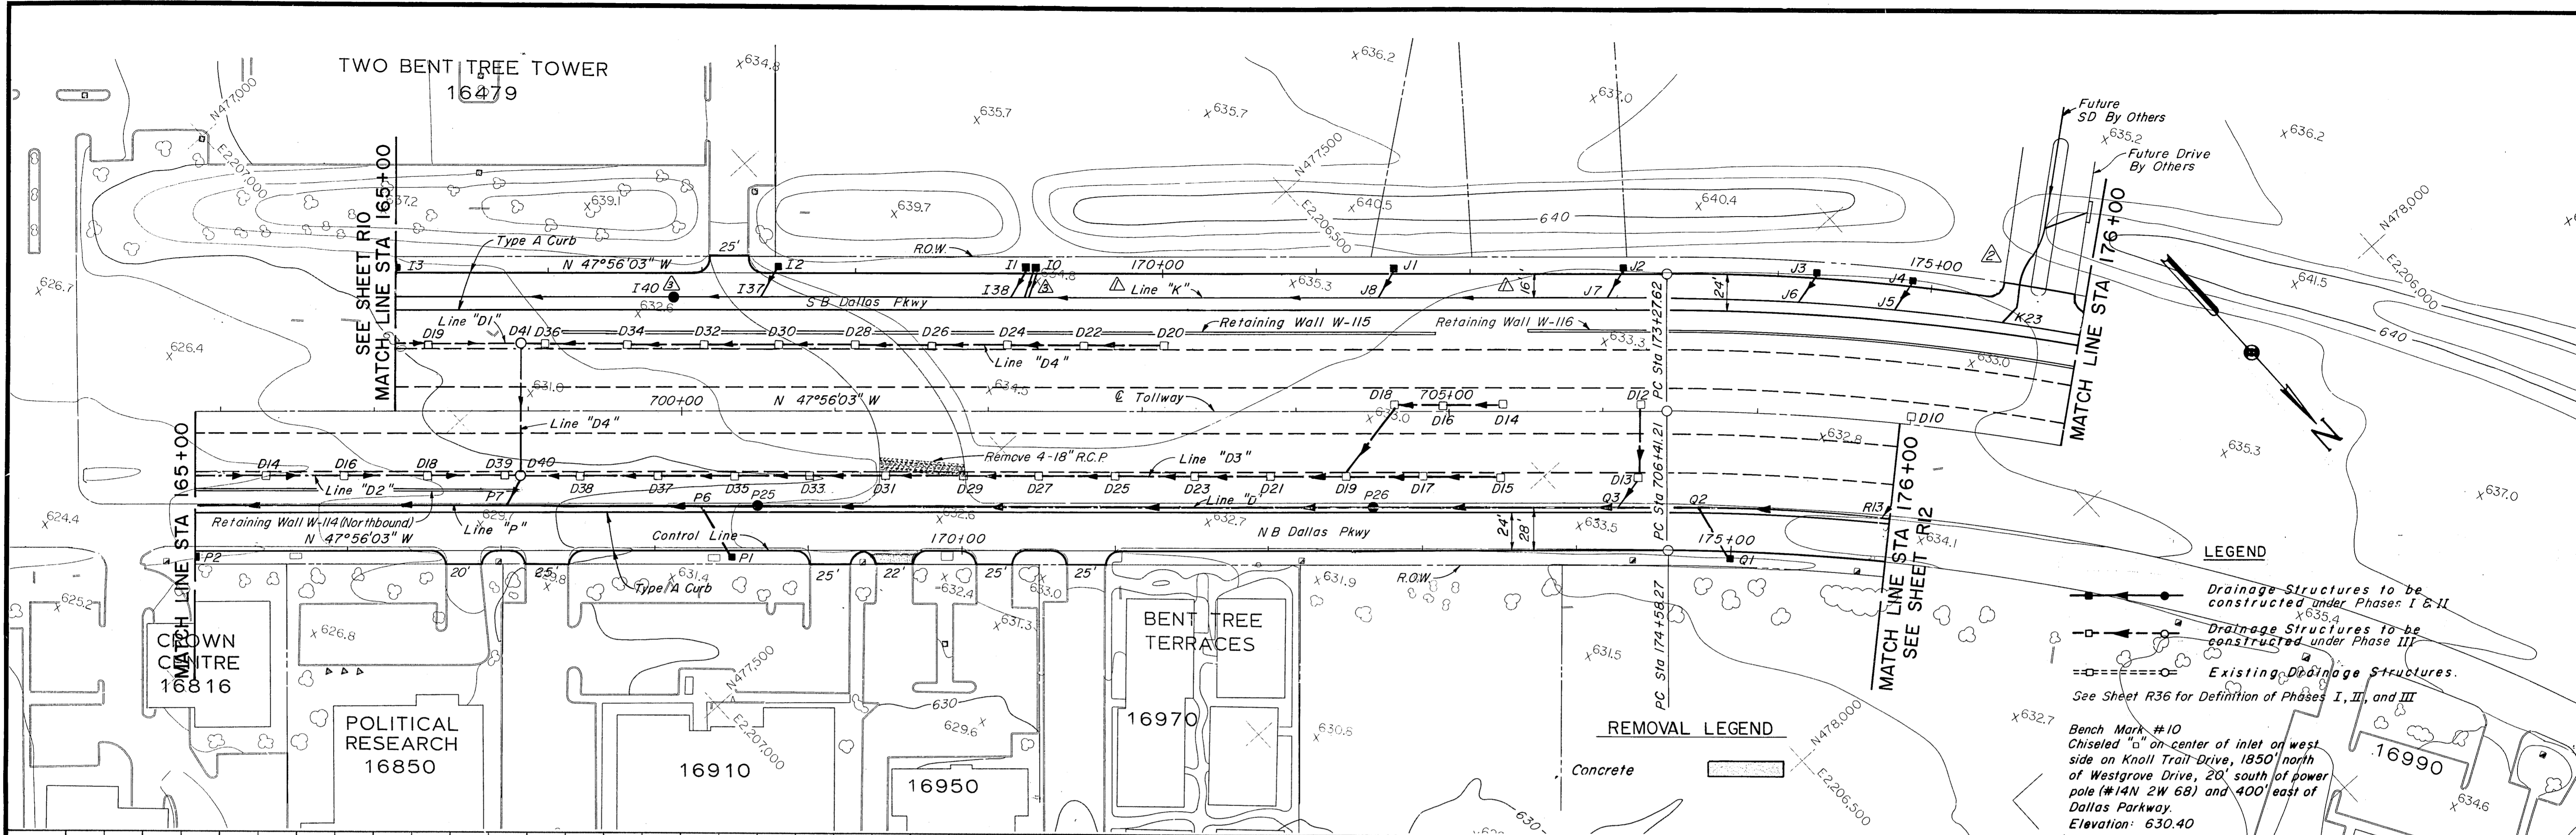


**LEGEND**

- Drainage Structures to be constructed under Phases I & II
- Drainage Structures to be constructed under Phase III
- Existing Drainage Structures

See Sheet R36 for Definition of Phases I, II, and III

Bench Mark #10  
Chiseled "L" on center of inlet on west side of Knoll Trail Drive, 1850' north of Westgrove Drive, 20' south of power pole (#14N 2W 68) and 400' east of Dallas Parkway.  
Elevation: 630.40

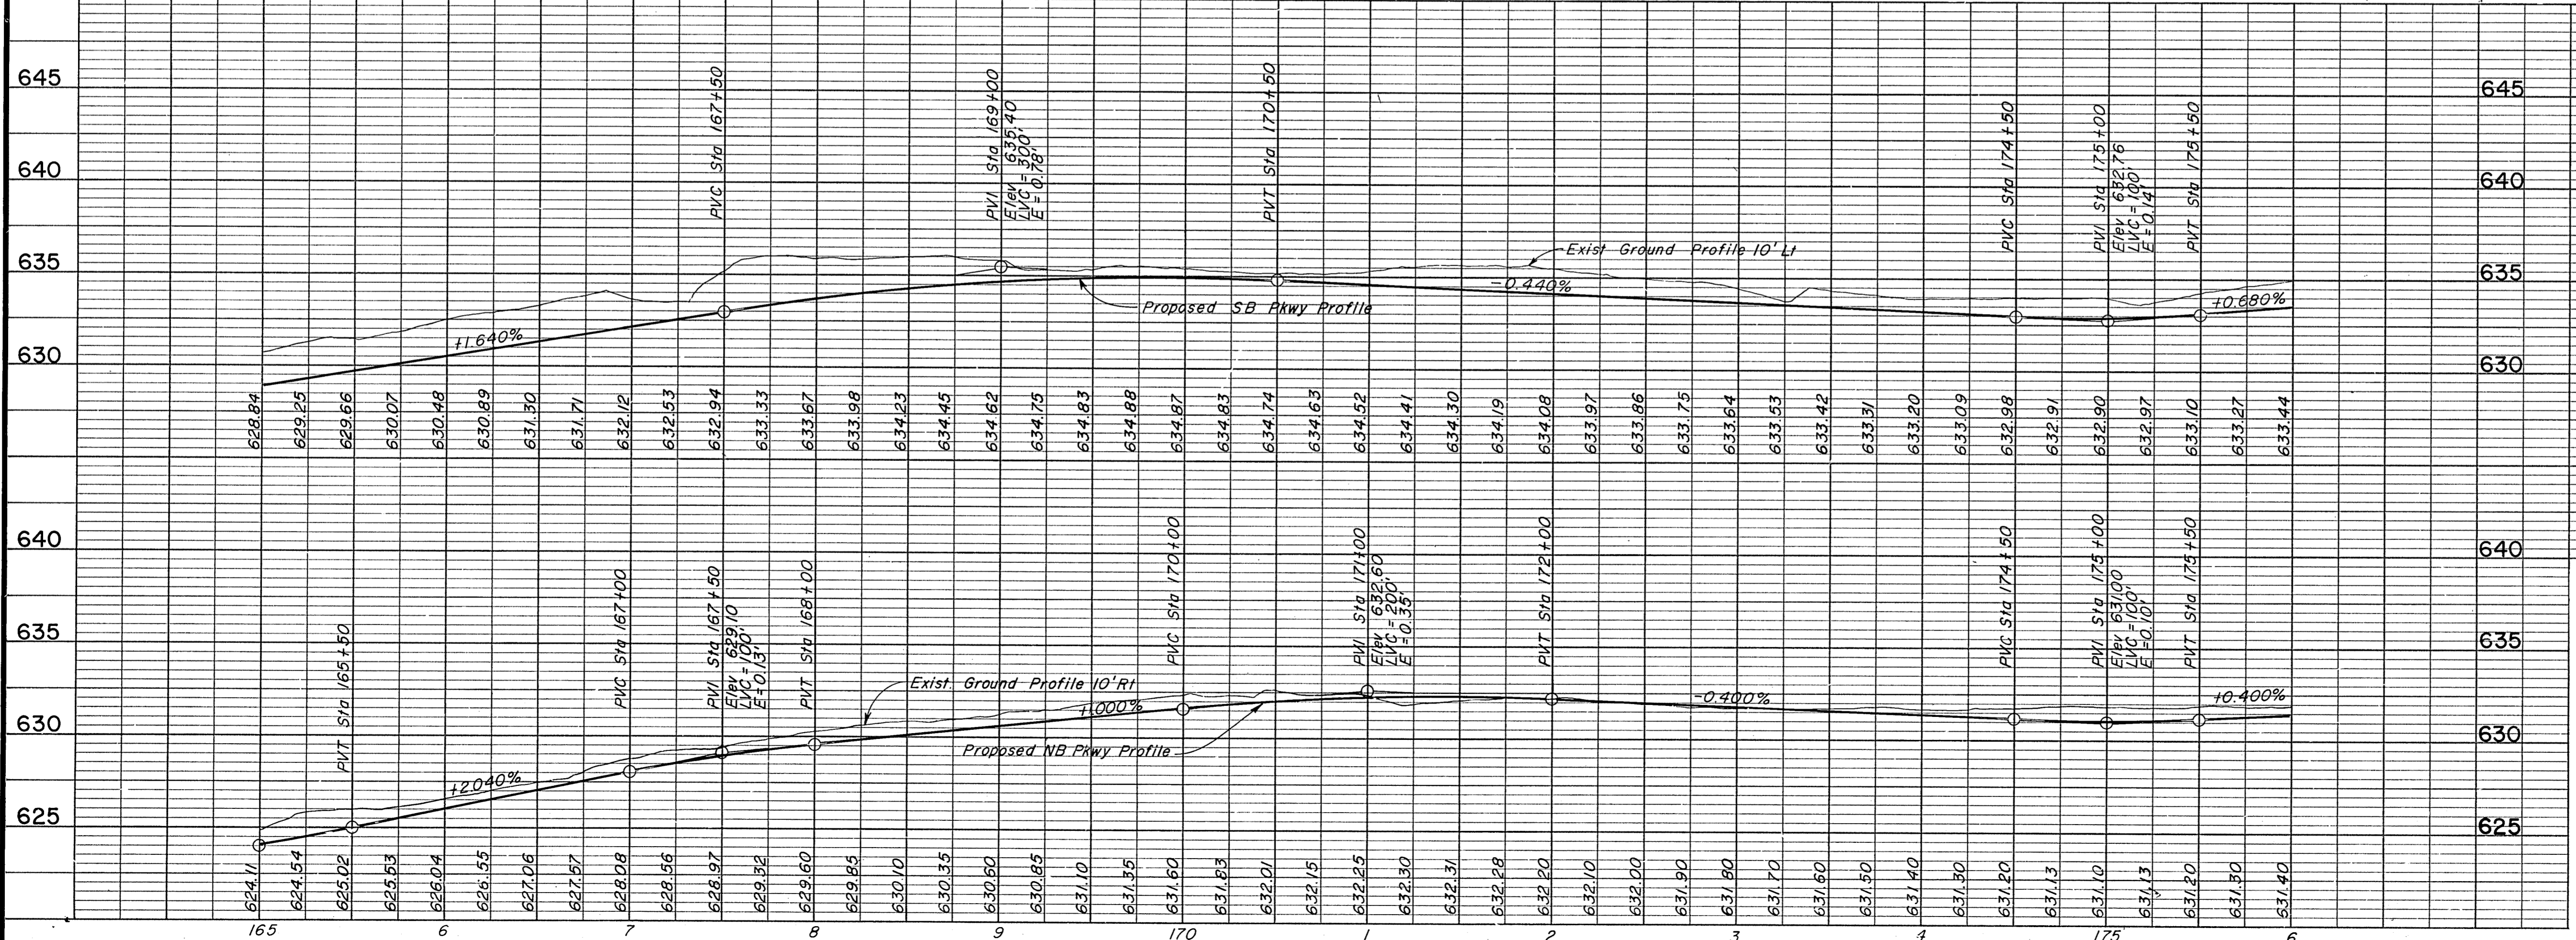

**NOTES:**

- See Sheet R21 for Tollway Plan & Profile.
- See Sheets W11 - W12 for Retaining Wall Details
- See the following Sheets for Storm Sewer Profiles:

Line	Sheet
K	R59
P	R57

4. For Slopes See Cross Sections.

**ASBUILT PLANS**

NO.	REVISION	BY	DATE
1	As Built	C.B.	
2	Deleted Inter. K21	MGB	4/11/85
3	Revised Storm Sewer Line "K" Alignment	MGB	3/14/85

**TEXAS TURNPIKE AUTHORITY**  
**DALLAS NORTH TOLLWAY**

PAVING AND GRADING  
DALLAS PARKWAY  
STA 165+00 TO STA 176+00


**Gibbs & Hill, Inc.**  
ENGINEERS DESIGNERS CONSTRUCTORS  
DALLAS

**SECTION VII**

DRAWN: CJB DATE: 4/5/83 DESIGNED: DWC DATE: 4/1/83  
CHECKED: DWC DATE: 5/7/84 SCALE: 1"=50' Hor. 1"=5' Vert.

CONTRACT NO. DNT-115 SHEET R11 OF R85




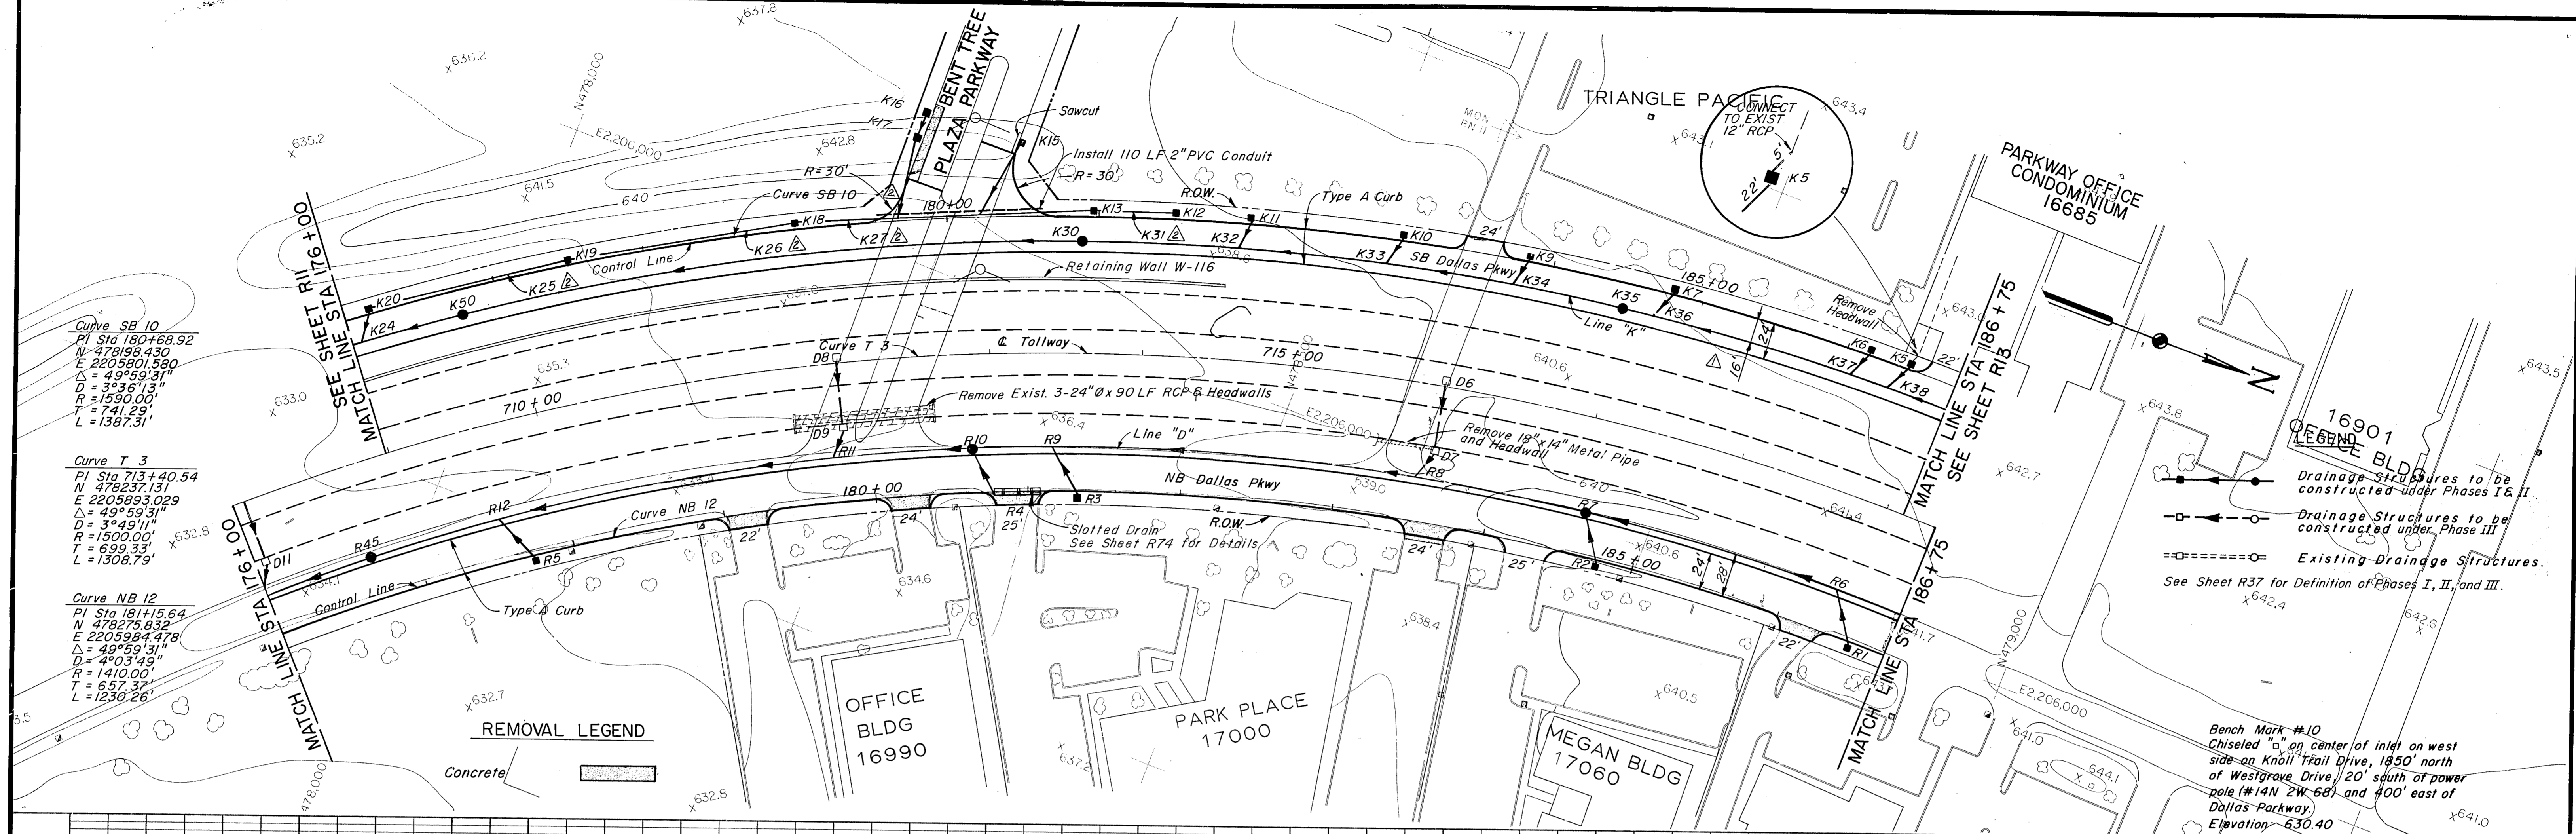

**Curve SB 10**  
 PI Sta 180+68.92  
 N 478198.430  
 E 2205801.580  
 Δ = 49°59'31"  
 D = 3°36'13"  
 R = 1590.00'  
 T = 741.29'  
 L = 1387.31'

**Curve T 3**  
 PI Sta 173+40.54  
 N 478237.131  
 E 2205893.029  
 Δ = 49°59'31"  
 D = 3°49'11"  
 R = 1500.00'  
 T = 699.33'  
 L = 1308.79'

**Curve NB 12**  
 PI Sta 181+15.64  
 N 478275.832  
 E 2205984.479  
 Δ = 49°59'31"  
 D = 4°03'49"  
 R = 1410.00'  
 T = 657.37'  
 L = 1230.26'

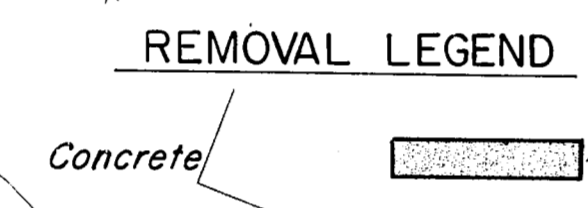


Drainage Structures to be constructed under Phases I & II

Drainage Structures to be constructed under Phase III

Existing Drainage Structures

See Sheet R37 for Definition of Phases I, II, and III.

Bench Mark #10  
 Chiseled "a" on center of inlet on west side of Knoll Trail Drive, 1850' north of Westgrove Drive, 20' south of power pole (#14N 2W 68) and 400' east of Dallas Parkway.  
 Elevation 630.40

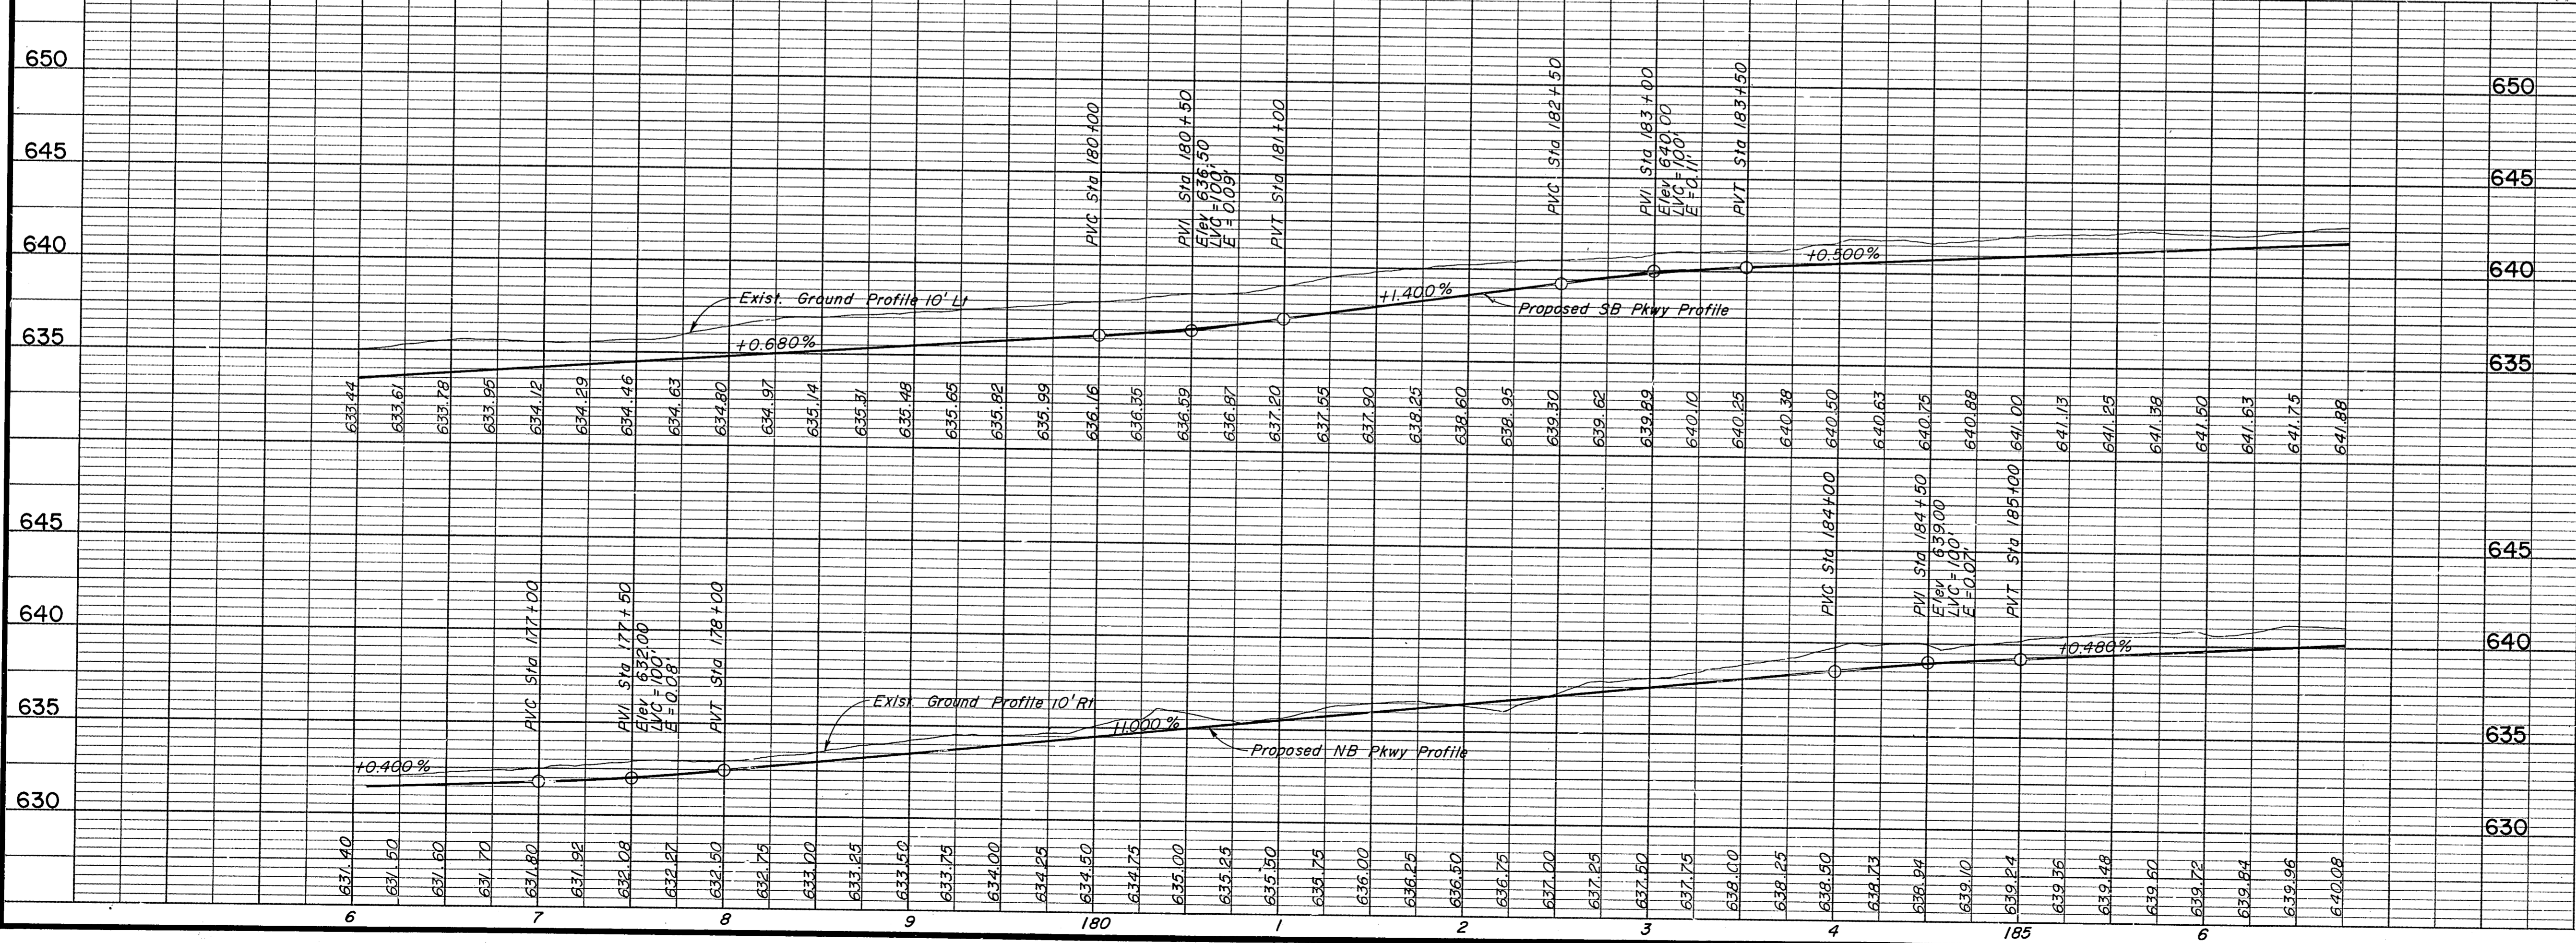

**NOTES**

- See Sheet R22 for Tollway Plan & Profile.
- See Sheet W12 for Retaining Wall Details.
- See the following Sheets for Storm Sewer Profiles:
 

Line	Sheet
K	R60
D	R62
- See Sheet R74 for Slotted Drain Detail.
- For Slopes See Cross Sections.

**ASBUILT PLANS**

As Built	C.B.		
Revised Storm Sewer Line "K" Alignment	MGB 3/14/85		
NO.	REVISION	BY	DATE

**TEXAS TURNPIKE AUTHORITY**  
**DALLAS NORTH TOLLWAY**

PAVING AND GRADING  
 DALLAS PARKWAY  
 STA 176+00 TO STA 186+75

**Gibbs & Hill, Inc.**  
 ENGINEERS DESIGNERS CONSTRUCTORS DALLAS

**SECTION VII**

DRAWN CJB DATE 4/5/83 DESIGNED DWC DATE 4/1/83  
 CHECKED DWC DATE 2/30/84 SCALE 1"=50' Hor 1"=5' Vert

CONTRACT NO. DNT-115 SHEET R12 OF R85



PARKWAY OFFICE  
CONDOMINIUM  
16685


Storm Sewer Curve K-2  
PI Sta 187+99.51, 16.00' RI, SB Pkwy  
 $\Delta = 42^{\circ}06'21''$   
 $D = 85^{\circ}30'58''$   
 $R = 67.00'$   
 $T = 25.79'$   
 $L = 49.24'$

OFFICE  
BLDG  
16901

Storm Sewer Curve L-1  
PI Sta 189+87.39, 5.00' RI, SB Pkwy  
 $\Delta = 29^{\circ}27'59''$   
 $D = 85^{\circ}30'58''$   
 $R = 67.00'$   
 $T = 17.62'$   
 $L = 34.57'$

REMOVAL LEGEND  
Concrete

SOJOURN LN

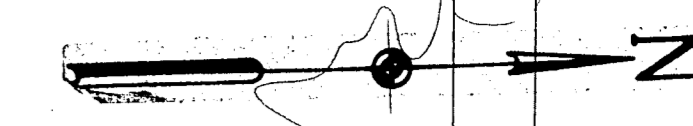

LEGEND

- Drainage Structures to be constructed under Phases I & II
- Drainage Structures to be constructed under Phase III
- Existing Drainage Structures. See Sheet R37 for Definition of Phase I, II, and III.

SEE SHEET R12  
MATCH LINE STA 186+75

MATCH LINE STA 199+00

MATCH LINE STA 186+75

MATCH LINE STA 199+00  
SEE SHEET R14

OFFICE  
BLDG

OFFICE  
BLDG

OFFICE  
BLDG


KEYSTONE CORP  
17110

EVERGREEN BLDG  
17120

OFFICE  
BLDG  
17130

Bench Mark #11  
Chiseled "L" on the back of curb at  
the southwest corner of a handicap  
ramp in the parking lot of the Wylain  
Building, 275' south of Knoll Trail  
Drive and 125' east of Dallas Parkway.  
Elevation: 636.26

WYLAIN  
17250

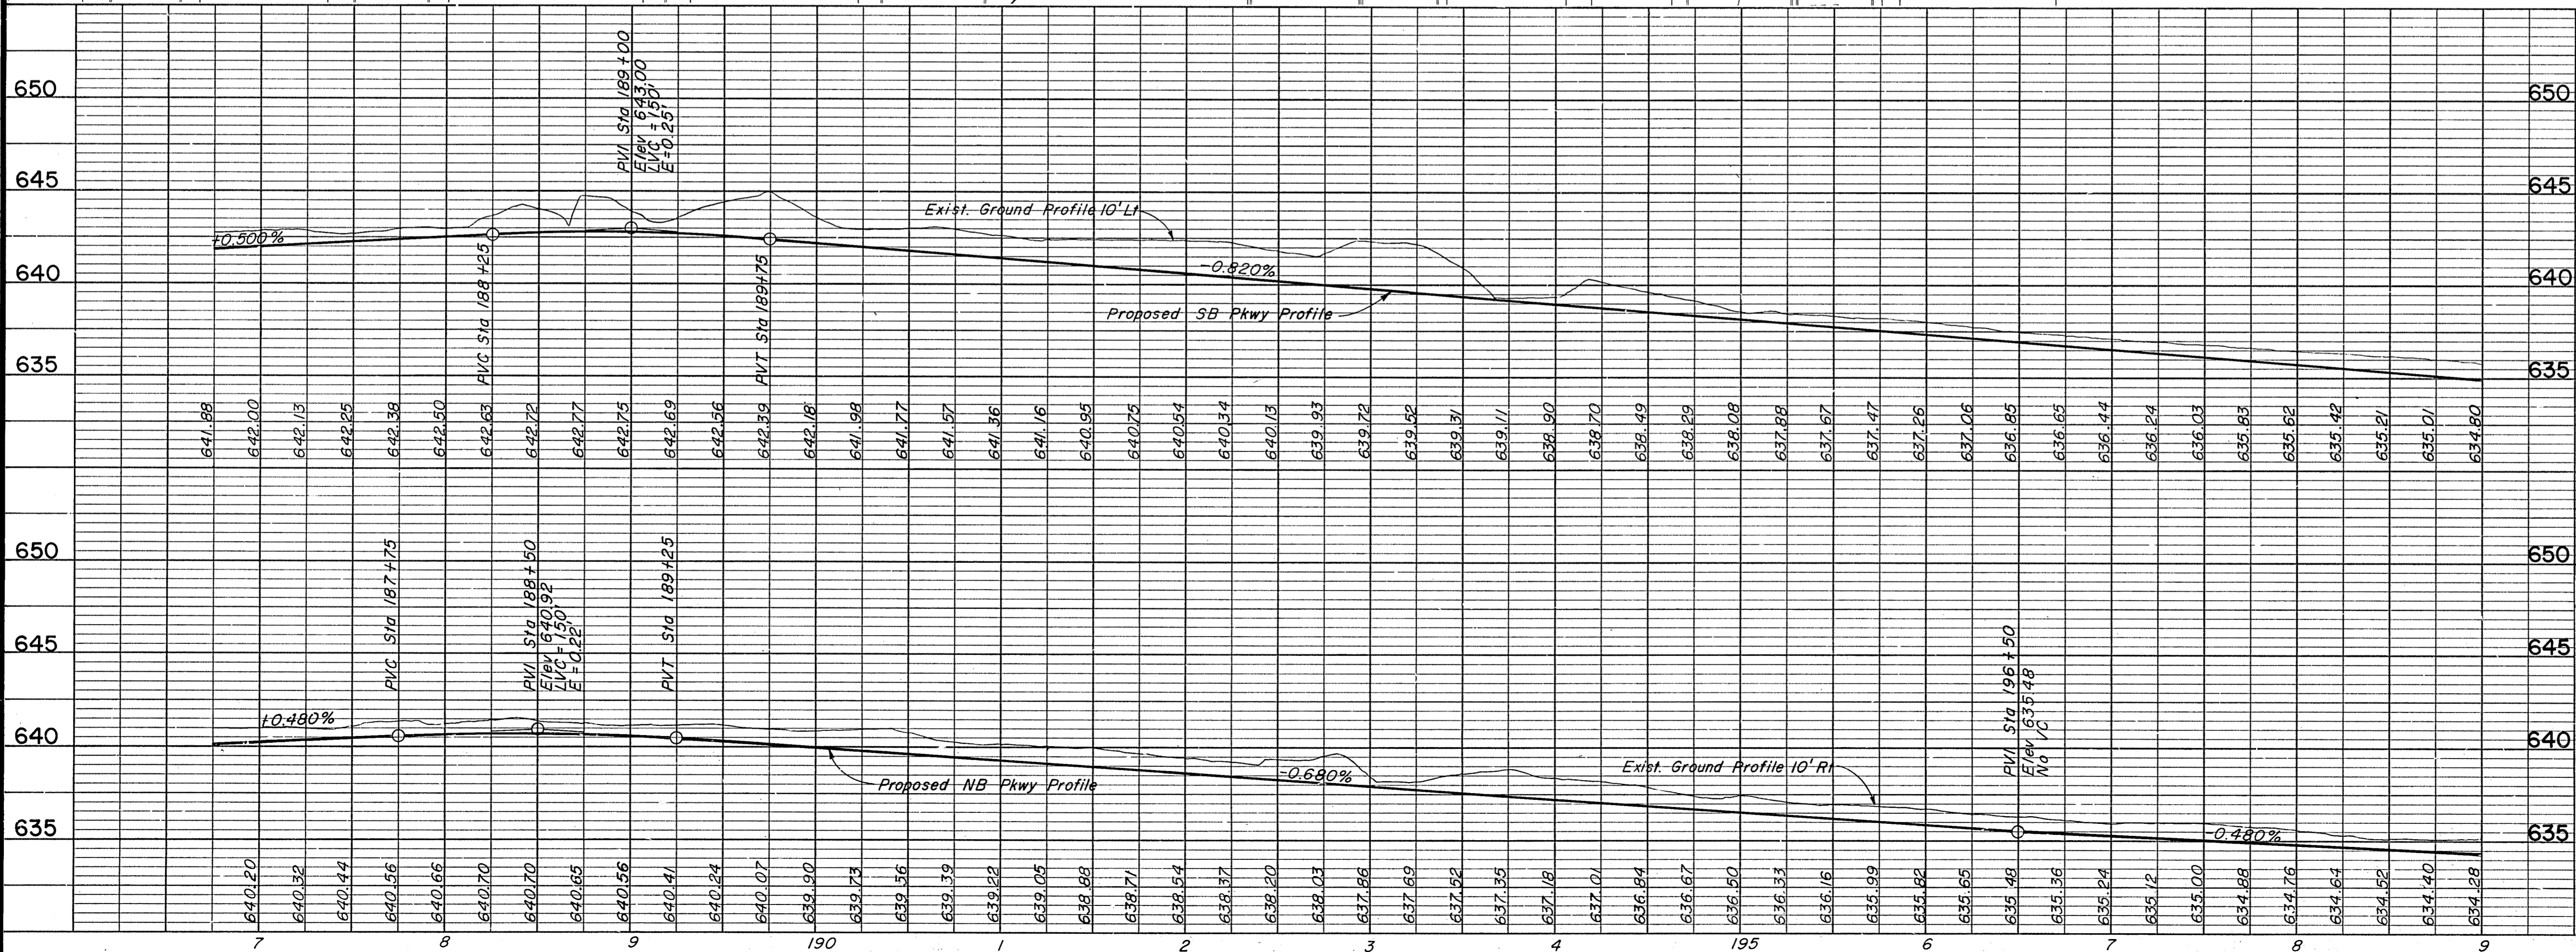

- NOTES:
- See Sheet R23 for Tollway Plan & Profile.
  - See the following sheets for Storm Sewer Profiles:
 

Line	Sheet
K	R60
L	R64
E, E2	R65
D	R62
S	R66
  - See Sheet R74 for Slotted Drain Detail.
  - For Slopes See Cross Sections.

ASBUILT PLANS

As Built	C.B.		
Revised Storm Sewer Line "K" Alignment	MGB 3/7/85		
NO.	REVISION	BY	DATE

TEXAS TURNPIKE AUTHORITY  
DALLAS NORTH TOLLWAY

PAVING AND GRADING  
DALLAS PARKWAY  
STA 186+75 TO STA 199+00

**Gibbs & Hill, Inc.** SECTION VII  
ENGINEERS DESIGNERS CONSTRUCTORS DALLAS

DRAWN CJB DATE 4/5/83 DESIGNED DWC DATE 4/1/83  
CHECKED DWC DATE 5/7/84 SCALE 1"=50' Hor 1"=5' Vert

CONTRACT NO. DNT-115 SHEET R13 OF R85




Curve T 4  
 PI Sta 744+67.60  
 N 481451.999  
 E 2206008.540  
 $\Delta = 21^{\circ}44'45''$   
 $D = 4^{\circ}00'00''$   
 $R = 1432.40'$   
 $T = 275.13'$   
 $L = 543.65'$

Curve SB 11  
 PI Sta 203+38.54  
 N 480561.807  
 E 2205886.497  
 $\Delta = 2^{\circ}23'37''$   
 $D = 2^{\circ}00'00''$   
 $R = 2864.79'$   
 $T = 59.85'$   
 $L = 119.68'$

Curve SB 12  
 PI Sta 204+58.25  
 N 480681.525  
 E 2205885.795  
 $\Delta = 2^{\circ}23'37''$   
 $D = 2^{\circ}00'00''$   
 $R = 2864.79'$   
 $T = 59.85'$   
 $L = 119.68'$

Curve NB 13  
 PI Sta 207+31.25  
 N 480974.192  
 E 2206091.430  
 $\Delta = 3^{\circ}20'03''$   
 $D = 4^{\circ}00'00''$   
 $R = 1432.39'$   
 $T = 41.69'$   
 $L = 83.35'$

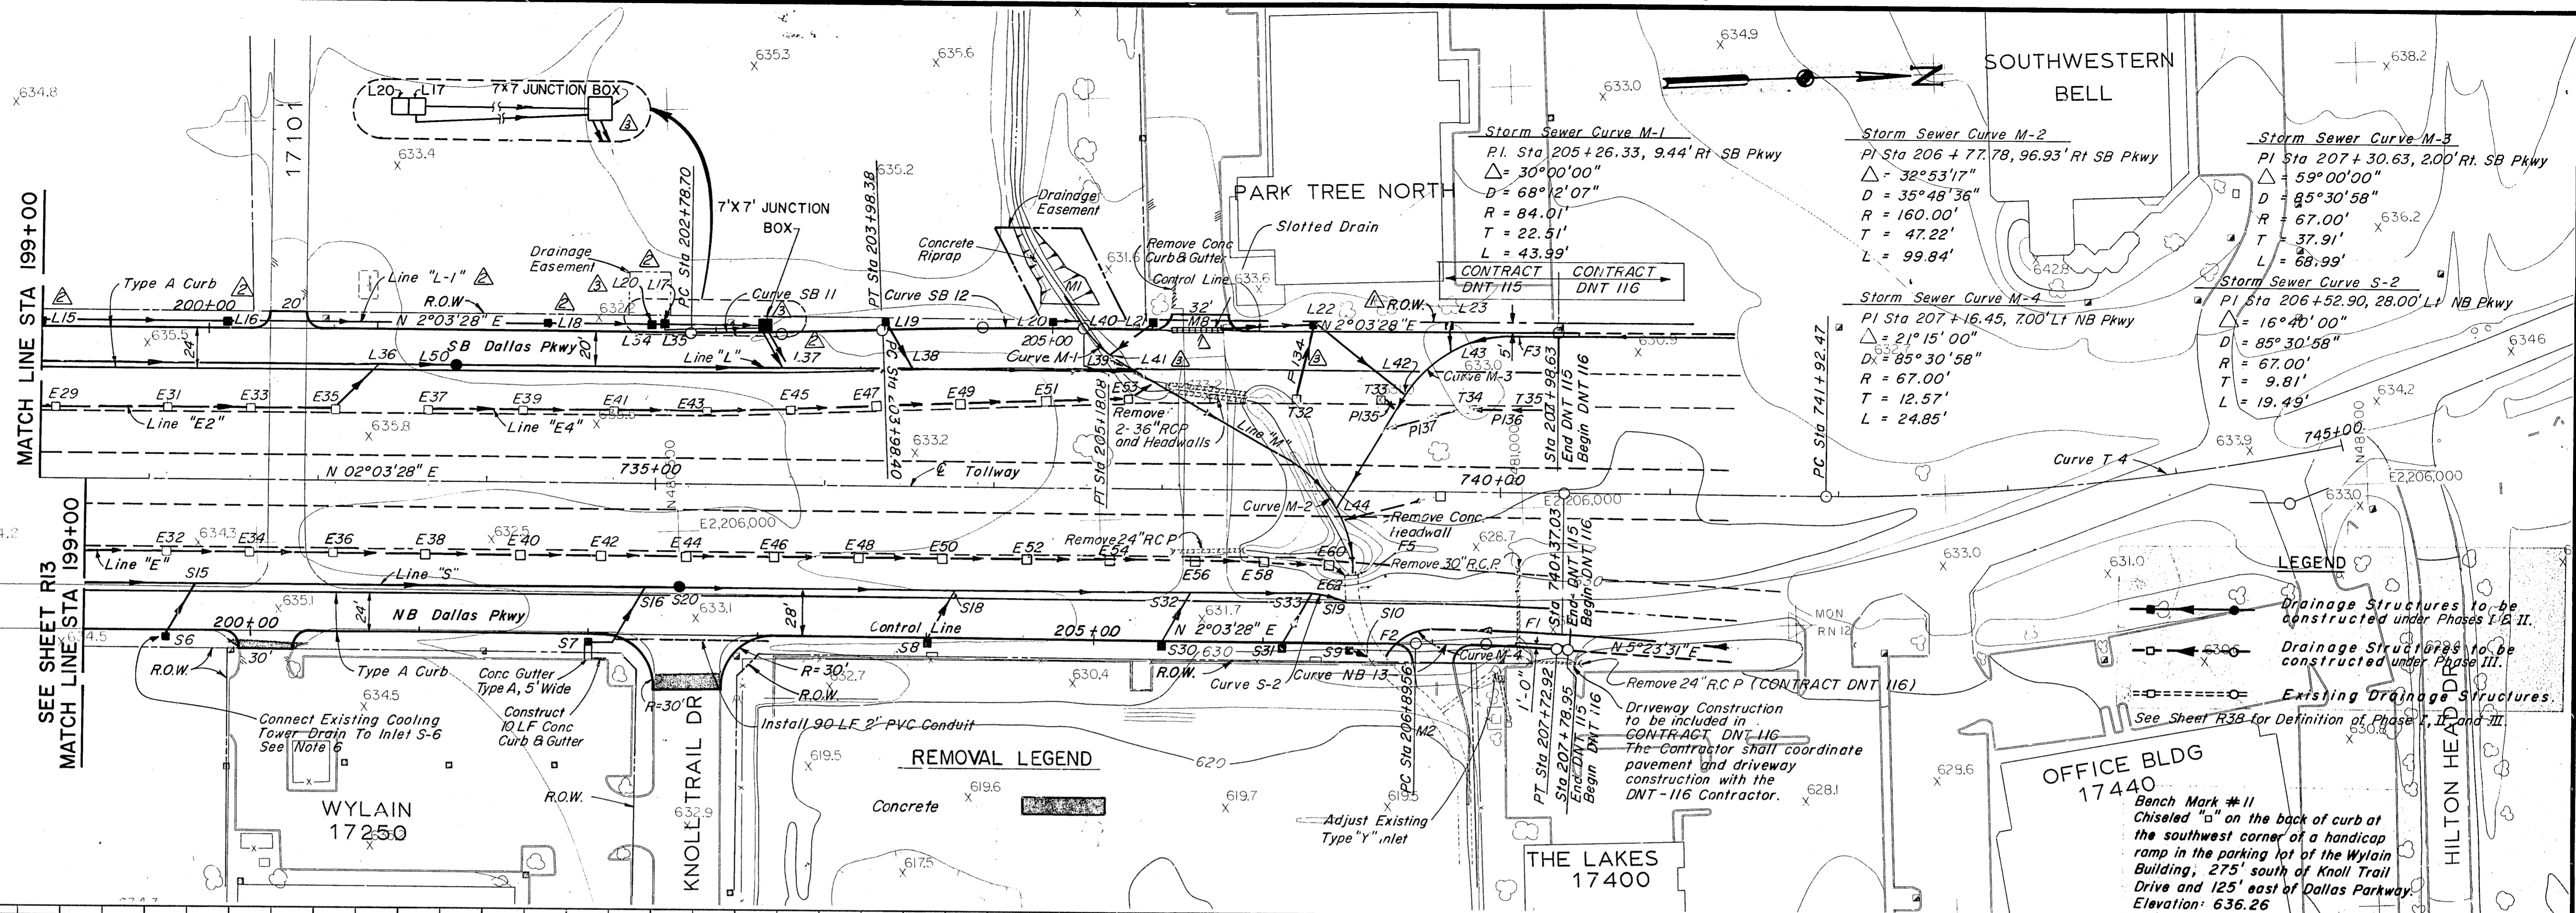


MATCH LINE STA 199+00  
 MATCH LINE STA 199+00  
 SEE SHEET R13  
 MATCH LINE STA 199+00

REMOVAL LEGEND  
 Concrete

LEGEND  
 Drainage Structures to be constructed under Phases I & II.  
 Drainage Structures to be constructed under Phase III.  
 Existing Drainage Structures.

OFFICE BLDG 17440  
 Bench Mark #11  
 Chiseled "B" on the back of curb at the southwest corner of a handicap ramp in the parking lot of the Wylain Building, 275' south of Knoll Trail Drive and 125' east of Dallas Parkway.  
 Elevation: 636.26

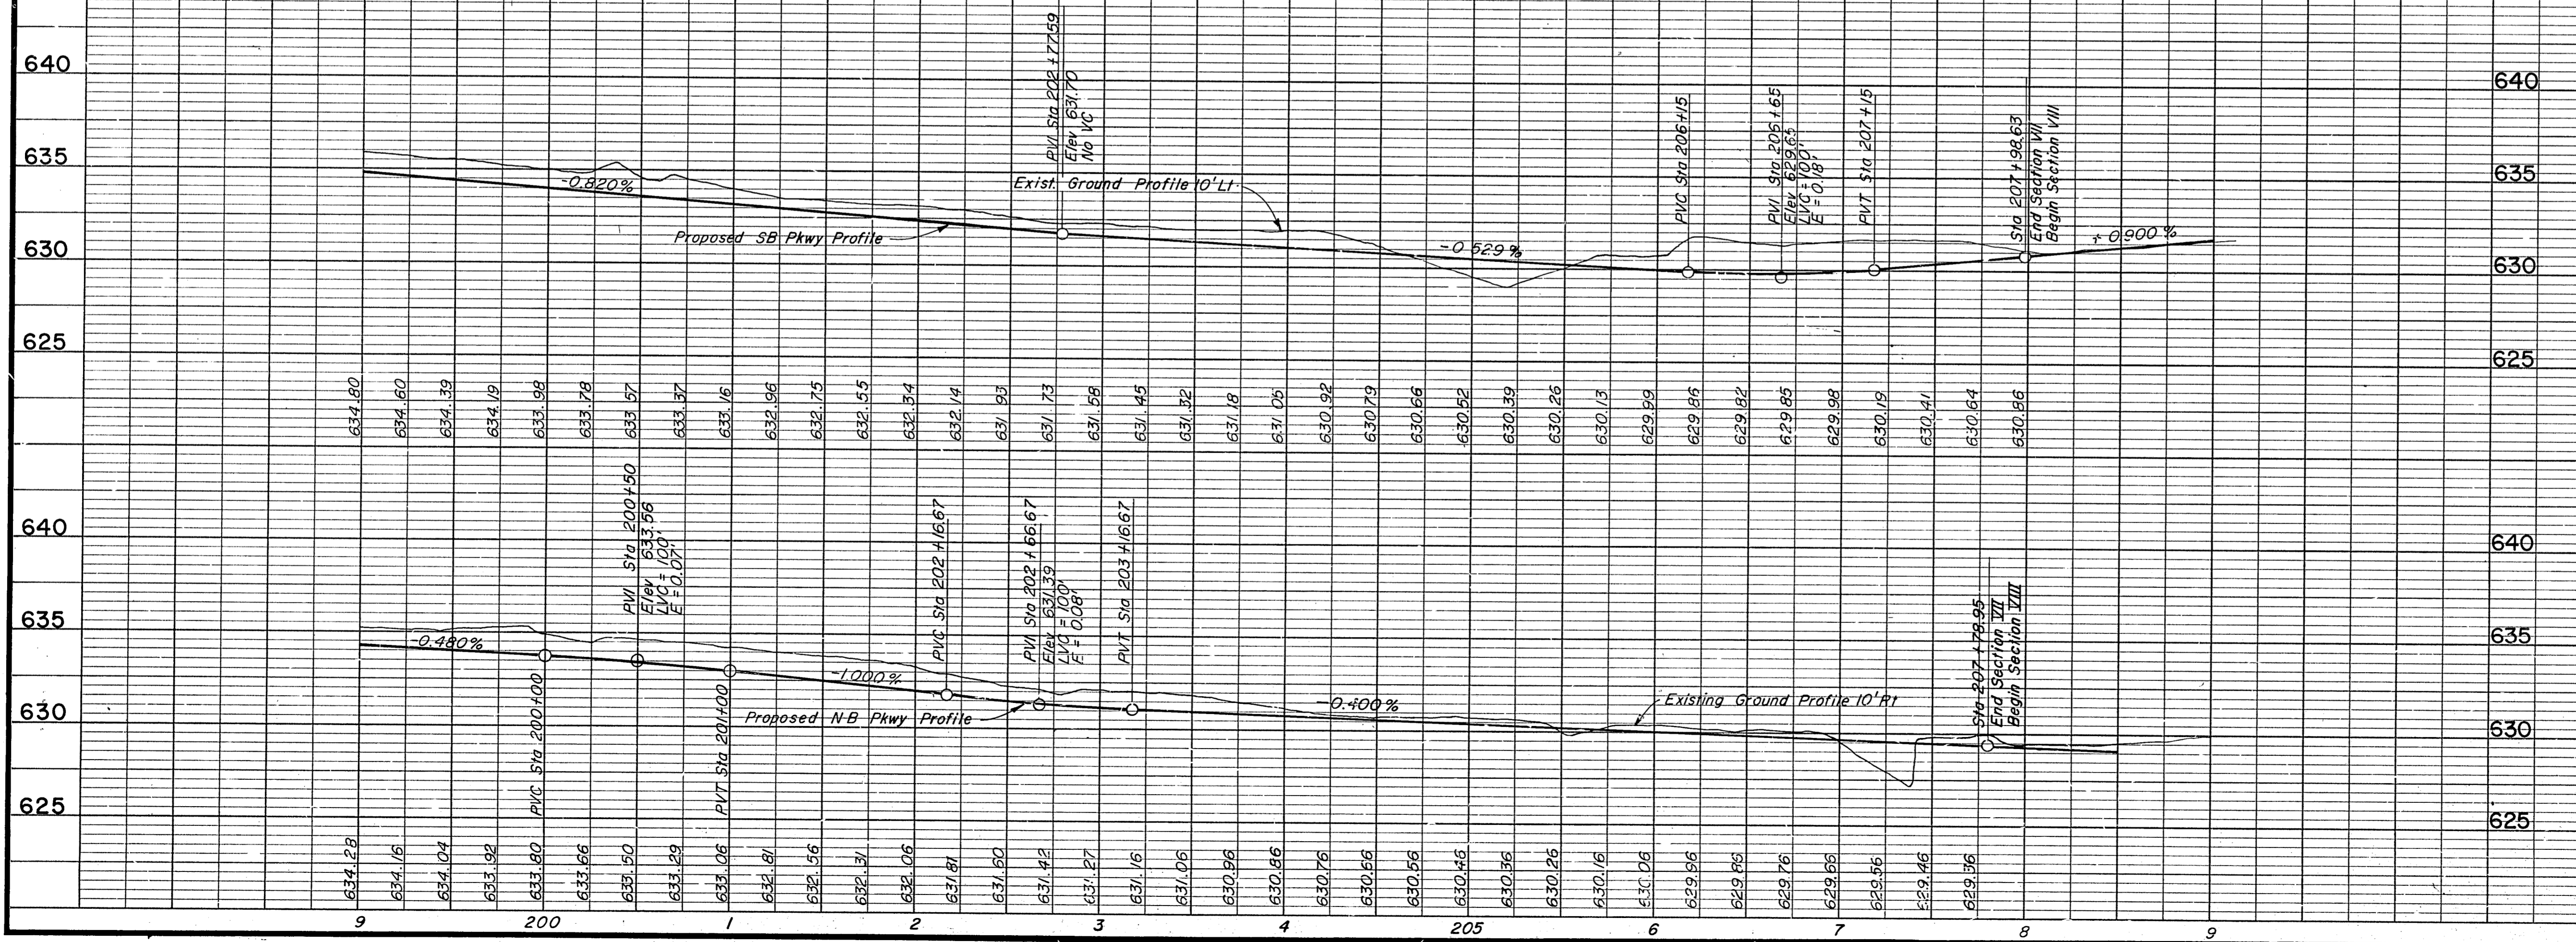


- NOTES
- See sheet R24 for Tollway Plan & Profile.
  - See sheet R73 for Culvert Details.
  - See sheet R33 for Paving Plan - Ramps A & B.
  - See the following Sheets for Storm Sewer Profiles
- | Line | Sheet |
|------|-------|
| S    | R66   |
| M    | R67   |
| L    | R64   |
- For Slopes See Cross Sections.
  - Cooling tower drain connection will not be paid for directly but will be considered subsidiary to Item 475 "Headwalls, Wingwalls, Inlets and Manholes."

ASBUILT PLANS


As Built	C.B.
General Trinity Mills/Brakgrove	GRB 10-9-85
Deleted Storm Sewer Laterals L-15, L-16, L-17, L-18; Added Line L-1	MGB 3-14-85
Removed Inlet M8 & Replaced with Slotted Drain; Revised R.O.W. Line	B&A 2-5-85

TEXAS TURNPIKE AUTHORITY  
 DALLAS NORTH TOLLWAY  
 PAVING AND GRADING  
 DALLAS PARKWAY  
 STA 199+00 TO STA 207+98.67  
**Gibbs & Hill, Inc.**  
 ENGINEERS DESIGNERS CONSTRUCTORS DALLAS  
 SECTION VII  
 DRAWN CJB DATE 4/4/83 DESIGNED DWC DATE 4/4/83  
 CHECKED MGB DATE 5/4/84 SCALE 1"=50' Hor 1"=5' Vert  
 CONTRACT NO. DNT-115 SHEET R14 OF R55



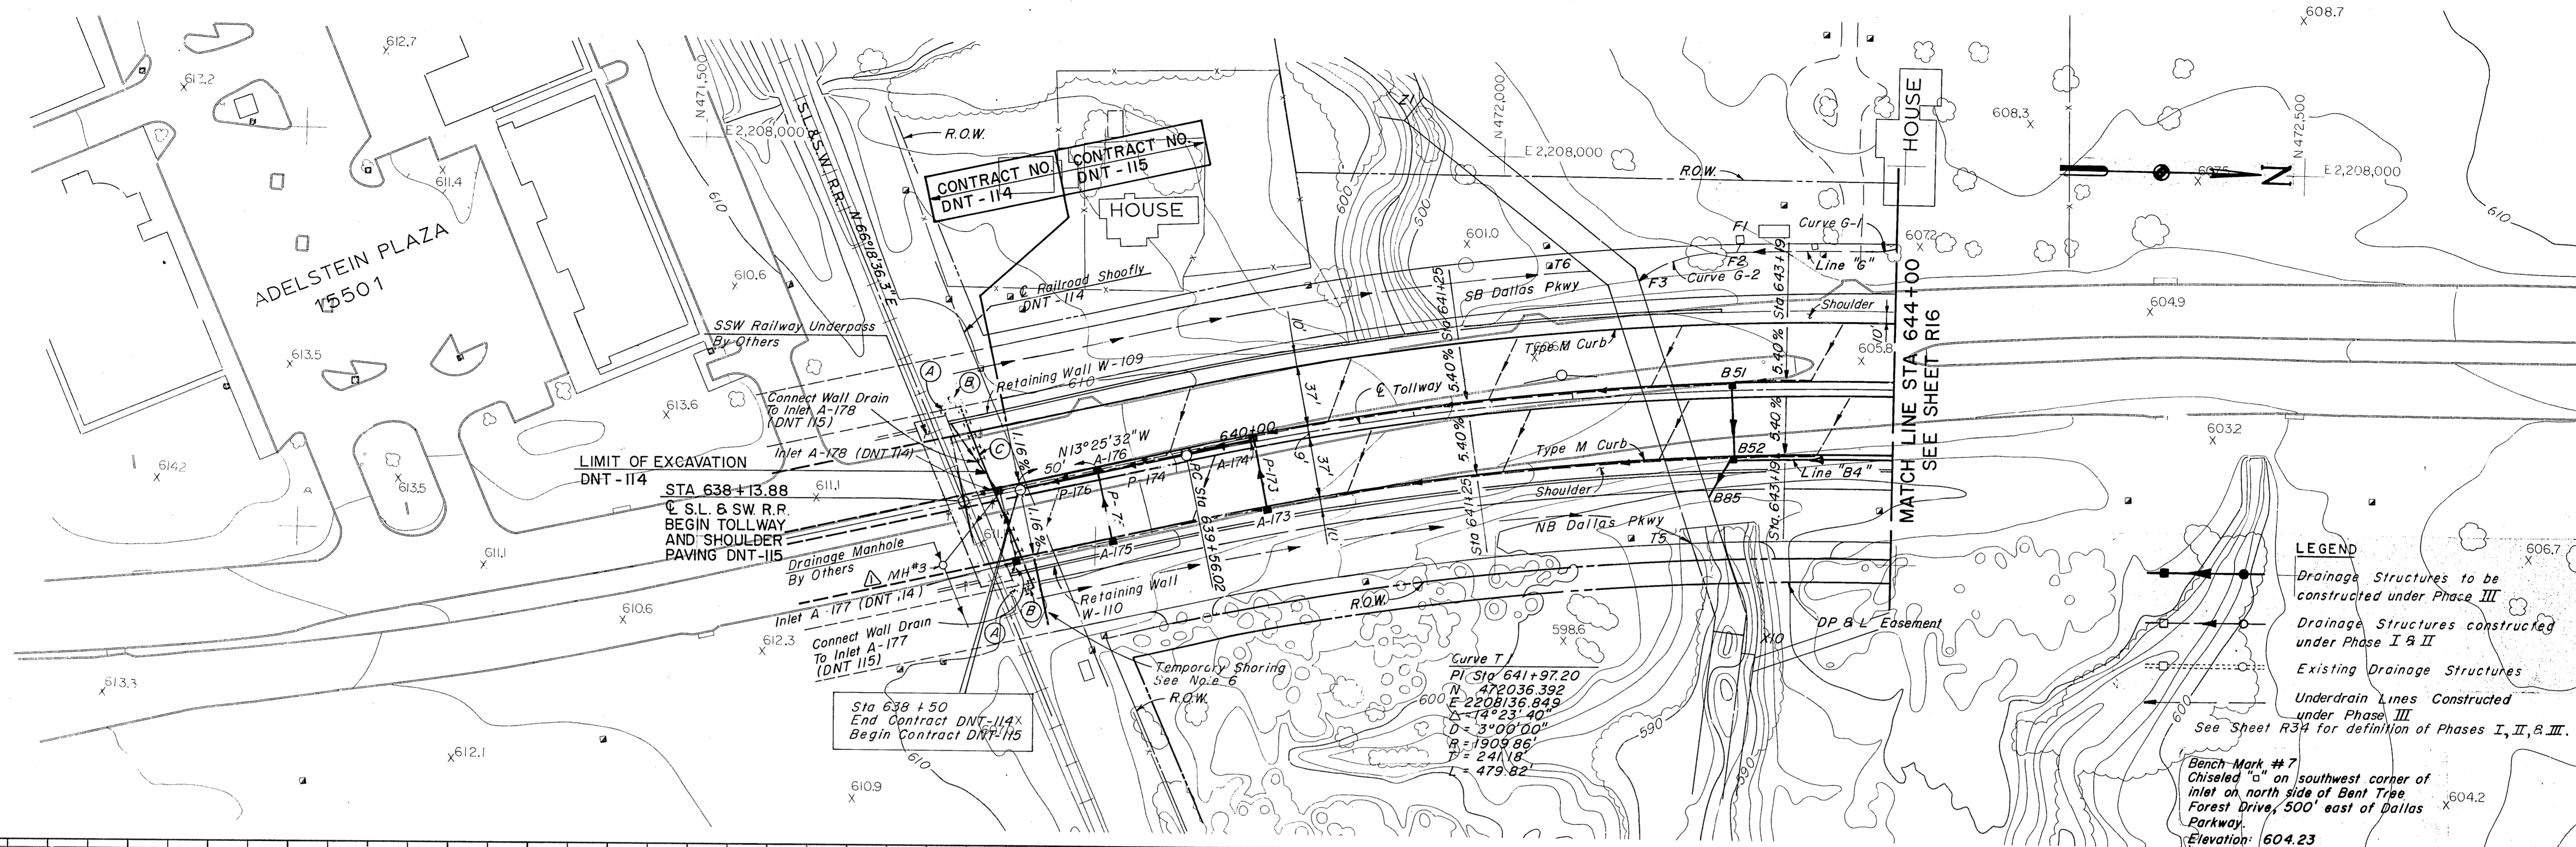



- NOTES:**
1. See Sheet R5 for Dallas Parkway Plan & Profiles for Removals.
  2. See Sheet R50 for Storm Sewer Profiles.
  3. See Sheets R68 - R69 for Box Culvert Details.
  4. See Sheets W1 for Retaining Wall and Shoring Details.
  5. For Shoulder and Median Barrier Details See Typical Sections.
  6. Temporary Shoring (A) and (B) shall be constructed by DNT-114 and will remain in place until Walls W-109 and W-110 are constructed. Temporary Shoring (A), if removed will be removed by DNT-114. DNT-115 (if their option) will salvage or abandon shoring (B) after Walls W-109 and W-110 are constructed. Temporary Shoring (C) will be constructed by DNT-114 and removed by DNT-114 after the railroad bridge is constructed and railroad traffic returned to original track. DNT-115 will not be permitted to work south of the shoofly until railroad traffic is returned to the existing track. The exact date of the shoofly removal has not been determined. DNT-114 and DNT-115 contractors shall coordinate construction at the contract limits.

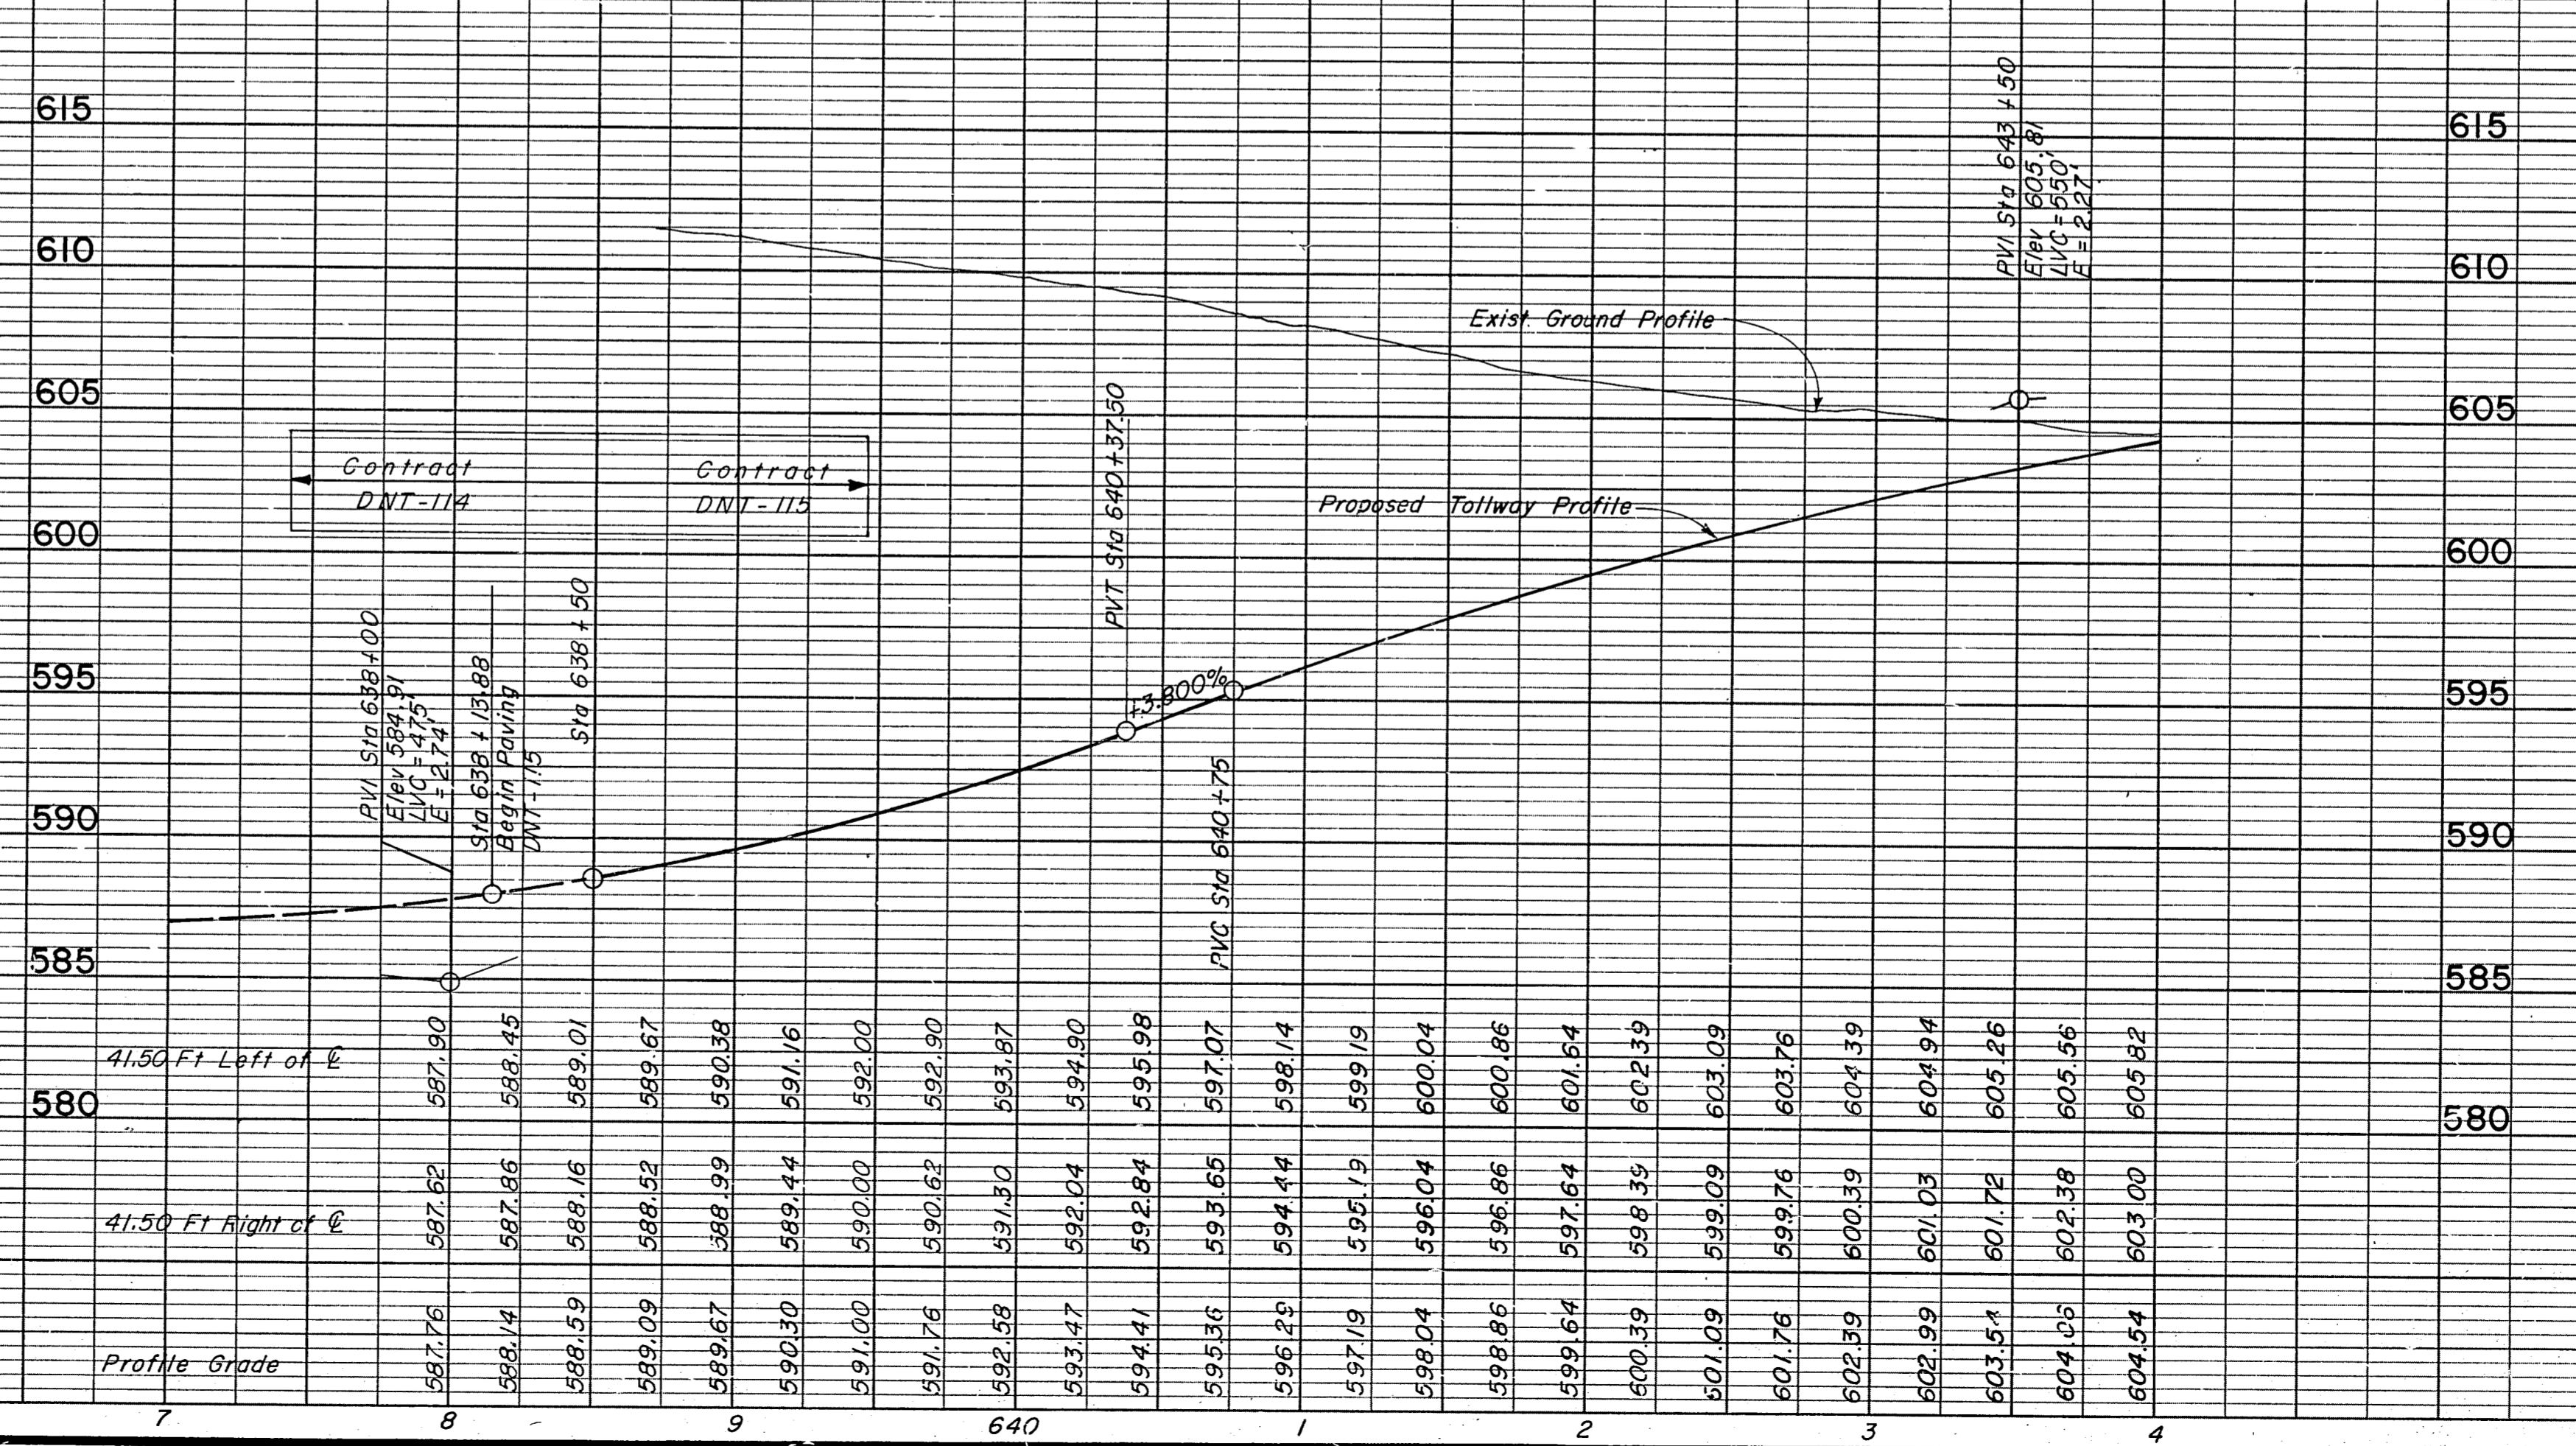

**ASBUILT PLANS**

As BUILT PLANS		FJ 1-8-88	
NO.	REVISION	BY	DATE
<b>TEXAS TURNPIKE AUTHORITY</b> <b>DALLAS NORTH TOLLWAY</b> PAVING AND GRADING TOLLWAY STA 638+50 TO STA 644+00 <b>Gibbs &amp; Hill, Inc.</b> ENGINEERS DESIGNERS CONSTRUCTORS DALLAS			
DRAWN VER DATE 7/8/83		DESIGNED DWG DATE 6/30/83	
CHECKED DWG DATE 4/30/84		SCALE 1"=50' Hor 1"=5' Vert	
CONTRACT NO. DNT-115 SHEET R15 OF R85			



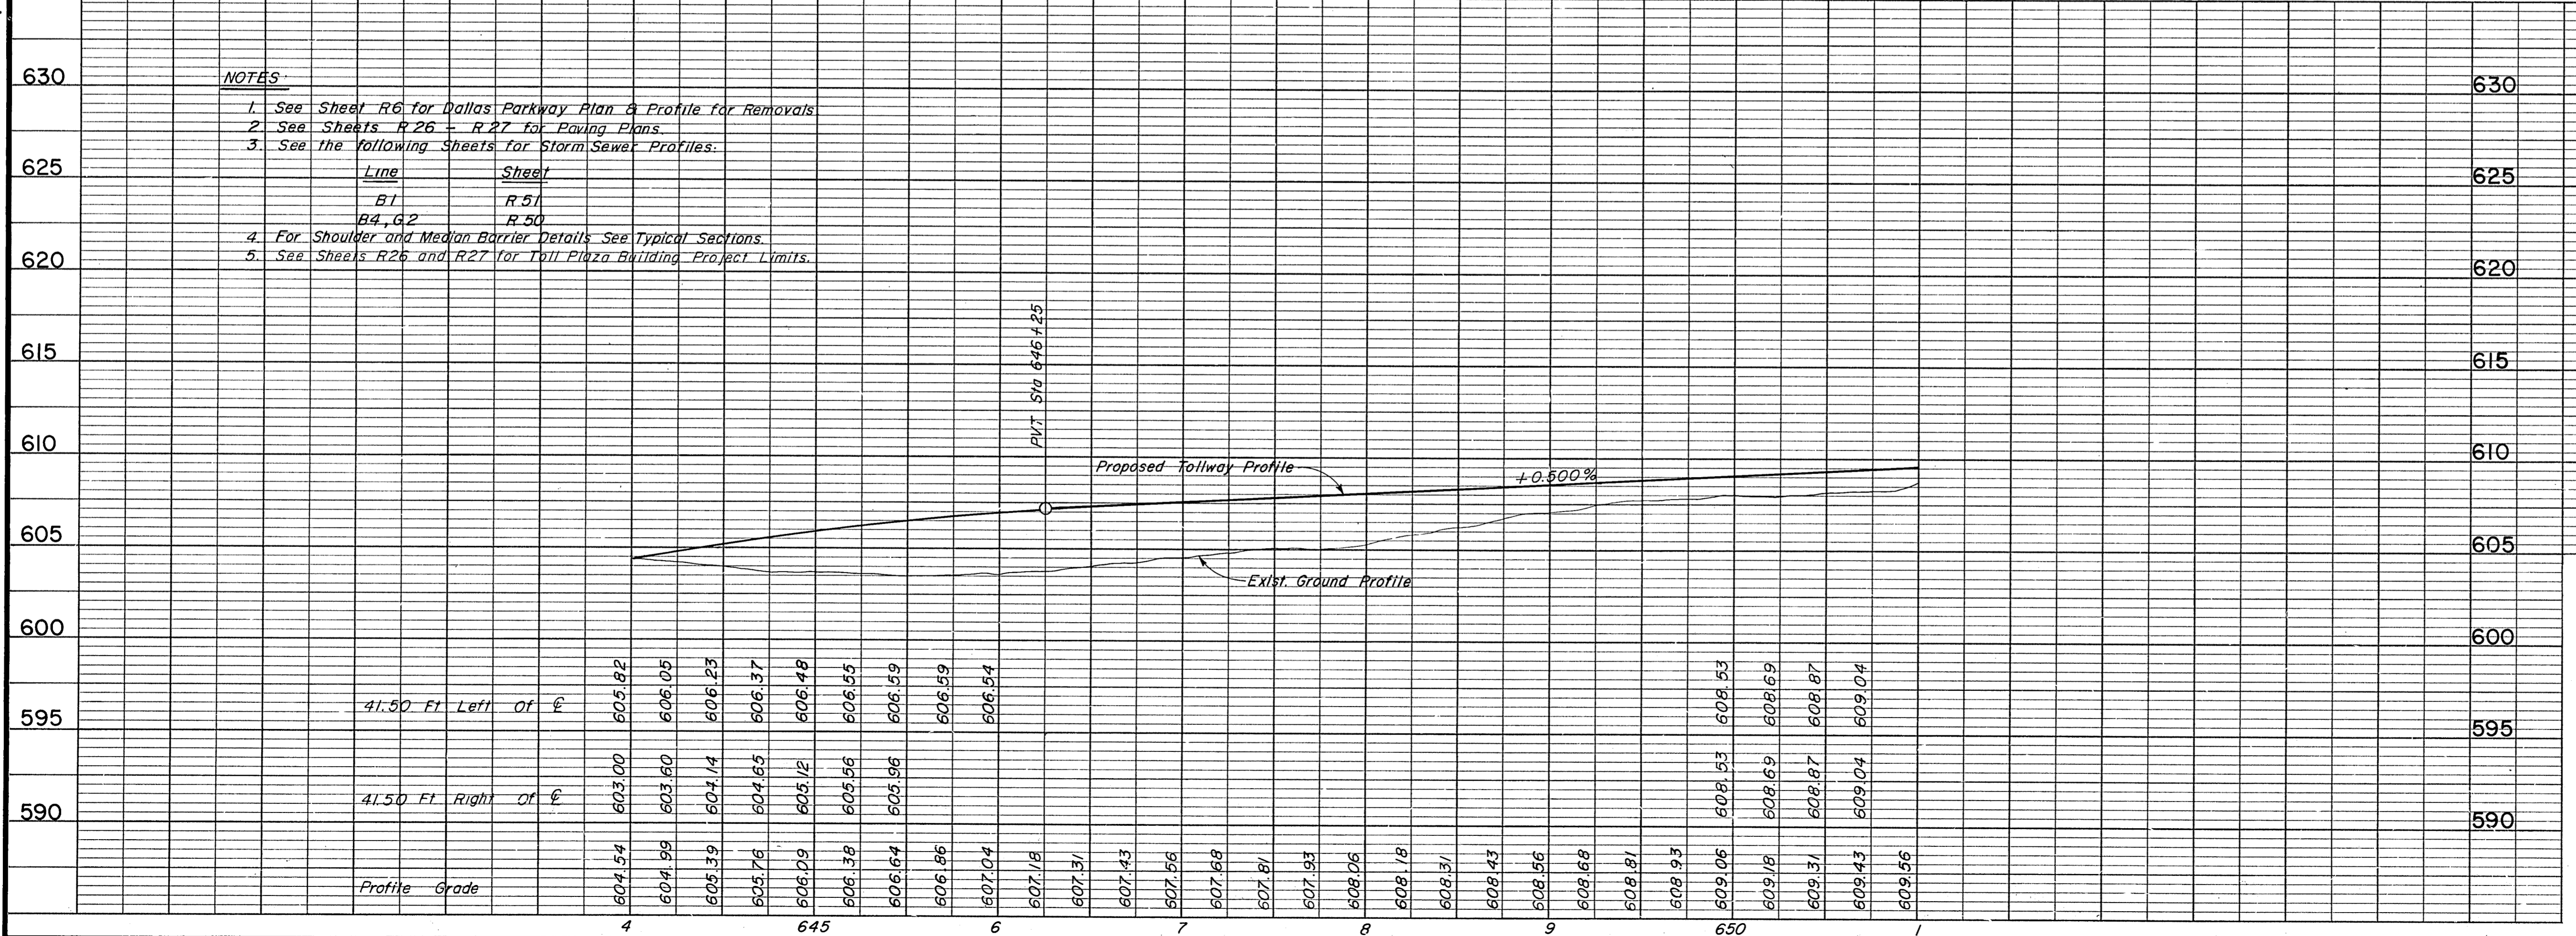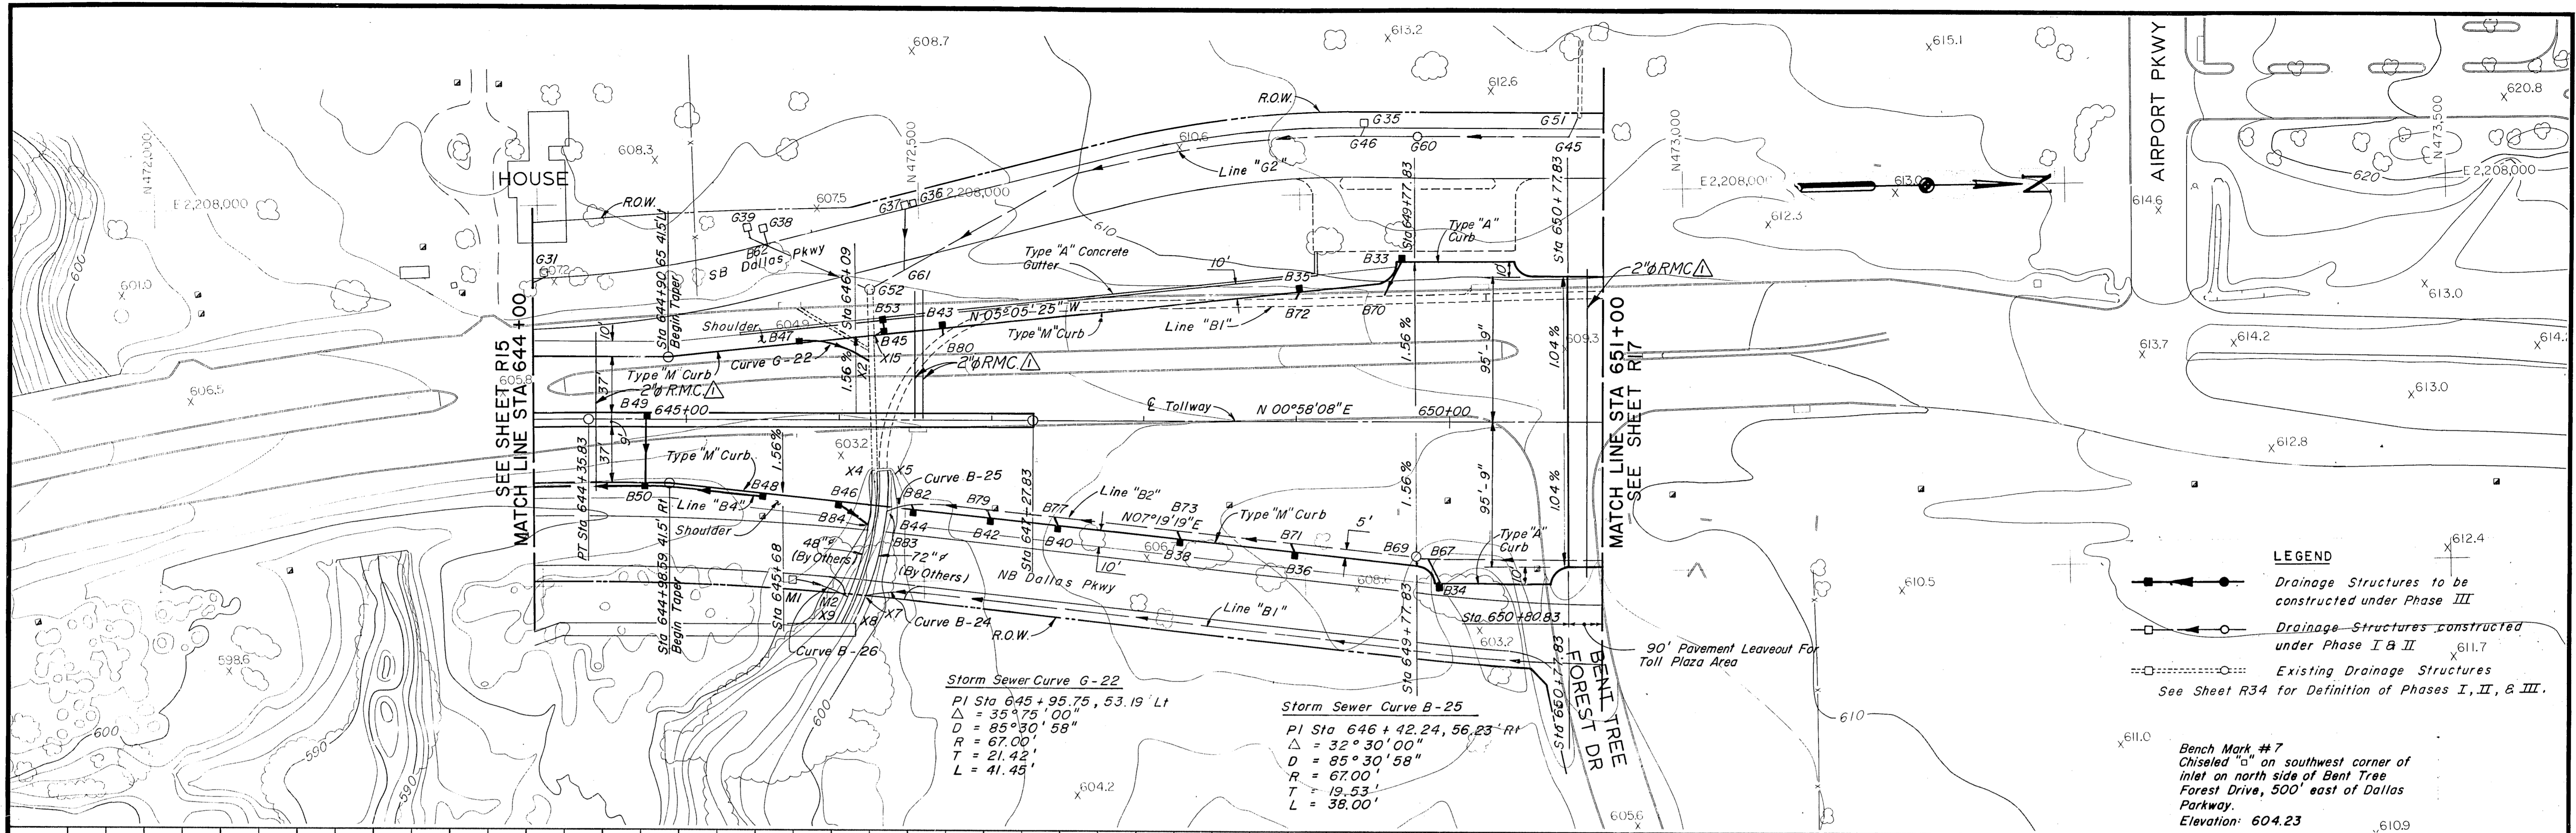

- NOTES**
1. See Sheet R6 for Dallas Parkway Plan & Profile for Removals
  2. See Sheets R26 - R27 for Paving Plans.
  3. See the following sheets for Storm Sewer Profiles:
 

Line	Sheet
B1	R51
B4, G2	R50
  4. For Shoulder and Median Barrier Details See Typical Sections.
  5. See Sheets R26 and R27 for Toll Plaza Building Project Limits.

**LEGEND**

- ▲ Drainage Structures to be constructed under Phase III
- Drainage Structures constructed under Phase I & II
- Existing Drainage Structures

See Sheet R34 for Definition of Phases I, II, & III.

Bench Mark #7  
Chiseled "o" on southwest corner of inlet on north side of Bent Tree Forest Drive, 500' east of Dallas Parkway.  
Elevation: 604.23

**ASBUILT PLANS**

NO.	REVISION	BY	DATE
	Added Conduit	JJK	2-19-86

**TEXAS TURNPIKE AUTHORITY**  
**DALLAS NORTH TOLLWAY**

PAVING AND GRADING  
TOLLWAY  
STA 644+00 TO STA 651+00


**Gibbs & Hill, Inc.**  
ENGINEERS DESIGNERS CONSTRUCTORS  
DALLAS

**SECTION VII**

DRAWN VER	DATE 7/8/83	DESIGNED DWC	DATE 6/30/83
CHECKED DWC	DATE 5/7/84	SCALE 1"=50' Hor 1"=5' Vert	

CONTRACT NO. DNT-115 SHEET R16 OF R85



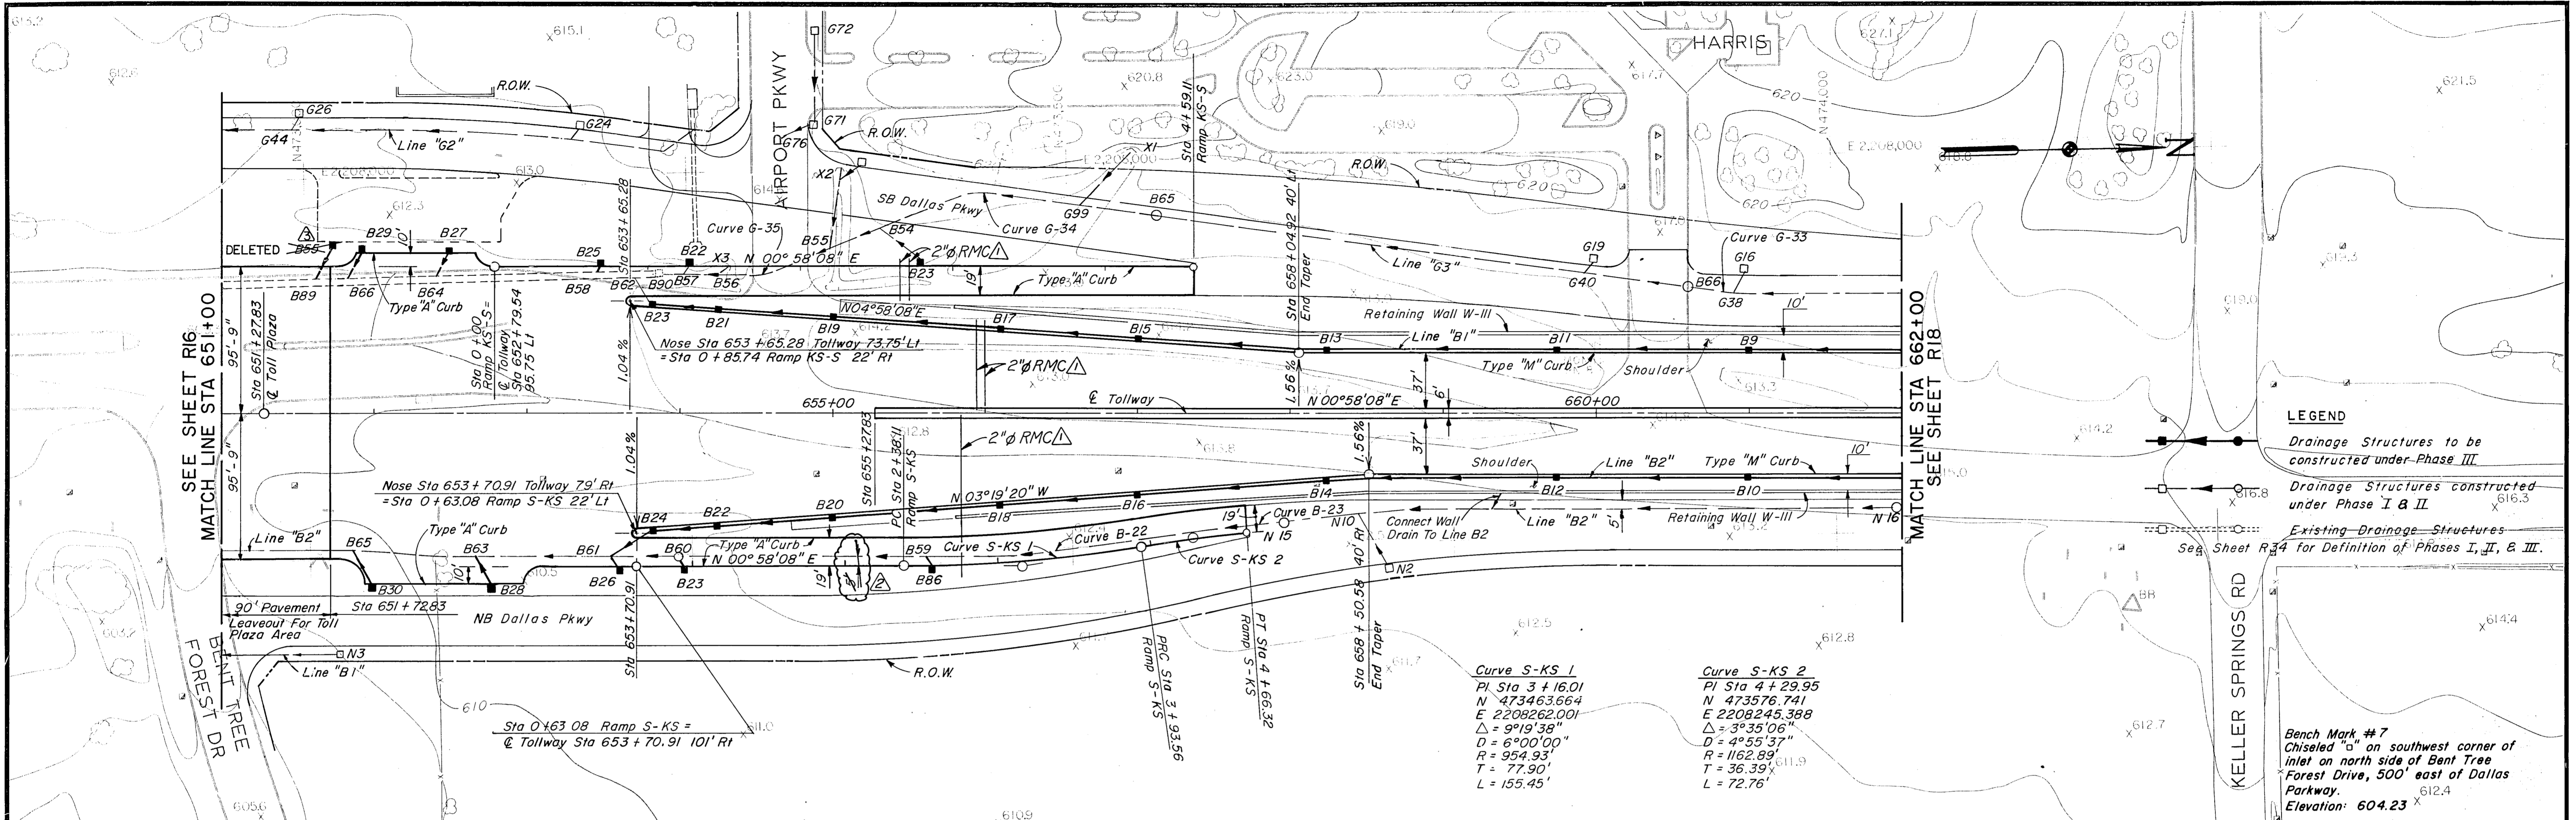

**LEGEND**


- Drainage Structures to be constructed under Phase III
- Drainage Structures constructed under Phase I & II
- - - Existing Drainage Structures

See Sheet R34 for Definition of Phases I, II, & III.

**Curve S-KS 1**  
 PI Sta 3 + 16.01  
 N 47°34'33.664"  
 E 22°08'26.001"  
 $\Delta = 9°19'38"$   
 D = 6°00'00"  
 R = 954.93'  
 T = 77.90'  
 L = 155.45'

**Curve S-KS 2**  
 PI Sta 4 + 29.95  
 N 47°35'76.741"  
 E 22°08'245.388"  
 $\Delta = 3°35'06"$   
 D = 4°55'37"  
 R = 1162.89'  
 T = 36.39'  
 L = 72.76'

**Bench Mark #7**  
 Chiseled "o" on southwest corner of inlet on north side of Bent Tree Forest Drive, 500' east of Dallas Parkway.  
 Elevation: 604.23

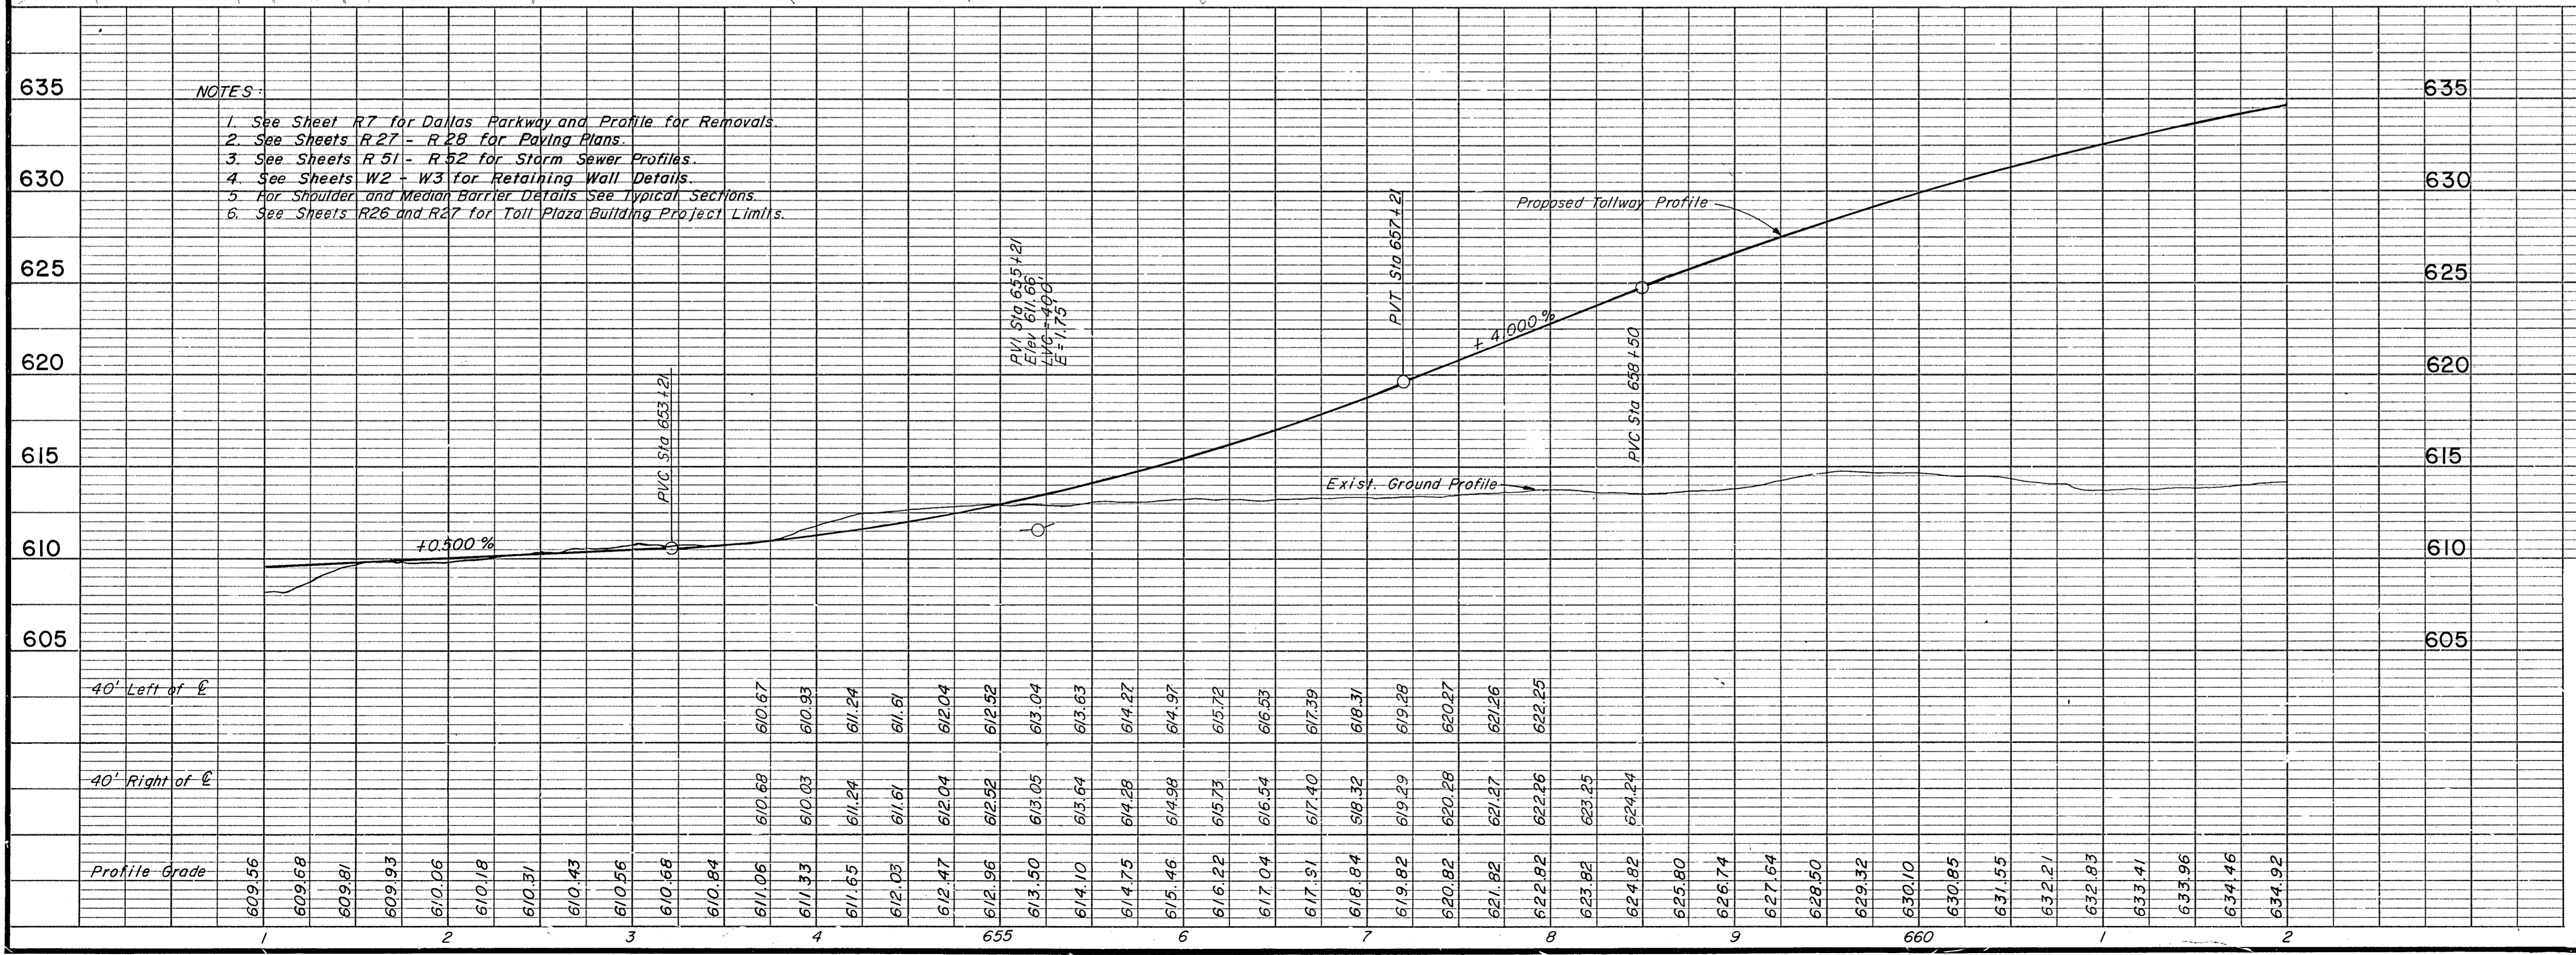

**ASBUILT PLANS**

3	AS BUILT PLANS	PJ	1-11-86
	Revised Storm Sewer Line B-2	REF	3-25-86
	Added Conduit	JTK	2-19-86
NO.	REVISION	BY	DATE

**TEXAS TURNPIKE AUTHORITY**  
**DALLAS NORTH TOLLWAY**

PAVING AND GRADING  
 TOLLWAY  
 STA 651+00 TO STA 662+00


**Gibbs & Hill, Inc.**  
 ENGINEERS, DESIGNERS, CONSTRUCTORS  
 DALLAS

**SECTION VII**

DRAWN **VER** DATE **7/8/83** DESIGNED **DWC** DATE **6/30/83**  
 CHECKED **DWC** DATE **5/2/84** SCALE **1"=50' Hor 1"=5' Vert**


CONTRACT NO. **DNT-115** SHEET **R17** OF **P85**



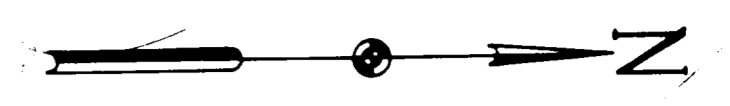

SEE SHEET R17  
MATCH LINE STA 662+00

MATCH LINE STA 674+00  
SEE SHEET R19

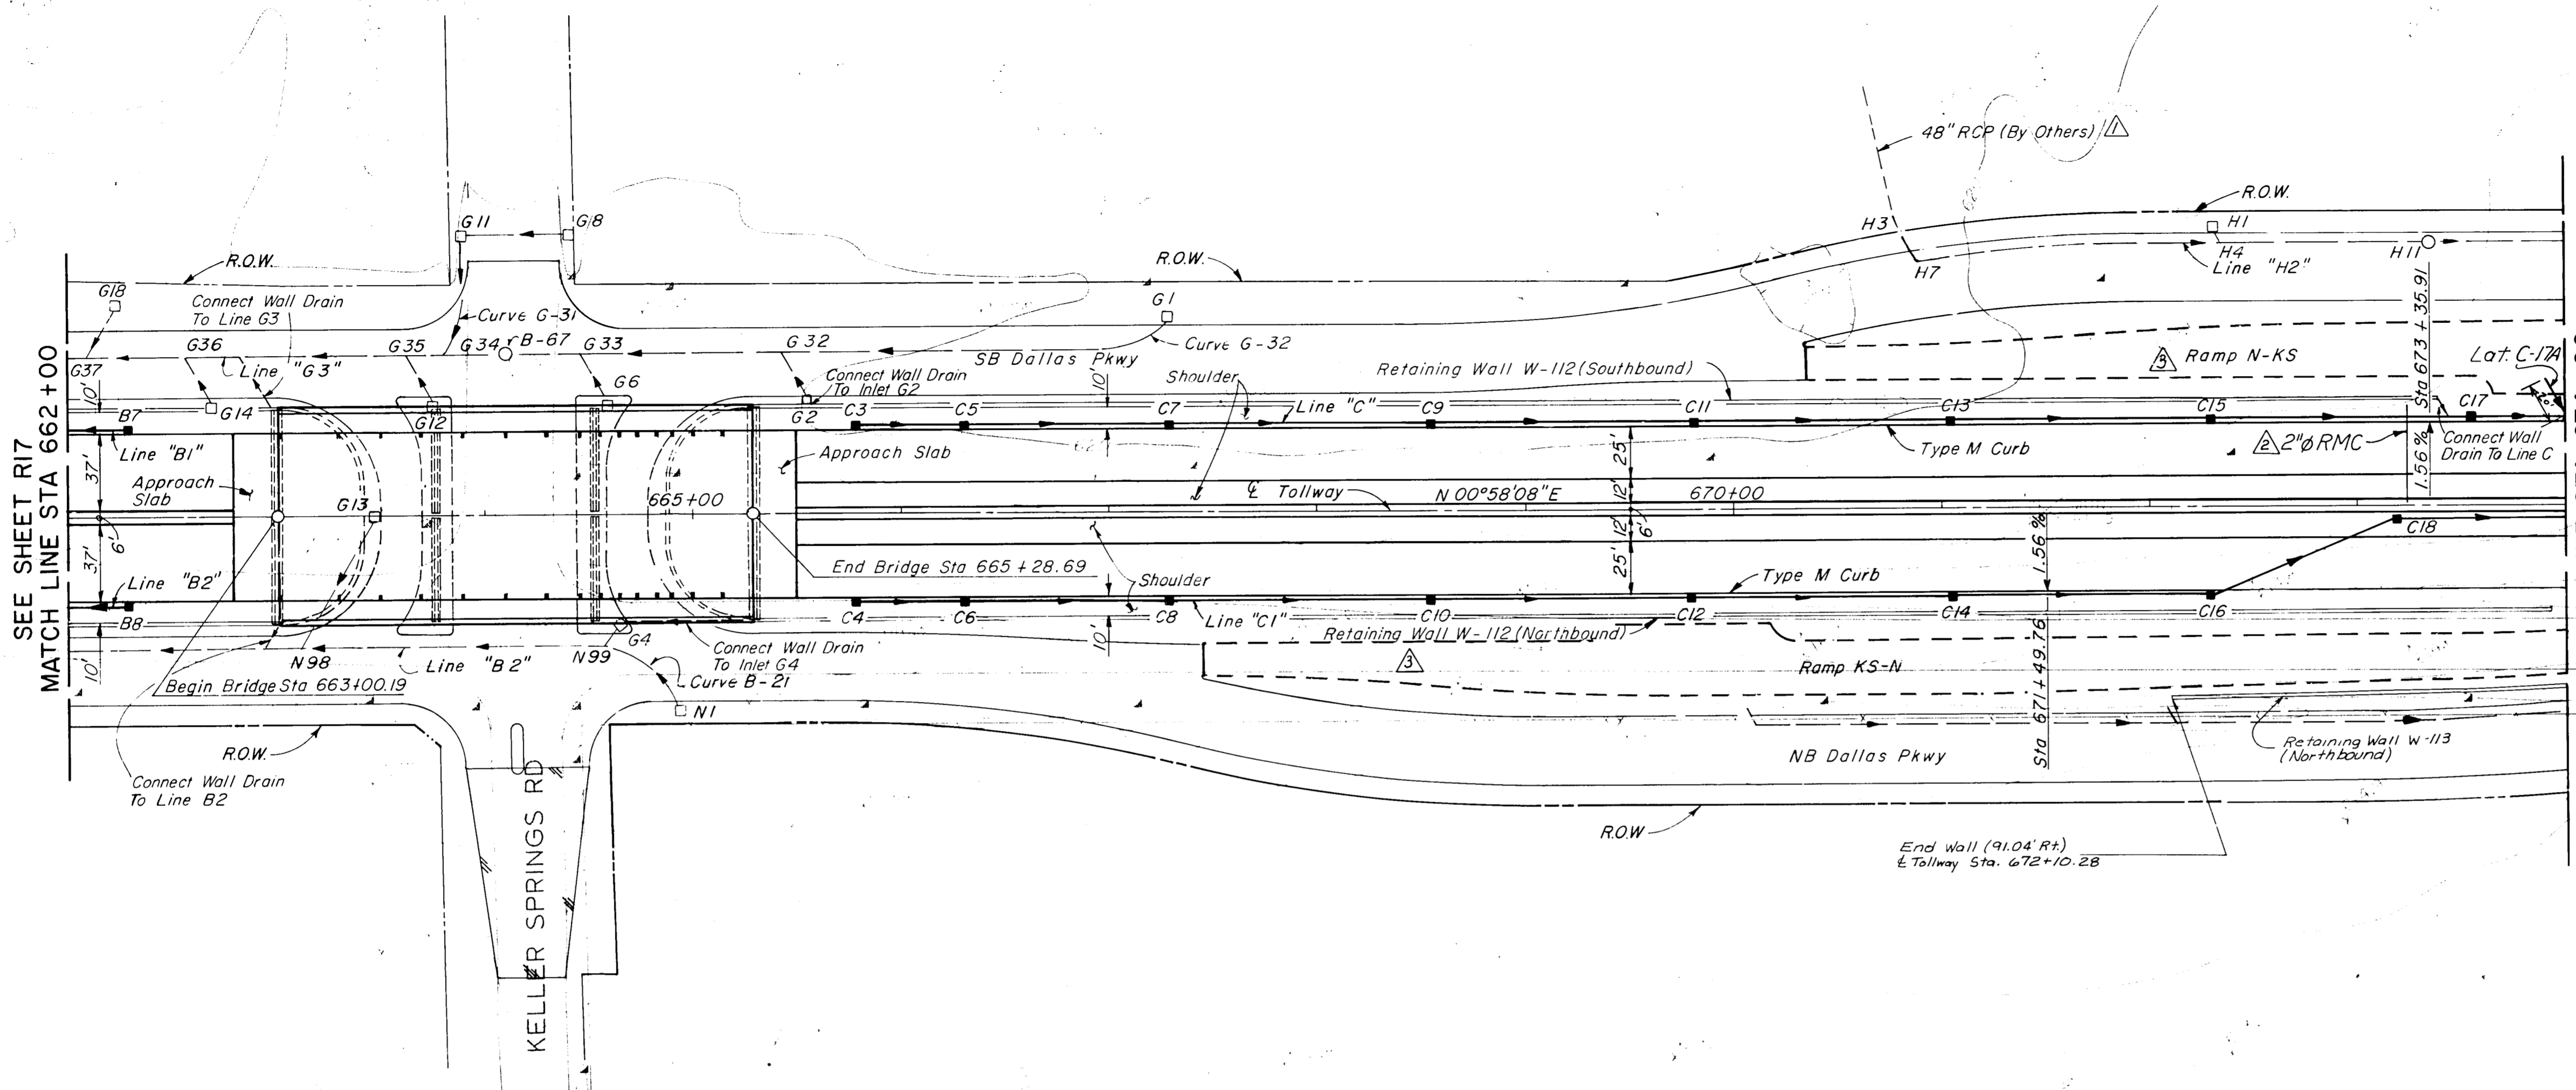


**LEGEND**

- Drainage Structures to be constructed under Phase III
- Drainage Structures constructed under Phase I & II
- Existing Drainage Structures

See Sheet R35 for Definition of Phase I, II, and III.

Bench Mark #8  
Chiseled '8' on end of curb radius at first drive on north side of Keller Springs Road, 150' east of United Fidelity Building, 500' west of Dallas Parkway  
Elevation: 626.24

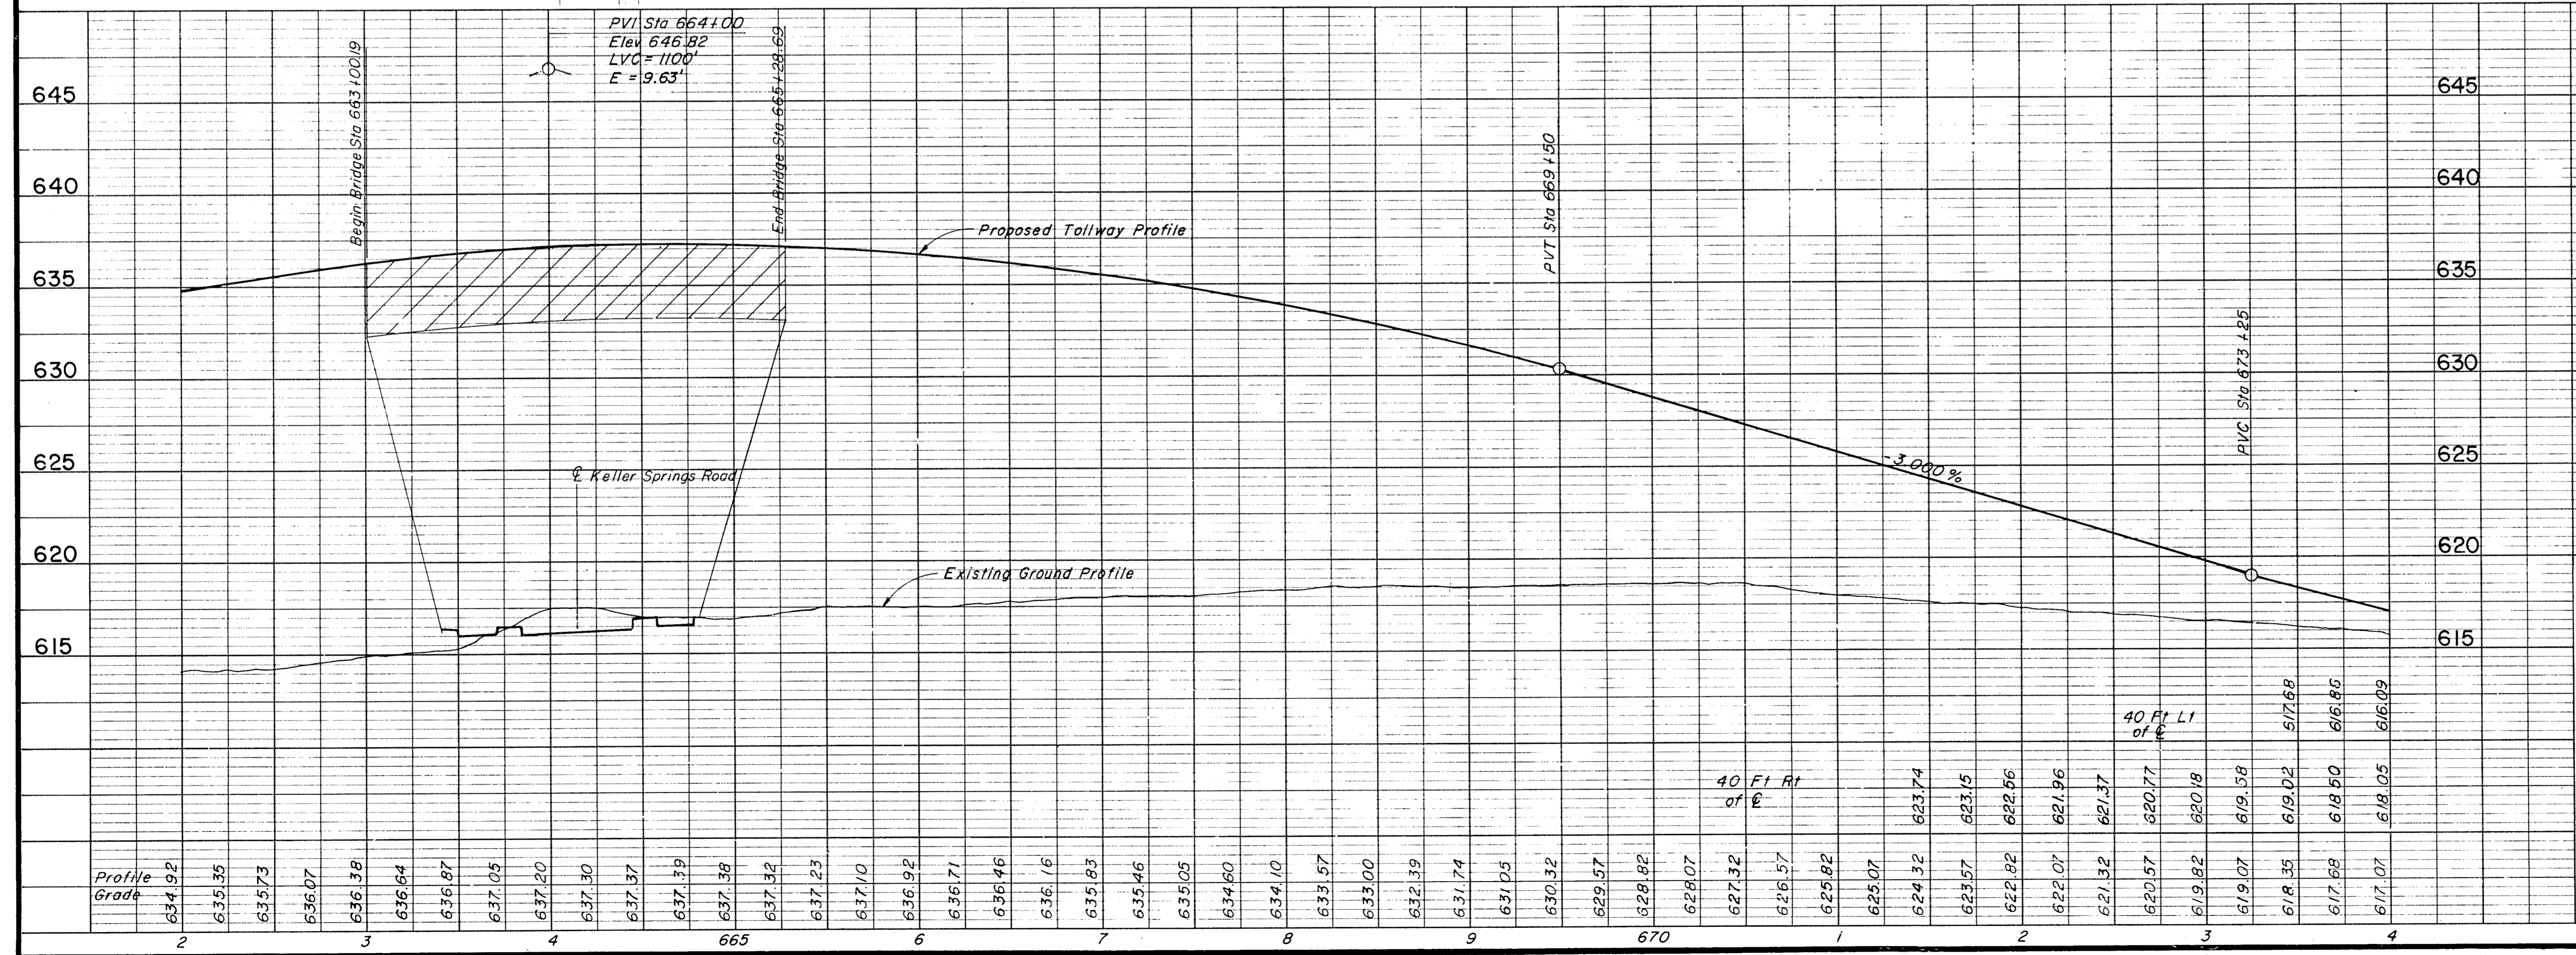

- Notes:
- See Sheet RB for Dallas Parkway Plan & Profile for Removals.
  - See Sheets W2 - W5 for Retaining Wall Details.
  - See Sheets S1 - S9 for Keller Springs Road Bridge Details.
  - See the following Sheets for Storm Sewer Profiles:
 

Line	Sheet
B1	R51
B2	R52
C, C1	R53
  - For Shoulder and Median Barrier Details See Typical Sections.

**ASBUILT PLANS**

NO.	REVISION	BY	DATE
1	Revise Ramps	GMG	7-01-86
2	Added Conduit	JTK	2-19-86
3	Storm Sewer Line H-2 Redesigned	MGB	2-7-85

**TEXAS TURNPIKE AUTHORITY**  
**DALLAS NORTH TOLLWAY**

PAVING AND GRADING  
TOLLWAY  
STA 662+00 TO STA 674+00


**Gibbs & Hill, Inc.**  
ENGINEERS DESIGNERS CONSTRUCTORS  
DALLAS

**SECTION VII**

DRAWN	VER	DATE	7/8/83	DESIGNED	DWC	DATE	6/30/83
CHECKED	DWC	DATE	5/2/84	SCALE	1"=50' Hor. 1"=5' Vert.		

CONTRACT NO. DNT-115 SHEET R18 OF R85



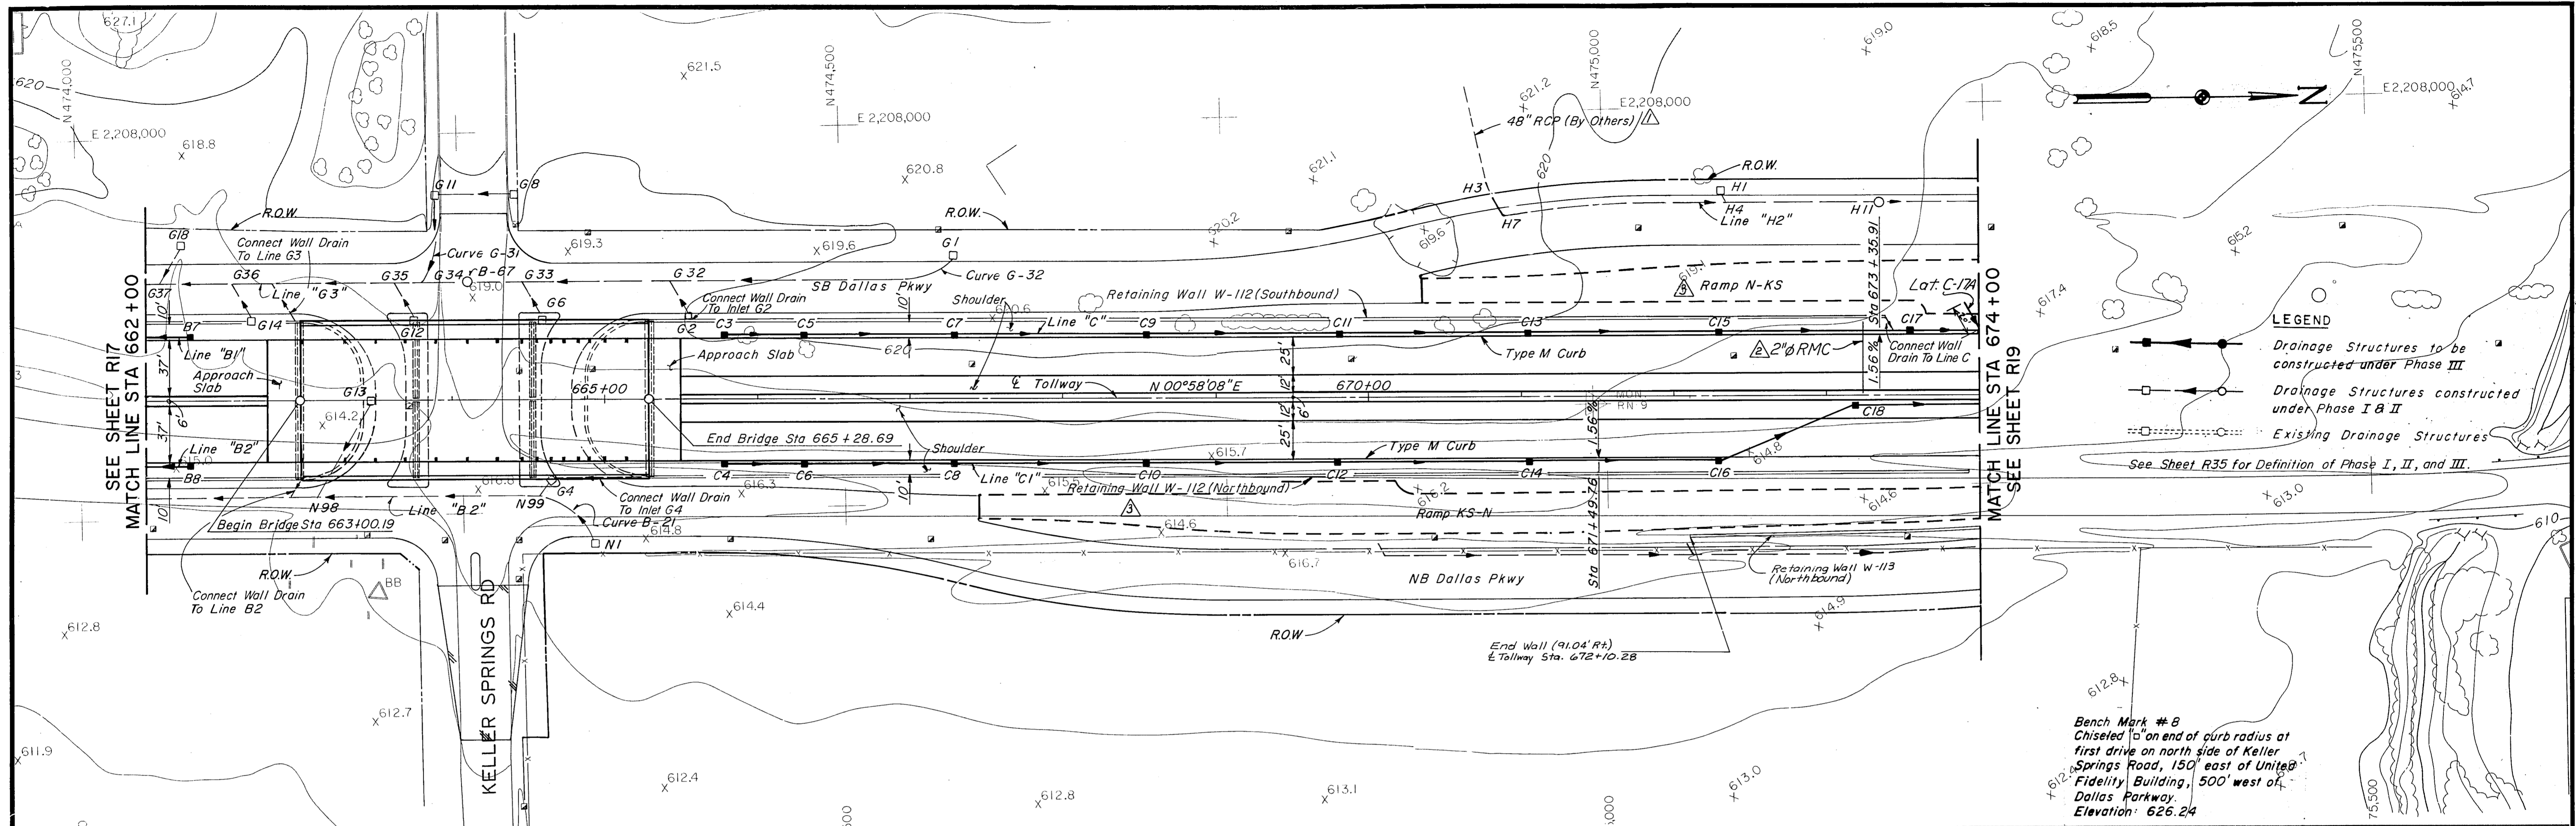


**LEGEND**

- Drainage Structures to be constructed under Phase III
- Drainage Structures constructed under Phase I & II
- ⋯ Existing Drainage Structures

See Sheet R35 for Definition of Phase I, II, and III.

Bench Mark #8  
Chiseled 15' on end of curb radius at first drive on north side of Keller Springs Road, 150' east of United Fidelity Building, 500' west of Dallas Parkway.  
Elevation: 626.24

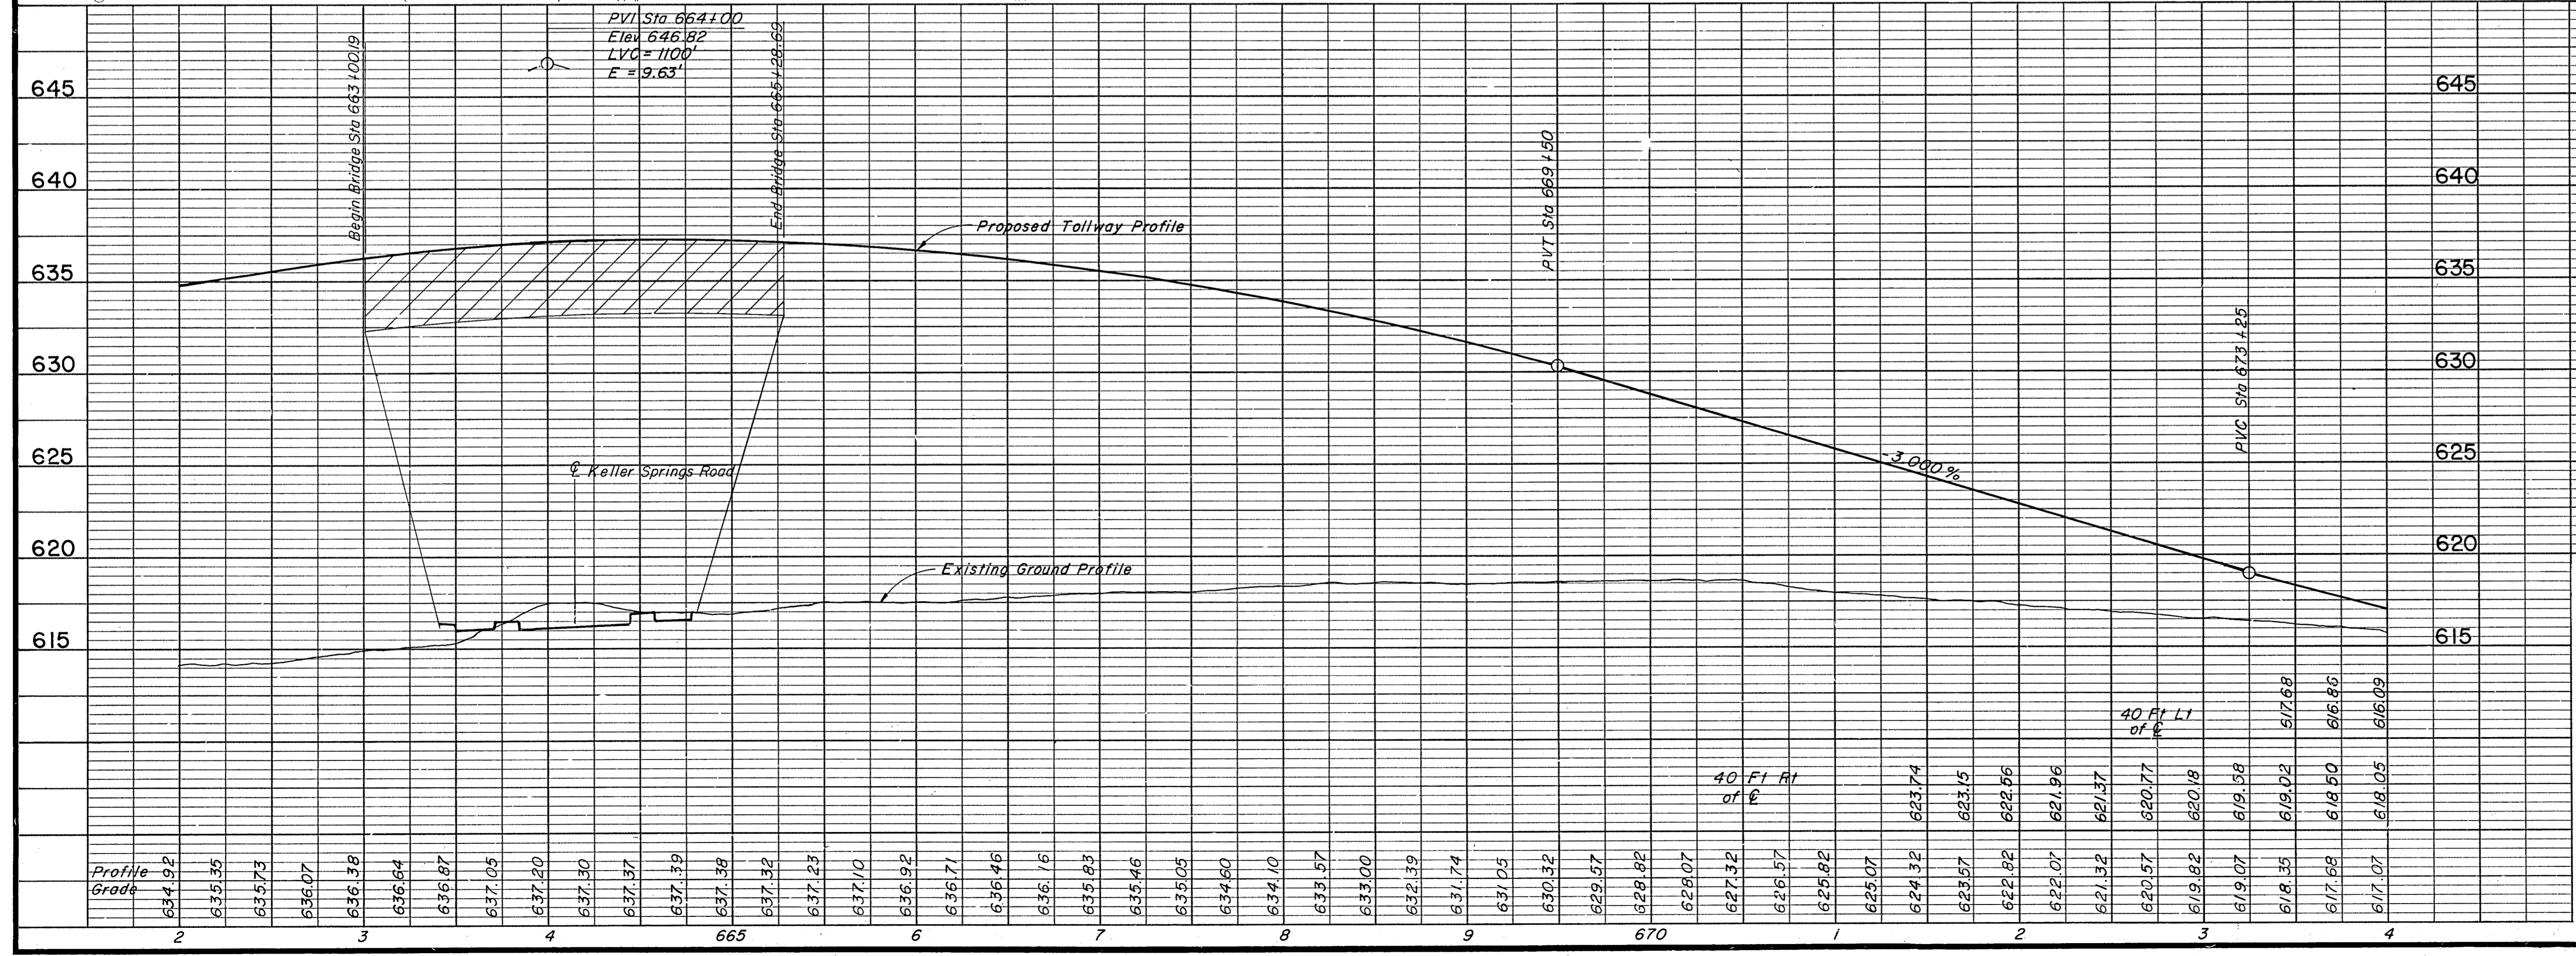

- Notes:**
1. See Sheet R2 for Dallas Parkway Plan & Profile for Removals.
  2. See Sheets W2 - W5 for Retaining Wall Details.
  3. See Sheets S1 - S9 for Keller Springs Road Bridge Details.
  4. See the following Sheets for Storm Sewer Profiles:  

Line	Sheet
B1	R51
B2	R52
C, C1	R53
  5. For Shoulder and Median Barrier Details See Typical Sections.

**ASBUILT PLANS**

△	Revise Ramps	GMG	7-01-86
△	Added Conduit	JTK	2-19-86
△	Storm Sewer Line H-2 Redesigned	MGB	2-7-85
NO.	REVISION	BY	DATE

**TEXAS TURNPIKE AUTHORITY**  
**DALLAS NORTH TOLLWAY**

PAVING AND GRADING  
TOLLWAY  
STA 662+00 TO STA 674+00


**Gibbs & Hill, Inc.**  
ENGINEERS DESIGNERS CONSTRUCTORS DALLAS

**SECTION VII**

DRAWN	VER	DATE	7/8/83	DESIGNED	DWC	DATE	6/30/83
CHECKED	DWC	DATE	5/2/84	SCALE	1"=50' Hor. 1"=5' Vert.		

**CONTRACT NO. DNT-115 SHEET R18 OF R85**



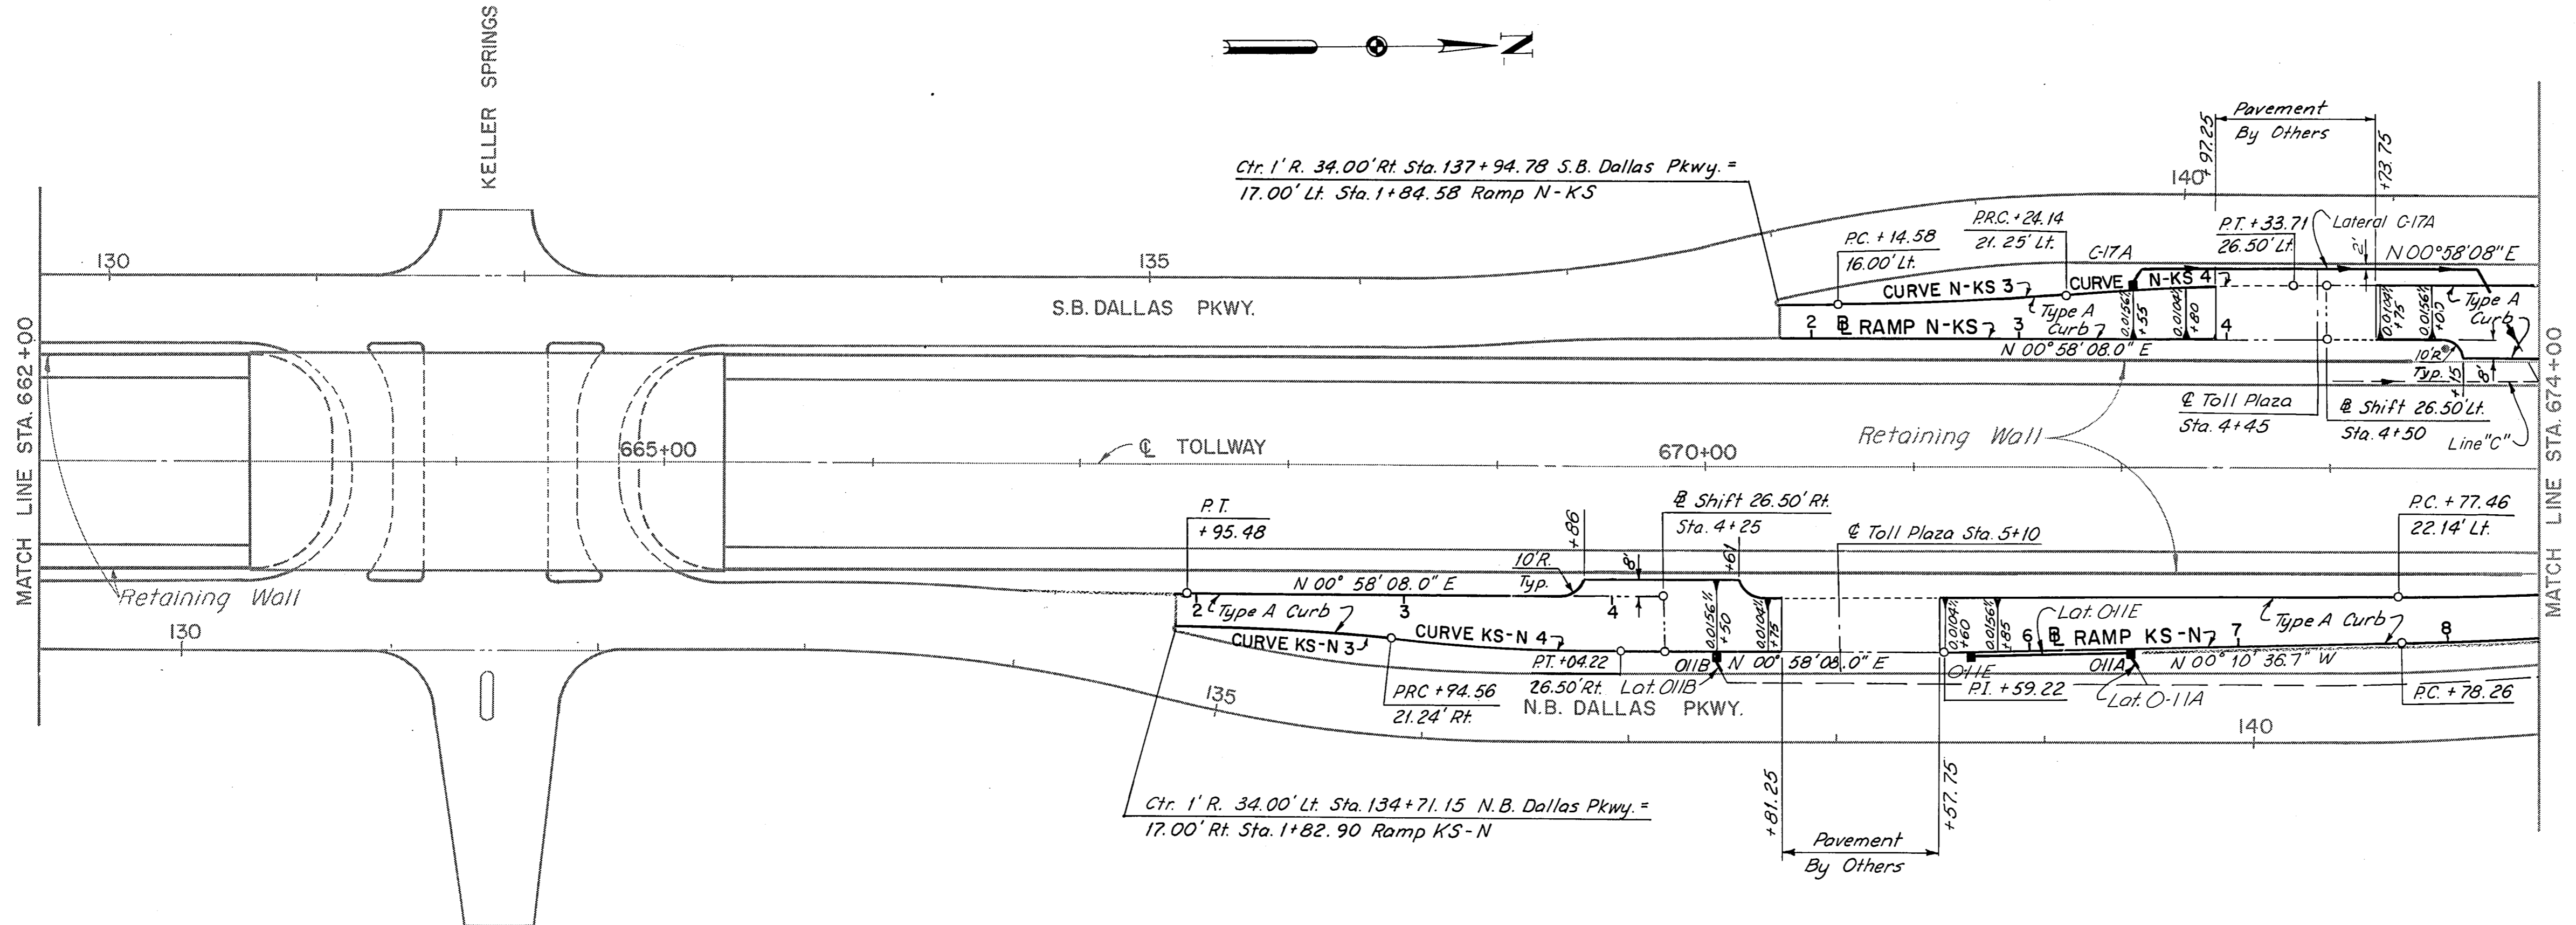


<b>CURVE N-KS3</b>	<b>CURVE N-KS4</b>
PI. —	PI. —
N 474,961.342	N 475,070.820
E 2,208,108.305	E 2,208,099.654
$\Delta = 5^\circ 29' 12''$	$\Delta = 5^\circ 29' 12''$
D = 5'00'00"	D = 5'00'00"
R = 1,145.92'	R = 1,145.92'
T = 54.91'	T = 54.91'
L = 109.74'	L = 109.74'

<b>CURVE KS-N3</b>	<b>CURVE KS-N4</b>
PI. —	PI. —
N 474,638.776	N 474,746.026
E 2,208,259.043	E 2,208,271.188
$\Delta = 5^\circ 17' 39''$	$\Delta = 5^\circ 29' 29''$
D = 5'00'00"	D = 5'00'00"
R = 1,145.92'	R = 1,145.92'
T = 52.98'	T = 54.96'
L = 105.88'	L = 109.83'

**NOTE:**  
Roadway Contractor shall provide dowels and dowel baskets for the expansion joints at the toll plaza leave-out and the Toll Plaza Contractor may be required to install them.



Bench Mark #8  
Chiseled "I" on end of curb radius at first drive on north side of Keller Springs Road, 150' east of United Fidelity Building, 500' west of Dallas Parkway. Elev. 626.24

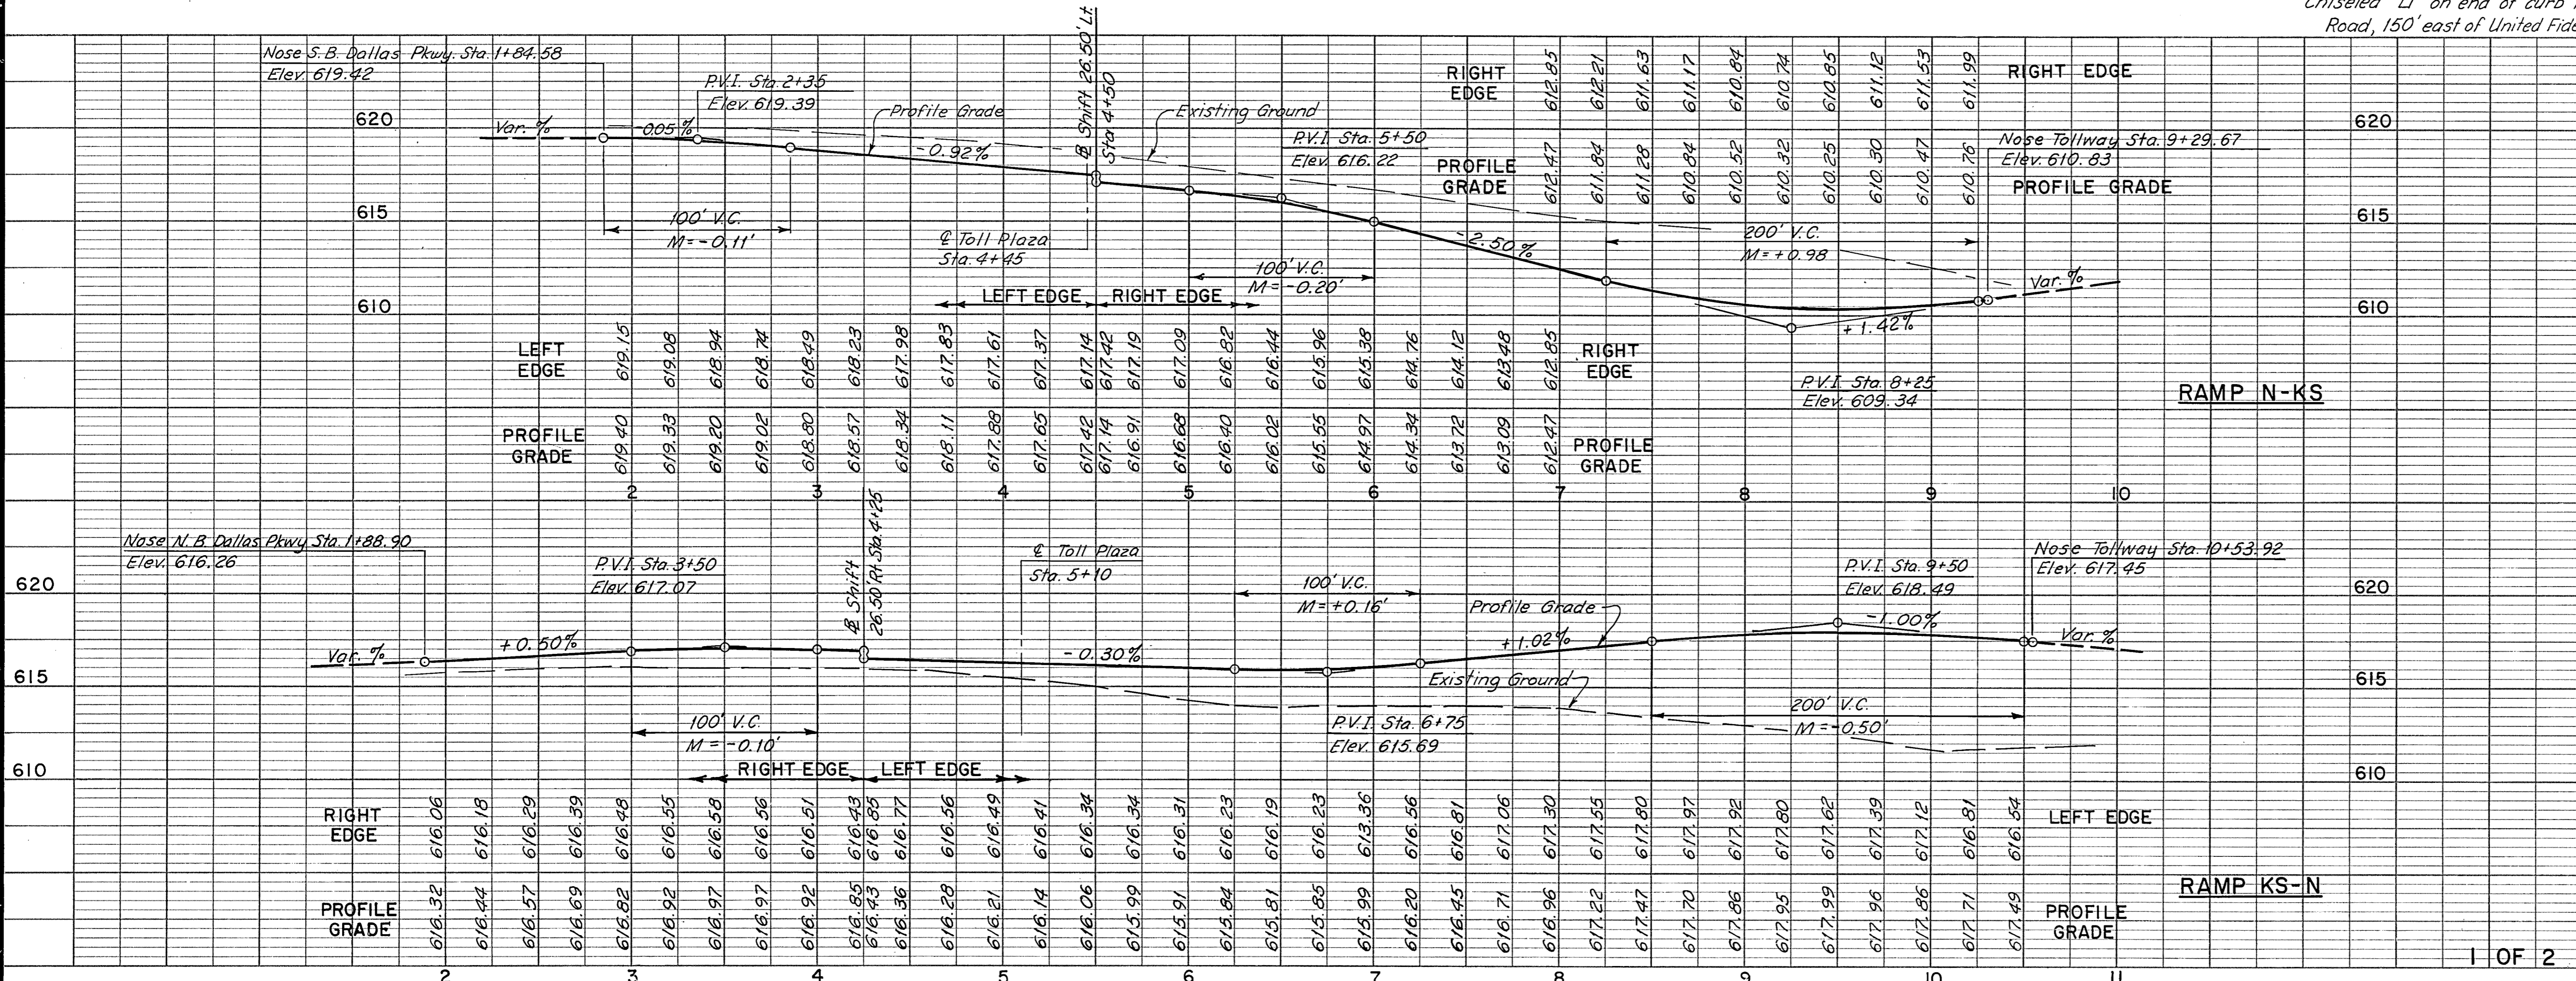

**ASBUILT PLANS**

NO.	REVISION	BY	DATE
TEXAS TURNPIKE AUTHORITY DALLAS NORTH TOLLWAY			
RAMP N-KS AND RAMP KS-N PAVING AND DRAINAGE			
<b>HNTB</b> HOWARD NEEDLES TAMMEN & BERGENDOFF			SECTION <u>III</u>
DRAWN	DATE	DESIGNED	DATE
GRB	6-13-86	GAL	5-27-86
CHECKED	DATE	SCALE	
JBR	6-20-86	1"=50'H; 1"=5'V	
CONTRACT NO. <u>DNT-115</u> SHEET <u>R18A</u> OF <u>R85</u>			



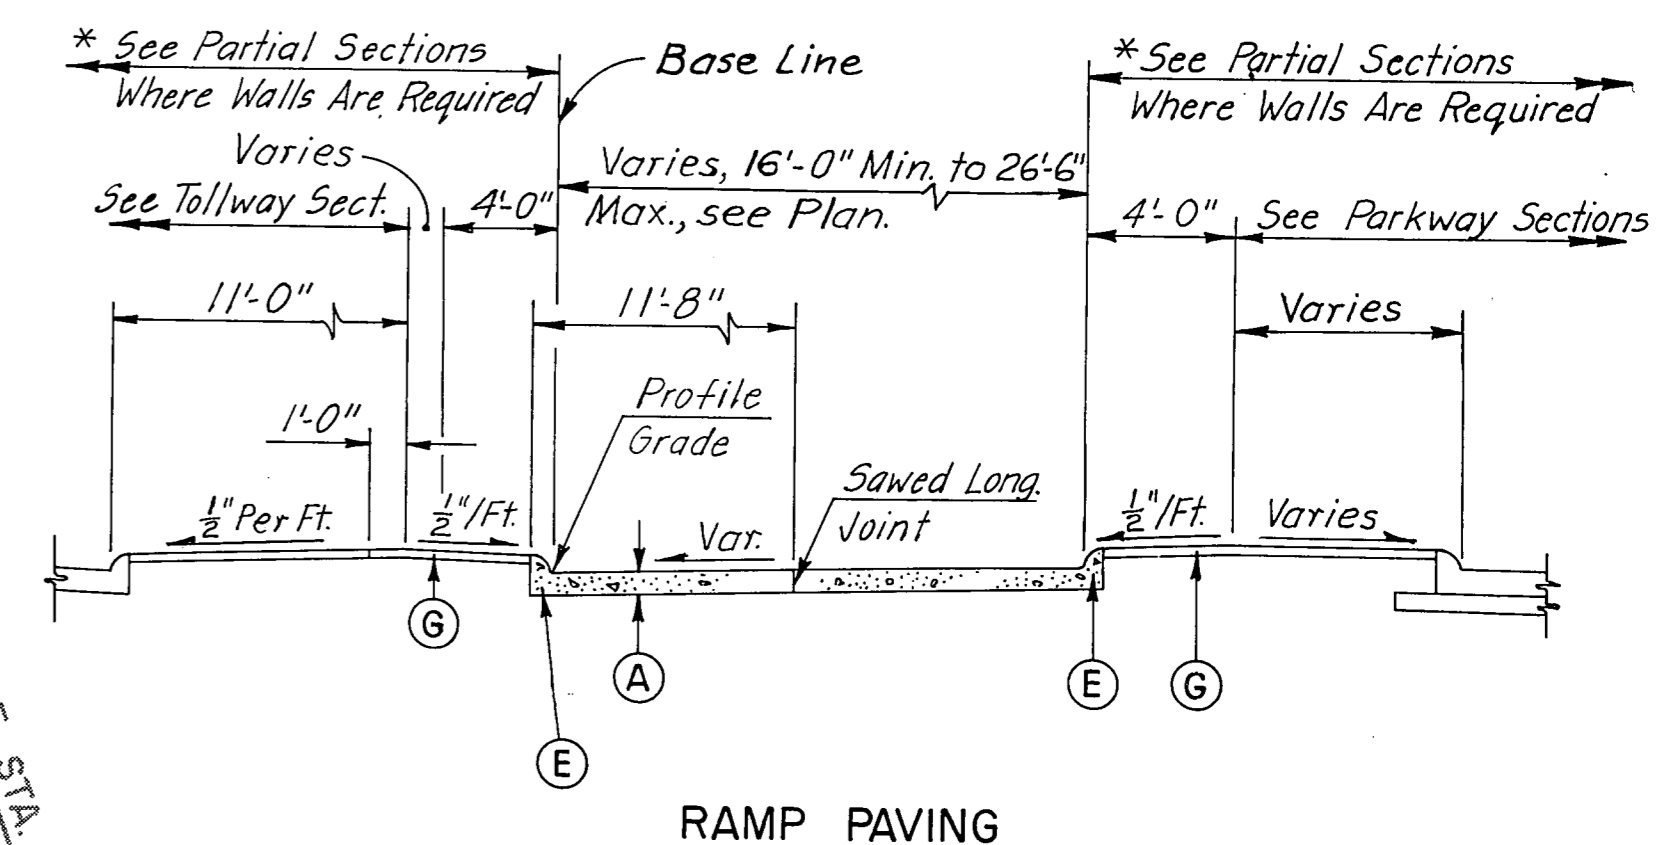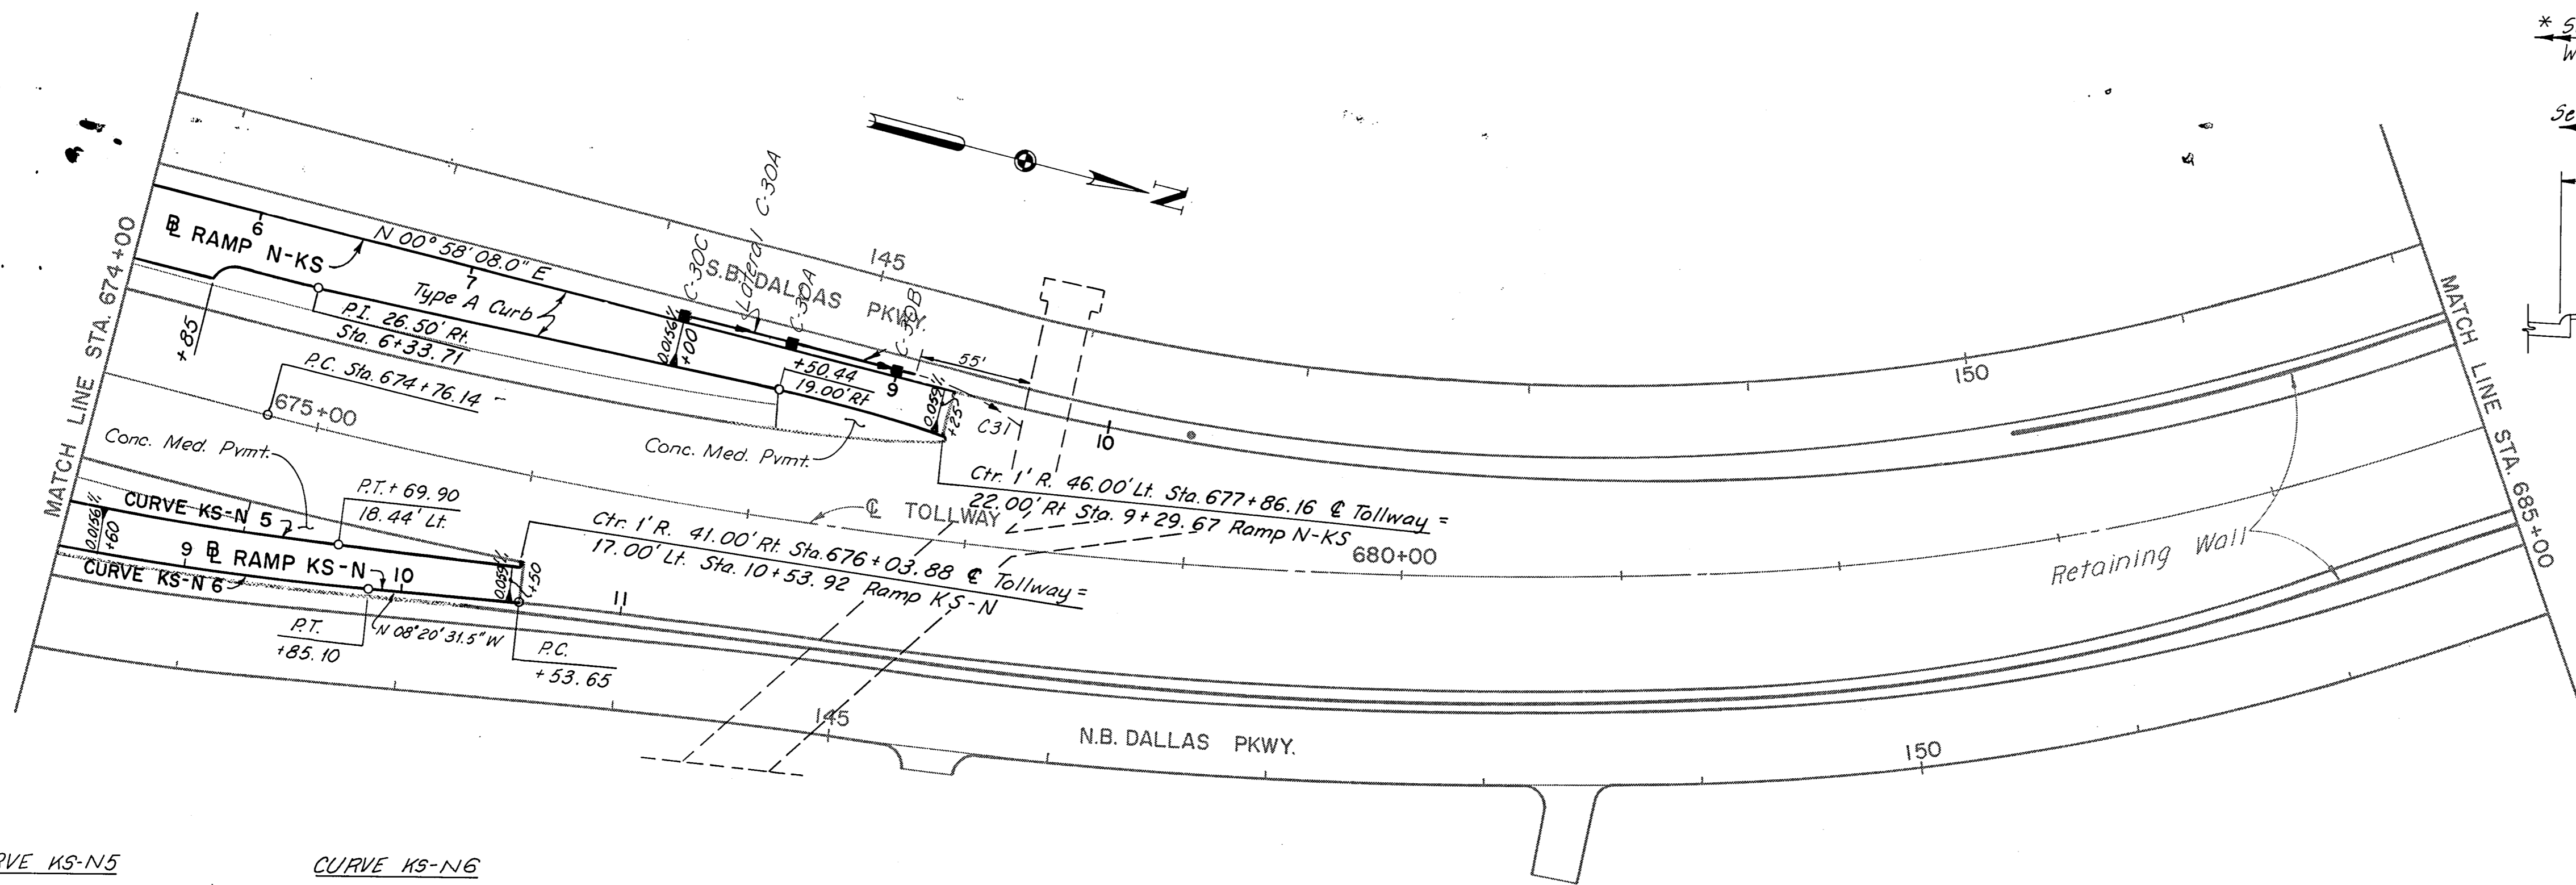


- RAMP PAVING**
- LEGEND**
- (A) Concrete Pavement (Water Cement Ratio) 10"
  - (E) Monolithic Curb (Type A) 6"
  - (G) 4" Topsoil & Broadcast Seeding (Type 4)

Note \*  
For "Partial Section for Retaining Wall" and additional information, see "Typical Sections" Sheets No. R1 and R2.

CURVE KS-N5		CURVE KS-N6	
PI.		PI.	3+81.86
N.	475, 174.127	N.	475, 278.589
E.	2,208, 251.924	E.	2,208, 273.742
D =	7°35'31"	D =	8°09'55"
D =	4°00'00"	D =	3°56'52"
R =	1,432.39'	R =	1,451.39'
T =	95.04'	T =	103.60'
L =	189.80'	L =	206.84'

Bench Mark #9  
Chiseled "I" on northeast corner of 2nd inlet on south side of Westgrove Drive, 500' west of Dallas Parkway. Elev. 620.80

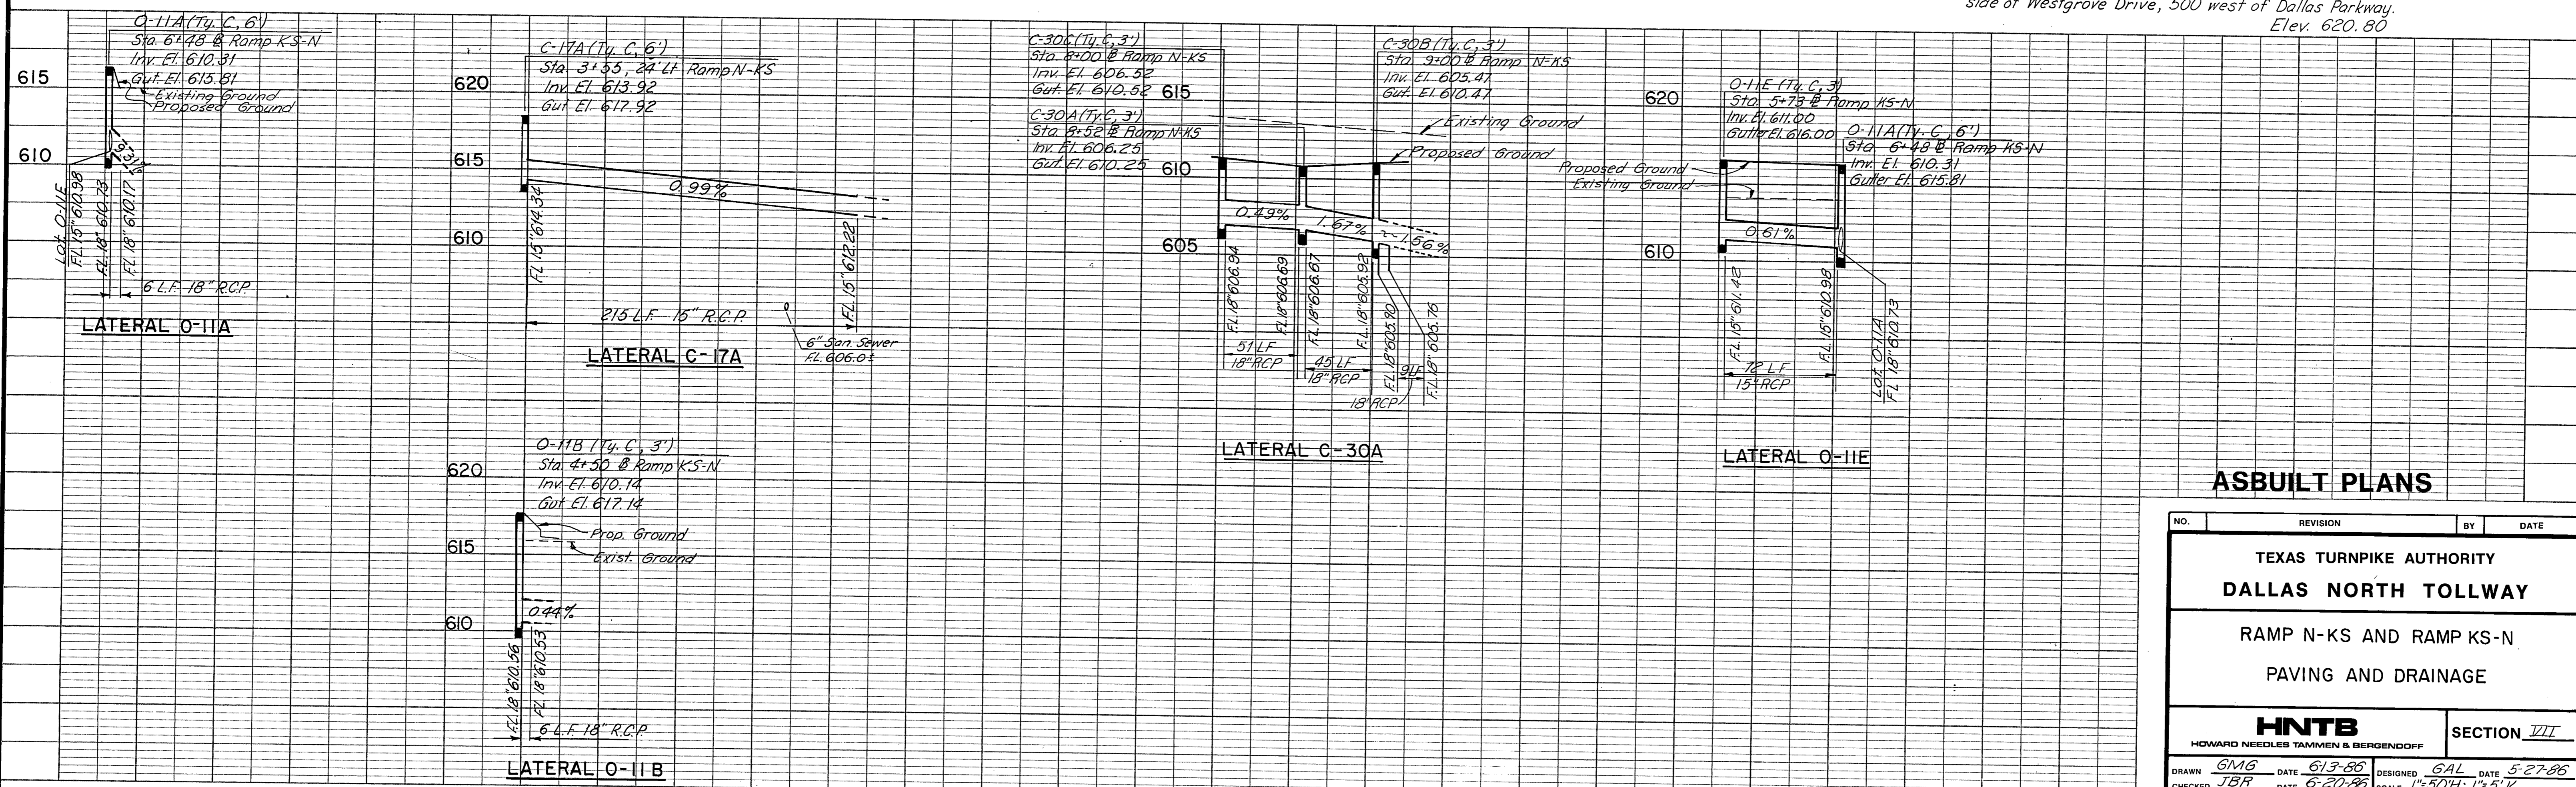

**ASBUILT PLANS**

NO.	REVISION	BY	DATE
TEXAS TURNPIKE AUTHORITY <b>DALLAS NORTH TOLLWAY</b> RAMP N-KS AND RAMP KS-N PAVING AND DRAINAGE			
<b>HNTB</b> <small>HOWARD NEEDLES TAMMEN &amp; BERGENDOFF</small>		SECTION VII	
DRAWN	GMB	DATE	6-13-86
CHECKED	IBR	DATE	6-20-86
DESIGNED	GAL	DATE	5-27-86
SCALE	1"=50H; 1"=5V		
CONTRACT NO. DNT-115 SHEET R18B OF R85			



Curve KS-N7  
PI Sta 10 + 6477.7  
N 475479.702  
E 2208244.252  
Δ = 2°30'17"  
D = 4°01'30"  
R = 1423.54'  
T = 31.12'  
L = 62.23'

Curve KS-N8  
PI Sta 14 + 0149  
N 475794.785  
E 2208212.039  
Δ = 2°26'40"  
D = 2343.83'  
T = 201.30'  
L = 401.61'

Curve KS-N9  
PI Sta 17 + 136.47  
N 476118.291  
E 2208121.382  
Δ = 16°36'33"  
D = 6°12'37"  
R = 922.61'  
T = 134.67'  
L = 267.45'

Curve T 2A  
PI Sta 678 + 10.96  
N 475652.180  
E 2208198.000  
Δ = 16°37'26"  
D = 2°30'00"  
R = 2291.83'  
T = 334.83'  
L = 664.95'


Curve T 2B  
PI Sta 682 + 76.95  
N 476105.410  
E 2208070.988  
Δ = 13°31'23"  
D = 3°00'00"  
R = 1145.92'  
T = 135.86'  
L = 270.46'

Curve N-KS7  
PI Sta 10 + 02.85  
N 475694.783  
E 2208110.207  
Δ = 6°46'28"  
D = 5°03'46"  
R = 1131.70'  
T = 66.98'  
L = 133.81'

Curve N-KS8  
PI Sta 12 + 54.21  
N 475945.009  
E 2208084.765  
Δ = 16°37'13"  
D = 04832.06"  
R = 1263.38'  
T = 184.53'  
L = 366.48'

Storm Sewer Curve H-23  
PI Sta 677 + 91.50, 74.00' Lt  
Δ = 29°22'01"  
D = 85°30'58"  
R = 67.00'  
T = 17.56'  
L = 34.34'

Storm Sewer Curve C-31  
PI Sta 678 + 69.61, 64' Lt  
Δ = 21°23'15"  
D = 85°30'58"  
R = 67.00'  
T = 12.65'  
L = 25.01'

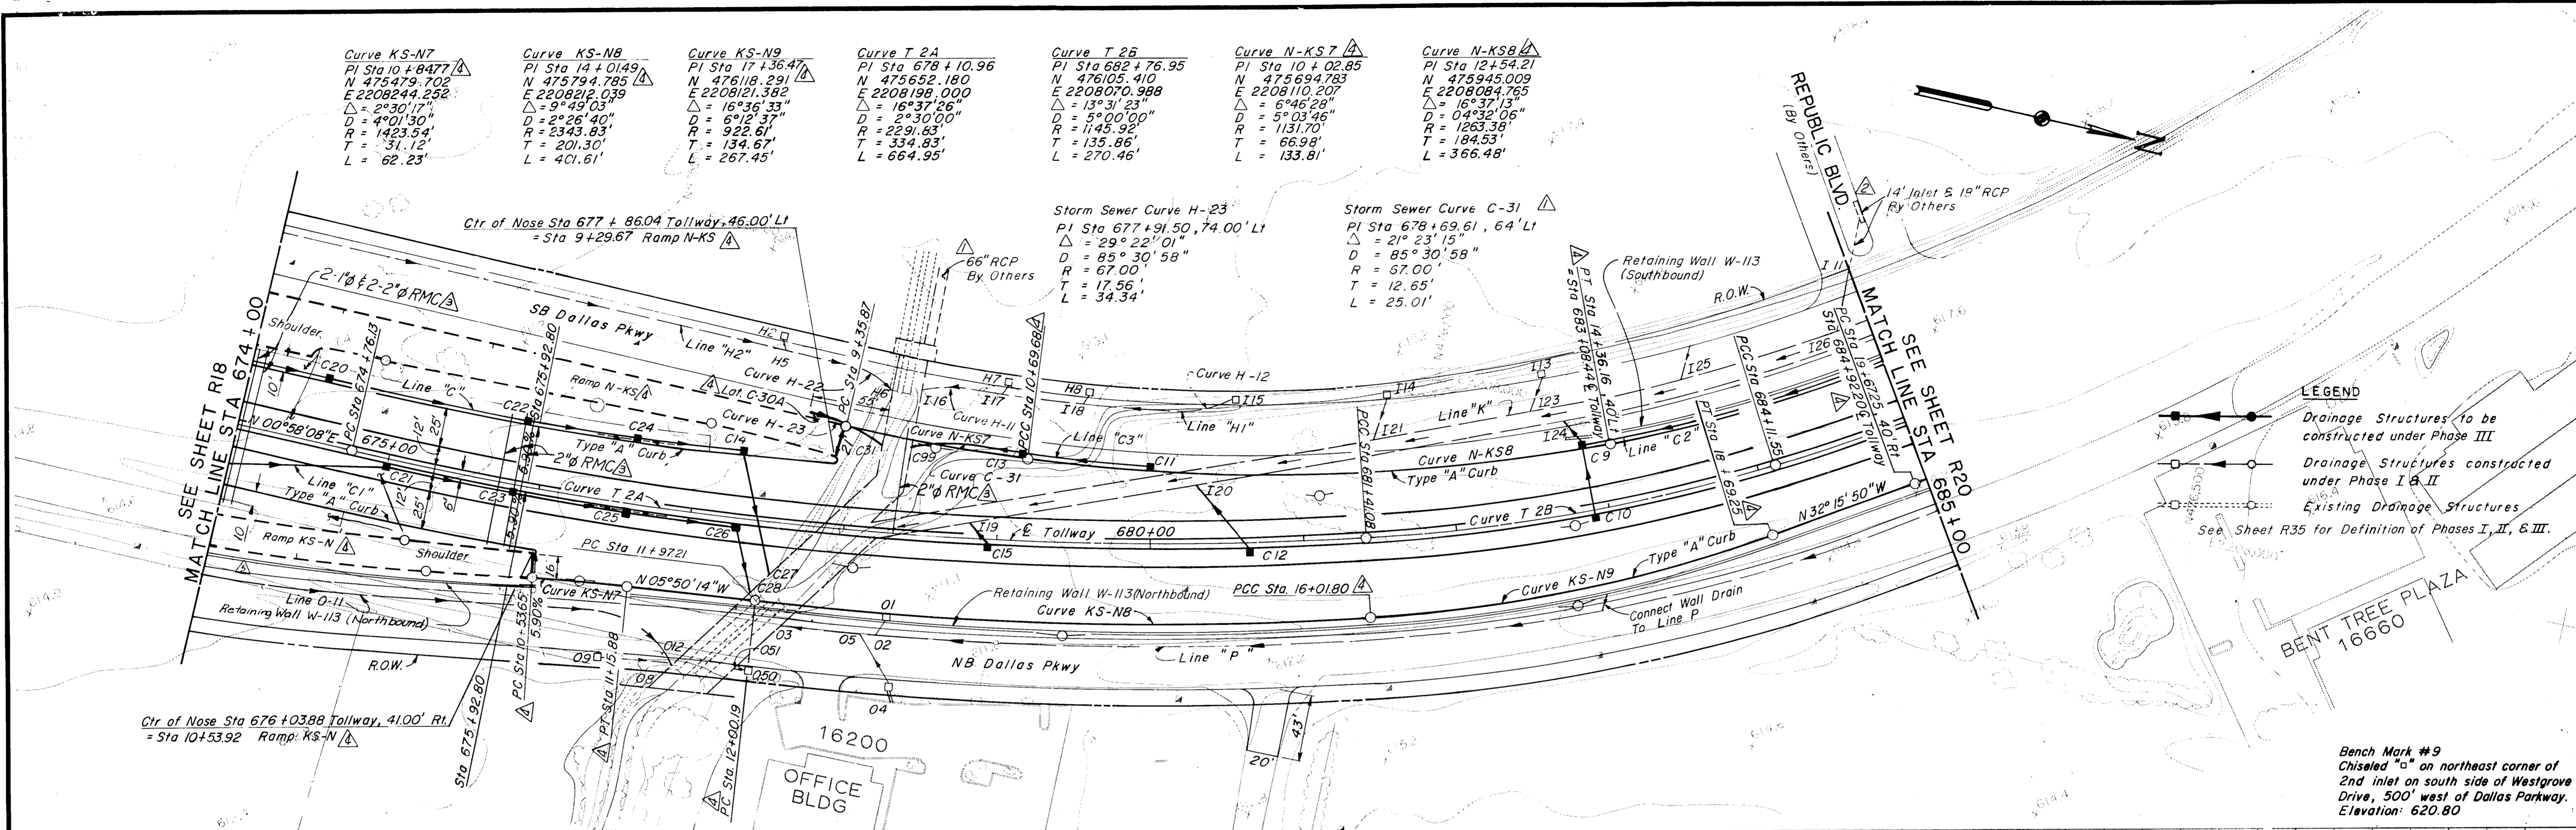


**LEGEND**

- Drainage Structures to be constructed under Phase III
- Drainage Structures constructed under Phase I & II
- Existing Drainage Structures

See Sheet R35 for Definition of Phases I, II, & III.

Bench Mark #9  
Chiseled "o" on northeast corner of 2nd inlet on south side of Westgrove Drive, 500' west of Dallas Parkway.  
Elevation: 620.80

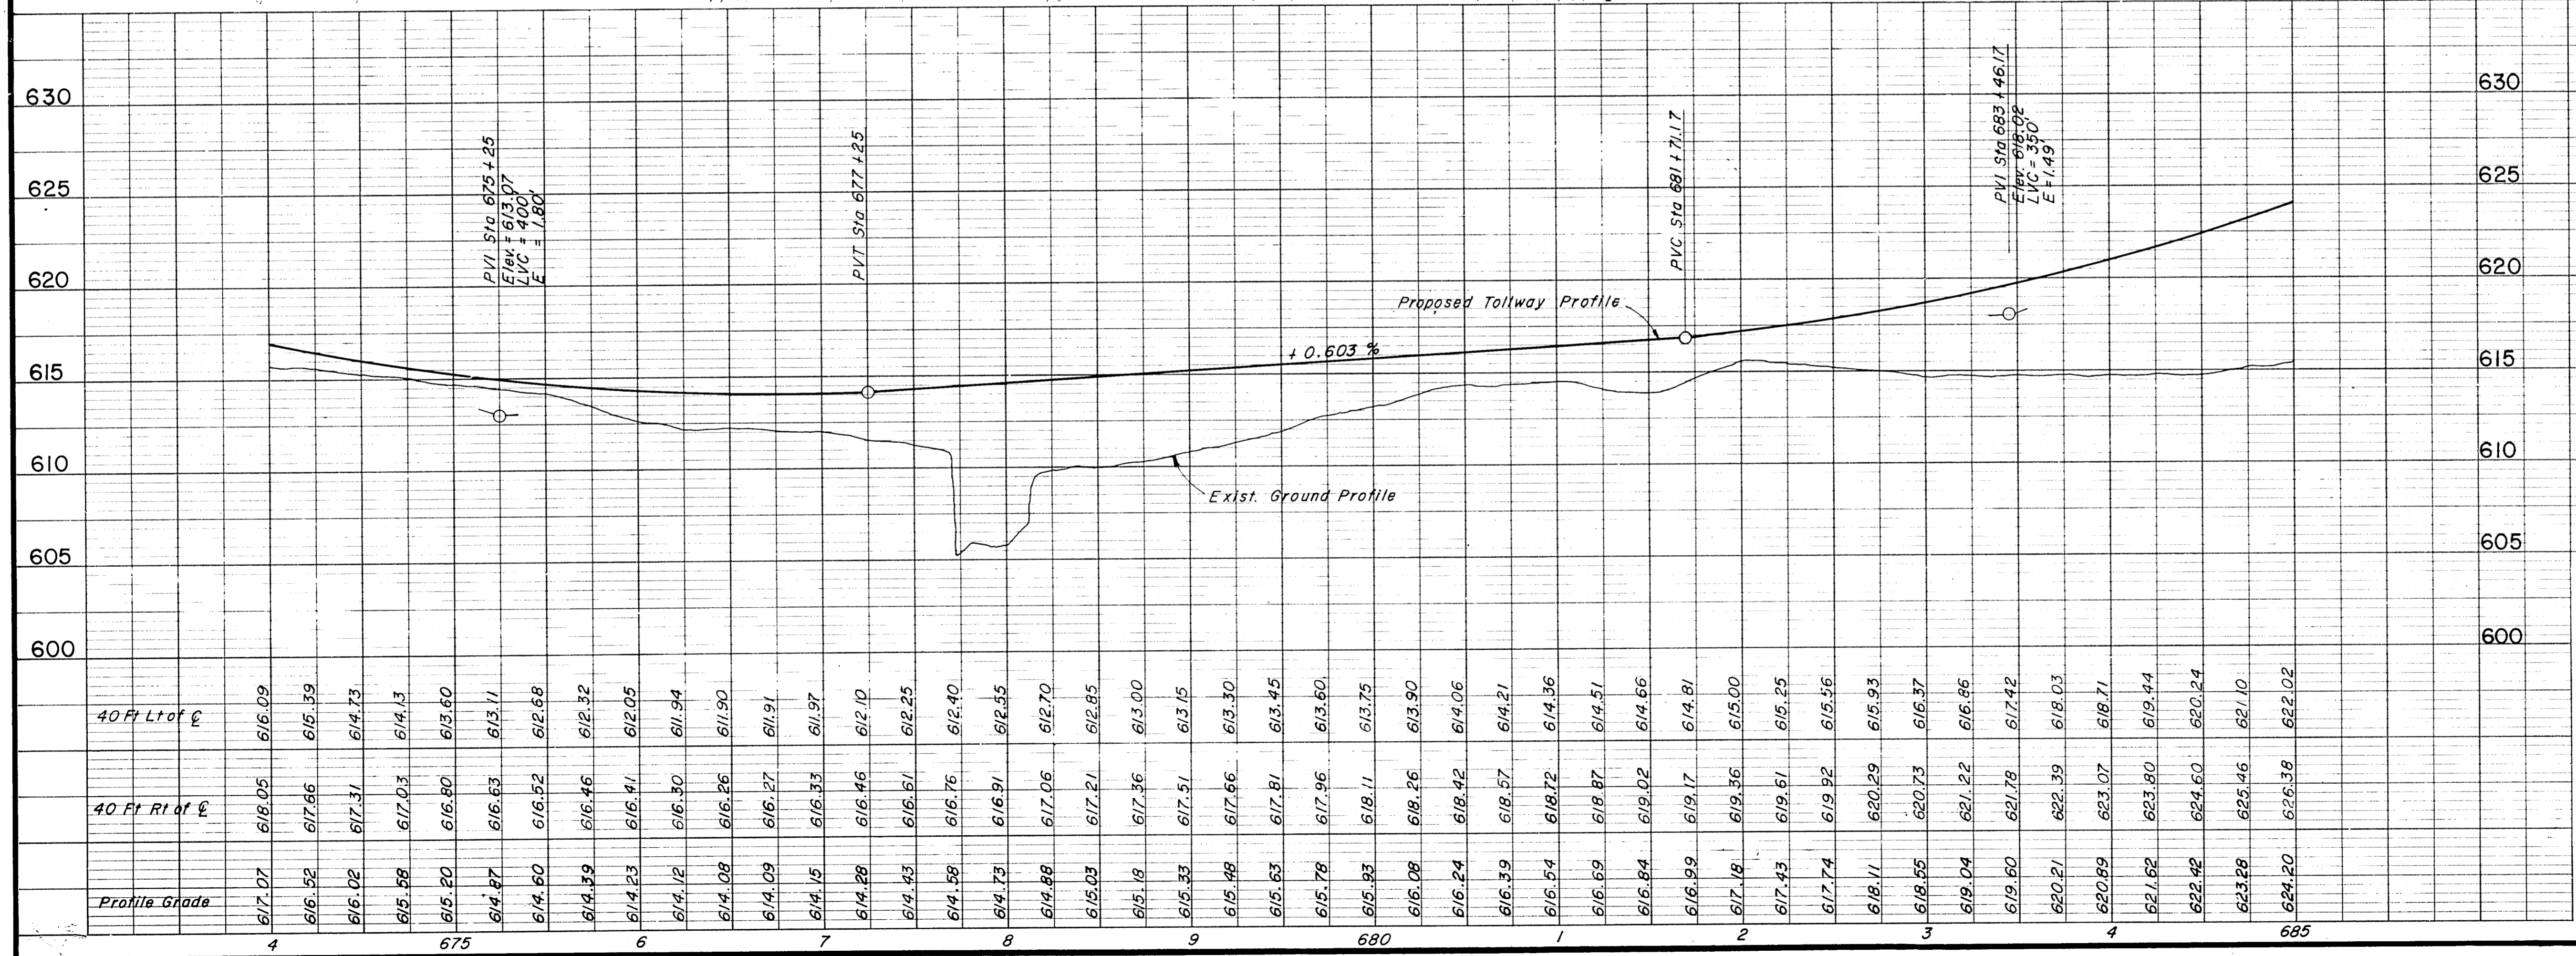

**NOTES:**

- See Sheet R9 for Dallas Parkway Plan & Profile for Removals.
- See Sheets R70 - R72 for Box Culvert Details.
- See Sheets R30 - R31 for Ramp Paving Plans.
- See the following Sheets for Storm Sewer Profiles:

Line	Sheet
C, C1	R 55
C3	R 56
K	R 38
C2	R 53

- See Sheets W6 - W8 for Reinforcing Wall Details.
- For Shoulder and Median Barrier Details See Typical Sections.

**ASBUILT PLANS**

Symbol	Description	By	Date
△	AsBuilt	PJ	3-8-88
△	Revise Ramps	GMO	7-1-86
△	Added Conduit	JTK	2-20-86
△	Replaced Inlet I-II with Inlet and Lateral By Others	MGB	2-7-85
△	Junction Box Widened and 2-10'x6' Conc Box Extended to Match	MGB	2-7-85

NO.	REVISION	BY	DATE

**TEXAS TURNPIKE AUTHORITY**  
**DALLAS NORTH TOLLWAY**

PAVING AND GRADING  
TOLLWAY  
STA 674+00 TO STA 685+00

**Gibbs & Hill, Inc.**  
ENGINEERS DESIGNERS CONSTRUCTORS  
DALLAS

**SECTION VII**

DRAWN	VER	DATE	9-14-83	DESIGNED	DWC	DATE	8-29-83
CHECKED	DWC	DATE	5-4-84	SCALE	1"=50' Hor 1"=5' Vert		

CONTRACT NO. DNT-115 SHEET R19 OF R85



Curve T 2C  
 PI Sta 686+59.28  
 N 476 440.332  
 E 2207883.975  
 $\Delta = 18^{\circ}45'22''$   
 $D = 3^{\circ}49'11''$   
 $R = 1500.00'$   
 $T = 247.73'$   
 $L = 491.04'$


16475

16479

BENT TREE TOWERS

SEE SHEET R19  
 MATCH LINE STA 685+00

SEE SHEET R21  
 MATCH LINE STA 697+00

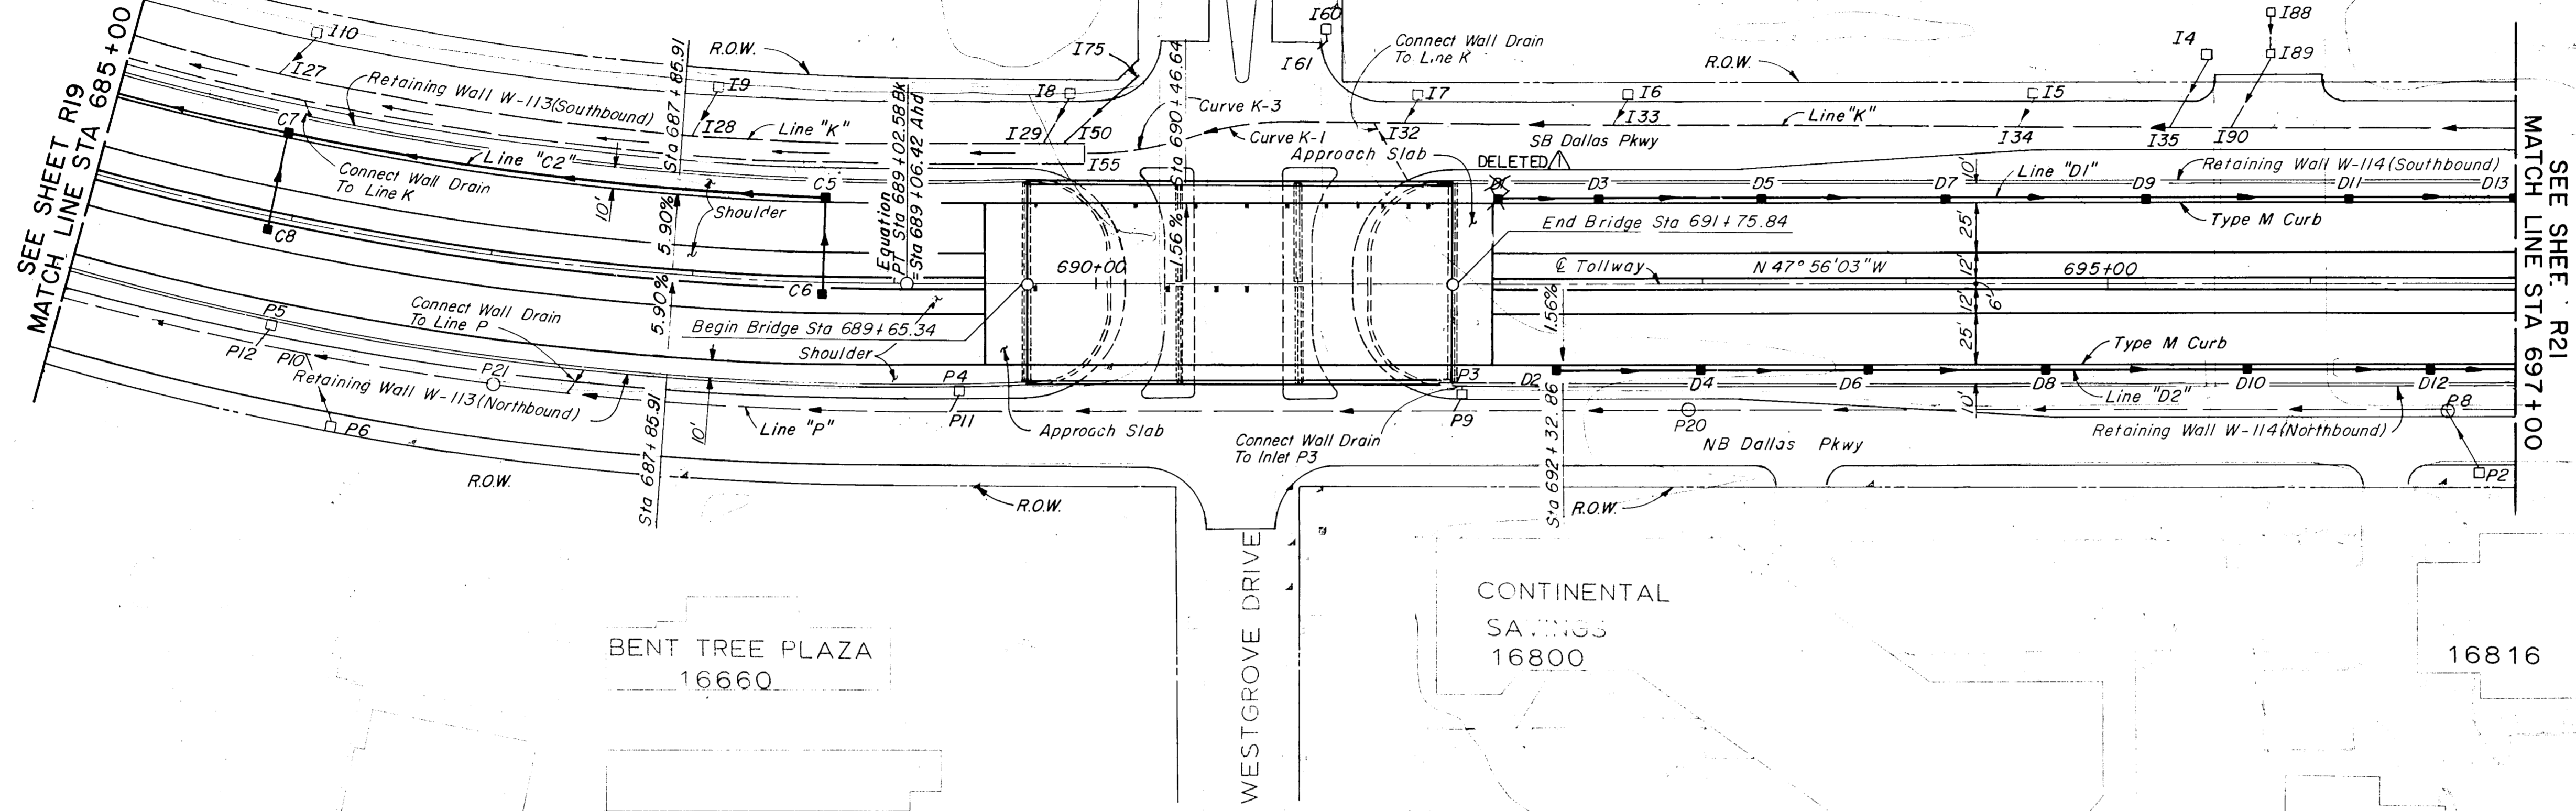


**LEGEND**

- Drainage Structures to be constructed under Phase III
- Drainage Structures constructed under Phase I & II
- Existing Drainage Structures

See Sheet R36 for Definition of Phase I, II, and III.

**RESEARCH** Bench Mark #9  
 Chiseled "a" on northeast corner of  
 2nd inlet on south side of Westgrove  
 Drive, 500' west of Dallas Parkway.  
 Elevation: 620.80

16910  
 16850

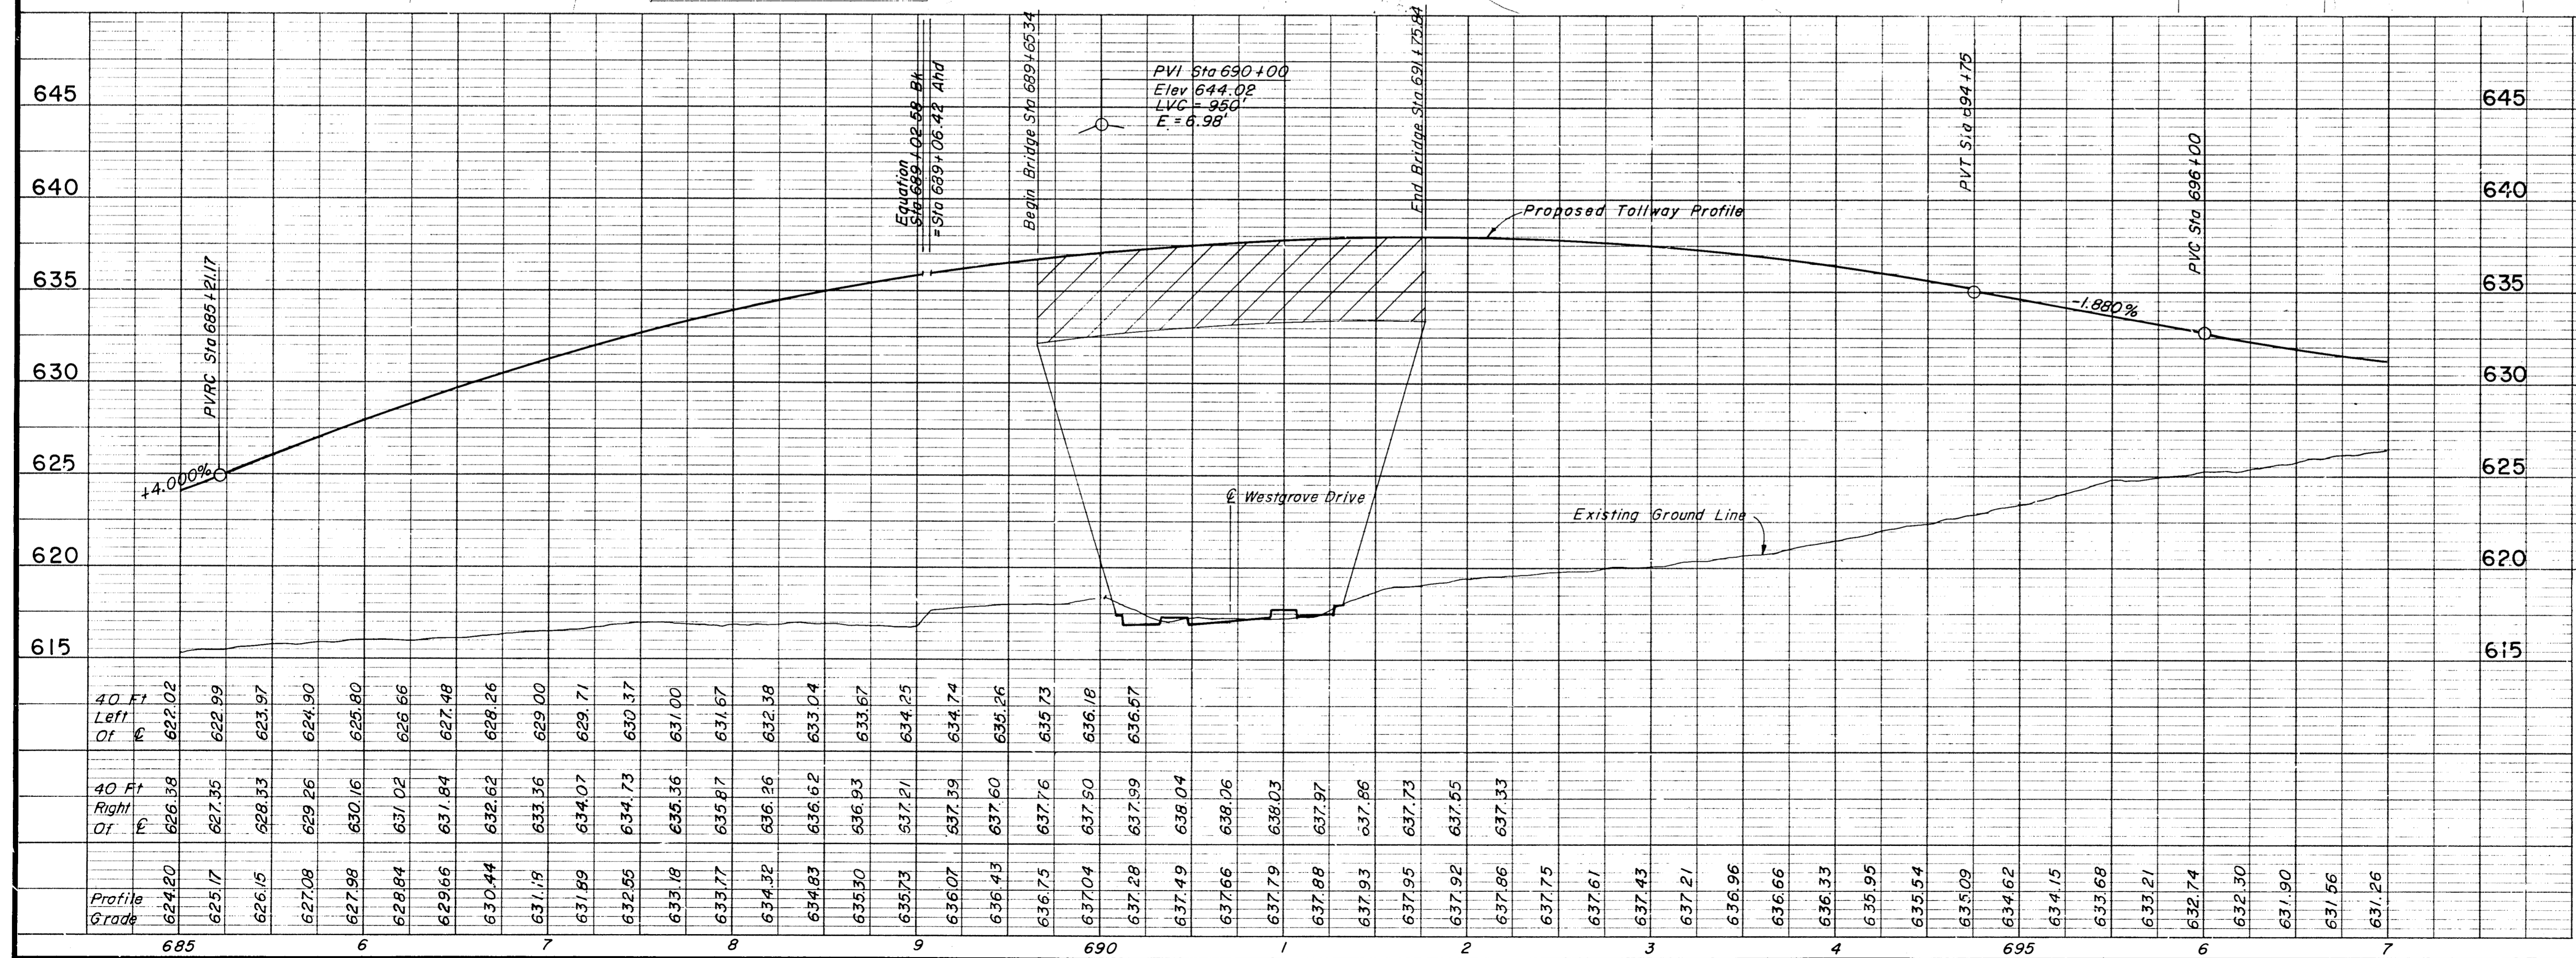

- NOTES:**
- See Sheet R10 for Dallas Parkway Plan & Profile for Removals.
  - See Sheet R32 for Paving Plan - Westgrove Drive.
  - See Sheets W6 - W10 for Retaining Wall Details.
  - See Sheets S10 - S20 for Westgrove Drive Bridge Details.
  - See the following Sheets for Storm Sewer Profiles:
- | Line   | Sheet |
|--------|-------|
| C2     | R 53  |
| D1, D2 | R 61  |
6. For Shoulder and Median Barrier Details See Typical Sections.

**ASBUILT PLANS**

AS BUILT PLANS		PJ	I-11-88
NO.	REVISION	BY	DATE

**TEXAS TURNPIKE AUTHORITY**  
**DALLAS NORTH TOLLWAY**  
 PAVING AND GRADING  
 TOLLWAY  
 STA 685+00 TO STA 697+00


**Gibbs & Hill, Inc.**  
 ENGINEERS DESIGNERS CONSTRUCTORS  
 DALLAS

**SECTION VII**

DRAWN	VER	DATE	7/8/83	DESIGNED	DWC	DATE	6/30/83
CHECKED	DWC	DATE	7/7/84	SCALE	1"=50' Hor. 1"=5' Vert.		

CONTRACT NO. DNT-115 SHEET R20 OF R85



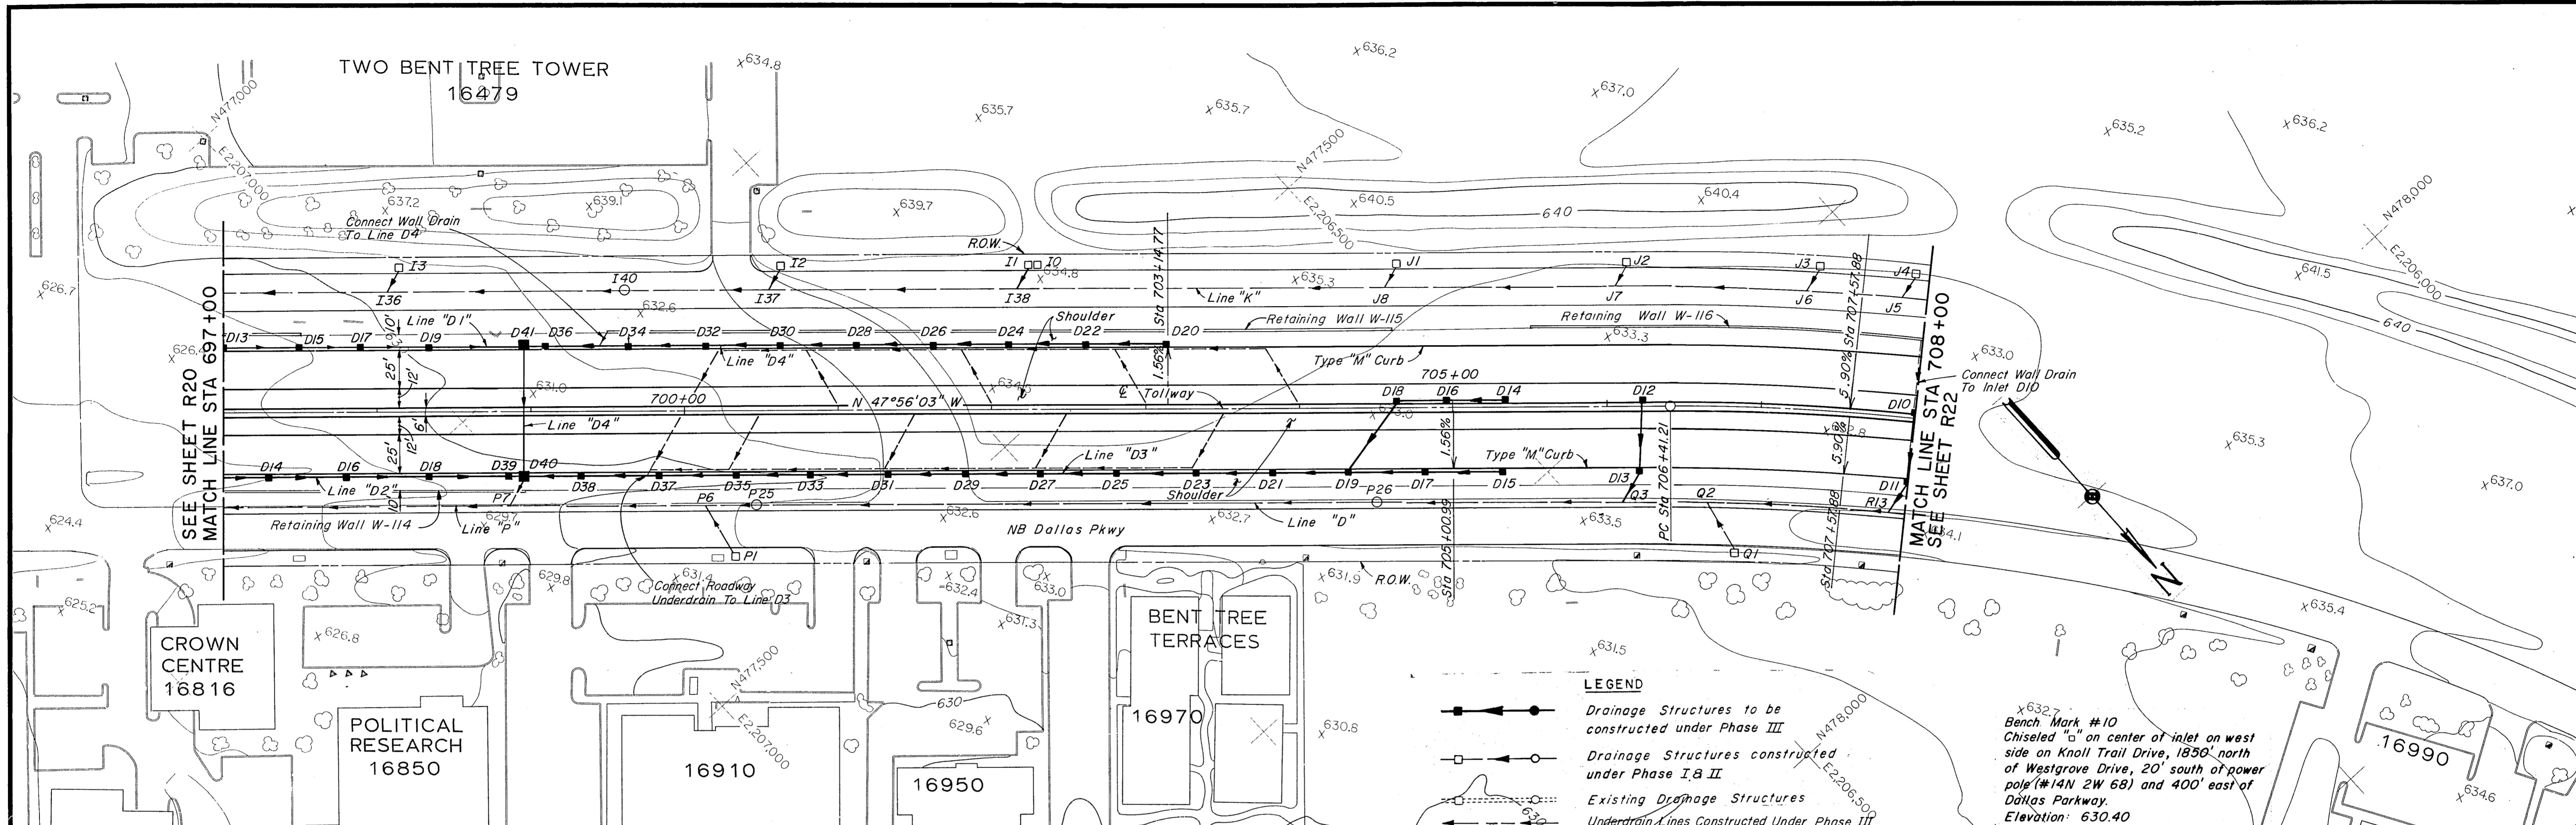


**LEGEND**

- Drainage Structures to be constructed under Phase III
- Drainage Structures constructed under Phase I & II
- Existing Drainage Structures
- Underdrain/Lines Constructed Under Phase III

See Sheet R36 for Definition of Phases I, II, & III.

Bench Mark #10  
Chiseled "a" on center of inlet on west side on Knoll Trail Drive, 1850' north of Westgrove Drive, 20' south of power pole (#14N 2W 68) and 400' east of Dallas Parkway.  
Elevation: 630.40

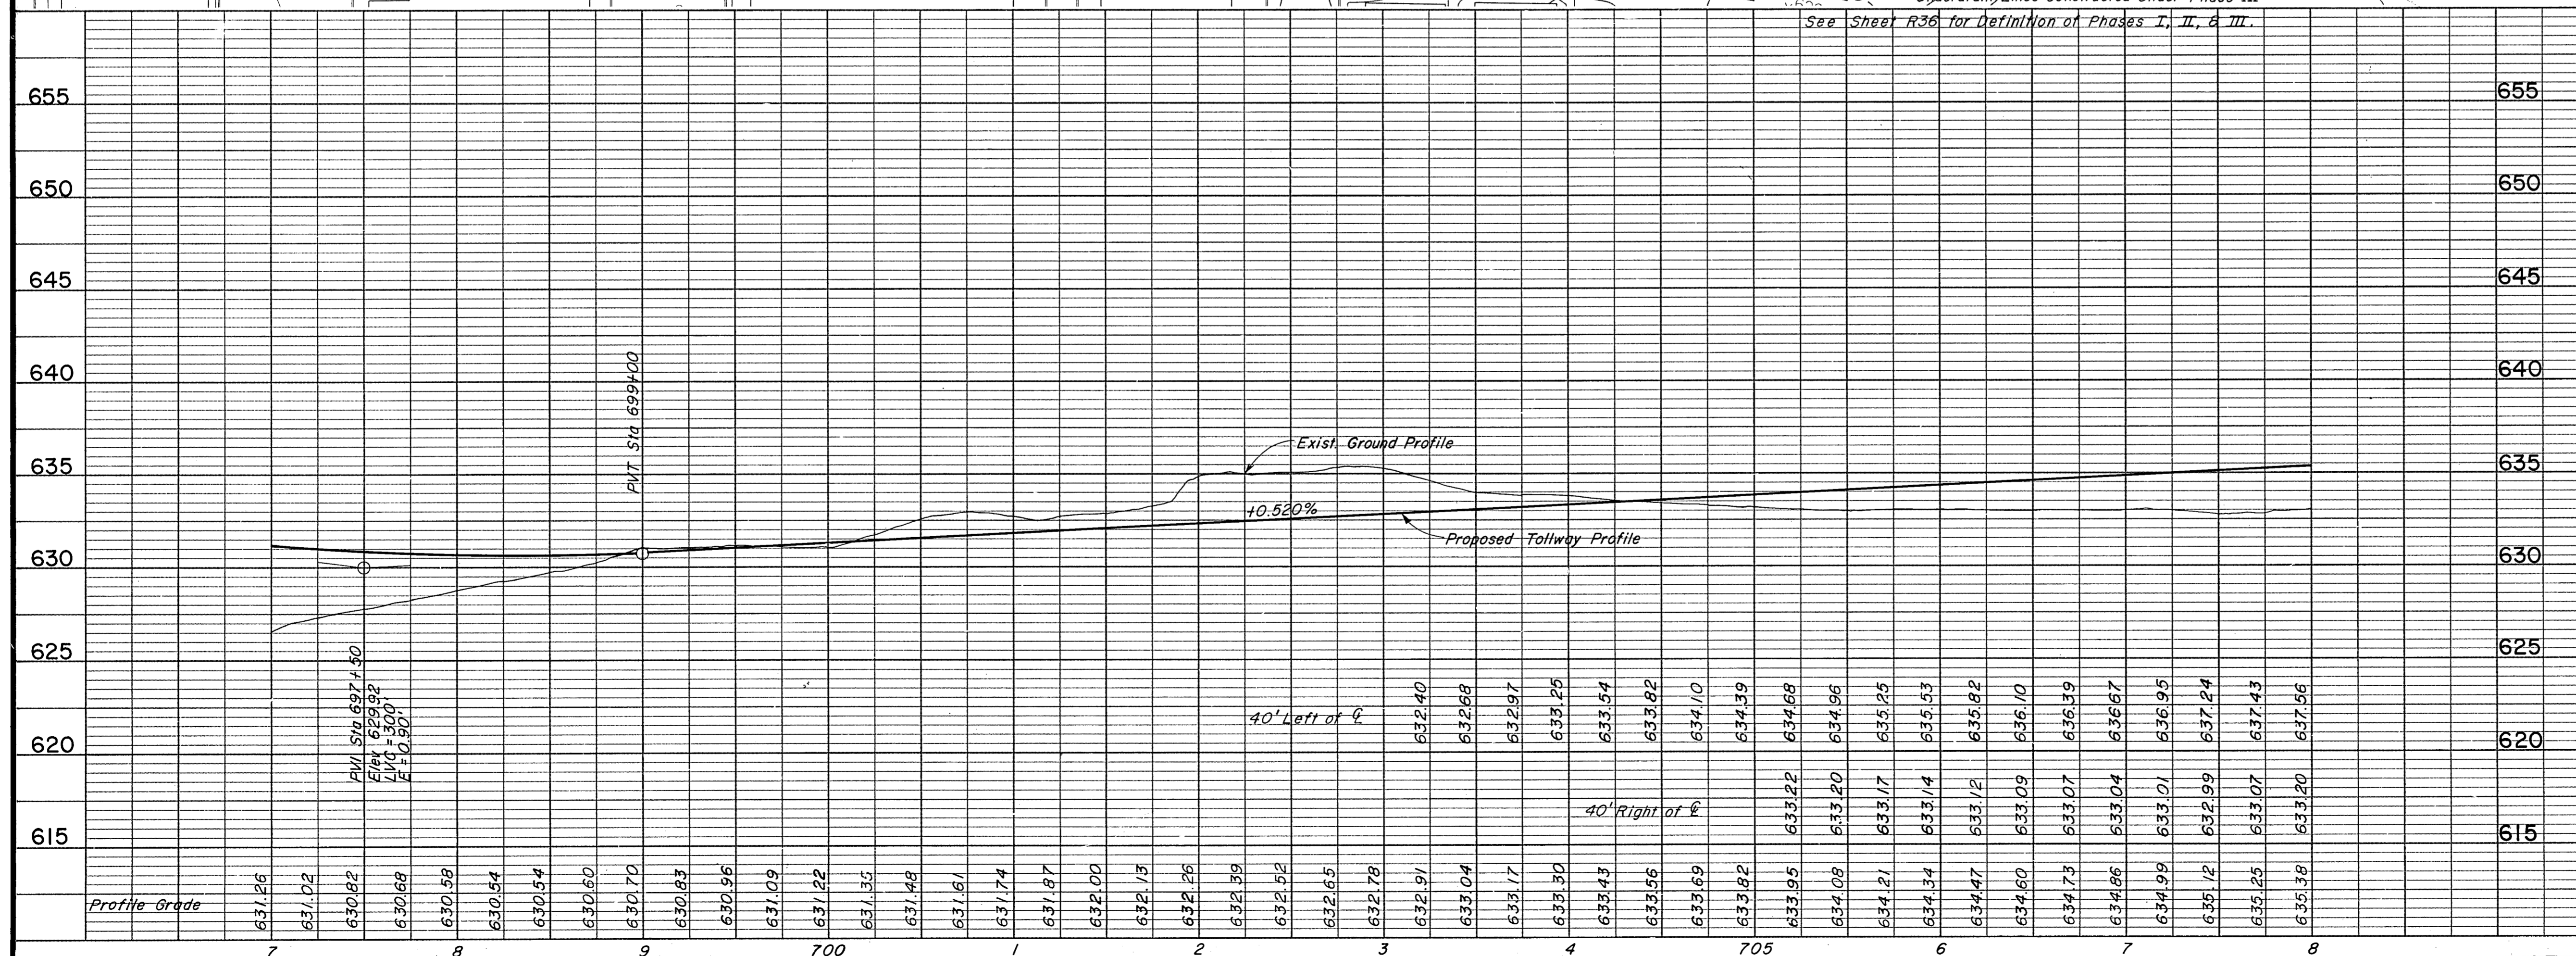


- NOTES:**
- See Sheet R11 for Dallas Parkway Plan & Profile for Removals.
  - See Sheets W11-W12 for Retaining Wall Details.
  - See Sheets R62-R63 for Storm Sewer Profiles.
  - For Shoulder and Median Barrier Details See Typical Sections.

**ASBUILT PLANS**

NO.	REVISION	BY	DATE
<b>TEXAS TURNPIKE AUTHORITY</b>			
<b>DALLAS NORTH TOLLWAY</b>			
PAVING AND GRADING TOLLWAY STA 697+00 TO STA 708+00			
<b>Gibbs &amp; Hill, Inc.</b> ENGINEERS DESIGNERS CONSTRUCTORS DALLAS			<b>SECTION VII</b>
DRAWN	VER	DATE	7/8/83
CHECKED	DWC	DATE	5/4/84
DESIGNED	DWC	DATE	6/30/83
SCALE	1"=50' Hor. 1"=5' Vert.		
CONTRACT NO. DNT-115 SHEET R21 OF R85			



TWO BENT TREE TOWER  
16479

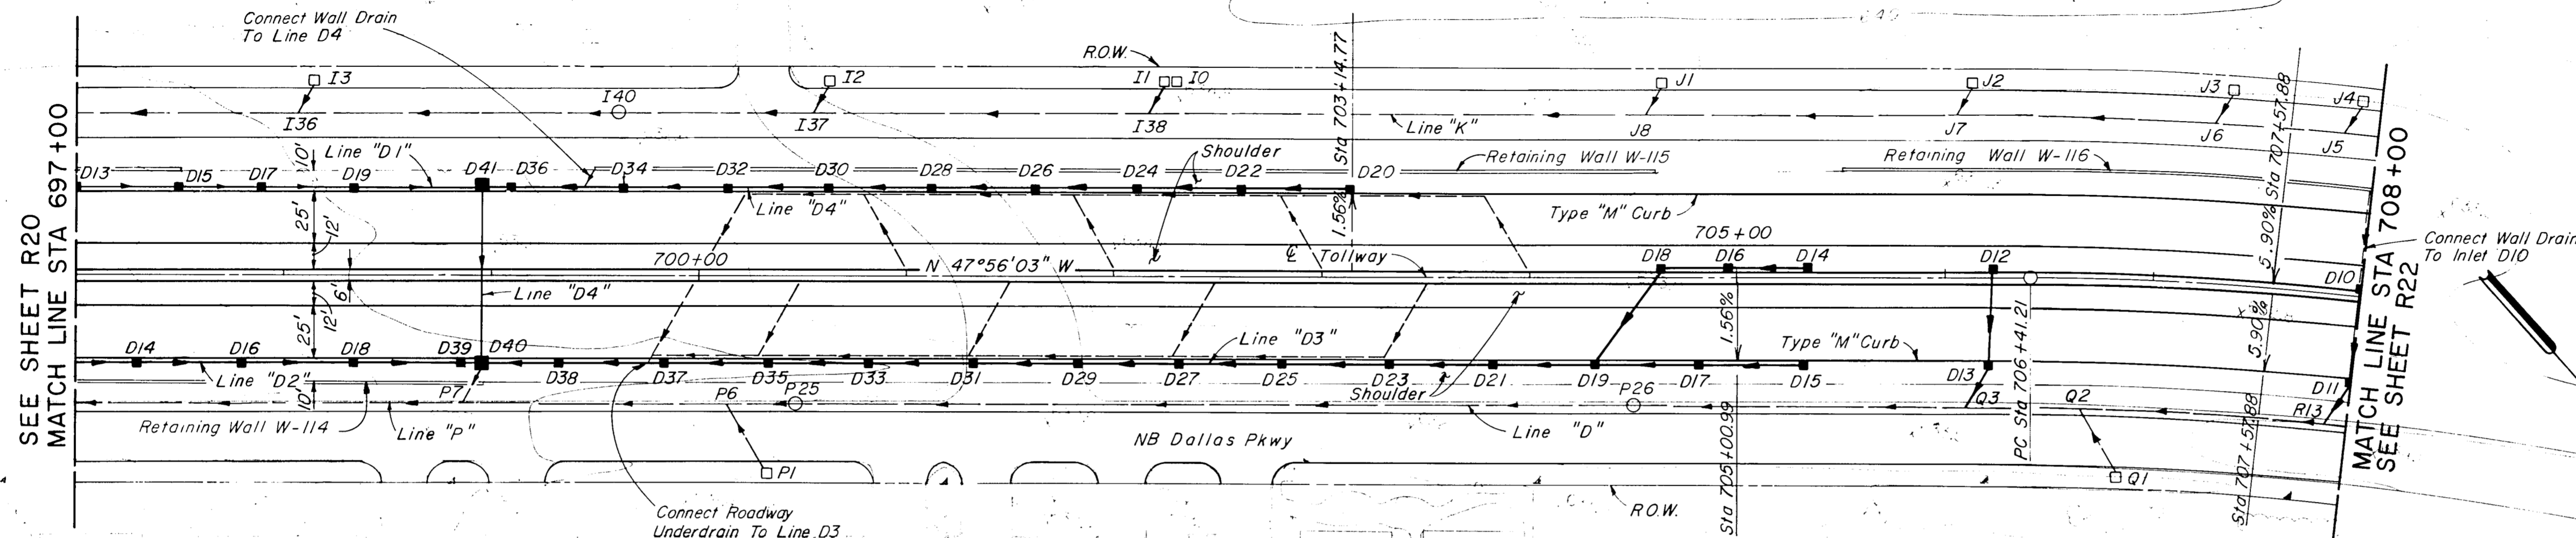

CROWN CENTRE  
16816

POLITICAL RESEARCH  
16850

16910

16950

BENT TREE TERRACES  
16970

16990

LEGEND


- Drainage Structures to be constructed under Phase III
- Drainage Structures constructed under Phase I & II
- Existing Drainage Structures
- Underdrain Lines Constructed Under Phase III

See Sheet R36 for Definition of Phases I, II, & III.

Bench Mark #10  
Chiseled "o" on center of inlet on west side on Knoll Trail Drive, 1850' north of Westgrove Drive, 20' south of power pole (#14N 2W 68) and 400' east of Dallas Parkway  
Elevation: 630.40



- NOTES:
- See Sheet R11 for Dallas Parkway Plan & Profile for Removals.
  - See Sheets W11 - W12 for Retaining Wall Details.
  - See Sheets R62 - R63 for Storm Sewer Profiles.
  - For Shoulder and Median Barrier Details See Typical Sections.

ASBUILT PLANS

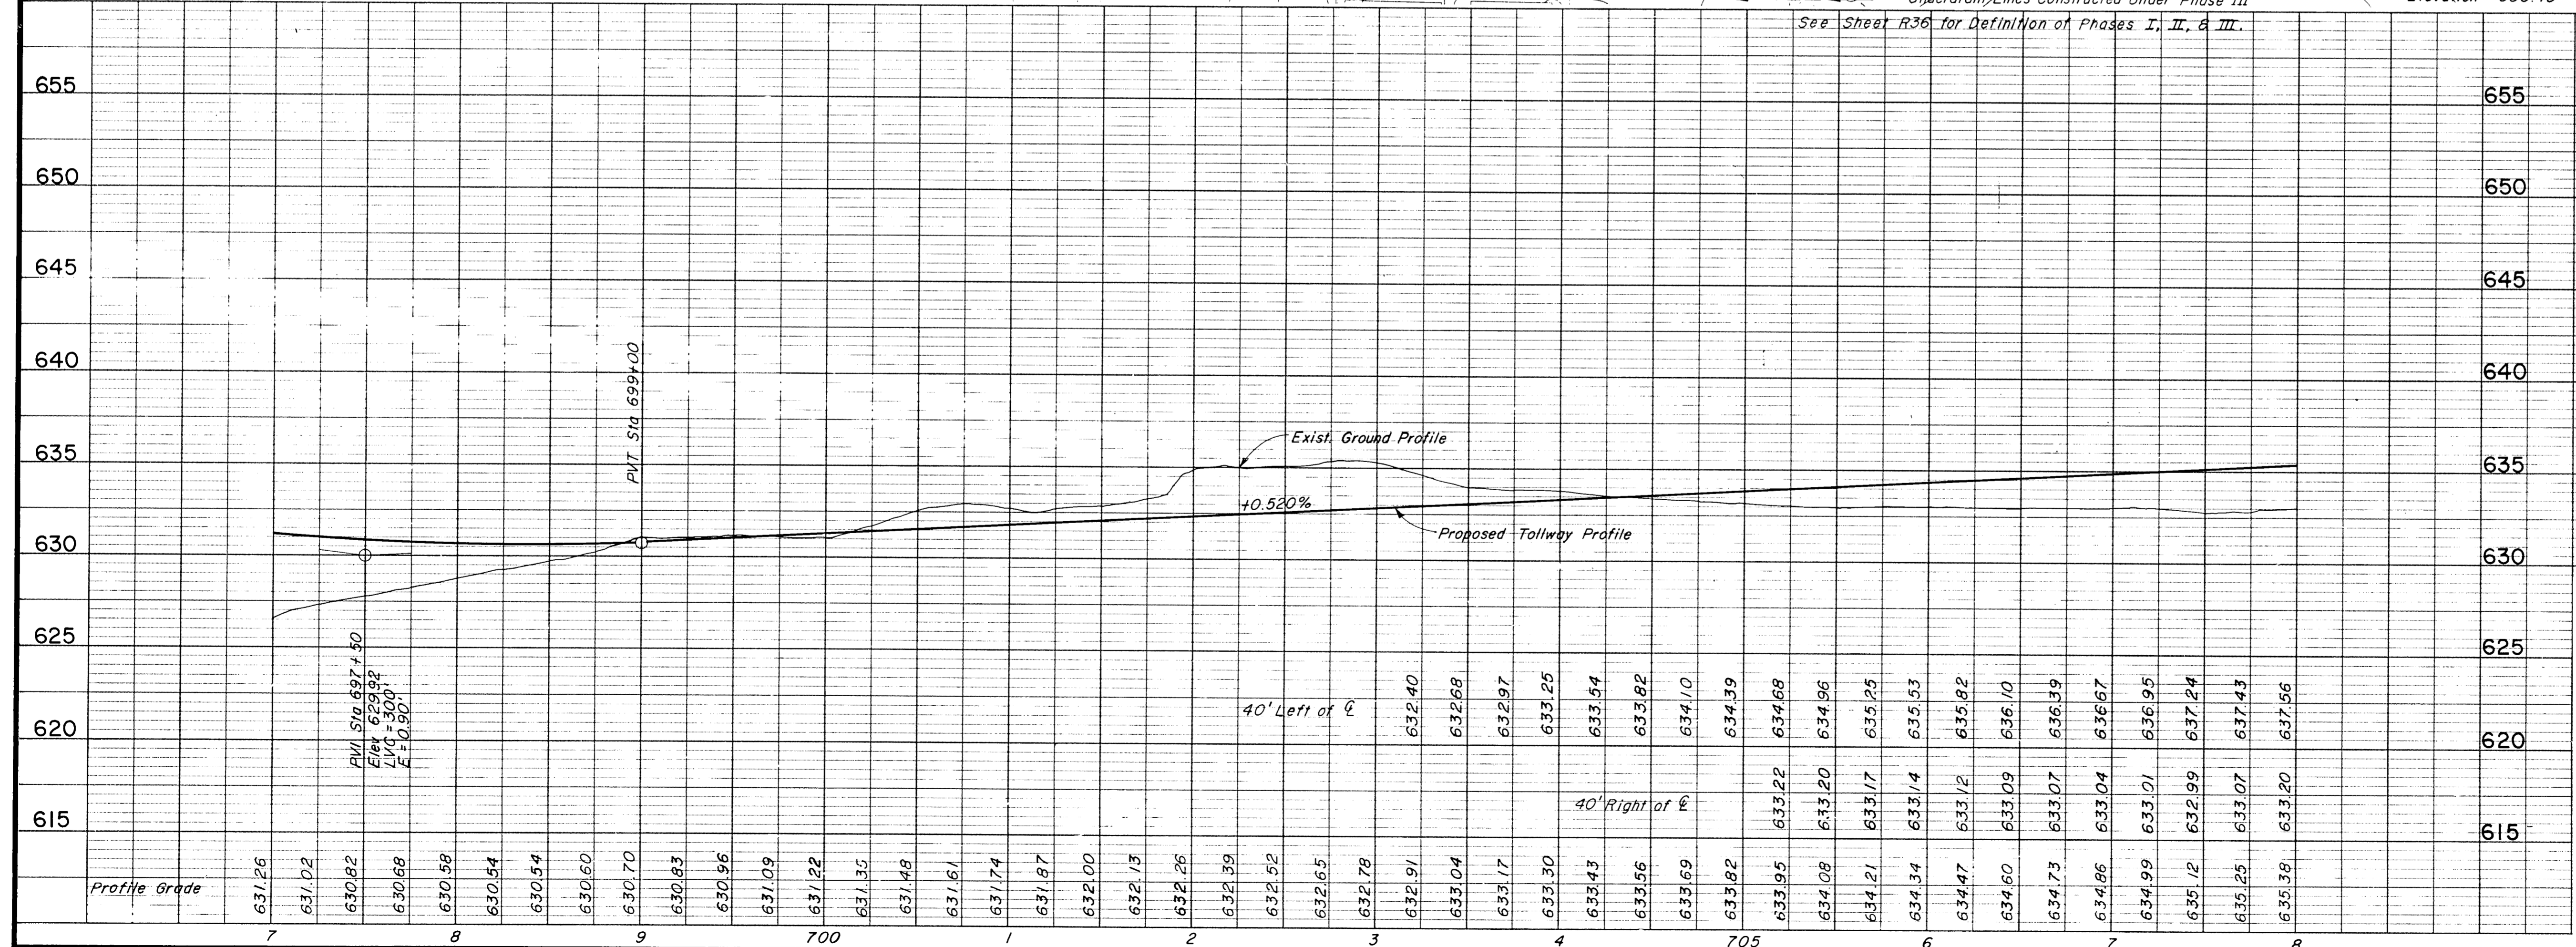

NO.	REVISION	BY	DATE
<b>TEXAS TURNPIKE AUTHORITY</b> <b>DALLAS NORTH TOLLWAY</b>			
PAVING AND GRADING TOLLWAY STA 697+00 TO STA 708+00			
<b>Gibbs &amp; Hill, Inc.</b> <small>ENGINEERS DESIGNERS CONSTRUCTORS DALLAS</small>			<b>SECTION VII</b>
<small>DRAWN</small> VER <small>CHECKED</small> DW	<small>DATE</small> 7/8/83 <small>DATE</small> 5/4/84	<small>DESIGNED</small> DW <small>DATE</small> 6/30/83	<small>SCALE</small> 1"=50' Hor 1"=5' Vert
CONTRACT NO. DNT-115 SHEET R21 OF R85			



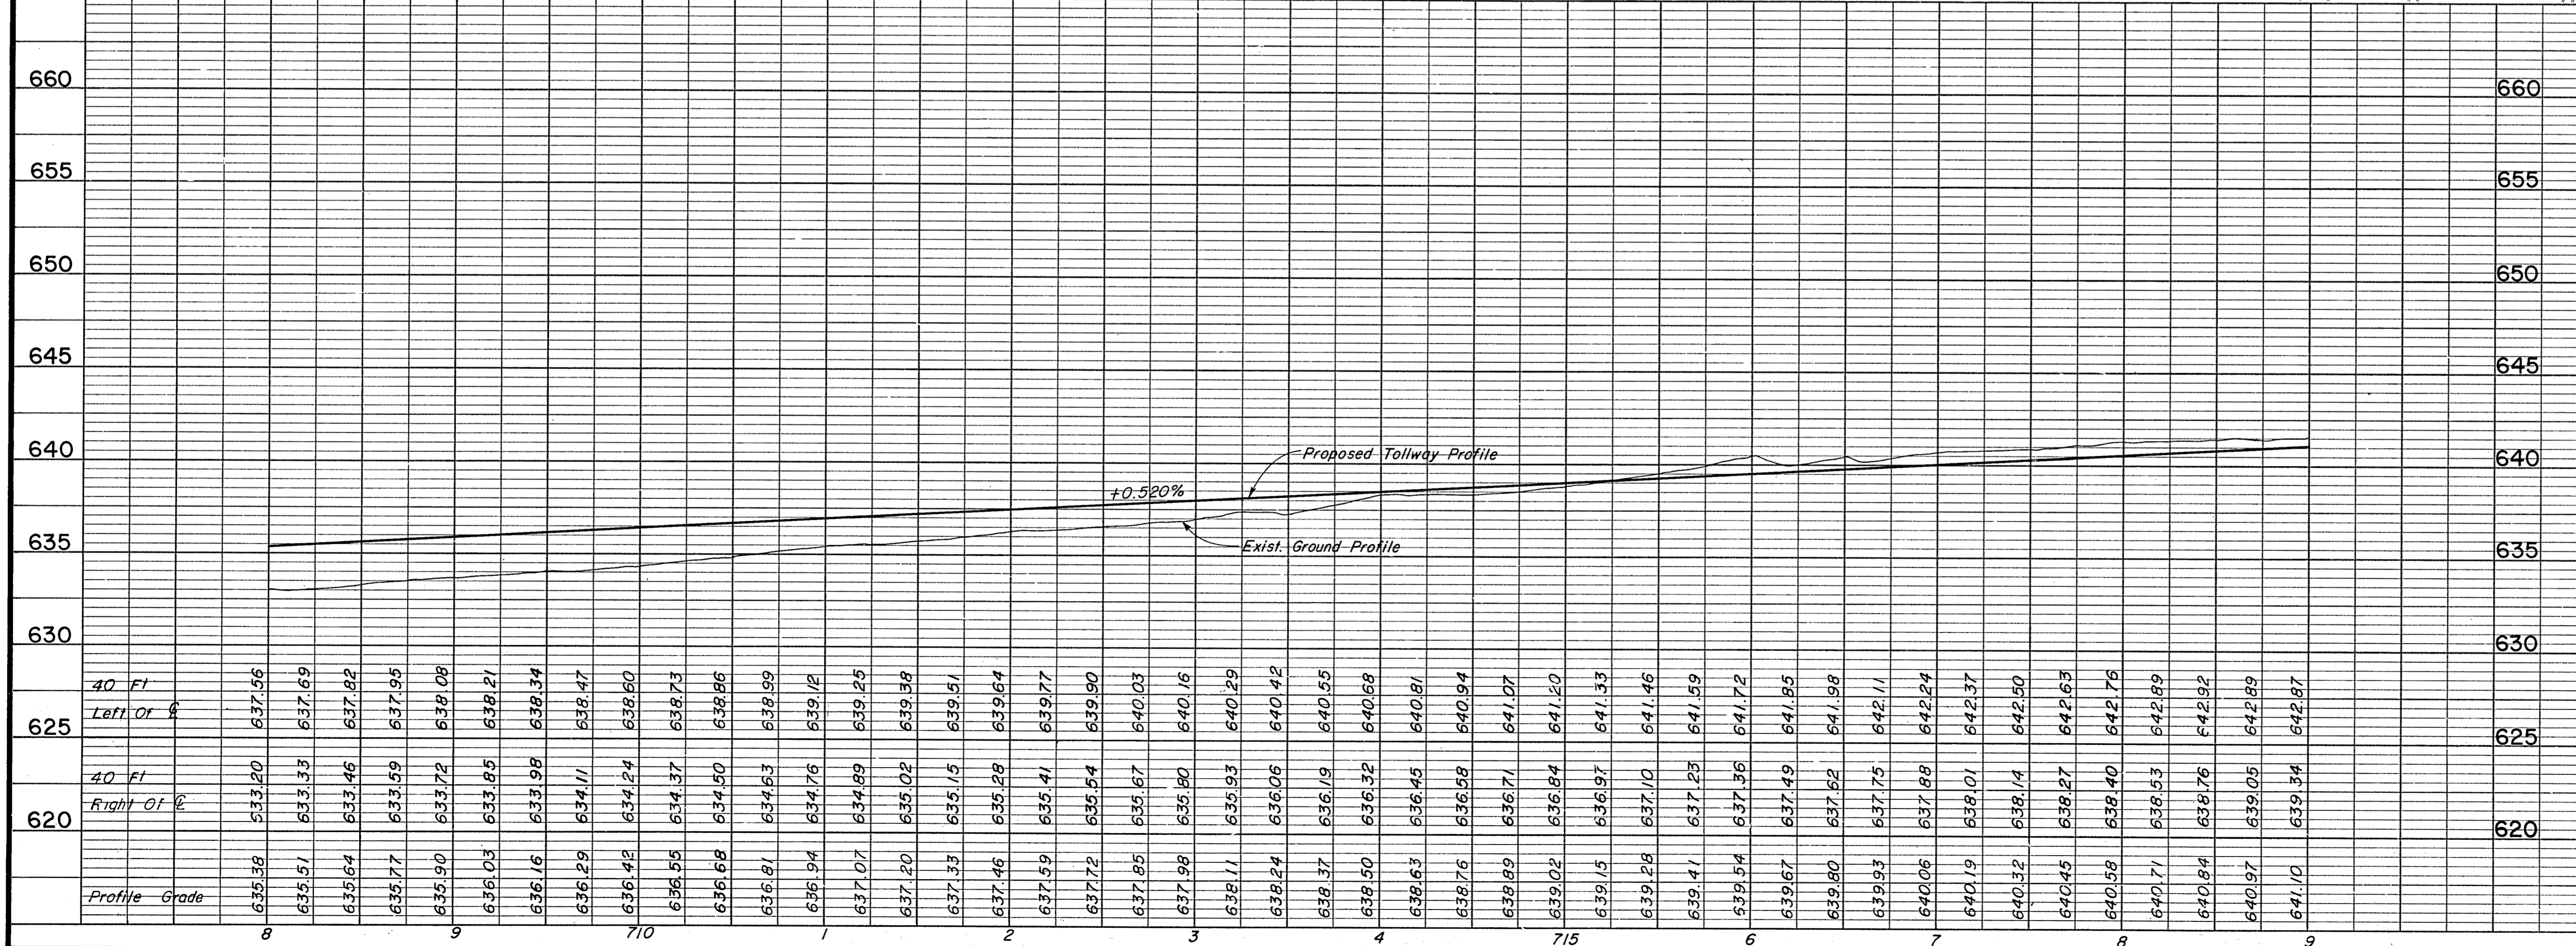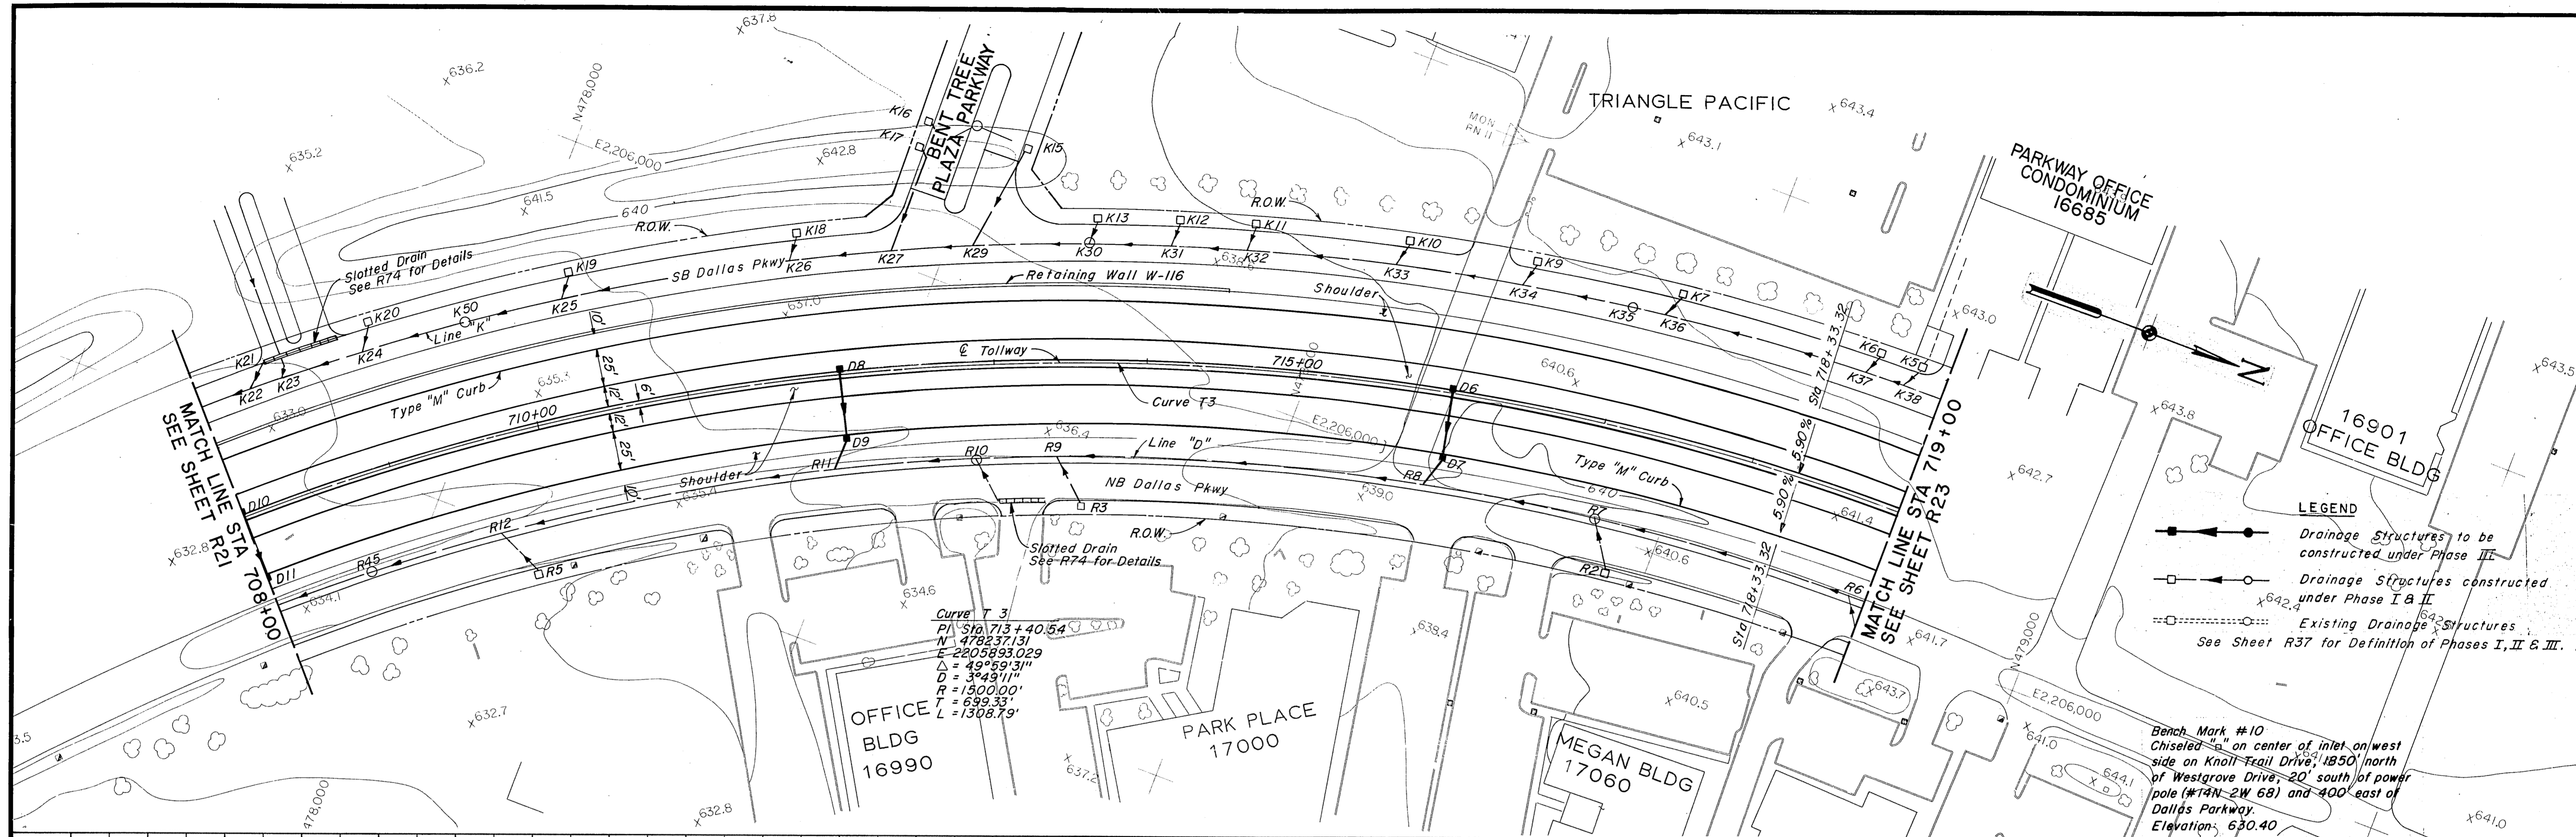


**NOTES**

- See Sheet R12 for Dallas Parkway Plan & Profile for Removals
- See Sheet W12 for Retaining Wall Details
- See Sheet R 62 for Storm Sewer Details
- For Shoulder and Median Barrier Details See Typical Sections

**ASBUILT PLANS**

NO.	REVISION	BY	DATE
<b>TEXAS TURNPIKE AUTHORITY</b> <b>DALLAS NORTH TOLLWAY</b> PAVING AND GRADING TOLLWAY STA 708+00 TO STA 719+00 <b>Gibbs &amp; Hill, Inc.</b> <small>ENGINEERS DESIGNERS CONSTRUCTORS DALLAS</small> <b>SECTION VII</b>			
DRAWN	VER	DATE	7/8/83
DESIGNED	DWC	DATE	6/30/83
CHECKED	DWC	DATE	5/4/84
SCALE		1"=50' Hor 1"=5' Vert	
CONTRACT NO. DNT-115 SHEET R22 OF R85			




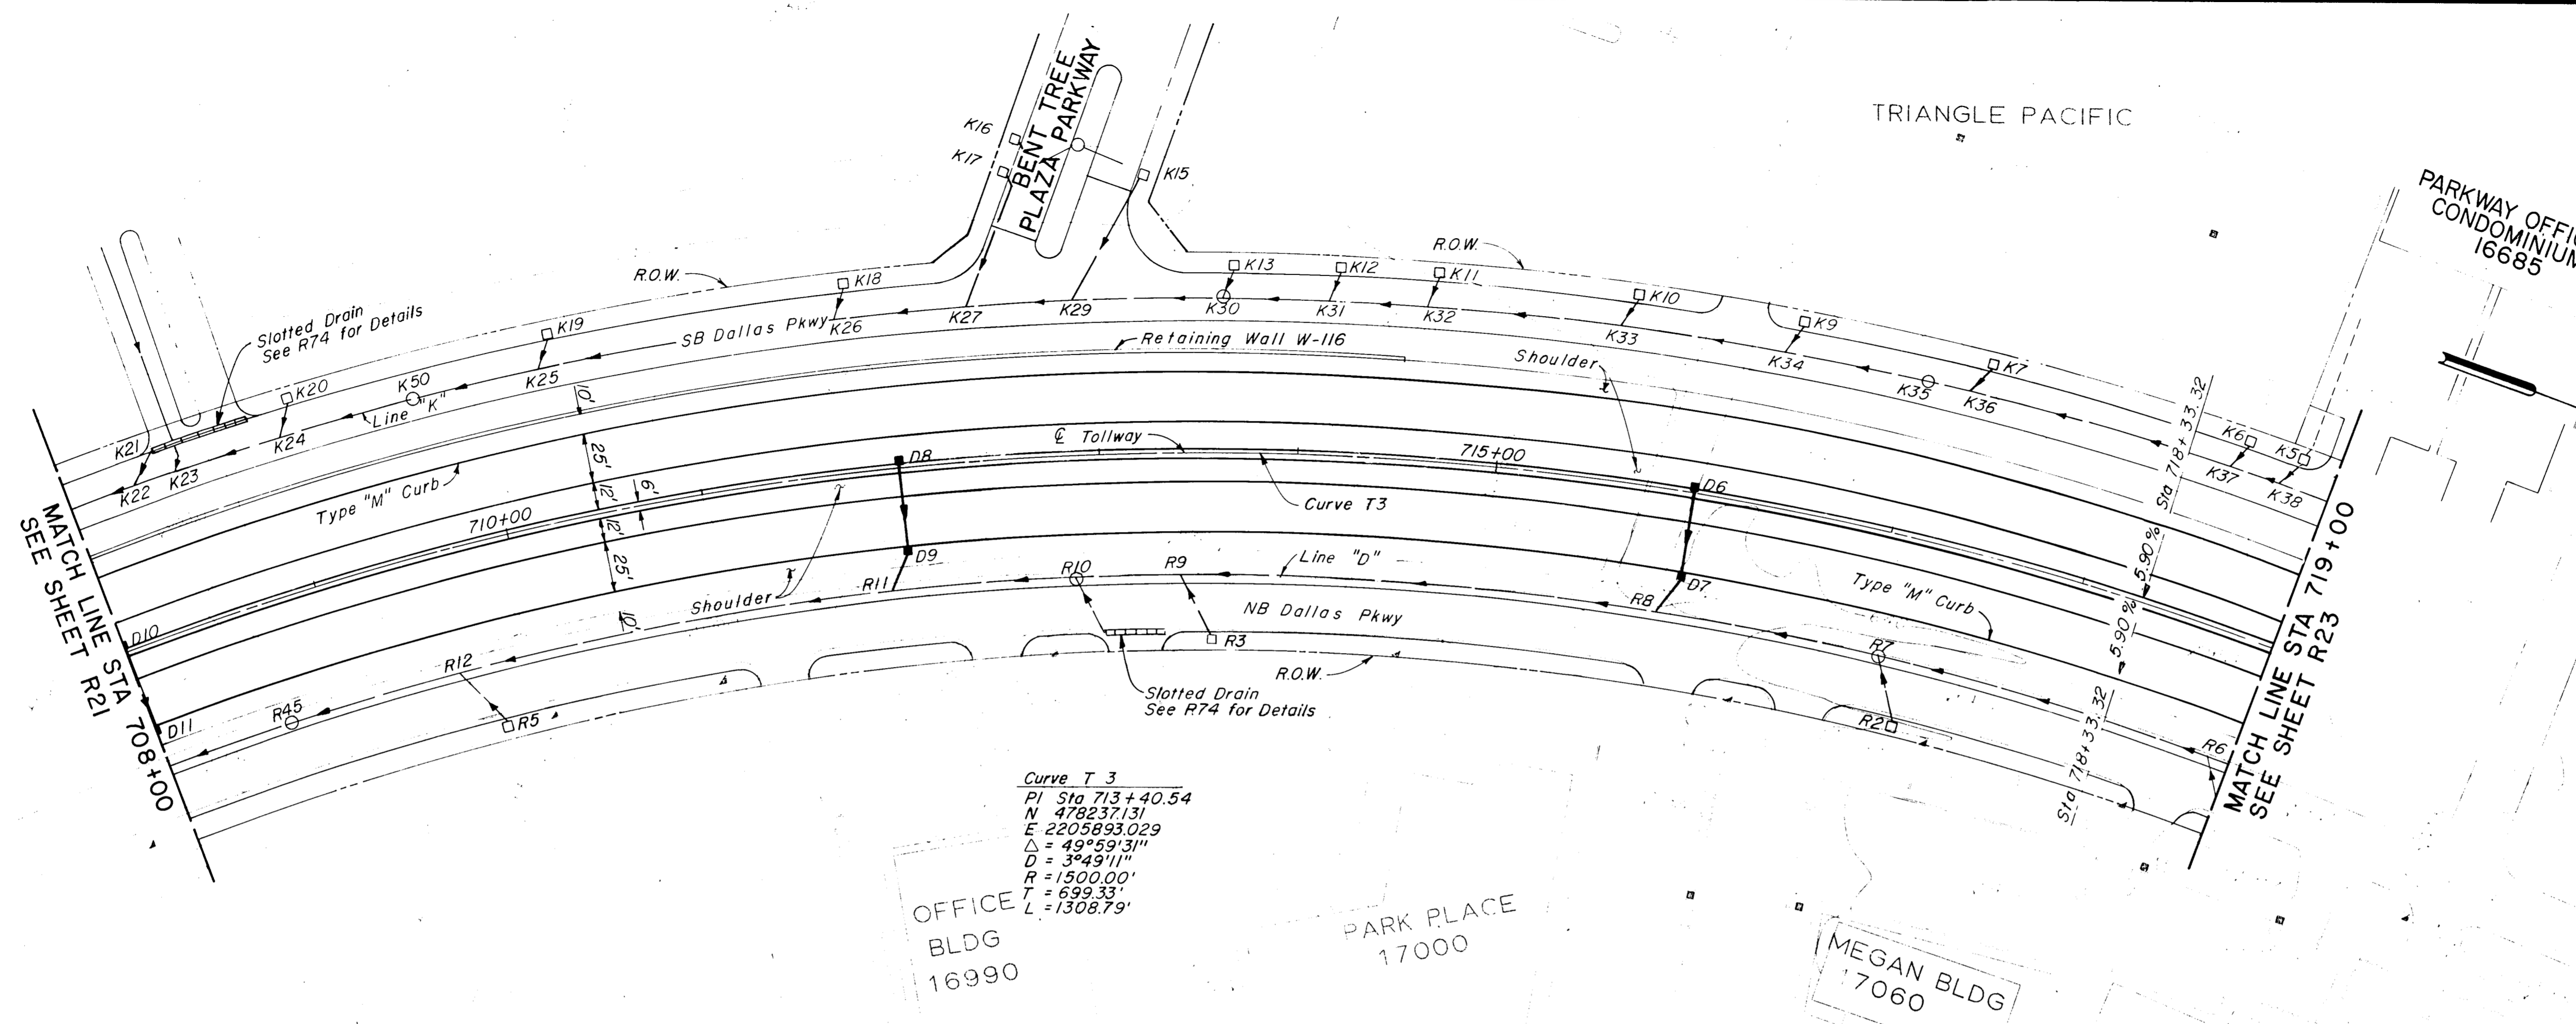

Curve T 3  
 PI STA 713+40.54  
 N 473237.31  
 E 2205893.029  
 $\Delta = 49^{\circ}59'31''$   
 $D = 3^{\circ}49'11''$   
 $R = 1500.00'$   
 $T = 699.33'$   
 $L = 1308.79'$

- LEGEND**
- Drainage Structures to be constructed under Phase III
  - Drainage Structures constructed under Phase I & II
  - Existing Drainage Structures
- See Sheet R37 for Definition of Phases I, II & III.

Bench Mark #10  
 Chiseled "s" on center of inlet on west side on Knoll Trail Drive, 1850' north of Westgrove Drive, 20' south of power pole (#14N-2W 68) and 400' east of Dallas Parkway.  
 Elevation: 630.40

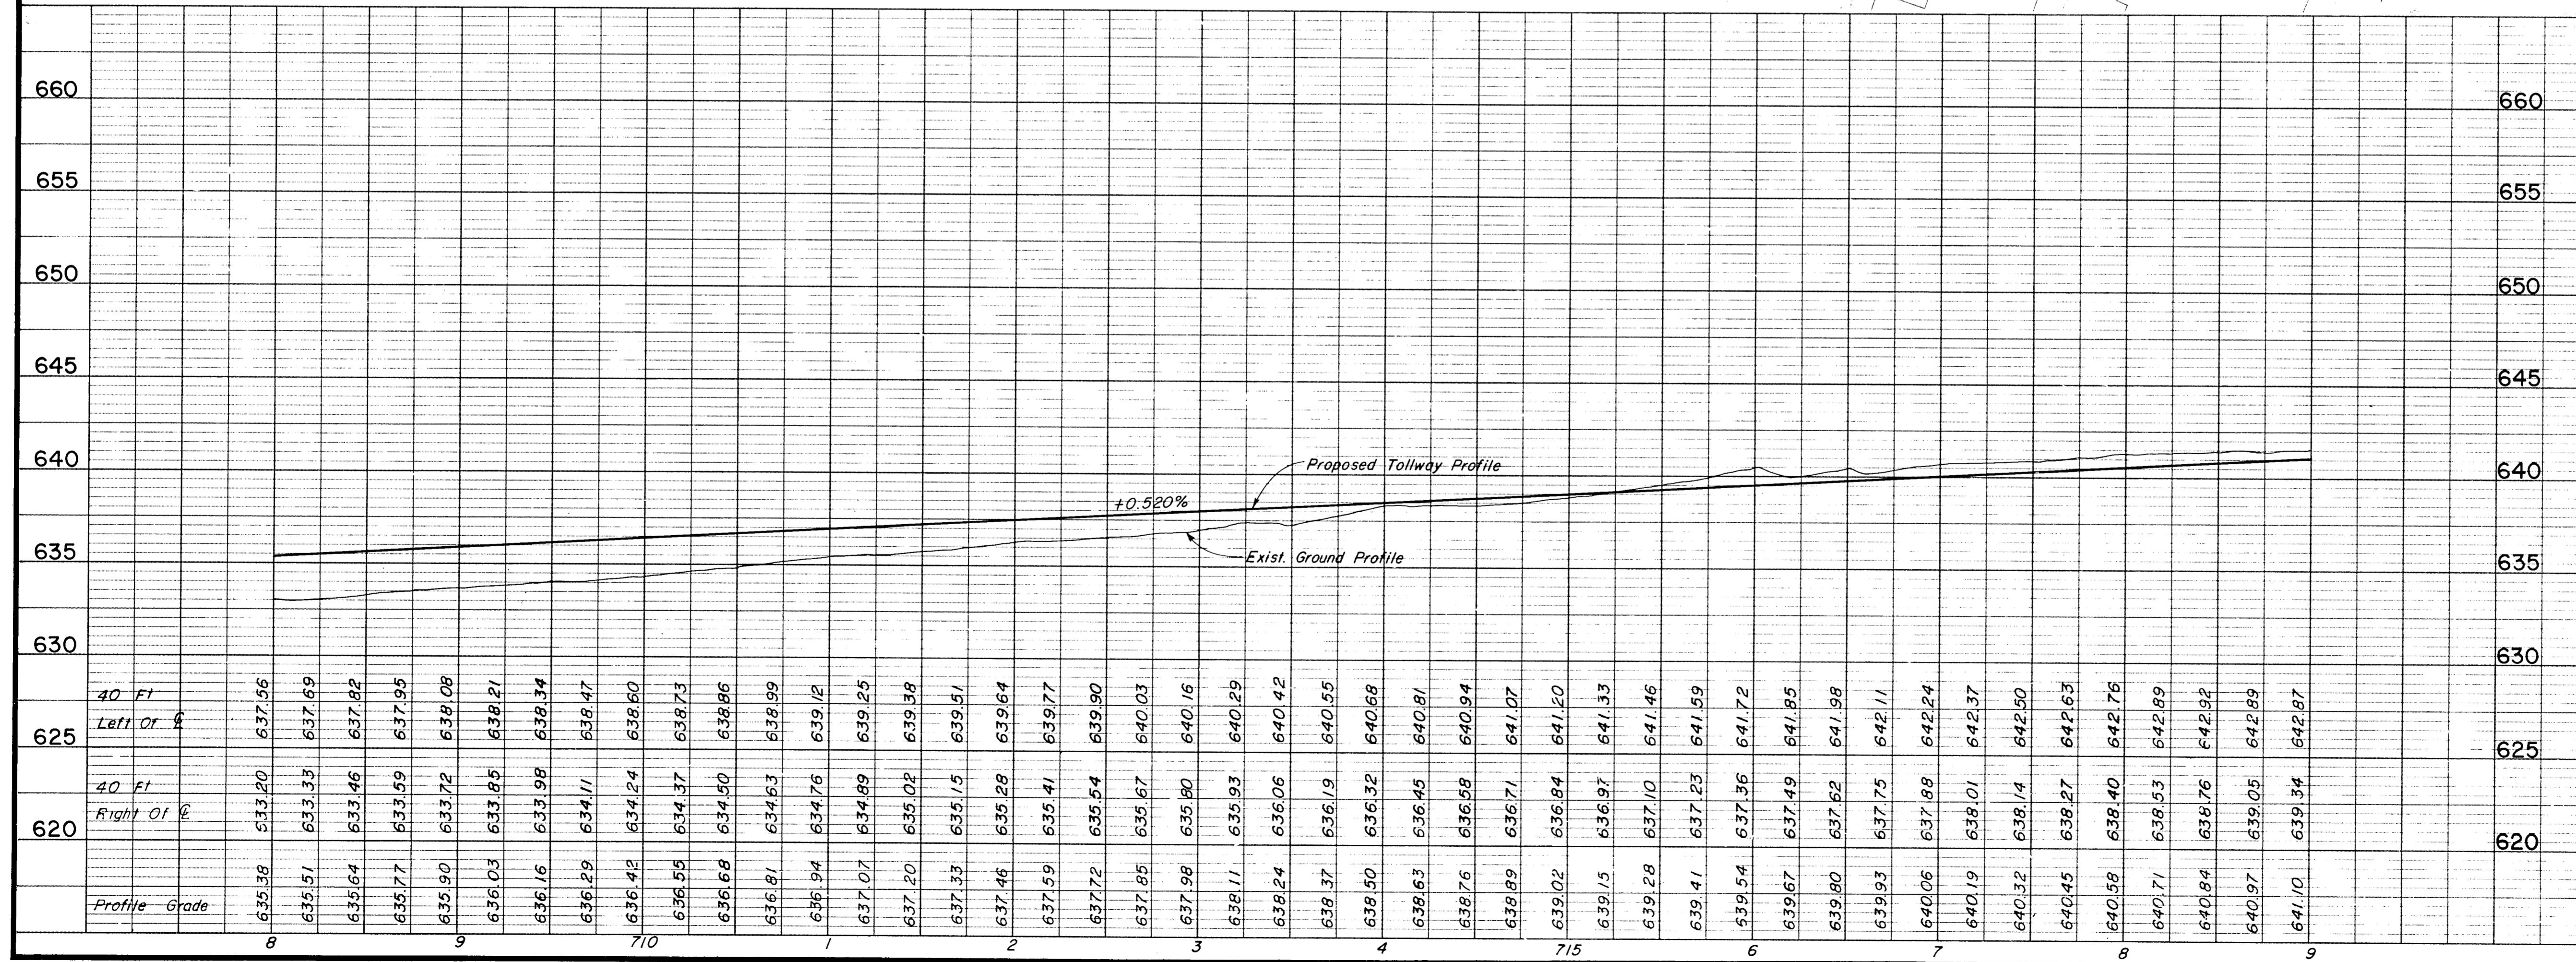


- NOTES**
- See Sheet R12 for Dallas Parkway Plan & Profile for Removals
  - See Sheet W12 for Retaining Wall details
  - See Sheet R 62 for Storm Sewer Details
  - For Shoulder and Median Barrier Details See Typical Sections

**ASBUILT PLANS**

NO.	REVISION	BY	DATE
<b>TEXAS TURNPIKE AUTHORITY</b> <b>DALLAS NORTH TOLLWAY</b>			
<b>PAVING AND GRADING</b> <b>TOLLWAY</b> <b>STA 708+00 TO STA 719+00</b>			
<b>Gibbs &amp; Hill, Inc.</b> <small>ENGINEERS DESIGNERS CONSTRUCTORS DALLAS</small>			<b>SECTION VII</b>
<small>DRAWN</small> VER <small>CHECKED</small> DWC	<small>DATE</small> 7/8/83 <small>DATE</small> 5/4/84	<small>DESIGNED</small> DWC <small>SCALE</small> 1"=50' Hor 1"=5' Vert	<small>DATE</small> 6/30/83
<b>CONTRACT NO. DNT-115 SHEET R22 OF R85</b>			



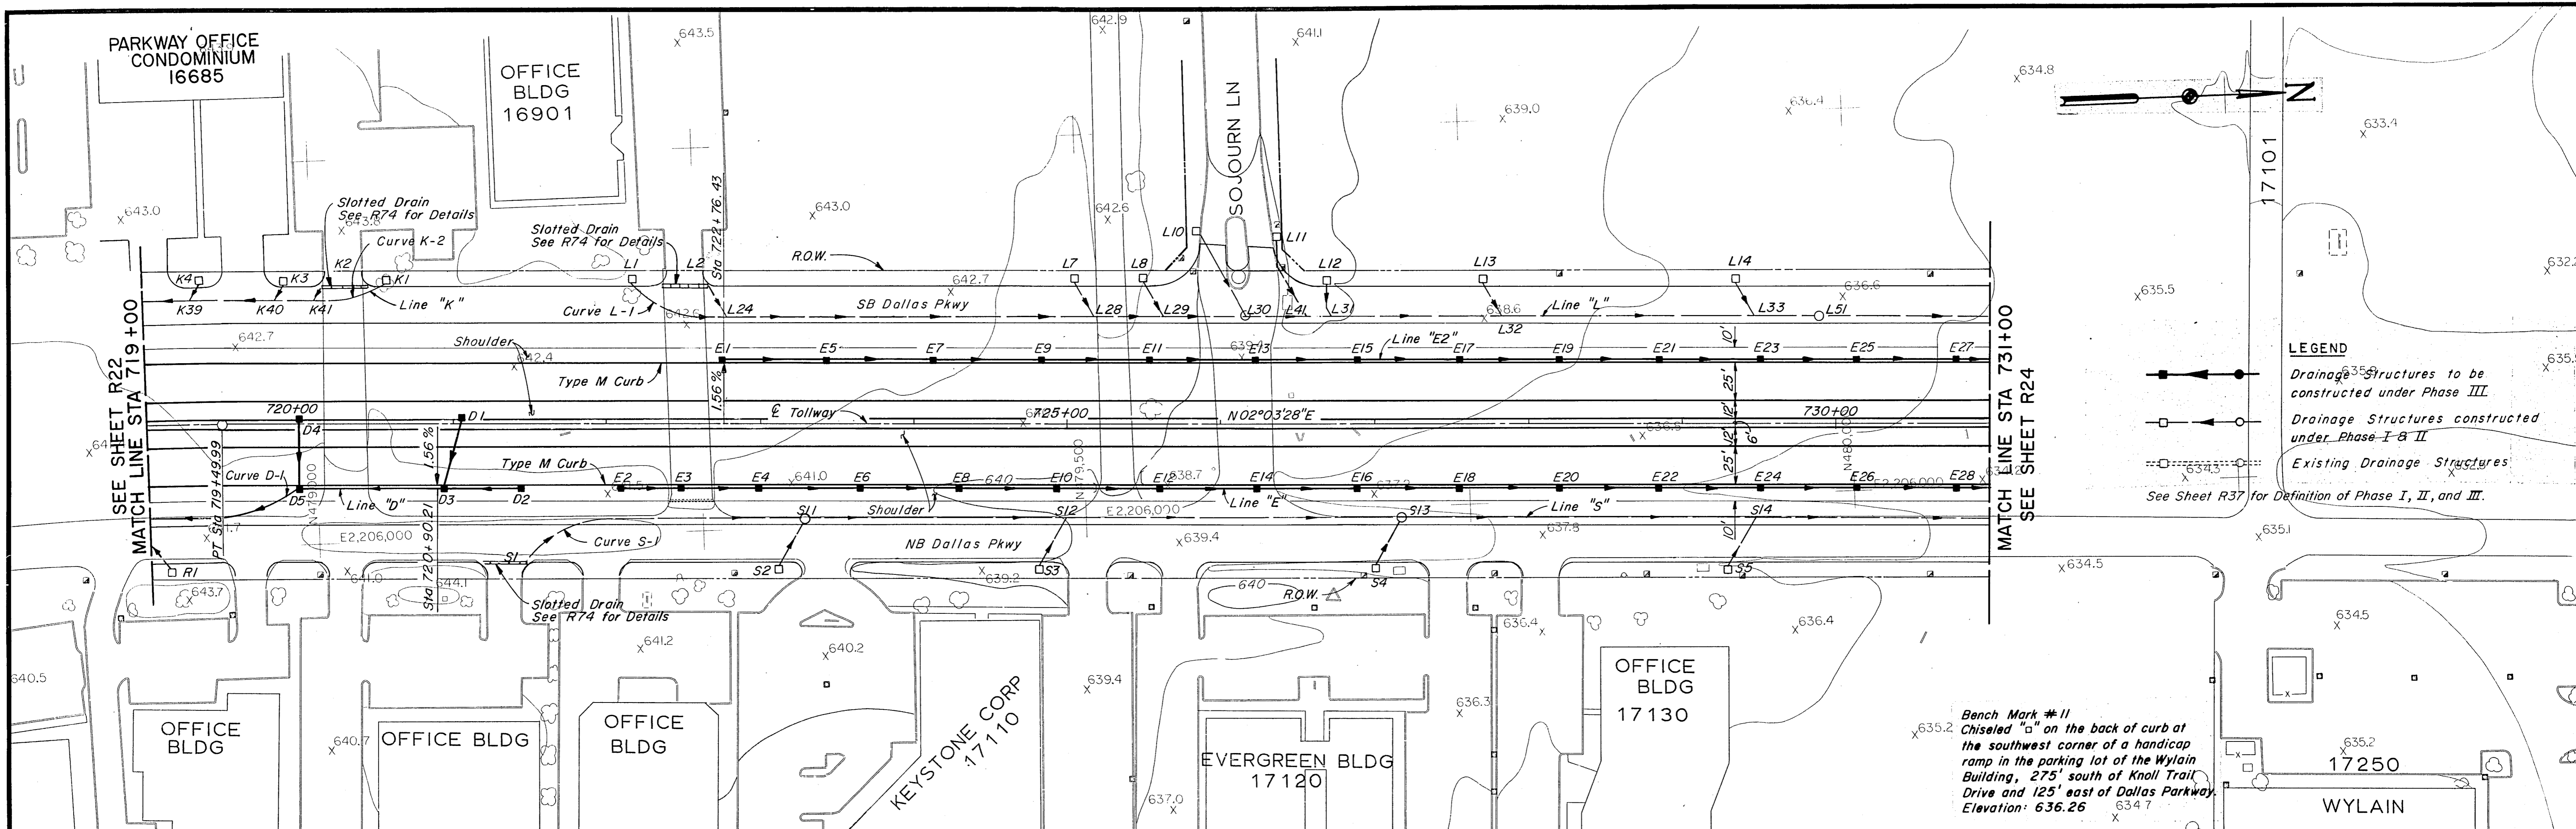


**LEGEND**

- Drainage Structures to be constructed under Phase III
- Drainage Structures constructed under Phase I & II
- Existing Drainage Structures

See Sheet R37 for Definition of Phase I, II, and III.

Bench Mark #11  
Chiseled "a" on the back of curb at the southwest corner of a handicap ramp in the parking lot of the Wylain Building, 275' south of Knoll Trail Drive and 125' east of Dallas Parkway.  
Elevation: 636.26

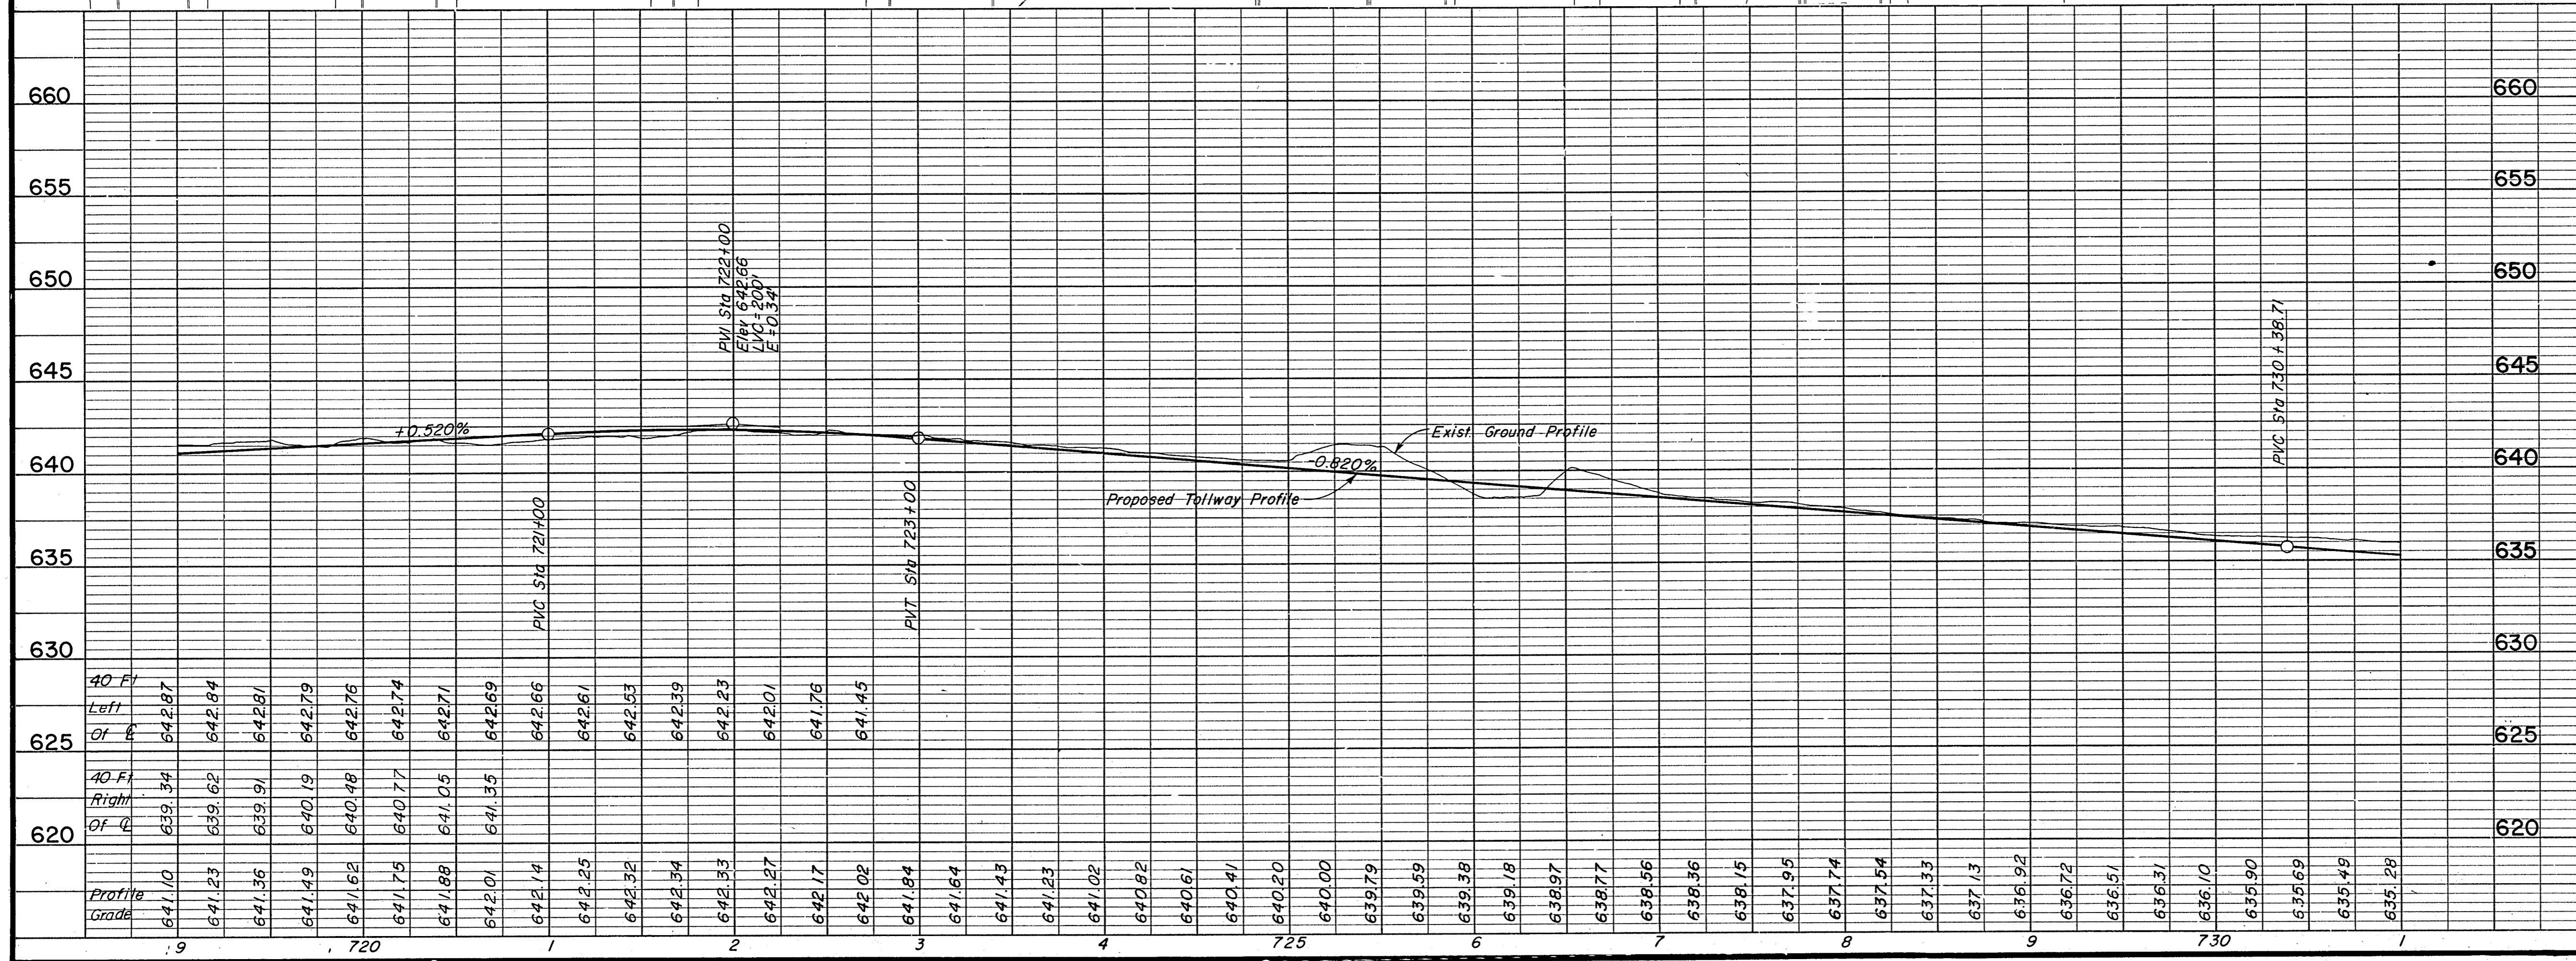

**NOTES**

- See Sheet R13 for Dallas Parkway Plan & Profile for Removals.
- See the following Sheets for Storm Sewer Profiles:
 

Line	Sheet
D	R 62
E, E2	R 63
- For Shoulder and Median Barrier Details See Typical Sections.

**ASBUILT PLANS**

NO.	REVISION	BY	DATE
<b>TEXAS TURNPIKE AUTHORITY</b> <b>DALLAS NORTH TOLLWAY</b>			
<b>PAVING AND GRADING</b> <b>TOLLWAY</b> <b>STA 719+00 TO STA 731+00</b>			
<b>Gibbs &amp; Hill, Inc.</b> <small>ENGINEERS DESIGNERS CONSTRUCTORS</small> <small>DALLAS</small>			<b>SECTION VII</b>
<small>DRAWN</small> VER <small>CHECKED</small> DWC	<small>DATE</small> 7/8/83 <small>DATE</small> 5/4/84	<small>DESIGNED</small> DWC <small>SCALE</small> 1"=50' Hor. 1"=5' Vert.	<small>DATE</small> 6/30/83
<b>CONTRACT NO. DNT-115 SHEET R23 OF R85</b>			



PARKWAY OFFICE  
CONDOMINIUM  
16685

OFFICE  
BLDG  
16901

EVERGREEN BLDG  
17120

OFFICE  
BLDG  
17130

17250

WYLAINE

Bench Mark #11  
Chiseled "a" on the back of curb at  
the southwest corner of a handicap  
ramp in the parking lot of the Wylaine  
Building, 275' south of Knoll Trail  
Drive and 125' east of Dallas Parkway.  
Elevation: 636.26

Slotted Drain  
See R74 for Details

Slotted Drain  
See R74 for Details

Slotted Drain  
See R74 for Details



SEE SHEET R22  
MATCH LINE STA 719+00

MATCH LINE STA 731+00  
SEE SHEET R24


LEGEND

- Drainage Structures to be constructed under Phase III
- Drainage Structures constructed under Phase I & II
- Existing Drainage Structures

See Sheet R37 for Definition of Phase I, II, and III.

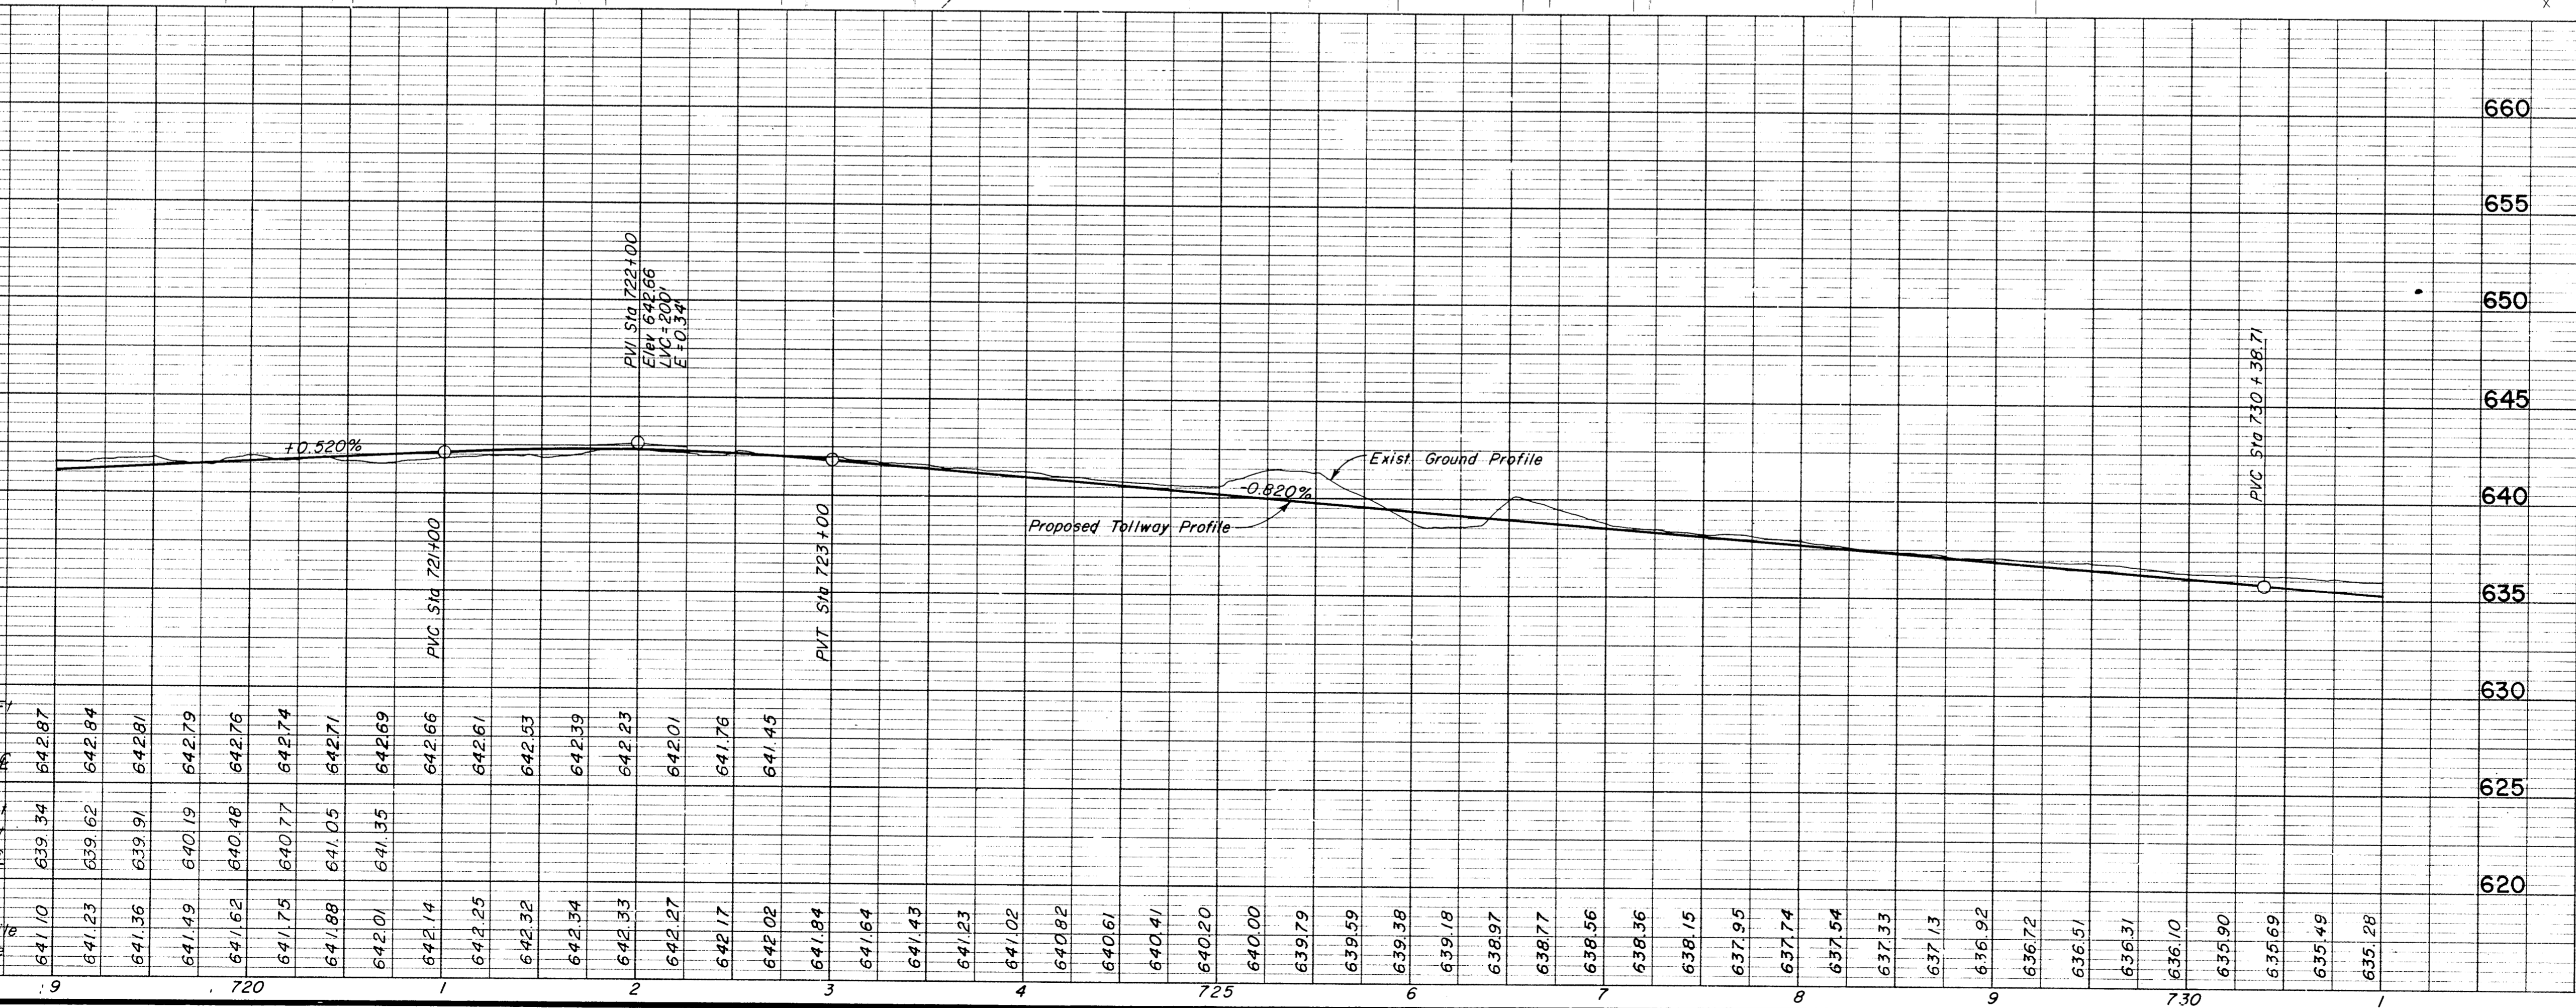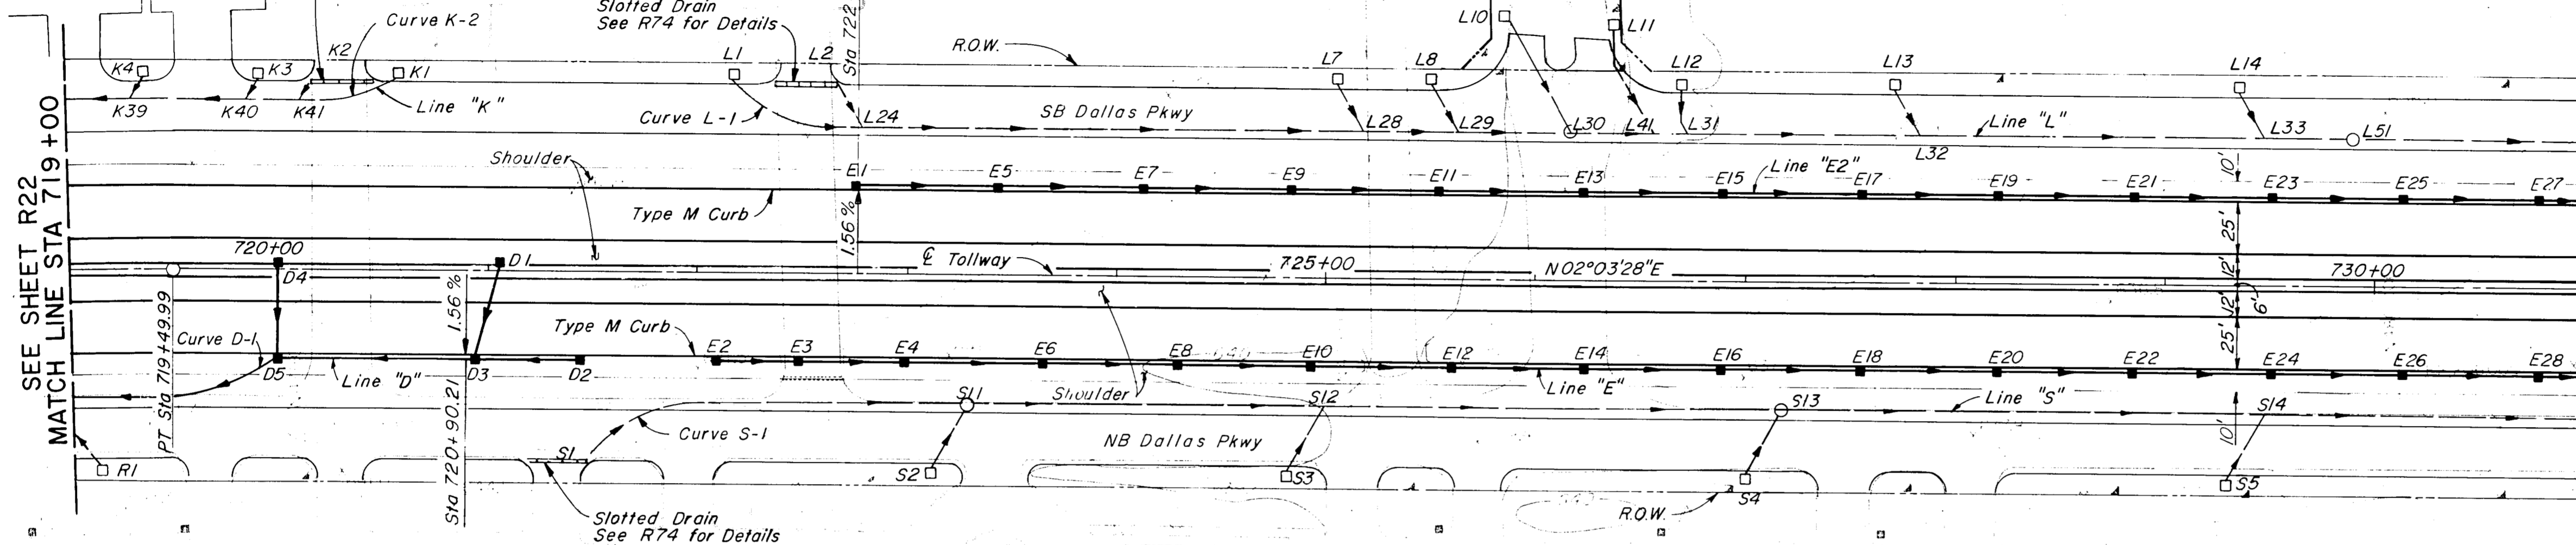



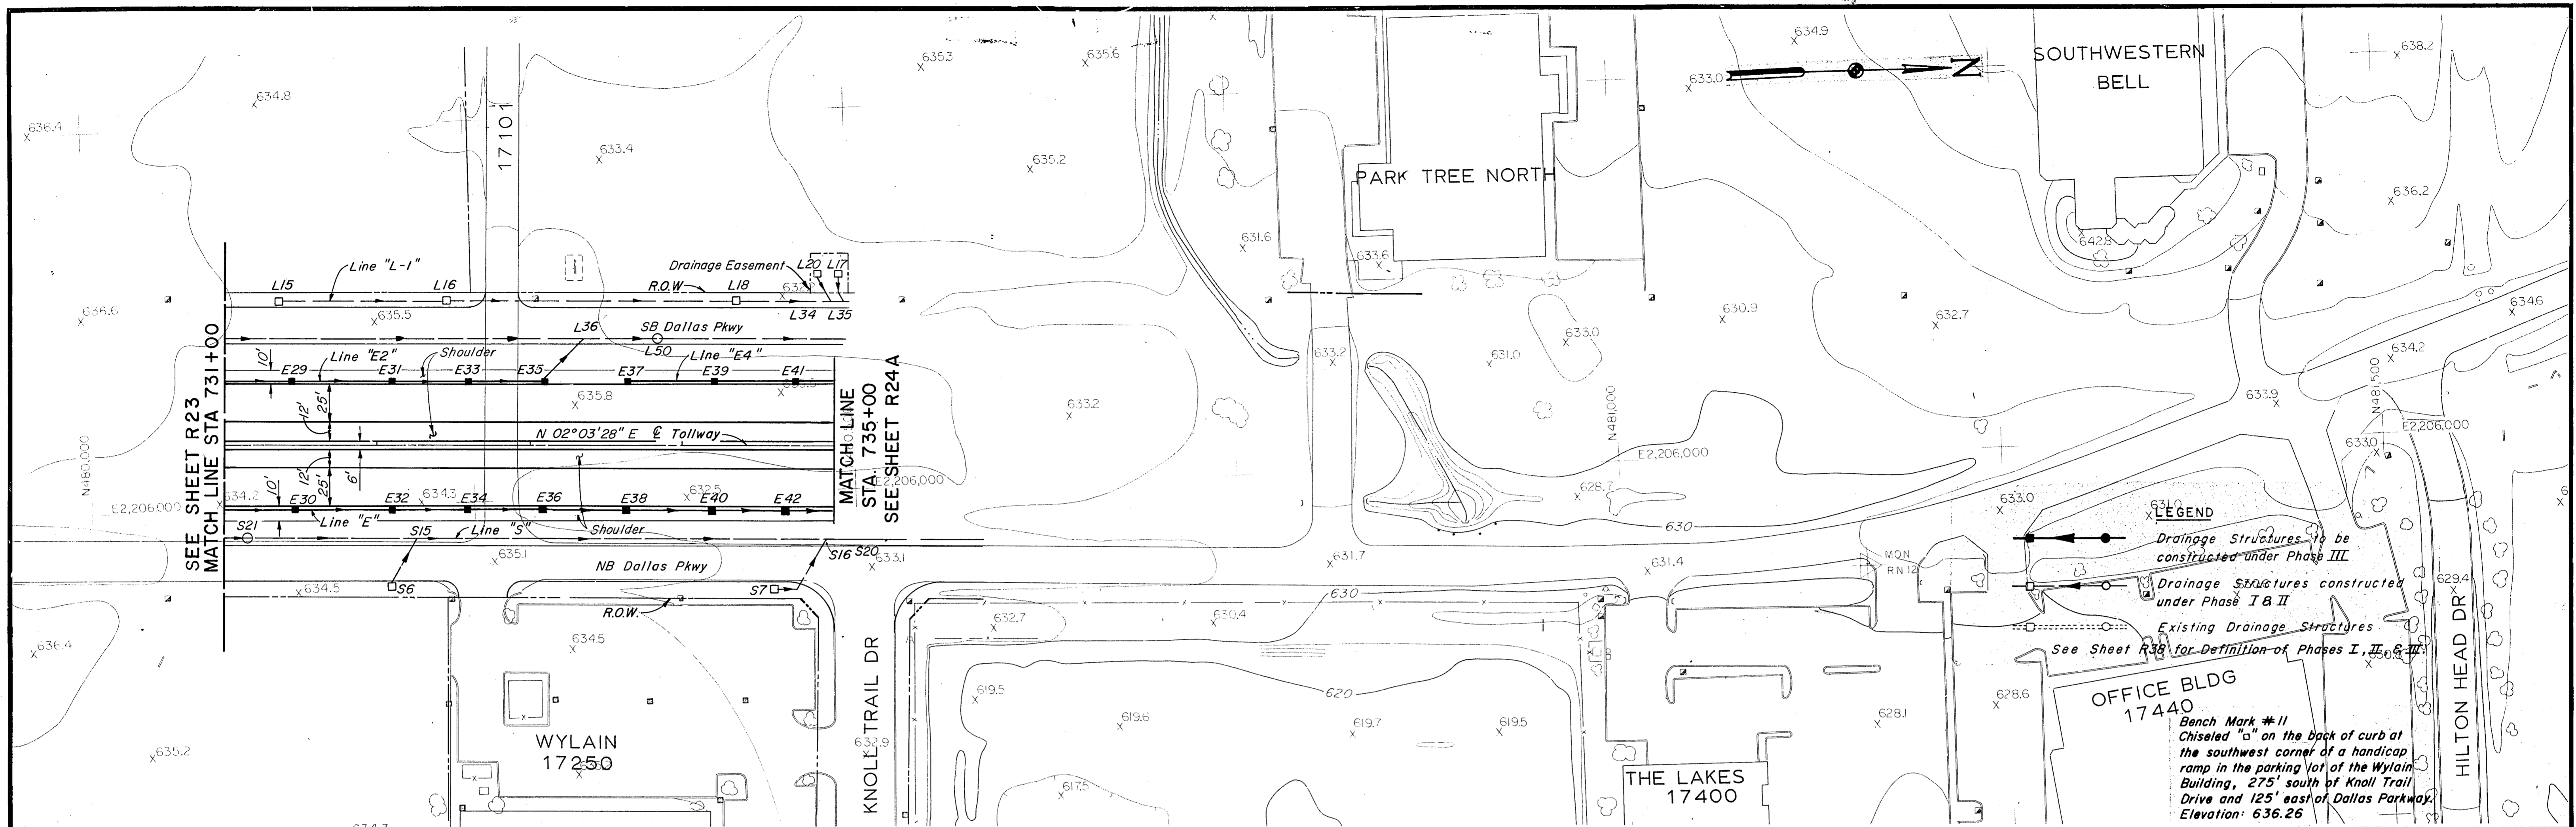

- NOTES:**
1. See Sheet R14 for Dallas Parkway Plan & Profile and Removals.
  2. See Sheet R65 for Storm Sewer Profiles.
  3. For Shoulder and Median Barrier Details see Typical Sections.

**ASBUILT PLANS**

NO.	REVISION	BY	DATE
1	General Trinity Mills/Belgrave	gbb	10-19-85
2	Removed Inlet MB & Replaced with Slotted Drain, Revised R.O.W. Line	B&A	2-5-85

**TEXAS TURNPIKE AUTHORITY**  
**DALLAS NORTH TOLLWAY**

**PAVING AND GRADING**  
**TOLLWAY**  
 STA 731+00 TO STA 740+37


**Gibbs & Hill, Inc.**  
ENGINEERS DESIGNERS CONSTRUCTORS

**SECTION VII**

DRAWN <i>VER</i>	DATE <i>7/8/83</i>	DESIGNED <i>DWC</i>	DATE <i>6/30/83</i>
CHECKED <i>DWC</i>	DATE <i>5/3/84</i>	SCALE <i>1"=50' Hor 1"=5' Vert</i>	



CONTRACT NO. **DNT-115** SHEET **R24** OF **R85**



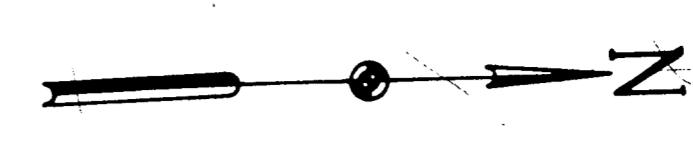

SOUTHWESTERN  
BELL

PARK TREE NORTH

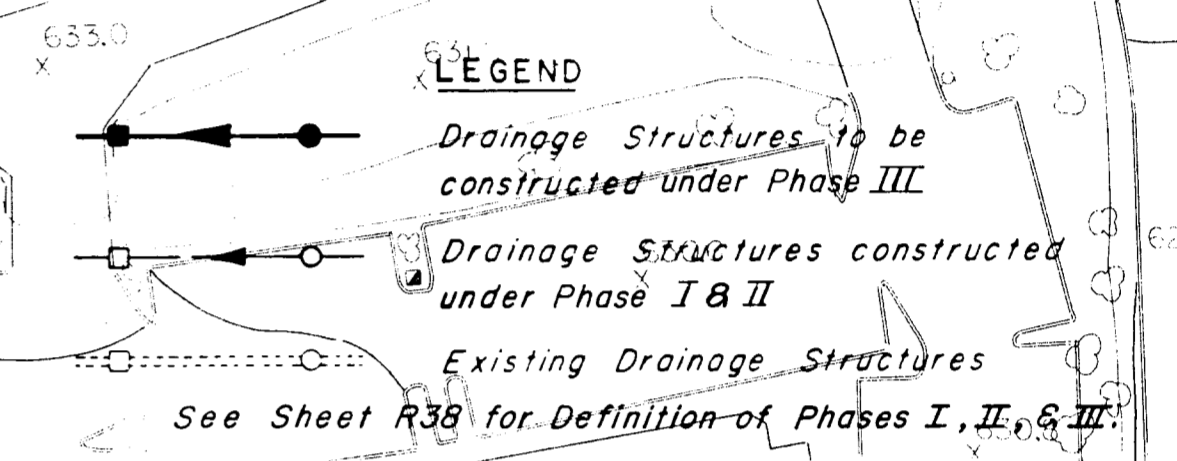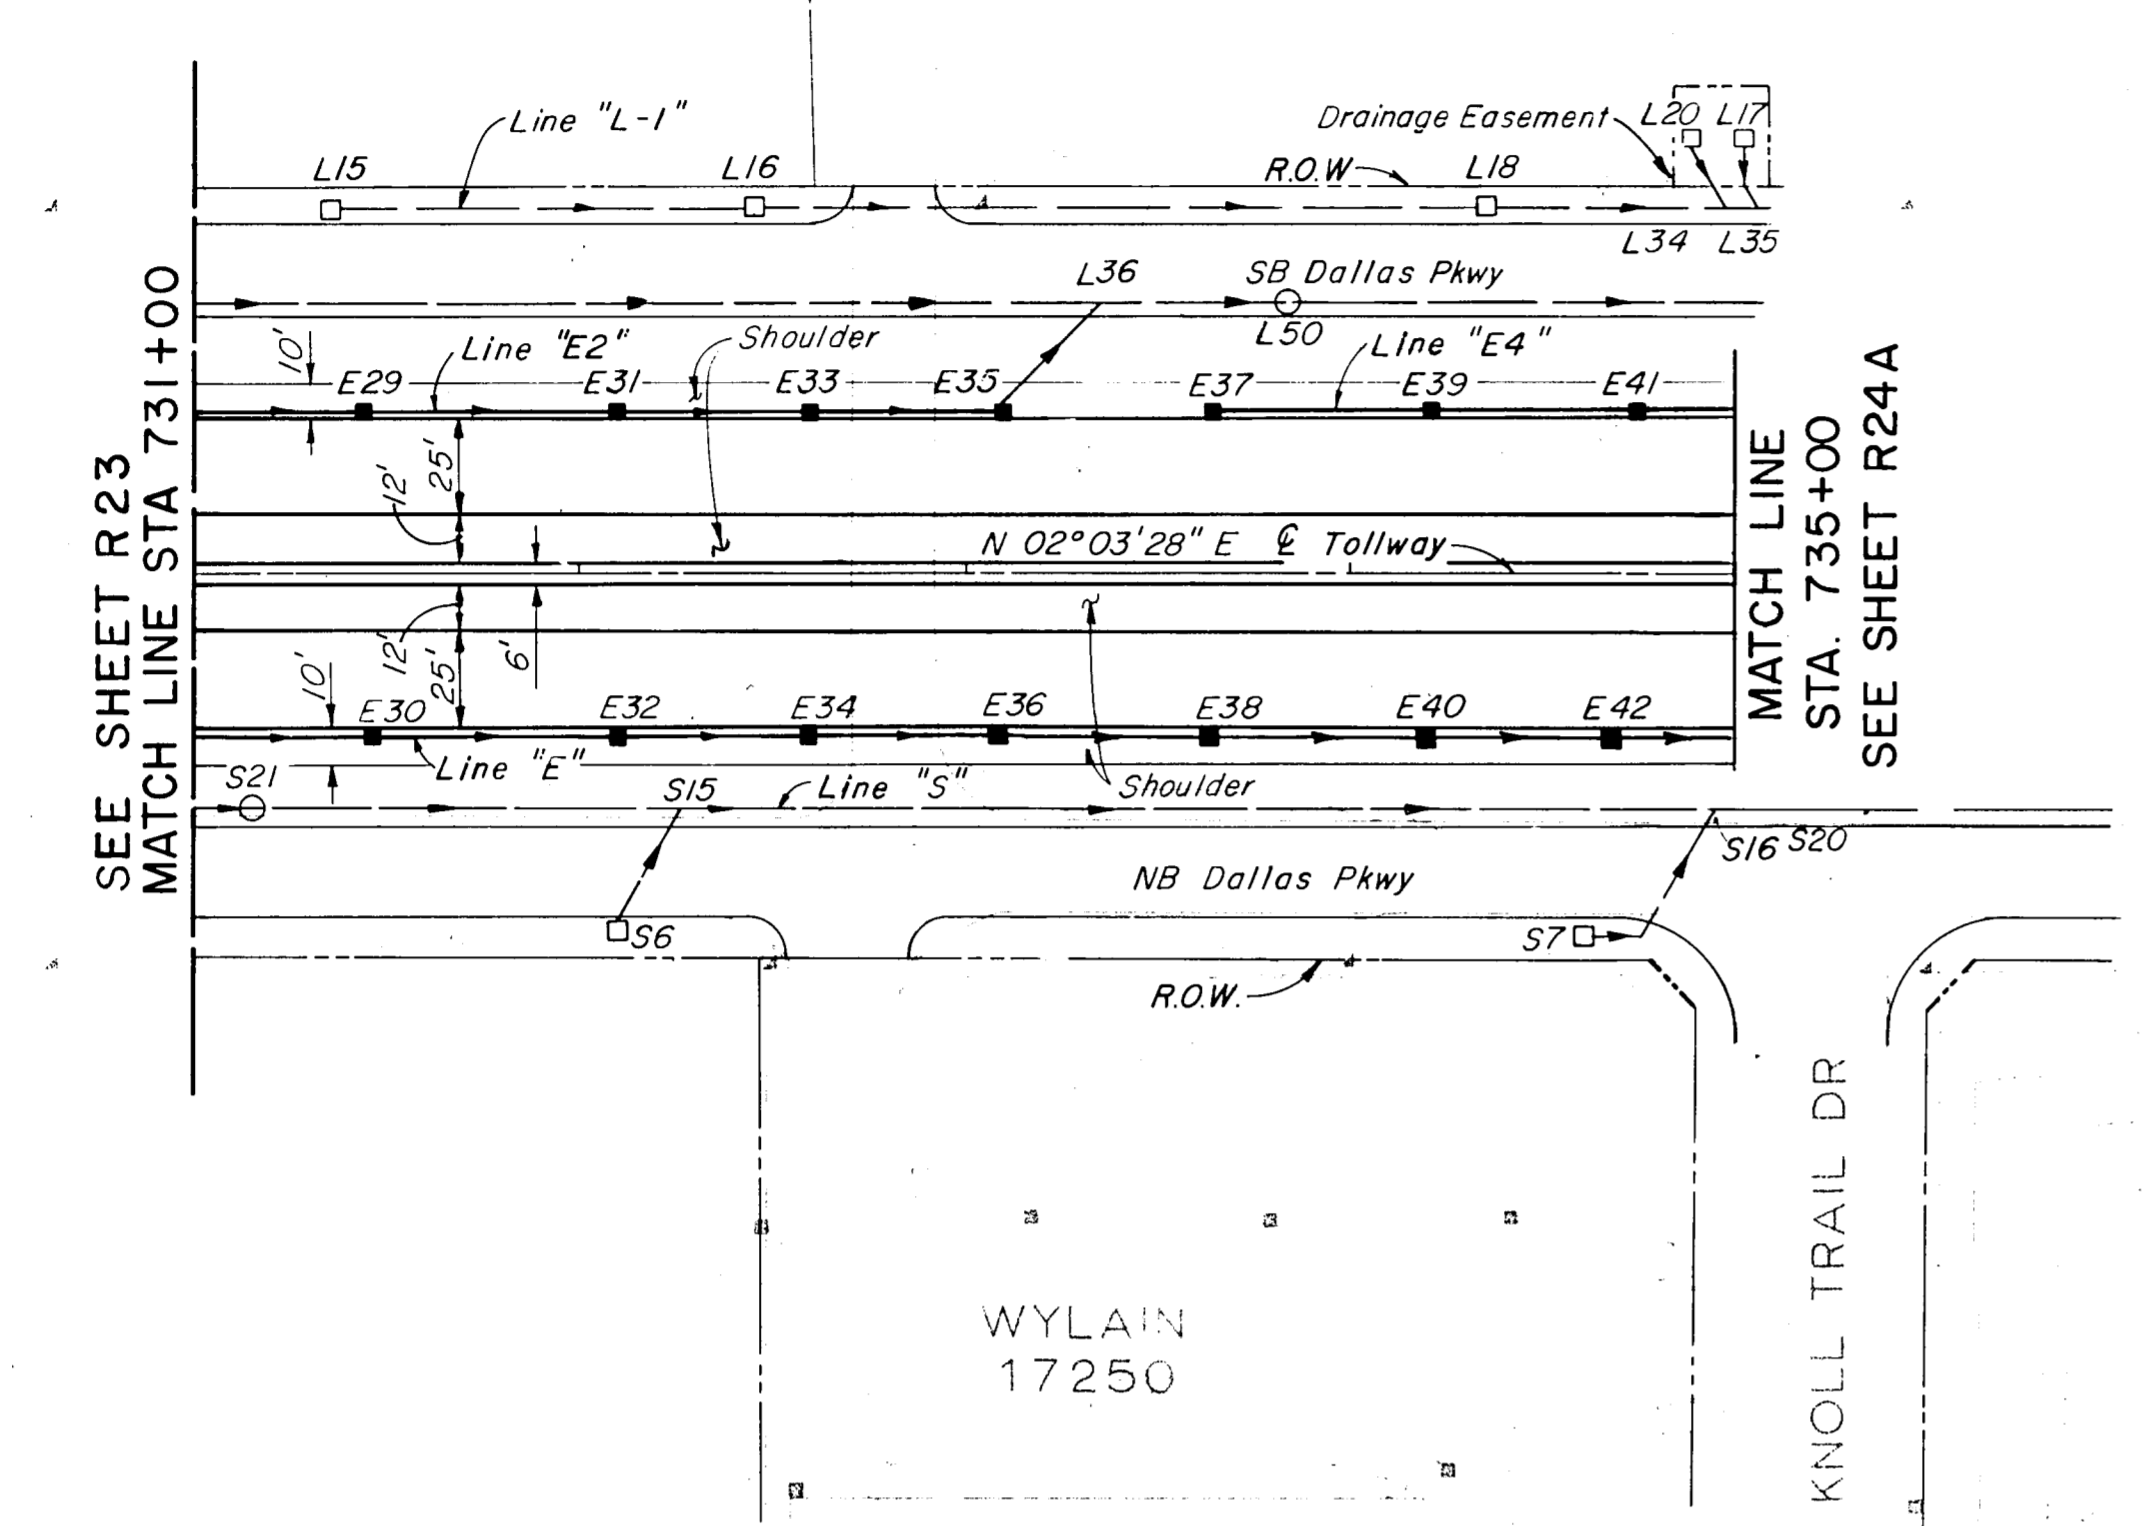


OFFICE BLDG  
17440

Bench Mark #11  
Chiseled "a" on the back of curb at  
the southwest corner of a handicap  
ramp in the parking lot of the Wylain  
Building, 275' south of Knoll Trail  
Drive and 125' east of Dallas Parkway.  
Elevation: 636.26

THE LAKES  
17400

**NOTES:**

1. See Sheet R14 for Dallas Parkway Plan & Profile and Removals.
2. See Sheet R65 for Storm Sewer Profiles
3. For Shoulder and Median Barrier Details see Typical Sections

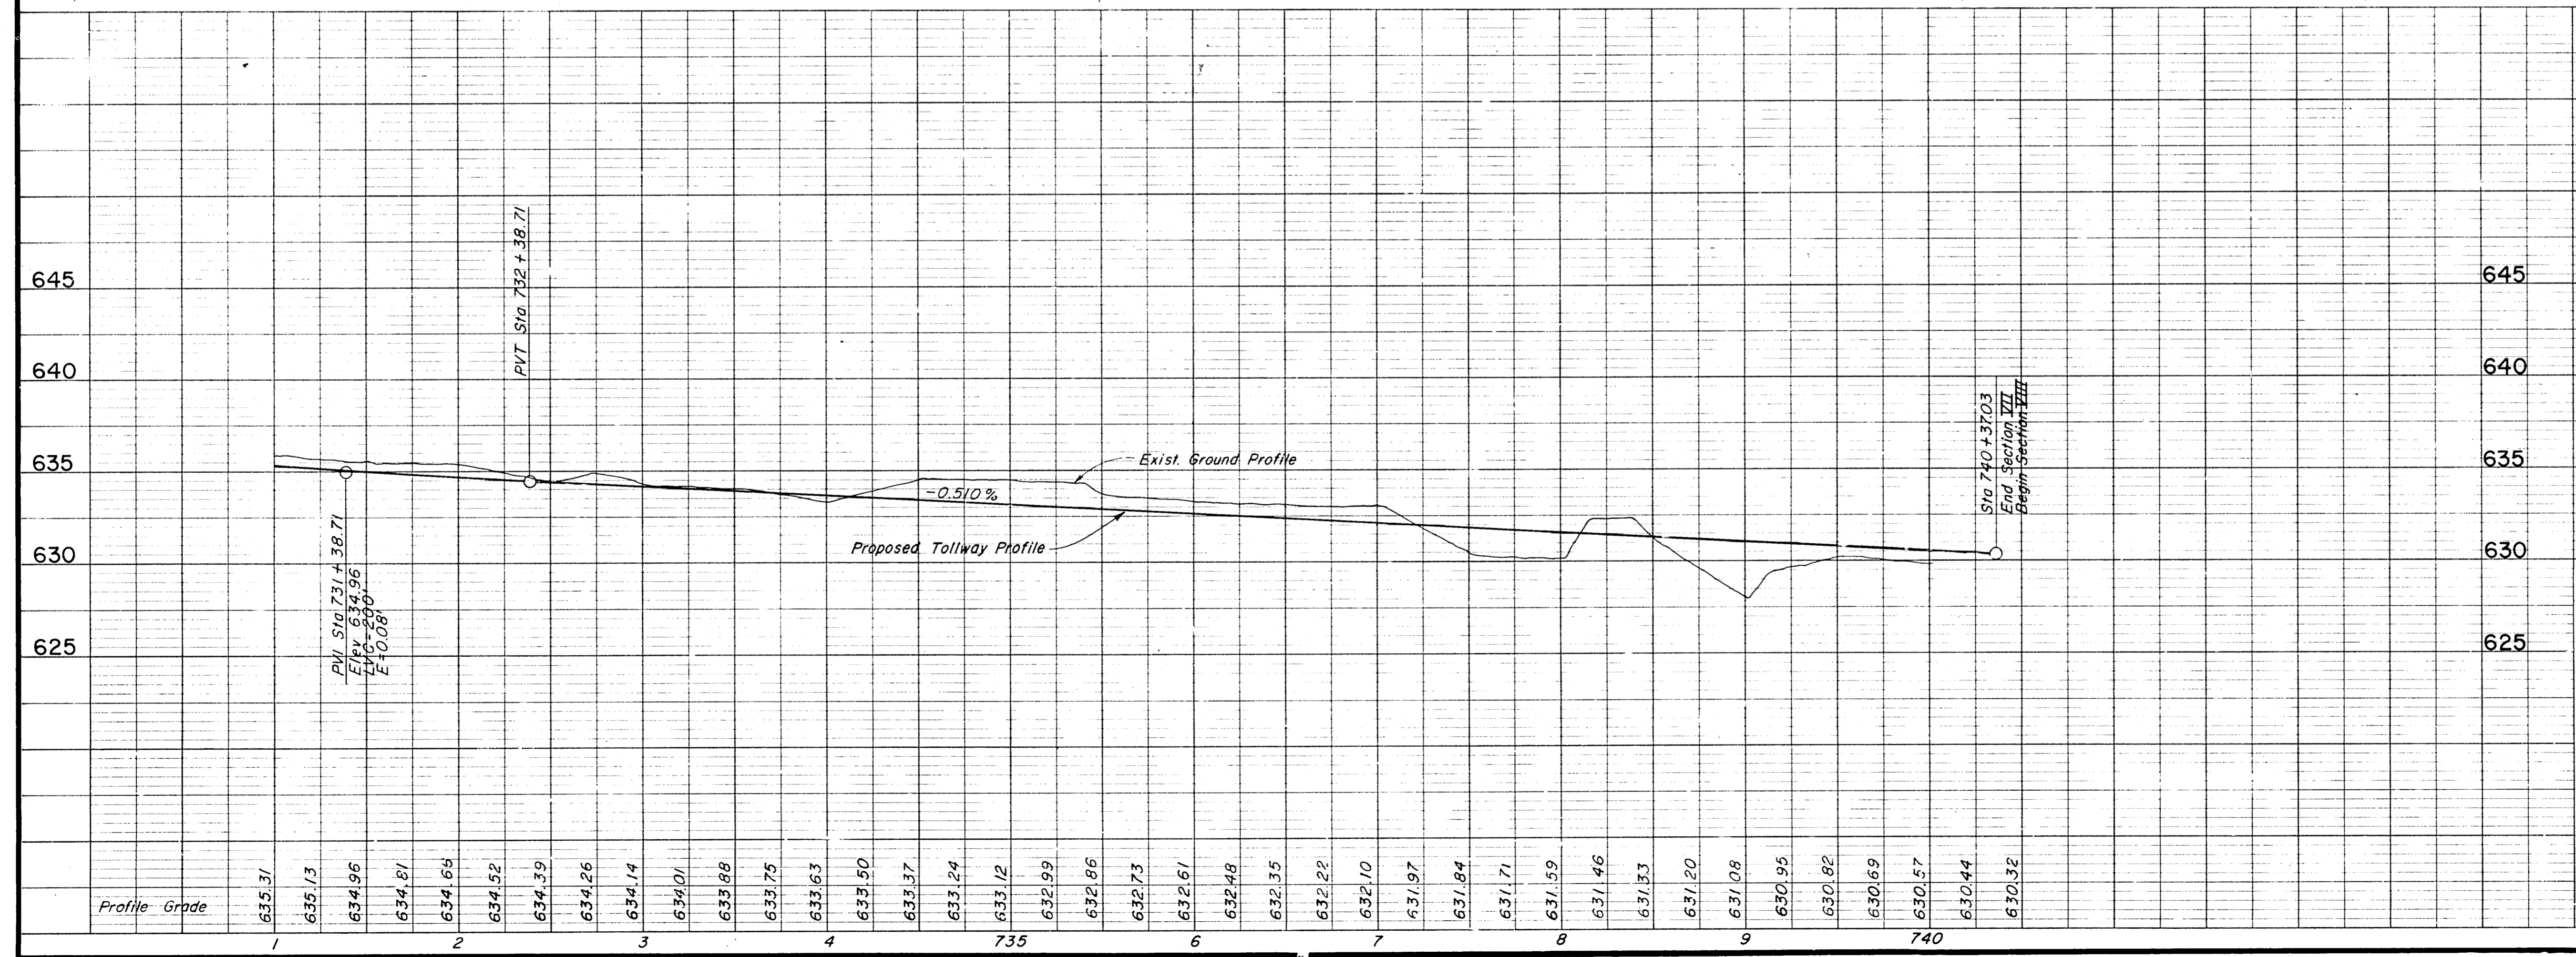

**ASBUILT PLANS**

General Trinity Mills/Briar Grove	GRB	10-9-85
Removed Inlet MB & Replaced with Slotted Drain; Revised R.O.W. Line	B&A	2-5-85
NO.	REVISION	BY DATE

TEXAS TURNPIKE AUTHORITY  
DALLAS NORTH TOLLWAY

PAVING AND GRADING  
TOLLWAY

STA 731+00 TO STA 740+37

**Gibbs & Hill, Inc.**  
ENGINEERS DESIGNERS CONSTRUCTORS  
DALLAS

SECTION VII



DRAWN VER	DATE 7/8/83	DESIGNED DWC	DATE 6/30/83
CHECKED DWC	DATE 5/3/84	SCALE 1"=50' Hor 1"=5' Vert	

CONTRACT NO. DNT-115 SHEET R24 OF R85







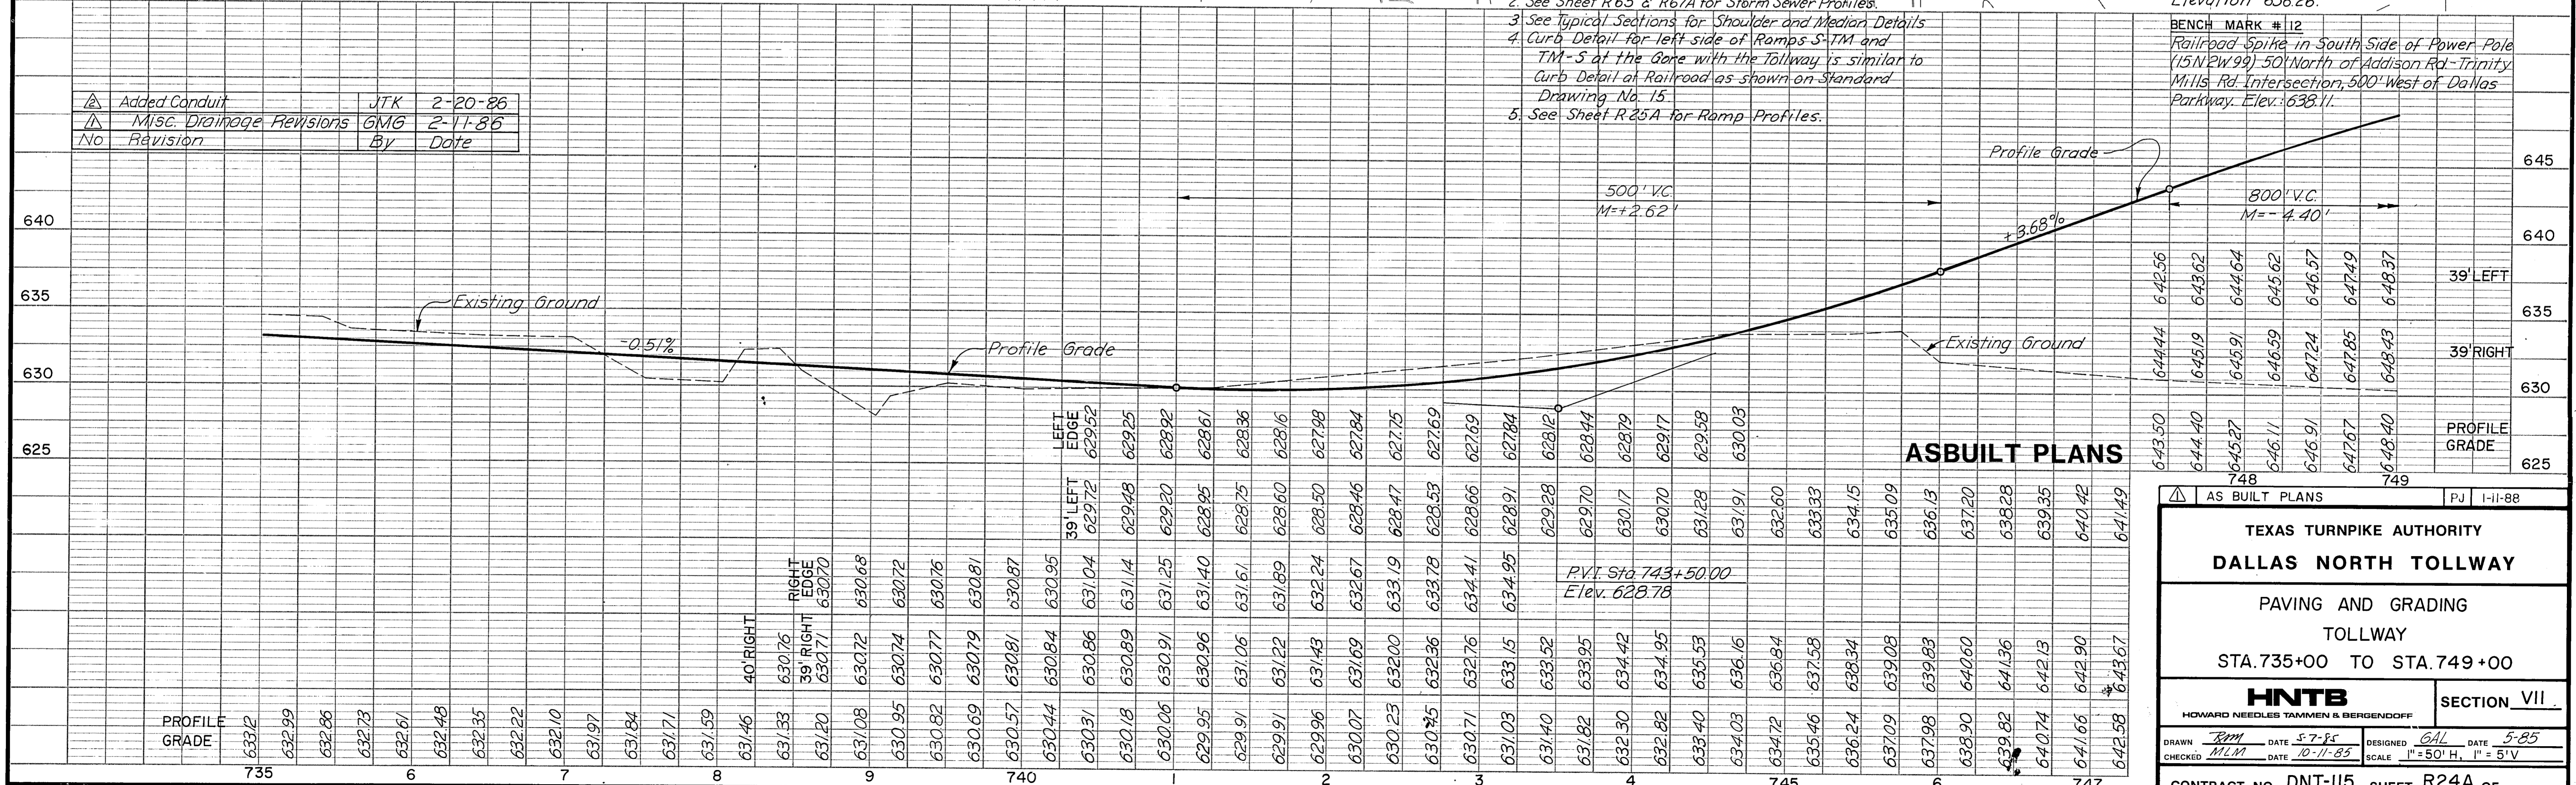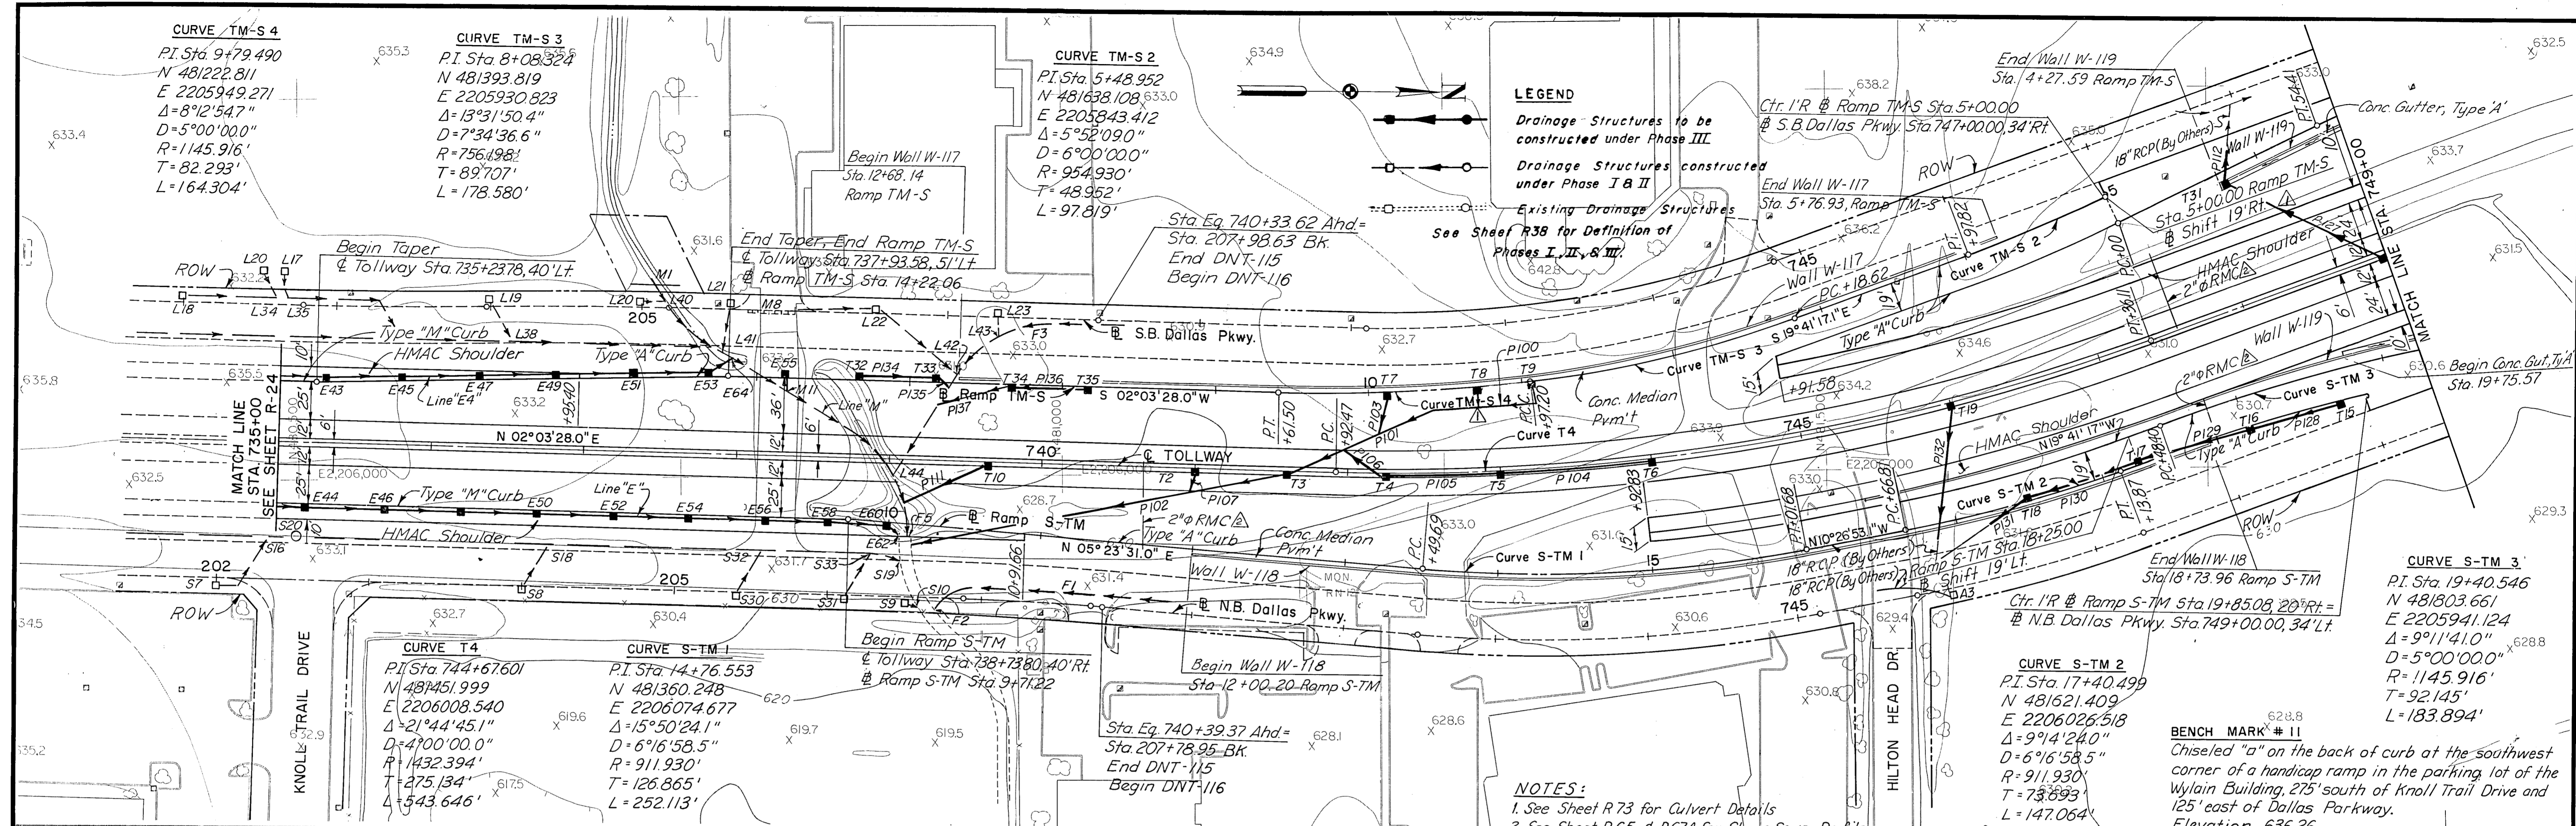

AS BUILT PLANS PJ 1-11-88

TEXAS TURNPIKE AUTHORITY  
**DALLAS NORTH TOLLWAY**  
 PAVING AND GRADING  
 TOLLWAY  
 STA. 735+00 TO STA. 749+00


**HNTB**  
 HOWARD NEEDLES TAMMEN & BERGENDOFF

SECTION VII

DRAWN: RM DATE: 5-7-85 DESIGNED: GAL DATE: 5-85  
 CHECKED: MLM DATE: 10-11-85 SCALE: 1"=50'H, 1"=5'V

CONTRACT NO. DNT-115 SHEET R24A OF



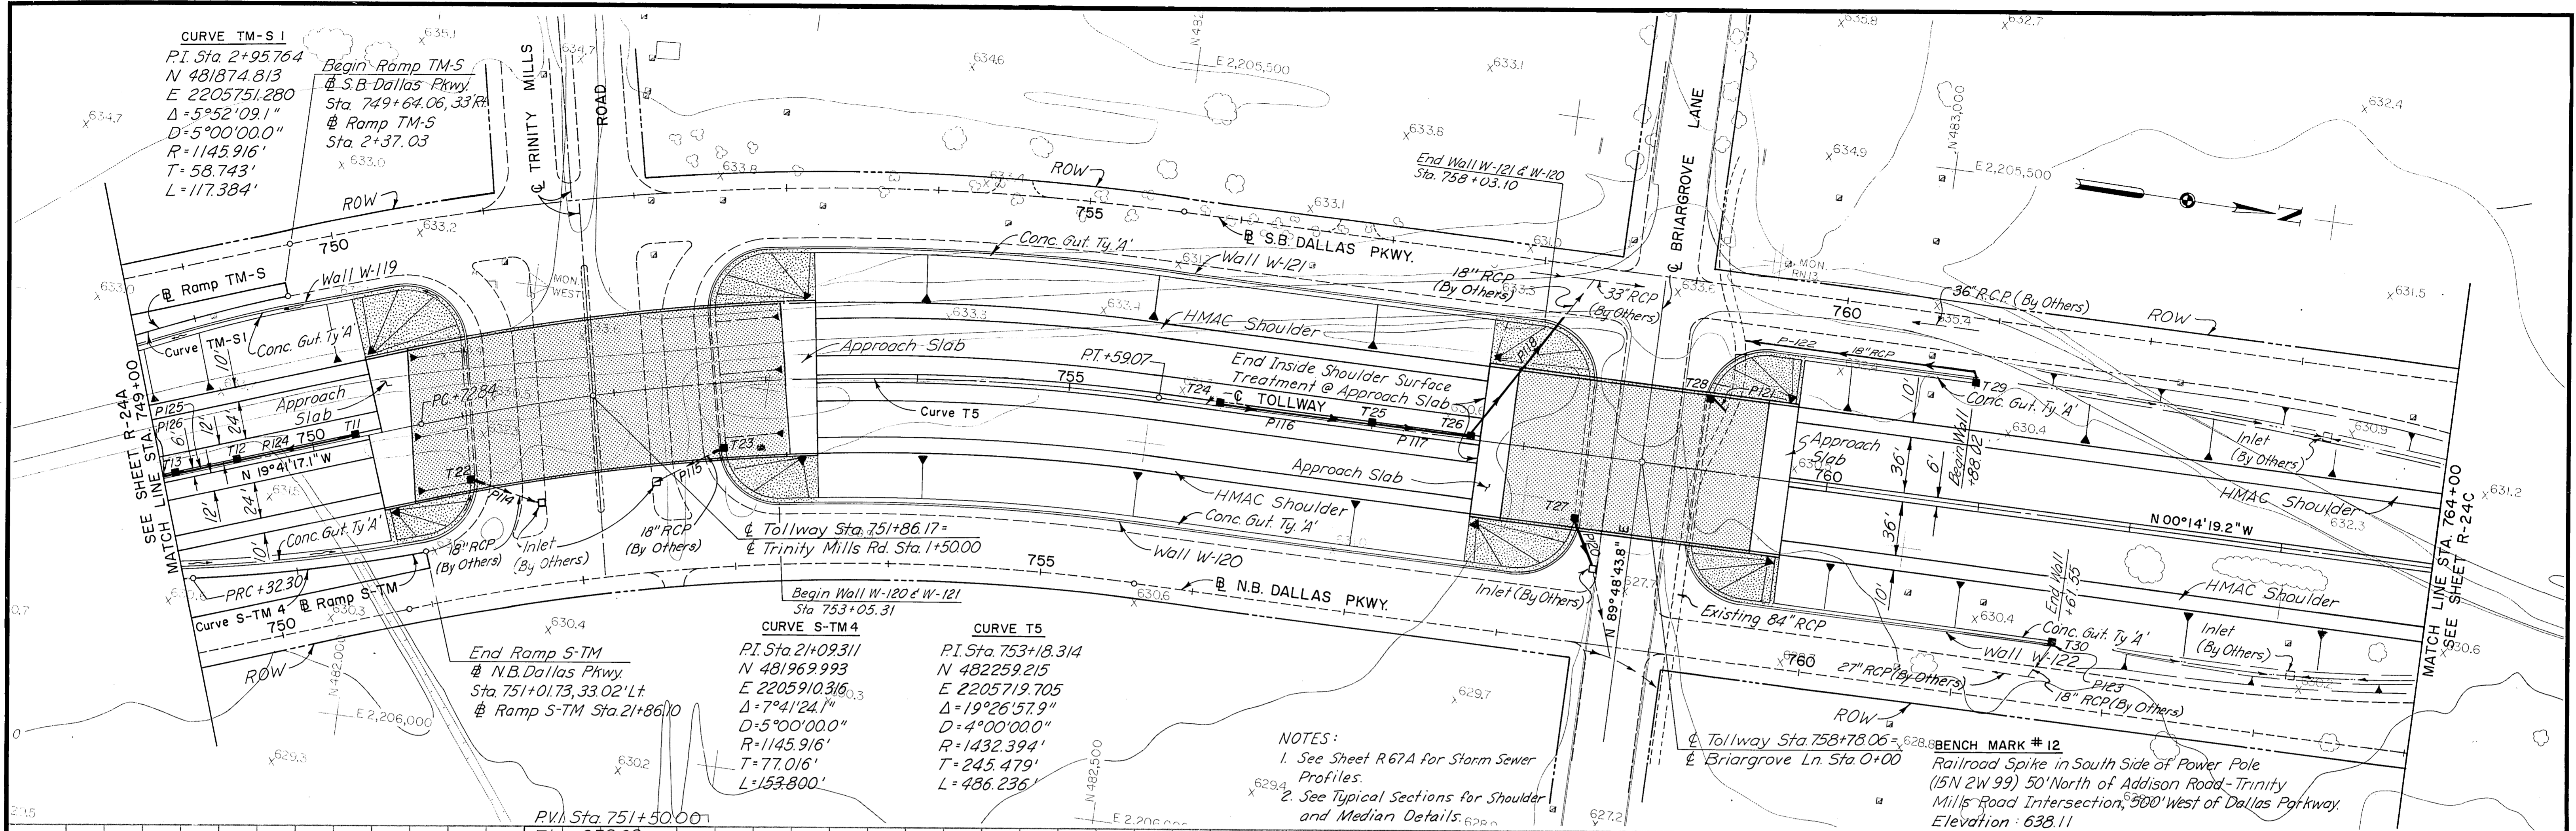

**CURVE TM-S 1**  
 P.I. Sta. 2+95.764  
 N 481874.813  
 E 2205751.280  
 $\Delta = 5^\circ 52' 09.1''$   
 $D = 5^\circ 00' 00.0''$   
 $R = 1145.916'$   
 $T = 58.743'$   
 $L = 117.384'$

**Begin Ramp TM-S**  
 @ S.B. Dallas Pkwy  
 Sta. 749+64.06, 33' RA  
 @ Ramp TM-S  
 Sta. 2+37.03


**End Ramp S-TM**  
 @ N.B. Dallas Pkwy  
 Sta. 751+01.73, 33.02' LT  
 @ Ramp S-TM Sta. 21+86.10

**CURVE S-TM 4**  
 P.I. Sta. 21+09.311  
 N 481969.993  
 E 2205910.316  
 $\Delta = 7^\circ 41' 24.1''$   
 $D = 5^\circ 00' 00.0''$   
 $R = 1145.916'$   
 $T = 77.016'$   
 $L = 153.800'$

**CURVE T5**  
 P.I. Sta. 753+18.314  
 N 482259.215  
 E 2205719.705  
 $\Delta = 19^\circ 26' 57.9''$   
 $D = 4^\circ 00' 00.0''$   
 $R = 1432.394'$   
 $T = 245.479'$   
 $L = 486.236'$


**NOTES:**  
 1. See Sheet R67A for Storm Sewer Profiles.  
 2. See Typical Sections for Shoulder and Median Details.

**BENCH MARK # 12**  
 Railroad Spike in South Side of Power Pole  
 (15N 2W 99) 50' North of Addison Road- Trinity Mills Road Intersection, 500' West of Dallas Parkway.  
 Elevation: 638.11

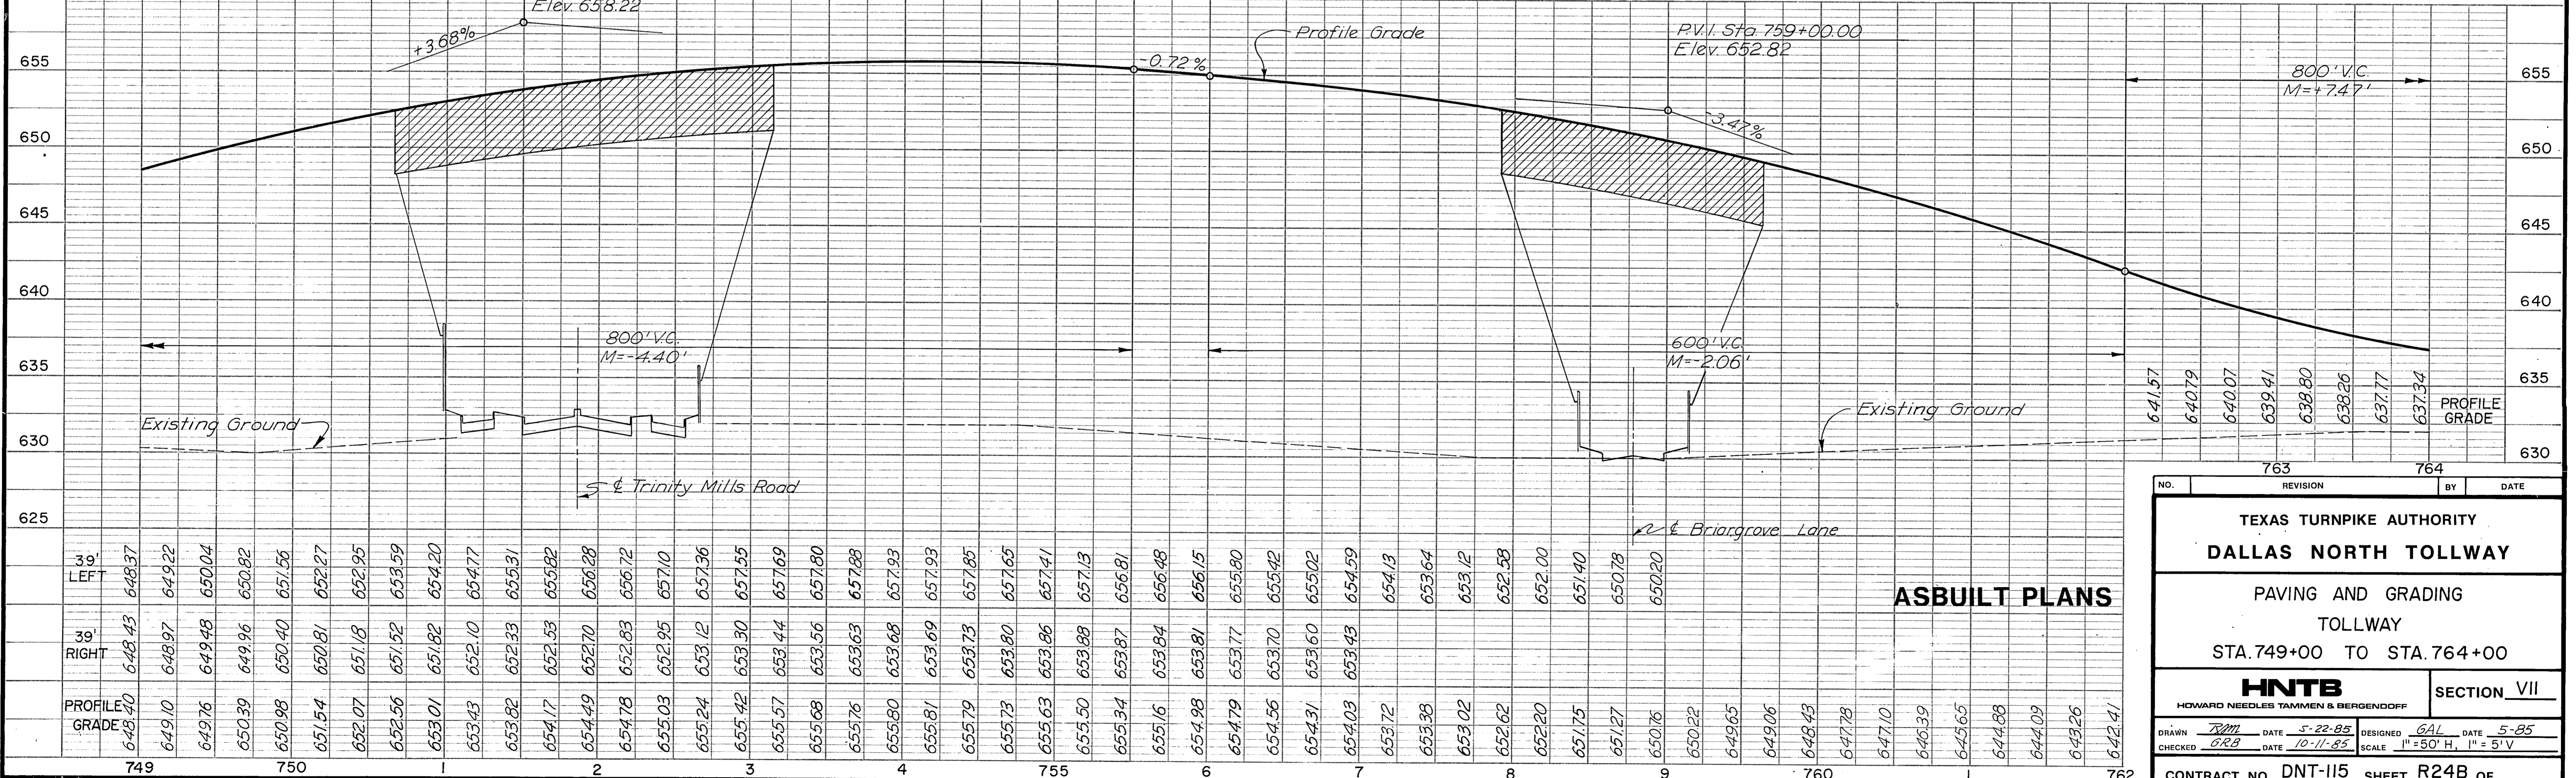

NO.	REVISION	BY	DATE
<b>TEXAS TURNPIKE AUTHORITY</b> <b>DALLAS NORTH TOLLWAY</b> PAVING AND GRADING TOLLWAY STA. 749+00 TO STA. 764+00 <b>HNTB</b> <small>HOWARD NEEDLES TAMMEN &amp; BERGENDOFF</small> <b>SECTION VII</b>			
<small>DRAWN</small> <i>TMM</i> <small>DATE</small> 5-22-85 <small>CHECKED</small> <i>GRB</i> <small>DATE</small> 10-11-85	<small>DESIGNED</small> <i>GAL</i> <small>DATE</small> 5-85 <small>SCALE</small> 1" = 50' H, 1" = 5' V	<b>ASBUILT PLANS</b>	
CONTRACT NO. DNT-115 SHEET R24B OF			



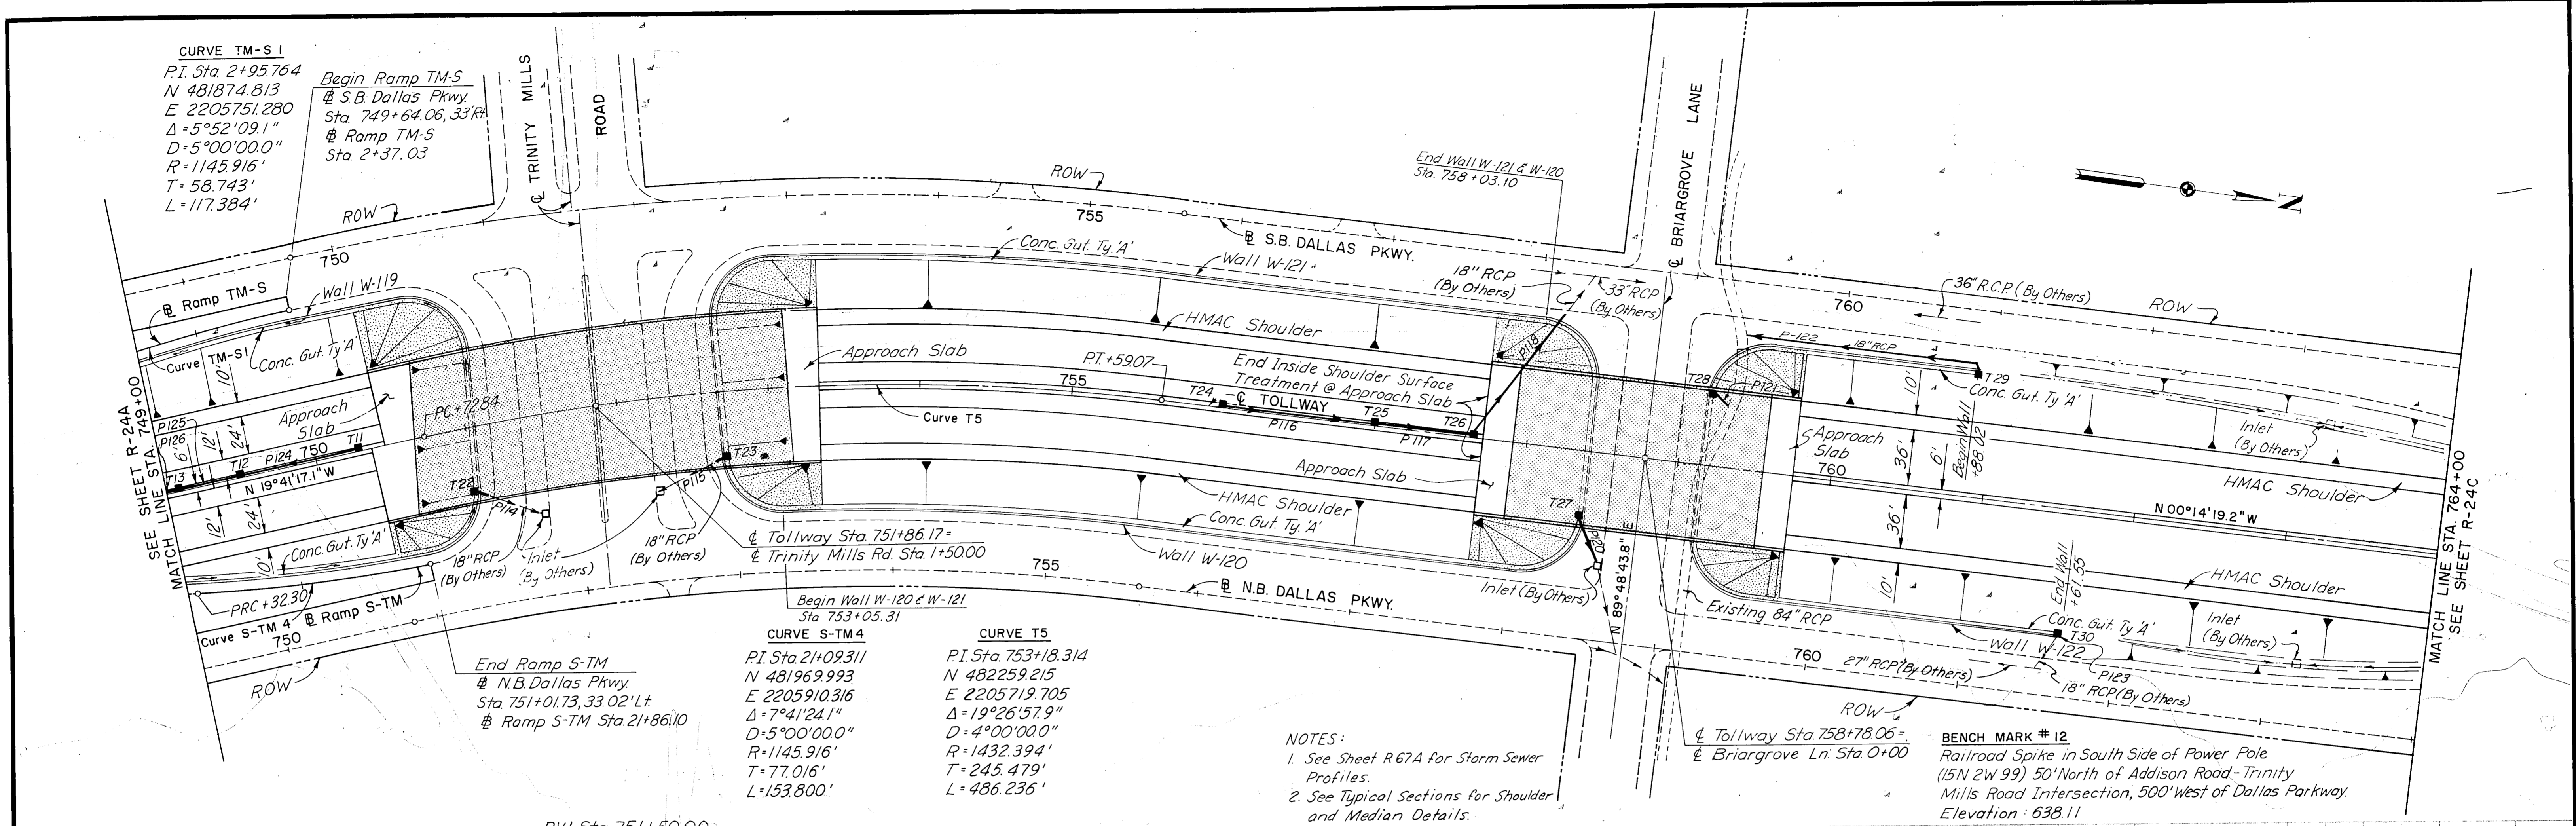

**CURVE TM-S1**  
 P.I. Sta 2+95764  
 N 481874.813  
 E 2205751.280  
 $\Delta = 5^\circ 52' 09.1''$   
 $D = 5^\circ 00' 00.0''$   
 $R = 1145.916'$   
 $T = 58.743'$   
 $L = 117.384'$

Begin Ramp TM-S  
 @ S.B. Dallas Pkwy.  
 Sta. 749+64.06, 33' R/L  
 @ Ramp TM-S  
 Sta. 2+37.03


End Ramp S-TM  
 @ N.B. Dallas Pkwy.  
 Sta. 751+01.73, 33.02' L/R  
 @ Ramp S-TM Sta. 2+186.10

**CURVE S-TM4**  
 P.I. Sta 2+09311  
 N 481969.993  
 E 2205910.316  
 $\Delta = 7^\circ 41' 24.1''$   
 $D = 5^\circ 00' 00.0''$   
 $R = 1145.916'$   
 $T = 77.016'$   
 $L = 153.800'$

**CURVE T5**  
 P.I. Sta. 753+18.314  
 N 482259.215  
 E 2205719.705  
 $\Delta = 19^\circ 26' 57.9''$   
 $D = 4^\circ 00' 00.0''$   
 $R = 1432.394'$   
 $T = 245.479'$   
 $L = 486.236'$

**NOTES:**  
 1. See Sheet R67A for Storm Sewer Profiles.  
 2. See Typical Sections for Shoulder and Median Details.

**BENCH MARK #12**  
 Railroad Spike in South Side of Power Pole  
 (15N 2W 99) 50' North of Addison Road - Trinity  
 Mills Road Intersection, 500' West of Dallas Parkway  
 Elevation: 638.11

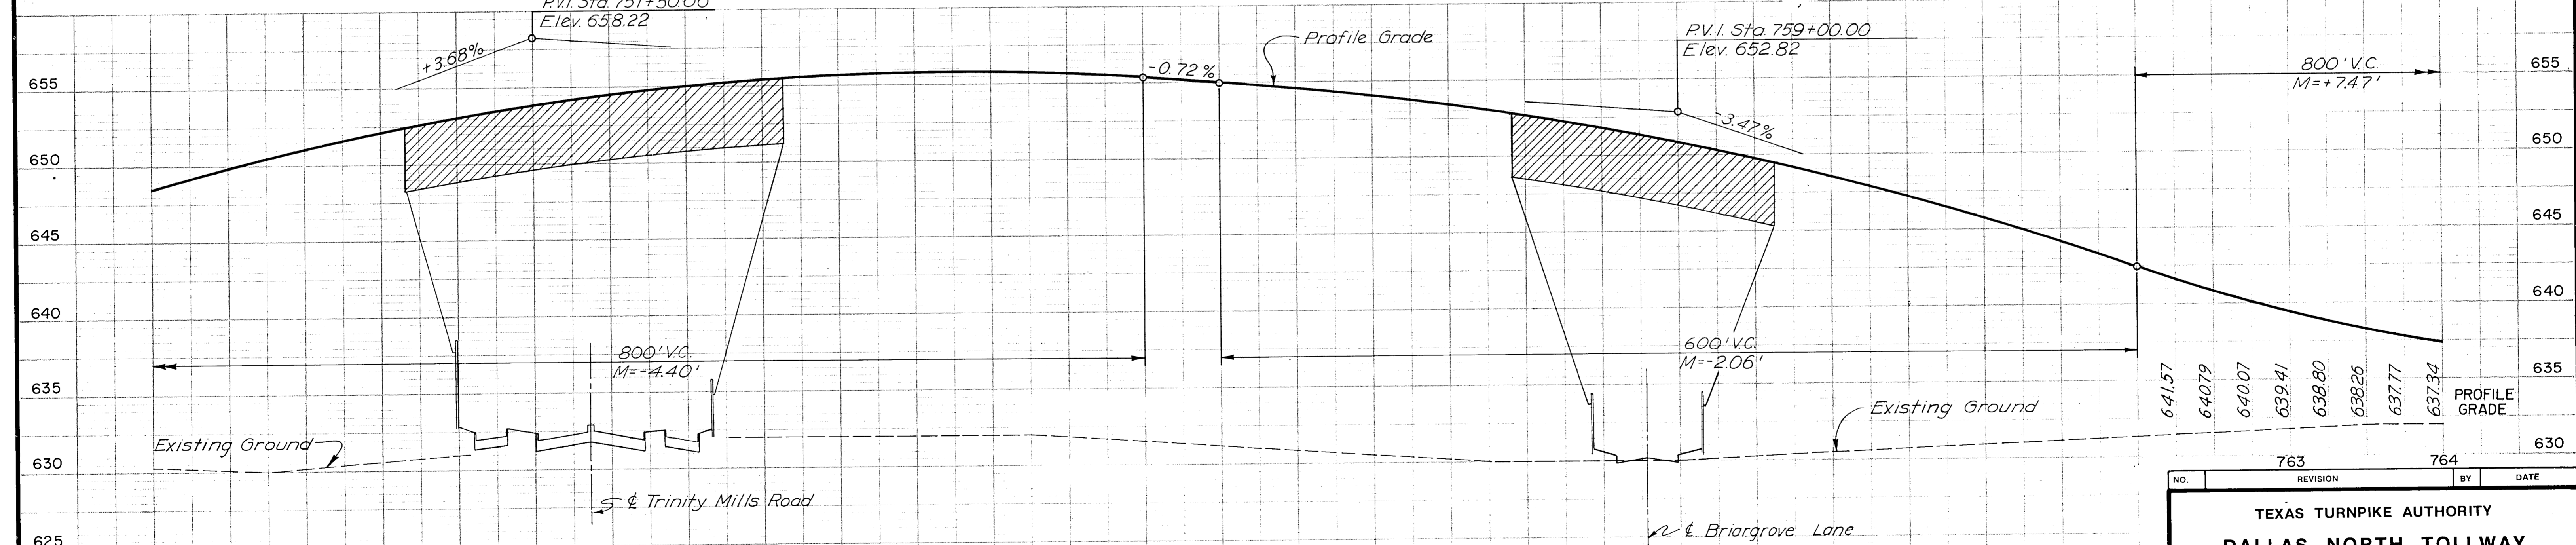


39' LEFT	648.37	649.22	650.04	650.82	651.56	652.27	652.95	653.59	654.20	654.77	655.31	655.82	656.28	656.72	657.10	657.36	657.55	657.69	657.80	657.88	657.93	657.93	657.85	657.65	657.41	657.13	656.81	656.48	656.15	655.80	655.42	655.02	654.59	654.13	653.64	653.12	652.58	652.00	651.40	650.78	650.20	649.65	649.06	648.43	647.78	647.10	646.39	645.65	644.88	644.03	643.26	642.41	
39' RIGHT	648.43	648.97	649.48	649.96	650.40	650.81	651.18	651.52	651.82	652.10	652.33	652.53	652.70	652.83	652.95	653.12	653.30	653.44	653.56	653.63	653.68	653.69	653.73	653.80	653.86	653.87	653.84	653.81	653.77	653.70	653.60	653.43	653.22	652.98	652.62	652.20	651.75	651.27	650.76	650.22	649.65	649.06	648.43	647.78	647.10	646.39	645.65	644.88	644.03	643.26	642.41		
PROFILE GRADE	648.40	649.10	649.76	650.39	650.98	651.54	652.07	652.56	653.01	653.43	653.82	654.17	654.49	654.78	655.03	655.24	655.42	655.57	655.68	655.76	655.80	655.81	655.79	655.73	655.63	655.50	655.34	655.16	654.98	654.79	654.56	654.31	654.03	653.72	653.38	653.02	652.62	652.20	651.75	651.27	650.76	650.22	649.65	649.06	648.43	647.78	647.10	646.39	645.65	644.88	644.03	643.26	642.41

**ASBUILT PLANS**


NO.	REVISION	BY	DATE
TEXAS TURNPIKE AUTHORITY DALLAS NORTH TOLLWAY			
PAVING AND GRADING TOLLWAY STA. 749+00 TO STA. 764+00			
<b>HNTB</b> HOWARD NEEDLES TAMMEN & BERGENDOFF			SECTION VII
DRAWN	DATE	DESIGNED	DATE
GRB	5-22-85	GAL	5-85
CHECKED	DATE	SCALE	
GRB	10-11-85	1" = 50' H, 1" = 5' V	
CONTRACT NO. DNT-115 SHEET R24B OF			



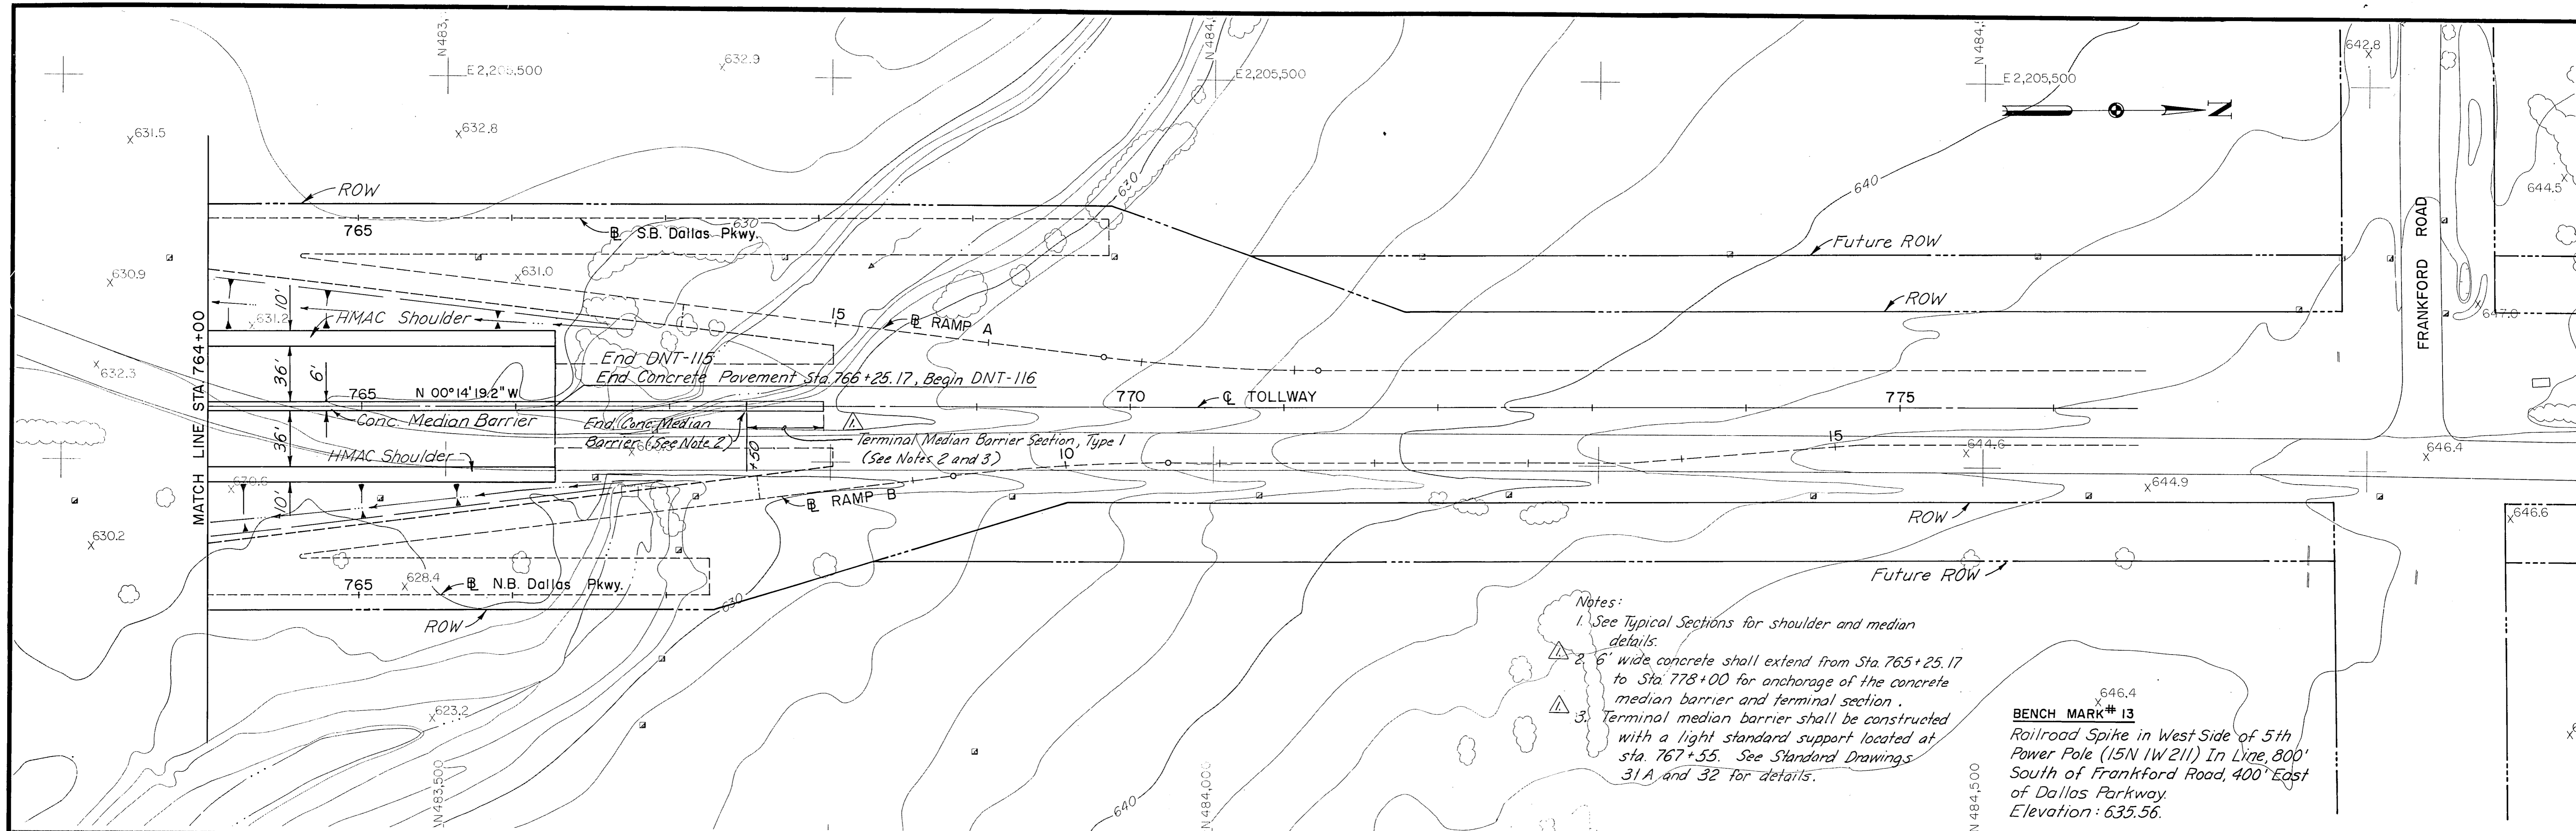

- Notes:
1. See Typical Sections for shoulder and median details.
  2. 6' wide concrete shall extend from Sta. 765+25.17 to Sta. 778+00 for anchorage of the concrete median barrier and terminal section.
  3. Terminal median barrier shall be constructed with a light standard support located at sta. 767+55. See Standard Drawings 31A and 32 for details.

**BENCH MARK # 13**  
 Railroad Spike in West Side of 5th Power Pole (15N 1W 211) In Line, 800' South of Frankford Road, 400' East of Dallas Parkway.  
 Elevation: 635.56.

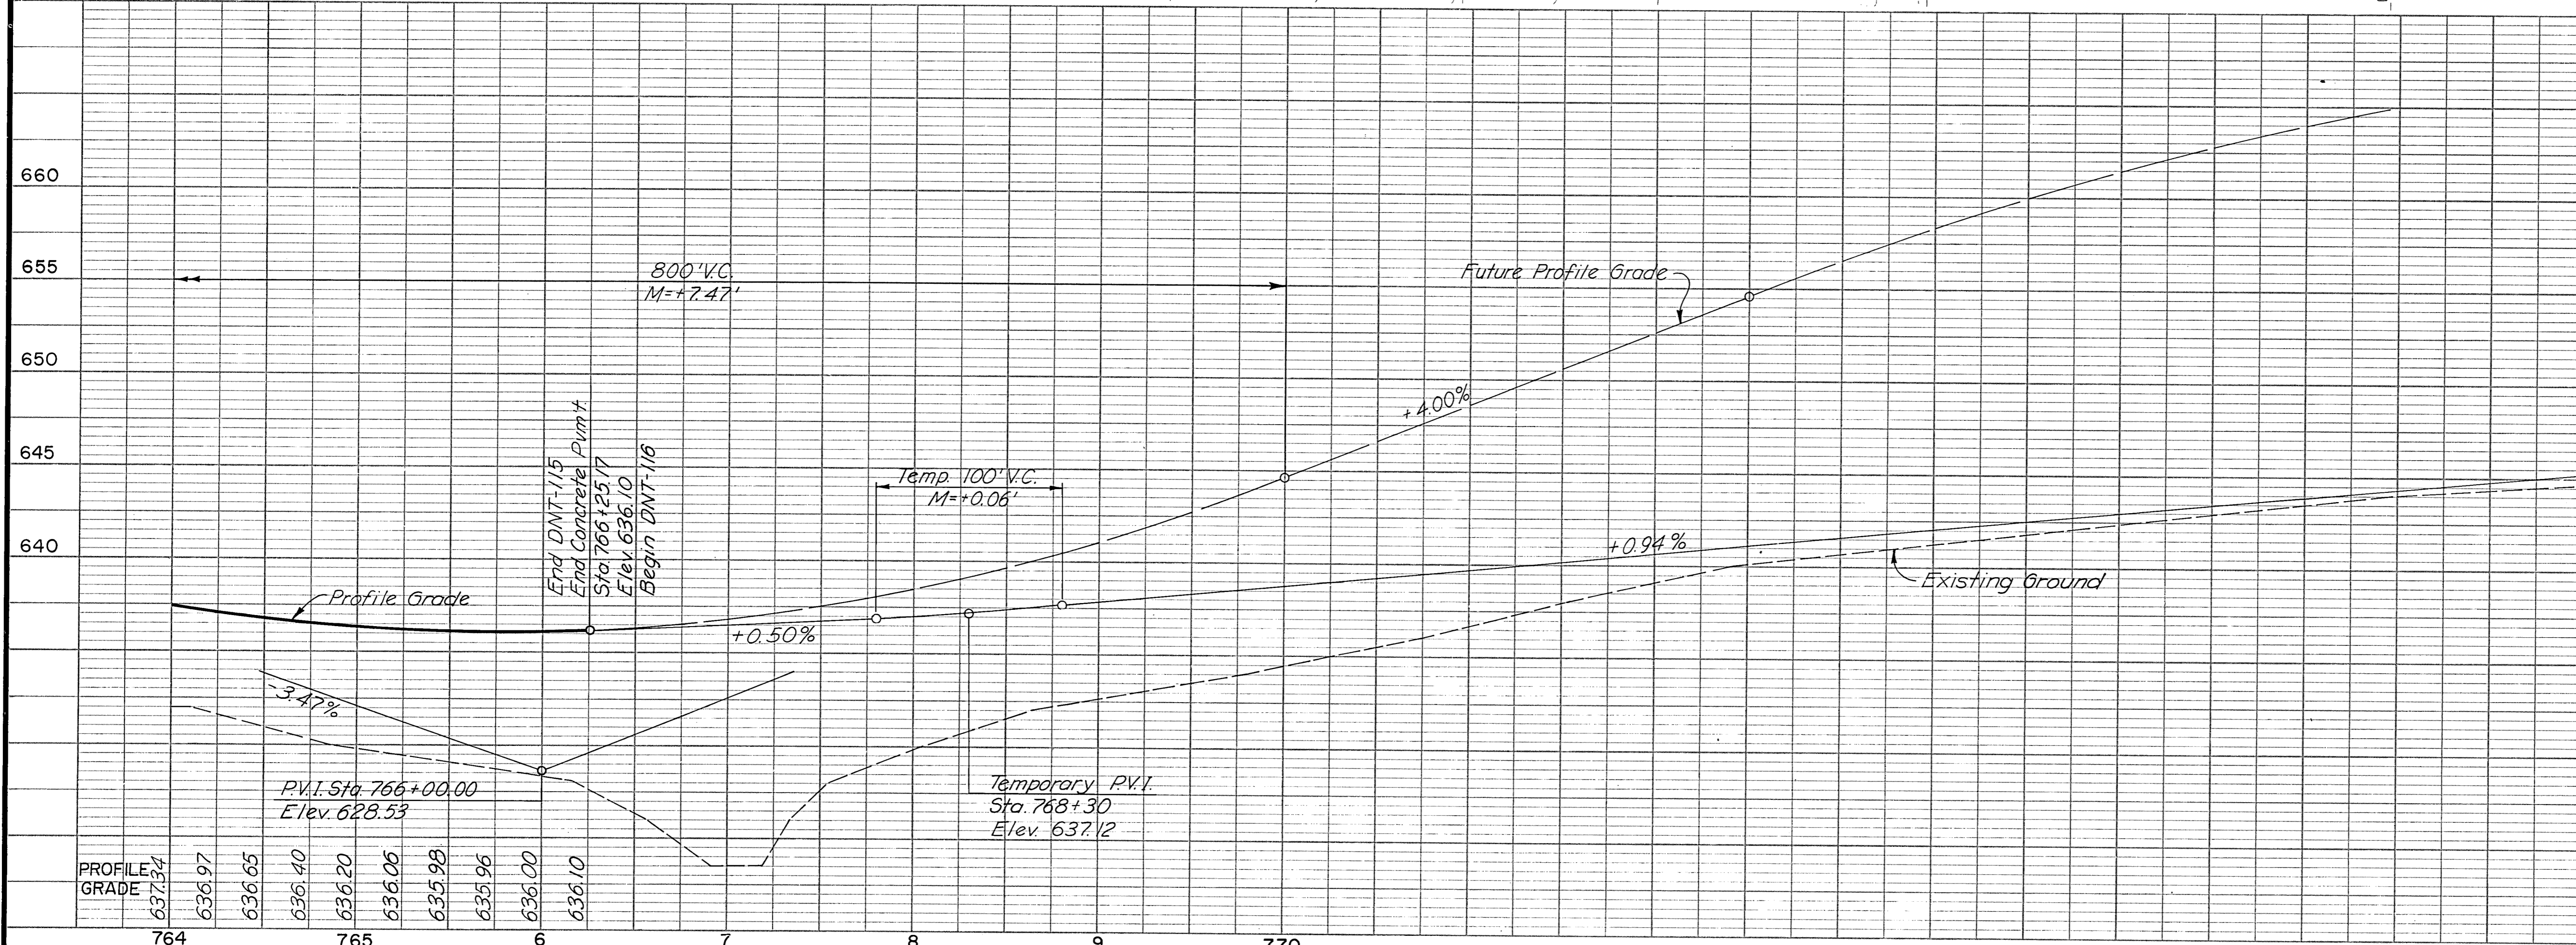

**ASBUILT PLANS**

NO.	REVISION	BY	DATE
	Extend Conc. Median Barrier	GRB	4-10-86

**TEXAS TURNPIKE AUTHORITY**  
**DALLAS NORTH TOLLWAY**

PAVING AND GRADING  
 TOLLWAY  
 STA. 764+00 TO STA. 766+25.17


**HNTB**  
 HOWARD NEEDLES TAMMEN & BERGENDOFF

SECTION VII

DRAWN	Rem	DATE	5-30-85	DESIGNED	Sal	DATE	5-85
CHECKED	GRB	DATE	10-11-85	SCALE	1" = 50' H, 1" = 5' V		


CONTRACT NO. DNT-115 SHEET R24C OF



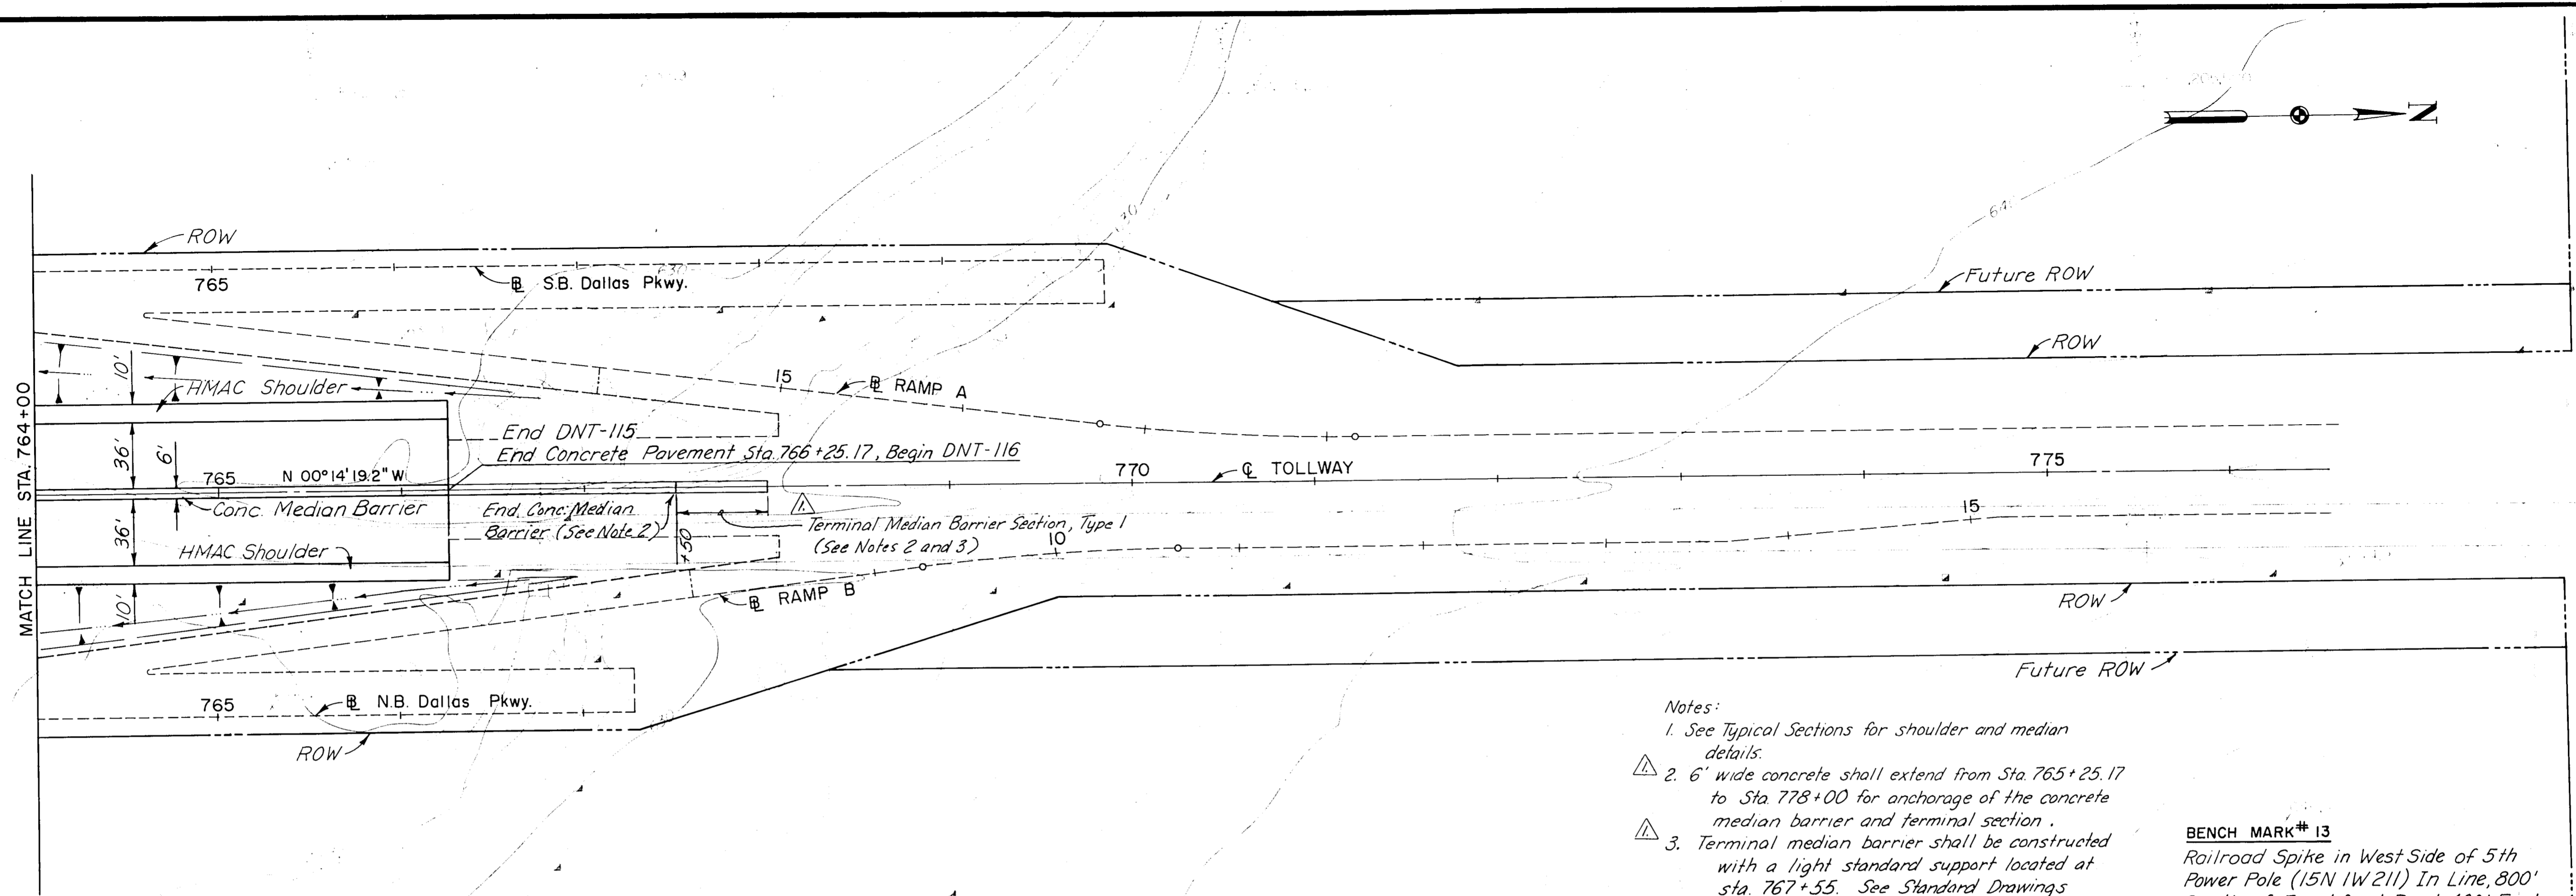

- Notes:
1. See Typical Sections for shoulder and median details.
  2. 6' wide concrete shall extend from Sta. 765+25.17 to Sta. 778+00 for anchorage of the concrete median barrier and terminal section.
  3. Terminal median barrier shall be constructed with a light standard support located at sta. 767+55. See Standard Drawings 31A and 32 for details.



**BENCH MARK # 13**  
 Railroad Spike in West Side of 5th Power Pole (15N 1W 211) In Line, 800' South of Frankford Road, 400' East of Dallas Parkway  
 Elevation: 635.56.

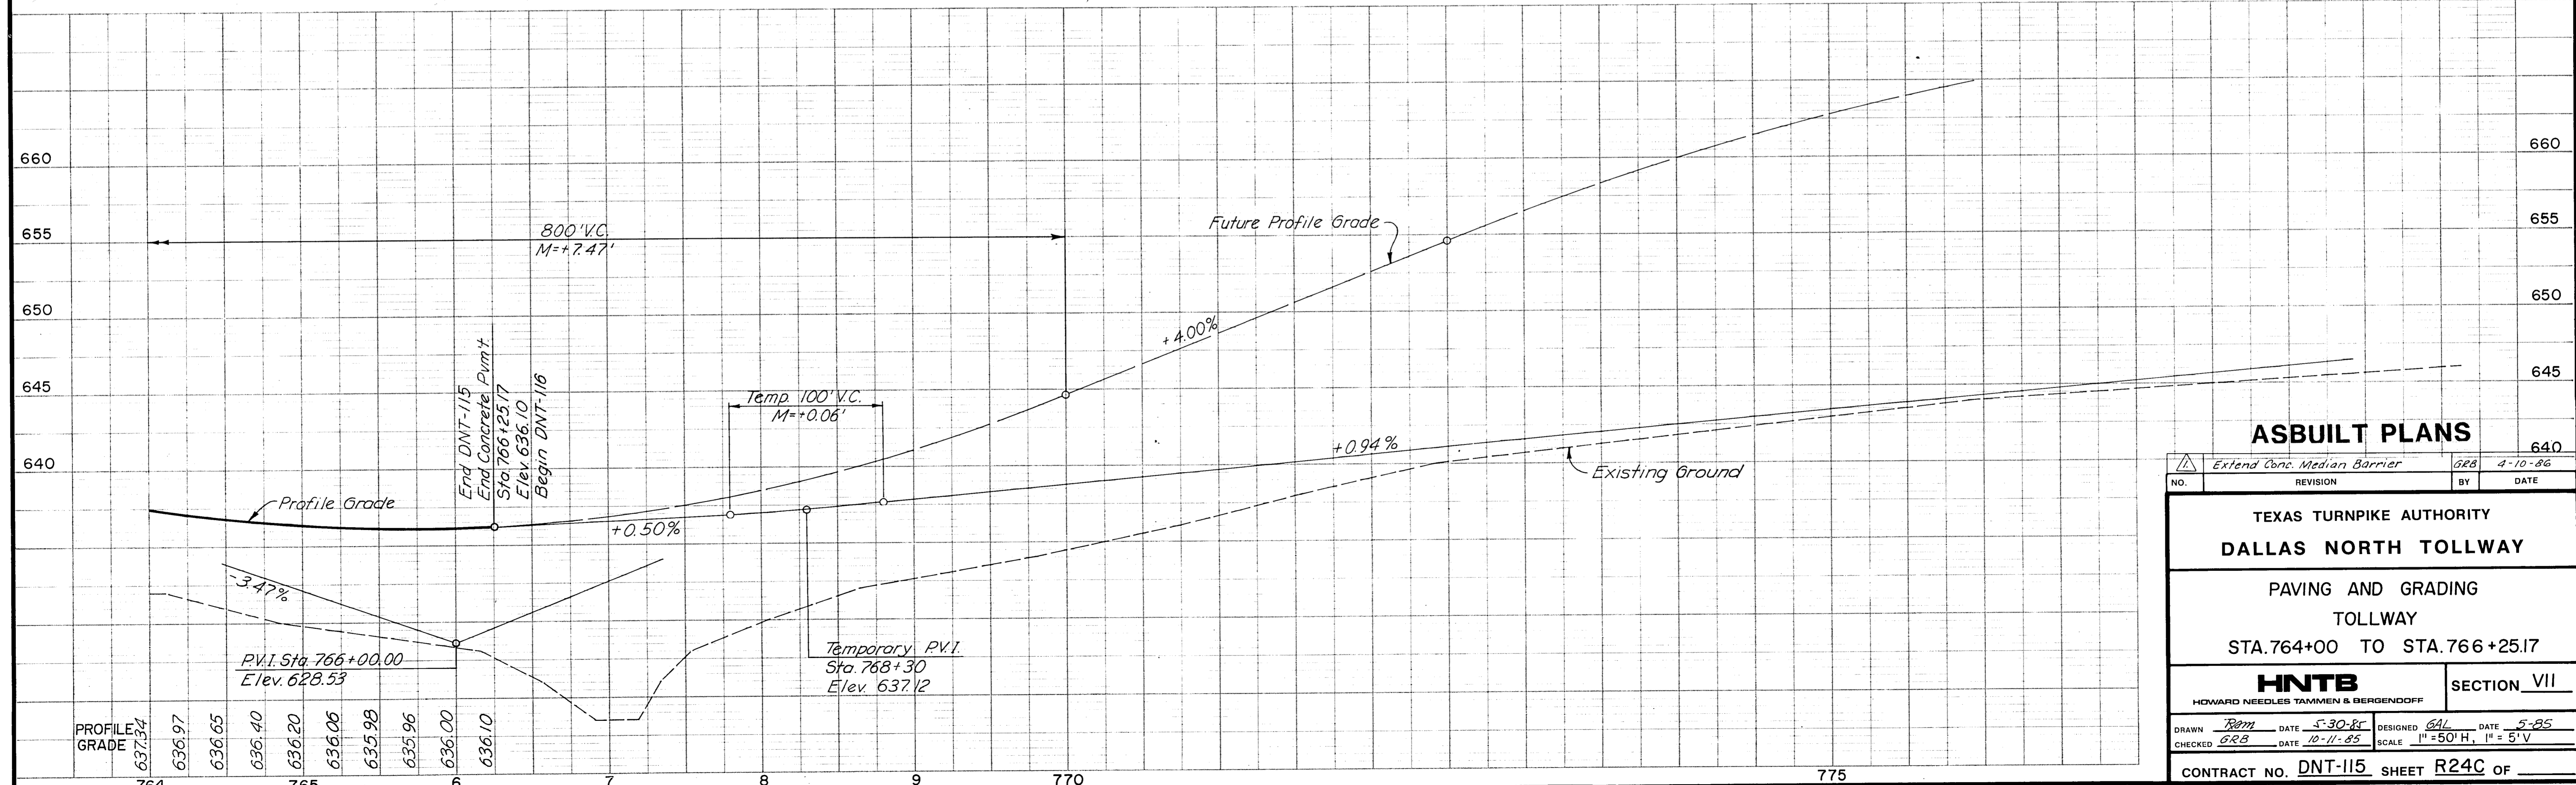

**ASBUILT PLANS**

NO. REVISION Extend Conc. Median Barrier	BY GRB	DATE 4-10-86
<b>TEXAS TURNPIKE AUTHORITY</b>		
<b>DALLAS NORTH TOLLWAY</b>		
PAVING AND GRADING TOLLWAY		
STA. 764+00 TO STA. 766+25.17		
<b>HNTB</b> <small>HOWARD NEEDLES TAMMEN &amp; BERGENDOFF</small>		SECTION VII
DRAWN <i>Rpm</i> DATE <i>5-30-85</i> CHECKED <i>GRB</i> DATE <i>10-11-85</i>	DESIGNED <i>SL</i> DATE <i>5-85</i> SCALE 1" = 50' H, 1" = 5' V	
CONTRACT NO. <b>DNT-115</b> SHEET <b>R24C</b> OF		



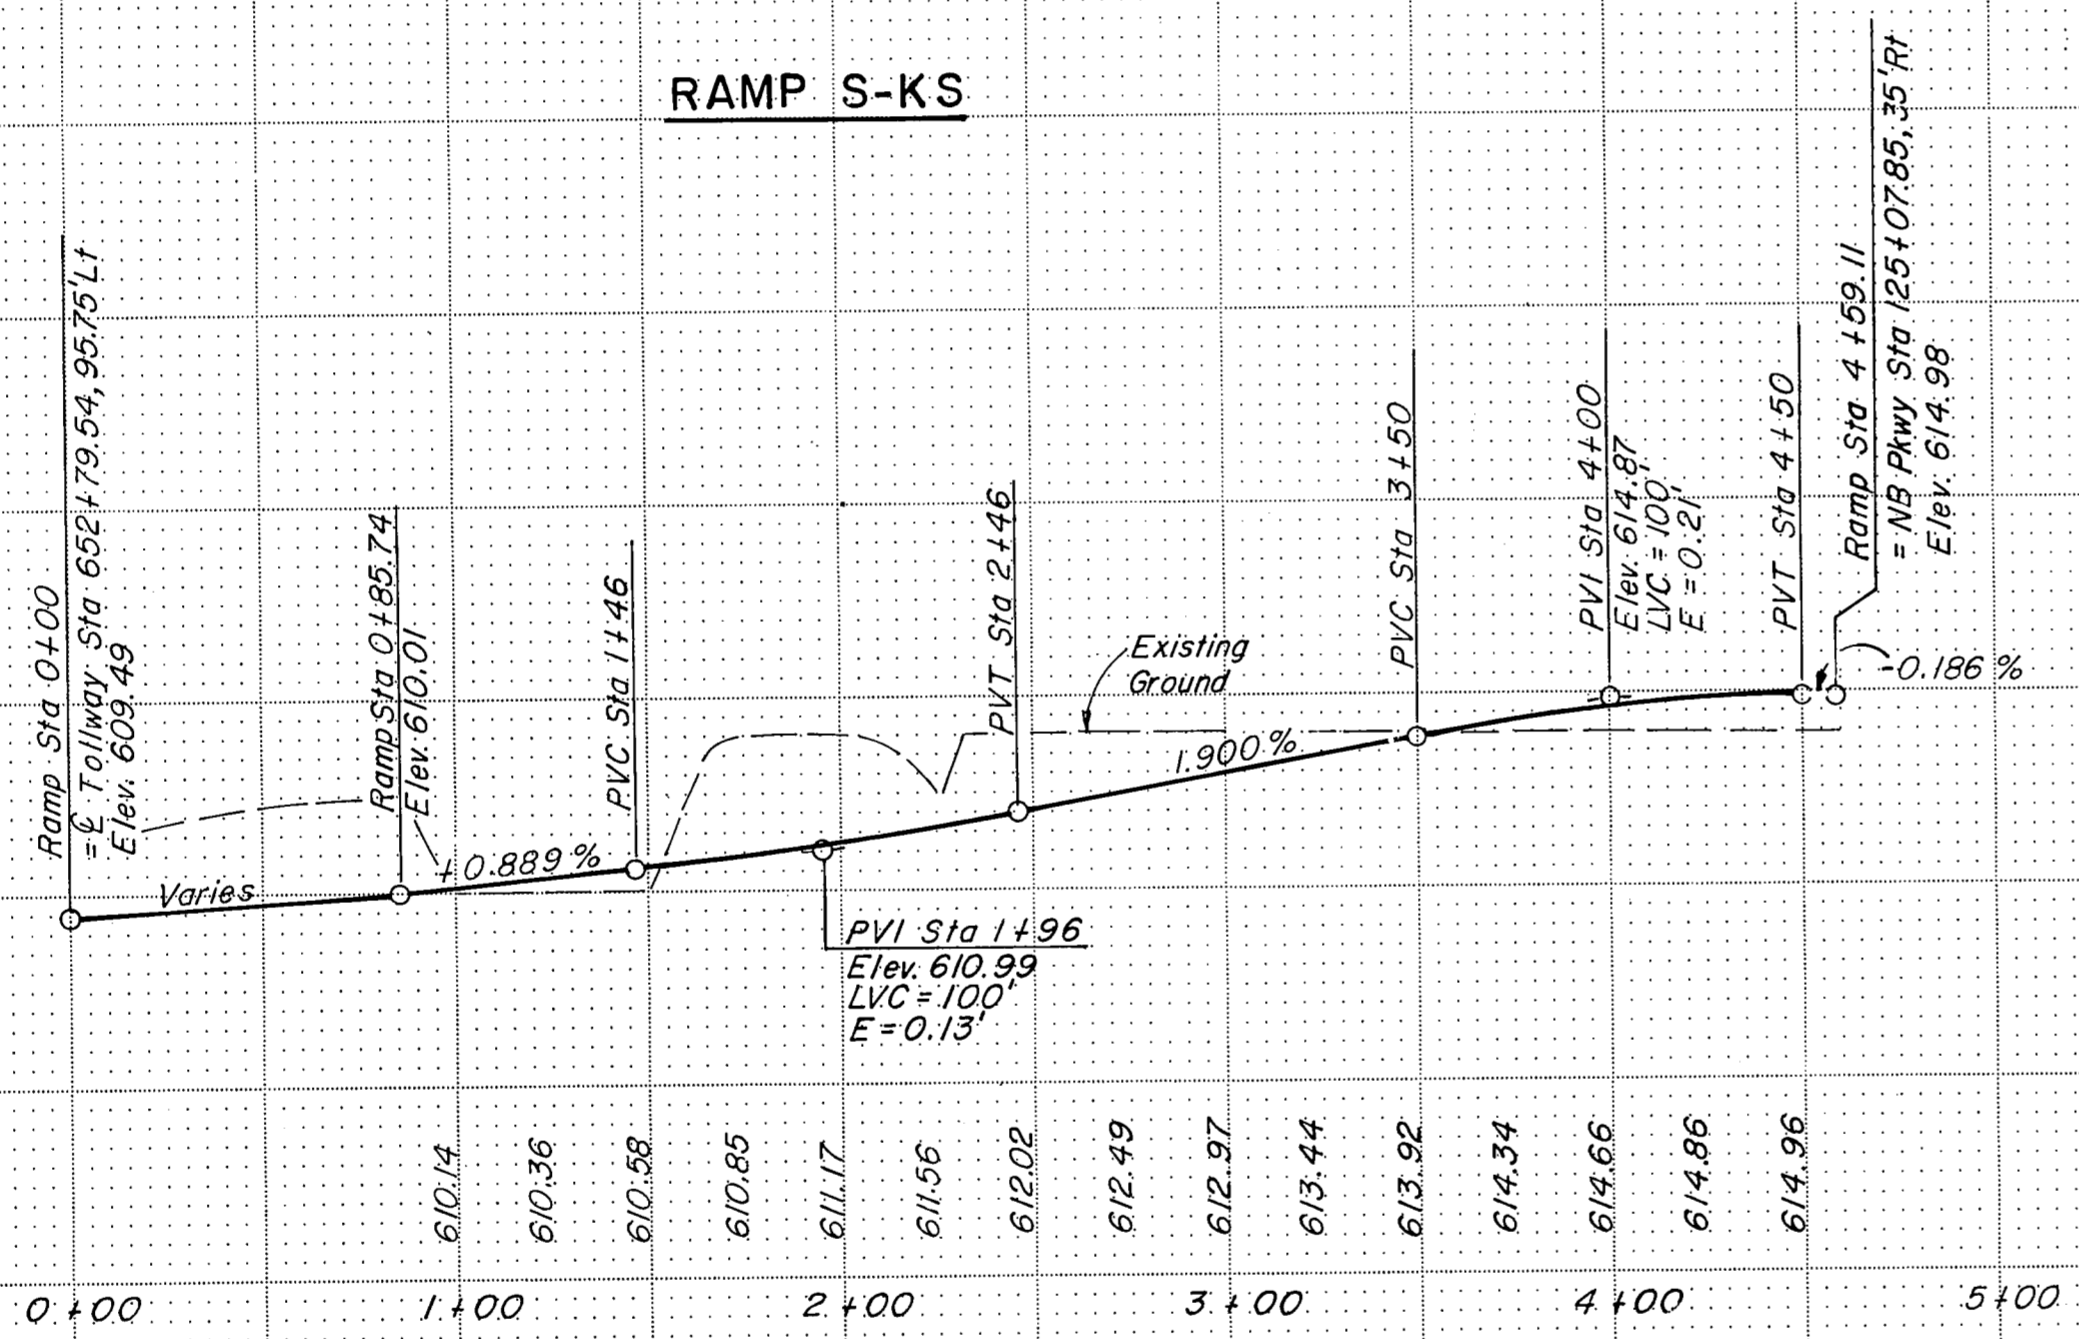
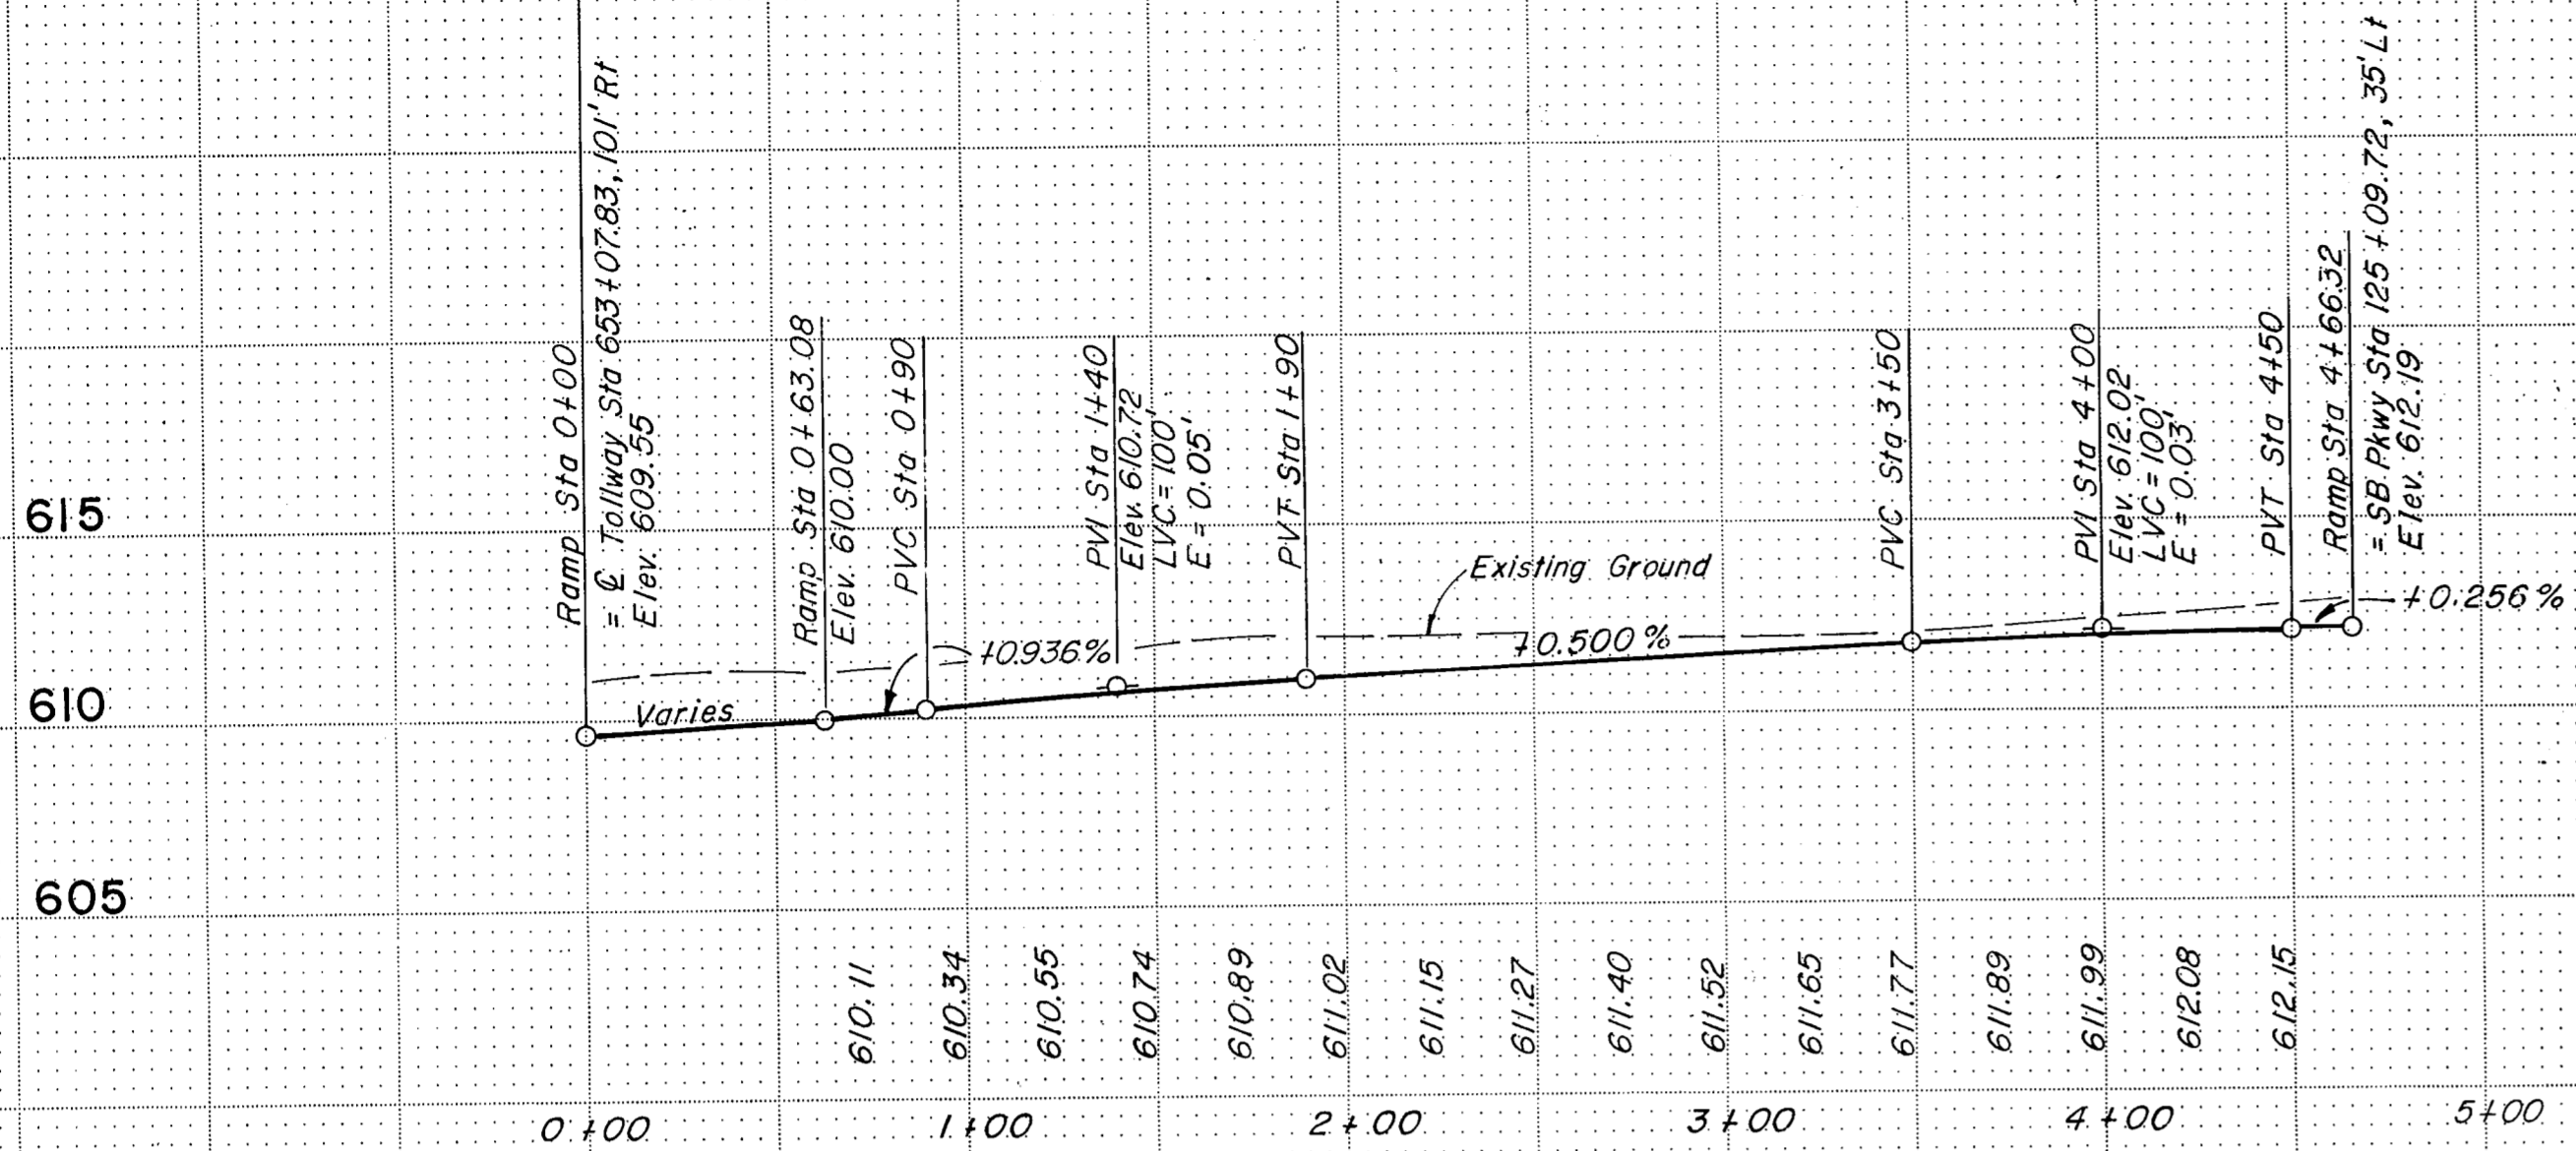


NOTE: See Paving Plan Sheets R27 And R28 For Additional Elevations.

**ASBUILT PLANS**

NO.	REVISION	BY	DATE
TEXAS TURNPIKE AUTHORITY DALLAS NORTH TOLLWAY			
RAMP PROFILES			
<b>Gibbs &amp; Hill, Inc.</b>			
MADE	MGB	DATE 4/24/84	TRACED MAV
CHECKED	DWC	DATE 7/28/84	SCALE 1"=50' Hor 1"=5' Vert
CONTRACT NO. <b>DNT-115</b> SHEET <b>R25</b> OF <b>R85</b>			



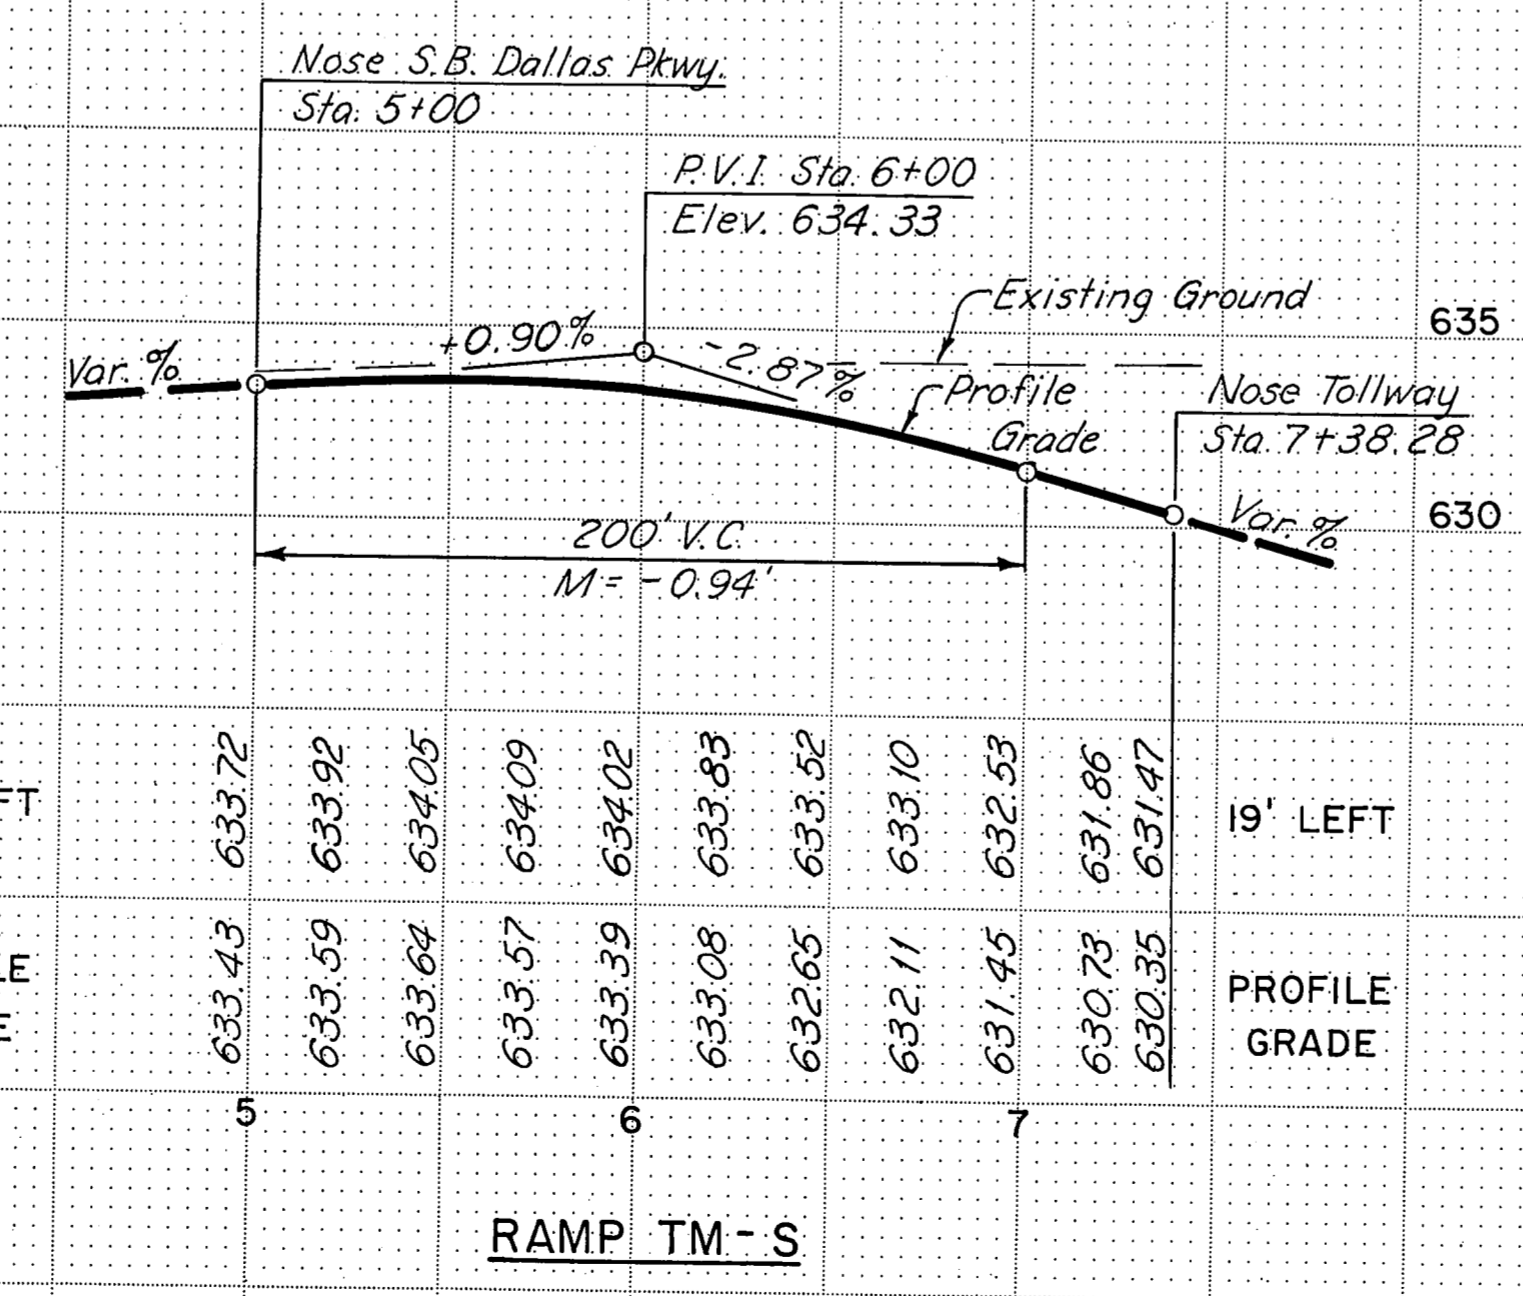
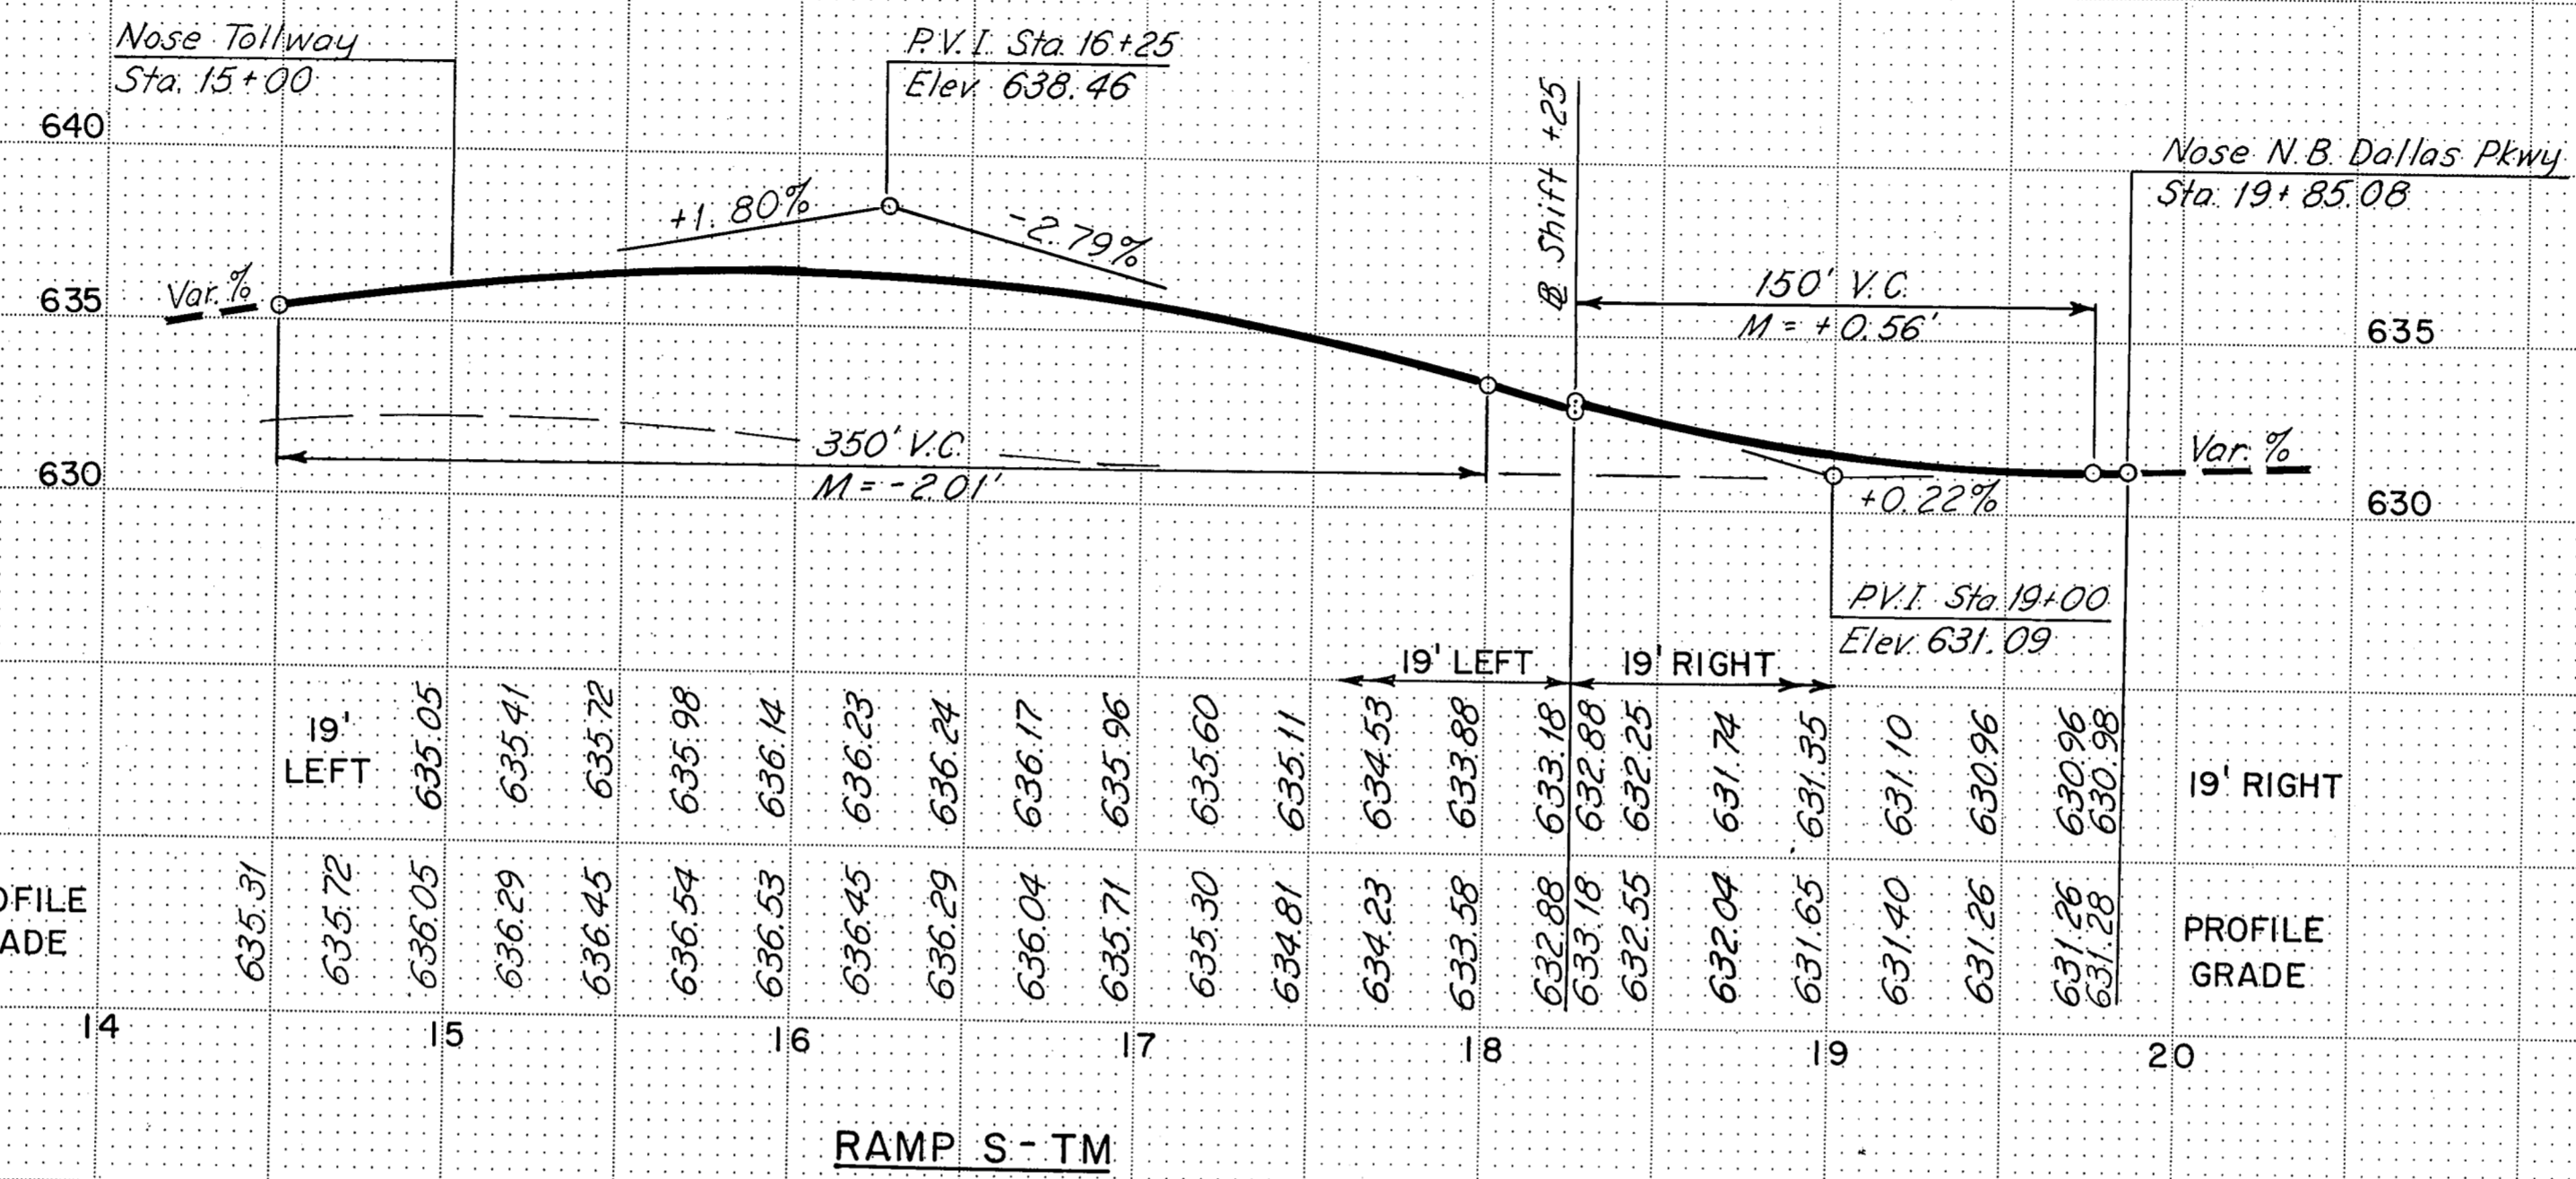


**ASBUILT PLANS**

NO.	REVISION	BY	DATE
<b>TEXAS TURNPIKE AUTHORITY</b>			
<b>DALLAS NORTH TOLLWAY</b>			
RAMP PROFILES			
RAMP S-TM AND RAMP TM-S			
<b>HNTB</b> <small>HERRARD HERRICKS TAYLOR &amp; BERNHARDT</small>		SECTION _____	
DRAWN: GRB	DATE: 9-85	DESIGNED: GAL	DATE: 5-85
CHECKED: WAP	DATE: 5-85	SCALE: 1"=50'H; 1"=5'V	
CONTRACT NO. DNT-115 SHEET R 25A OF _____			

TELETYPE POST 11/8/80



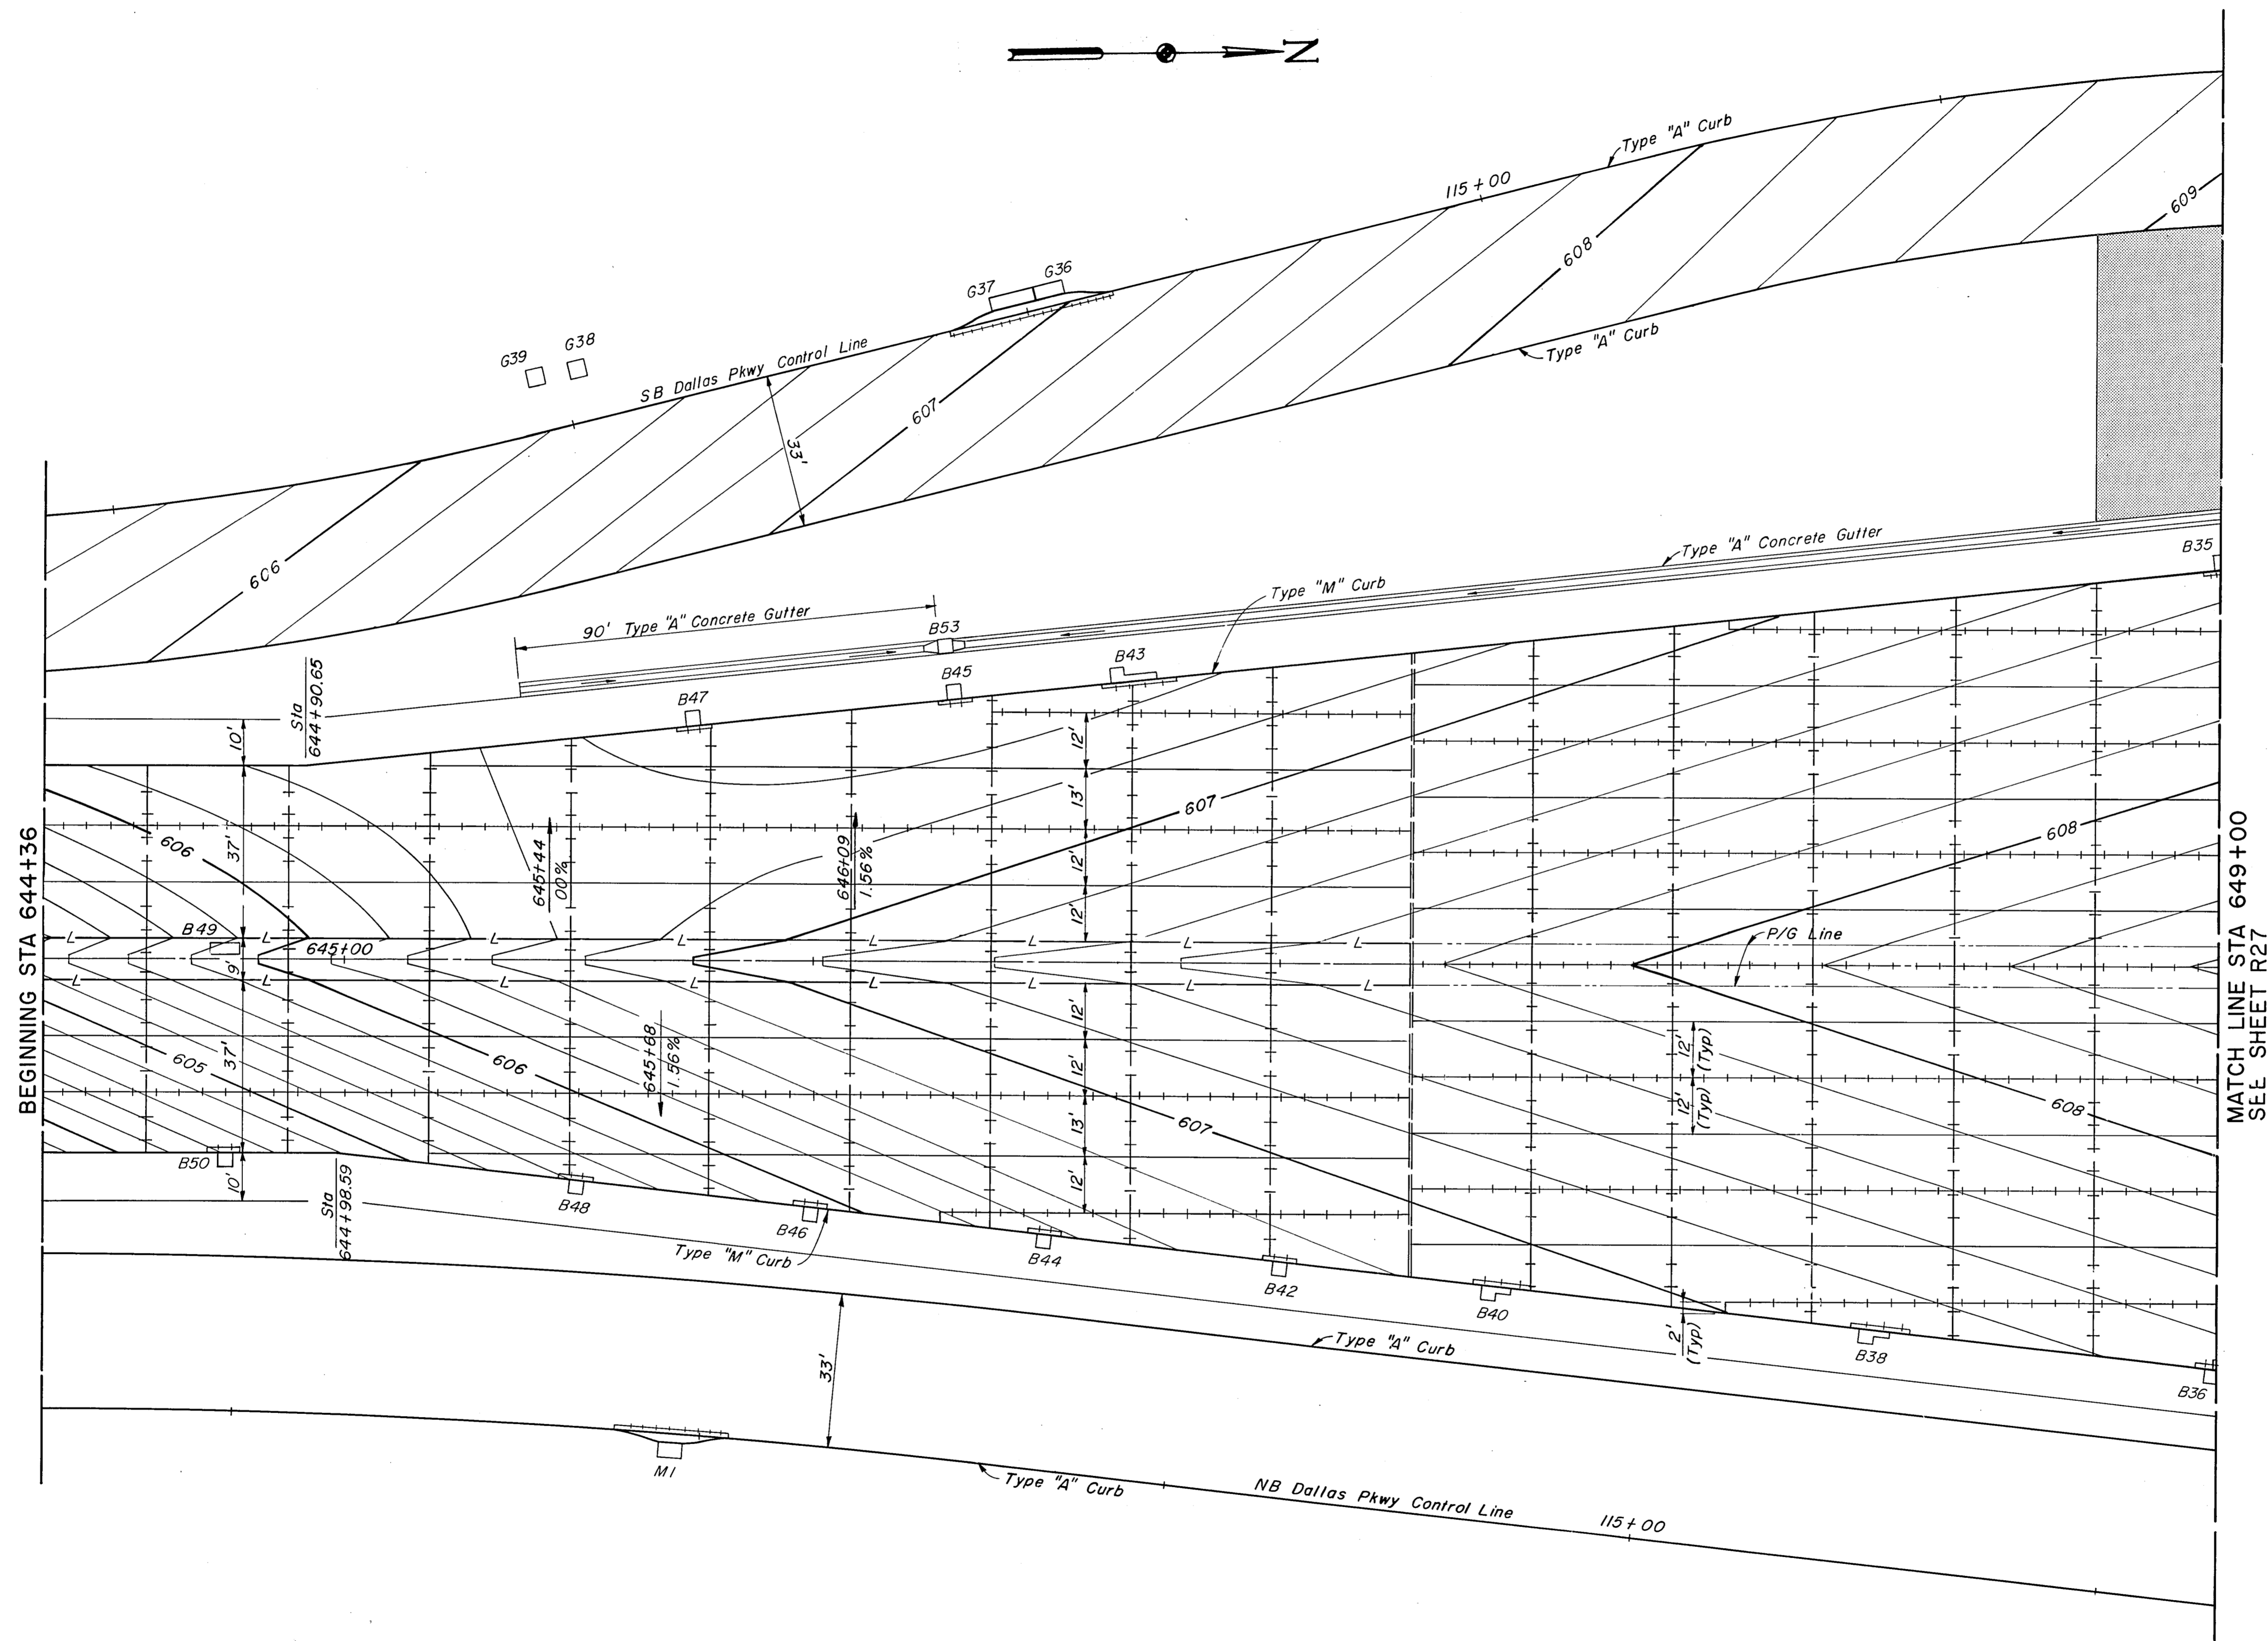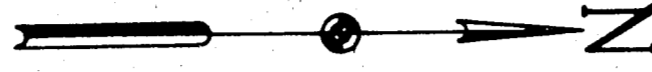


Notes:  
 1. All pavement contours shown are finished top of pavement elevations.  
 2. See Standard Drawings for joints and joint spacing.

**LEGEND**


—+—+—	Longitudinal Construction Joint (LC)
— — —	Sawed Longitudinal Joint (SL)
—=—=—	Transverse Expansion Joint (E)
—+—+—	Transverse Contraction Joint (SC)
—L—	Longitudinal Construction Joint Without Tie Bar (L)
▨	Building Project Limits

NO.	REVISION	BY	DATE
<b>TEXAS TURNPIKE AUTHORITY</b> <b>DALLAS NORTH TOLLWAY</b>			
PAVING PLAN TOLL PLAZA AREA			
<b>Gibbs &amp; Hill, Inc.</b> <small>ENGINEERS DESIGNERS CONSTRUCTORS</small> <small>DALLAS</small>			<b>SECTION VII</b>
<small>DRAWN</small> AELT <small>CHECKED</small> DWG	<small>DATE</small> 5/11/83 <small>DATE</small> 5/14/84	<small>DESIGNED</small> MGB <small>SCALE</small> 1" = 20'	<small>DATE</small> 5/5/83
<b>ASBUILT PLANS</b> <small>CONTRACT NO. DNT-115 SHEET R26 OF R85</small>			



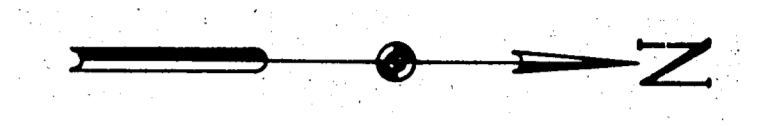

- Notes:
1. All pavement contours shown are finished top of pavement elevations.
  2. See Standard Drawings for joints and joint spacing.

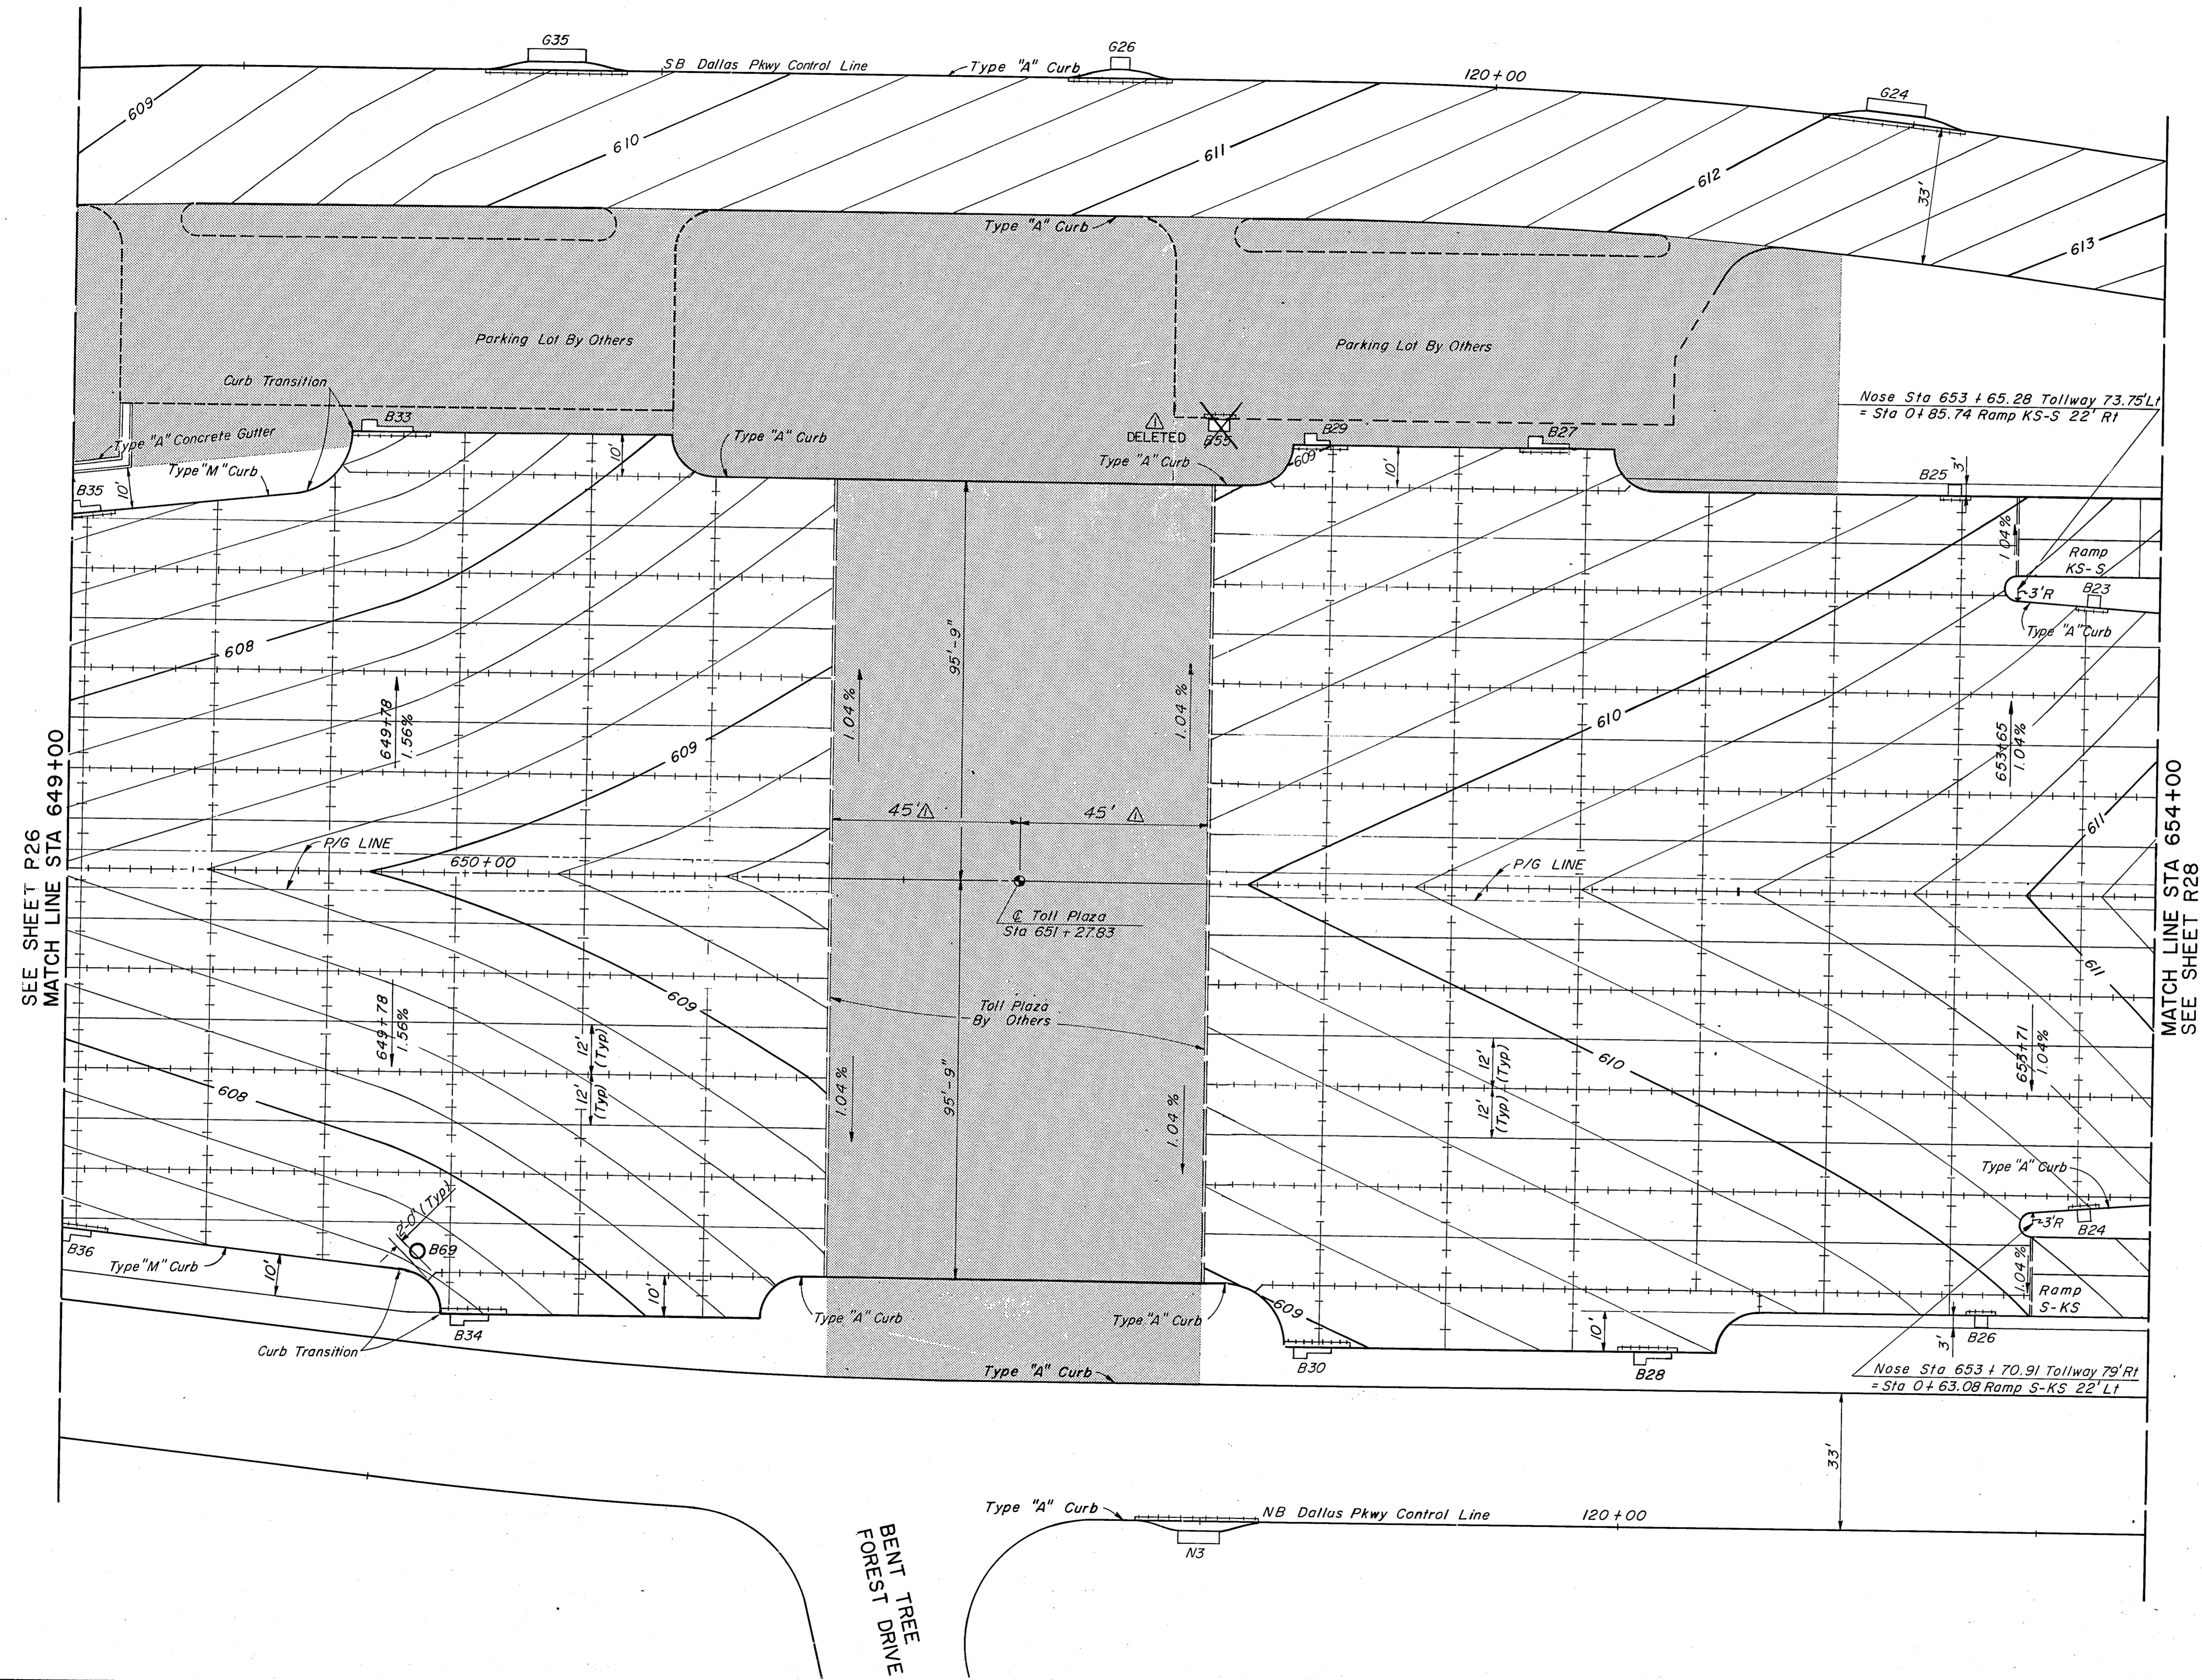

SEE SHEET P26  
MATCH LINE STA 649+00

MATCH LINE STA 654+00  
SEE SHEET R28

- LEGEND**
- ++++ Longitudinal Construction Joint (LC)
  - Sawed Longitudinal Joint (SL)
  - ==== Transverse Expansion Joint (E)
  - ++++ Transverse Contraction Joint (SC)
  - ▨ Building Project Limits

**ASBUILT PLANS**

AS BUILT PLANS	PJ	1-11-88
NO.	REVISION	BY DATE

TEXAS TURNPIKE AUTHORITY  
DALLAS NORTH TOLLWAY

PAVING PLAN  
TOLL PLAZA AREA

**Gibbs & Hill, Inc.**  
ENGINEERS DESIGNERS CONSTRUCTORS  
DALLAS

SECTION VII

DRAWN *AELT* DATE *5/12/83* DESIGNED *MGB* DATE *5/5/83*  
CHECKED *DWC* DATE *5/14/84* SCALE *1" = 20'*

CONTRACT NO. DNT-115 SHEET R27 OF R85

BENT TREE  
FOREST DRIVE




AIRPORT PARKWAY



- Notes:
1. All pavement contours shown are finished top of pavement contours.
  2. See Standard drawings for joints and joint spacing.

SEE SHEET R27  
MATCH LINE STA 654+00

END STA 660+00

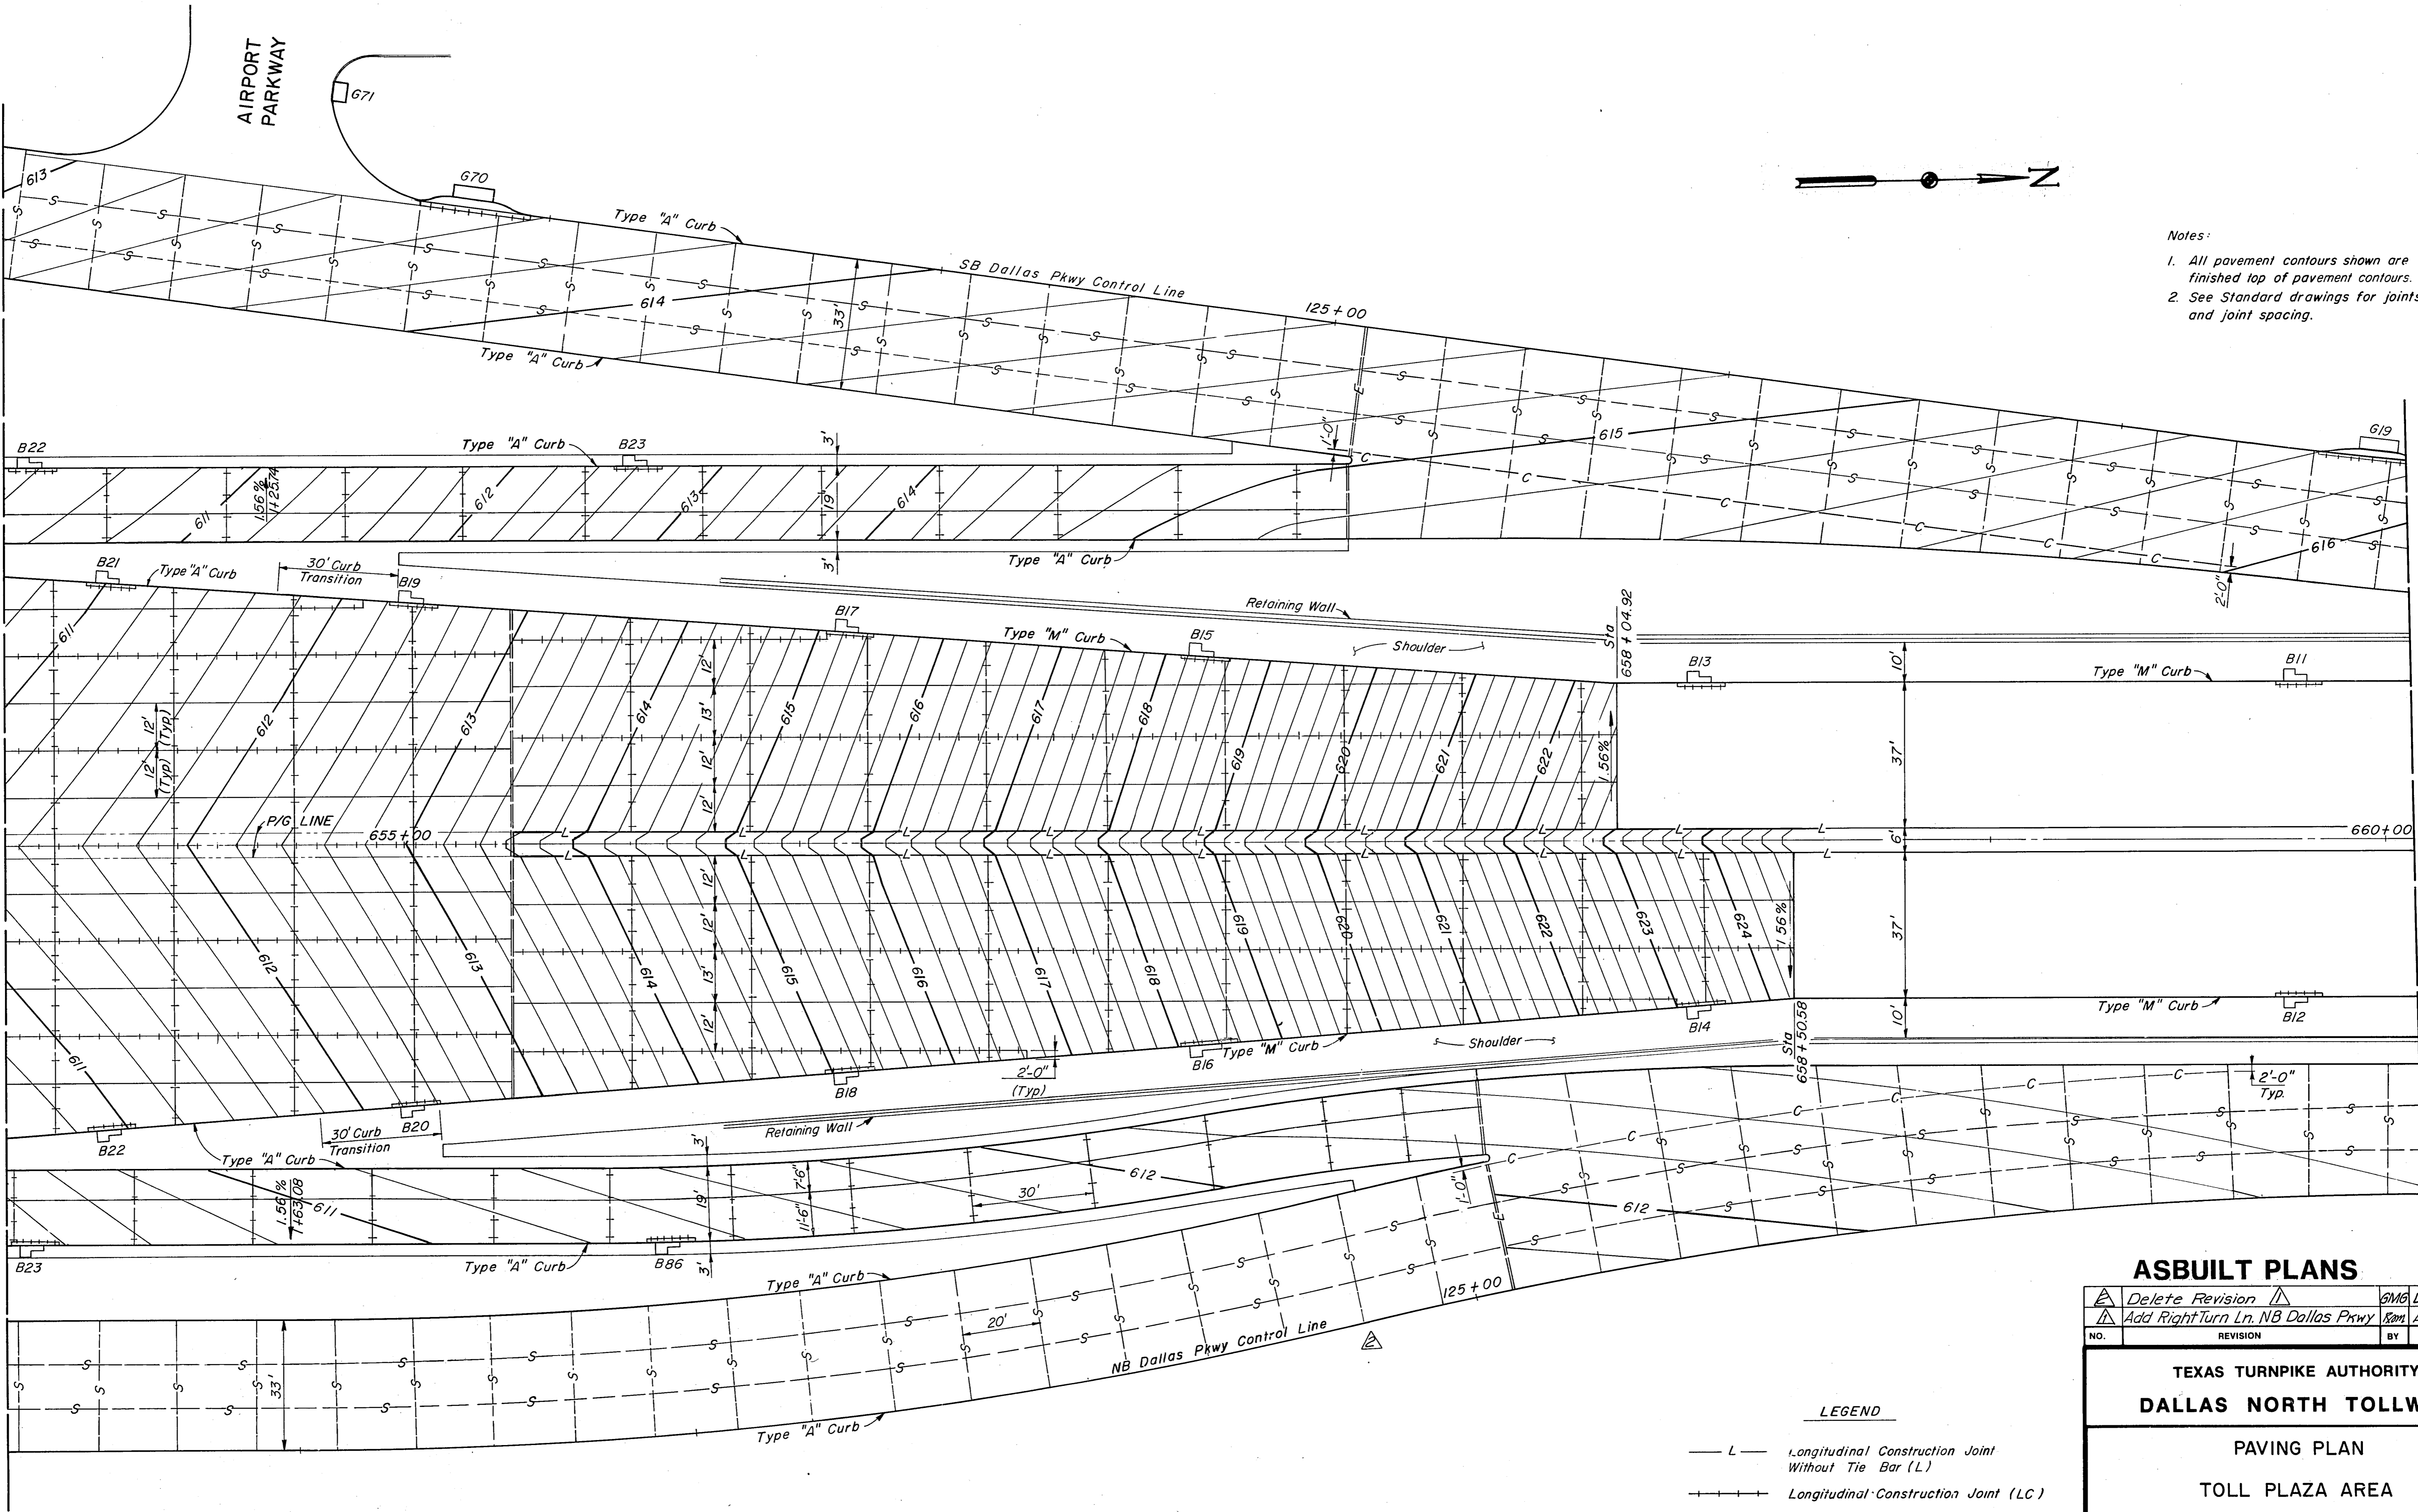

LEGEND

- L — Longitudinal Construction Joint Without Tie Bar (L)
- ++++ Longitudinal Construction Joint (LC)
- SL — Sawed Longitudinal Joint (SL)
- == E == Transverse Expansion Joint (E)
- ++++ SC ++++ Transverse Contraction Joint (SC)
- S — Sawed Dummy Joint (S)
- C — Construction Joint (C)

ASBUILT PLANS

△ Delete Revision	△ Add Right Turn Ln. NB Dallas Pkwy	6MG	Dec. 31, 1985
NO.	REVISION	BY	DATE

TEXAS TURNPIKE AUTHORITY  
DALLAS NORTH TOLLWAY

PAVING PLAN  
TOLL PLAZA AREA

**Gibbs & Hill, Inc.**  
ENGINEERS DESIGNERS CONSTRUCTORS  
DALLAS

SECTION VII


DRAWN AELT	DATE 5/12/83	DESIGNED MGB	DATE 5/6/83
CHECKED DWG	DATE 5/17/84	SCALE 1" = 20'	

CONTRACT NO. DNT-115 SHEET R28 OF R85



NOTES:

1. All curb shall be Type "A".
2. All pavement contours shown are finished top of pavement elevations.

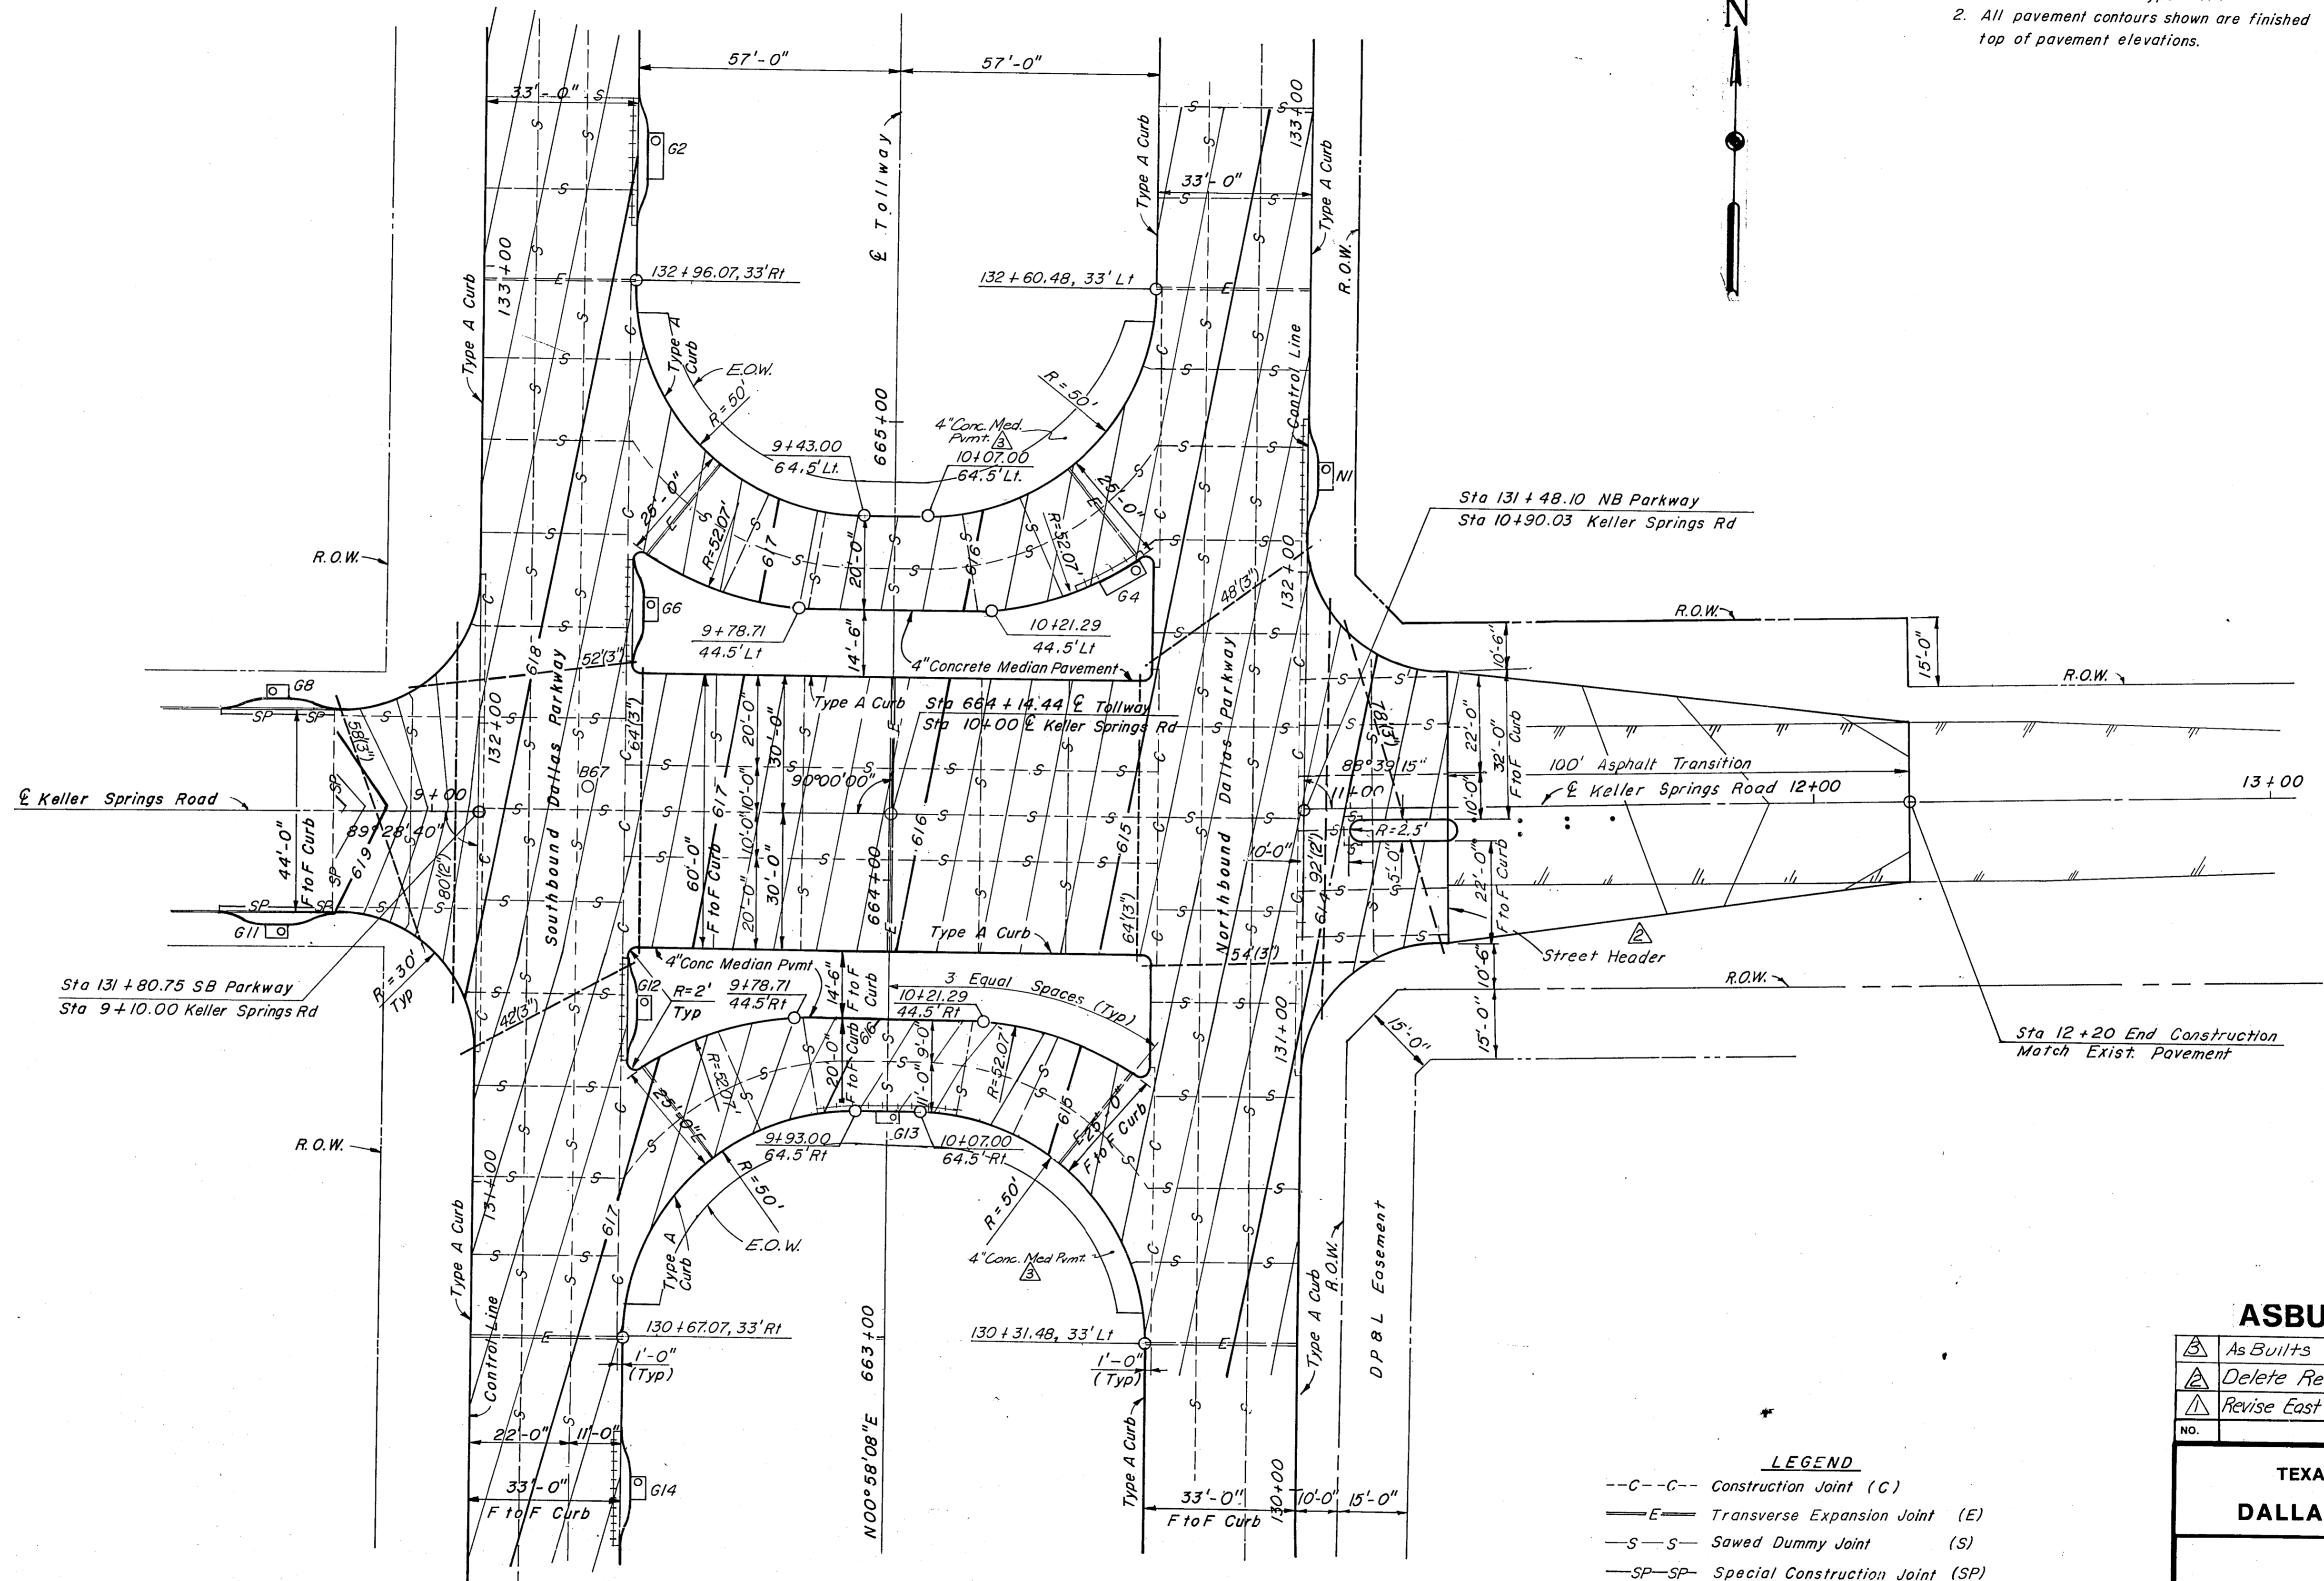

**LEGEND**

- C--C-- Construction Joint (C)
- E— Transverse Expansion Joint (E)
- S—S— Sawed Dummy Joint (S)
- SP—SP— Special Construction Joint (SP)
- PVC Conduit

**ASBUILT PLANS**

As Built	PJ	3-8-88
Delete Revision	GMB	12-31-85
Revise East NBDP & Keller Springs	WAP	7-15-85
NO.	REVISION	BY DATE


**TEXAS TURNPIKE AUTHORITY  
DALLAS NORTH TOLLWAY**

**PAVING PLAN  
KELLER SPRINGS ROAD**


**Gibbs & Hill, Inc.**  
ENGINEERS DESIGNERS CONSTRUCTORS DALLAS

SECTION VII
DRAWN VER DATE 4-4-83 DESIGNED DWG DATE 4-1-83
CHECKED DWG DATE 4-5-83 SCALE 1"=20'



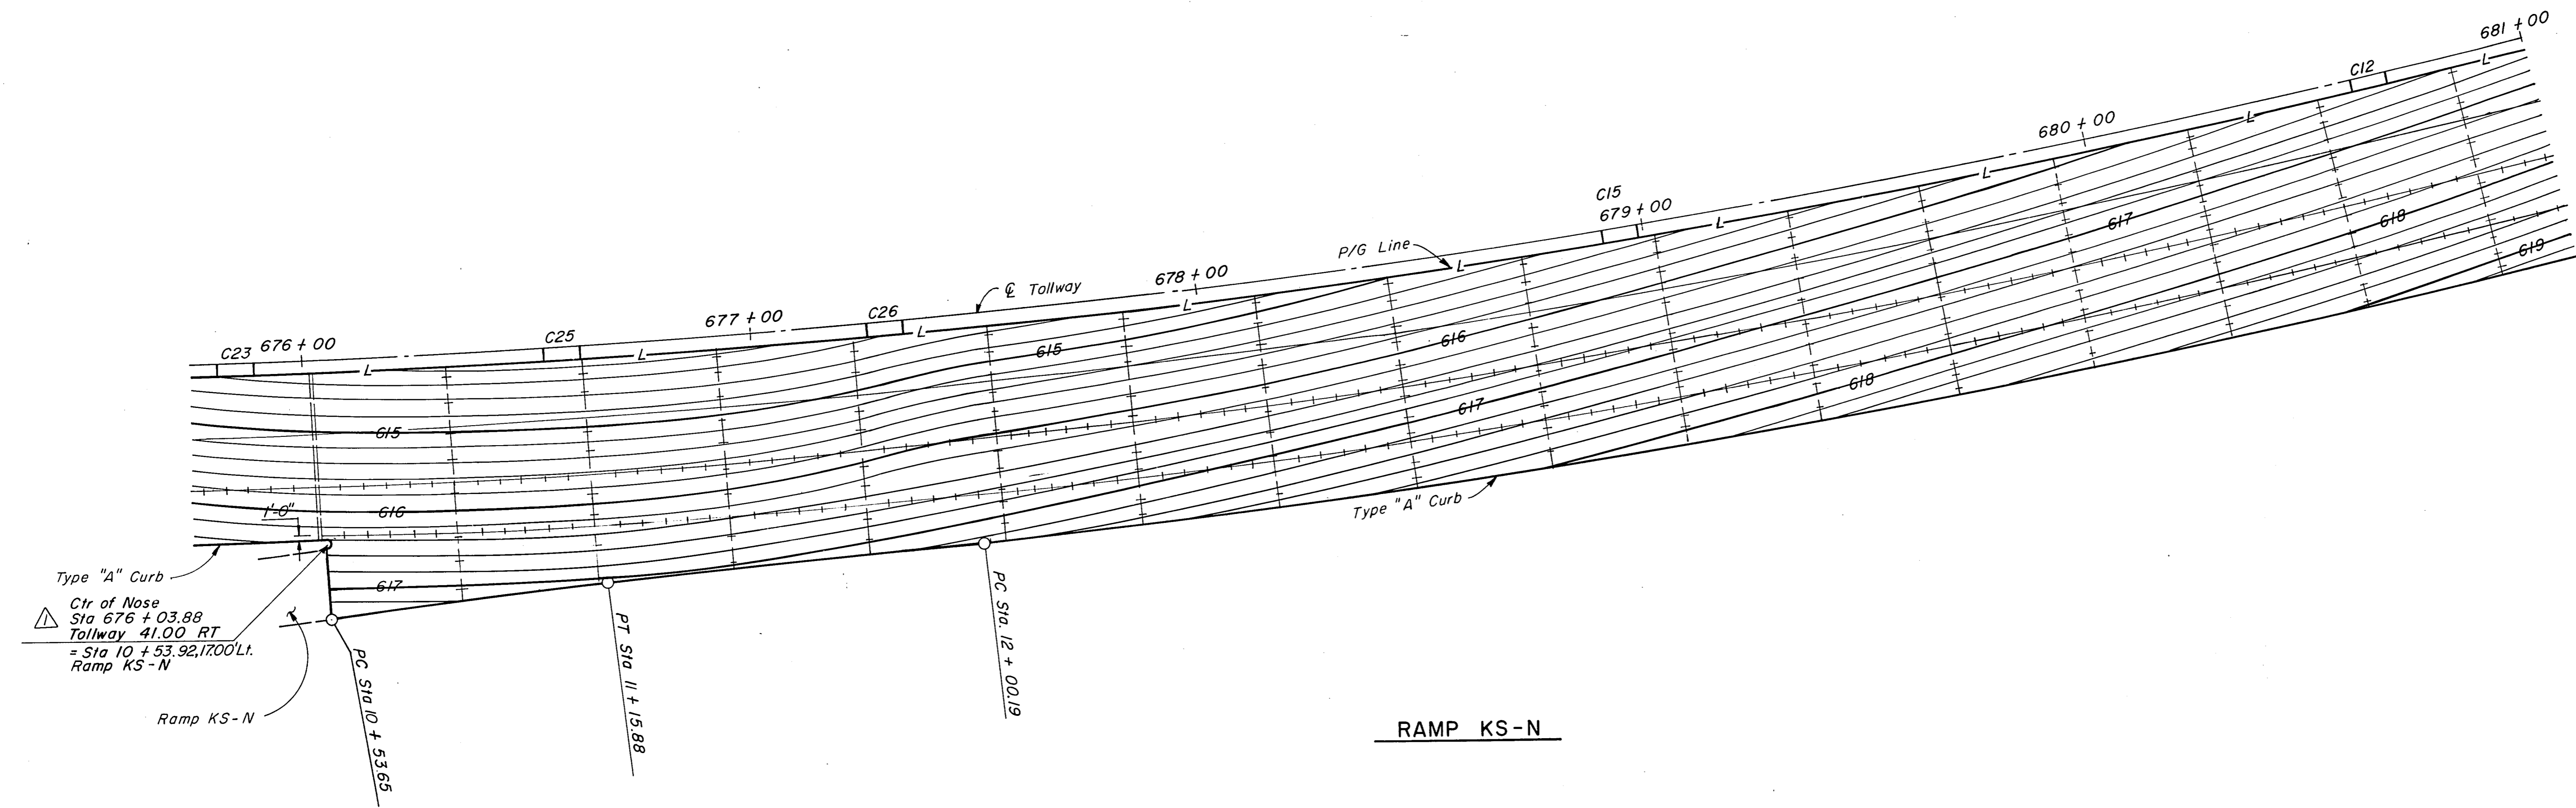

RAMP KS-N

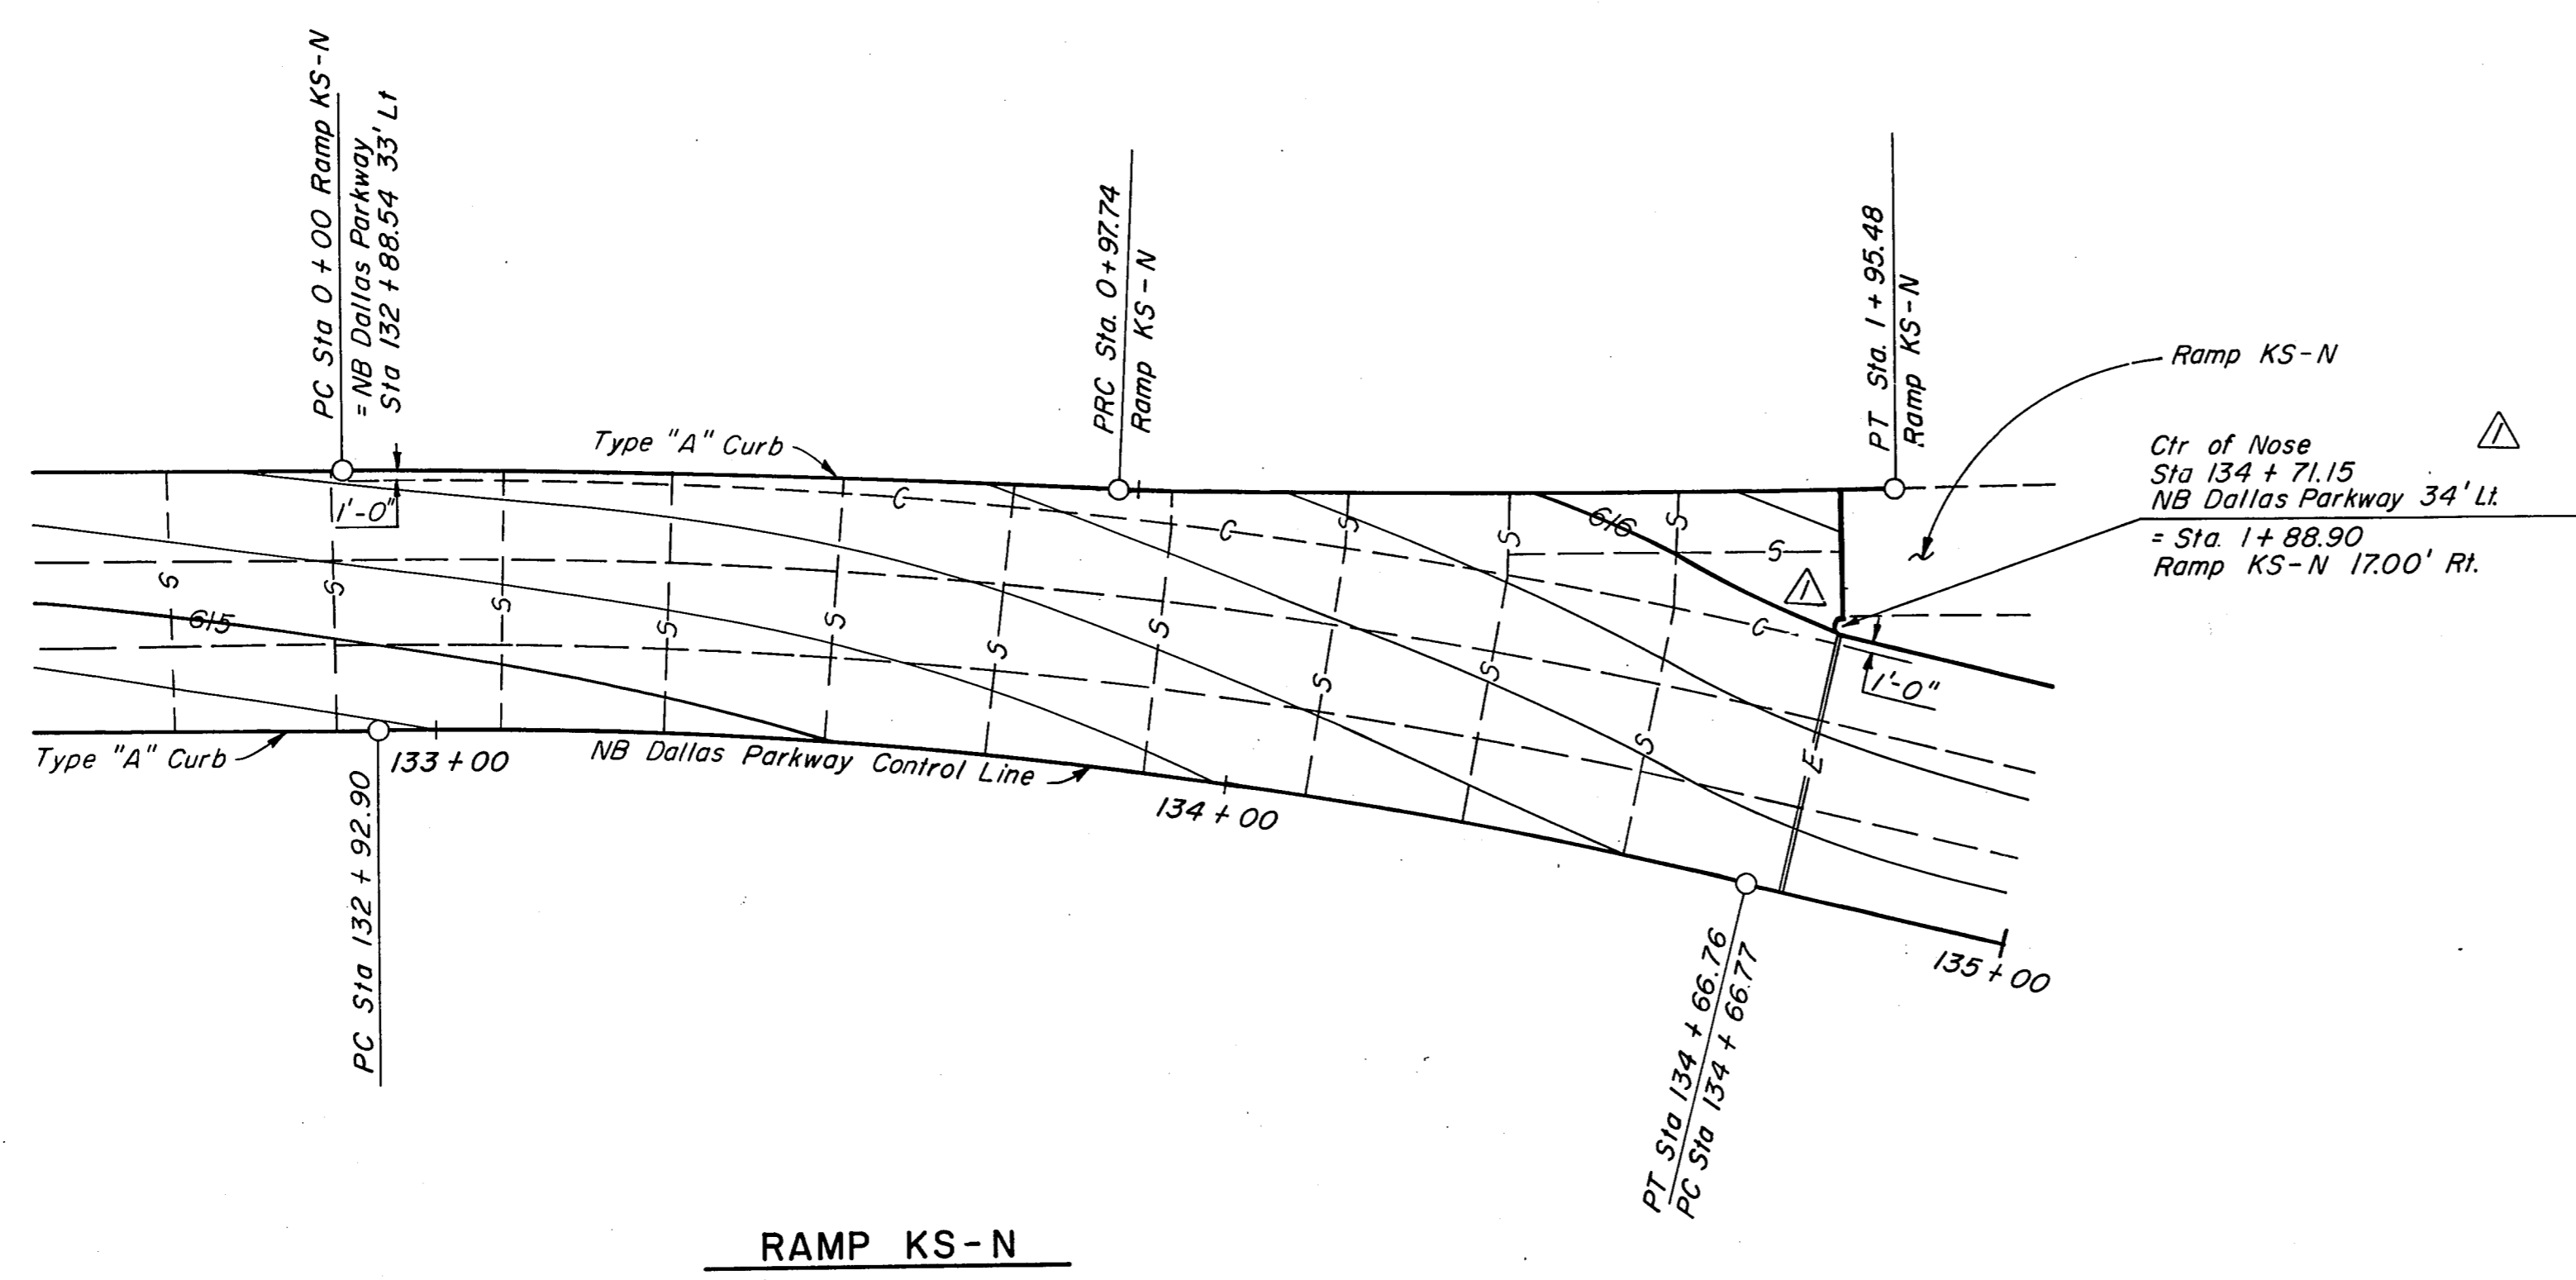

RAMP KS-N


**LEGEND**

+++++	Longitudinal Construction Joint (LC)
-----	Sawed Longitudinal Joint (SL)
==E==	Transverse Expansion Joint (E)
++ + ++	Transverse Contraction Joint (SC)
---S---	Sawed Dummy Joint (S)
-----L-----	Longitudinal Construction Joint w/o Tie Bar(L)
---C---	Construction Joint (C)

**ASBUILT PLANS**

1	Revise Ramp	GMB	7-01-86
NO.	REVISION	BY	DATE
TEXAS TURNPIKE AUTHORITY DALLAS NORTH TOLLWAY			
PAVING PLAN RAMP KS-N			
<b>Gibbs &amp; Hill, Inc.</b> ENGINEERS DESIGNERS CONSTRUCTORS DALLAS			SECTION VII
DRAWN	AELT	DATE	4/18/84
CHECKED	DWC	DATE	5/4/84
DESIGNED	MGB	DATE	4/16/84
SCALE	1" = 20'		
CONTRACT NO. DNT-115 SHEET R30 OF R85			




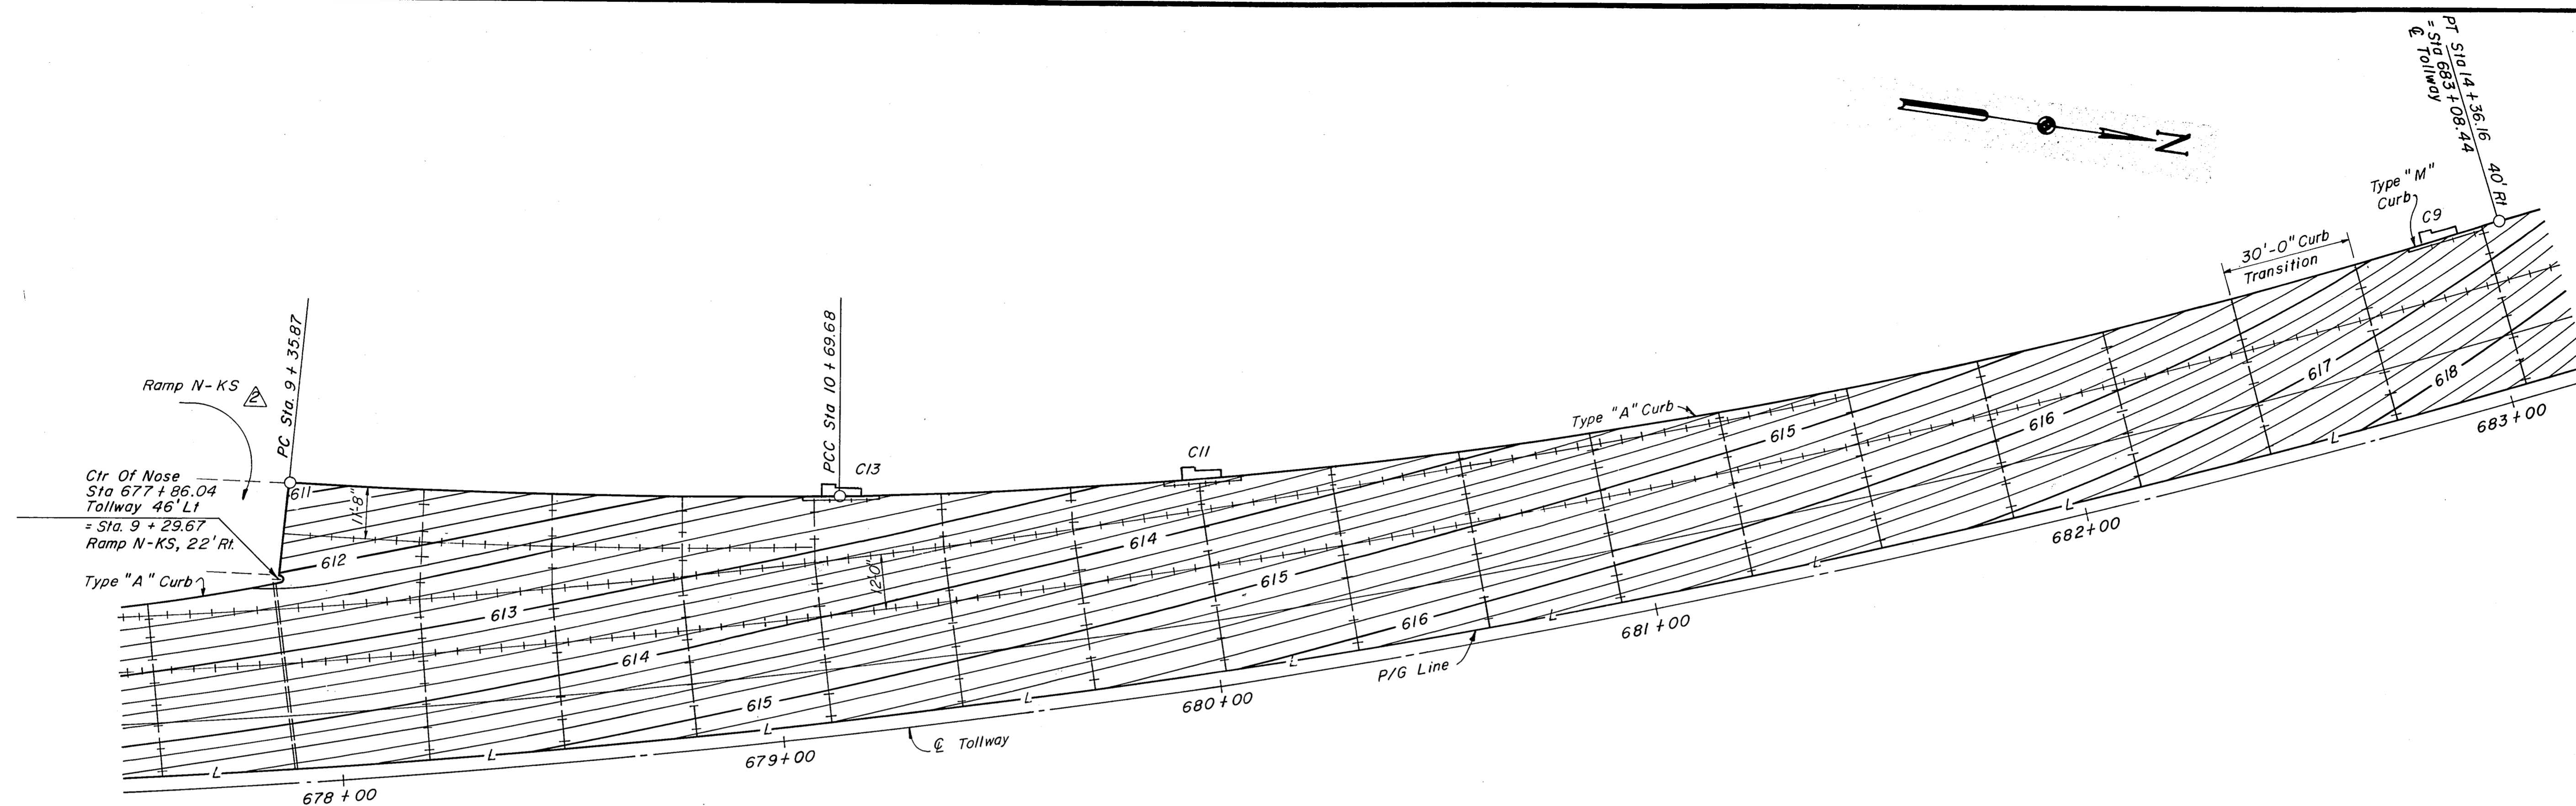

RAMP N - KS

LEGEND

- Longitudinal Construction Joint (LC)
- Sawed Longitudinal Joint (SL)
- == E == Transverse Expansion Joint (E)
- Transverse Contraction Joint (SC)
- S — Sawed Dummy Joint (S)
- L — Longitudinal Construction Joint w/ Tie Bar(L)
- C — Construction Joint (C)

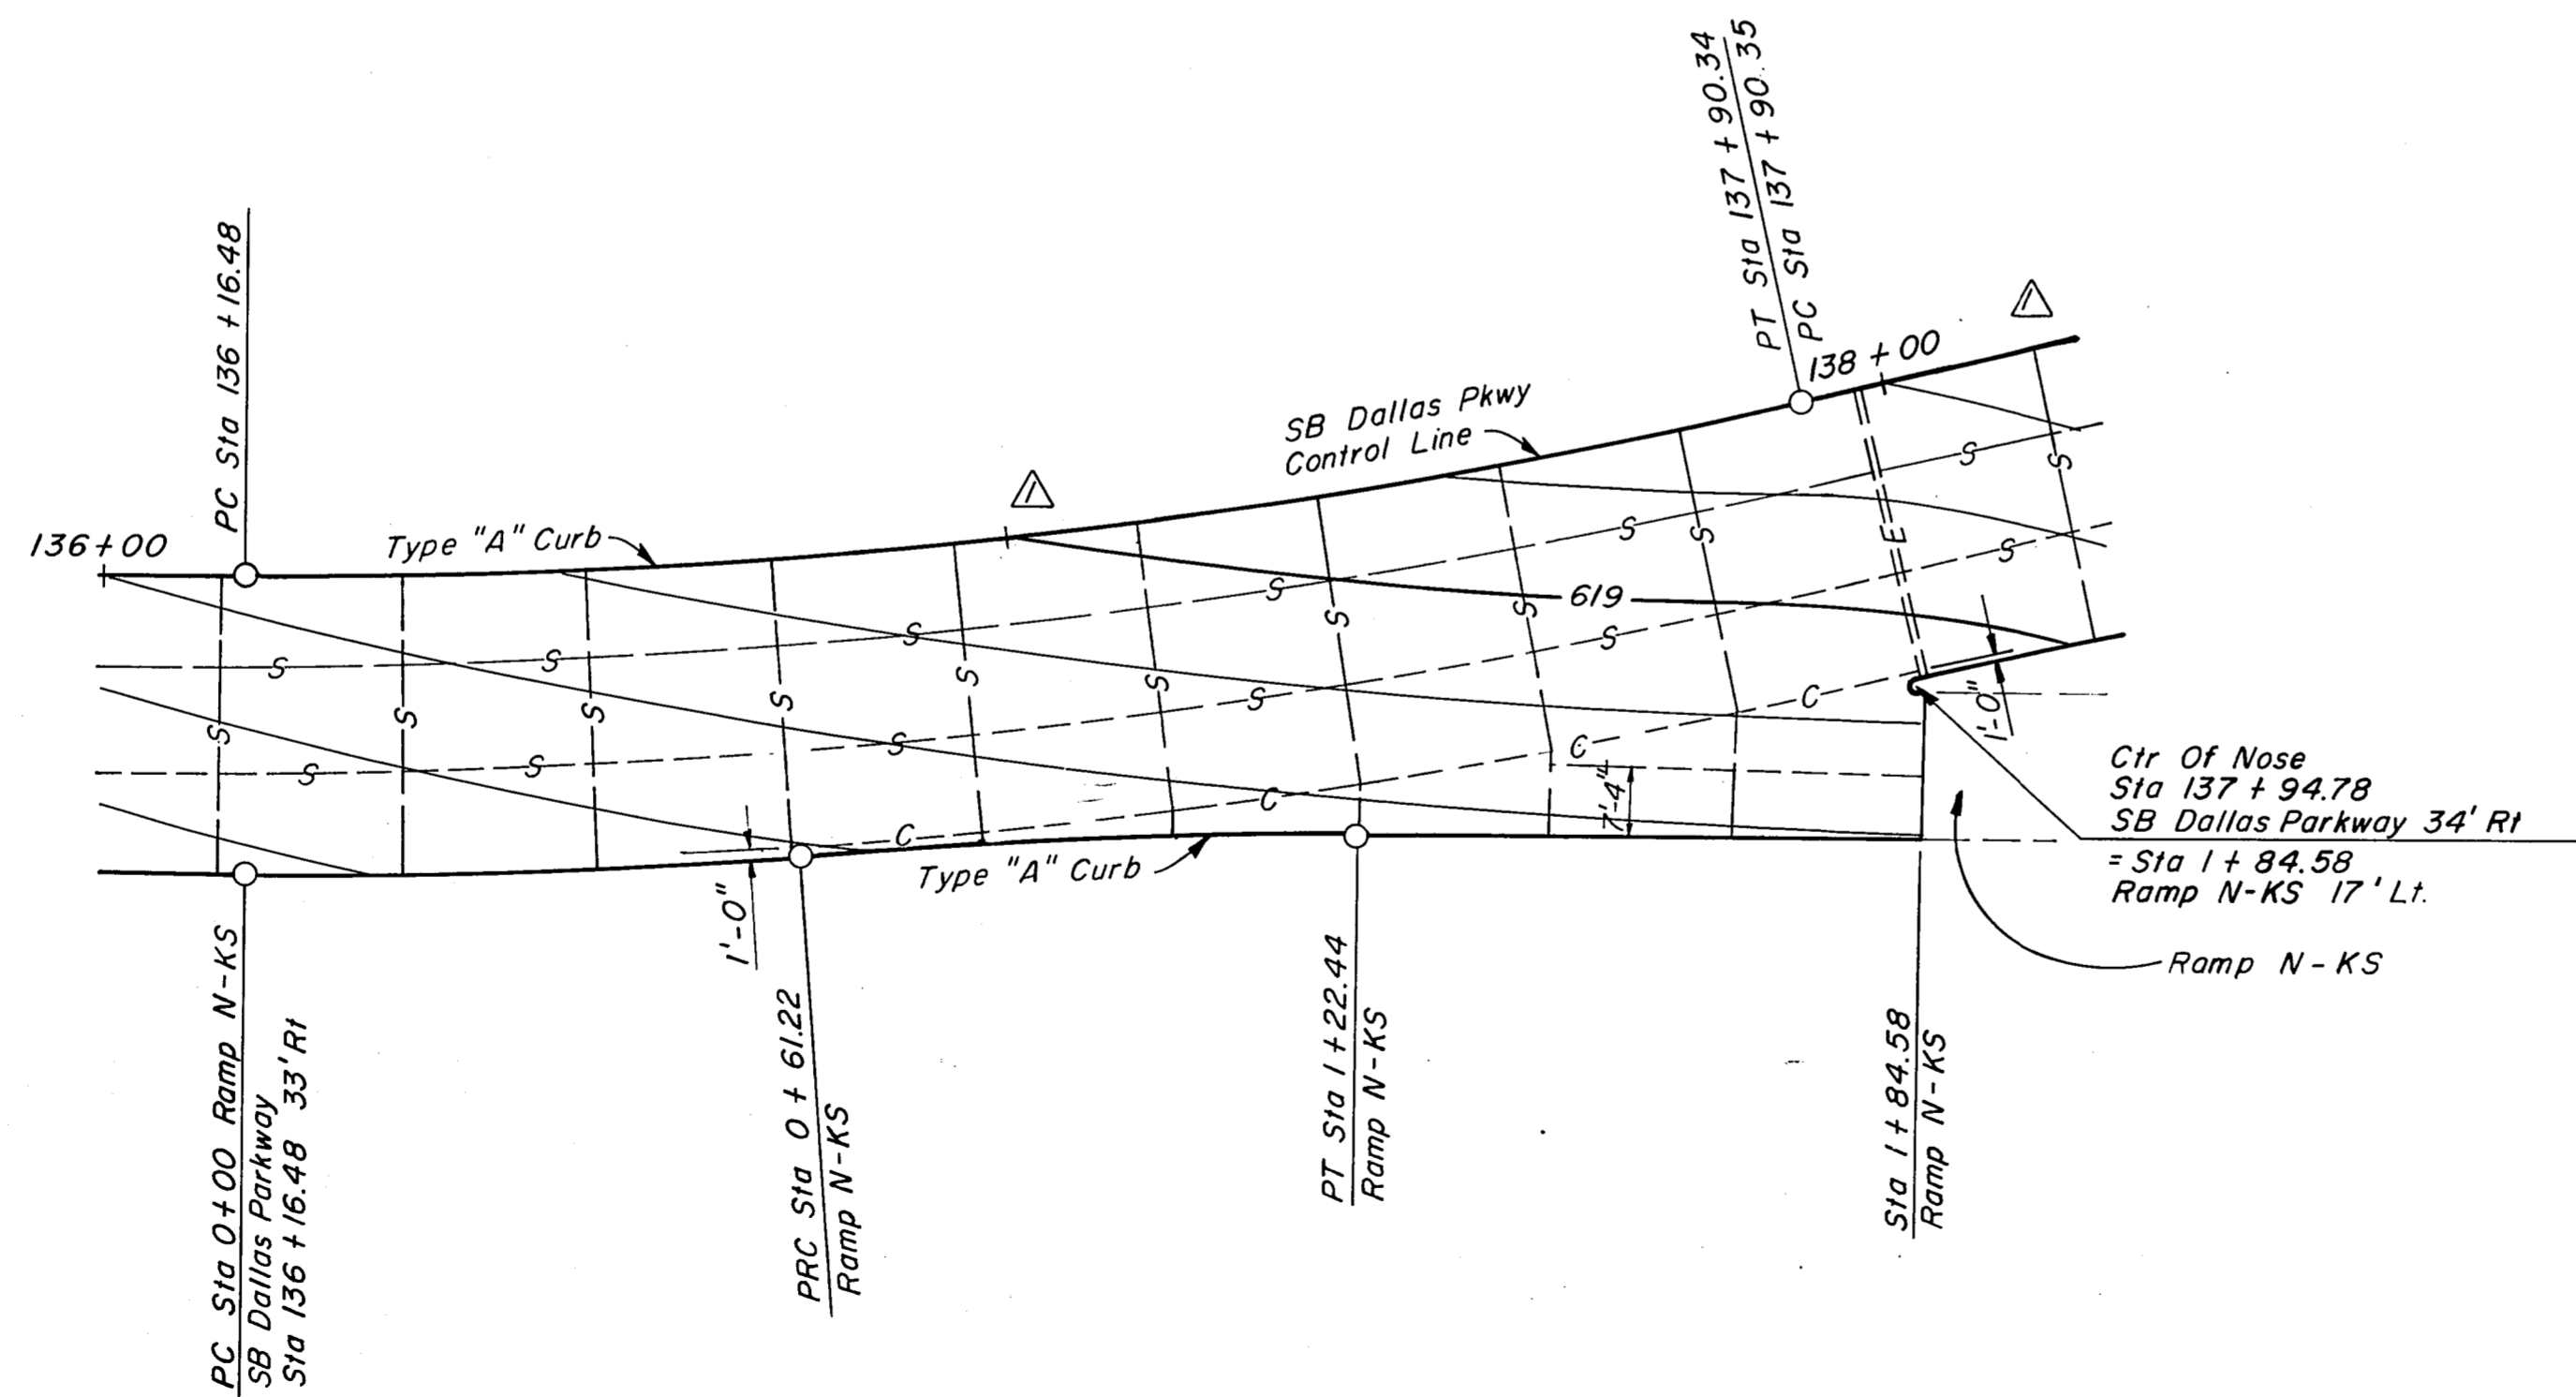

RAMP N - KS

ASBUILT PLANS

△	Revise Ramp	GMG	7-01-86
△	Inlets H1 & H2 Deleted	MGB	2-8-85
NO.	REVISION	BY	DATE

TEXAS TURNPIKE AUTHORITY  
DALLAS NORTH TOLLWAY


PAVING PLAN  
RAMP N - KS

**Gibbs & Hill, Inc.**  
ENGINEERS DESIGNERS CONSTRUCTORS  
DALLAS


SECTION VII

DRAWN	AELT	DATE	4/17/84	DESIGNED	MGB	DATE	4/12/84
CHECKED	DWC	DATE	5/4/84	SCALE	1" = 20'		



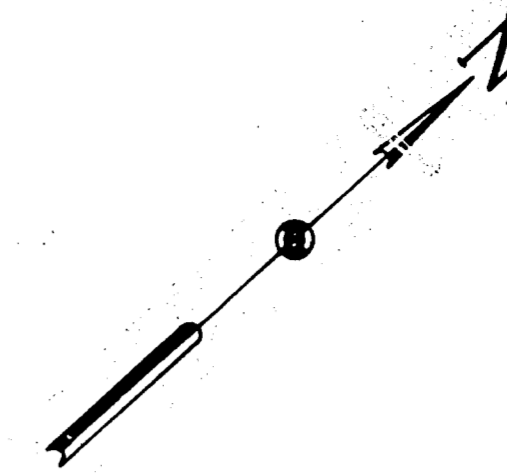

NOTES:  
 1. All curb shall be Type "A".  
 2. All pavement contours shown are finished top of pavement elevations.

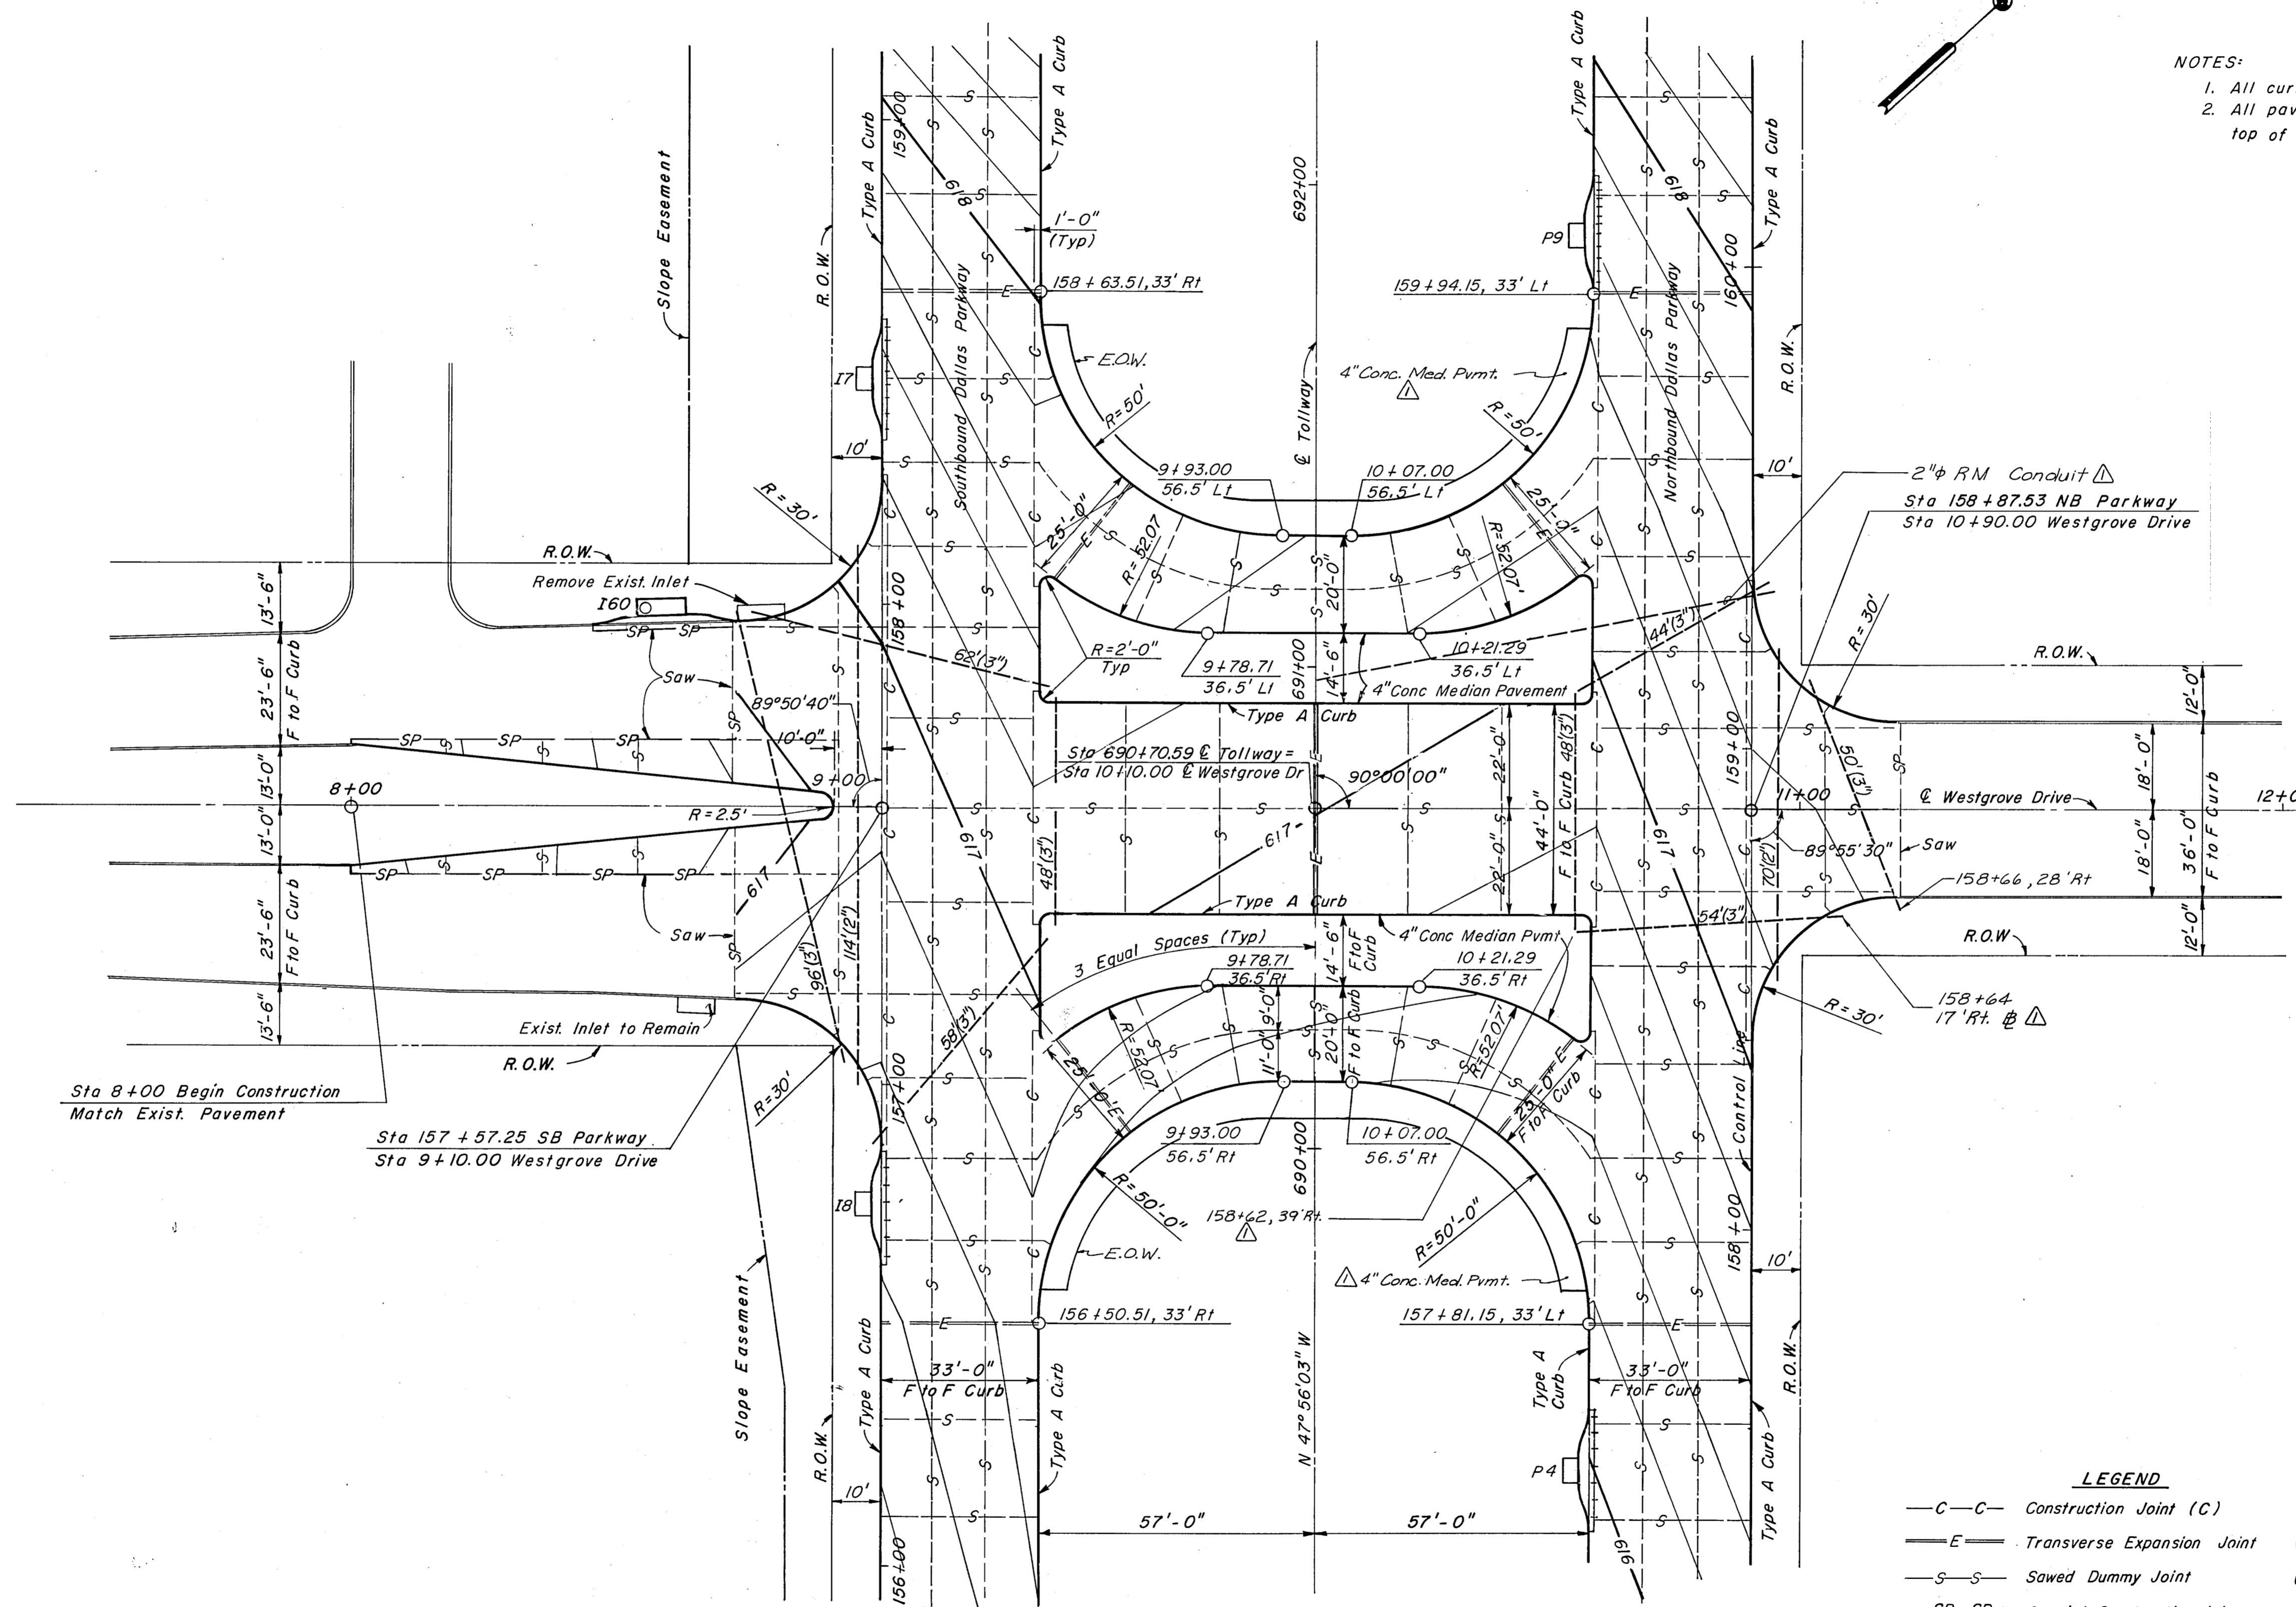

Sta 8+00 Begin Construction  
 Match Exist. Pavement

Sta 157+57.25 SB Parkway  
 Sta 9+10.00 Westgrove Drive

**LEGEND**

—C—C—	Construction Joint (C)
—E—E—	Transverse Expansion Joint (E)
—S—S—	Sawed Dummy Joint (S)
—SP—SP—	Special Construction Joint (SP)
---	PVC Conduit

**ASBUILT PLANS**

NO.	As Builts	REVISION	BY	DATE
				3-8-88

TEXAS TURNPIKE AUTHORITY  
 DALLAS NORTH TOLLWAY

PAVING PLAN  
 WESTGROVE DRIVE


**Gibbs & Hill, Inc.**  
 ENGINEERS DESIGNERS CONSTRUCTORS  
 DALLAS

SECTION VII

DRAWN CJB	DATE 4/4/83	DESIGNED DWC	DATE 4/1/83
CHECKED DWC	DATE 4/5/83	SCALE	1" = 20'

CONTRACT NO. DNT-115 SHEET R 32 OF R 85



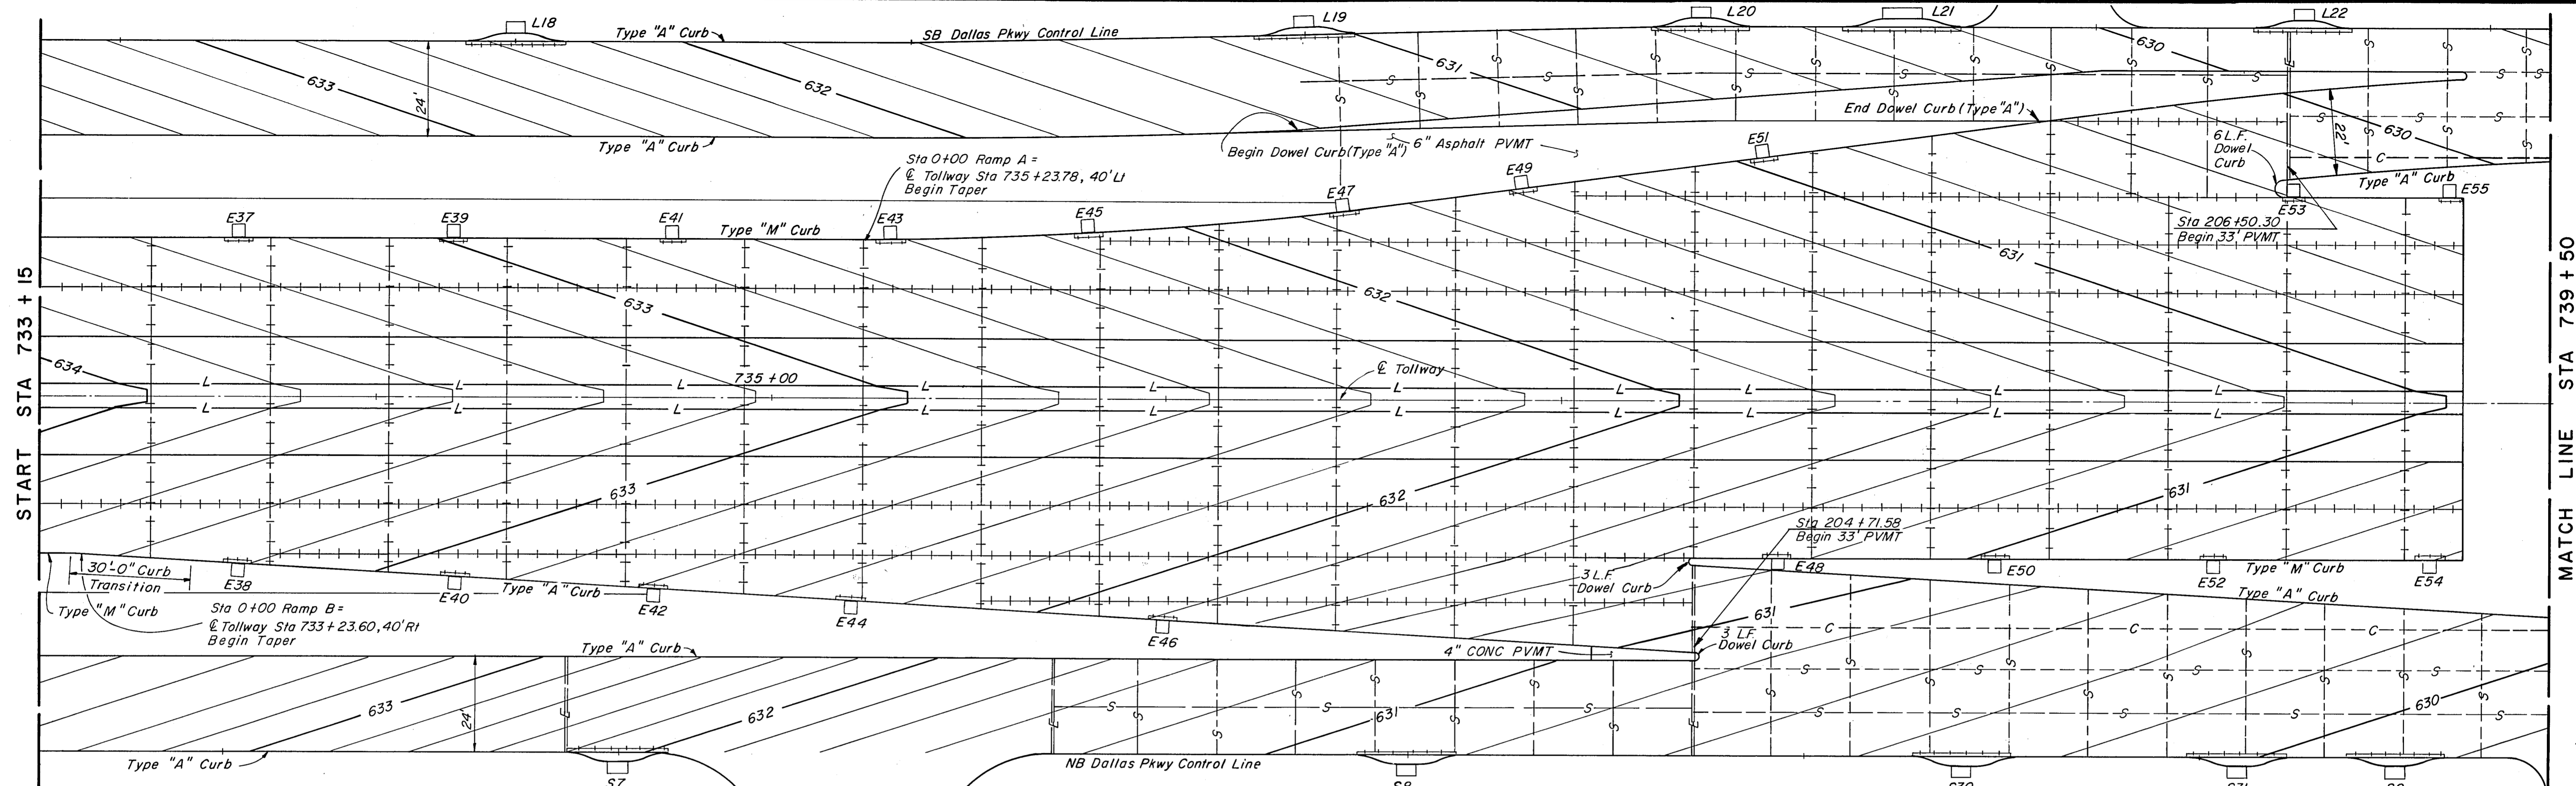


START STA 733 + 15

MATCH LINE STA 739 + 50

KNOLL TRAIL DRIVE

MATCH LINE STA 739 + 50

END SECTION VII

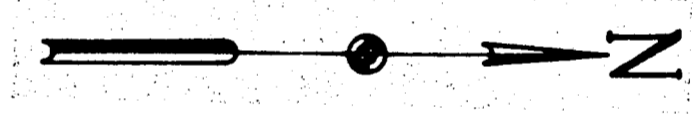

- LEGEND**
- +—+— Longitudinal Construction Joint (LC)
  - /—/— Sawed Longitudinal Joint (SL)
  - E—E— Transverse Expansion Joint (E)
  - +—+— Transverse Contraction Joint (SC)
  - S—S— Sawed Dummy Joint (S)
  - L—L— Longitudinal Construction Joint W/O Tie Bar(L)
  - C—C— Construction Joint (C)

**ASBUILT PLANS**

NO.	REVISION	BY	DATE
TEXAS TURNPIKE AUTHORITY DALLAS NORTH TOLLWAY			
PAVING PLAN RAMPS A & B			
<b>Gibbs &amp; Hill, Inc.</b> ENGINEERS DESIGNERS CONSTRUCTORS DALLAS			SECTION VII
DRAWN <i>ELB</i>	DATE <i>5/01/84</i>	DESIGNED <i>MGB</i>	DATE <i>4/30/84</i>
CHECKED <i>DWC</i>	DATE <i>5/8/84</i>	SCALE <i>1" = 20'</i>	
CONTRACT NO. <i>DNT-115</i> SHEET <i>R33</i> OF <i>R85</i>			



**LEGEND**


- Construction
- Traffic Lanes
- Detours
- Barricades
- Vertical Panel
- Vertical Panel With Flashers
- Barrel With Flasher
- Barrel
- Sign

**BARRICADES & SIGNS**

- TYPE III BARRICADES WITH WARNING LIGHTS SHALL BE INSTALLED AT KELLER SPRINGS ROAD AND WESTGROVE DRIVE TO SEPARATE TRAFFIC FROM CONSTRUCTION LIMITS, AS DIRECTED BY THE ENGINEER FOR EACH PHASE.
- TYPE I BARRICADES WITH FLASHERS SHALL BE INSTALLED AT ALL DRIVES TO SEPARATE TRAFFIC FROM CONSTRUCTION LIMITS, AS DIRECTED BY THE ENGINEER.
- SIGNS CW-20-1D AND G20-2 ON FIXED SUPPORTS SHALL BE INSTALLED ON EACH SIDE STREET, APPROXIMATELY 100' OUTSIDE THE WORK AREAS, INCLUDING DETOURS.
- REGULATORY SIGNS SHALL BE INSTALLED IN ACCORDANCE WITH THE "TEXAS MANUAL ON UNIFORM TRAFFIC CONTROL DEVICES FOR STREETS AND HIGHWAYS" AND AS DIRECTED BY THE ENGINEER.
- AT LEAST 48 HOURS PRIOR TO CLOSING ANY DRIVEWAY, THE CONTRACTOR SHALL NOTIFY EACH PROPERTY OWNER OR OWNER'S REPRESENTATIVE OF ALL DRIVEWAY CLOSINGS AND THE NECESSITY OF ALTERNATE ACCESS FROM ADDISON ROAD OR KNOLL TRAIL DRIVE. DRIVEWAY ACCESS MUST BE MAINTAINED CONTINUOUSLY TO ALL BUILDINGS.

**STRIPING (TEMPORARY)**


- TRAFFIC EDGE LINES FOR DETOURS SHALL BE 6-INCH SOLID WHITE PAVEMENT MARKINGS.
- LINE SEPARATING TWO-WAY TRAFFIC SHALL BE DOUBLE 4-INCH SOLID YELLOW PAVEMENT MARKING.
- LANE SEPARATION LINE SHALL BE DASHED WITH 4-INCH BY 10-FOOT SOLID WHITE PAVEMENT MARKING WITH 30-FOOT GAPS.
- TURNING LANES SHALL BE SEPARATED FROM THROUGH TRAFFIC BY A 4-INCH SOLID WHITE PAVEMENT MARKING.
- SEE SPECIAL PROVISION TO ITEM 662, "CONSTRUCTION PAVEMENT MARKINGS" FOR THE TYPE OF STRIPING TO BE USED.

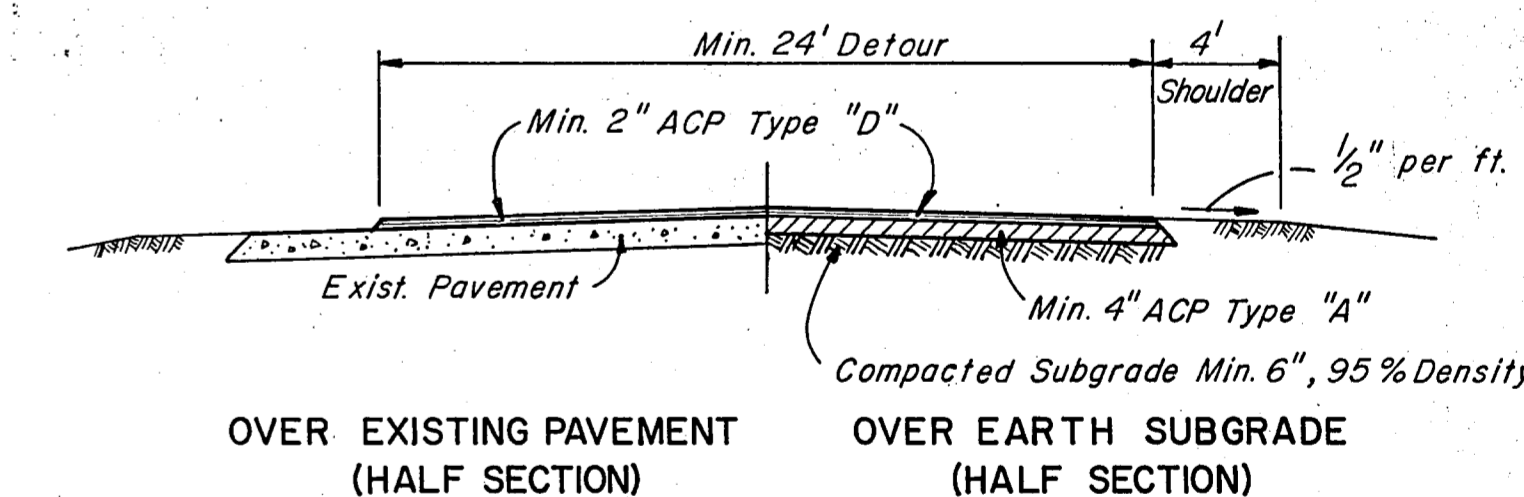

**DETOUR TYPICAL SECTION**  
(NOT TO SCALE)


**ASBUILT PLANS**

NO.	REVISION	BY	DATE
<b>TEXAS TURNPIKE AUTHORITY</b>			
<b>DALLAS NORTH TOLLWAY</b>			
<b>SUGGESTED CONSTRUCTION SEQUENCE</b>			
<b>AND TRAFFIC CONTROL</b>			
<b>STA. 638+50 TO STA. 662+00</b>			
<b>Gibbs &amp; Hill, Inc.</b>			<b>SECTION VII</b>
<small>ENGINEERS DESIGNERS CONSTRUCTORS DALLAS</small>			
DRAWN	VER	DATE	DESIGNED
CHKD	DWC	5/7/84	JOP
		8/3/84	5/2/84
		SCALE	1" = 100'
<b>CONTRACT NO. DNT-115 SHEET R34 OF R85</b>			

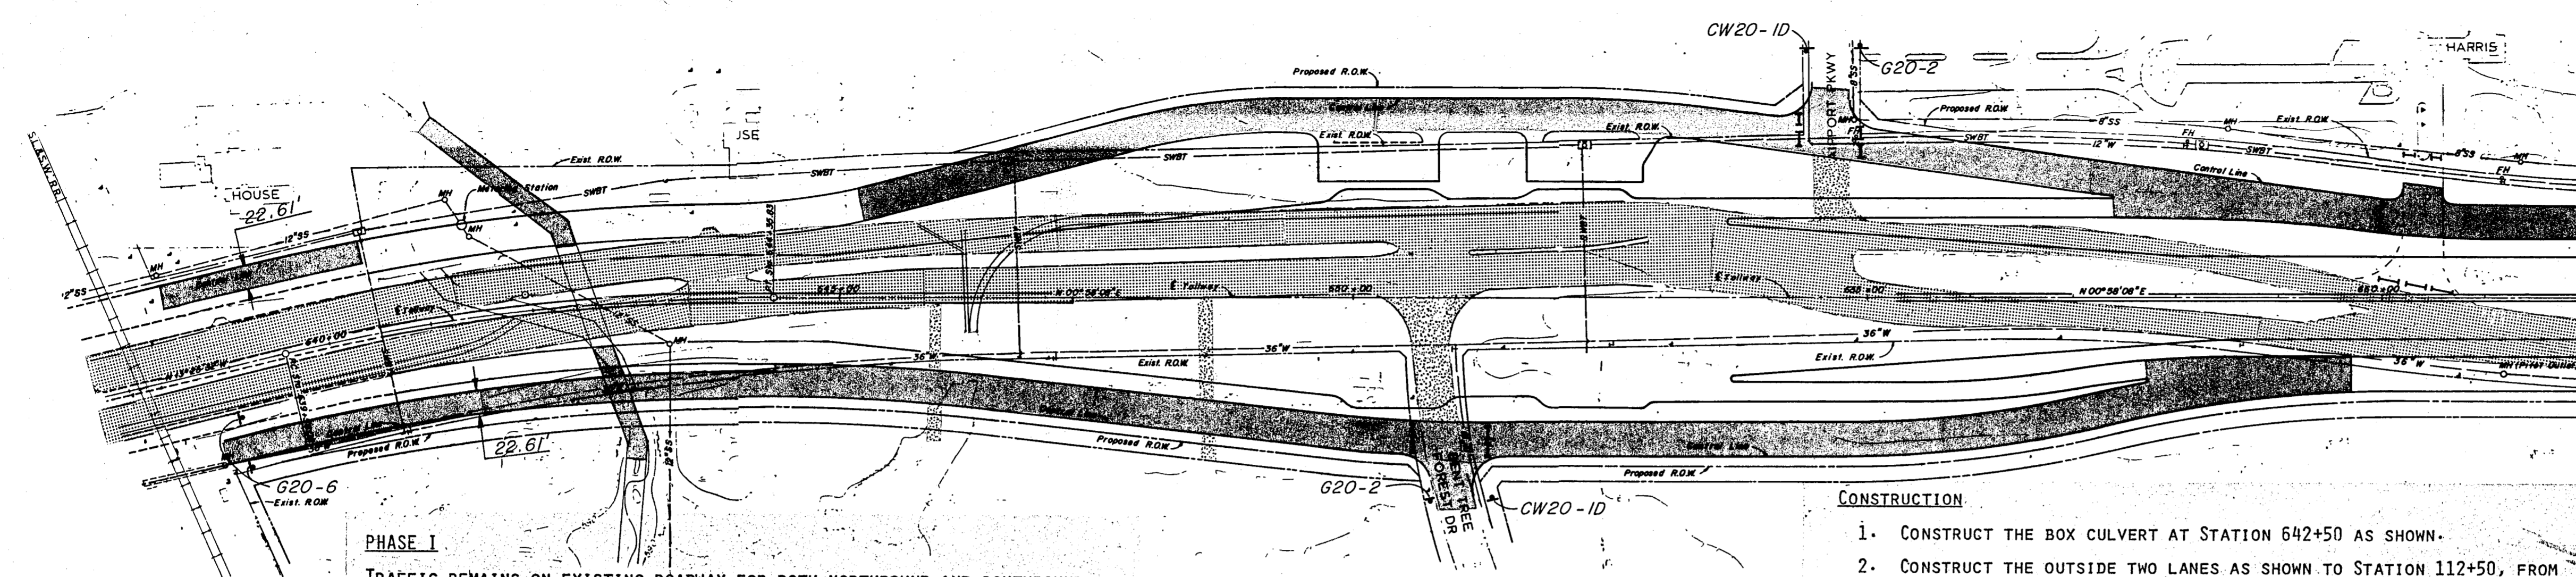


**PHASE I**  
TRAFFIC REMAINS ON EXISTING ROADWAY FOR BOTH NORTHBOUND AND SOUTHBOUND DALLAS PARKWAY.  
PRIVATE DRIVES SOUTH OF AIRPORT PARKWAY AND BENT TREE FOREST DRIVE MUST HAVE ACCESS TO DALLAS PARKWAY MAINTAINED DURING ALL PHASE I CONSTRUCTION.  
BENT TREE FOREST DRIVE AND AIRPORT PARKWAY SHALL BE CONSTRUCTED IN SUCH SEQUENCE AS TO MAINTAIN TWO LANES ACCESS TO DALLAS PARKWAY DURING ALL OF PHASE I CONSTRUCTION, UNLESS CLOSING IS APPROVED BY BOTH THE CITY OF DALLAS AND THE CITY OF ADDISON.

- CONSTRUCTION**
- CONSTRUCT THE BOX CULVERT AT STATION 642+50 AS SHOWN.
  - CONSTRUCT THE OUTSIDE TWO LANES AS SHOWN TO STATION 112+50, FROM NORTH HEADER OF RAILROAD SHOOF-FLY, 45 FEET NORTH OF EXISTING TRACK.
  - CONSTRUCT THE REMAINING DALLAS PARKWAY AS SHOWN TO FULL SECTION.
  - DRAINAGE STRUCTURES WILL BE CONSTRUCTED ONLY UNDER THAT PORTION OF THE ROADWAY UNDER CONSTRUCTION WITH TEMPORARY CONNECTIONS TO EXISTING SYSTEMS FOR CONTINUOUS STORM WATER DRAINAGE.

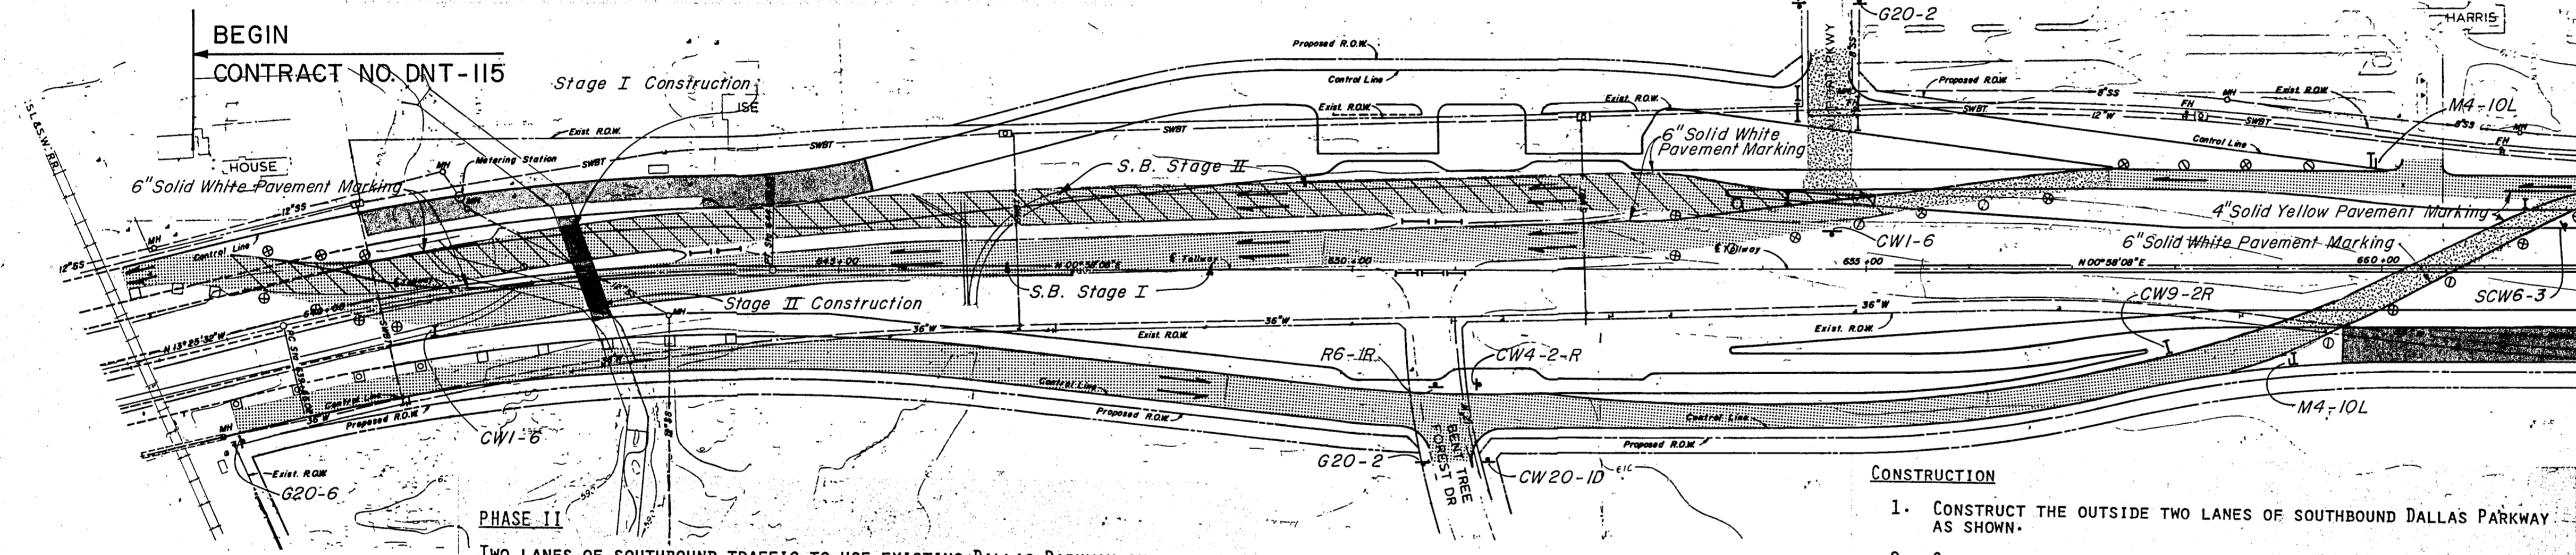

**PHASE II**  
TWO LANES OF SOUTHBOUND TRAFFIC TO USE EXISTING DALLAS PARKWAY AND DETOURS FROM ST. LOUIS SOUTHWESTERN RAILWAY TO STATION 662+00. THE SOUTHBOUND LANES WILL REQUIRE TWO STAGES, FOR CONSTRUCTION OF THE DOUBLE 8'X8' BOX CULVERT AT STATION 642+50, TO KEEP THE DRAINAGE THROUGH THE EXISTING CULVERT UNTIL DRAINAGE IS ESTABLISHED THROUGH THE NEW CULVERT.  
TWO LANES OF NORTHBOUND TRAFFIC TO USE FUTURE NORTHBOUND DALLAS PARKWAY AND DETOUR FROM ST. LOUIS SOUTHWESTERN RAILWAY TO STATION 662+00.  
AIRPORT PARKWAY SHALL BE CONNECTED TO SOUTHBOUND DALLAS PARKWAY DURING ALL OF PHASE II CONSTRUCTION.

- CONSTRUCTION**
- CONSTRUCT THE OUTSIDE TWO LANES OF SOUTHBOUND DALLAS PARKWAY AS SHOWN.
  - CONSTRUCT THE NORTHBOUND DALLAS PARKWAY AS SHOWN TO FULL SECTION.
  - THE DOUBLE 8'X8' BOX CULVERT MUST BE CONSTRUCTED UNDER THE EXISTING SOUTHBOUND PARKWAY AND THE PAVEMENT REPLACED FOR SOUTHBOUND TRAFFIC DETOUR. COMPLETE THE CULVERT, FILL THE EXISTING CHANNEL AND COMPLETE PHASE II GRADING AND PAVING.

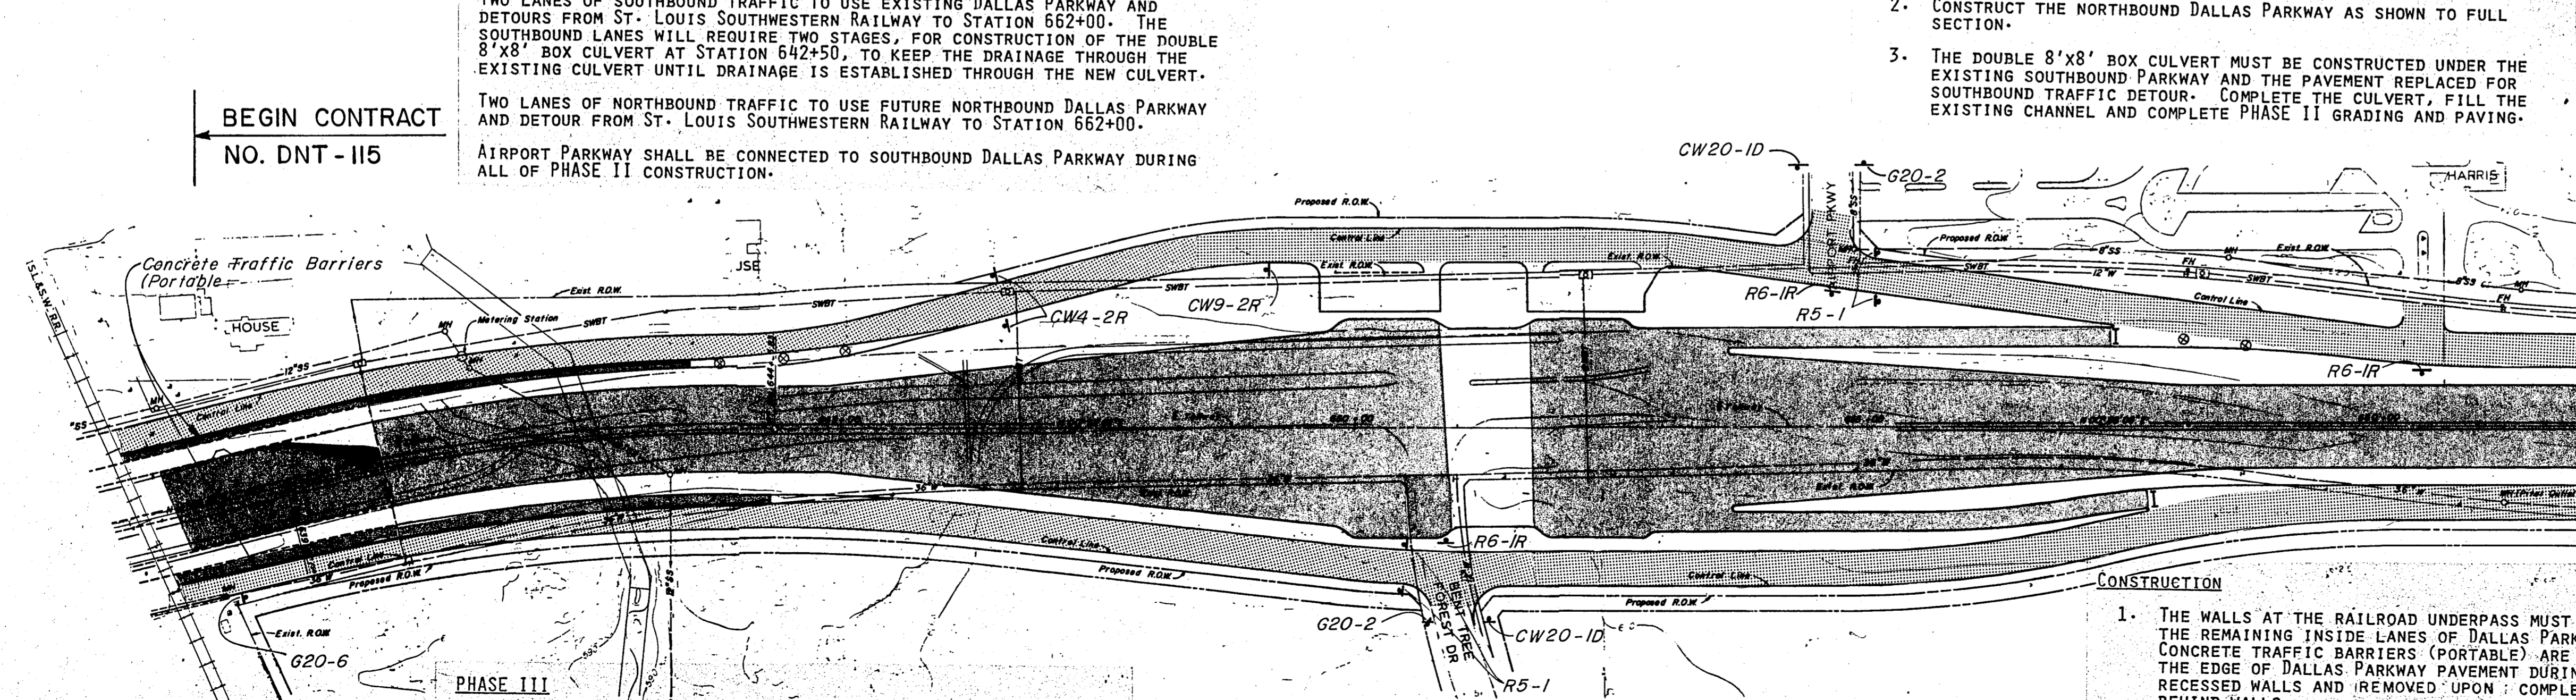


**PHASE III**  
TRAFFIC PLACED ON COMPLETED DALLAS PARKWAY ONE-WAY ON EACH ROAD REDUCED TO TWO LANES AT THE ST. LOUIS SOUTHWESTERN RAILWAY.  
BARRICADES WILL BE MAINTAINED AT RAMPS UNTIL ALL SECTIONS OF THE DALLAS NORTH TOLLWAY ARE COMPLETED.

- CONSTRUCTION**
- THE WALLS AT THE RAILROAD UNDERPASS MUST BE CONSTRUCTED AND THE REMAINING INSIDE LANES OF DALLAS PARKWAY COMPLETED. CONCRETE TRAFFIC BARRIERS (PORTABLE) ARE TO BE PLACED ALONG THE EDGE OF DALLAS PARKWAY PAVEMENT DURING CONSTRUCTION OF RECESSED WALLS AND REMOVED UPON COMPLETION OF BACK FILL BEHIND WALLS.
  - CONSTRUCT DALLAS NORTH TOLLWAY.
  - ALL WALLS, GRADING, DRAINAGE AND STRUCTURES MUST BE COMPLETED PRIOR TO ANY TOLLWAY PAVING OPERATION BEGINNING.



**LEGEND**

	Construction
	Traffic Lanes
	Detours
	Barricades
	Vertical Panel
	Vertical Panel With Flashers
	Barrel With Flasher
	Barrel
	Sign

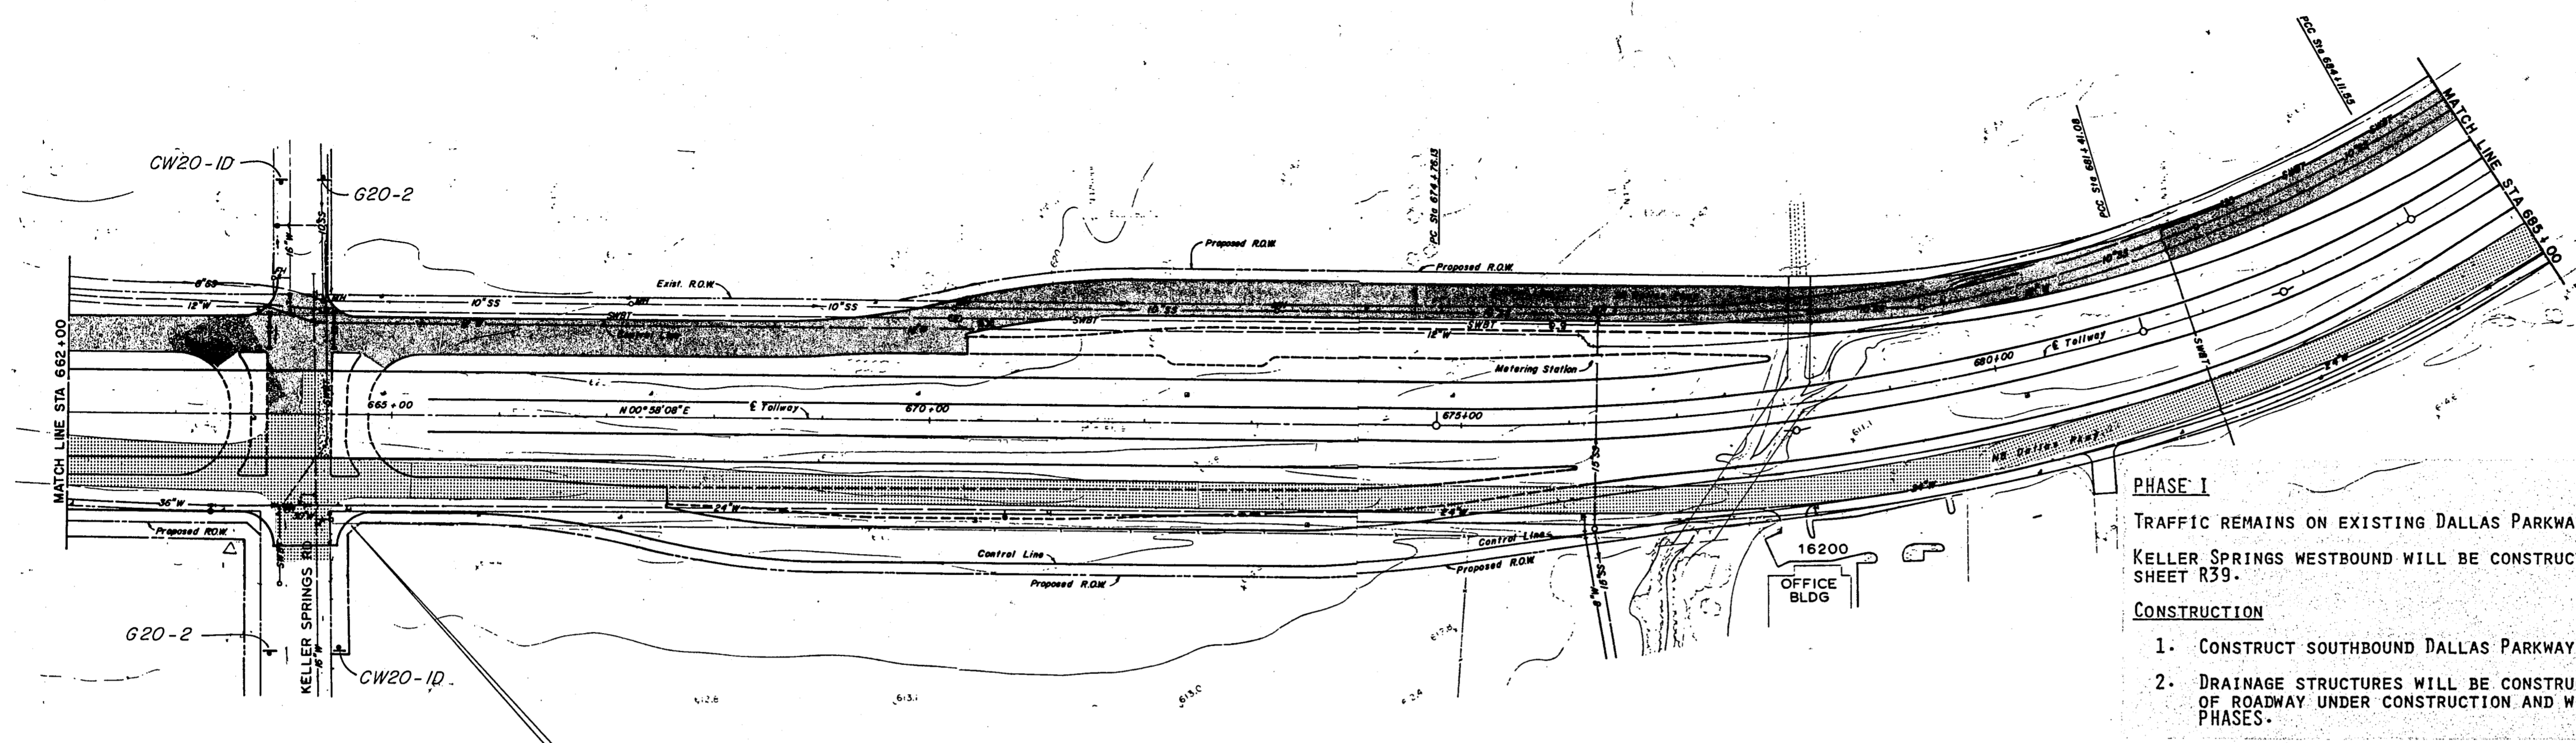


**PHASE I**  
 TRAFFIC REMAINS ON EXISTING DALLAS PARKWAY.  
 KELLER SPRINGS WESTBOUND WILL BE CONSTRUCTED UNDER TRAFFIC. SEE SHEET R39.

**CONSTRUCTION**

1. CONSTRUCT SOUTHBOUND DALLAS PARKWAY AS SHOWN.
2. DRAINAGE STRUCTURES WILL BE CONSTRUCTED ONLY UNDER THAT PORTION OF ROADWAY UNDER CONSTRUCTION AND WILL BE COMPLETED IN OTHER PHASES.


See Sheet R39 for Intersection Details

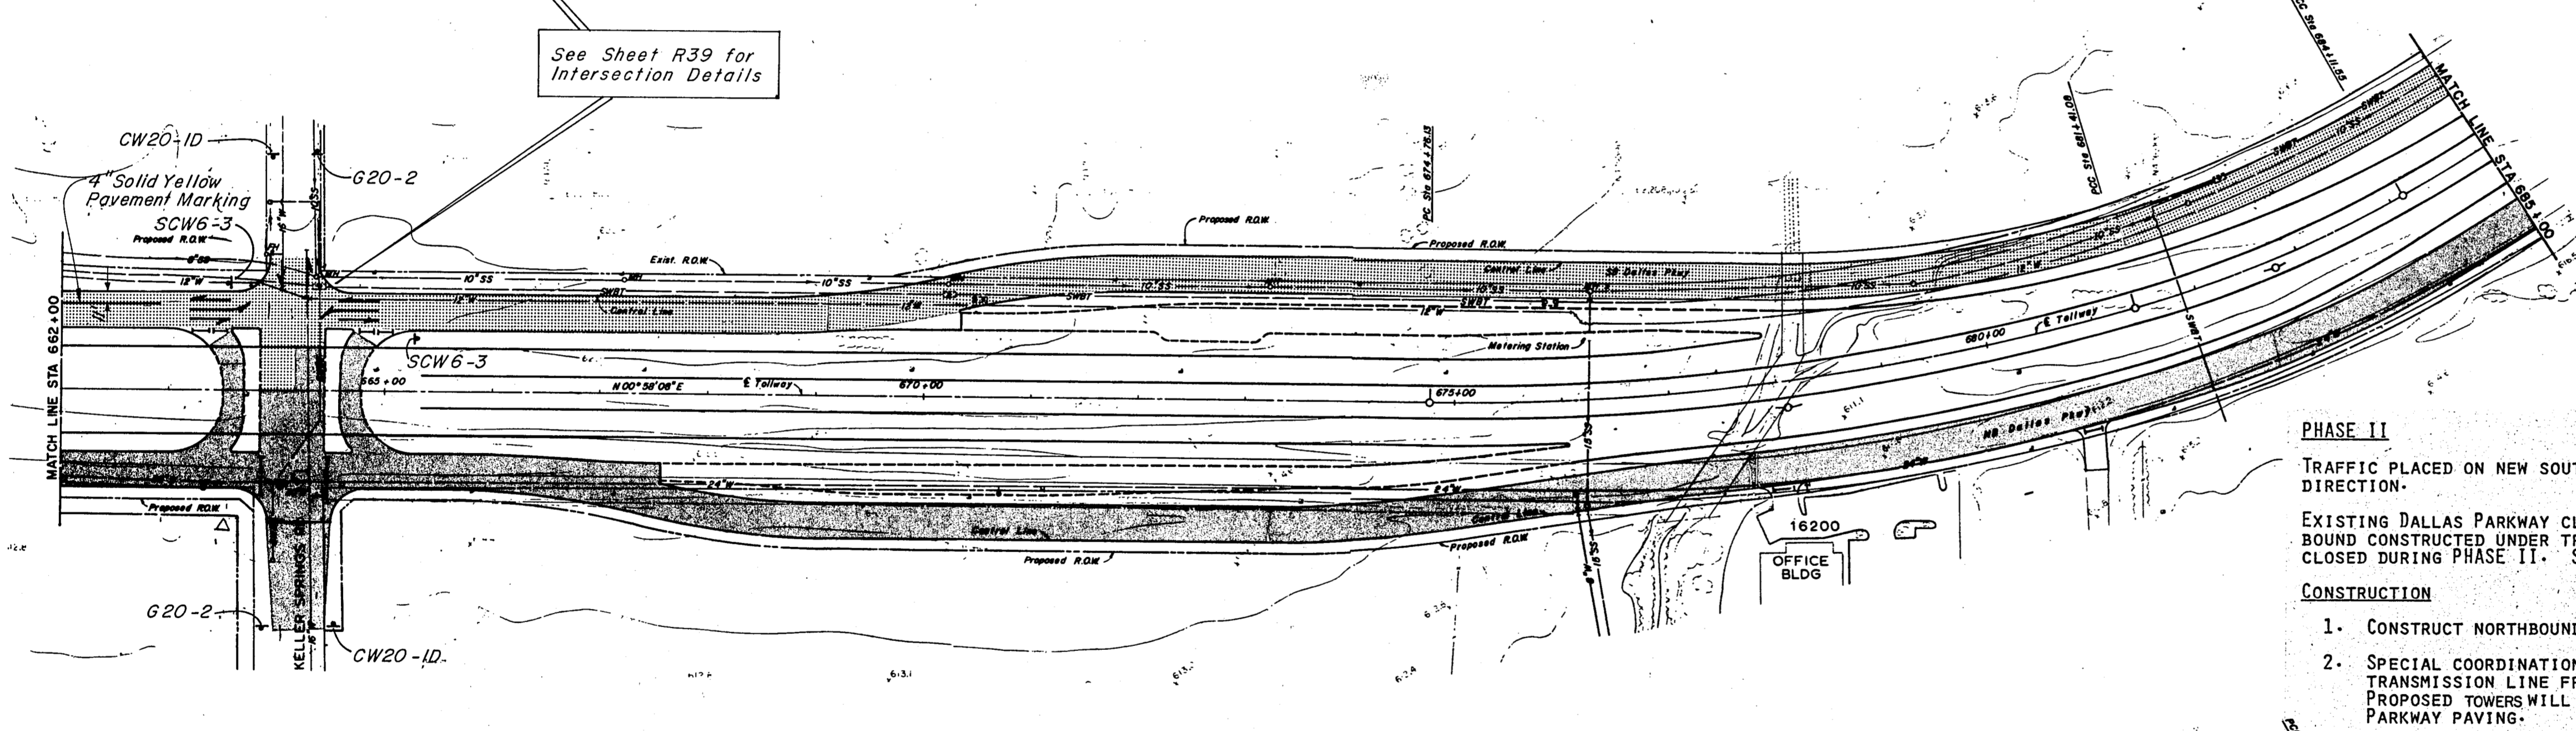

**PHASE II**  
 TRAFFIC PLACED ON NEW SOUTHBOUND DALLAS PARKWAY ONE LANE IN EACH DIRECTION.  
 EXISTING DALLAS PARKWAY CLOSED TO TRAFFIC WITH KELLER SPRINGS EASTBOUND CONSTRUCTED UNDER TRAFFIC. THE DRIVES ON EAST SIDE SHALL BE CLOSED DURING PHASE II. SEE SHEET R39.

**CONSTRUCTION**

1. CONSTRUCT NORTHBOUND DALLAS PARKWAY AS SHOWN.
2. SPECIAL COORDINATION WITH UTILITY COMPANY FOR THE RELOCATION OF TRANSMISSION LINE FROM KELLER SPRINGS NORTH WILL BE REQUIRED. PROPOSED TOWERS WILL BE CONSTRUCTED INSIDE THE NORTHBOUND DALLAS PARKWAY PAVING.

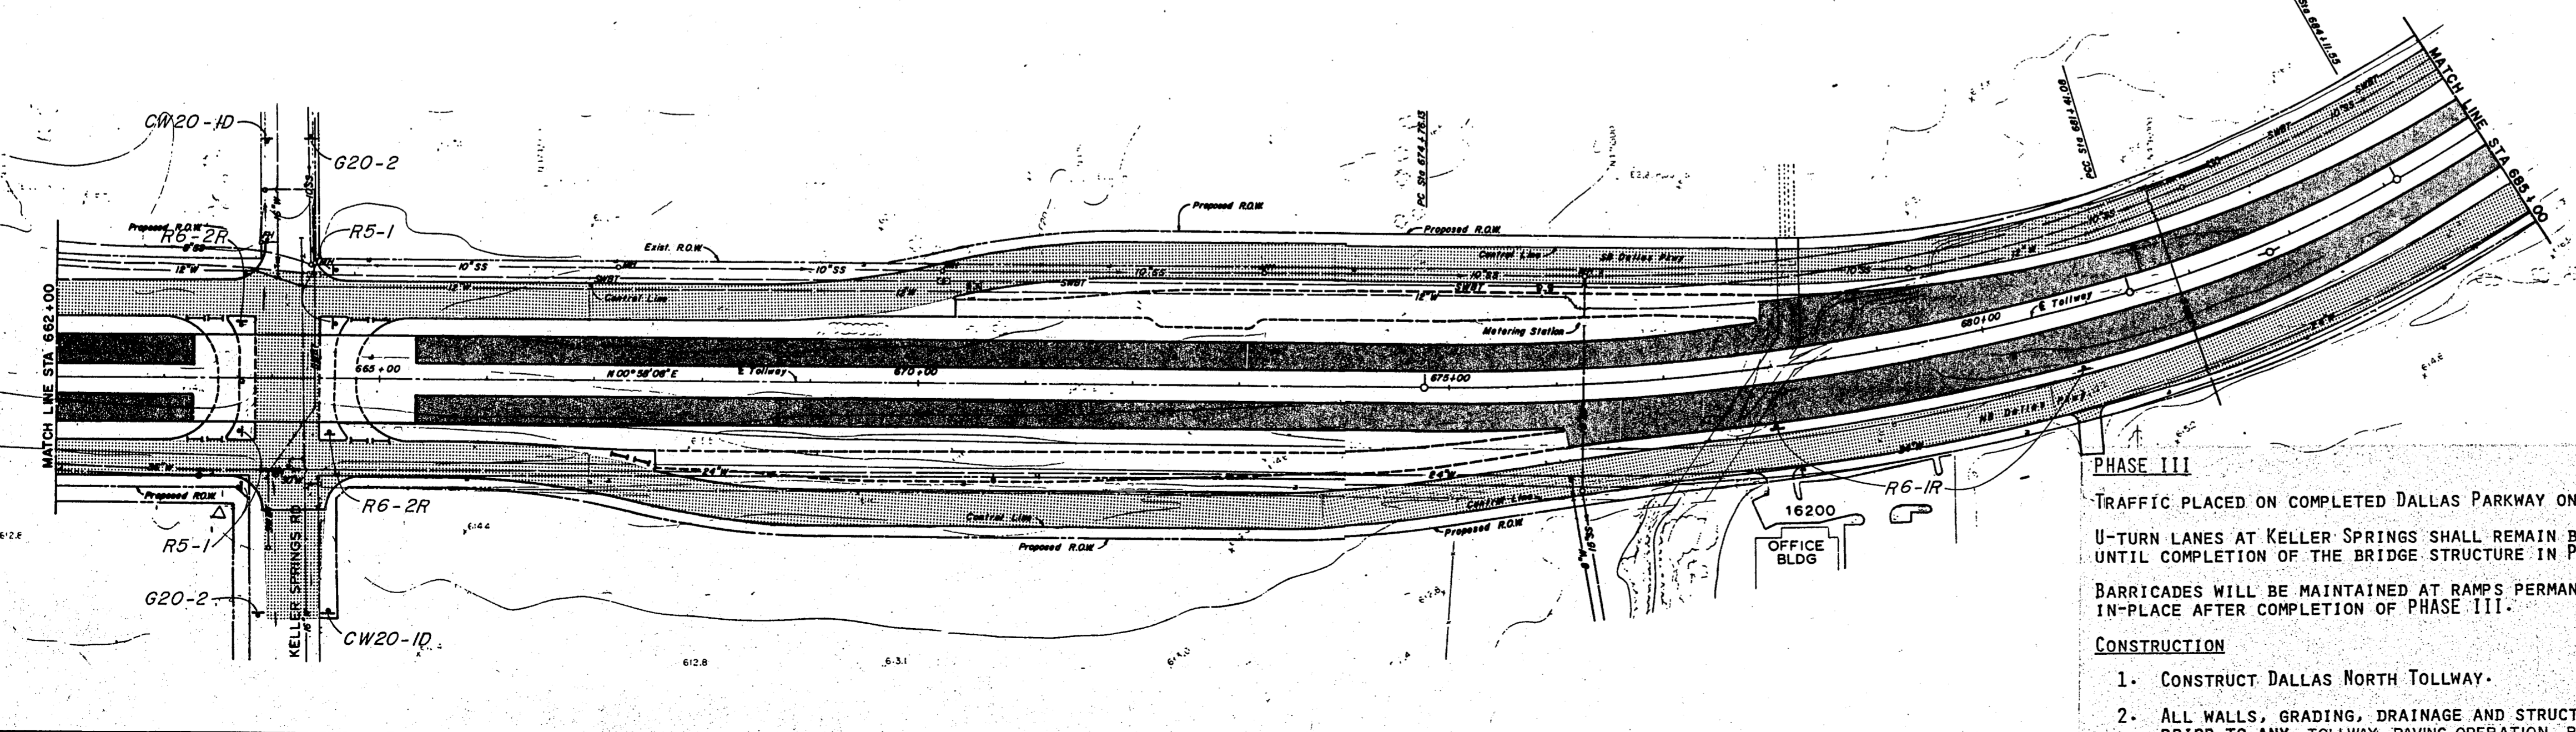

**PHASE III**  
 TRAFFIC PLACED ON COMPLETED DALLAS PARKWAY ONE-WAY ON EACH ROAD. U-TURN LANES AT KELLER SPRINGS SHALL REMAIN BARRICADED TO TRAFFIC UNTIL COMPLETION OF THE BRIDGE STRUCTURE IN PHASE III.  
 BARRICADES WILL BE MAINTAINED AT RAMPS PERMANENTLY AND SHALL BE LEFT IN-PLACE AFTER COMPLETION OF PHASE III.


**CONSTRUCTION**

1. CONSTRUCT DALLAS NORTH TOLLWAY.
2. ALL WALLS, GRADING, DRAINAGE AND STRUCTURES MUST BE COMPLETED PRIOR TO ANY TOLLWAY PAVING OPERATION BEGINNING.

**ASBULT PLANS**

NO.	REVISION	BY	DATE
TEXAS TURNPIKE AUTHORITY DALLAS NORTH TOLLWAY			
SUGGESTED CONSTRUCTION SEQUENCE AND TRAFFIC CONTROL STA. 662+00 TO STA. 685+00			
<b>Gibbs &amp; Hill, Inc.</b> ENGINEERS DESIGNERS CONSTRUCTORS DALLAS			SECTION VII
DRAWN	VER	DATE	5/15/84
CHECKED	DWC	DATE	8/3/84
DESIGNED	JOP	DATE	5/3/84
SCALE	1" = 100'		
CONTRACT NO. DNT-115 SHEET R35 OF R85			



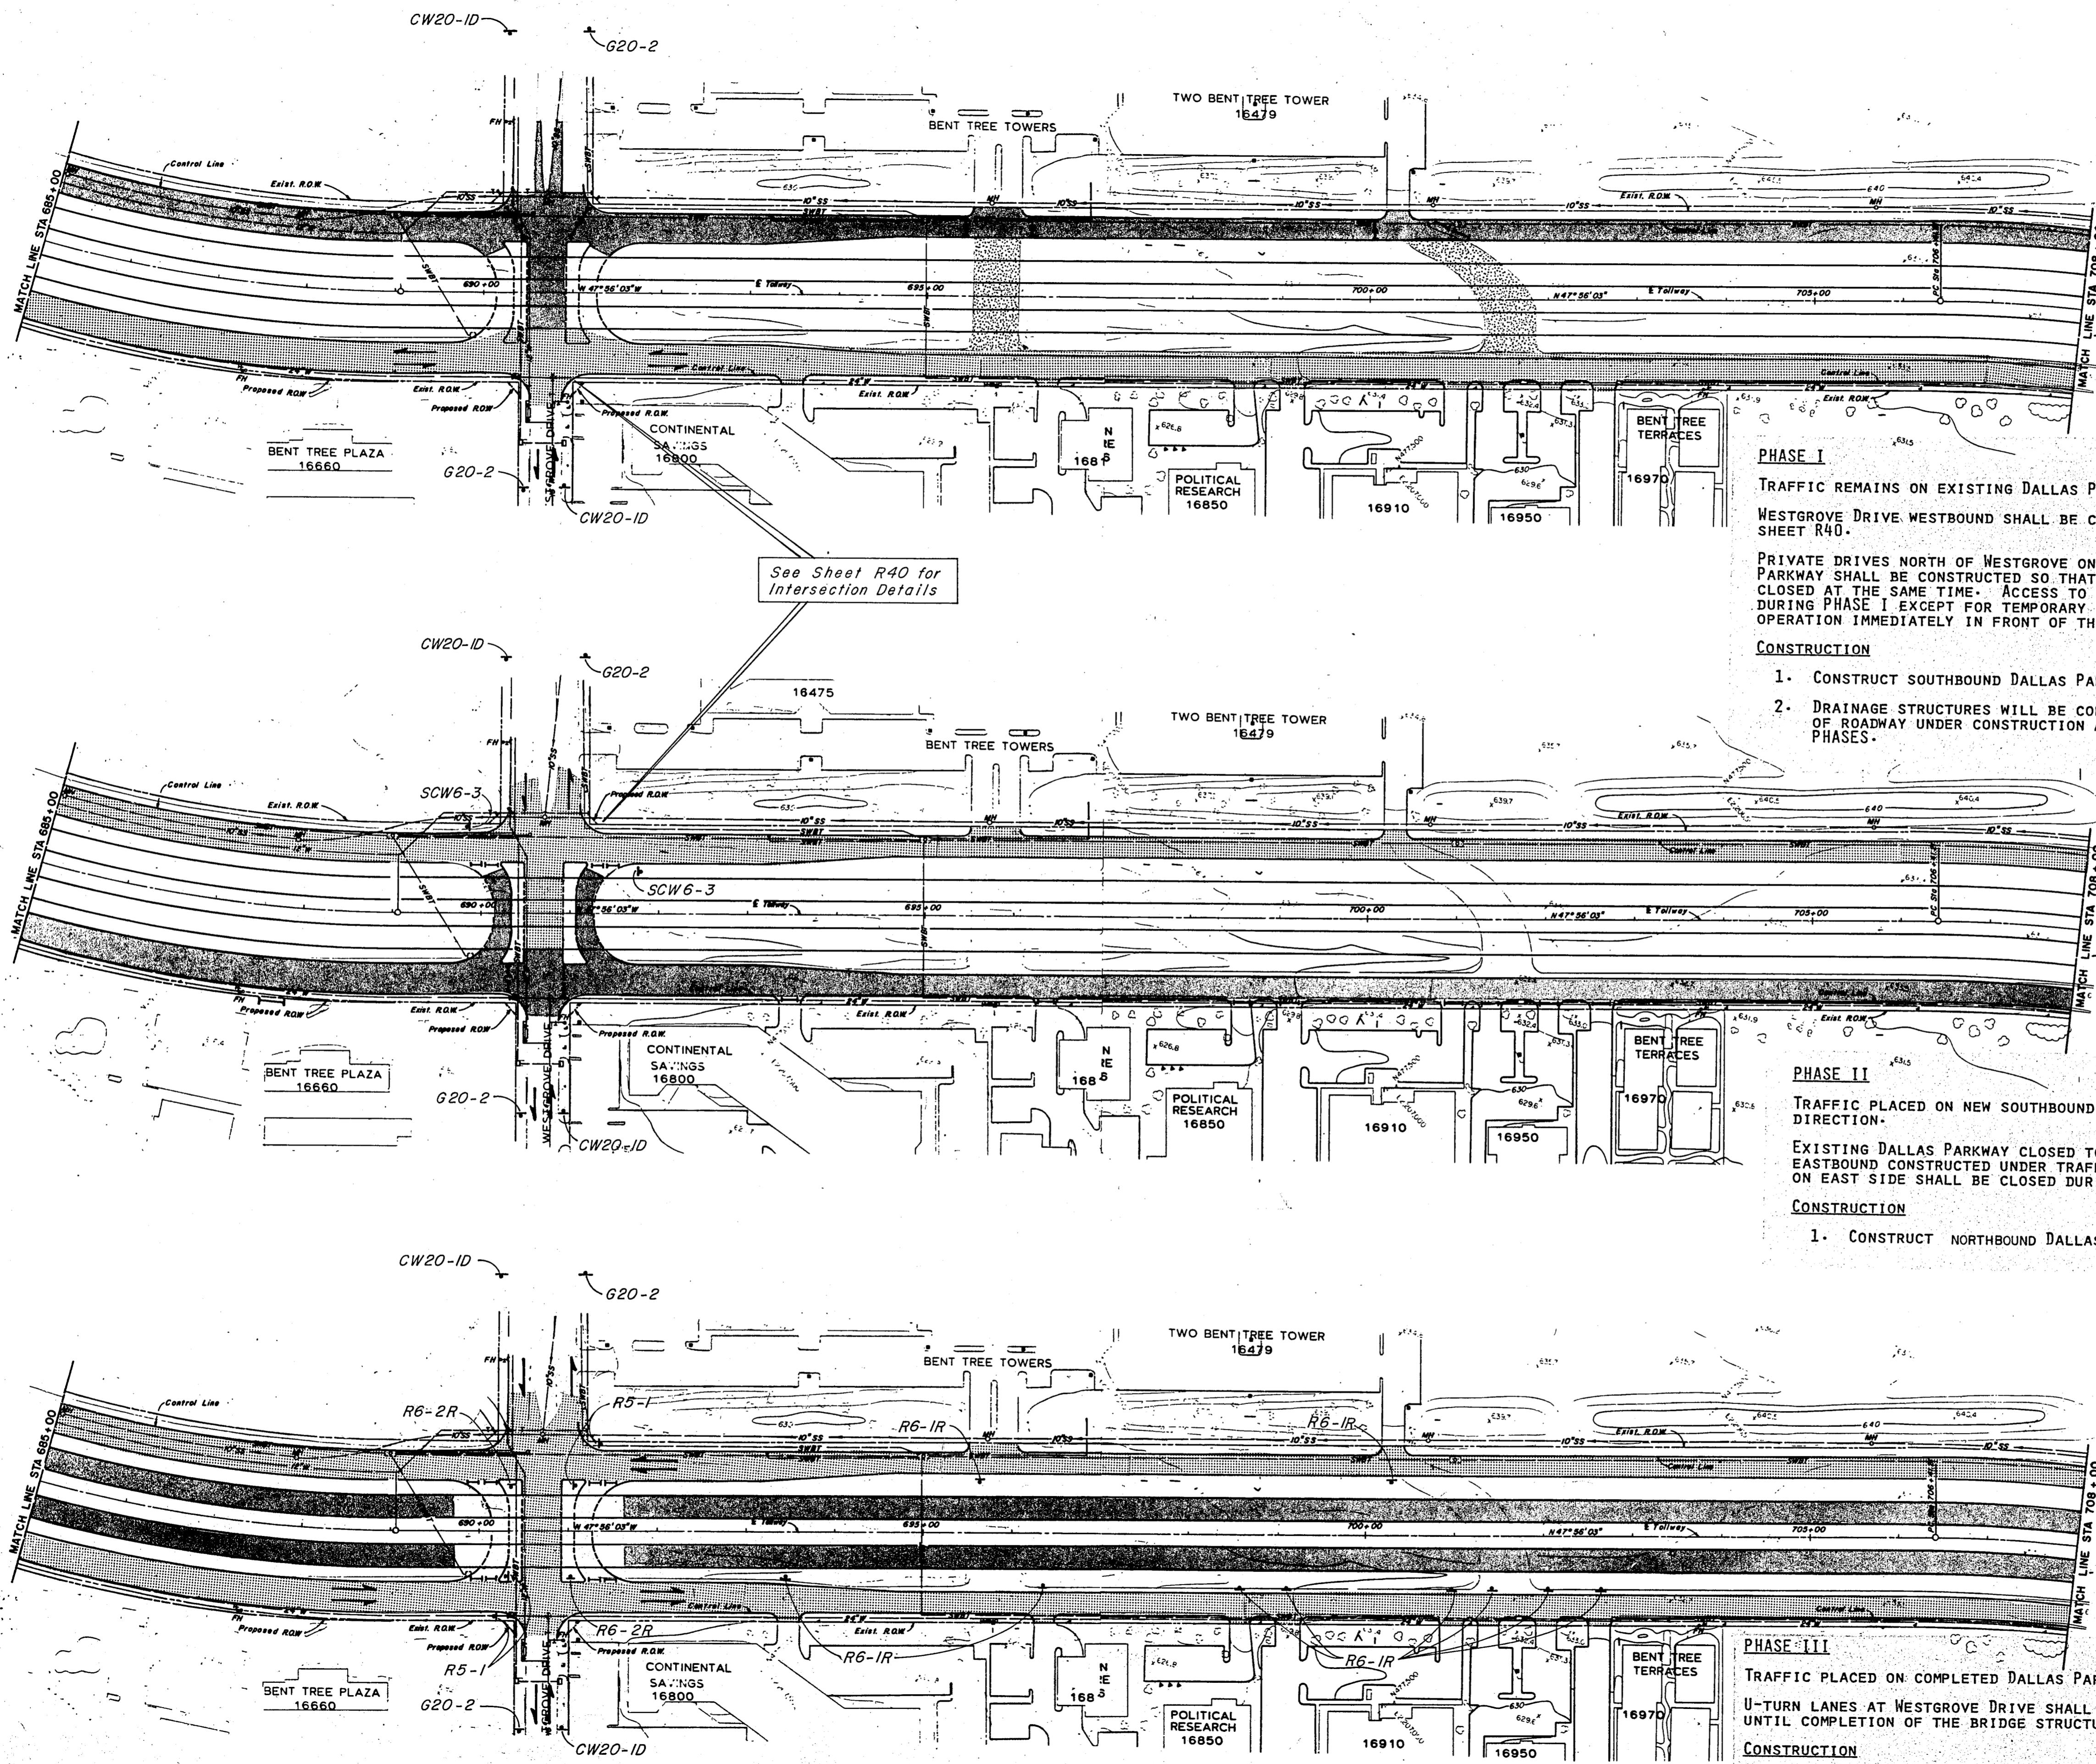

**LEGEND**

	Construction
	Traffic Lanes
	Detours
	Barricades
	Vertical Panel
	Vertical Panel With Flashers
	Barrel With Flasher
	Barrel
	Sign

**PHASE I**  
 TRAFFIC REMAINS ON EXISTING DALLAS PARKWAY.  
 WESTGROVE DRIVE WESTBOUND SHALL BE CONSTRUCTED UNDER TRAFFIC. SEE SHEET R40.

PRIVATE DRIVES NORTH OF WESTGROVE ON THE WEST SIDE OF DALLAS PARKWAY SHALL BE CONSTRUCTED SO THAT NO TWO ADJACENT DRIVES ARE CLOSED AT THE SAME TIME. ACCESS TO DALLAS PARKWAY WILL BE MAINTAINED DURING PHASE I EXCEPT FOR TEMPORARY CLOSINGS DURING CONSTRUCTION OPERATION IMMEDIATELY IN FRONT OF THE DRIVES.

- CONSTRUCTION**
1. CONSTRUCT SOUTHBOUND DALLAS PARKWAY.
  2. DRAINAGE STRUCTURES WILL BE CONSTRUCTED ONLY UNDER THAT PORTION OF ROADWAY UNDER CONSTRUCTION AND WILL BE COMPLETED IN OTHER PHASES.

**PHASE II**  
 TRAFFIC PLACED ON NEW SOUTHBOUND DALLAS PARKWAY ONE-LANE IN EACH DIRECTION.  
 EXISTING DALLAS PARKWAY CLOSED TO TRAFFIC WITH WESTGROVE DRIVE EASTBOUND CONSTRUCTED UNDER TRAFFIC. (SEE SHEET R40.) ALL DRIVES ON EAST SIDE SHALL BE CLOSED DURING PHASE II.

- CONSTRUCTION**
1. CONSTRUCT NORTHBOUND DALLAS PARKWAY.

**PHASE III**  
 TRAFFIC PLACED ON COMPLETED DALLAS PARKWAY ONE-WAY ON EACH ROAD. U-TURN LANES AT WESTGROVE DRIVE SHALL REMAIN BARRICADED TO TRAFFIC UNTIL COMPLETION OF THE BRIDGE STRUCTURE IN PHASE III.










- CONSTRUCTION**
1. CONSTRUCT DALLAS NORTH TOLLWAY.
  2. ALL WALLS, GRADING, DRAINAGE AND STRUCTURES MUST BE COMPLETED PRIOR TO ANY TOLLWAY PAVING OPERATION BEGINNING.


**ASBUILT PLANS**

NO.	REVISION	BY	DATE
<b>TEXAS TURNPIKE AUTHORITY DALLAS NORTH TOLLWAY</b>			
<b>SUGGESTED CONSTRUCTION SEQUENCE AND TRAFFIC CONTROL STA. 685+00 TO STA. 708+00</b>			
<b>Gibbs &amp; Hill, Inc.</b> ENGINEERS DESIGNERS CONSTRUCTORS DALLAS			<b>SECTION VII</b>
DRAWN	VER	DATE 5/17/84	DESIGNED JOP DATE 5/4/84
CHECKED	DWC	DATE 8/3/84	SCALE 1"=100'
<b>CONTRACT NO. DNT-115 SHEET R36 OF R85</b>			

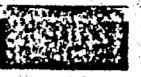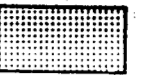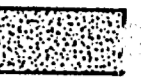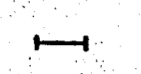

**LEGEND**

-  Construction
-  Traffic Lanes
-  Delours
-  Barricades
-  Vertical Panel
-  Vertical Panel With Flashers
-  Barrel With Flasher
-  Barrel
-  Sign

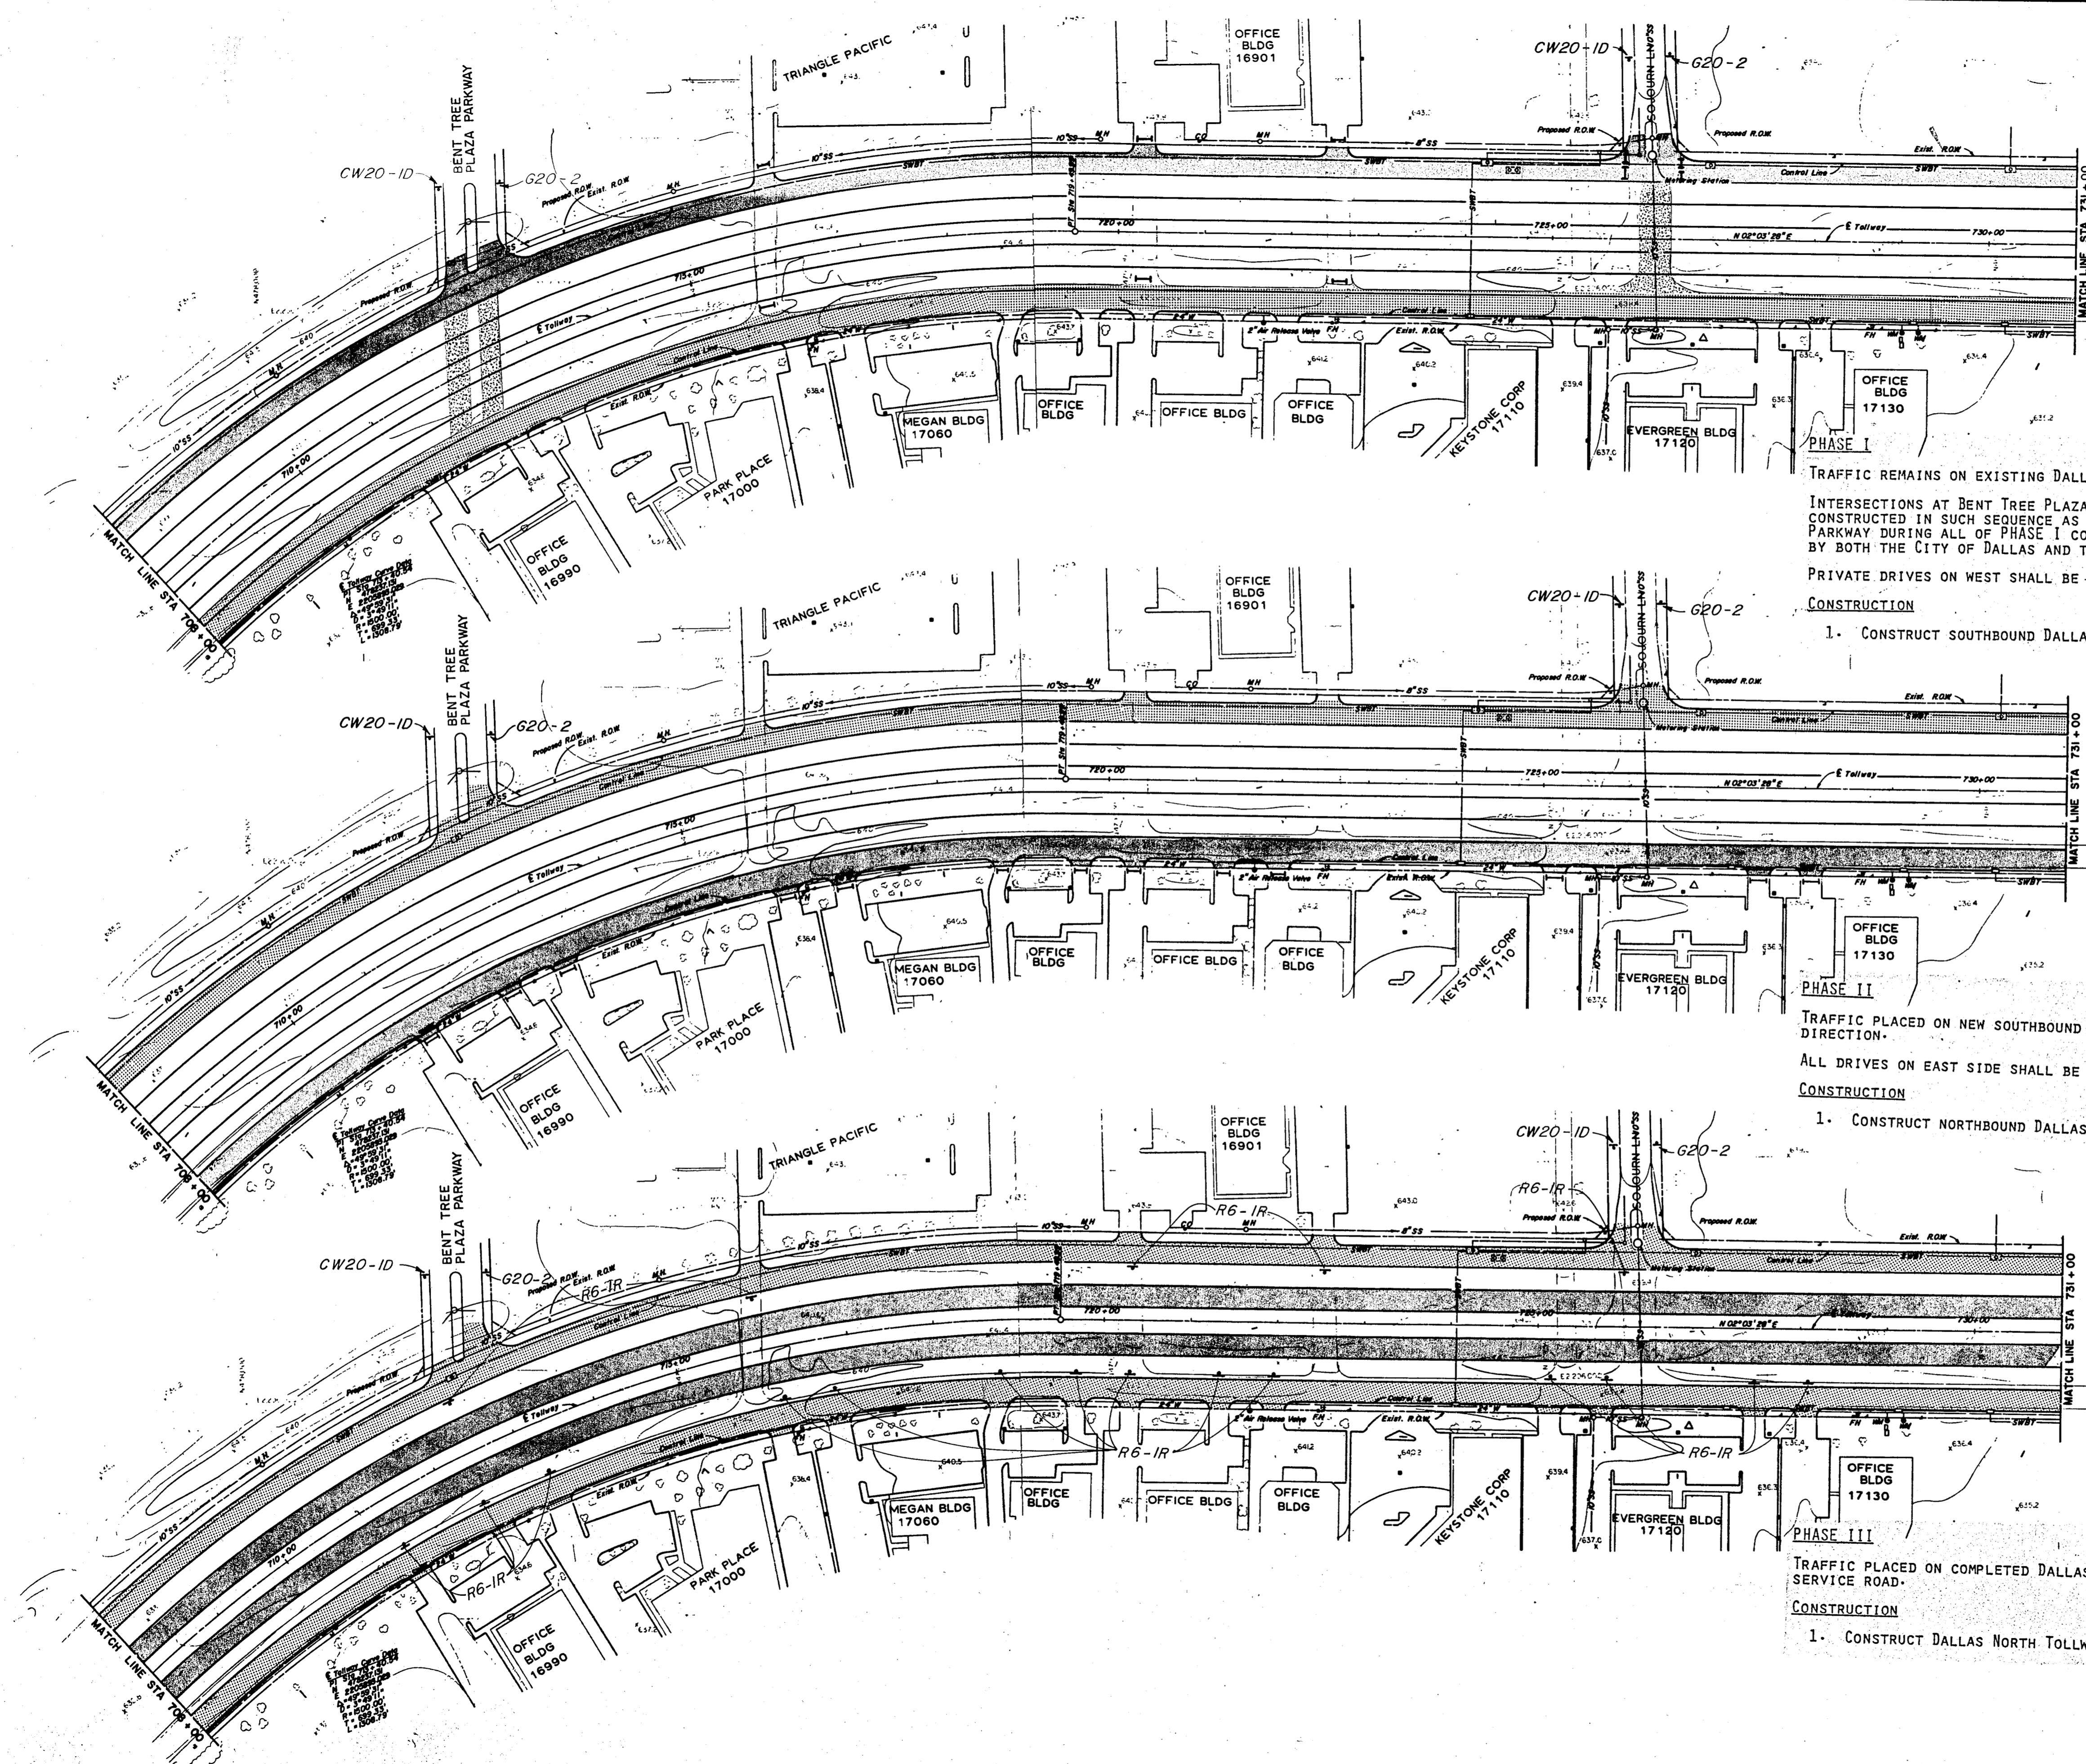

TRAFFIC REMAINS ON EXISTING DALLAS PARKWAY.  
 INTERSECTIONS AT BENT TREE PLAZA PARKWAY AND SOJOURN LANE SHALL BE CONSTRUCTED IN SUCH SEQUENCE AS TO MAINTAIN TWO LANE ACCESS TO DALLAS PARKWAY DURING ALL OF PHASE I CONSTRUCTION, UNLESS CLOSING IS APPROVED BY BOTH THE CITY OF DALLAS AND THE CITY OF ADDISON.  
 PRIVATE DRIVES ON WEST SHALL BE CLOSED TO DALLAS PARKWAY.

**CONSTRUCTION**  
 1. CONSTRUCT SOUTHBOUND DALLAS PARKWAY.

TRAFFIC PLACED ON NEW SOUTHBOUND DALLAS PARKWAY ONE LANE EACH DIRECTION.  
 ALL DRIVES ON EAST SIDE SHALL BE CLOSED DURING PHASE II.


**CONSTRUCTION**  
 1. CONSTRUCT NORTHBOUND DALLAS PARKWAY.

TRAFFIC PLACED ON COMPLETED DALLAS PARKWAY 2 LANES ONE-WAY ON EACH SERVICE ROAD.  
**CONSTRUCTION**  
 1. CONSTRUCT DALLAS NORTH TOLLWAY.

**ASBUILT PLANS**

NO.	REVISION	BY	DATE
TEXAS TURNPIKE AUTHORITY <b>DALLAS NORTH TOLLWAY</b>			
SUGGESTED CONSTRUCTION SEQUENCE AND TRAFFIC CONTROL STA. 708+00 TO STA. 731+00			
<b>Gibbs &amp; Hill, Inc.</b> ENGINEERS DESIGNERS CONSTRUCTORS DALLAS			<b>SECTION VII</b>
DRAWN <i>VER</i> DATE <i>5/14/84</i> CHECKED <i>DWC</i> DATE <i>8/3/84</i>	DESIGNED <i>JOP</i> DATE <i>5/14/84</i> SCALE <i>1"=100'</i>		
CONTRACT NO. <b>DNT-115</b> SHEET <b>R 37</b> OF <b>R 85</b>			



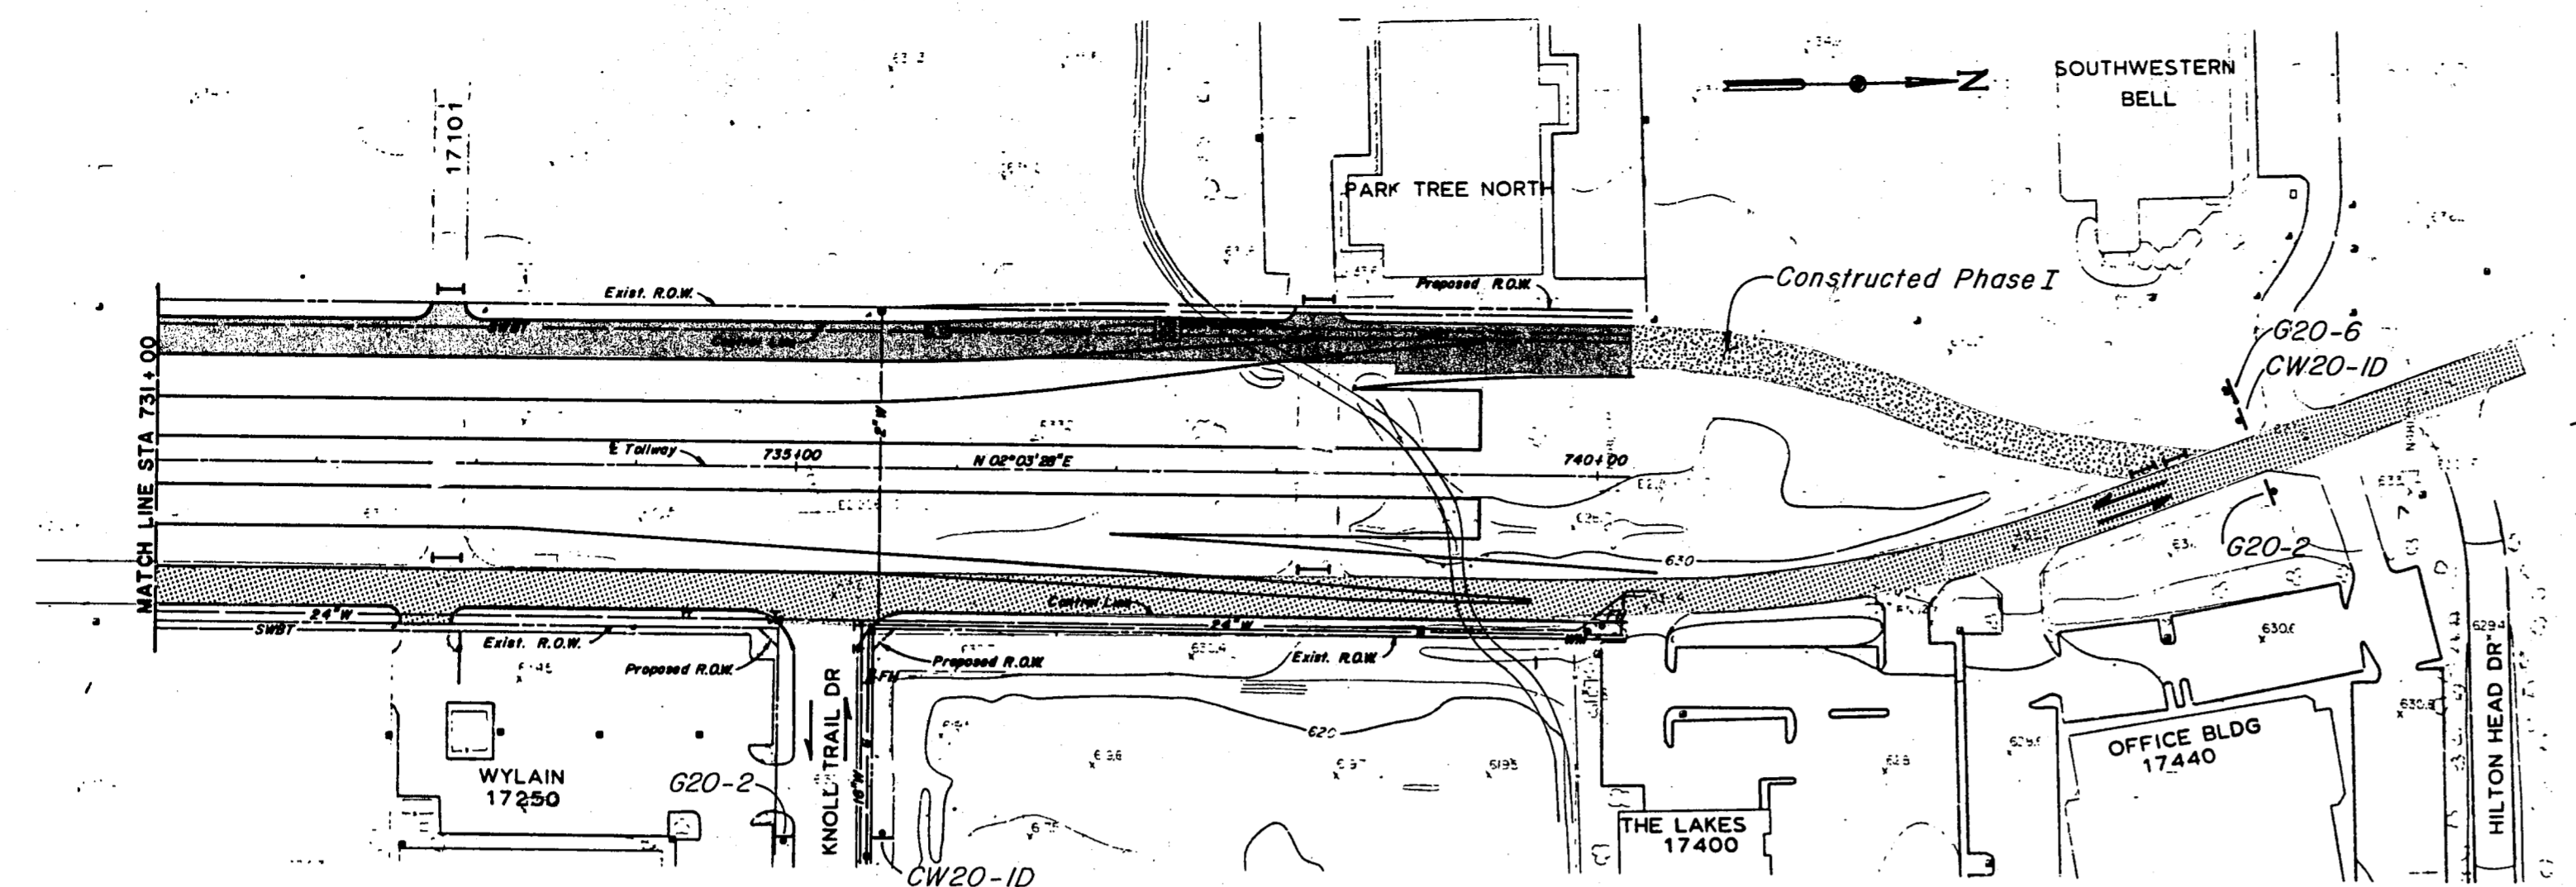


**PHASE I**  
 TRAFFIC REMAINS ON EXISTING DALLAS PARKWAY.  
 PRIVATE DRIVES ON WEST SHALL BE CLOSED TO DALLAS PARKWAY.

**CONSTRUCTION**

1. CONSTRUCT DRAINAGE CULVERTS WITH LATERALS AS COMPLETE AS POSSIBLE WITHOUT DISRUPTION TO TRAFFIC.
2. CONSTRUCT SOUTHBOUND DALLAS PARKWAY.
3. CONSTRUCT DETOUR REQUIRED FOR PHASE II.

**LEGEND**

- Construction
- Traffic Lanes
- Detours
- Barricades
- Vertical Panel
- Vertical Panel With Flashers
- Barrel With Flasher
- Barrel
- Sign

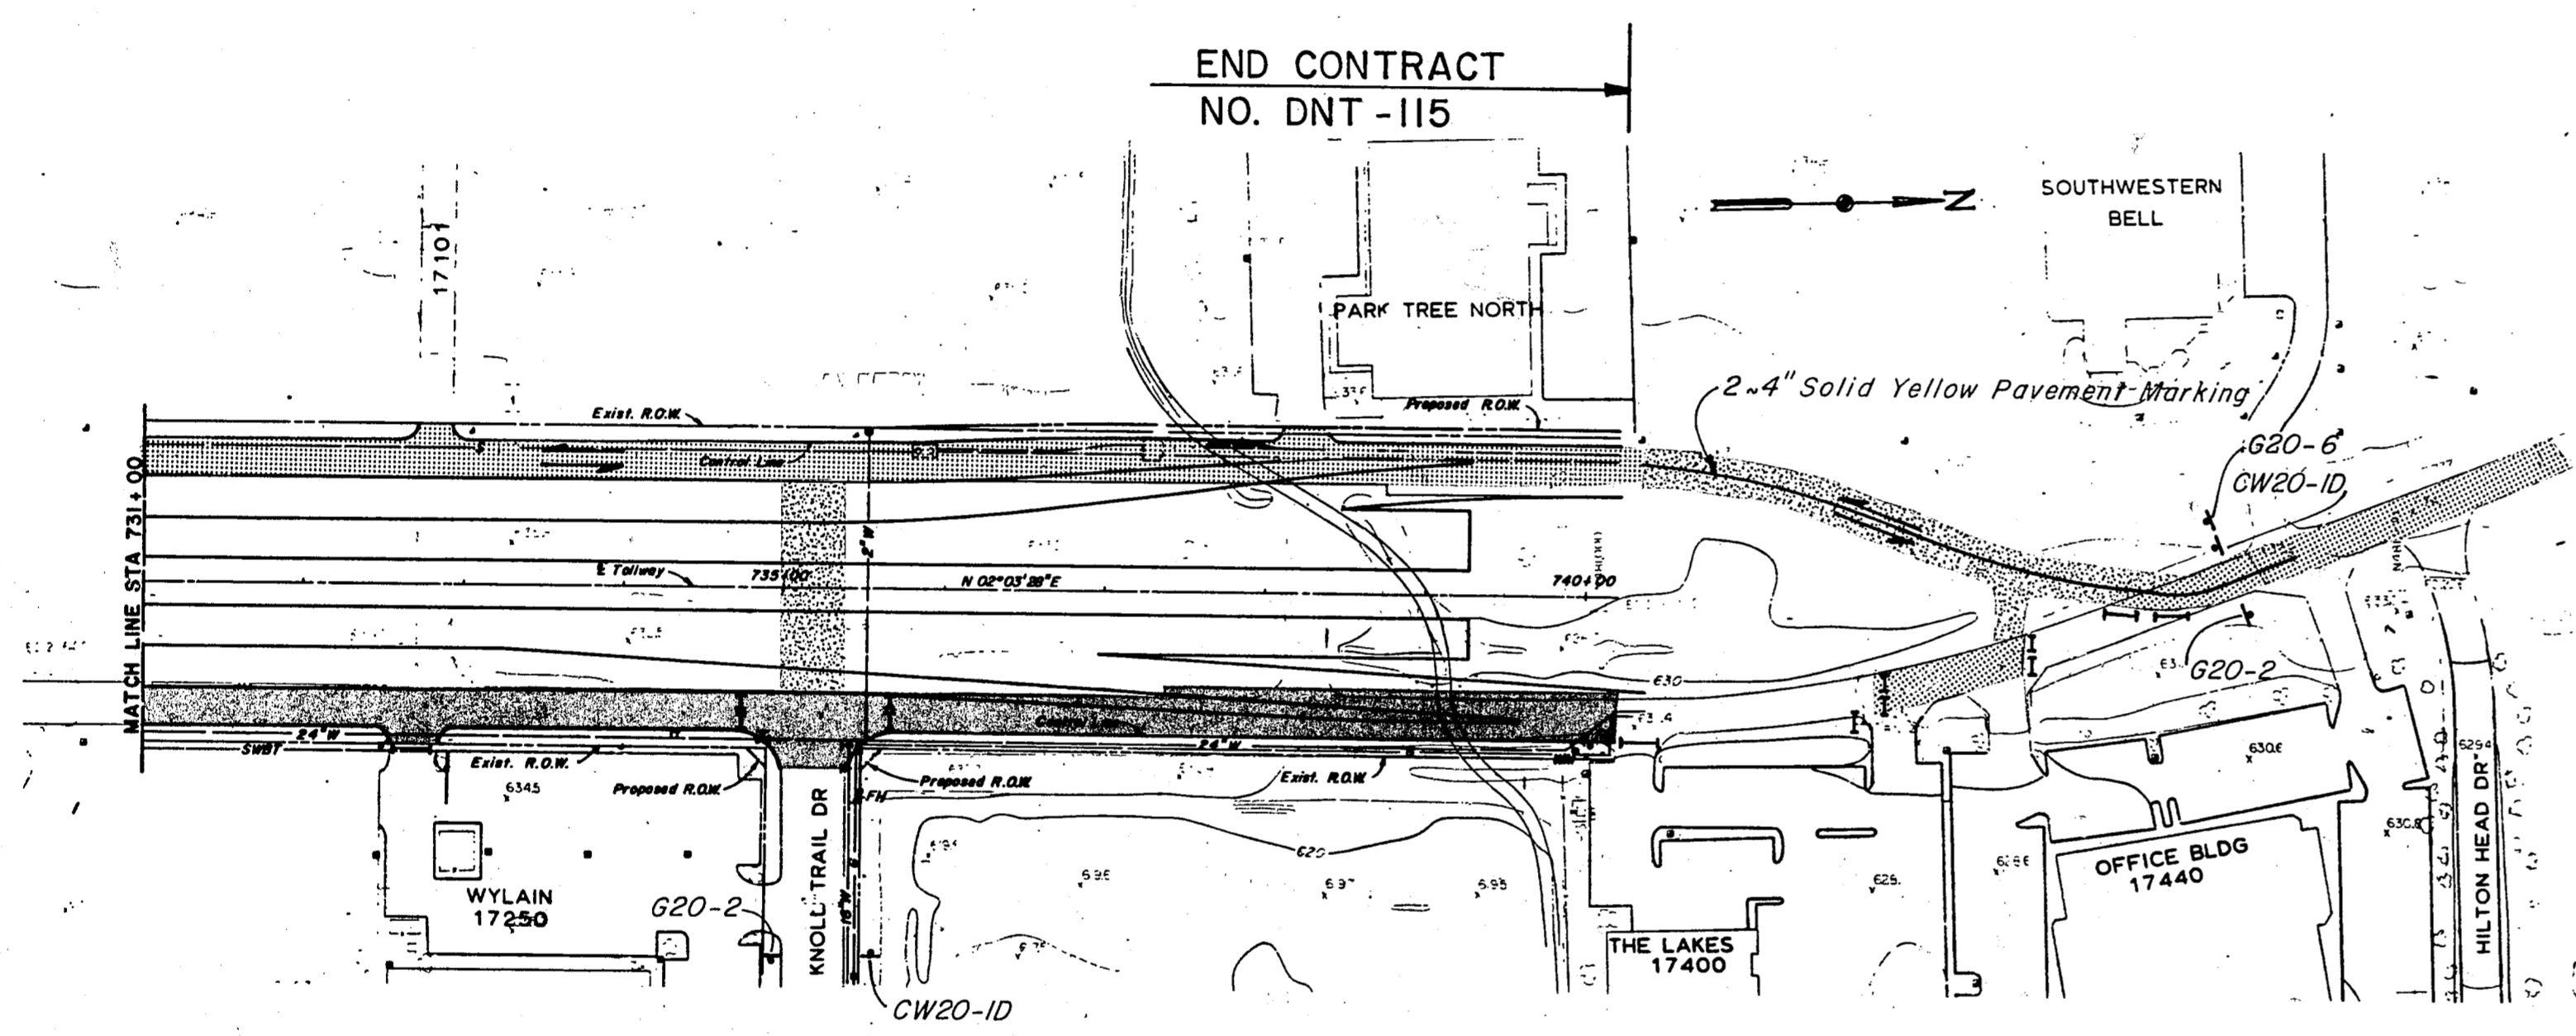

**PHASE II**  
 PLACE TRAFFIC ON NEW SOUTHBOUND DALLAS PARKWAY AND DETOUR WITH ONE LANE IN EACH DIRECTION.

KNOLL TRAIL INTERSECTION SHALL BE CONNECTED BY TEMPORARY DETOUR TO THE SOUTHBOUND DALLAS PARKWAY AND CONSTRUCTED IN SUCH SEQUENCE THAT TWO LANES OF TRAFFIC ARE MAINTAINED DURING CONSTRUCTION OF PHASE II.


**CONSTRUCTION**

1. CONSTRUCT NORTHBOUND DALLAS PARKWAY.

SUMMARY  
 CONSTRUCTION WARNING SIGNS

SIGNS	SIZE	SHEET NO.				
		R-34	R-35	R-36	R-37	R-38
<b>PHASE I</b>						
G 20-2 (PHASE II & III)	60 x 24	2	2	2	2	2
G 20-6 (PHASE II & III)	48 x 42	1				1
CW 20-10 (PHASE II & III)	48 x 48	2	2	2	2	2
CW 1-6	30 x 30			2		
BARRICADE (TYPE I)		2			3	
BARRICADE (TYPE II)		4			4	
BARRICADE (TYPE III)		11	7	12	12	6
<b>PHASE II</b>						
CW 1-6	48 x 24	1		2		
SW 6-1	48 x 48					
SCW 6-3	30 x 30	1	2	2		
M4-9L	48 x 48			1		
M4-10L	48 x 48	1				
BARRICADE (TYPE I)				9	15	2
BARRICADE (TYPE II)				2	2	4
BARRICADE (TYPE III)			2	6	13	12
<b>PHASE III</b>						
R 5-1*	30 x 30	2	4	4		
R 6-1R*	36 x 12	3				
R 6-2R*	18 x 24		2	10	19	4
SCW 6-3	30 x 30					1
CW 4-2R	36 x 36	2				
CW 9-2R	36 x 3	1				
BARRICADE (TYPE III)		2	8	8		2

\* SIGNS TO BE FURNISHED BY OWNER. THE CONTRACTOR SHALL FURNISH AND INSTALL SIGN POSTS AND INSTALL SIGNS.

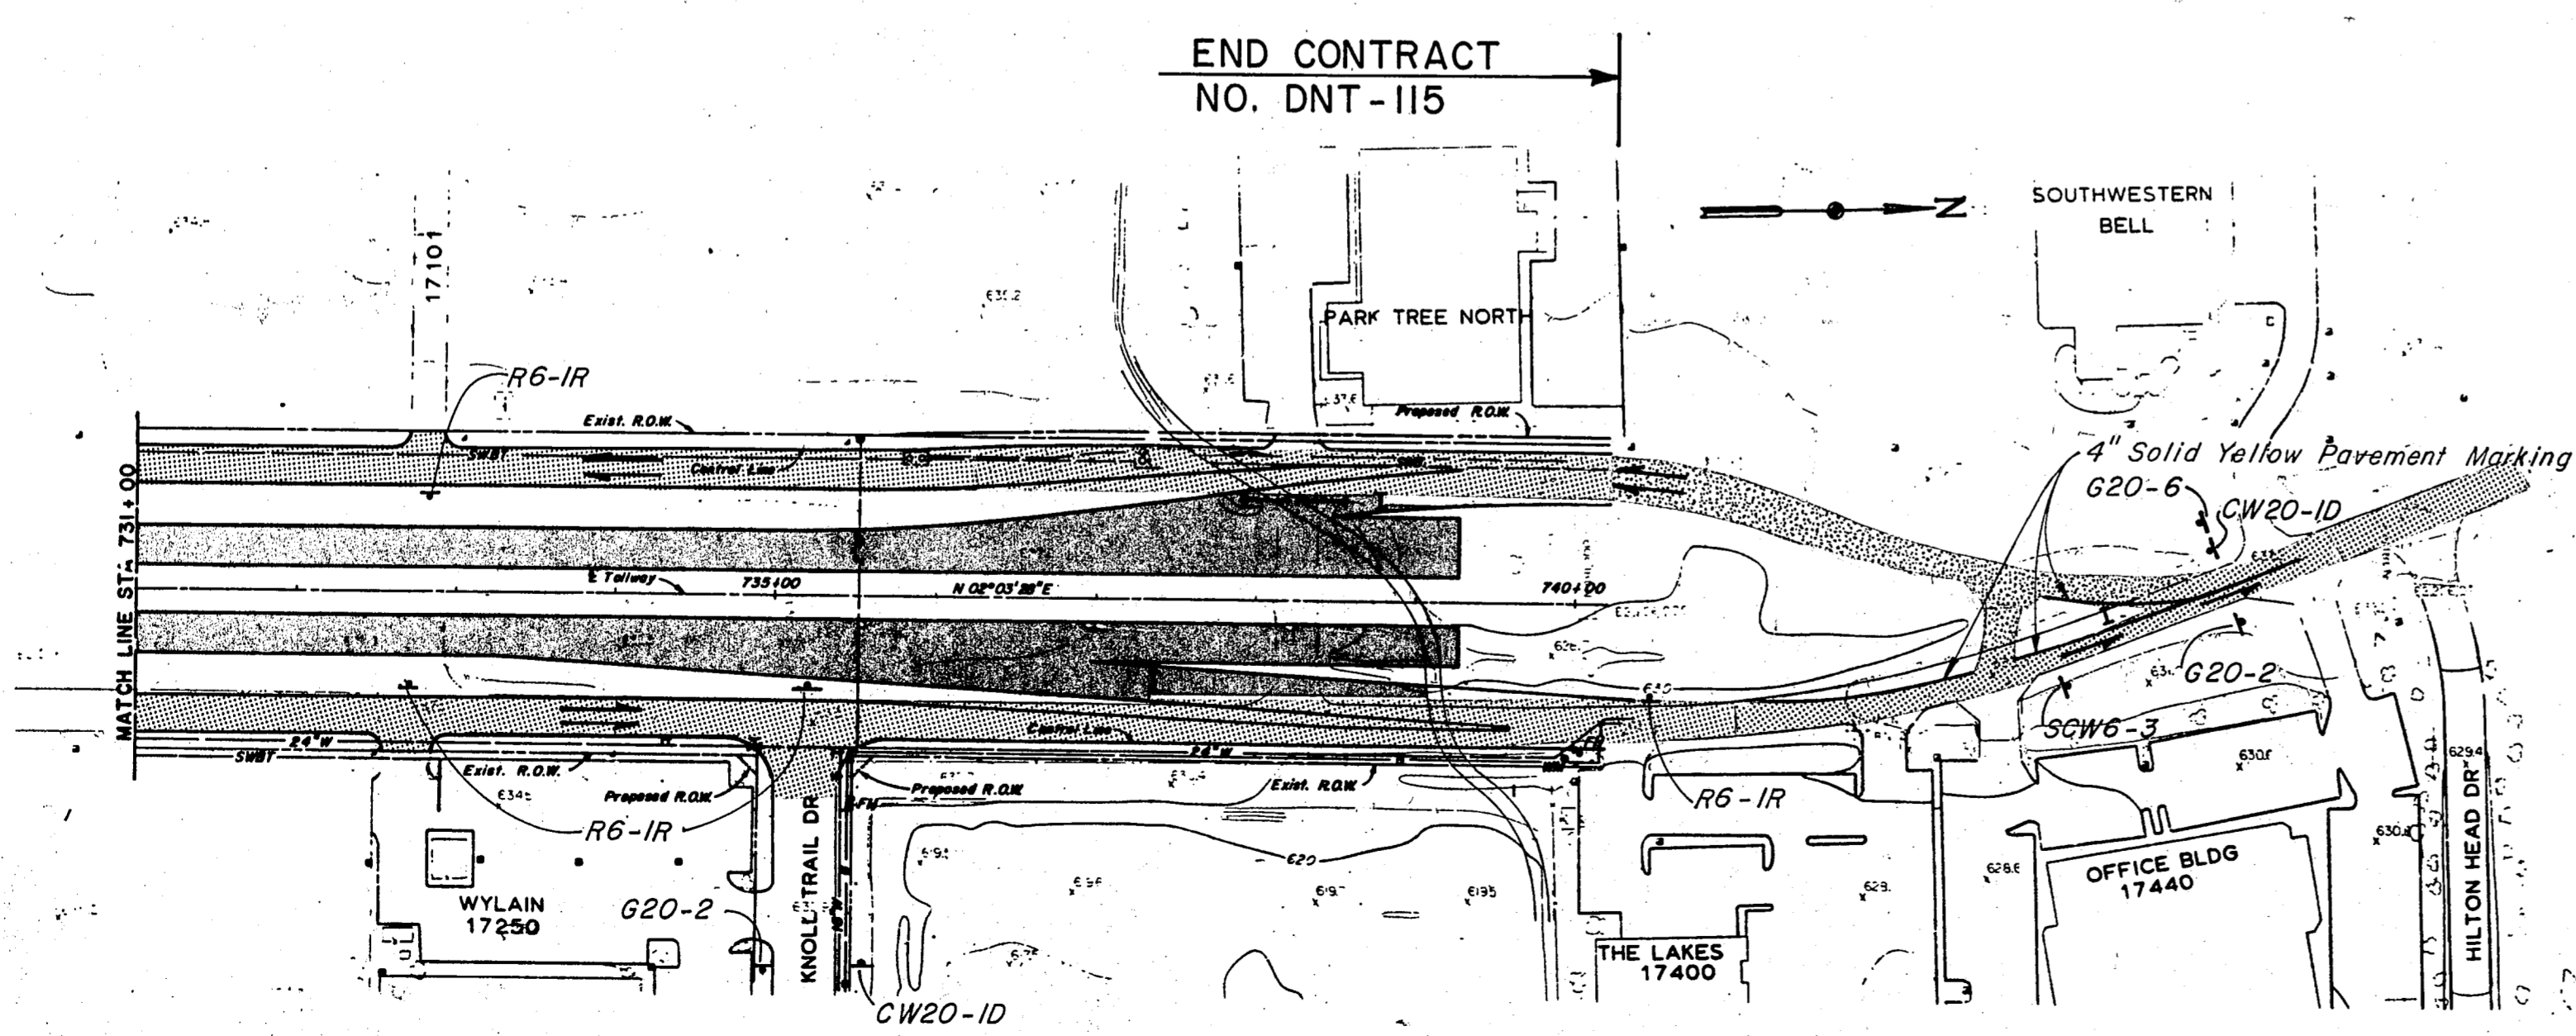

**PHASE III**  
 TRAFFIC PLACED ON COMPLETED DALLAS PARKWAY AND DETOUR ONE-WAY ON EACH ROAD.

BARRICADE RAMPS UNTIL COMPLETION OF ALL SECTIONS OF THE DALLAS NORTH TOLLWAY.


**CONSTRUCTION**

1. CONSTRUCT DALLAS NORTH TOLLWAY.

**ASBUILT PLANS**

NO.	REVISION	BY	DATE
<b>TEXAS TURNPIKE AUTHORITY</b>			
<b>DALLAS NORTH TOLLWAY</b>			
SUGGESTED CONSTRUCTION SEQUENCE AND TRAFFIC CONTROL STA. 731+00 TO STA. 740+37			
<b>Gibbs &amp; Hill, Inc.</b> ENGINEERS DESIGNERS CONSTRUCTORS			SECTION VII
DRAWN VER	DATE 5/16/84	DESIGNED JOP	DATE 5/7/84
CHECKED DWC	DATE 8/3/84	SCALE 1"=100'	
CONTRACT NO. DNT-115 SHEET R 38 OF R85			



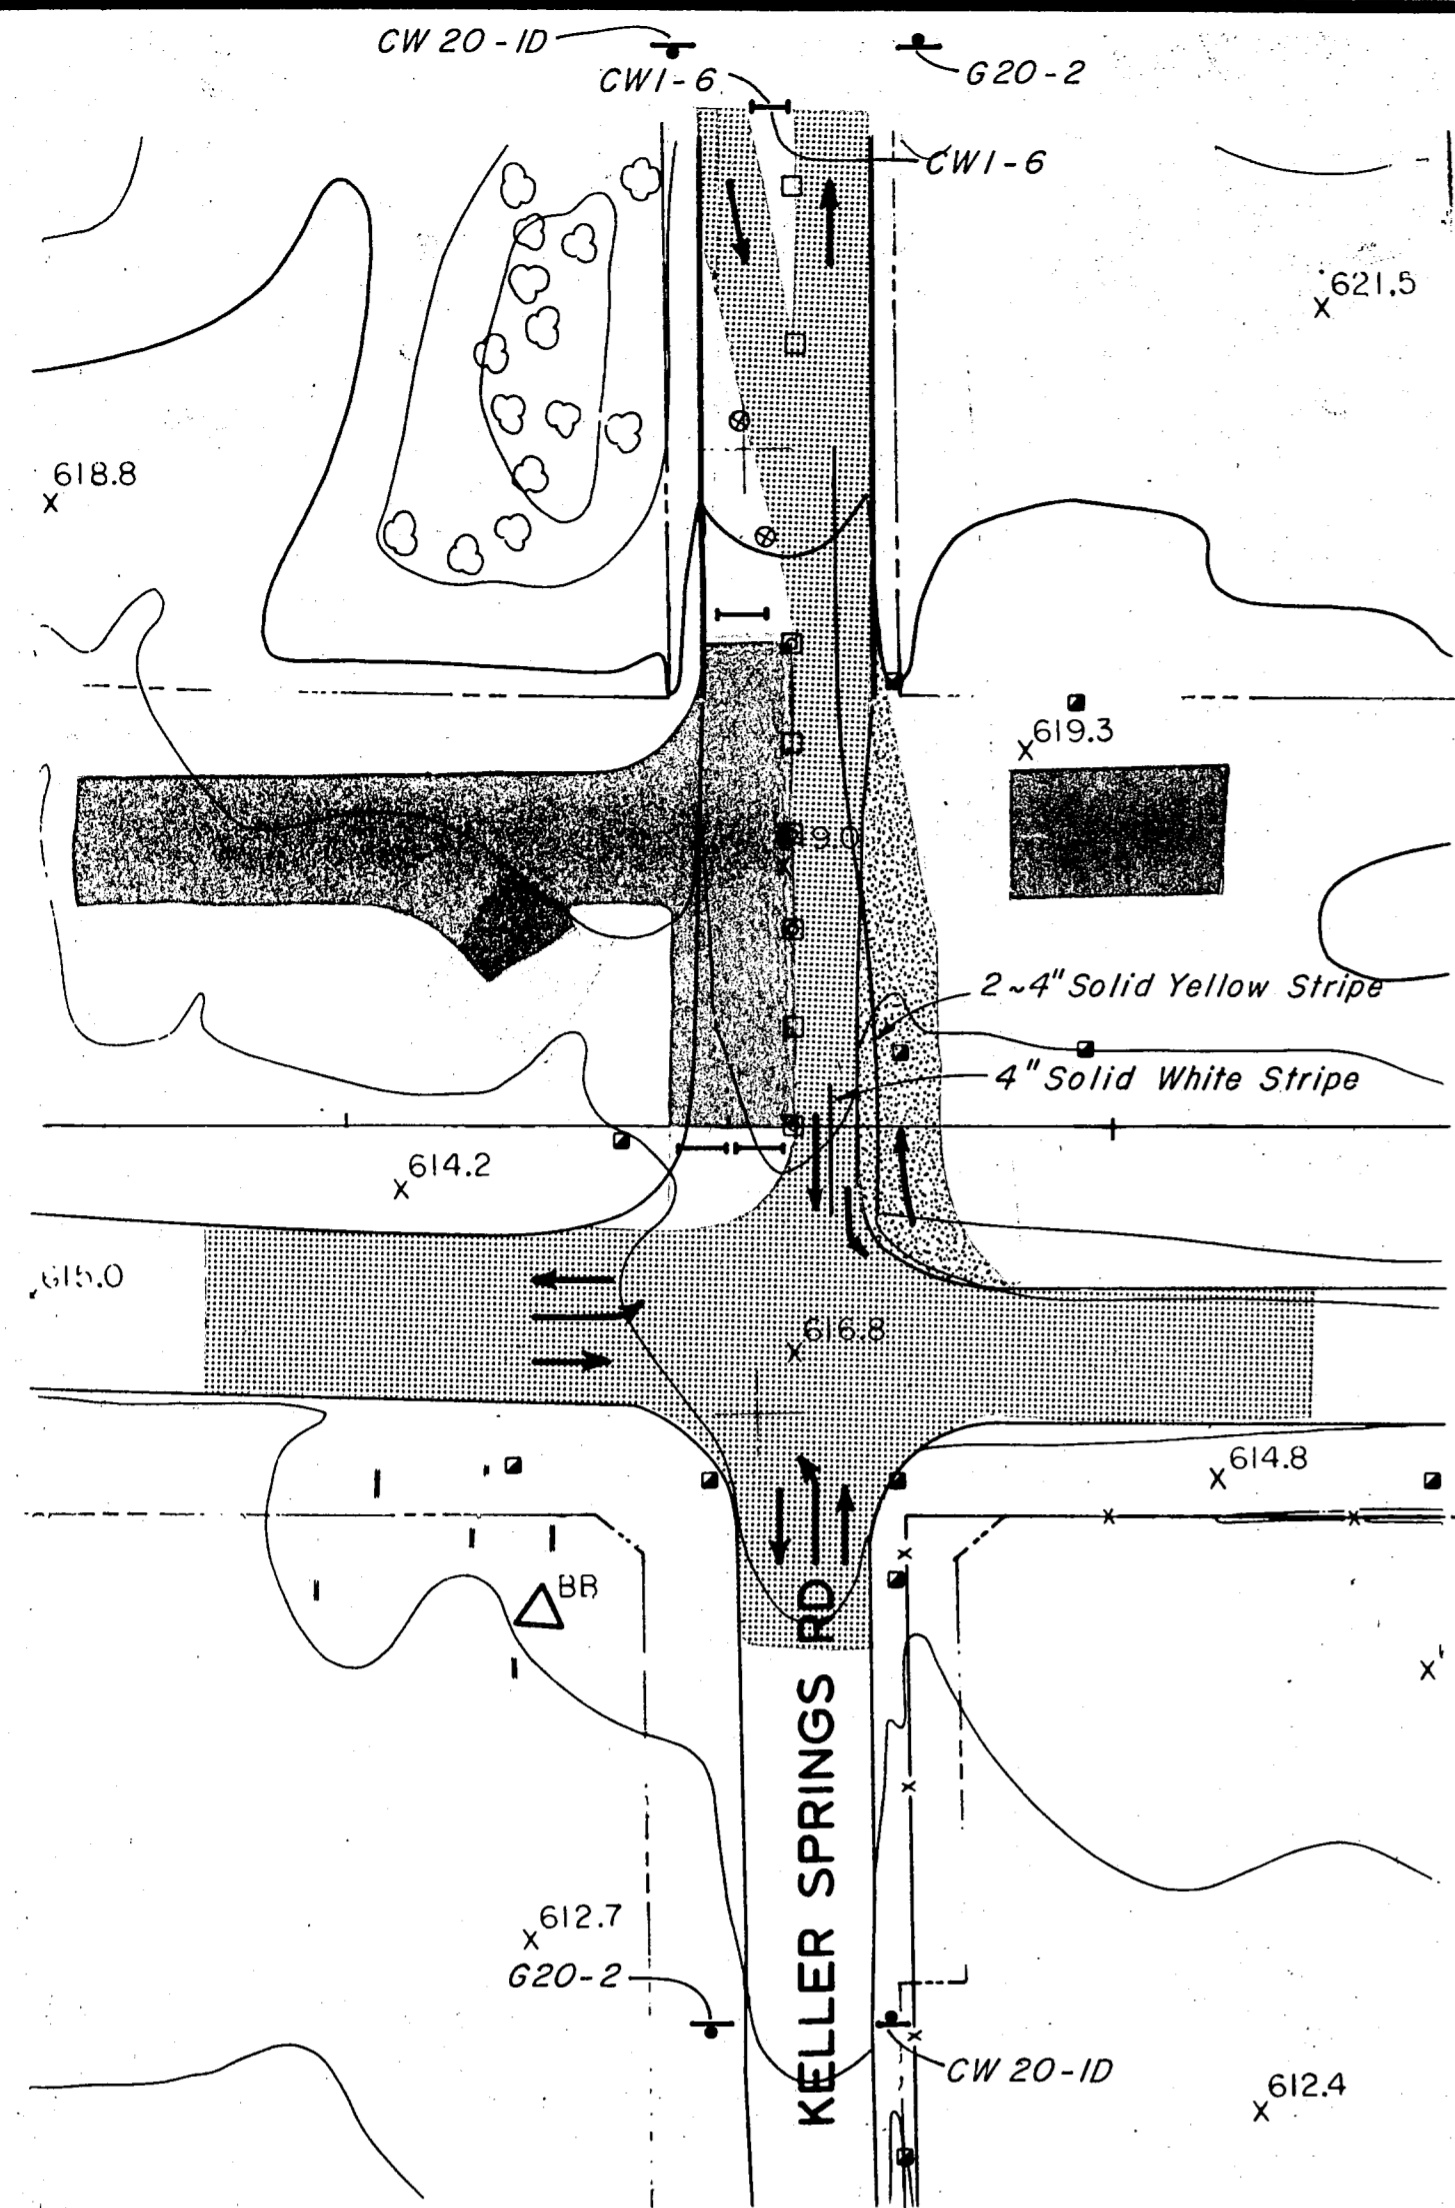


**PHASE I  
STAGE 1**

**TRAFFIC**

1. MAINTAIN TRAFFIC LANES AS EXIST ON DALLAS PARKWAY AND KELLER SPRINGS EAST OF EXISTING DALLAS PARKWAY.
2. CLOSE SOUTH 1/2 OF KELLER SPRINGS WEST OF THE TOLLWAY CENTERLINE AND CONSTRUCT DETOUR ALL ALONG NORTH SIDE TO ALLOW LEFT TURN LANE.
3. ROUTE TRAFFIC AS SHOWN ABOVE.

**CONSTRUCTION**

1. CONSTRUCT SOUTHBOUND DALLAS PARKWAY FROM SOUTH.
2. DRAINAGE MUST BE COMPLETED FROM DOWN STREAM AND EXTENDED SUFFICIENT DISTANCE TO FACILITATE CONNECTING IN STAGE 2 AND OTHER PHASES.

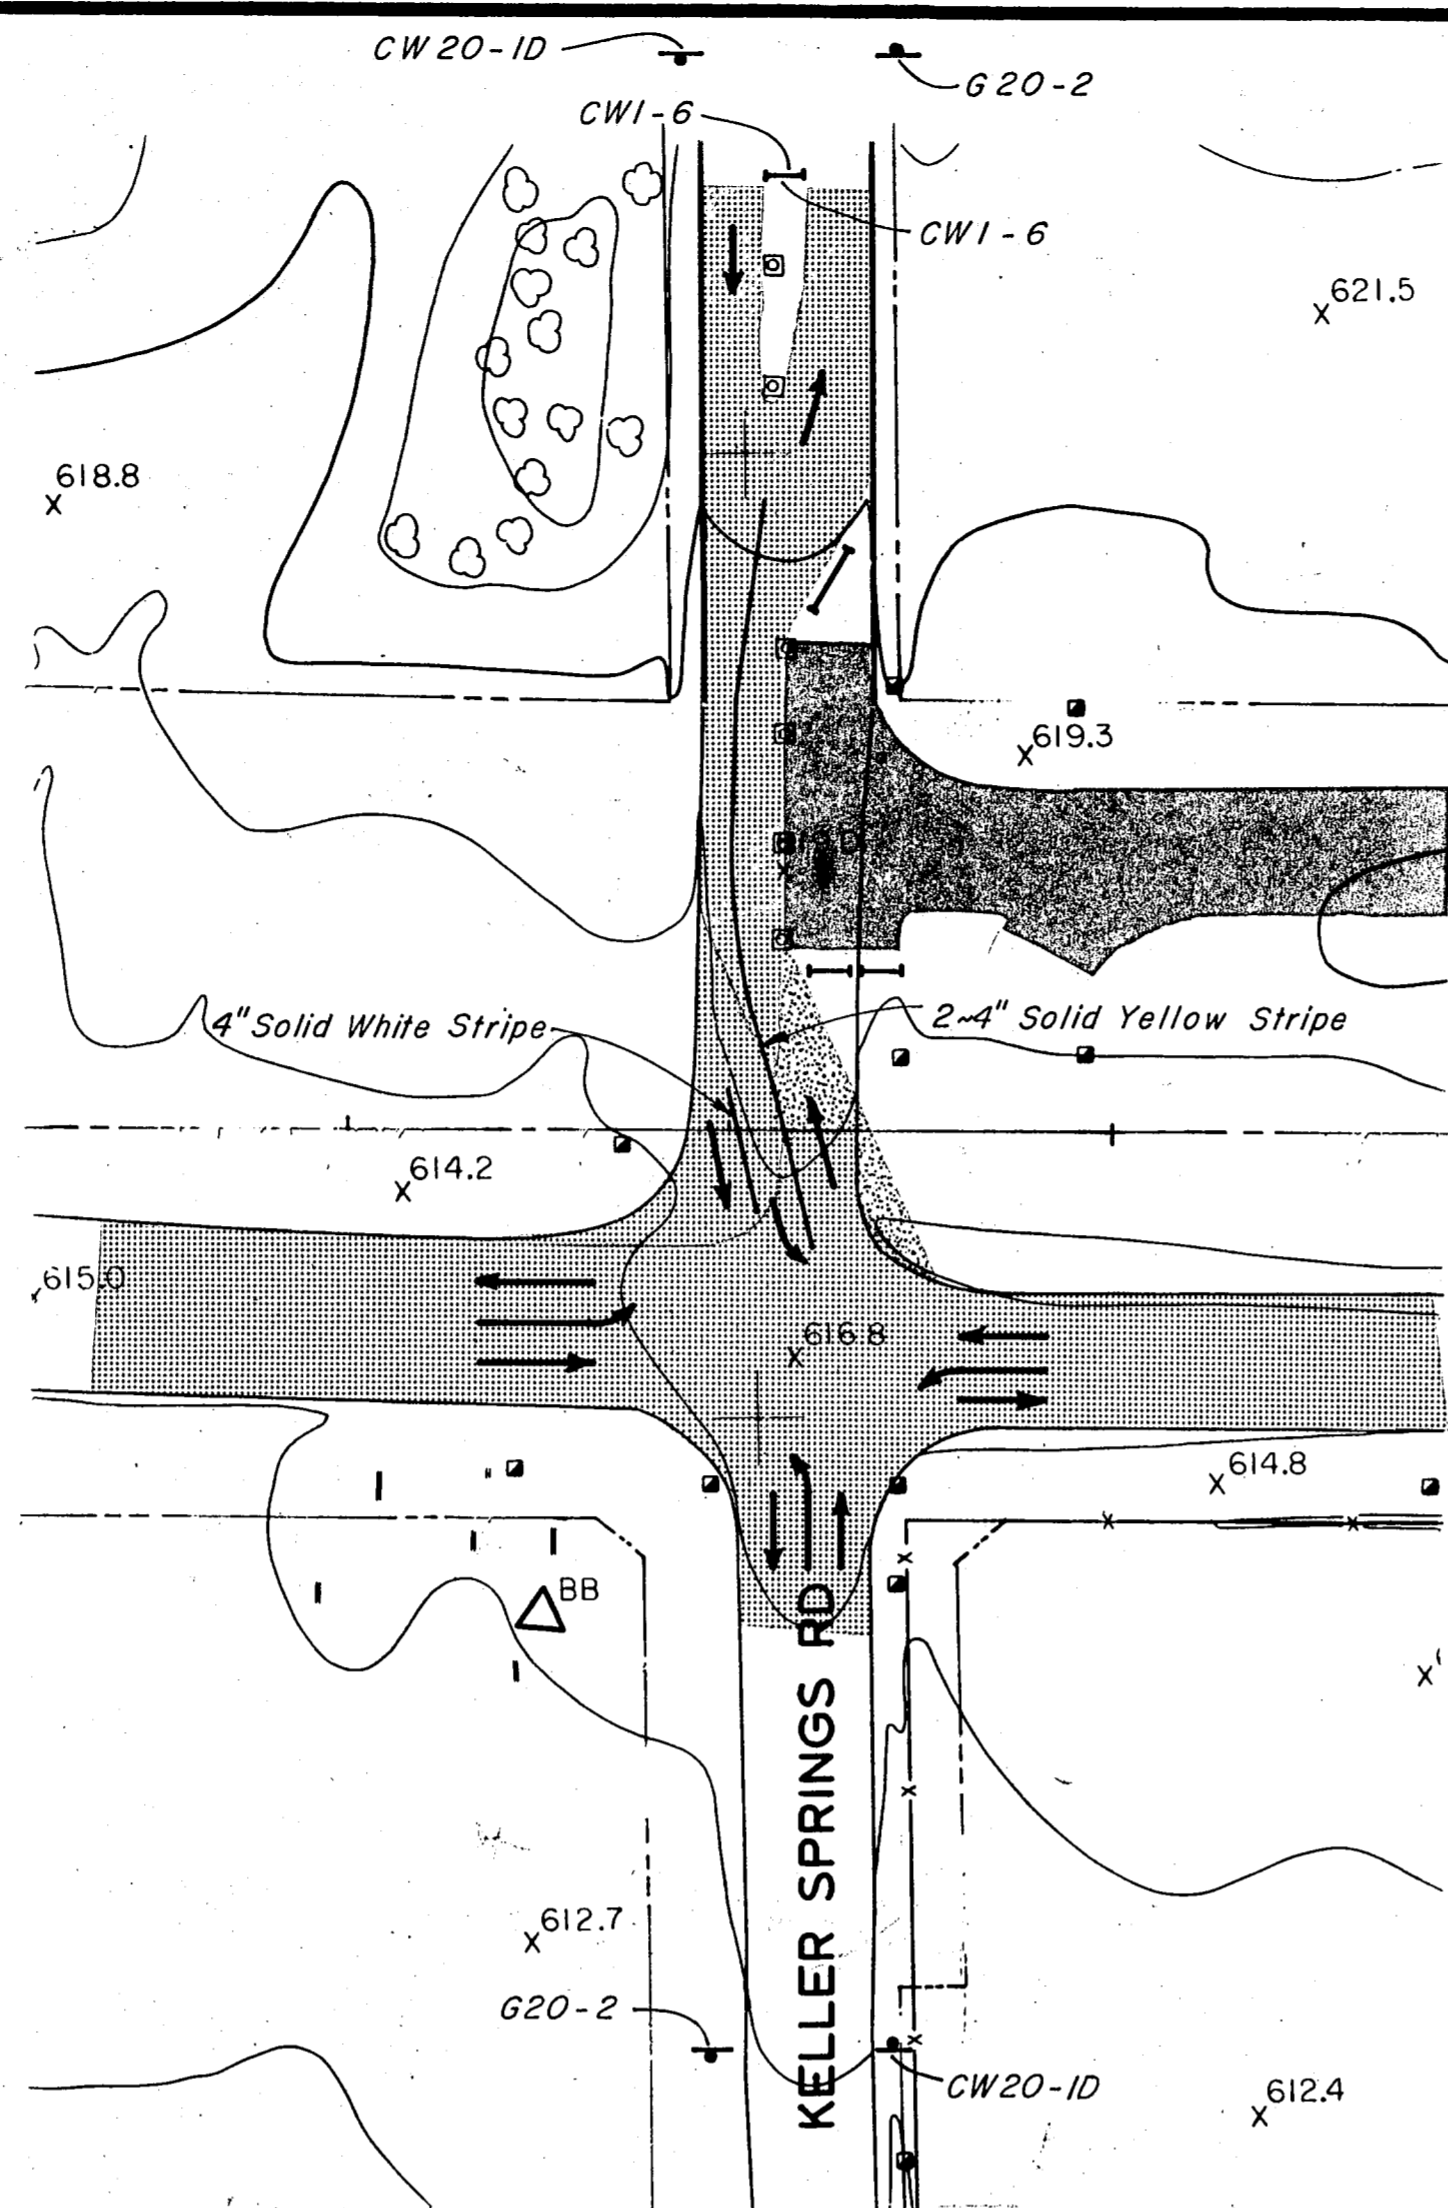

**PHASE I  
STAGE 2**

**TRAFFIC**


1. CLOSE PORTION OF THE NORTH 1/2 OF KELLER SPRINGS ACROSS PROPOSED SOUTHBOUND DALLAS PARKWAY AND CONSTRUCT DETOUR OVER EXISTING PAVEMENT WITH A LEFT TURN LANE.

**CONSTRUCTION**

1. CONSTRUCT SOUTHBOUND DALLAS PARKWAY TO NORTH.

**LEGEND**

- Construction
- Traffic Lanes
- Detours
- Barricades
- Vertical Panel
- Vertical Panel With Flashers
- Barrel With Flasher
- Barrel
- Sign

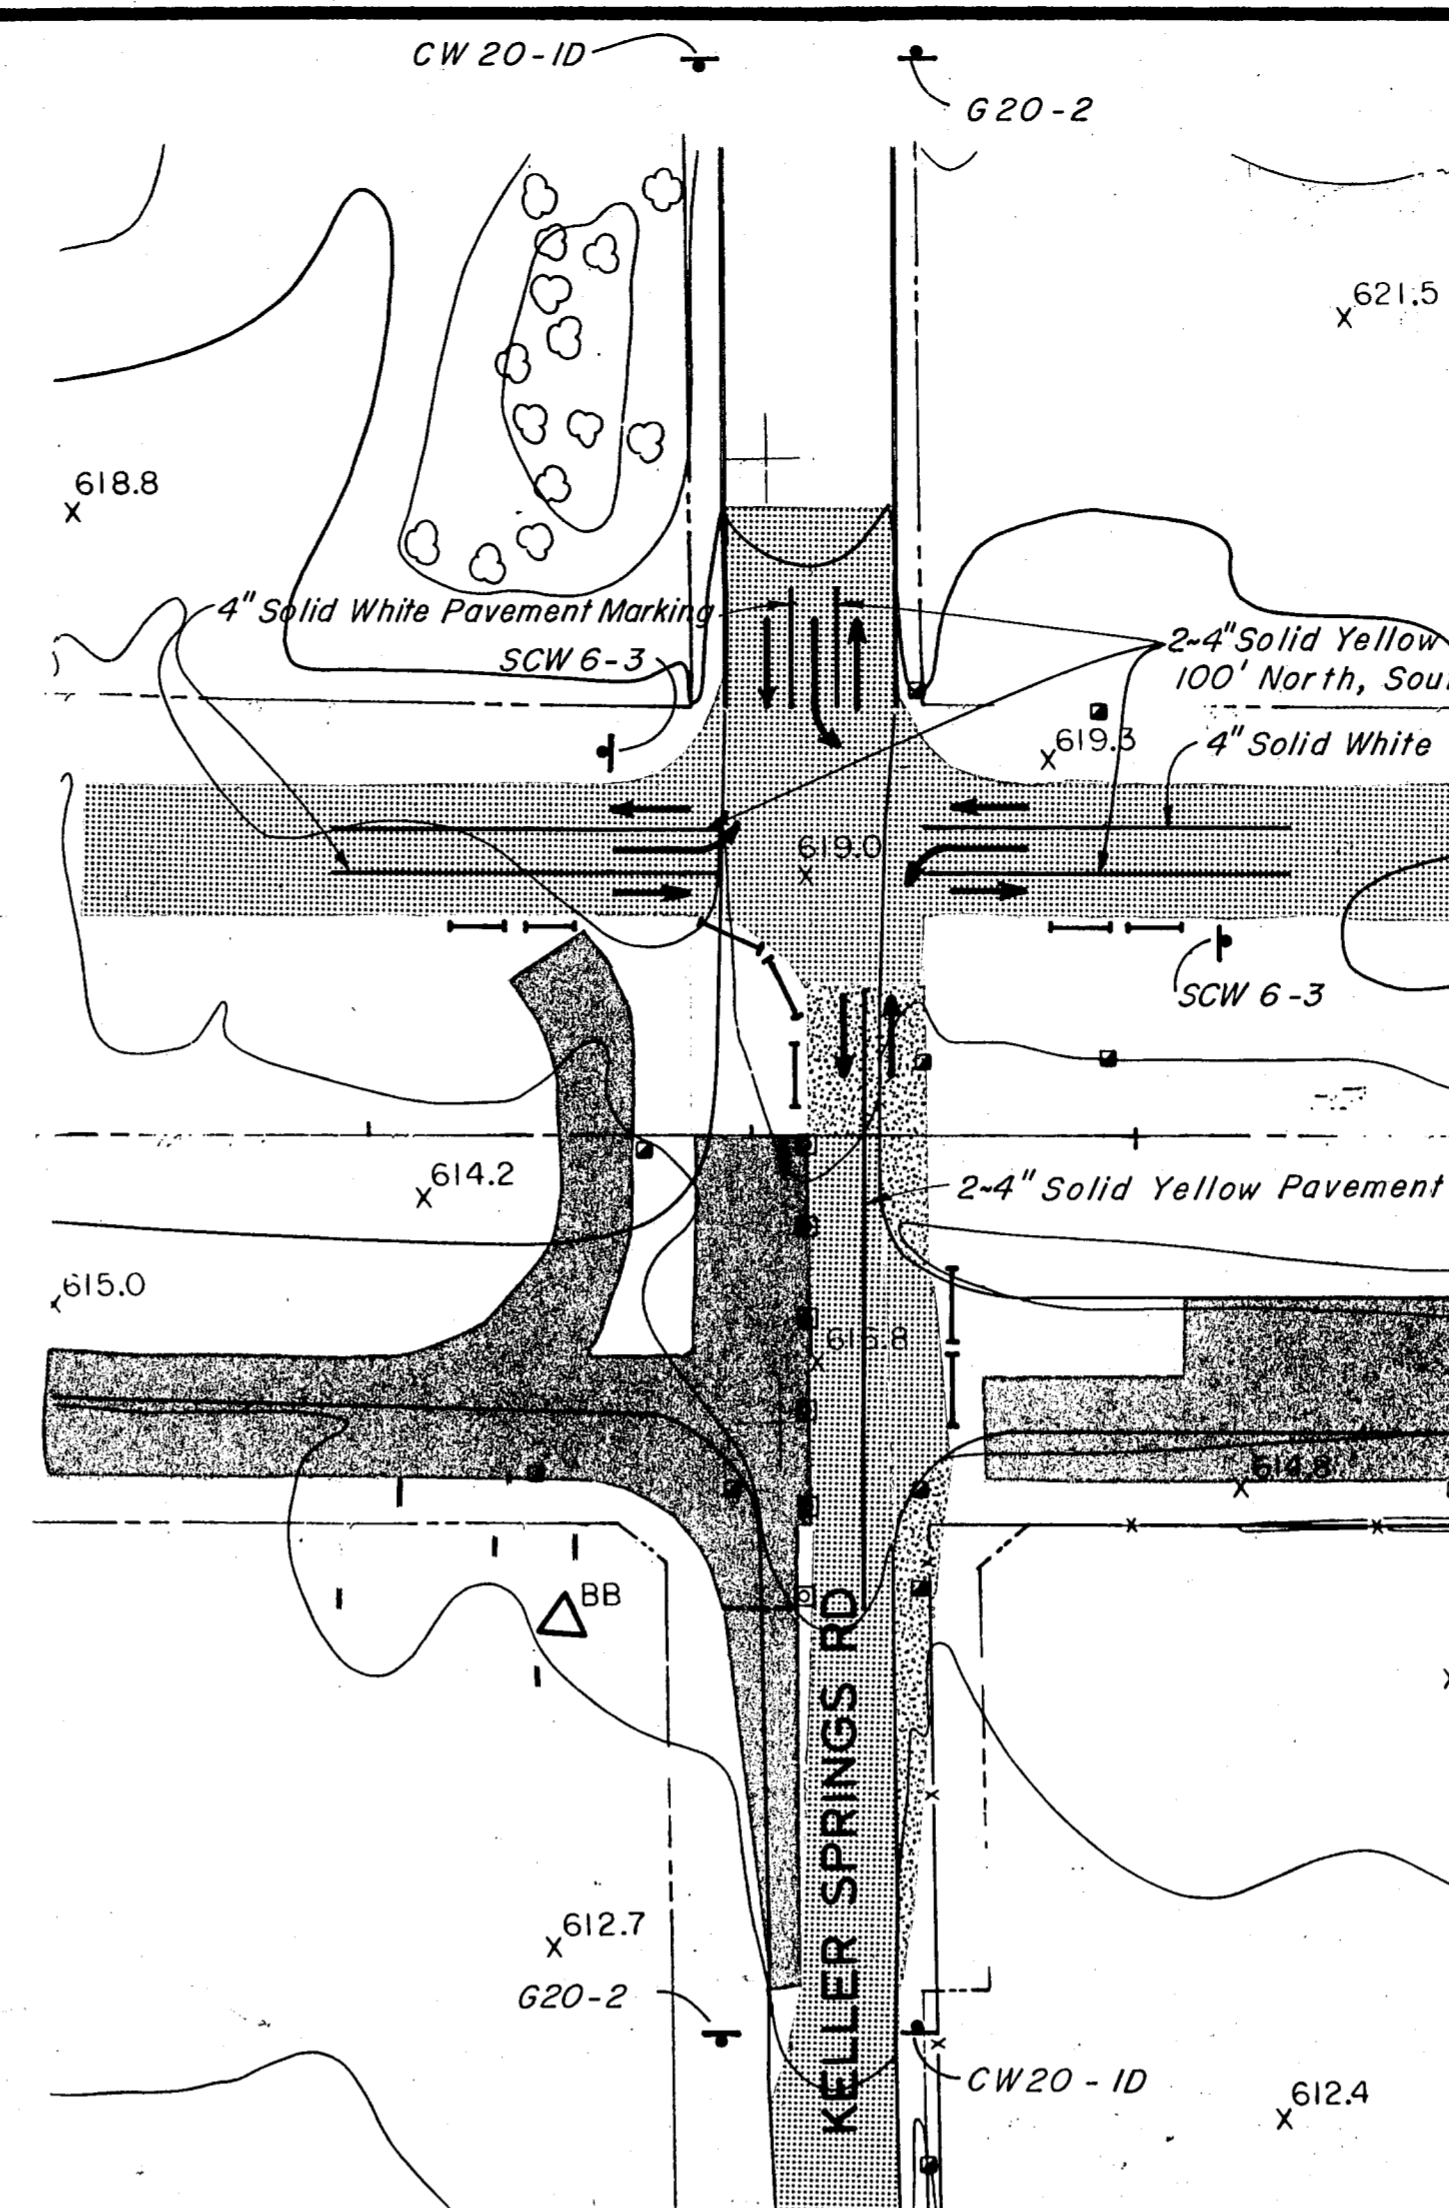

**PHASE II  
STAGE 1**

**TRAFFIC**

1. ALL DALLAS PARKWAY TRAFFIC MUST BE PLACED ON THE SOUTHBOUND DALLAS PARKWAY.
2. CONSTRUCT DETOUR ALL ALONG NORTH SIDE TO PROVIDE FOR LEFT TURN LANE.
3. CLOSE SOUTH 1/2 OF KELLER SPRINGS EAST OF THE TOLLWAY CENTERLINE.
4. THE NORTHBOUND DALLAS PARKWAY WILL REMAIN BARRICADED UNTIL THE COMPLETION OF ALL PHASE II PAVEMENT IN DALLAS NORTH TOLLWAY SECTION VII AND U-TURN.

**CONSTRUCTION**

1. CONSTRUCT NORTHBOUND DALLAS PARKWAY FROM SOUTH.


**PHASE III**

**TRAFFIC**

1. ALL TRAFFIC PLACED ON COMPLETED DALLAS PARKWAY.
2. U-TURNS REMAIN BARRICADED TO TRAFFIC UNTIL COMPLETION OF THE TOLLWAY BRIDGE OVERPASS.
3. TRAFFIC MAY BE REDUCED TEMPORARILY TO TWO LANES FOR BRIDGE ERECTION BY USE OF BARRICADES AND FLAGMEN.

**CONSTRUCTION**

1. COMPLETE WALLS AND BRIDGE AND OPEN U-TURNS TO TRAFFIC.

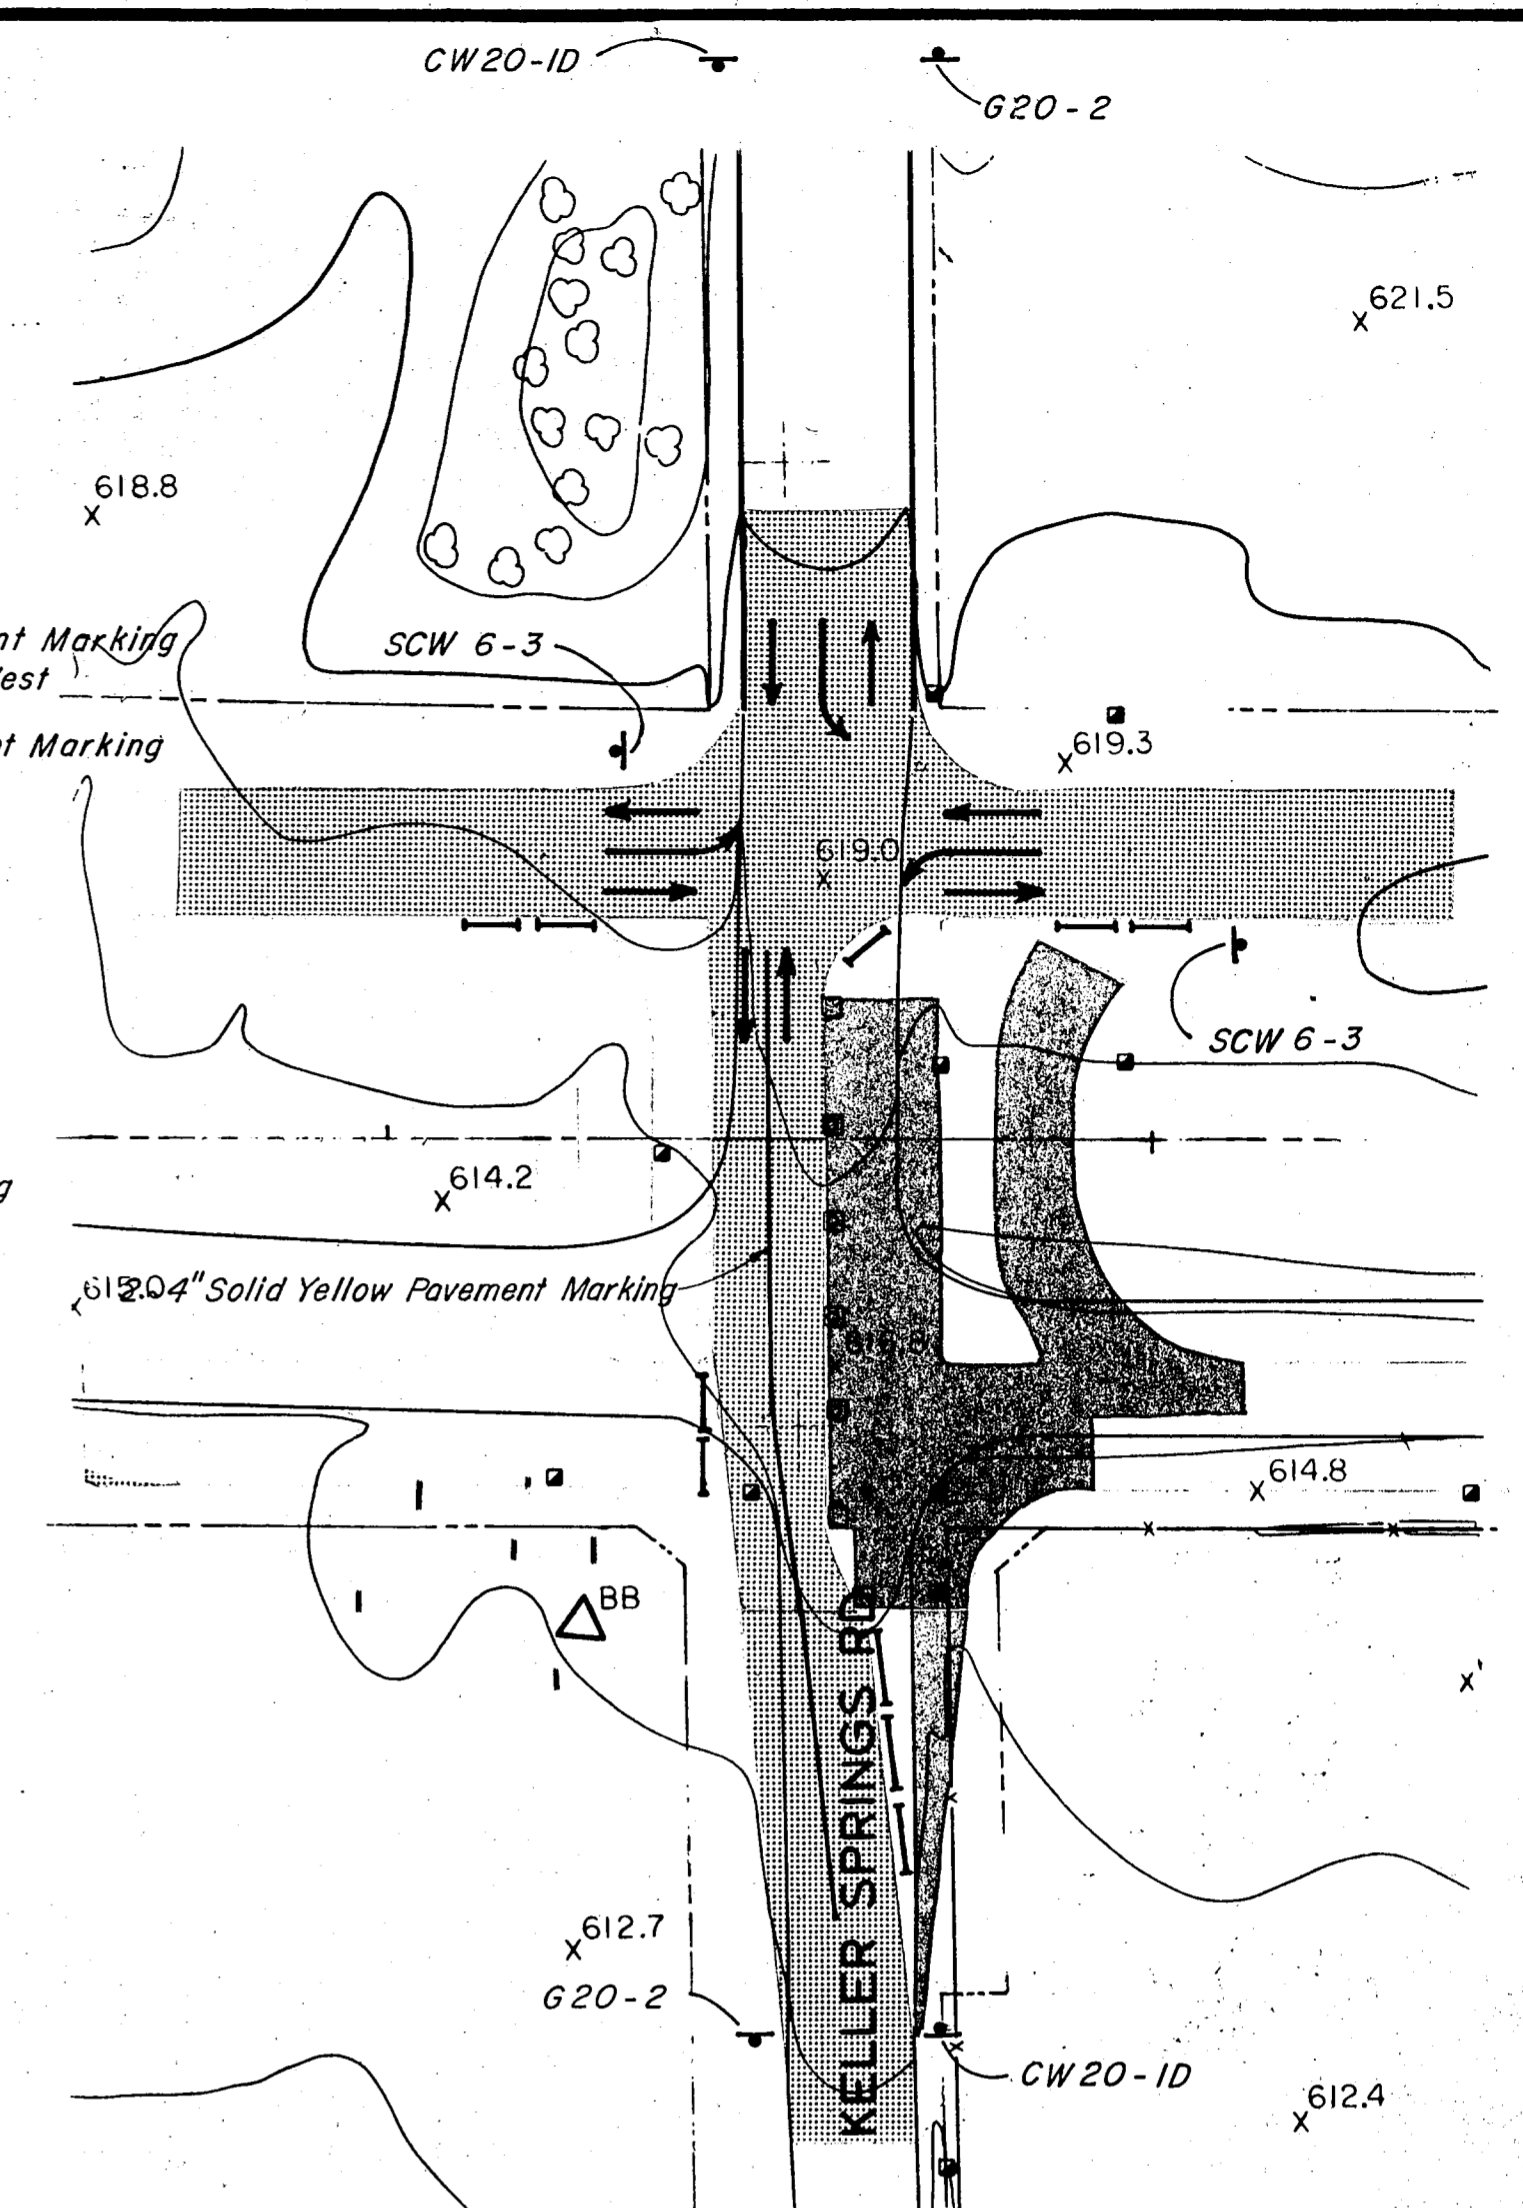

**PHASE II  
STAGE 2**

**TRAFFIC**

1. CLOSE NORTH 1/2 OF KELLER SPRINGS, AS SHOWN ABOVE.


**CONSTRUCTION**

1. CONSTRUCT NORTHBOUND DALLAS PARKWAY AND U-TURN TO THE NORTH.

**ASBUILT PLANS**


NO.	REVISION	BY	DATE
<b>TEXAS TURNPIKE AUTHORITY DALLAS NORTH TOLLWAY</b>			
<b>CONSTRUCTION SEQUENCE AND TRAFFIC CONTROL KELLER SPRINGS ROAD INTERSECTION</b>			
<b>Gibbs &amp; Hill, Inc.</b> ENGINEERS DESIGNERS CONSTRUCTORS			<b>SECTION VII</b>
DRAWN VER	DATE 5/18/84	DESIGNED JOP	DATE 5-24-84
CHECKED DWC	DATE 8/3/84	SCALE 1"=50'	
<b>CONTRACT NO. DNT-115 SHEET R39 OF R85</b>			



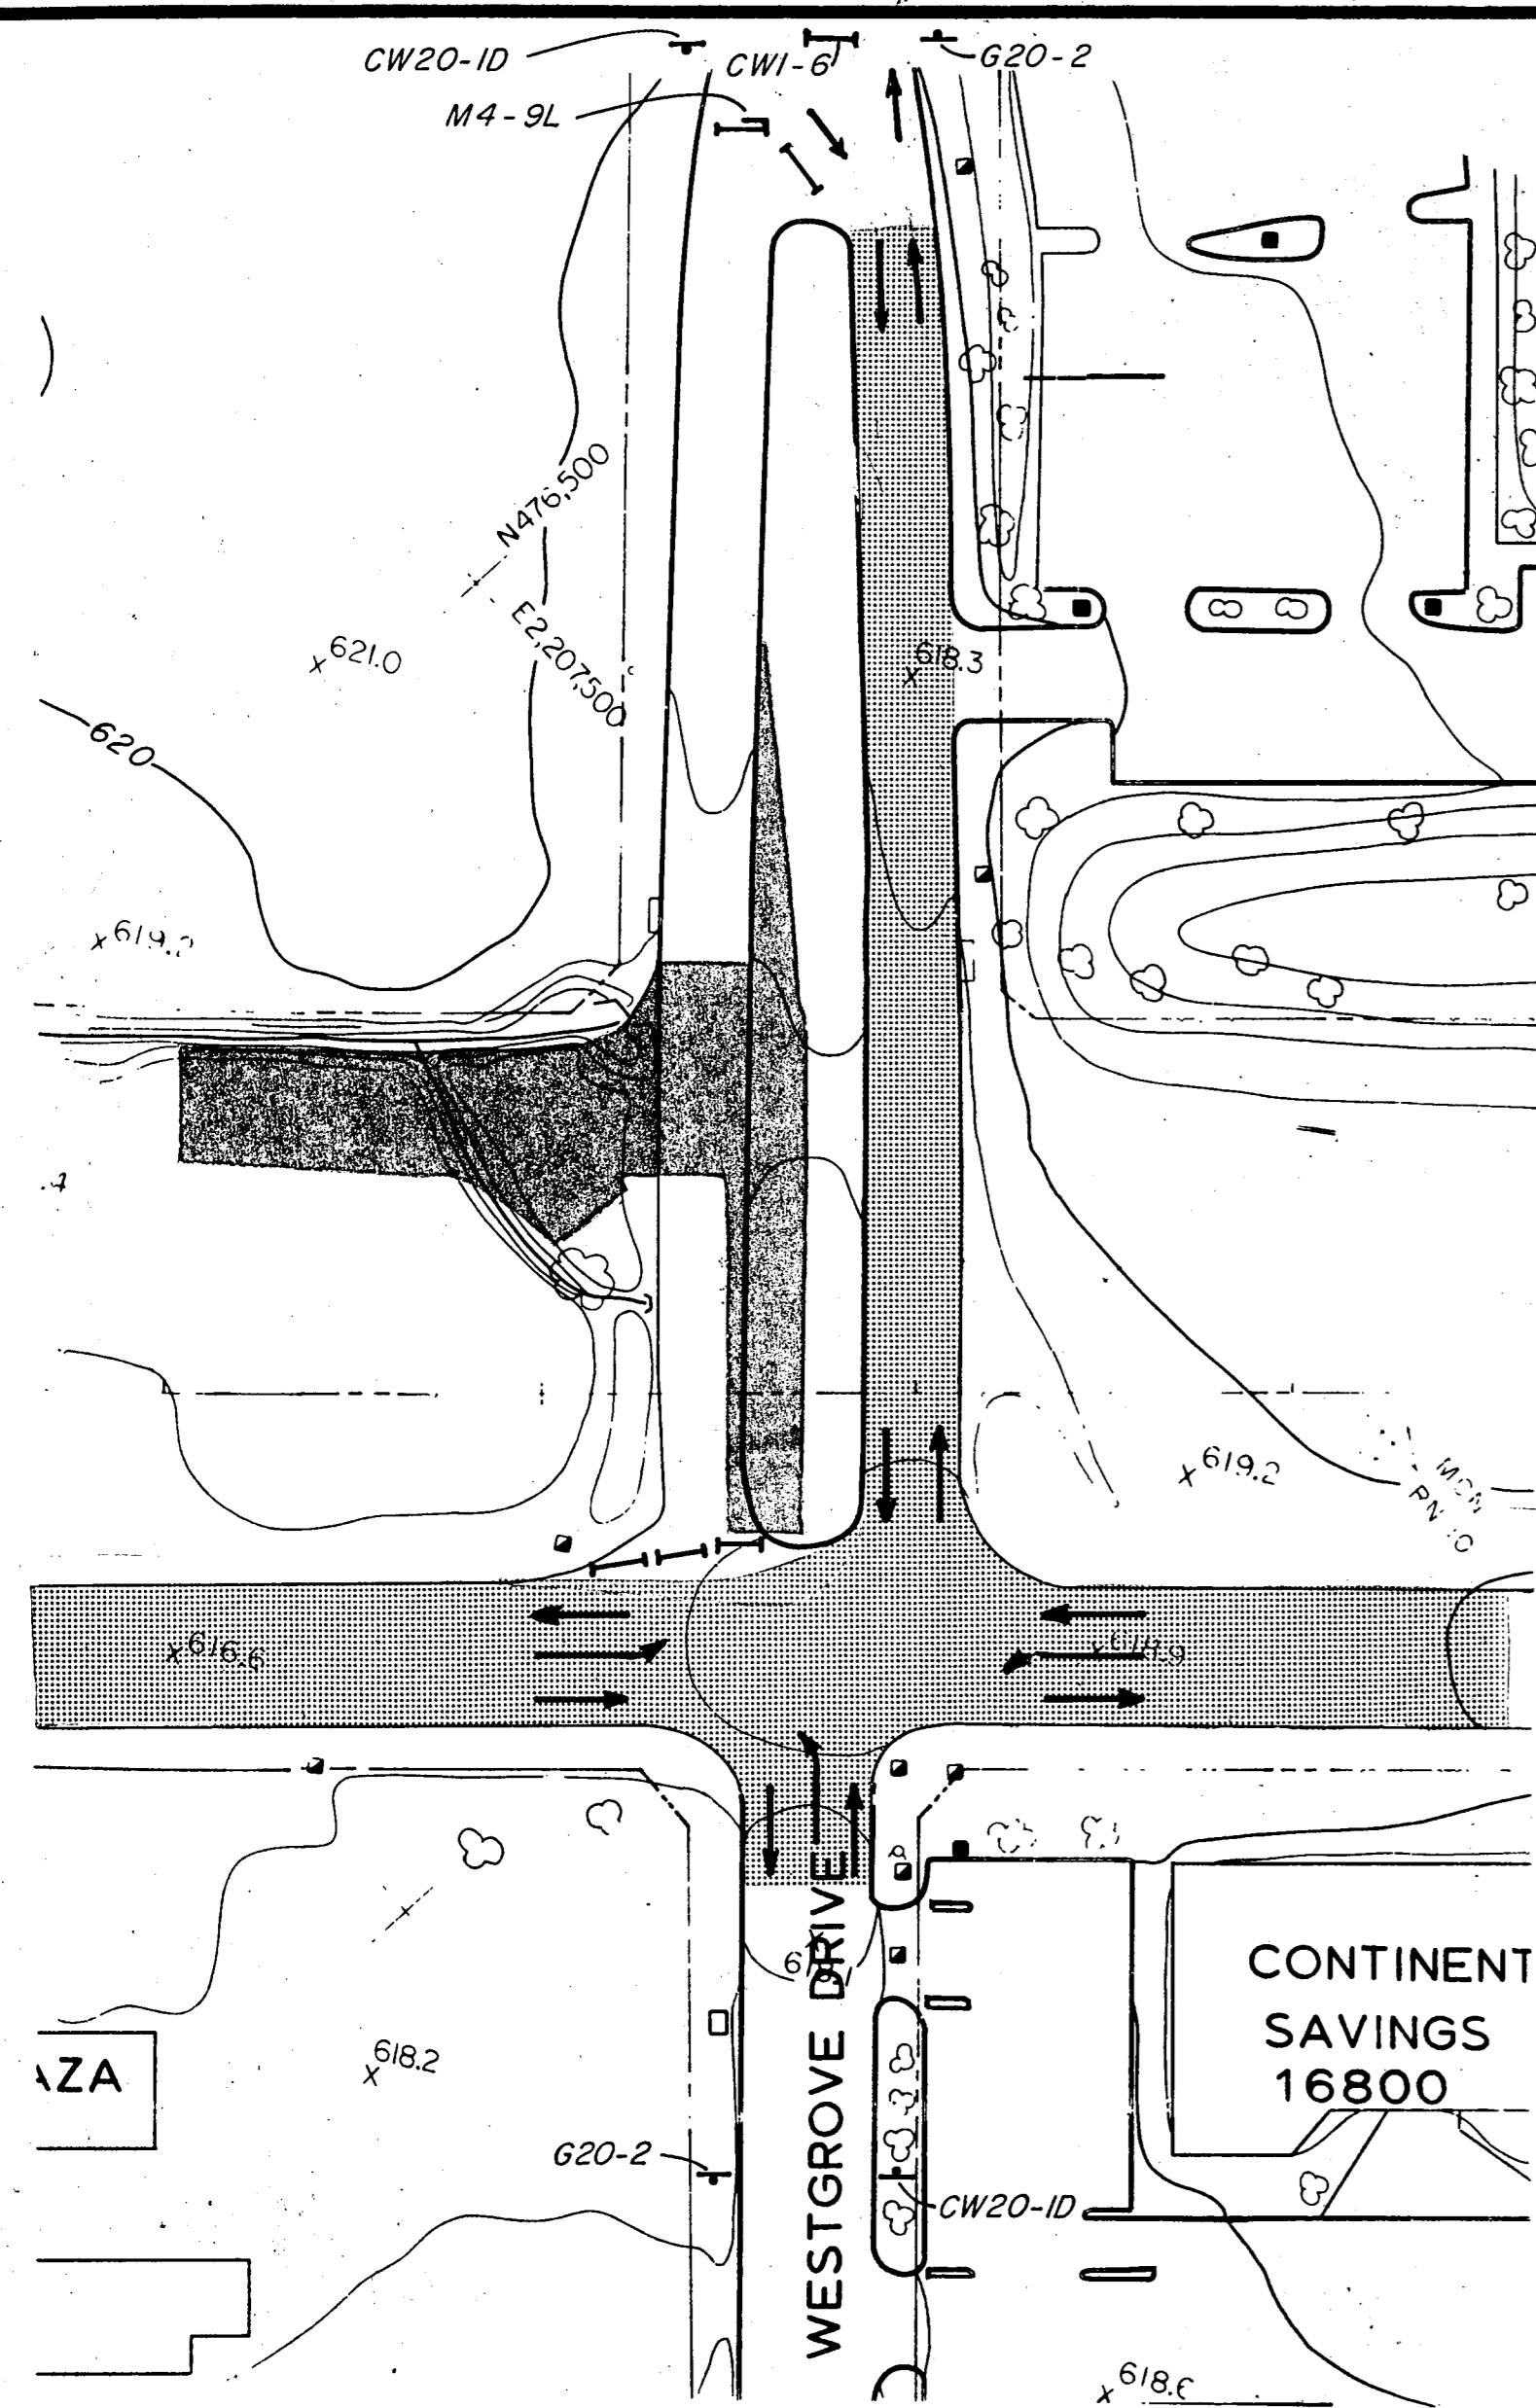


PHASE I  
STAGE 1

- TRAFFIC**
1. MAINTAIN TRAFFIC LANES AS EXIST ON DALLAS PARKWAY AND ROUTE TRAFFIC AS SHOWN ABOVE.
  2. CLOSE SOUTH 1/2 OF WESTBOUND WESTGROVE DRIVE.
- CONSTRUCTION**
1. CONSTRUCT SOUTHBOUND DALLAS PARKWAY FROM SOUTH AND WESTGROVE DRIVE AS SHOWN ABOVE.
  2. DRAINAGE MUST BE COMPLETED FROM DOWN STREAM AND EXTENDED SUFFICIENT DISTANCE TO FACILITATE CONNECTING IN STAGE 2 AND OTHER PHASES.

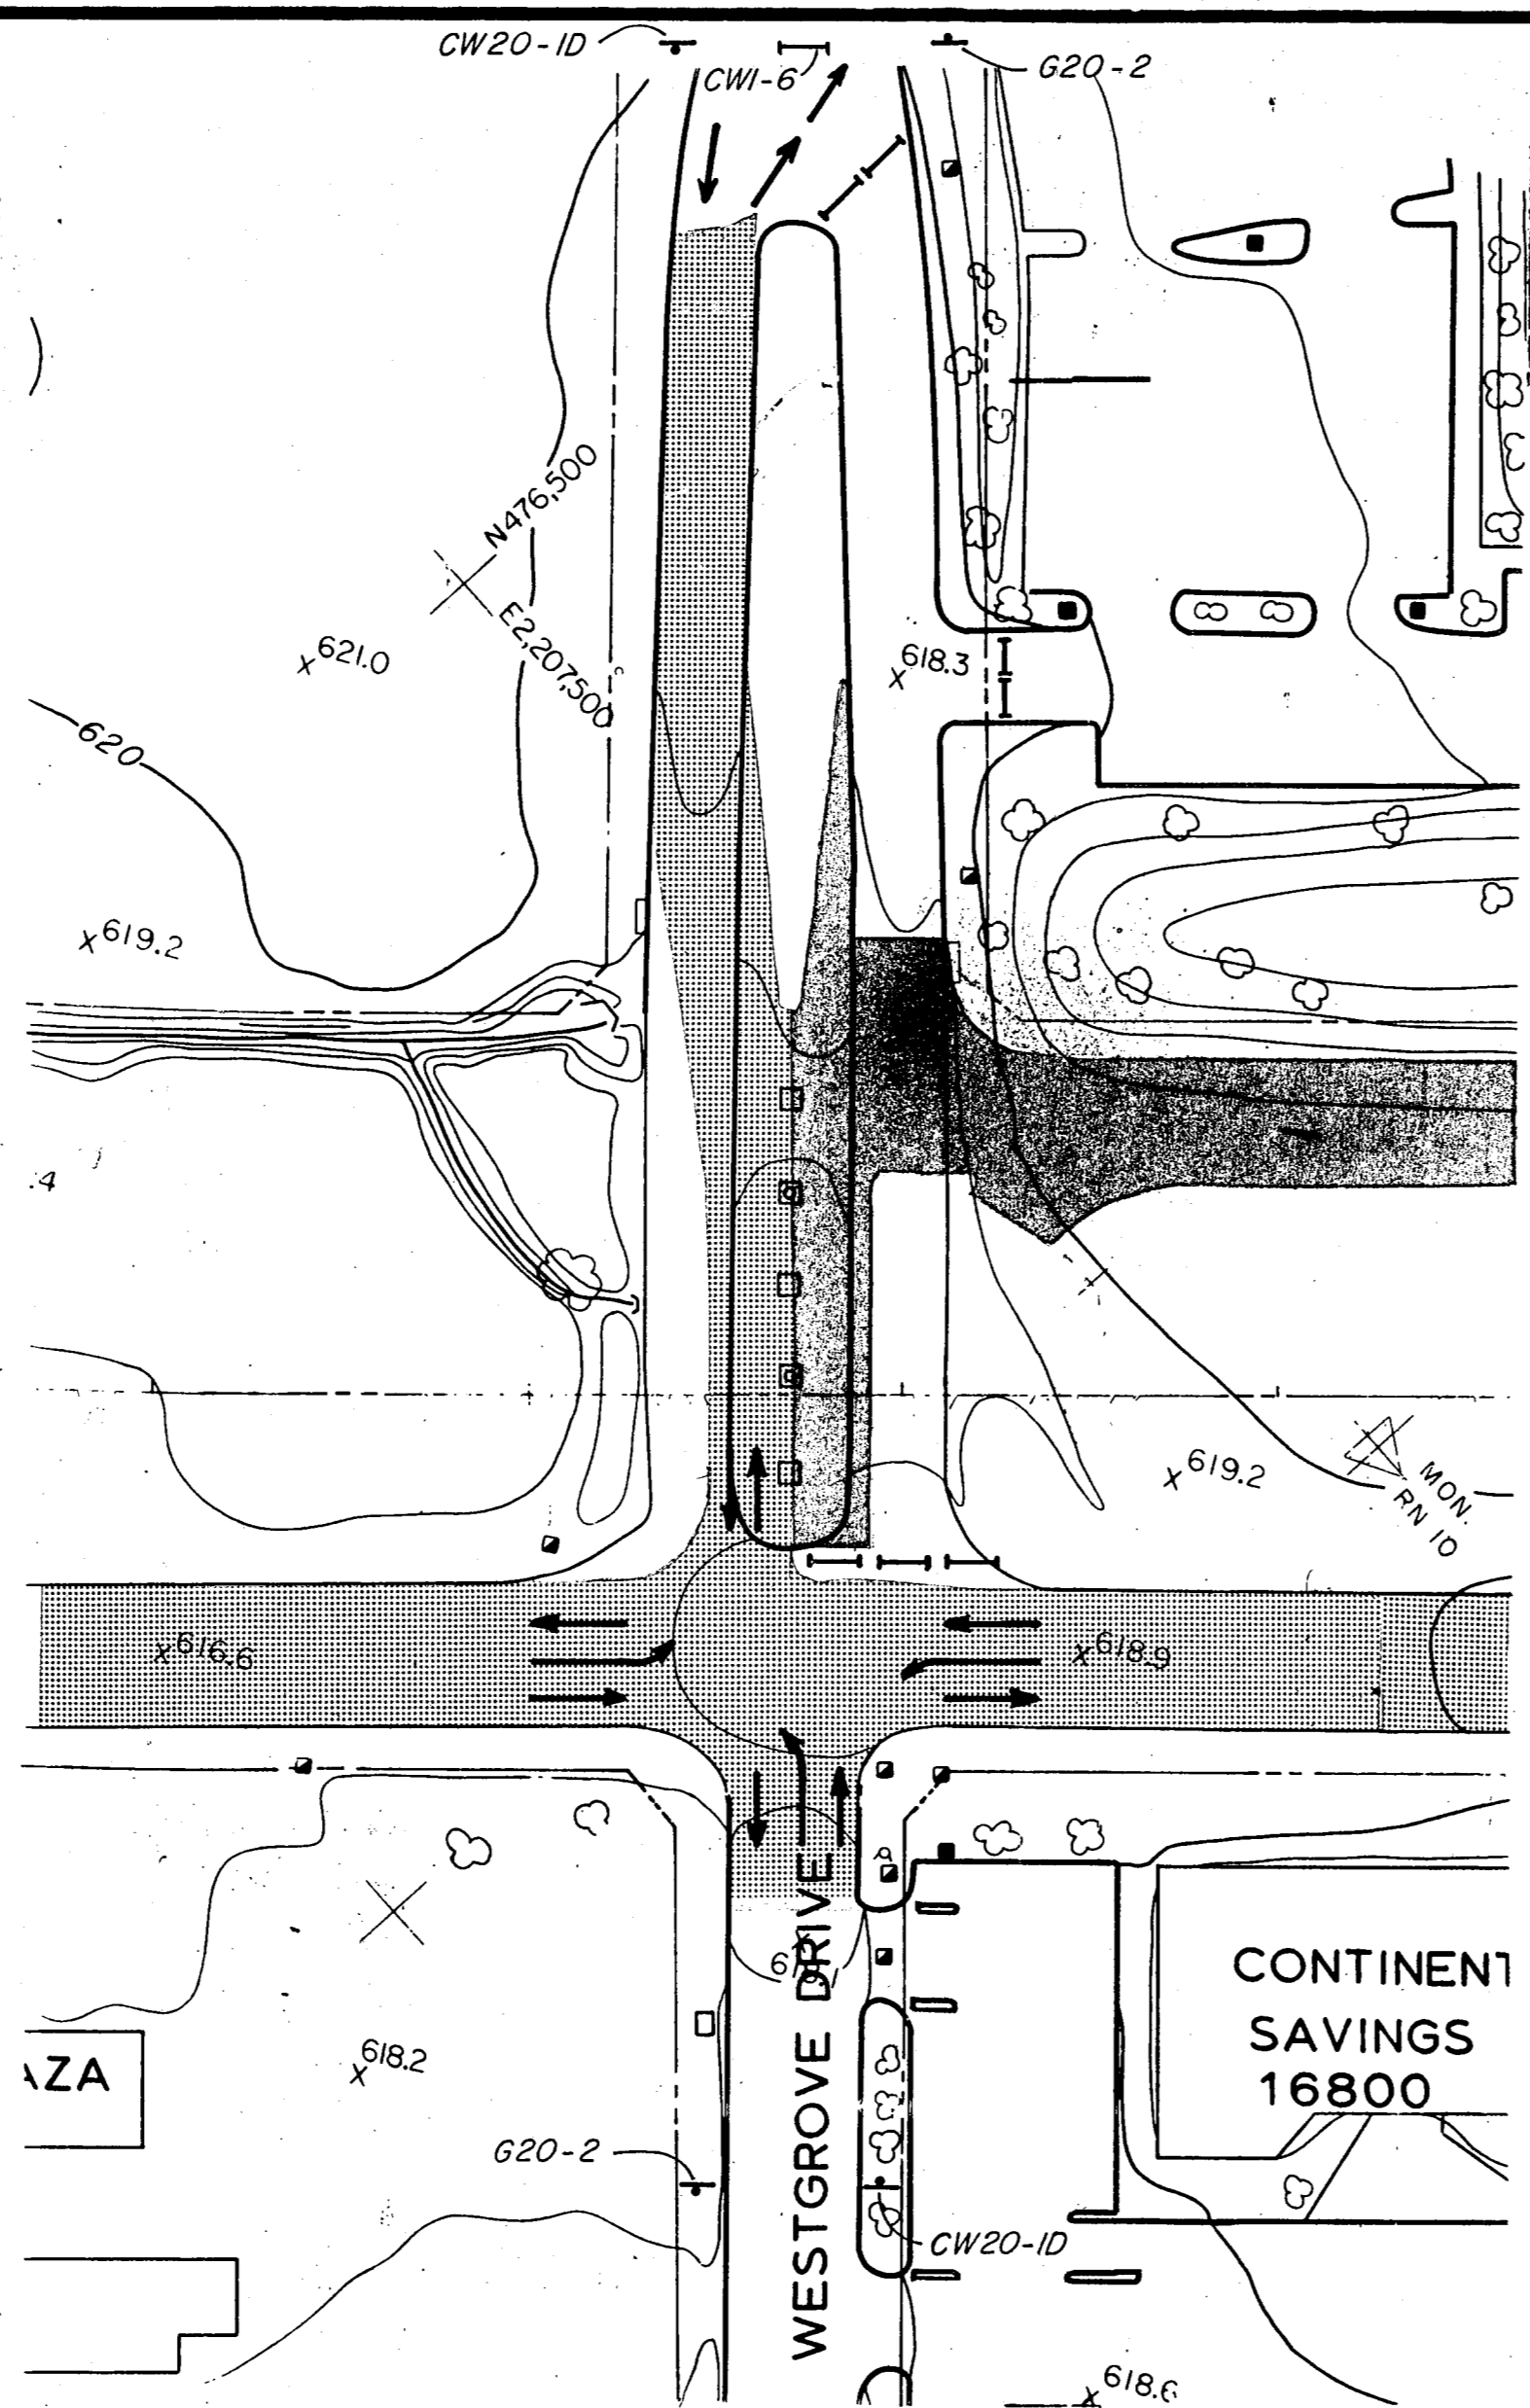


PHASE I  
STAGE 2

- TRAFFIC**
1. CLOSE NORTH 1/2 OF WESTGROVE DRIVE AND ROUTE ALL TRAFFIC ON SOUTH SIDE AS SHOWN ABOVE.
- CONSTRUCTION**
1. CONSTRUCT SOUTHBOUND DALLAS PARKWAY TO NORTH AND WESTGROVE DRIVE AS SHOWN ABOVE.

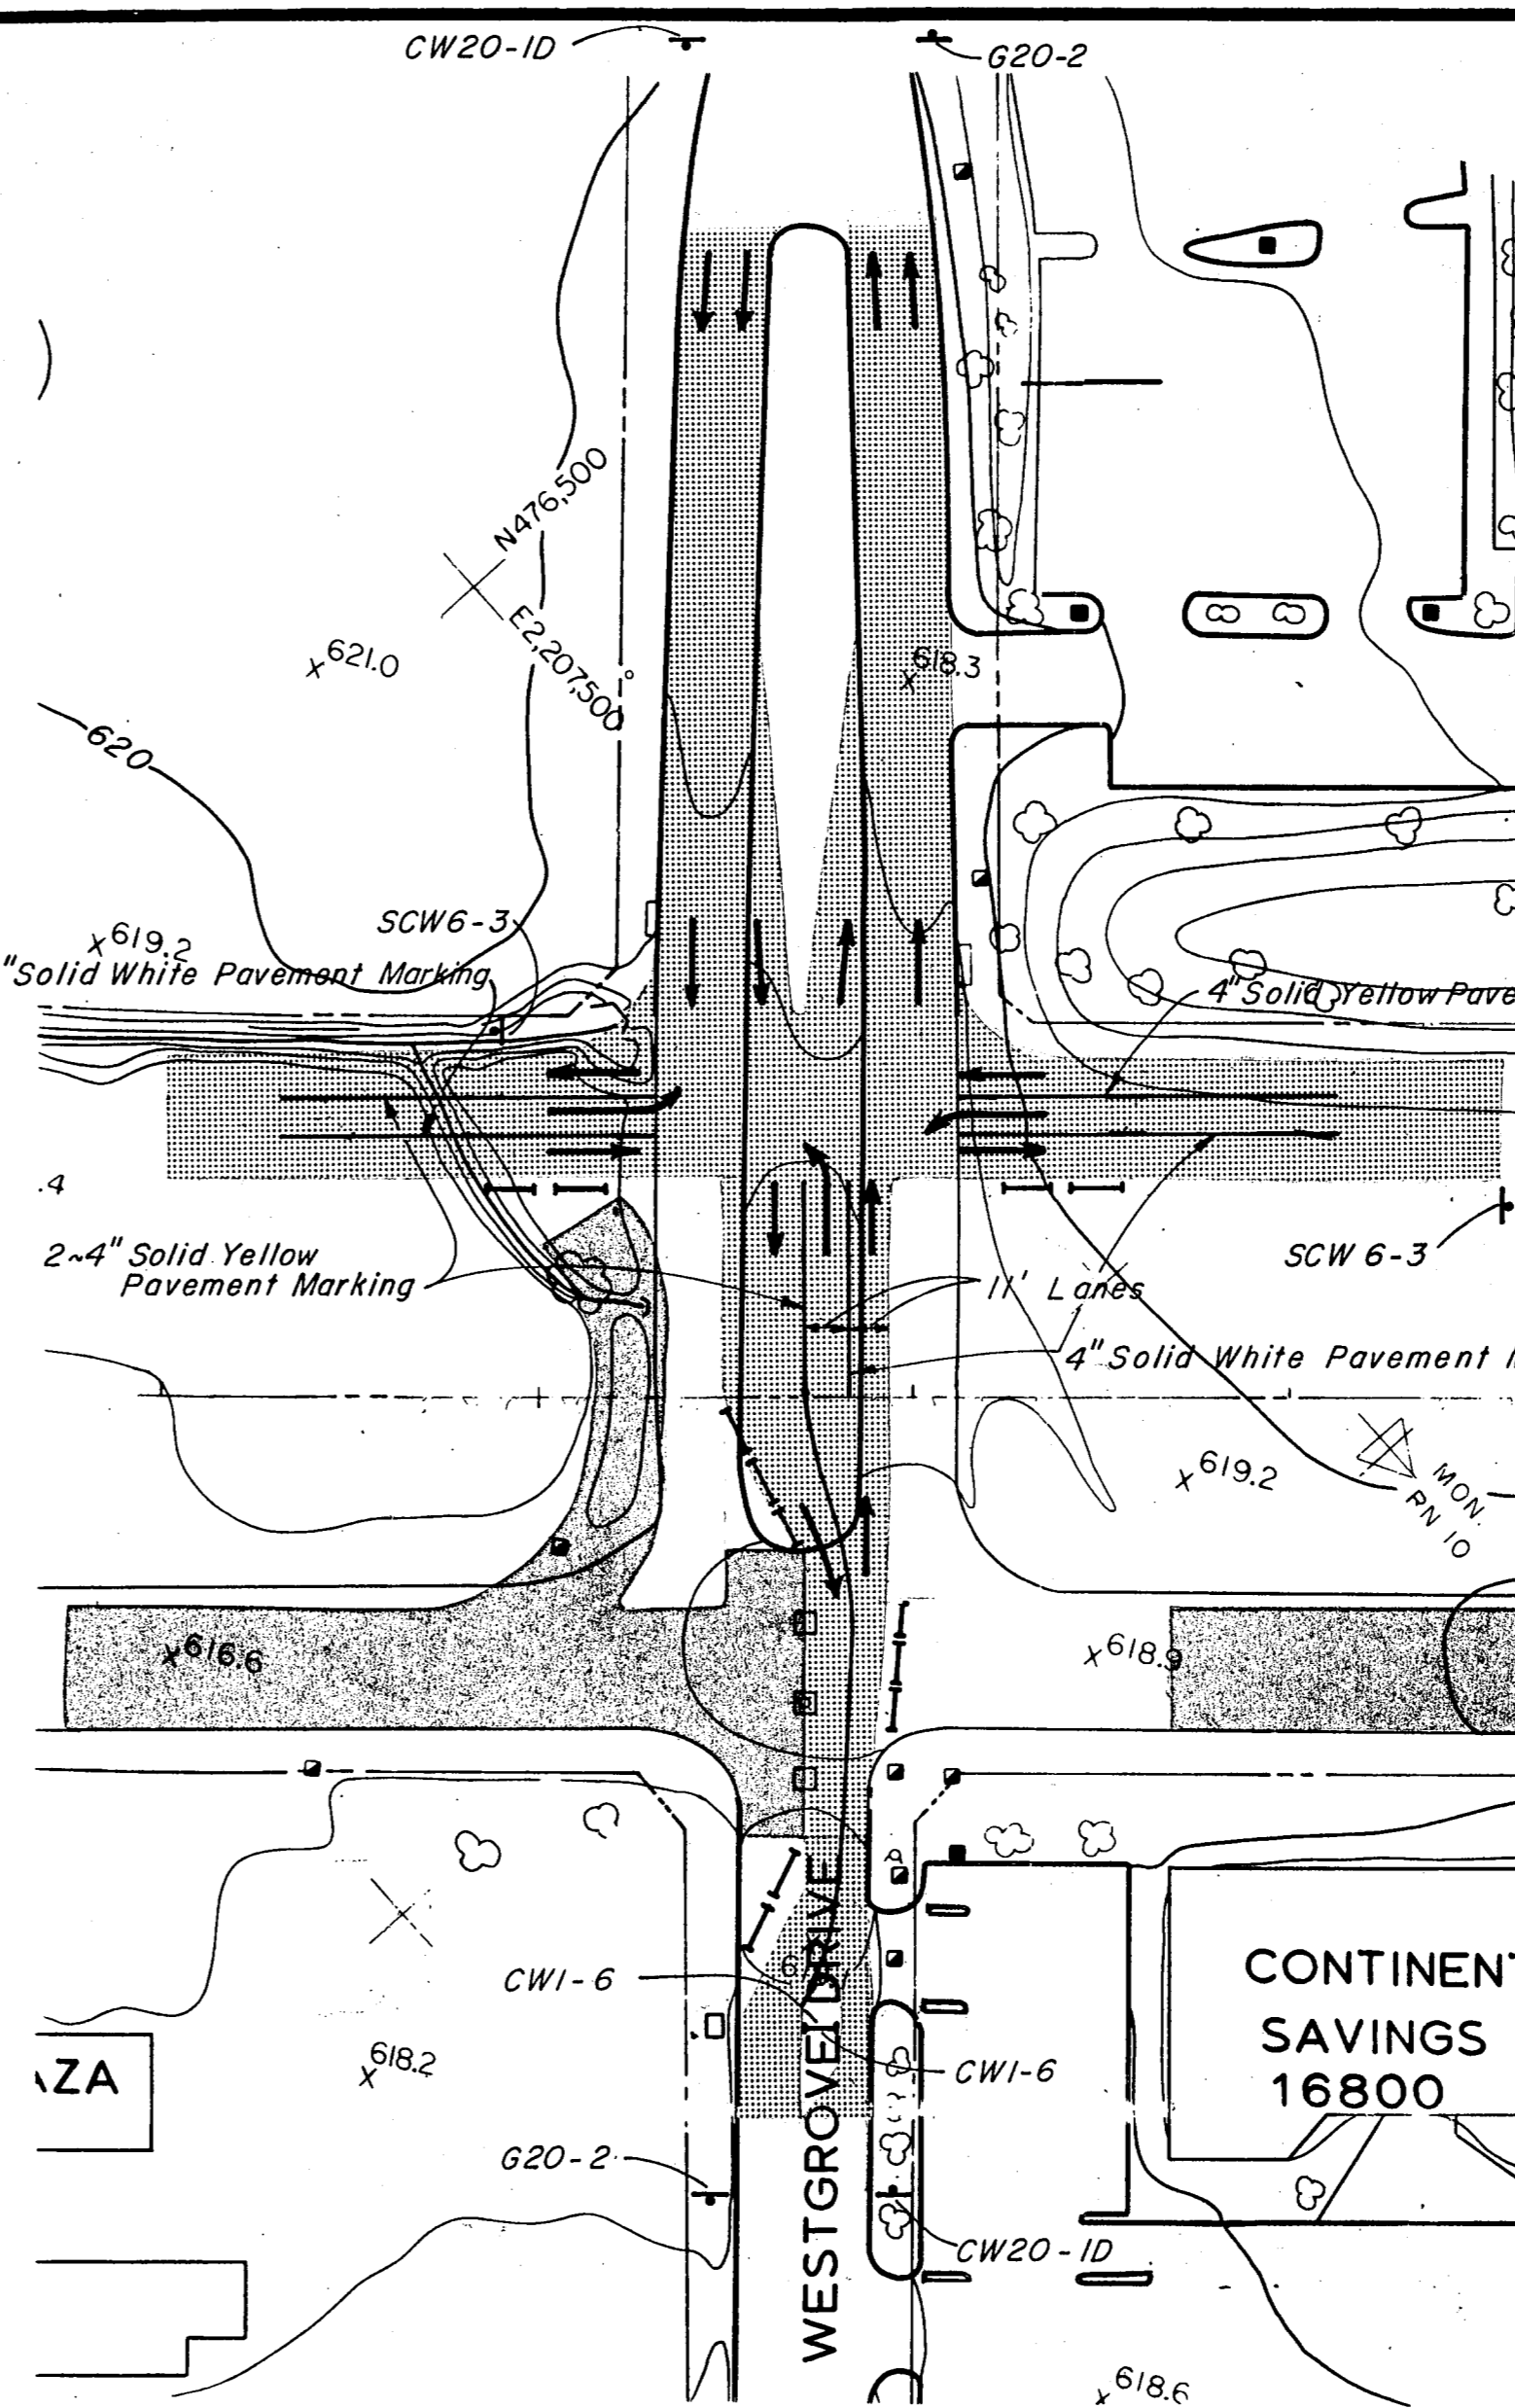

PHASE II  
STAGE 1

- TRAFFIC**
1. ALL DALLAS PARKWAY TRAFFIC MUST BE PLACED ON THE SOUTHBOUND DALLAS PARKWAY.
  2. CLOSE SOUTH 1/2 OF WESTGROVE DRIVE AND ROUTE TRAFFIC AS SHOWN ABOVE.
  3. THE NORTHBOUND DALLAS PARKWAY WILL REMAIN BARRICADED UNTIL THE COMPLETION OF ALL PHASE II PAVEMENT IN DALLAS NORTH TOLLWAY SECTION VII.
- CONSTRUCTION**
1. CONSTRUCT NORTHBOUND DALLAS PARKWAY FROM THE SOUTH.

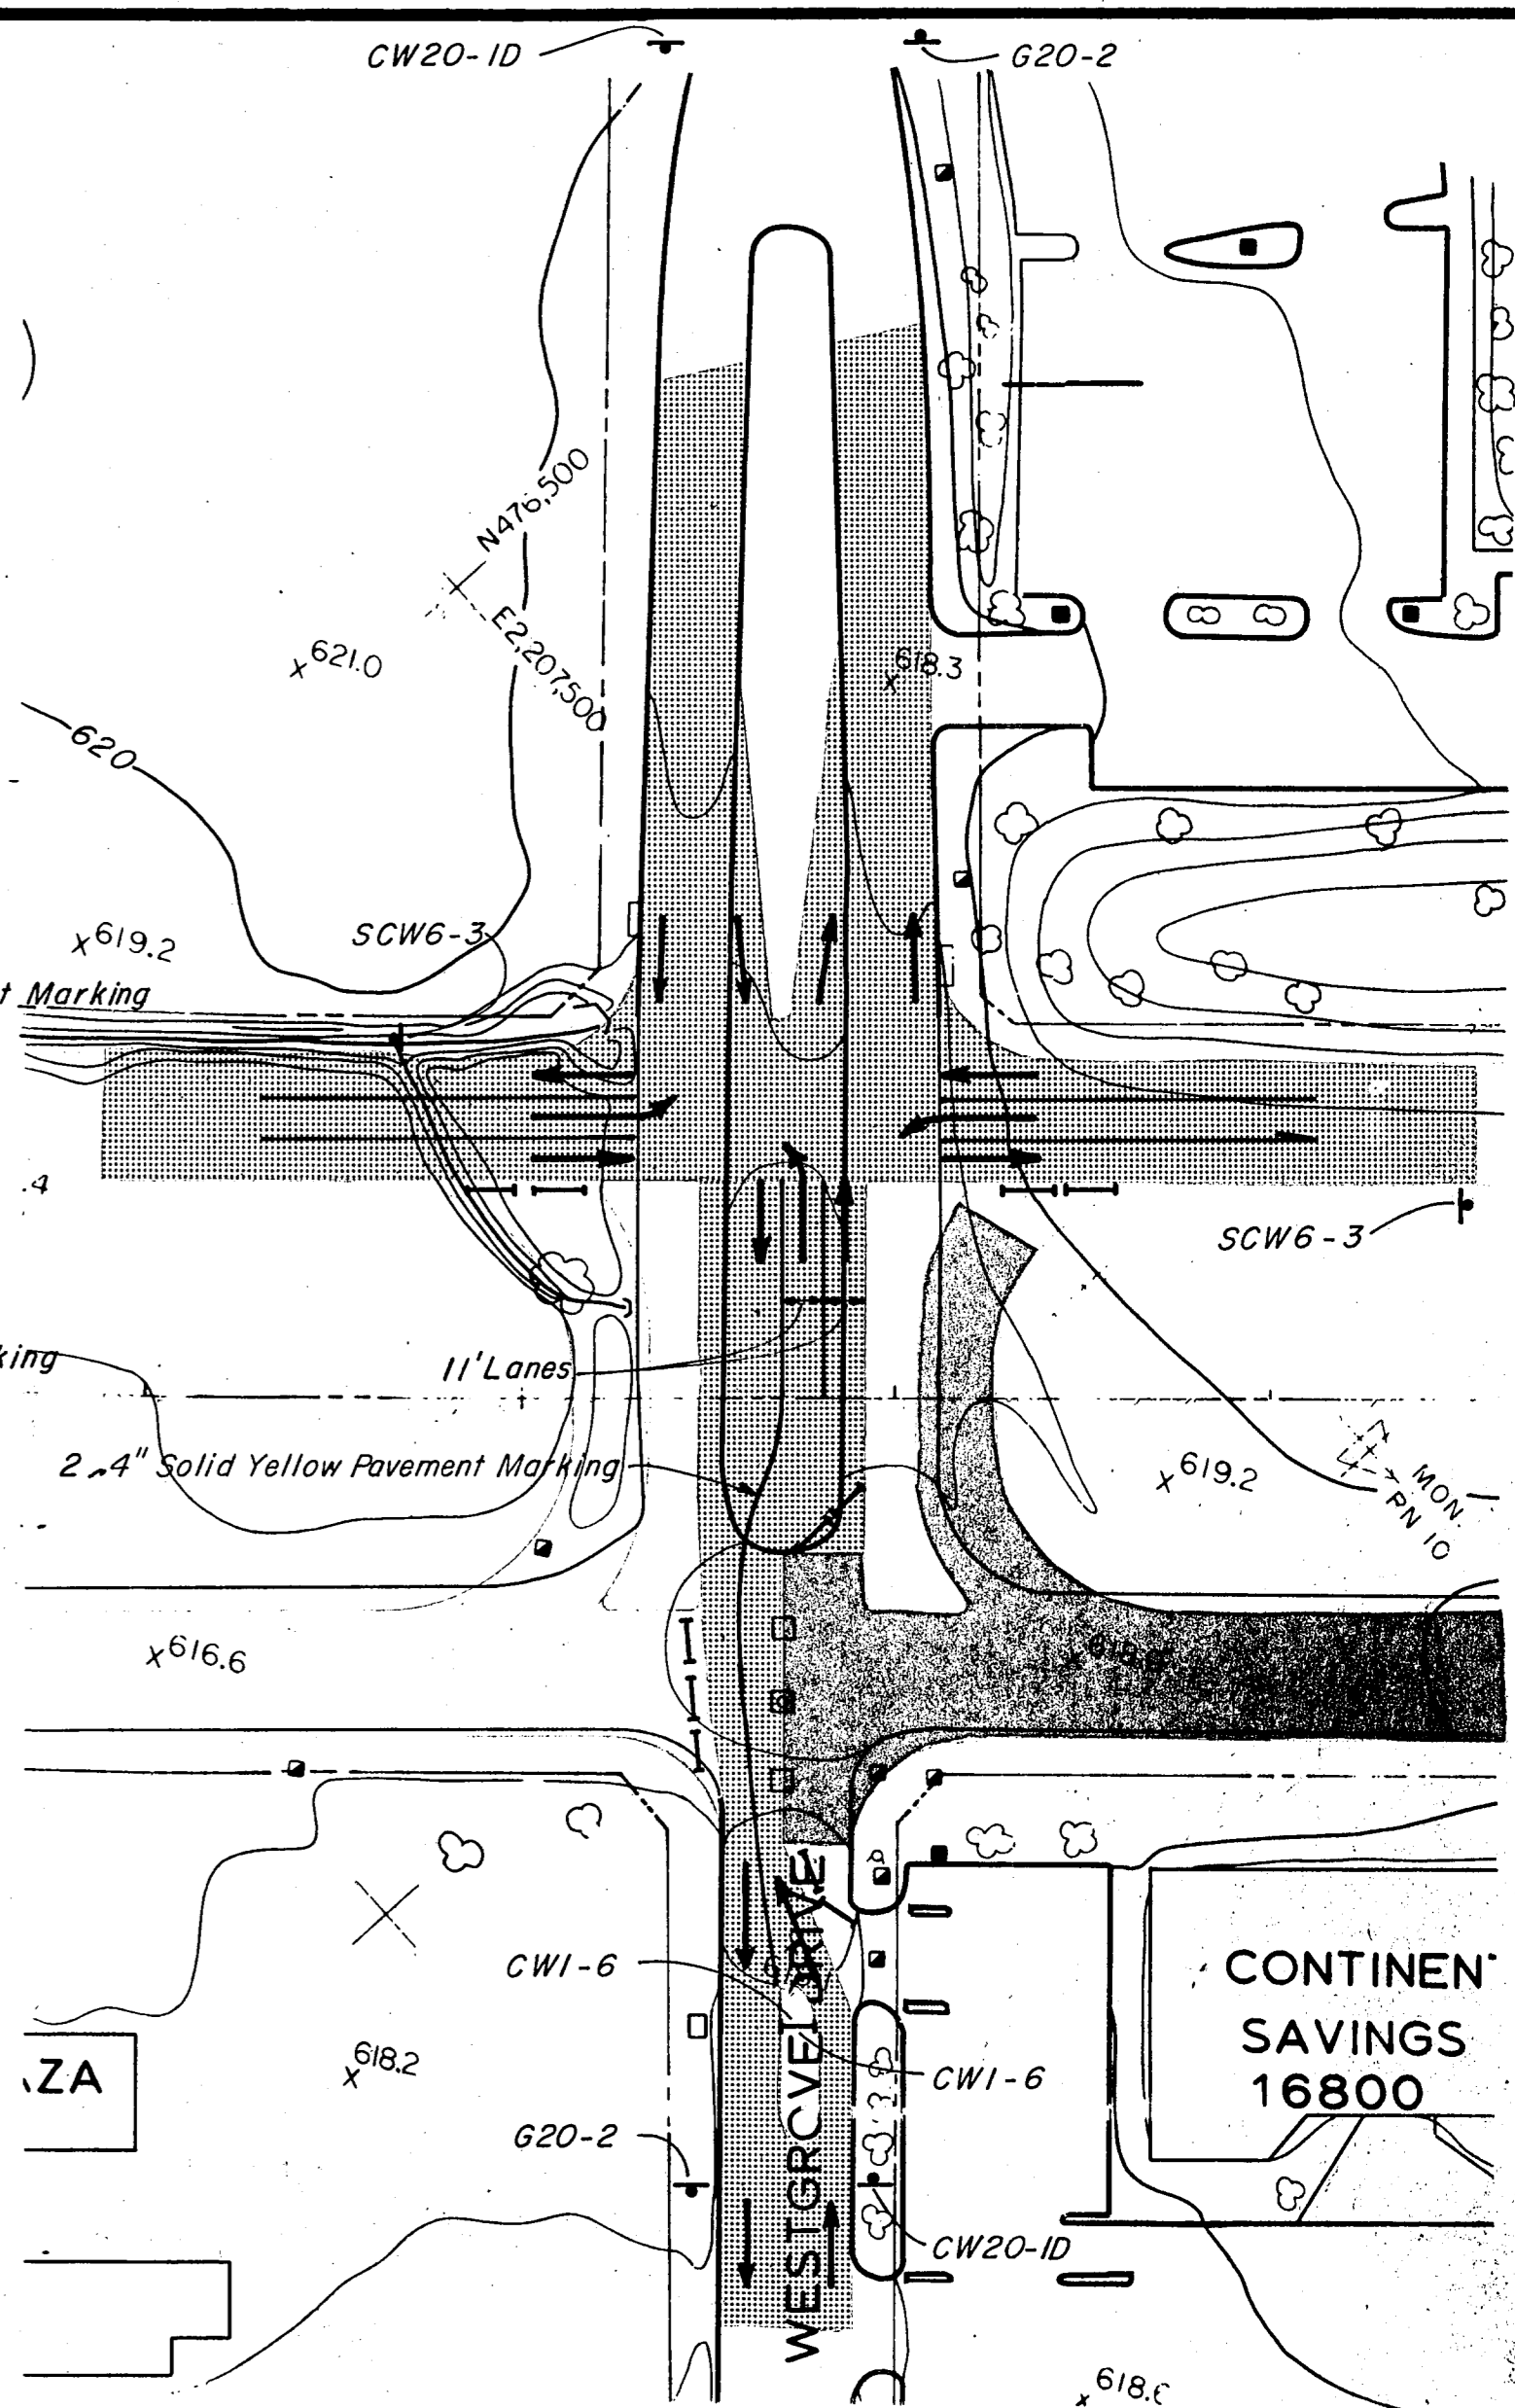

PHASE II  
STAGE 2

- TRAFFIC**
1. CLOSE NORTH 1/2 OF WESTGROVE DRIVE AND ROUTE TRAFFIC AS SHOWN ABOVE.
- CONSTRUCTION**
1. CONSTRUCT NORTHBOUND DALLAS PARKWAY AND U-TURN TO THE NORTH.

**LEGEND**

- Construction
- Traffic Lanes
- Detours
- Barricades
- Vertical Panel
- Vertical Panel With Flashers
- Barrel With Flasher
- Barrel
- Sign

PHASE III

- TRAFFIC**
1. ALL TRAFFIC PLACED ON COMPLETED DALLAS PARKWAY.
  2. U-TURNS REMAIN BARRICADED TO TRAFFIC UNTIL COMPLETION OF THE TOLLWAY BRIDGE OVERPASS.
  3. TRAFFIC MAY BE REDUCED TEMPORARILY TO TWO LANES AS NECESSARY FOR BRIDGE ERECTION BY USE OF BARRICADES AND FLAGMEN.
- CONSTRUCTION**
1. COMPLETE WALLS AND BRIDGE AND OPEN U-TURNS TO TRAFFIC.

**ASBUILT PLANS**

NO.	REVISION	BY	DATE
<b>TEXAS TURNPIKE AUTHORITY</b>			
<b>DALLAS NORTH TOLLWAY</b>			
CONSTRUCTION SEQUENCE AND TRAFFIC CONTROL			
WESTGROVE DRIVE INTERSECTION			
<b>Gibbs &amp; Hill, Inc.</b> ENGINEERS DESIGNERS CONSTRUCTORS DALLAS			<b>SECTION VII</b>
DRAWN VER	DATE 5/18/84	DESIGNED JOP	DATE 5-25-84
CHECKED DWC	DATE 8/3/84	SCALE 1"=50'	
CONTRACT NO. DNT-115 SHEET R40 OF R85			



MATCH LINE A SEE SHEET R43



Addison Road

Arapaho Road

Quorum Drive

Belt Line Road

Spectrum

Arapaho Road

St. Louis & Southwestern Railroad

Airport Parkway

Keller Springs Road

I

III

H

MATCH LINE B SEE SHEET R 42

610+00

620+00

630+00

640+00

650+00


6 Tollway

660+00

**ASBUILT PLANS**

NO.	REVISION	BY	DATE
TEXAS TURNPIKE AUTHORITY DALLAS NORTH TOLLWAY			
DRAINAGE AREA MAP			
<b>Gibbs &amp; Hill, Inc.</b> <small>ENGINEERS DESIGNERS CONSTRUCTORS DALLAS</small>			SECTION VII
DRAWN <i>CJB</i>	DATE <i>4/18/83</i>	DESIGNED <i>KJ</i>	DATE <i>4/15/83</i>
CHECKED <i>DWC</i>	DATE <i>5/8/84</i>	SCALE <i>1" = 200'</i>	
CONTRACT NO. <b>DNT-115</b> SHEET <b>R 41</b> OF <b>R85</b>			

Existing 8'x6' Box Culvert Area II  
 Existing 3-8'x8' Box Culvert Areas I & II  
 2-8'x8' Box Culvert Area I  
 33" RCP To Outfall (By Others)

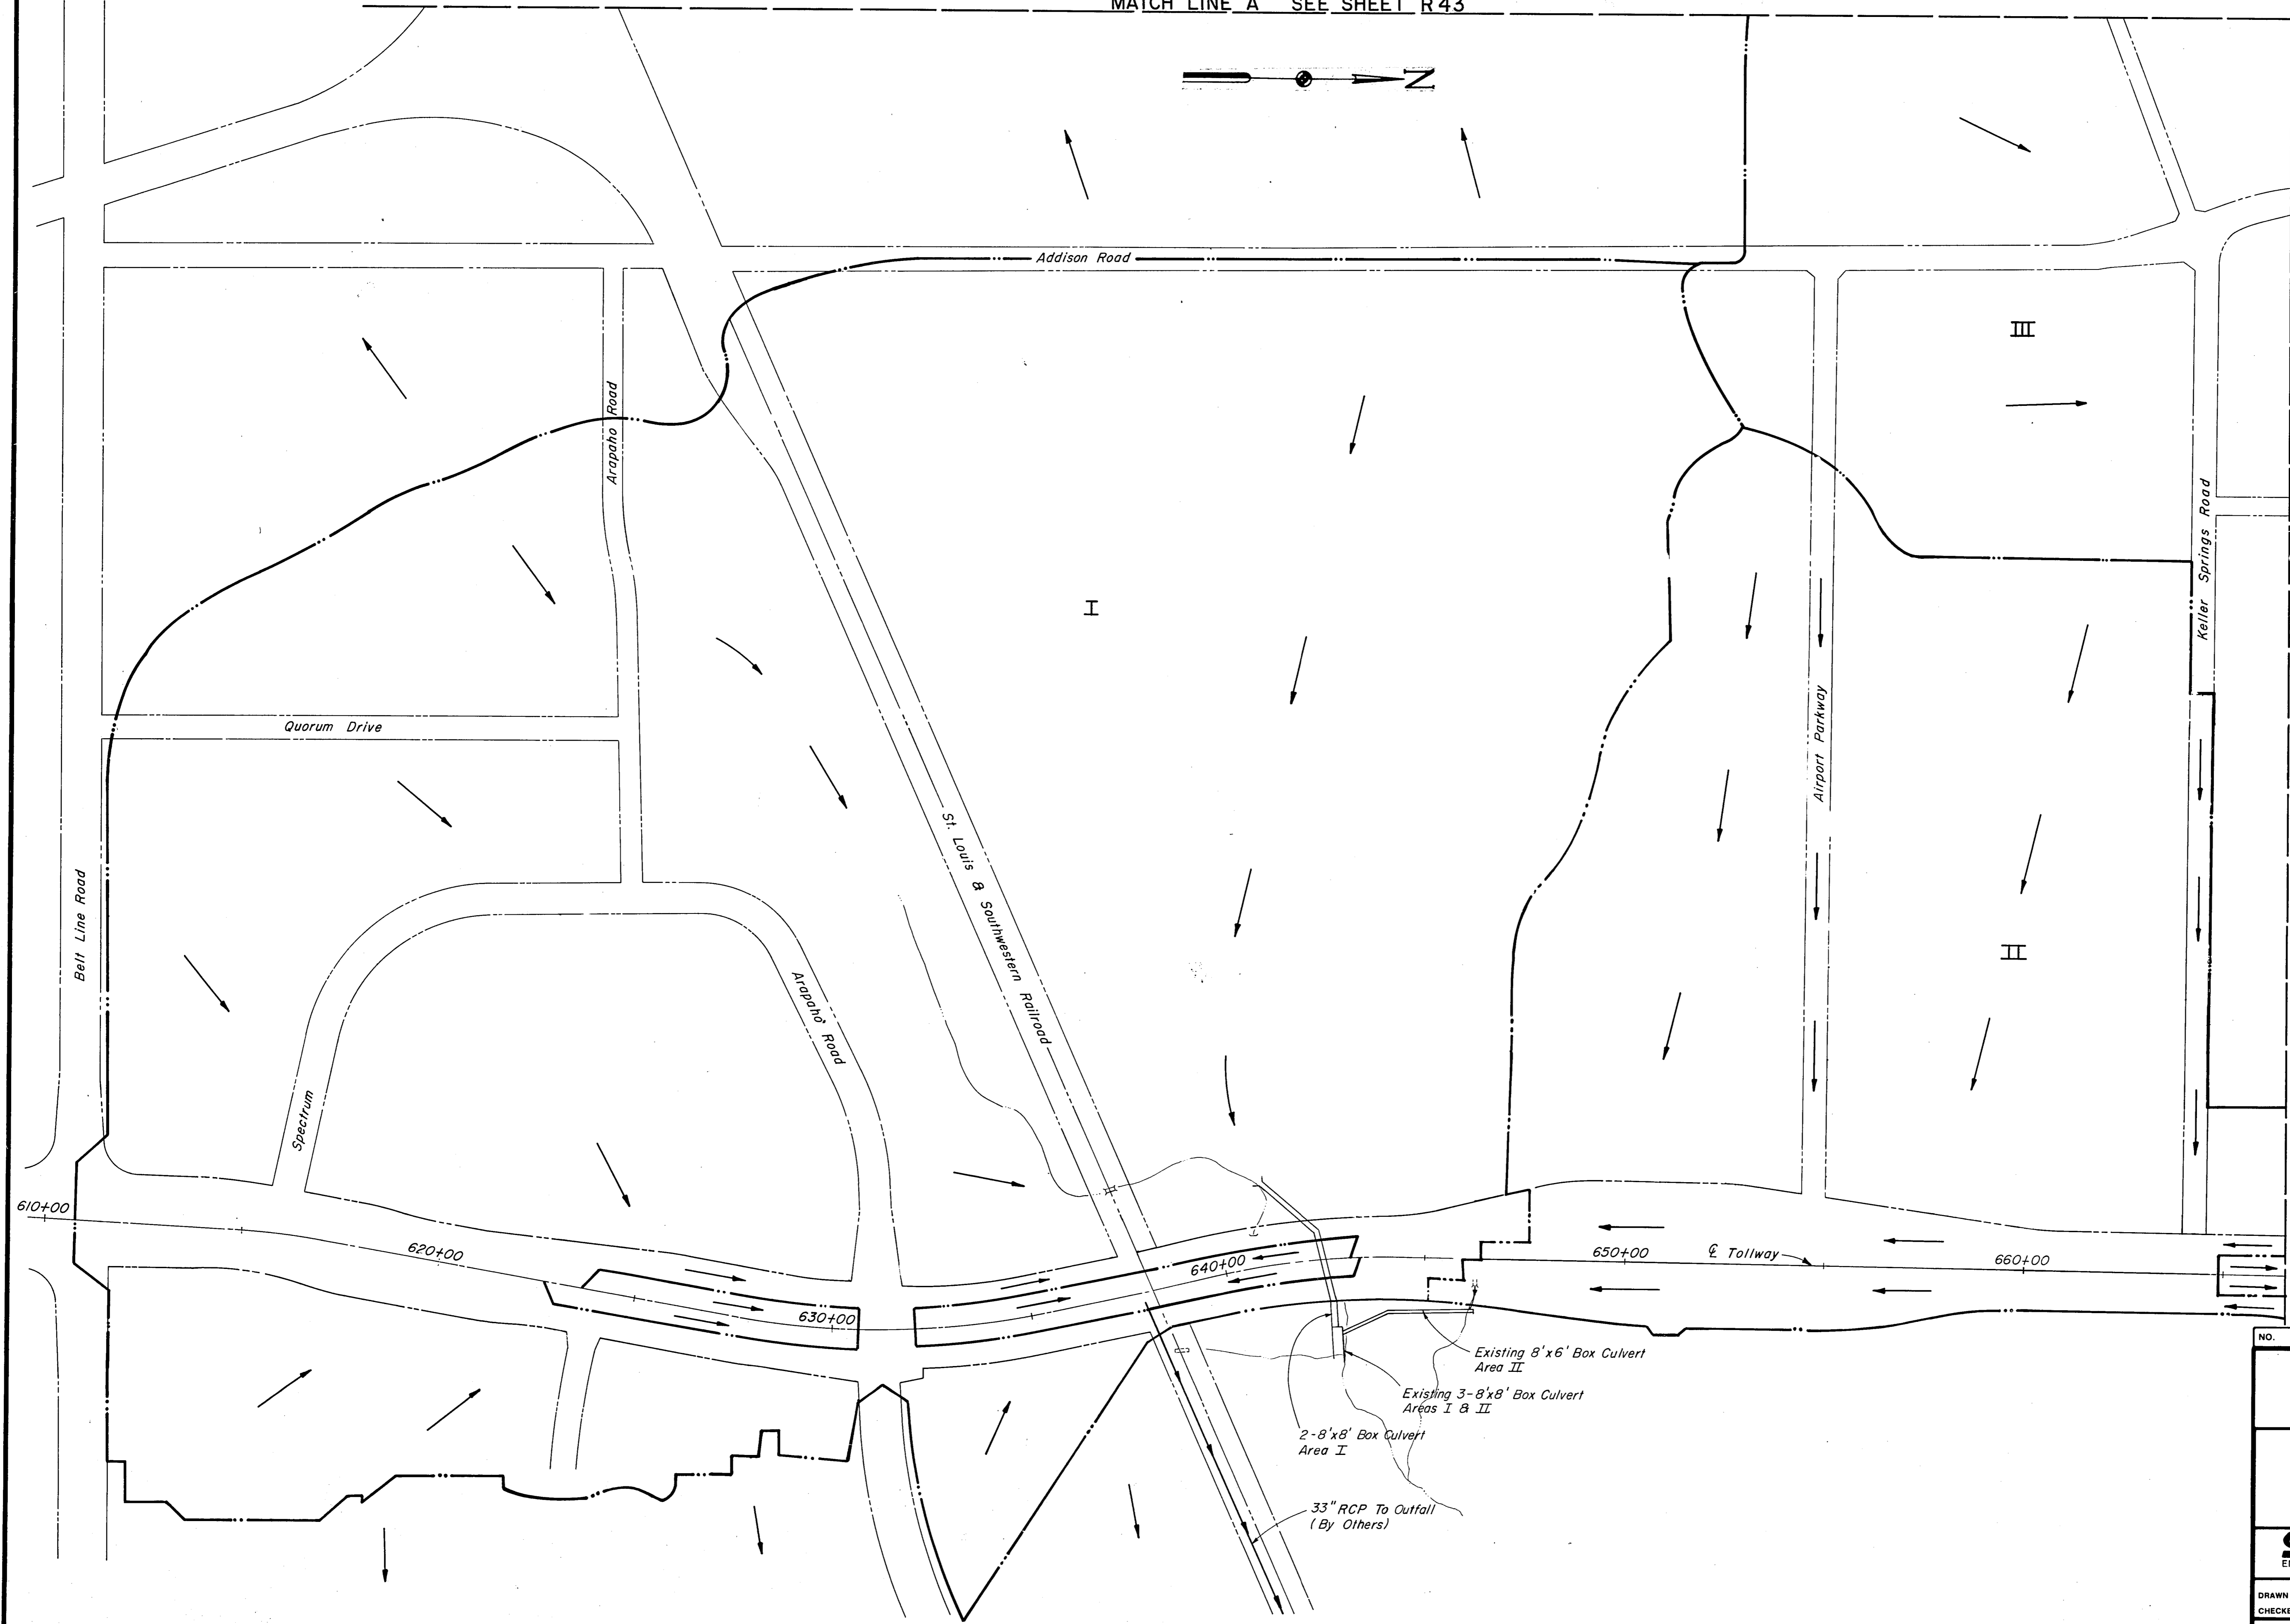






MATCH LINE C SEE SHEET R 43

MATCH LINE D SEE SHEET R 43


MATCH LINE B SEE SHEET R 41

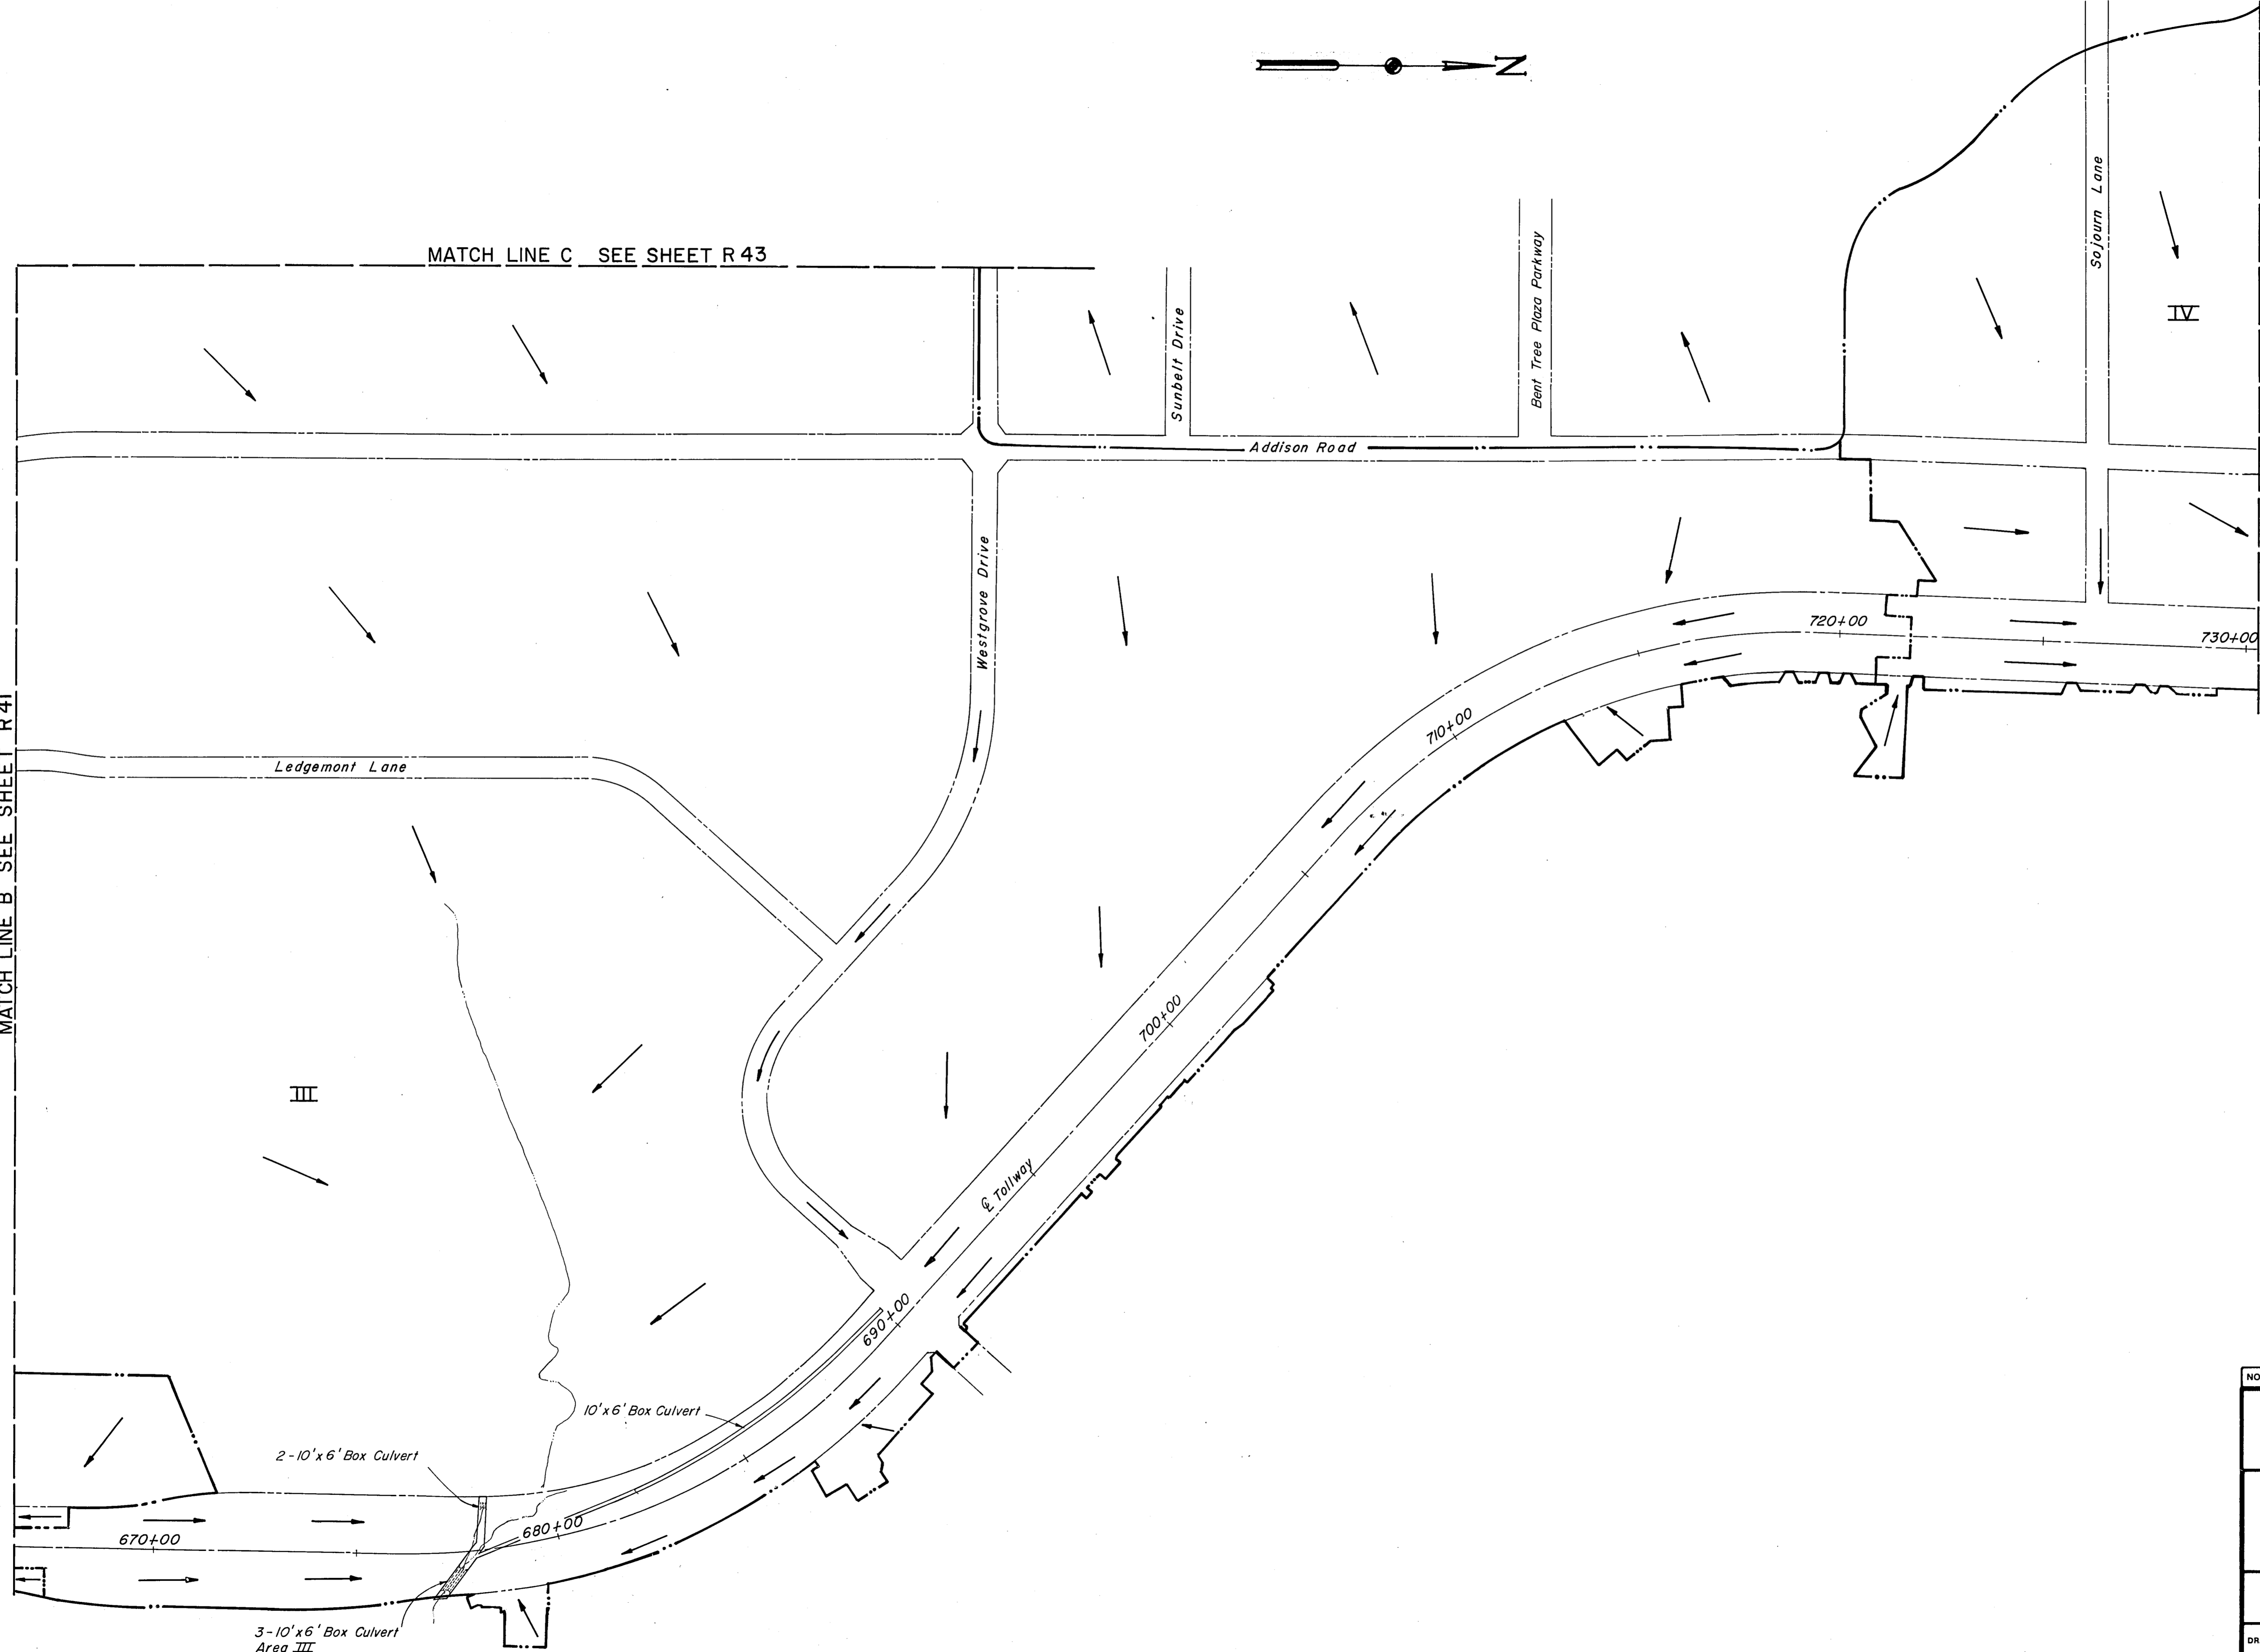

### ASBUILT PLANS

NO.	REVISION	BY	DATE
TEXAS TURNPIKE AUTHORITY DALLAS NORTH TOLLWAY			
DRAINAGE AREA MAP			
<b>Gibbs &amp; Hill, Inc.</b> ENGINEERS DESIGNERS CONSTRUCTORS DALLAS			SECTION VII
DRAWN	CJB/VER	DATE	5/9/83
DESIGNED	KJ	DATE	4/15/83
CHECKED	DWC	DATE	5/8/84
SCALE	1" = 200'		
CONTRACT NO. DNT-115 SHEET R 42 OF R85			



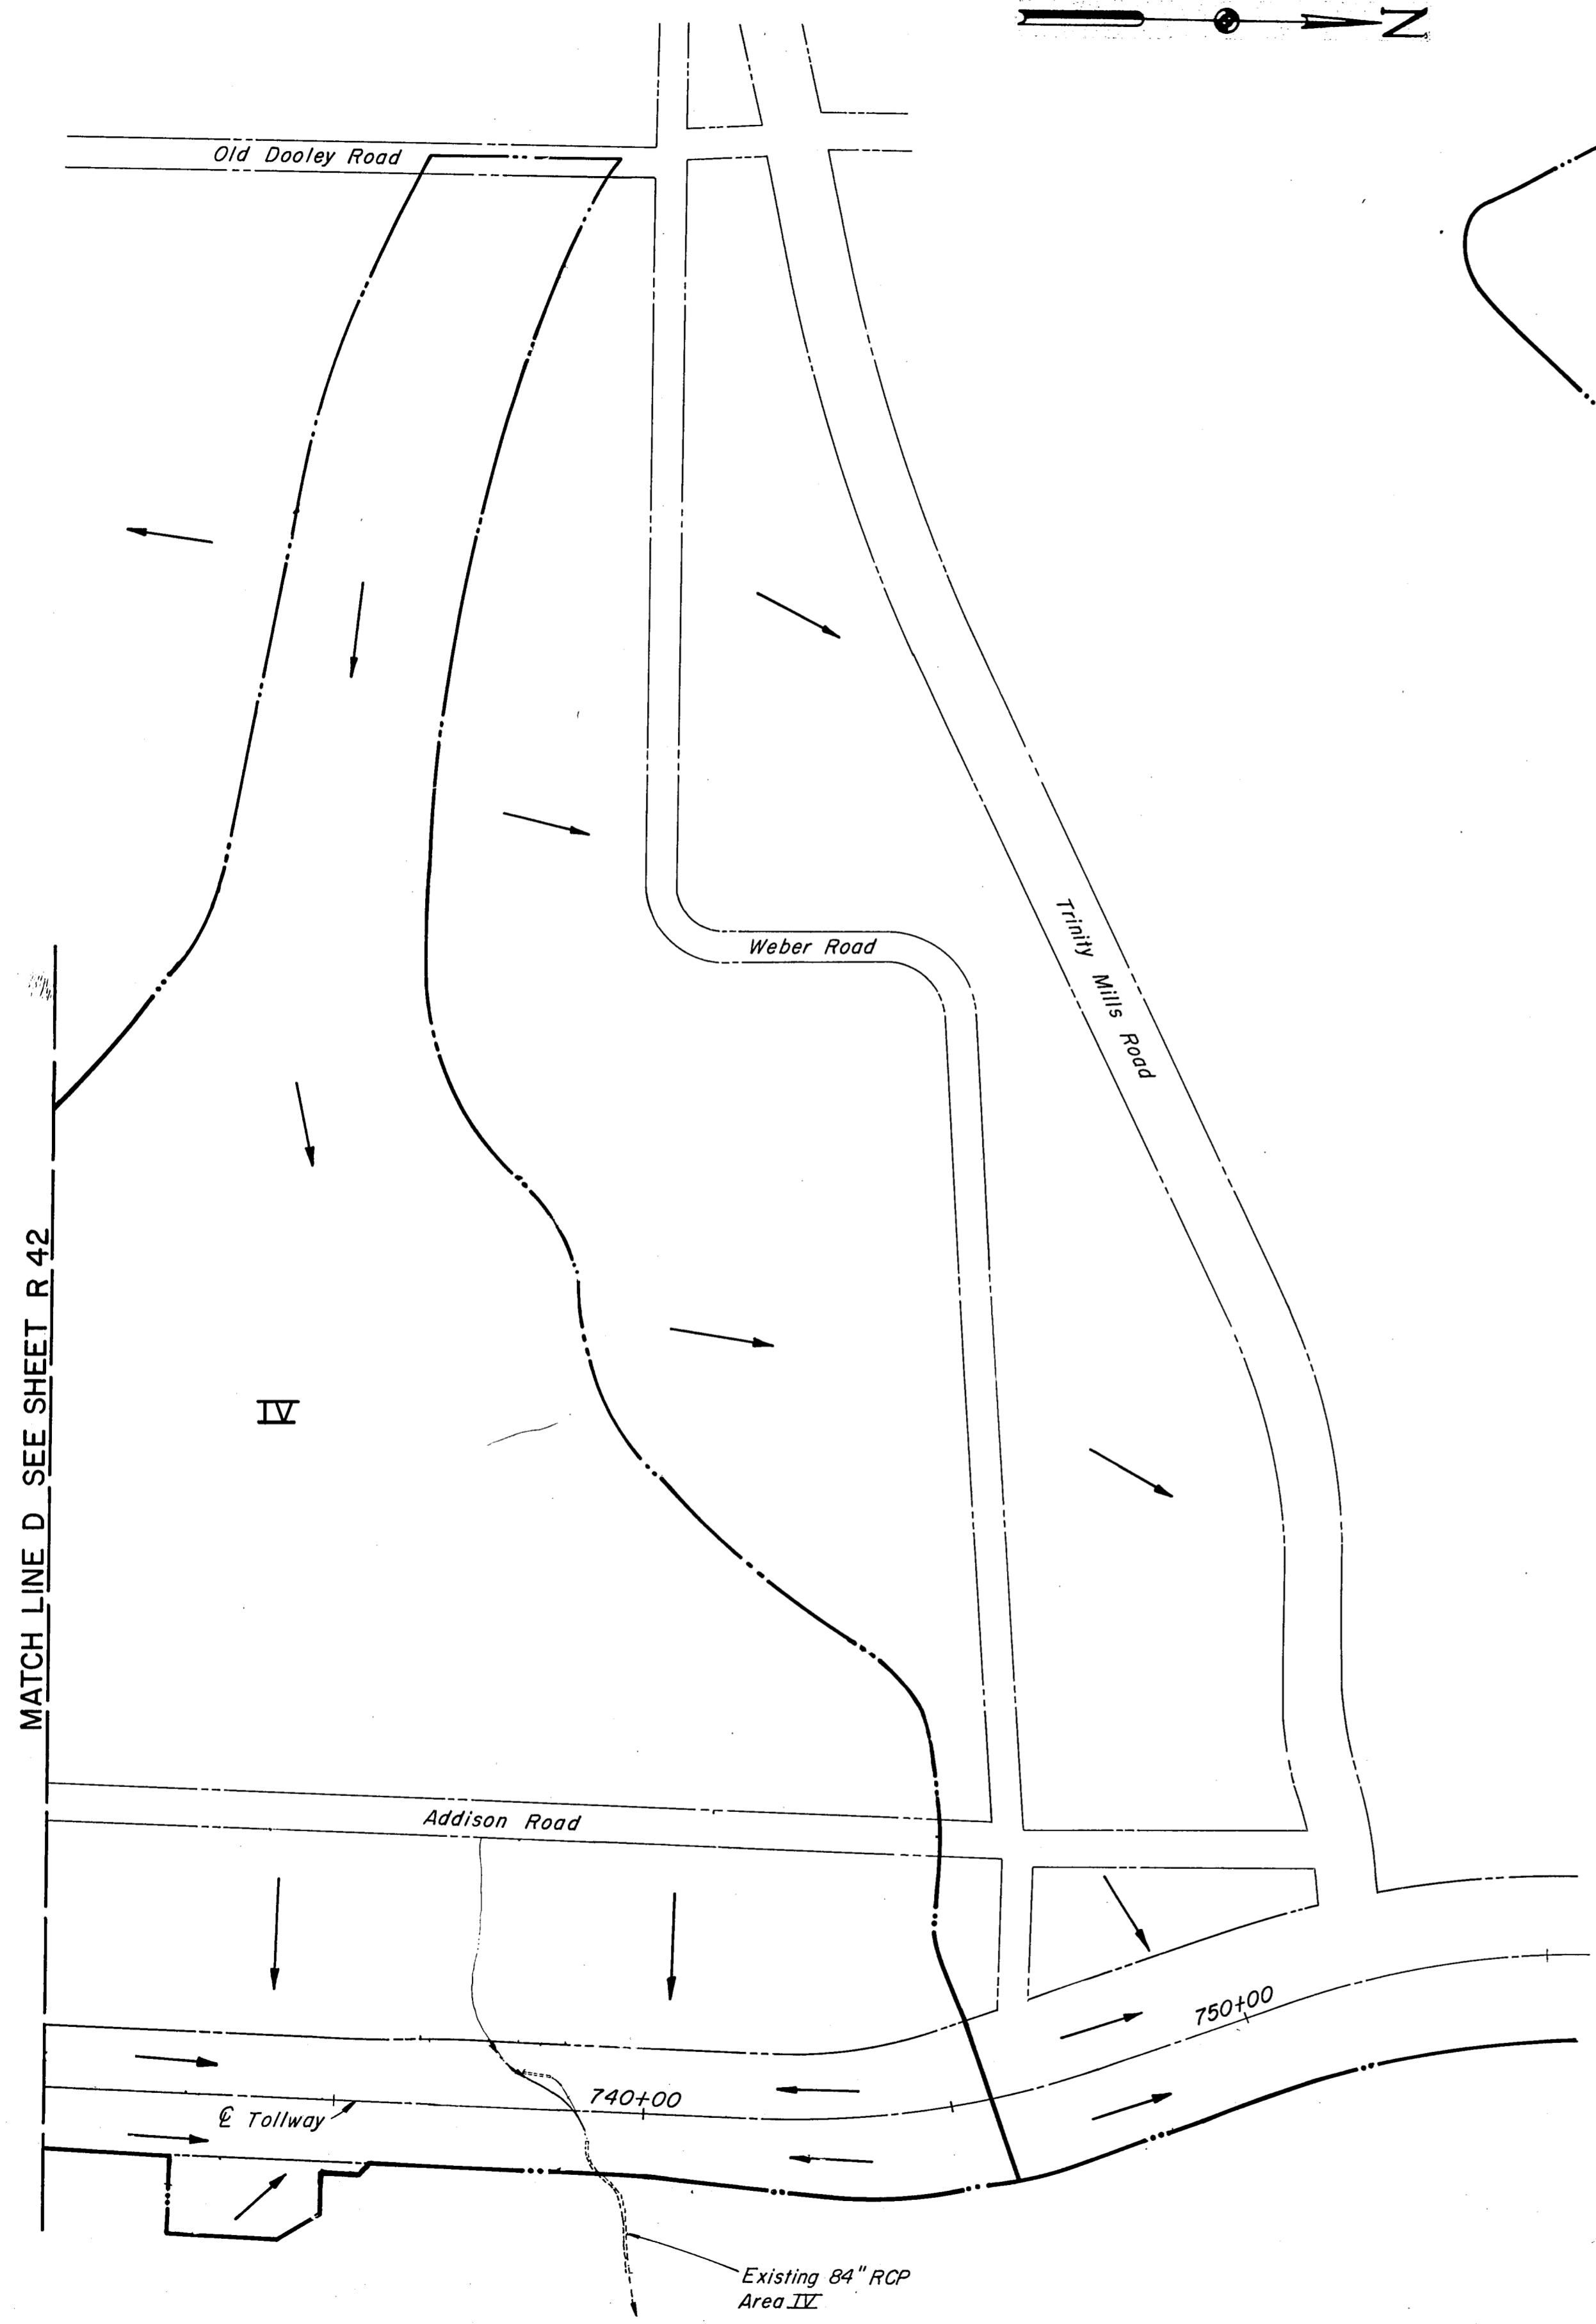

MATCH LINE D SEE SHEET R 42

Drainage Area #	Area (ac.s)	Time of Concentration (min.)	Discharge (C.F.S.)
I	224.8	15.5	1330
II	118.9	30.5	483
III	309.0	26.5	1365
IV	86.0	27.1	375

**ASBUILT PLANS**

NO.	REVISION	BY	DATE
TEXAS TURNPIKE AUTHORITY DALLAS NORTH TOLLWAY			
DRAINAGE AREA MAP			
<b>Gibbs &amp; Hill, Inc.</b> ENGINEERS DESIGNERS CONSTRUCTORS DALLAS			SECTION VII
DRAWN CJB	DATE 4/18/83	DESIGNED KJ	DATE 4/15/83
CHECKED DWC	DATE 5/8/84	SCALE 1" = 200'	
CONTRACT NO. DNT-115 SHEET R 43 OF R85			



# INLET & MANHOLE SUMMARY

ID#	LOCATION	DESCRIPTION	GUT ELEV.	OUTLET FL.	DEPTH	REMARKS	ID#	LOCATION	DESCRIPTION	GUT ELEV.	OUTLET FL.	DEPTH	REMARKS	ID#	LOCATION	DESCRIPTION	GUT ELEV.	OUTLET FL.	DEPTH	REMARKS										
LINE B-1																														
B-43	646+65	DNT	60'LT	8' TY "C"	606.51	598.12	8.5	△													D-20	703+15	DNT	40'LT	6' TY "C"	632.28	628.23	4.5		
B-35	649+00	DNT	85'LT	8' TY "C"	607.30	599.88	7.5														D-22	702+65	DNT	40'LT	3' TY "C"	632.02	627.94	4.5		
B-33	649+70	DNT	105'LT	8' TY "C"	607.30	602.37	5.0	△													D-24	702+15	DNT	40'LT	3' TY "C"	631.76	627.68	4.5		
B-55	651+74	DNT	113'LT	8' TY "C"	609.55	603.72	6.0	△	ABANDONED												D-26	701+65	DNT	40'LT	3' TY "C"	631.50	627.42	4.5		
B-29	651+96	DNT	105'LT	8' TY "C"	608.95	604.85	4.5	△													D-28	701+15	DNT	40'LT	3' TY "C"	631.24	627.16	4.5		
B-27	652+50	DNT	105'LT	8' TY "C"	609.26	604.25	5.5	△													D-30	700+65	DNT	40'LT	3' TY "C"	630.98	626.90	4.5		
B-25	653+50	DNT	96'LT	3' TY "C"	609.87	606.36	4.0														D-32	700+15	DNT	40'LT	3' TY "C"	630.72	626.14	5.0		
B-23	653+84	DNT	70'LT	3' TY "C"	610.44	604.02	6.5														D-34	699+65	DNT	40'LT	3' TY "C"	630.46	625.88	5.0		
B-21	654+25	DNT	67'LT	6' TY "C"	610.94	605.11	6.0														D-36	699+10	DNT	40'LT	3' TY "C"	630.17	625.62	5.0		
B-19	655+00	DNT	62'LT	6' TY "C"	612.26	607.33	5.0														D-41	698+98	DNT	40'LT	M.H. TY "III"	630.11	624.59	6.0	* RIM ELEV	
B-17	656+10	DNT	54'LT	6' TY "C"	615.09	611.01	4.5														D-40	698+98	DNT	40'RT	M.H. TY "III"	630.11	623.76	7.0	* RIM ELEV	
B-15	657+00	DNT	47'LT	8' TY "C"	618.20	614.12	4.5														LINE C-2									
B-13	658+25	DNT	40'LT	6' TY "C"	623.24	619.16	4.5														C-6	688+65	DNT	3'RT	TY "M"	635.11	630.96	4.5	2-GRATE	
B-11	659+75	DNT	40'LT	6' TY "C"	628.74	624.66	4.5														C-5	688+65	DNT	40'LT	6' TY "C"	633.40	629.25	4.5		
B-9	661+00	DNT	40'LT	6' TY "C"	632.25	628.17	4.5														C-7	685+90	DNT	40'LT	8' TY "C"	625.45	617.81	8.0		
B-7	662+30	DNT	40'LT	6' TY "C"	634.85	630.77	4.5														C-8	685+90	DNT	3'RT	TY "M"	627.63	621.11	7.0	3-GRATE	
N-3	119+00	N.B.	0'RT	10' TY "CDR"	607.13	602.99	4.5														C-9	682+90	DNT	40'LT	8' TY "C"	616.19	607.98	8.5		
LINE B-2																														
B-44	646+50	DNT	60'RT	3' TY "C"	606.44	597.52	9.0														C-10	682+90	DNT	3'RT	TY "M"	618.37	610.93	7.5	3-GRATE	
B-42	647+00	DNT	65'RT	3' TY "C"	606.61	598.36	8.5														LINE C-3									
B-40	647+45	DNT	70'RT	6' TY "C"	606.77	598.94	8.0														C-11	680+00	DNT	47'LT	8' TY "C"	613.33	609.19	4.5		
B-38	648+25	DNT	79'RT	8' TY "C"	607.02	600.21	7.0	△													C-13	679+16	DNT	54'LT	6' TY "C"	612.42	607.20	5.5		
B-36	649+00	DNT	88'RT	8' TY "C"	607.25	601.90	5.5														LINE D									
B-34	649+96	DNT	105'RT	8' TY "C"	607.55	603.41	4.5														D-1	721+05	DNT	3'LT	TY "M"	642.17	638.28	4.0	DELETED	
B-30	651+97	DNT	112'RT	8' TY "C"	608.90	604.96	4.0														D-2	721+45	DNT	40'RT	3' TY "C"	641.73	637.84	4.0		
B-28	652+75	DNT	112'RT	8' TY "C"	609.30	605.25	4.5														D-3	720+95	DNT	40'RT	3' TY "C"	641.53	637.54	4.5		
B-26	653+00	DNT	101'RT	3' TY "C"	609.90	605.87	4.5														D-4	720+00	DNT	3'LT	TY "M"	641.62	637.73	4.0	2-GRATE	
B-23	654+05	RAMP S-KS	101'RT	6' TY "C"	610.28	606.81	4.0														D-5	720+00	DNT	40'RT	3' TY "C"	640.48	636.49	4.5		
B-22	655+65	RAMP S-KS	101'RT	6' TY "C"	611.30	606.10	5.5														R-1	186+50	N.B.	0'RT	5' TY "CDR"	639.96	635.82	4.5		
N-2	126+00	N.B.	0'RT	5' TY "CDR"	612.00	608.11	4.5														R-2	184+75	N.B.	0'RT	5' TY "CDR"	639.10	634.96	4.5		
G-13	130+80	N.B.	90'LT	5' TY "CDR"	615.67	611.46	5.0	△													D-6	716+00	DNT	3'LT	TY "M"	639.54	635.46	4.5	3-GRATE	
G-4	131+98	N.B.	40'LT	10' TY "CDR"	615.25	609.90	6.0														D-7	716+00	DNT	40'RT	8' TY "C"	637.36	632.68	5.0		
N-1	132+25	N.B.	0'RT	5' TY "CDR"	614.50	610.36	4.5														R-3	181+30	N.B.	0'RT	5' TY "CDR"	635.80	631.66	4.5		
B-24	653+84	DNT	75'RT	3' TY "C"	610.39	606.06	4.5														R-4	180+89	N.B.	0'RT	30' SLOT DRN	635.28	633.28	---	18" DIA	
B-22	654+25	DNT	72'RT	6' TY "C"	610.89	606.56	4.5														D-8	712+00	DNT	3'LT	TY "M"	637.46	632.74	5.0	3-GRATE	
B-20	655+00	DNT	66'RT	6' TY "C"	612.21	608.13	4.5														D-9	712+00	DNT	40'RT	8' TY "C"	635.28	630.46	5.0		
B-18	656+10	DNT	58'RT	6' TY "C"	615.04	610.96	4.5														R-5	177+75	N.B.	0'RT	5' TY "CDR"	632.27	628.30	4.5		
B-16	657+00	DNT	52'RT	6' TY "C"	618.16	614.08	4.5	△													D-10	708+00	DNT	3'LT	TY "M"	635.38	630.32	5.5	3-GRATE	
B-14	658+25	DNT	42'RT	6' TY "C"	623.22	619.14	4.5	△													D-11	708+00	DNT	40'RT	8' TY "C"	633.20	628.04	5.5		
B-12	659+75	DNT	40'RT	6' TY "C"	628.74	624.66	4.5														Q-1	175+00	N.B.	0'RT	5' TY "CDR"	631.10	626.96	4.5		
B-10	661+00	DNT	40'RT	6' TY "C"	632.25	628.17	4.5														D-12	706+25	DNT	3'LT	TY "M"	634.47	630.39	4.5	2-GRATE	
B-8	662+30	DNT	40'RT	6' TY "C"	634.85	630.77	4.5														D-13	706+25	DNT	40'RT	3' TY "C"	633.12	627.30	6.0	△	
B-69	649+80	DNT	91'RT	M.H. TY "III"	607.62	601.65	6.5														P-1	168+50	N.B.	0'RT	5' TY "CDR"	630.10	625.96	4.5		
B-60	654+00	RAMP S-KS	94'RT	M.H. TY "III"	610.32	604.38	6.5														P-25	168+65	N.B.	28'LT	M.H. TY "III"	631.28	623.05	9.0	* RIM ELEV	
N-15	126+34	N.B.	39'LT	M.H. TY "III"	612.73	606.33	7.0														P-26	172+65	N.B.	28'LT	M.H. TY "III"	633.09	624.23	9.5	* RIM ELEV	
N-16	129+30	N.B.	28'LT	M.H. TY "III"	613.76	608.18	6.0														R-7	184+60	N.B.	28'LT	M.H. TY "III"	639.49	634.73	5.5	* RIM ELEV	
LINE B-4																														
B-48	645+50	DNT	48'RT	3' TY "C"	605.83	601.78	4.5														R-10	180+65	N.B.	28'LT	M.H. TY "III"	636.20	629.61	7.5	* RIM ELEV	
B-49	644+75	DNT	3'LT	TY "M"	605.76	601.68	4.5	3-GRATE △													R-45	176+65	N.B.	28'LT	M.H. TY "III"	633.06	627.13	6.5	* RIM ELEV	
B-50	644+75	DNT	40'RT	3' TY "C"	604.65	599.63	5.5														LINE D-1									
B-51	643+00	DNT	3'LT	TY "M"	602.39	598.31	4.5	3-GRATE △													D-1	692+00	DNT	40'LT	3' TY "C"	637.34	633.29	4.5		
B-52	643+00	DNT	40'RT	6' TY "C"	600.39	593.77	7.0														D-3	692+50	DNT	40'LT	3' TY "C"	637.17	633.09	4.5		
LINE C																														
C-3	665+79	DNT	40'LT	3' TY "C"	636.49	632.44	4.5														D-5	693+30	DNT	40'LT	3' TY "C"	636.59	632.51	4.5		
C-5	666+30	DNT	40'LT	3' TY "C"	636.08	631.93	4.5														D-7	694+20	DNT	40'LT	8' TY "C"	635.46	631.37	4.5	△	
C-7	667+30	DNT	40'LT	6' TY "C"	634.80	630.65	4.5														D-9	695+20	DNT	40'LT	8' TY "C"	633.66	629.58	4.5	△	
C-9	668+55	DNT	40'LT	6' TY "C"	632.31	628.16	4.5														D-11	696+20	DNT	40'LT	6' TY "C"	631.80	627.72	4.5		
C-11	669+80	DNT	40'LT	6' TY "C"	628.84	624.69	4.5														D-13	697+00	DNT	40'LT	3' TY "C"	630.68	626.60	4.5		
C-13	671+05	DNT	40'LT	6' TY "C"	625.09	620.94	4.5														D-15	697+50	DNT	40'LT	3' TY "C"	630.24	625.66	5.0		
C-15	672+30	DNT	40'LT	6' TY "C"	621.34	617.19	4.5														D-17	697+90	DNT	40'LT	3' TY "C"	630.03	625.45	5.0		
C-17	673+55	DNT	40'LT	6' TY "C"	617.51	613.27	4.5														D-19	698+35	DNT	40'LT	3' TY "C"	629.95	624.77	5.5		
C-20	674+50	DNT	40'LT	6' TY "C"	614.73	610.49	4.5														LINE D-2									
C-22	675+85	DNT	40'LT	6' TY "C"	612.18	607.69	5.0														D-2	692+30	DNT	40'RT	3' TY "C"	637.28	633.23	4.5		
C-24	676+58	DNT	40'LT	6' TY "C"	611.89	606.90	5.5														D-4	693+00	DNT	40'RT	3' TY "C"	636.85	632.70	4.5		
C-14	677+30	DNT	40'LT	6' TY "C"	612.13	606.42	6.0														D-6	693+80	DNT	40'RT	TY "M"	636.02	631.87	4.5	3-GRATE △	
LINE C-1																														
C-4	665+79	DNT	40'RT	3' TY "C"	636.49	632.41	4.5														D-8	694+70	DNT	40'RT	TY "M"	634.60	630.45	4.5	3-GRATE △	
C-6	666+30	DNT	40'RT	3' TY "C"	636.08	632.00	4.5														D-10	695+70	DNT	40'RT	3' TY "C"	632.72	628.57	4.5	△	
C-8	667+30	DNT	40'RT																											



# INLET & MANHOLE SUMMARY

ID#	LOCATION	DESCRIPTION	GUT ELEV	OUTLET FL	DEPTH	REMARKS	ID#	LOCATION	DESCRIPTION	GUT ELEV	OUTLET FL	DEPTH	REMARKS	ID#	LOCATION	DESCRIPTION	GUT ELEV	OUTLET FL	DEPTH	REMARKS						
T-16	19+08	RAMP S-TM 19' RT	3' TY "C"	631.26	628.72	3.5'		G-12	131+40	S.B.	33' RT	5' TY "CDR"	617.25	613.11	4.5		L-1	189+80	S.B.	0' LT	5' TY "CDR"	642.34	638.12	5.0		
T-17	18+25	RAMP S-TM 0' LT	5' TY "C&G"	632.88	627.76	5.5'	CURB & GRATE INLET	G-14	130+34	S.B.	33' RT	5' TY "CDR"	616.77	612.64	4.5		L-2	190+30	S.B.	0' LT	30' SLOT DRN	641.93	639.93	2.0	18" DIA	
T-18	17+00	RAMP S-TM 0' LT	5' TY "C&G"	635.77	627.26	8.5'	CURB & GRATE INLET	G-16	129+90	S.B.	25' LT	TY "Y"	616.00	610.82	6.0	* RIM ELEV	L-7	192+70	S.B.	0' LT	5' TY "CDR"	639.97	636.61	4.0		
T-19	746+00	DNT	3' RT	637.98	632.40	6.0'	3 GRATES	G-18	128+65	S.B.	0' LT	5' TY "CDR"	616.29	612.15	4.5		L-8	193+15	S.B.	0' LT	5' TY "CDR"	639.60	636.22	4.0		
T-22	750+99.7	DNT	42.29' RT	634.51	626.93	8.0'	1 GRATE	G-19	127+65	S.B.	0' LT	10' TY "CDR"	615.69	609.75	6.5		L-10	193+55	S.B.	35' LT	5' TY "CDR"	639.27	635.64	4.5		
T-23	752+64.6	DNT	39.51' RT	634.66	627.08	8.0'	1 GRATE	B-23	655+57	RAMP KS-5	96' LT	6' TY "C"	612.60	608.90	4.0		L-11	193+98	S.B.	31' LT	5' TY "CDR"	638.72	635.29	4.5	DELETED	
T-24	756+00	DNT	3' LT	654.98	651.40	4.0'	3 GRATES	B-22	654+05	RAMP KS-5	96' LT	6' TY "C"	610.38	604.56	6.0		L-12	194+35	S.B.	0' LT	5' TY "CDR"	638.62	634.99	4.5		
T-25	757+00	DNT	3' LT	654.03	650.45	4.0'	2 GRATES	B-66	128+29	S.B.	8' RT	M.H. TY "II"	616.14	608.89	8.0	* RIM ELEV	L-13	195+35	S.B.	0' LT	5' TY "CDR"	637.80	634.44	4.0		
T-26	757+65	DNT	3' LT	653.17	649.59	4.0	2 GRATES	B-67	131+40	S.B.	12' RT	M.H. TY "II"	617.85	611.45	7.0	* RIM ELEV	L-14	197+00	S.B.	0' LT	5' TY "CDR"	636.44	632.81	4.0		
T-27	758+43.0	DNT	41.53' RT	632.58	625.50	7.5'	1 GRATE	G-70	122+80	S.B.	0' LT	10' TY "CDR"	613.52	608.12	6.0		L-15	199+00	S.B.	0' LT	5' TY "CDR"	634.80	631.17	4.0		
T-28	759+13.1	DNT	41.54' LT	633.67	627.59	6.5'	1 GRATE	G-71	122+45	S.B.	24' LT	5' TY "CDR"	614.35	609.36	5.5		L-16	200+10	S.B.	0' LT	5' TY "CDR"	633.90	630.17	4.5		
T-29	760+86.0	DNT	80.88' LT	635.02	626.94	8.5'	1 GRATE	G-72	122+45	S.B.	85' LT	5' TY "CDR"	614.57	610.40	4.5	DELETED	L-18	202+00	S.B.	0' LT	5' TY "CDR"	632.34	630.61	4.5		
T-30	761+59.6	DNT	80.88' RT	632.72	624.64	8.5'	1 GRATE	G-60A	AIRPORT PKWY.	M.H. TY "I"			602.90			FIELD CHANGE	L-17	202+65	S.B.	21' LT	10' TY "CDR"	632.30	627.49	5.5	* RIM ELEV	
T-31	748+11.8	DNT	77.74' LT	636.15	629.07	7.5'	1 GRATE	G-60B	AIRPORT PKWY.	M.H. TY "Id"						FIELD CHANGE	L-19	204+00	S.B.	0' LT	5' TY "CDR"	631.05	627.34	4.0		
T-32	738+80	DNT	51' LT	630.43	626.32	4.5'		I-15	148+00	S.B.	0' LT	5' TY "CDR"	612.44	608.30	4.5		L-20	202+55	S.B.	21' LT	5' TY "CDR"	632.30	627.54	5.5	OPEN BACK	
T-33	739+30	DNT	51' LT	630.17	625.59	5.0'		H-8	147+04	S.B.	0' LT	10' TY "CDR"	612.10	607.96	4.5		L-30	193+83	S.B.	20' RT	M.H. TY "III"	639.36	633.86	6.0	* RIM ELEV	
T-34	739+80	DNT	51' LT	629.92	624.84	5.5'	CURB & GRATE INLET	H-7	146+50	S.B.	0' LT	10' TY "CDR"	612.25	607.16	5.5		L-50	201+49	S.B.	20' RT	M.H. TY "II"	633.47	626.96	6.5	* RIM ELEV	
T-35	740+30	DNT	51' LT	629.66	625.58	4.5'	CURB & GRATE INLET																			
LINE E-2							LINE H-2							LINE M												
E-1	722+75	DNT	40' LT	3' TY "C"	641.45	637.37	4.5		H-1	140+00	S.B.	0' LT	10' TY "CDR"	617.40	611.46	6.5		M-20	205+00	S.B.	0' LT	10' TY "CDR"	630.52	626.38	4.5	
E-5	723+45	DNT	40' LT	3' TY "C"	640.89	636.81	4.5		H-2	145+00	S.B.	0' LT	5' TY "CDR"	613.14	606.30	7.0		M-21	205+60	S.B.	0' LT	5' TY "CDR"	630.21	625.75	5.0	
E-7	724+15	DNT	40' LT	3' TY "C"	640.32	636.24	4.5		H-3	149+20	S.B.	0' LT	5' TY "CDR"	617.88	613.74	4.5		M-22	206+53	S.B.	0' LT	5' TY "CDR"	629.82	625.68	4.5	
E-9	724+85	DNT	40' LT	3' TY "C"	639.75	635.67	4.5		H-4	141+00	S.B.	0' LT	10' TY "CDR"	616.80	611.73	6.0		E-35	738+30	DNT	51' LT	3' TY "C"	630.68	625.60	5.5	
E-11	725+55	DNT	40' LT	3' TY "C"	639.17	635.09	4.5		H-5	143+00	S.B.	0' LT	10' TY "CDR"	614.76	608.83	6.5		L-23	207+35	S.B.	0' LT	14' TY "CDR"	630.28	624.62	6.5	
E-13	726+25	DNT	40' LT	3' TY "C"	638.60	634.52	4.5		H-6	145+00	S.B.	0' LT	10' TY "CDR"	613.06	606.33	7.5		S-9	206+50	N.B.	0' LT	5' TY "CDR"	629.86	625.22	5.0	
E-15	726+90	DNT	40' LT	3' TY "C"	638.07	633.99	4.5		H-11	141+03	S.B.	5' RT	M.H. TY "III"	616.88	610.90	6.5	* RIM ELEV	M-8	205+85	S.B.	0' LT	30' SLOT DRN	630.08	627.74	2.0	21" DIA
E-17	727+55	DNT	40' LT	3' TY "C"	637.53	633.45	4.5		H-13	145+03	S.B.	5' RT	M.H. TY "II"	613.14	605.23	8.5	* RIM ELEV	LINE P								
E-19	728+20	DNT	40' LT	3' TY "C"	637.00	632.92	4.5		K-1	188+20	S.B.	0' LT	5' TY "CDR"	642.60	638.46	4.5		P-2	165+00	N.B.	0' RT	5' TY "CDR"	624.11	619.97	5.0	
E-21	728+85	DNT	40' LT	3' TY "C"	636.47	632.39	4.5		K-2	187+80	S.B.	0' LT	30' SLOT DRN	642.40	640.40	2.0	18" DIA	P-3	160+00	N.B.	33' LT	10' TY "CDR"	617.56	612.09	6.0	
E-23	729+50	DNT	40' LT	3' TY "C"	635.93	631.85	4.5		K-3	187+55	S.B.	0' LT	5' TY "CDR"	642.28	638.14	4.5		P-4	157+50	N.B.	33' LT	5' TY "CDR"	615.98	610.97	5.5	
E-25	730+15	DNT	40' LT	3' TY "C"	635.40	631.32	4.5		K-4	187+00	S.B.	0' LT	5' TY "CDR"	642.00	637.86	4.5		P-5	154+33	N.B.	8' RT	5' TY "CDR"	614.80	609.29	6.0	
E-27	730+80	DNT	40' LT	3' TY "C"	634.88	630.55	4.5		K-5	186+42	S.B.	0' LT	5' TY "CDR"	641.71	637.62	4.5		P-6	154+00	N.B.	33' LT	10' TY "CDR"	614.19	607.88	7.0	
E-29	731+45	DNT	40' LT	3' TY "C"	634.42	630.24	4.5		K-6	186+15	S.B.	0' LT	5' TY "CDR"	641.58	637.44	4.5		O-4	145+41	N.B.	5' RT	TY "Y"	611.28	605.67	6.0	* RIM ELEV
E-31	732+10	DNT	40' LT	3' TY "C"	634.03	629.95	4.5		K-7	184+80	S.B.	0' LT	10' SP "CDR"	640.90	636.20	5.5	OPEN BACK	O-1	145+85	N.B.	33' LT	10' TY "CDR"	611.75	605.20	7.0	
E-33	732+60	DNT	40' LT	3' TY "C"	633.76	629.68	4.5		K-9	183+85	S.B.	0' LT	5' TY "CDR"	640.43	636.80	4.0		P-8	164+83	N.B.	28' LT	M.H. TY "II"	624.28	617.45	7.5	* RIM ELEV
E-35	733+10	DNT	40' LT	3' TY "C"	633.51	629.43	4.5		K-10	183+00	S.B.	0' LT	5' TY "CDR"	639.89	636.26	4.0		P-21	155-11	N.B.	28' LT	M.H. TY "I"	614.63	607.75	7.5	* RIM ELEV
DELETE LINE E-3							LINE K-1							LINE S												
E-37	733+65	DNT	40' LT	3' TY "C"	633.23	628.83	4.5		K-11	182+00	S.B.	0' LT	5' TY "CDR"	638.60	635.23	4.0		S-1	188+55	N.B.	0' RT	30' SLOT DRN	640.62	638.62	2.0	18" DIA
E-39	734+20	DNT	40' LT	3' TY "C"	632.95	628.55	4.5		K-12	181+50	S.B.	0' LT	5' TY "CDR"	637.90	634.27	4.5		S-2	190+50	N.B.	0' RT	5' TY "CDR"	639.56	635.42	4.5	
E-41	734+75	DNT	40' LT	3' TY "C"	632.67	628.27	4.5		K-13	180+95	S.B.	0' LT	5' TY "CDR"	637.13	633.50	4.0		S-3	192+20	N.B.	0' RT	5' TY "CDR"	638.40	634.26	4.5	
E-43	735+30	DNT	40.25' LT	3' TY "C"	632.38	627.98	4.5		K-15	180+50	S.B.	49' LT	10' TY "CDR"	637.09	632.75	5.0	ON BENT TREE	S-4	194+40	N.B.	0' RT	5' TY "CDR"	636.91	632.77	4.5	
E-45	735+80	DNT	42.29' LT	3' TY "C"	632.09	627.51	5.0		K-16	179+92	S.B.	72' LT	10' TY "CDR"	636.99	632.85	5.0	ON BENT TREE	S-5	196+70	N.B.	0' RT	5' TY "CDR"	635.38	631.24	4.5	
E-47	736+30	DNT	44.33' LT	3' TY "C"	631.81	627.23	5.0		K-17	179+86	S.B.	58' LT	14' TY "CDR"	636.85	632.83	4.5	ON BENT TREE	S-6	199+50	N.B.	0' RT	5' TY "CDR"	634.04	629.90	4.5	OPEN BACK
E-49	736+80	DNT	46.37' LT	3' TY "C"	631.52	626.94	5.0		K-18	179+00	S.B.	0' LT	5' TY "CDR"	635.48	631.85	4.0		S-7	202+00	N.B.	0' RT	5' SP "CDR"	632.06	629.19	3.5	OPEN BACK
E-51	737+30	DNT	48.41' LT	3' TY "C"	631.23	626.65	5.0		K-19	177+50	S.B.	0' LT	5' TY "CDR"	634.46	631.11	4.0		S-8	204+00	N.B.	0' RT	5' TY "CDR"	630.86	627.00	4.5	
E-53	737+80	DNT	50.45' LT	3' TY "C"	630.95	626.37	5.0		K-20	176+15	S.B.	0' LT	5' TY "CDR"	633.54	630.87	3.5		S-30	205+40	N.B.	0' RT	5' TY "CDR"	630.30	626.16	4.5	
LINE E-4							LINE K-2							LINE T												
E-37	733+65	DNT	40' LT	3' TY "C"	633.23	628.83	4.5		K-21	175+44	S.B.	0' LT	50' SLOT DRN	633.05	631.05	2.0	18" DIA	T-1	111+60	S.B.	0' LT	14' TY "CDR"	605			



# STORM SEWER SUMMARY

STORM SEWER OR LATERAL IDENTIFICATION	FROM	TO	SIZE (IN.)	LENGTH (FT.)	TYPE	REMARKS
LINE B-1						
	B-7	B-9	15	126	127	Rev. $\Delta$
	B-9	B-11	15	132	122	
	B-11	B-13	15	127	147	
	B-13	B-15	15		122	
	B-15	B-17	15		87	
	B-17	B-19	15		107	
	B-19	B-21	15		72	
	B-21	B-23	18		38	
	B-23	B-62	18		23	
LATERAL	B-25	B-58	15	4	14	
LATERAL	B-27	B-64	15		23	
LATERAL	B-29	B-66	15		24	
LATERAL	B-55	B-89	15		28	
LATERAL	B-33	B-70	15		30	
LATERAL	B-35	B-72	15		9	
LATERAL	B-43	B-80	15	12	9	
LATERAL	N-3	X-7	18	65	556	
LINE B-2						
	B-8	B-10	15		127	
	B-10	B-12	15		122	
	B-12	B-14	15		147	
	B-14	B-16	15		122	
	B-16	B-18	15	86	87	
	B-18	B-20	15		107	
	B-20	B-22	15		72	
	B-22	B-24	18		38	
	B-24	B-61	18		35	
LATERAL	G-4	N-99	21		19	
	N-1	A-1	18	49	45	
	A-1	N-99	24	0	3	
	N-99	A-10	24		140	
	A-10	N-98	4		3	
LATERAL	G-13	N-98	18		69	
	N-98	N-16	24		112	
	N-16	A-2	24	349	342	
	A-2	N-10	27	0	3	
LATERAL	N-2	N-10	15		42	
	N-10	N-15	27		45	
	N-15	A-3	27	258	255	
	A-3	B-59	30		3	
LATERAL	B-86	B-59	15	8	12	$\Delta$
	B-59	B-60	30	140	158	
LATERAL	B-23	B-60	15	8	12	$\Delta$
	B-60	A-5	33		40	
	A-5	B-61	33		3	
LATERAL	B-26	B-61	15	9	12	$\Delta$
	B-61	B-63	33		87	
LATERAL	B-28	B-63	15	12	18	
	B-63	B-65	33		85	
LATERAL	B-30	B-65	15		23	
	B-65	B-67	33		200	
LATERAL	B-34	B-67	15		18	
	B-67	B-69	33		5	
	B-69	B-71	33		81	
LATERAL	B-36	B-71	15	7	7	$\Delta$
	B-71	B-73	33		25	
LATERAL	B-38	B-73	15	7	7	$\Delta$
	B-73	B-77	33		80	
LATERAL	B-40	B-77	15	7	7	$\Delta$
	B-77	B-79	33		45	
LATERAL	B-42	B-79	15	7	7	$\Delta$
	B-79	B-82	33		50	
LATERAL	B-44	B-82	15		4	
	B-82	B-83	33		20	
LINE B-4						
	B-48	B-50	15		72	
LATERAL	B-49	B-50	15	39	44	
	B-50	B-52	15	170	172	
LATERAL	B-51	B-52	15		41	
	B-52	B-85	15	32	34	
LINE C						
	C-3	C-5	15	49	48	
	C-5	C-7	15		97	
	C-7	C-9	15	116	122	
	C-9	C-11	15	120	122	
	C-11	C-13	15	120	122	
	C-13	C-15	15		122	
	C-15	C-17	15		122	
	C-17	C-17B	15		43	
	C-17B	C-20	15		49	
	C-20	C-22	15	131	132	
	C-22	C-24	21	68	570	
	C-24	C-14	24	67	66	
	C-14	C-27	24	80	66	
LATERAL	C-17A	C-17B	15	221	20	$\Delta$

STORM SEWER OR LATERAL IDENTIFICATION	FROM	TO	SIZE (IN.)	LENGTH (FT.)	TYPE	REMARKS
LINE C-1						
	C-4	C-6	15		48	Rev. $\Delta$
	C-6	C-8	15	96	97	
	C-8	C-10	15	121	122	
	C-10	C-12	15	130	122	
	C-12	C-14	15	130	122	
	C-14	C-16	15	129	122	
	C-16	C-18	15	99	93	
	C-18	C-21	15	169	180	
	C-21	C-23	18	71	82	
	C-23	C-25	18	72	70	
	C-25	C-26	21	60	69	
	C-26	C-28	21	32	28	
LINE C-2						
LATERAL	C-6	C-5	15	40	44	
	C-5	C-7	15	262	275	
LATERAL	C-8	C-7	15	39	44	
	C-7	C-9	15	288	300	
LATERAL	C-10	C-9	15	40	44	
	C-9	I-24	18		19	
LINE C-3						
	C-11	C-13	15		84	
	C-13	C-99	15	$\Delta$	75	
LINE D						
	D-2	D-3	15		47	
LATERAL	D-1	D-3	15	42	43	DELETED
	D-3	D-5	15	90	92	
LATERAL	D-4	D-5	15	40	44	
	D-5	A-1	15		107	
LATERAL	A-1	R-6	18	8	3	
	R-1	R-6	18		36	
LATERAL	R-6	R-7	18		173	
	R-2	R-7	18		36	
LATERAL	R-7	A-3	18	117	105	
	A-3	R-8	21		3	
LATERAL	D-6	D-7	15		41	
LATERAL	D-7	R-8	21		23	
	R-8	A-4	21	225	237	
	A-4	R-9	24	7	3	
LATERAL	R-3	R-9	18	32	36	
	R-9	R-10	24		55	
LATERAL	R-4	R-10	18	38	35	
	R-10	R-11	30		85	
LATERAL	D-8	D-9	15		41	
LATERAL	D-9	R-11	15		23	
	R-11	R-12	30		225	
LATERAL	R-5	R-12	18	37	36	
	R-12	R-45	30		93	
	R-45	A-8	30		65	
	A-8	R-13	33		3	
LATERAL	D-10	D-11	15		41	
LATERAL	D-11	R-13	15	27	23	
	R-13	A-9	33		117	
	A-9	Q-2	36		3	
LATERAL	Q-1	Q-2	18	37	36	
	Q-2	A-10	36		47	
	A-10	Q-3	42		3	
LATERAL	D-12	D-13	15		41	
LATERAL	D-13	Q-3	15		23	
	Q-3	P-26	42		163	
	P-26	P-25	42		396	
	P-25	P-6	42		33	
LATERAL	P-1	P-6	18	37	36	
	P-6	A-12	42		125	
LINE D-1						
	D-1	D-3	15	0	47	DELETED
	D-3	D-5	15	78	77	
	D-5	D-7	15	86	87	
	D-7	D-9	15		97	
	D-9	D-11	15		97	
	D-11	D-13	15		77	
	D-13	D-15	15		47	
	D-15	D-17	18	38	37	
	D-17	D-19	18		42	
	D-19	D-41	21	59	58	
LINE D-2						
	D-2	D-4	15		67	
	D-4	D-6	15	78	77	
	D-6	D-8	15		87	
	D-8	D-10	15	96	97	
	D-10	D-12	15		87	
	D-12	D-14	15	66	67	
	D-14	D-16	18		47	
	D-16	D-18	21		52	
	D-18	D-39	21		47	
	D-39	D-40	21	10	8	

STORM SEWER OR LATERAL IDENTIFICATION	FROM	TO	SIZE (IN.)	LENGTH (FT.)	TYPE	REMARKS
LINE D-3						
	D-15	D-17	15	46	47	Rev. $\Delta$
	D-17	D-19	15		47	
	D-14	D-16	15		35	
	D-16	D-18	15		27	
LATERAL	D-18	D-19	15		47	
	D-19	D-21	15		47	
	D-21	D-23	15		47	
	D-23	D-25	15		47	
	D-25	D-27	18		47	
	D-27	D-29	18		47	
	D-29	D-31	18		47	
	D-31	D-33	18		47	
	D-33	D-35	21		47	
	D-35	D-37	21		47	
	D-37	D-38	21		47	
	D-38	D-40	21		37	
LINE D-4						
	D-20	D-22	15		47	
	D-22	D-24	15		47	
	D-24	D-26	15		47	
	D-26	D-28	15		47	
	D-28	D-30	15		47	
	D-30	D-32	15		47	
	D-32	D-34	18		47	
	D-34	D-36	18		52	
	D-36	D-41	18		9	
	D-41	D-40	21		80	
	D-40	P-7	24		20	
LINE E						
	E-2	E-3	15		37	
	E-3	E-4	15		47	
	E-4	E-6	15		62	
	E-6	E-8	15		62	
	E-8	E-10	15		62	
	E-10	E-12	15		62	
	E-12	E-14	15		62	
	E-14	E-16	15		62	
	E-16	E-18	15		62	
	E-18	E-20	15		62	
	E-20	E-22	15		62	
	E-22	E-24	15		62	
	E-24	E-26	18	64	62	
	E-26	E-28	18	58	62	
	E-28	E-30	18	61	62	
	E-30	E-32	21		62	
	E-32	E-34	21		47	
	E-34	E-36	21	46	47	
	E-36	E-38	21	53.2	52	
	E-38	E-40	21		52	
	E-40	E-42	21		47	
	E-42	E-44	21		47	
	E-44	E-46	21		47	$\Delta$
	E-46	E-48	21	48	47	$\Delta$
	E-48	E-50	21		47	$\Delta$
	E-50	E-52	21		47	$\Delta$
	E-52	E-54	21	48.8	47	$\Delta$
	E-54	E-56	21		47	$\Delta$
	E-56	E-58	24		37	$\Delta$
	E-58	E-60	24		37	$\Delta$
	E-60	E-62	24	10	9	$\Delta$

$\Delta$ AS BUILT PLANS	PJ	12-23-87
$\Delta$ Revised Line C	GMG	7-03-86
$\Delta$ Revised Line B-2	REF	3-25-86
$\Delta$ Misc. Drainage Revisions	GMG	10-10-85
$\Delta$ Line C-3 Revised	MGB	2-8-85
NO. REVISION	BY	DATE

**TEXAS TURNPIKE AUTHORITY**  
**DALLAS NORTH TOLLWAY**

STORM SEWER SUMMARY

**Gibbs & Hill, Inc.**  
ENGINEERS DESIGNERS CONSTRUCTORS

SECTION VII

DRAWN AEL DATE 7/30/84	DESIGNED AEL DATE 7/30/84
CHECKED DWK DATE 7/30/84	SCALE None

CONTRACT NO. DNT-115 SHEET R46 OF R85

**ASBUILT PLANS**



# STORM SEWER SUMMARY

STORM SEWER OR LATERAL IDENTIFICATION	FROM	TO	SIZE (IN.)	LENGTH (FT.)	TYPE	REMARKS	STORM SEWER OR LATERAL IDENTIFICATION	FROM	TO	SIZE (IN.)	LENGTH (FT.)	TYPE	REMARKS	STORM SEWER OR LATERAL IDENTIFICATION	FROM	TO	SIZE (IN.)	LENGTH (FT.)	TYPE	REMARKS		
LINE E-2	E-1	E-5	18	67		Rev. $\Delta$	LATERAL	B-23	B-54	15	33	<del>32</del>	Rev. $\Delta$	LINE K-2	X-1	K-23	42	34	$\Delta$	Rev. $\Delta$		
	E-5	E-7	18	67				B-54	B-55	60	37	<del>40</del>		LATERAL	K-23	A-12	60	726	<del>8</del>	$\Delta$		
	E-7	E-9	18	67				X-2	G-75	33	0	<del>6</del>	FIELD CHANGE	LATERAL	J-4	J-5	66	3	$\Delta$			
	E-9	E-11	18	67				G-70	G-75	21	0	<del>16</del>	DELETED	LATERAL	J-5	J-6	66	58	<del>63</del>	$\Delta$		
	E-11	E-13	18	67				G-75	B-55	36	0	<del>49</del>	DELETED	LATERAL	J-6	J-7	66	124	$\Delta$			
	E-13	E-15	18	605	<del>62</del>			B-55	B-56	60	70			LATERAL	J-7	J-8	66	150	$\Delta$			
	E-15	E-17	18	63	<del>62</del>			X-3	B-56	33	12.5	<del>7</del>		LATERAL	J-8	I-38	66	237	$\Delta$			
	E-17	E-19	18	645	<del>62</del>			B-56	B-57	60	25			LATERAL	I-1	I-38	$\Delta$ 24	36	21	<del>22</del>	$\Delta$	
	E-19	E-21	18	605	<del>62</del>			B-22	B-57	15	2	<del>6</del>	DELETED	LATERAL	I-38	I-37	66	165	$\Delta$			
	E-21	E-23	18	60	<del>62</del>			B-57	B-90	60	18			LATERAL	I-2	I-37	66	22	$\Delta$			
	E-23	E-25	18	59	<del>62</del>			G-72	G-71	18	0	<del>67</del>		LATERAL	I-37	I-40	66	176	<del>54</del>	$\Delta$		
	E-25	E-27	18	635	<del>62</del>			G-71	G-76	18	20			LATERAL	I-92	I-91	18	31.5	<del>30</del>	$\Delta$		
	E-27	E-29	21	62.5	<del>62</del>			LINE H-1	I-15	A-1	18	79	<del>101</del>		LATERAL	I-40	I-36	66	224	<del>190</del>	$\Delta$	
	E-29	E-31	21	61	<del>62</del>				A-1	I-18	30	3		LATERAL	I-3	I-36	18	172	<del>22</del>	$\Delta$		
	E-31	E-33	21	48	<del>47</del>			LATERAL	H-8	I-18	21	10	<del>9</del>		LATERAL	I-36	I-91	66	88	$\Delta$		
	E-33	E-35	21	495	<del>47</del>				I-18	A-2	30	51		LATERAL	I-91	I-90	66	152	$\Delta$			
	E-35	L-36	21	36				LATERAL	A-2	I-17	33	3		LATERAL	I-4	I-35	21	41.5	<del>37</del>	$\Delta$		
LINE E-3	E-48	E-50	15	0	<del>52</del>	$\Delta$		LATERAL	H-7	I-17	21	53	<del>9</del>		LATERAL	I-35	A-17	66	78	$\Delta$		
	E-50	E-52	15	0	<del>52</del>	$\Delta$		$\Delta$ LINE H-2	I-17	I-16	33	$\Delta$ 72	<del>60</del>		LATERAL	A-17	I-34	66	3	$\Delta$		
	E-52	E-56	15	0	<del>47</del>	$\Delta$		LATERAL	H-3	H-7	48	18	<del>17</del>		LATERAL	I-5	I-34	18	21	<del>22</del>	$\Delta$	
LINE E-4	E-37	E-39	18	50	<del>52</del>			LATERAL	H-7	H-4	48	133	<del>134</del>		LATERAL	I-34	A-18	66	197			
	E-39	E-41	18	54	<del>52</del>			LATERAL	H-4	H-5	48	496	<del>500</del>	DELETED	LATERAL	A-18	I-33	66	3	$\Delta$		
	E-41	E-43	18	495	<del>52</del>			LATERAL	A-2	H-10	27	0	<del>3</del>		LATERAL	I-6	I-33	18	21	<del>22</del>	$\Delta$	
	E-43	E-45	18	48	<del>47</del>			LATERAL	H-2	H-5	21	9			LATERAL	I-33	A-19	66	103	$\Delta$		
	E-45	E-47	18	49	<del>47</del>	$\Delta$		LATERAL	H-5	H-6	48	72			LATERAL	A-19	I-32	72	3	$\Delta$		
	E-47	E-49	18	47		$\Delta$		LATERAL	H-4	H-11	21	0	<del>9</del>	DELETED	LATERAL	I-7	I-32	18	21	<del>22</del>	$\Delta$	
	E-49	E-51	18	49	<del>47</del>	$\Delta$		LATERAL	H-11	A-4	27	0	<del>195</del>		LATERAL	I-32	I-55	72	153	<del>155</del>	$\Delta$	
	E-51	E-53	18	45.5	<del>47</del>	$\Delta$		LATERAL	A-4	H-12	36	0	<del>3</del>		LATERAL	I-55	I-50	6x10	10			
	E-53	E-64	18	21	<del>18</del>	$\Delta$		LATERAL	H-5	H-12	21	0	<del>9</del>		LATERAL	I-75	I-50	54	51	<del>50</del>	$\Delta$	
LINE G	G-31	A-2	18	0	<del>13</del>	$\Delta$	DELETED	LATERAL	H-12	H-13	36	0	<del>198</del>		LATERAL	I-50	I-29	6x10	10			
LATERAL	A-2	F-2	21	0	<del>9</del>	DELETED		LATERAL	H-6	H-13	21	0	<del>9</del>	DELETED	LATERAL	I-8	I-29	18	26.5	<del>25</del>		
	F-2	F-3	21	62				$\Delta$ LINE K-1	H-13	H-14	42	0	<del>65</del>		LATERAL	I-29	I-28	6x10	177			
LINE G-2	G-43	A-5	18	0	<del>81</del>	DELETED		LATERAL	K-1	A-1	18	41	<del>49</del>	$\Delta$	LATERAL	I-9	I-28	18	29.5	<del>27</del>		
	A-5	G-42	27	0	<del>3</del>	DELETED		LATERAL	A-1	K-41	21	4.3	<del>3</del>		LATERAL	I-28	I-27	6x10	200			
LATERAL	G-24	G-42	24	0	<del>9</del>	DELETED		LATERAL	K-2	K-41	21	20	<del>22</del>	$\Delta$	LATERAL	I-27	I-27	18	25	<del>27</del>		
	G-42	G-44	27	47	<del>177</del>			LATERAL	K-41	A-40	21	26			LATERAL	I-27	I-26	6x10	93			
LATERAL	G-26	G-44	21	7	<del>9</del>			LATERAL	K-3	K-40	18	21	<del>22</del>	$\Delta$	LATERAL	I-26	I-25	6x10	110			
	G-44	A-1	27	68				LATERAL	K-40	A-90	21	52			LATERAL	I-25	I-24	6x10	80			
LATERAL	A-1	G-45	36	2	<del>3</del>			LATERAL	A-90	K-39	24	3			LATERAL	I-24	I-23	6x10	20			
	G-51	G-45	36	17				LATERAL	K-39	A-91	24	45.3	<del>54</del>	$\Delta$	LATERAL	I-23	I-21	6x10	21	22.5	<del>26</del>	
	G-45	G-60	36	98				LATERAL	A-91	K-38	27	6.1	<del>3</del>	$\Delta$	LATERAL	I-21	I-20	6x10	120			
	G-60	A-2	36	402.8	<del>28</del>	FIELD CHANGE		LATERAL	K-5	K-38	18	21	<del>22</del>	$\Delta$	LATERAL	I-20	I-19	6x10	149			
LATERAL	A-2	G-46	42	0	<del>3</del>			LATERAL	K-38	K-37	27	27			LATERAL	I-19	I-19	18	13	<del>12</del>		
	G-35	G-46	18	8	<del>9</del>			LATERAL	K-6	K-37	18	21	<del>22</del>	$\Delta$	LATERAL	I-18	I-18	6x10	154			
	G-46	A-3	42	38	<del>17</del>			LATERAL	K-7	A-8	27	130			LATERAL	I-17	I-17	6x10	22.5	<del>26</del>		
LATERAL	A-3	G-61	48	5	<del>3</del>			LATERAL	A-8	K-36	33	3			LATERAL	I-16	I-16	6x10	20			
	G-37	G-61	30	19	<del>40</del>			LATERAL	K-7	K-36	21	18	<del>22</del>	$\Delta$	LATERAL	I-15	I-23	6x10	21	22.5	<del>26</del>	
	G-61	G-52	48	24				LATERAL	K-36	K-35	33	20			LATERAL	I-14	I-21	6x10	21	27.5	<del>32</del>	
	G-39	A-4	27	335	<del>17</del>	FIELD CHANGE		LATERAL	K-35	K-34	33	71			LATERAL	I-21	I-20	6x10	46	<del>48</del>		
	A-4	G-62	36	0	<del>3</del>			LATERAL	K-34	K-34	18	21	<del>22</del>	$\Delta$	LATERAL	I-20	I-19	6x10	149			
LATERAL	G-38	G-62	27	28.5	<del>14</del>	FIELD CHANGE		LATERAL	K-34	K-33	33	84			LATERAL	I-19	I-19	18	13	<del>12</del>		
	G-62	G-52	36	0	<del>72</del>			LATERAL	K-10	K-33	18	19	<del>22</del>	$\Delta$	LATERAL	I-18	I-18	6x10	154			
LATERAL	B-53	B-45	15	8				LATERAL	K-11	K-32	33	99			LATERAL	I-17	I-17	6x10	20			
LATERAL	B-45	X-15	15	6				LATERAL	K-11	K-32	15	19	<del>44</del>	$\Delta$	LATERAL	I-16	I-16	6x10	20			
LATERAL	B-47	X-2	15	38.5	<del>47</del>			LATERAL	K-32	K-31	33	49			LATERAL	I-15	I-15	6x10	149			
LATERAL	B-46	B-84	15	26				LATERAL	K-32	K-31	18	0	<del>22</del>	DELETED	LATERAL	I-14	I-14	6x10	154			
LATERAL	M-1	M-2	18	15	<del>35</del>			LATERAL	K-31	K-30	33	53			LATERAL	I-13	I-13	6x10	154			
LINE G-3	G-1	A-1	18	186	<del>176</del>			LATERAL	K-31	K-30	18	0	<del>22</del>	DELETED	LATERAL	I-12	I-12	6x10	0	<del>44</del>	DELETED	
	A-1	G-32	21	3				LATERAL	K-13	K-30	18	0	<del>22</del>	DELETED	LATERAL	I-11	I-11	6x10	0	<del>27</del>	DELETED	
LATERAL	G-2	G-32	21	26.5	<del>28</del>			LATERAL	K-30	A-6	33	70	<del>72</del>	$\Delta$	LATERAL	I-10	I-10	6x10	0	<del>27</del>	DELETED	
	G-32	A-2	21	95				LATERAL	A-6	K-29	42	14	<del>3</del>		LATERAL	I-9	I-9	6x10	68			
LATERAL	G-6	G-33	18	20	<del>3</del>			LATERAL	K-15	A-25	21	39	<del>35</del>		LATERAL	I-8	I-8	6x10	0	<del>44</del>	DELETED	
	G-33	B-67	36	32	<del>34</del>			LATERAL	A-25	K-29	21	0	<del>30</del>	DELETED	LATERAL	I-7	I-7	6x10	0	<del>44</del>	DELETED	
	B-67	G-34	36	21	<del>23</del>			LATERAL	K-29	K-27	42	49			LATERAL	I-6	I-6	6x10	0	<del>44</del>	DELETED	
LATERAL	G-8	G-11	21	0	<del>45</del>	FIELD CHANGE		LATERAL	K-16	A-20	24	24			LATERAL	I-5	I-5	6x10	0	<del>44</del>	DELETED	
	G-11	G-3																				



# STORM SEWER SUMMARY


STORM SEWER OR LATERAL IDENTIFICATION	FROM	TO	SIZE (IN.)	LENGTH (FT.)	TYPE	REMARKS
LINE L	L-1	A-1	18	73 <del>70</del>		Rev. $\Delta$
	A-1	L-24	21	3		
LATERAL	L-2	L-24	21	19 <del>22</del>		
	L-24	A-2	21	222.6 <del>234</del>		
	A-2	L-28	30	21 <del>3</del>		
LATERAL	L-7	L-28	15	0 <del>54</del>		DELETED
	L-28	L-29	30	45		Rev. $\Delta$
LATERAL	L-8	L-29	15	0 <del>27</del>		DELETED
	L-29	L-30	30	55 <del>52</del>		
LATERAL	L-10	L-30	18	37 <del>65</del>		
	L-30	L-41	30	37 <del>45</del>		
LATERAL	L-11	L-41	18	0 <del>56</del>	$\Delta$	DELETED
	L-41	L-31	30	15 <del>10</del>		
LATERAL	L-12	L-31	18	0 <del>24</del>		DELETED
	L-31	L-32	30	109		
LATERAL	L-13	L-32	18	0 <del>27</del>		DELETED
	L-32	L-33	30	165		
LATERAL	L-14	L-33	18	0 <del>27</del>		DELETED
	L-33	L-51	30	361 <del>34</del>		
	L-51	A-5	30	269	$\Delta$	
LATERAL	L-15	L-34	18	0 <del>27</del>	$\Delta$	DELETED
	L-34	A-5	30	0 <del>107</del>	$\Delta$	DELETED
	A-5	A-6	33	74.4 <del>77</del>	$\Delta$	
LATERAL	L-16	L-35	18	0 <del>27</del>	$\Delta$	DELETED
	L-35	A-6	33	0 <del>74</del>	$\Delta$	DELETED
	A-6	L-36	36	3		
	L-36	L-50	36	47	$\Delta$	
	L-50	A-7	36	111	$\Delta$	
LATERAL	L-18	L-37	18	0 <del>27</del>	$\Delta$	DELETED
	L-37	A-7	36	0 <del>49</del>	$\Delta$	DELETED
	A-7	L-37	48	75.7 <del>74</del>	$\Delta$	
LATERAL	L-20	L-42	27	0 <del>12</del>	$\Delta$	DELETED
LATERAL	L-17	L-42	27	0 <del>6</del>	$\Delta$	"
LATERAL	L-42	L-40	33	0 <del>24</del>	$\Delta$	DELETED
	L-37	L-38	48	75	$\Delta$	
LATERAL	L-19	L-38	18	29 <del>27</del>	$\Delta$	
	L-38	L-39	48	138	$\Delta$	
	E-57	L-39	48	0 <del>34</del>	$\Delta$	DELETED
LINE M	M-1	L-40	72	97.44		
LATERAL	L-20	L-40	18	34 <del>16</del>		
	L-40	L-39	72	40 <del>45</del>		
	L-39	L-41	72	5		
LATERAL	L-21	L-41	21	30	$\Delta$	
	L-41	E-64	72	7	$\Delta$	
LATERAL	M-8	L-22	21	46	$\Delta$	
LATERAL	L-22	L-42	21	67	$\Delta$	
LATERAL	E-64	M-11	72	38	$\Delta$	
LATERAL	E-55	M-11	15	6	$\Delta$	
	M-11	L-44	72	91	$\Delta$	
	F-3	A-1	30	57.9 <del>67</del>	$\Delta$	
	A-1	L-43	36	13	$\Delta$	
LATERAL	L-23	L-43	36	1	$\Delta$	
	L-43	L-42	36	27 <del>33</del>	$\Delta$	
	L-42	P-135	36	9	$\Delta$	
P-134	T-32	T-33	15	43 <del>47</del>	$\Delta$	
P-135	T-33	Line F-3	15	14	$\Delta$	
	P-135	P-137	36	8	$\Delta$	
P-136	T-35	T-34	15	42 <del>47</del>	$\Delta$	
P-137	T-34	Line F-3	15	42 <del>49</del>	$\Delta$	
	P-137	L-44	36	49 <del>55</del>	$\Delta$	
	L-44	P-111	72	20	$\Delta$	
P-111	T-10	Line "M"	15	0 <del>61</del>	$\Delta$	
	P-111	F-5	72	19	$\Delta$	
	S-9	S-10	18	22.5 <del>18</del>	$\Delta$	
	F-1	F-2	36	111.8 <del>104</del>	$\Delta$	
LINE P	A-12	P-7	42	3		
	P-7	P-8	42	231		
LATERAL	P-2	P-8	21	33 <del>35</del>		
	P-8	P-20	42	370		
	P-20	A-2	42	109		
LATERAL	A-2	P-9	48	3		
	P-9	A-3	48	252		
	A-3	P-11	48	3		
LATERAL	P-4	P-11	15	12 <del>9</del>		
	P-11	P-21	48	229		
	P-21	P-10	48	96		
LATERAL	P-6	P-10	21	43 <del>41</del>		
	P-10	A-4	48	18		
LATERAL	A-4	P-12	60	3		
	P-5	P-12	21	10 <del>9</del>		
LATERAL	P-12	O-2	60	814		
LATERAL	O-1	O-2	21	10 <del>9</del>		
	O-2	O-5	60	7		
LATERAL	O-4	O-5	21	35 <del>37</del>		
	O-5	O-3	60	59 <del>60</del>		

STORM SEWER OR LATERAL IDENTIFICATION	FROM	TO	SIZE (IN.)	LENGTH (FT.)	TYPE	REMARKS
LINE S	S-1	S-11	18	2045 <del>206</del>		Rev. $\Delta$
LATERAL	S-2	S-11	18	34 <del>36</del>		
	S-11	S-12	18	168		
LATERAL	S-3	S-12	18	345 <del>36</del>		
	S-12	S-13	18	218		
LATERAL	S-4	S-13	18	36		
	S-13	A-4	21	225		
LATERAL	A-4	S-14	24	3		
LATERAL	S-5	S-14	18	37		
	S-14	S-21	24	143 <del>163</del>		
	S-21	S-15	24	113		
LATERAL	S-6	S-15	18	35 <del>37</del>		
	S-15	S-16	24	265		
LATERAL	S-7	S-16	18	475 <del>49</del>		
	S-16	S-20	24	18		
	A-7	A-7	24	98 <del>159</del>	$\Delta$	
	A-7	S-18	30	79 <del>3</del>	$\Delta$	
	S-17	S-18	30	0 <del>73</del>	$\Delta$	DELETED
LATERAL	S-8	S-18	18	37		
	S-18	S-32	30	140		
LATERAL	S-30	S-32	18	38 <del>37</del>		
	S-32	S-33	30	71		
LATERAL	S-32	S-33	18	25 <del>35</del>		
	S-33	S-19	30	25		
CUL 2	C-30B	C-31	18	65 <del>55</del>	$\Delta$	
LINE O-II	O-IIB	O-IIC	18	13 <del>10</del>		
LATERAL	O-IIC	A-1	18	80.8 <del>99</del>		
	A-1	O-IID	21	114 <del>3</del>		
LATERAL	O-IIA	O-IID	18	16 <del>10</del>		
	O-IID	A-2	21	497		
	A-2	O-12	27	8 <del>3</del>		
LATERAL	O-9	O-12	21	41 <del>10</del>		
	O-12	O-8	27	6		
UPSTREAM LINE L-1	L-15	L-16	18	105 <del>106</del>		
	L-16	L-18	18	180		
	L-18	A-1	18	0 <del>61</del>		
LATERAL	A-1	L-34	36	0 <del>3</del>		
	L-20	L-34	24	0 <del>21</del>		
LATERAL	L-34	L-35	36	0 <del>4</del>		
	L-17	L-35	24	0 <del>79</del>		
	L-35	L-37	36	0 <del>87</del>		
P-100	T-9	T-8	18	86.5 <del>4</del>		
P-101	T-8	P-103	21	255 <del>67</del>		
P-103	T-7	P-101	15	22.8 <del>24</del>		
P-101	P-103	P-106	21	23		
P-104	T-6	T-5	15	97		
P-105	T-5	T-4	15	72		
P-106	T-4	P-101	15	31		
P-101	P-106	T-3	24	37.3 <del>42</del>		
P-102	T-3	P-107	30	59.2 <del>61</del>		
P-107	T-2	P-102	15	12		
P-102	P-107	LINE "M"	30	178.3 <del>187</del>		
P-111	T-10	LINE "M"	15	60.3 <del>61</del>		
P-112	T-31	18" RCP*	18	61 <del>21</del>		
P-124	T-11	T-12	15	74 <del>77</del>		
P-125	T-12	T-13	15	33 <del>37</del>		
P-126	T-13	T-14	15	8 <del>12</del>		
P-127	T-14	T-31	15	109 <del>110</del>	$\Delta$	
P-128	T-15	T-16	15	52 <del>53</del>	$\Delta$	
P-129	T-16	T-17	15	78 <del>80</del>	$\Delta$	
P-130	T-17	T-18	15	71 <del>72</del>	$\Delta$	
P-131	T-18	18" RCP*	18	44 <del>40</del>	$\Delta$	
P-132	T-19	18" RCP*	15	85	$\Delta$	

STORM SEWER OR LATERAL IDENTIFICATION	FROM	TO	SIZE (IN.)	LENGTH (FT.)	TYPE	REMARKS
P-114	T-22	18" RCP*	18	9		
P-115	T-23	18" RCP*	18	7		
P-116	T-24	T-25	15	89.3	97	
P-117	T-25	T-26	15	53	62	
P-118	T-26	18" RCP*	15	102		
P-120	T-27	INLET*	18	24	31	
P-121	T-28	EX. 84" RCP	15	10	12	
P-122	T-29	18" RCP*	18	8	6	
P-123	T-30	18" RCP*	18	0	6	
LINE G-3	G-8	G-33A	18	11.5		
LATERAL	G-75	B-60B	36	27		
LATERAL	G-60B	B-56	36	147	A.B. CHANGE at AIRPORT PKWY.	
LATERAL	G-43	G-60A	18	21.5		
LATERAL	G-24	G-60A	24	56.5		
LATERAL	G-60A	B-62	27	79.5		
LINE K-1	K-12	K-13	18	52.5		
LATERAL	K-18	K-19	21	144		
LATERAL	K-19	K-20	21	132		
LINE K-2	I-0,1	I-38	24	19.5	FIELD CHANGE	
LATERAL	I-0,2	I-38	24	21.5	FIELD CHANGE	
LATERAL	I-60	I-61	21	12	OMITTED FROM SUMMARY	
LINE L	L-12	L-13	24	93		
LATERAL	L-13	L-14	24	160		
LATERAL	L-14	7X7JB	24	46		
LATERAL	7X7JB	L	24	45		
LINE S	S-32	S-33	18	37.5		
CULVERT 2	C-30C	C-30A	18	47.5		
CULVERT 2	C-30A	C-30B	18	46.4		
LINE O-II	O-IIE	O-IIA	15	72		
LINE L-1	L-18	L-20/L-17	27	47		
	L-20/L-17	7X7JB	24	133.5		
	7X7JB	L-37	24	30		
	T-9	T-8	15	24		
P-100	T-9	T-8	15	24		
P-173	A-173	A-174	15	44.2		
P-174	A-174	A-176	15	90.9		
P-175	A-175	A-176	15	43.8		
P-176	A-176	A-178	15	57.7		
P-177	A-177	A-178	15	43.9</		



CONTRACT NO. DNT-114 (BY OTHERS) CONTRACT NO. DNT-115 (BY OTHERS)

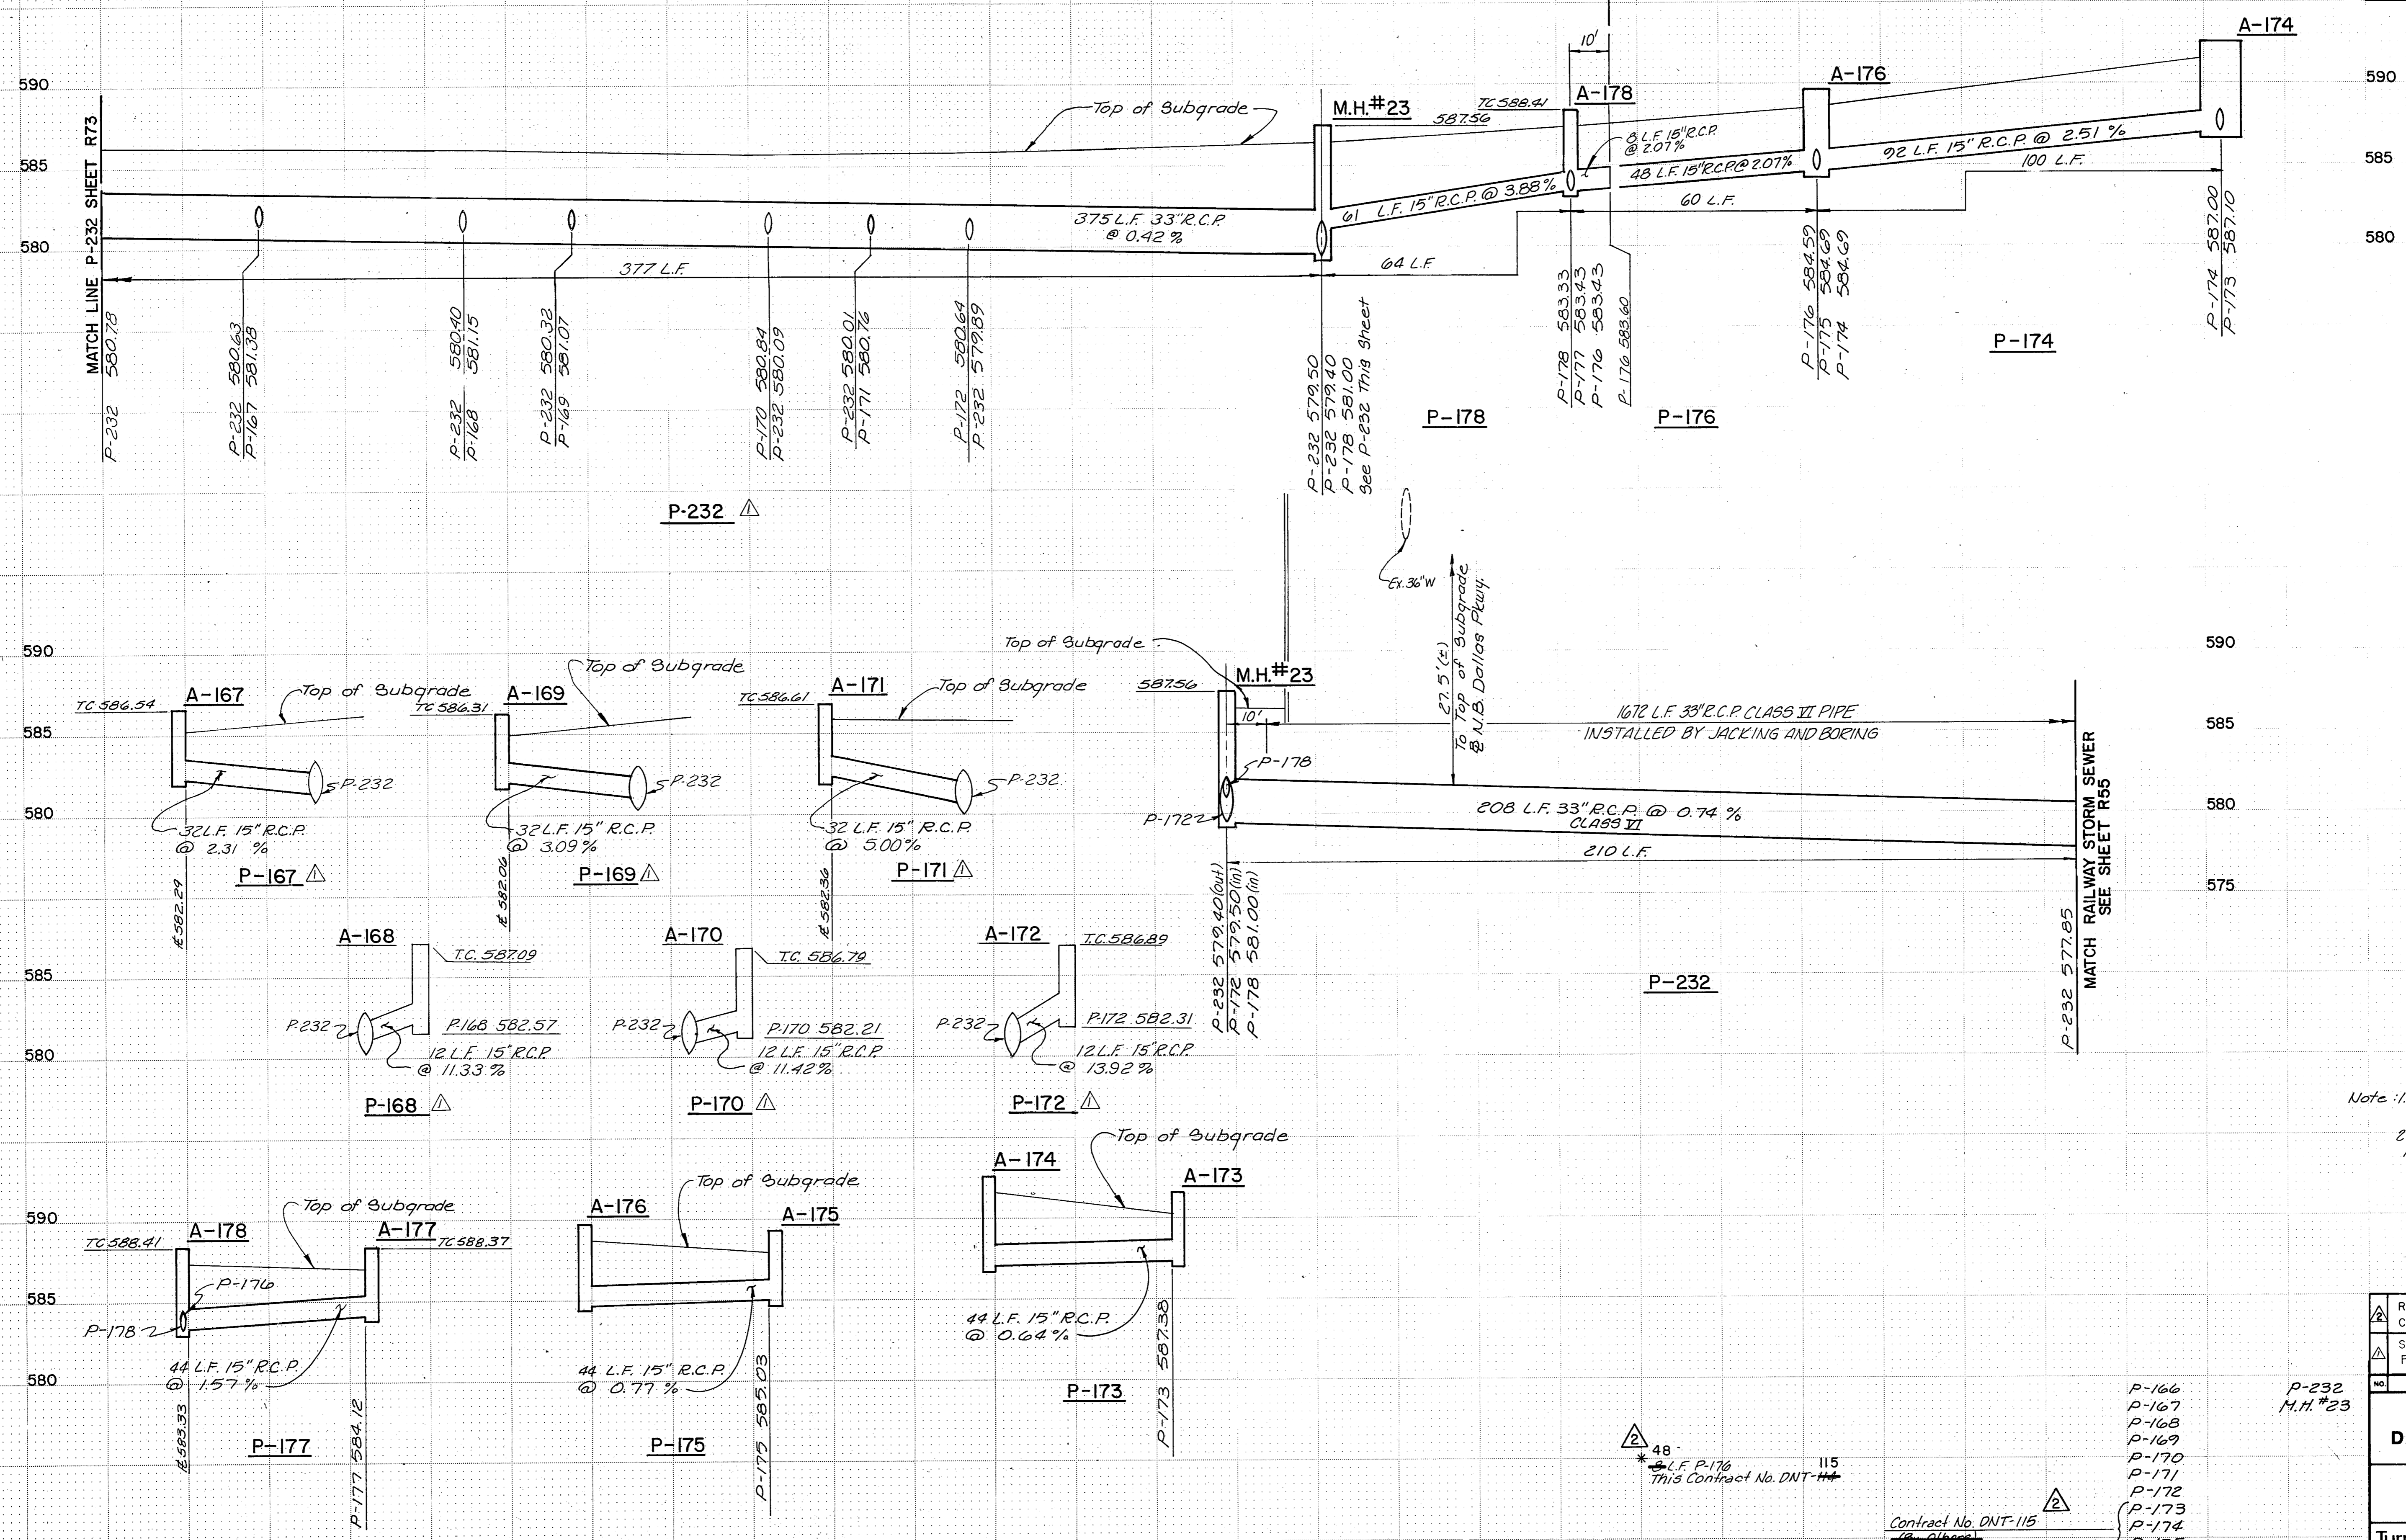

Note: ALL R.C.P. to be Class III unless noted, R15. See sheet R54 for horizontal location of pipes.

**ASBUILT PLANS**

REVISION	NO.	DATE	BY
REVISED SHEET FOR CONTRACT DNT-115	1		DWC/B-84
STORM SEWER AND LATERALS FROM M.H.#22 TO M.H.#23	2		GGG/5-84

TEXAS TURNPIKE AUTHORITY  
DALLAS NORTH TOLLWAY

**STORM SEWER PROFILE**















Turner Collie & Braden Inc.	SECTION VII
MADE D.W.G. DATE 7-83	TRACED A.L.A. DATE 7-83
CHECKED J.B.L. DATE 7-83	SCALE H <sub>1</sub> = 20' / V <sub>1</sub> = 5'
CONTRACT NO. DNT-115 SHEET R49 OF R85	

- P-166
  - P-167
  - P-168
  - P-169
  - P-170
  - P-171
  - P-172
  - P-173
  - P-174
  - P-175
  - P-176 \*
  - P-177
  - P-178
- P-232  
M.H.#23

48' \* 3 L.F. P-176 This Contract No. DNT-114

Contract No. DNT-115 (By Others)



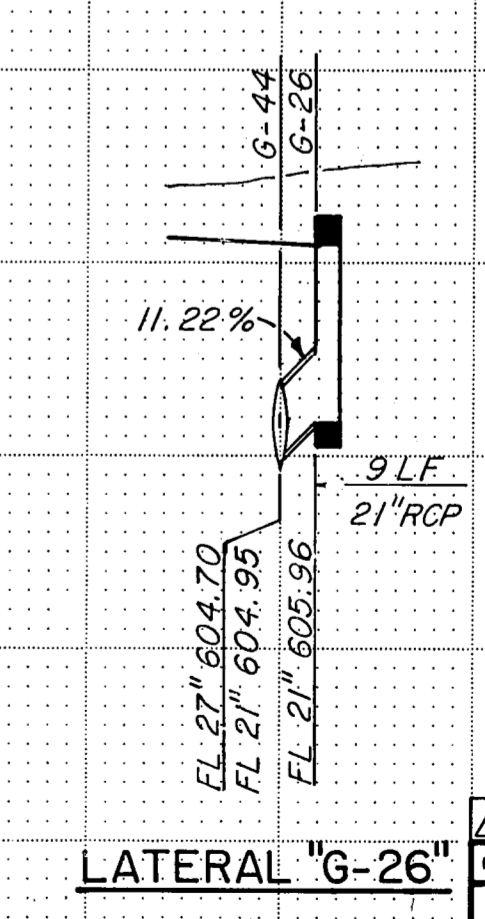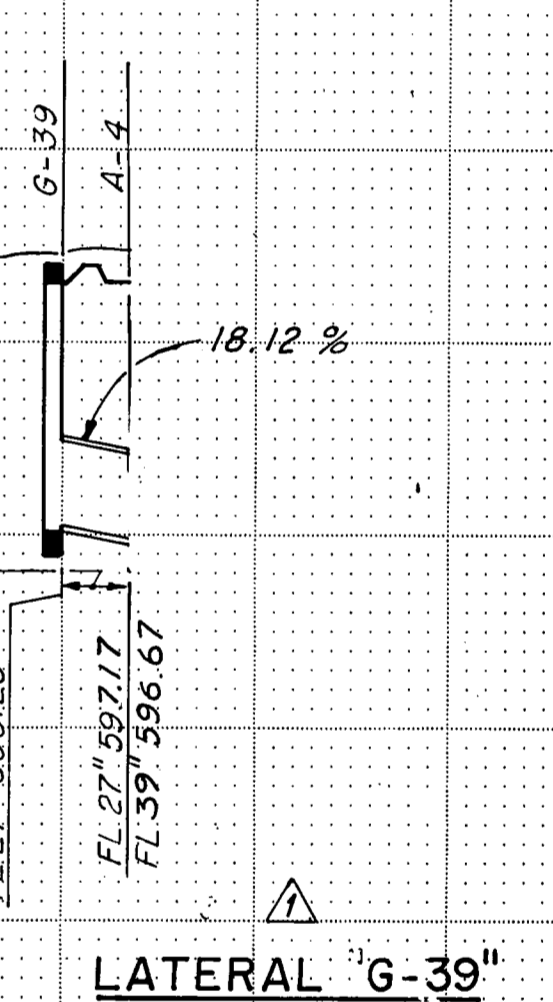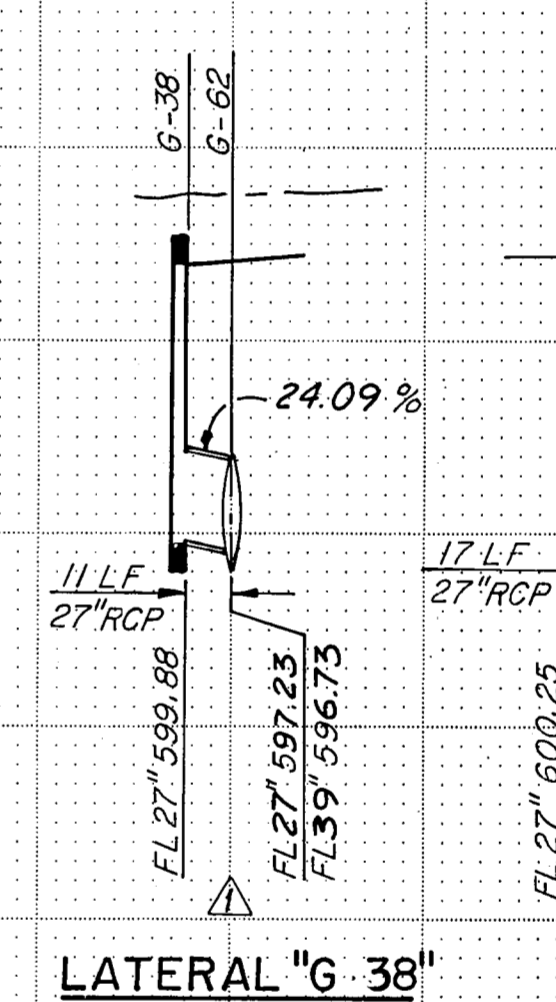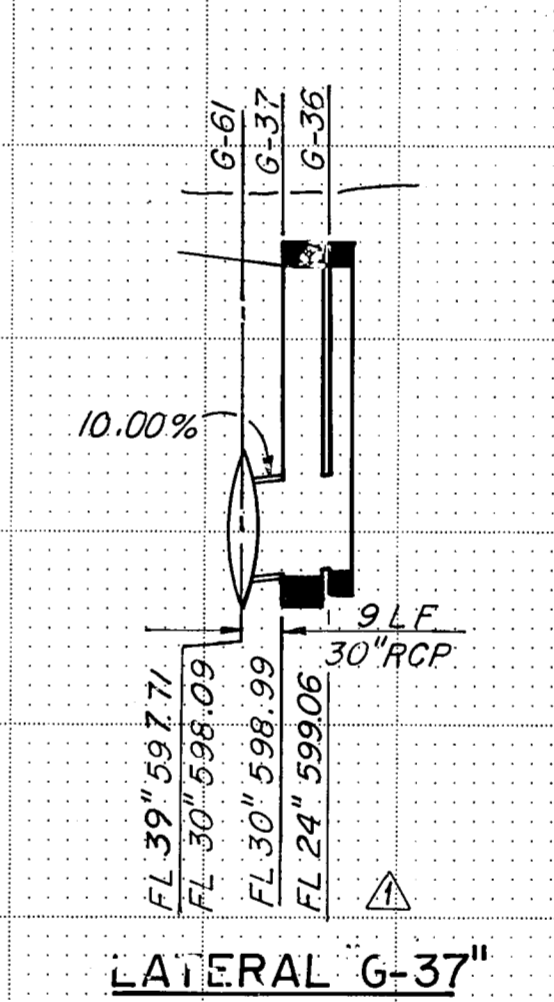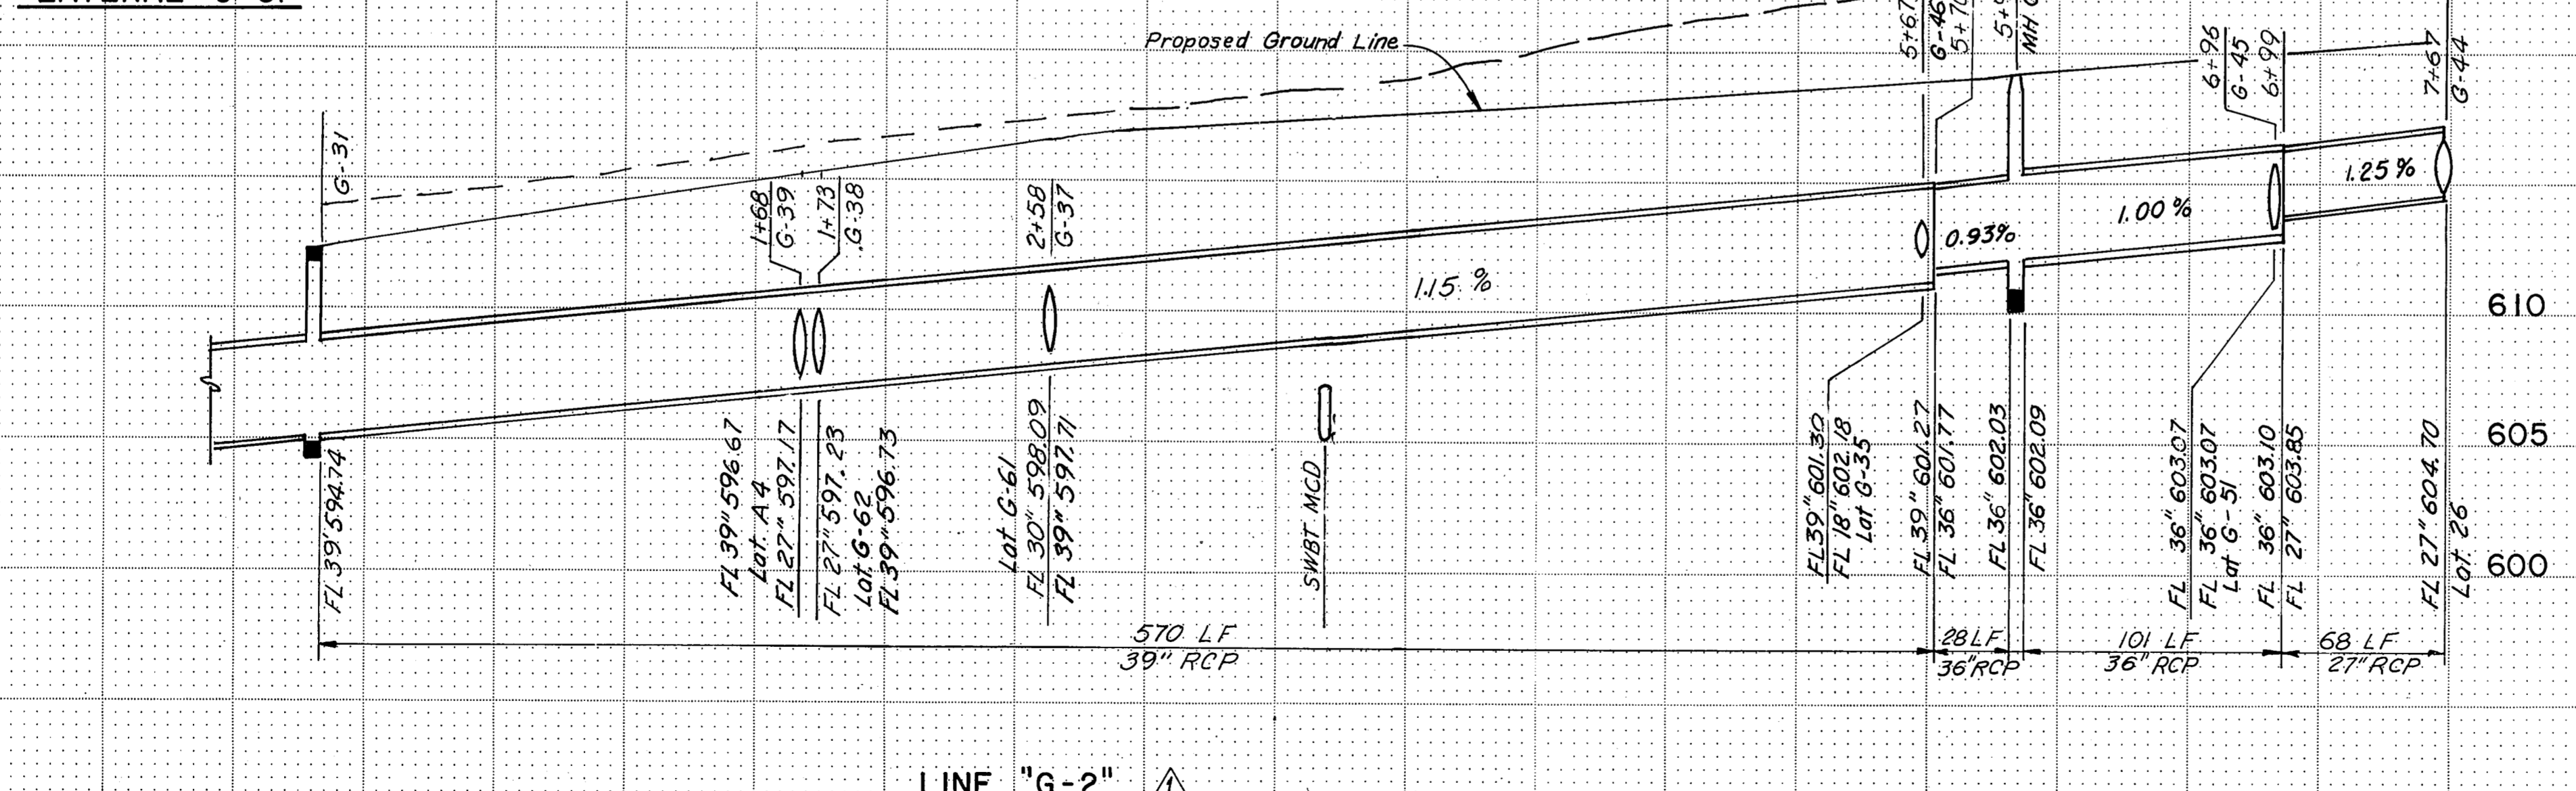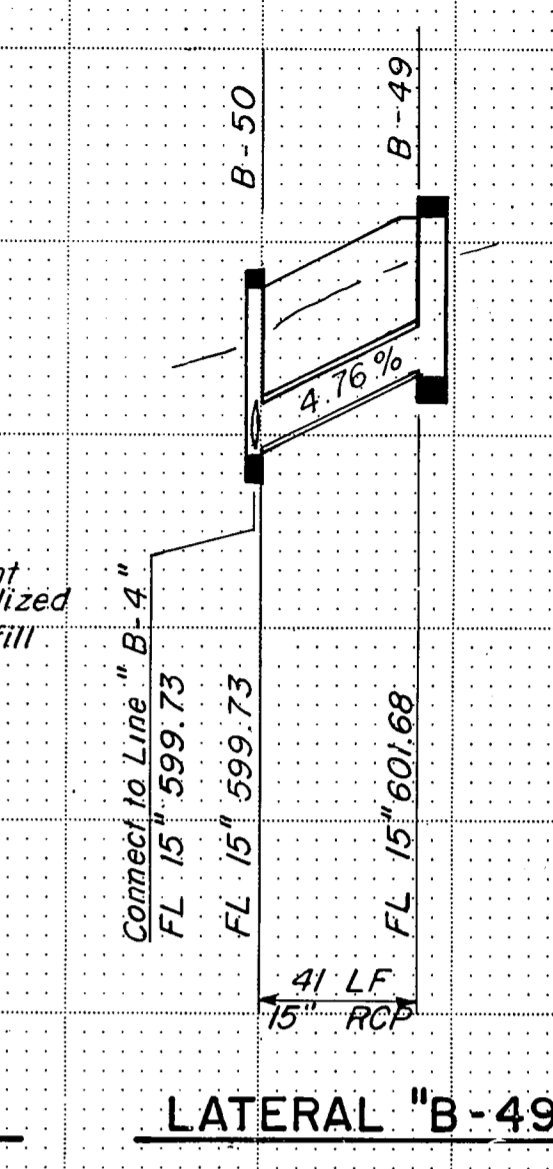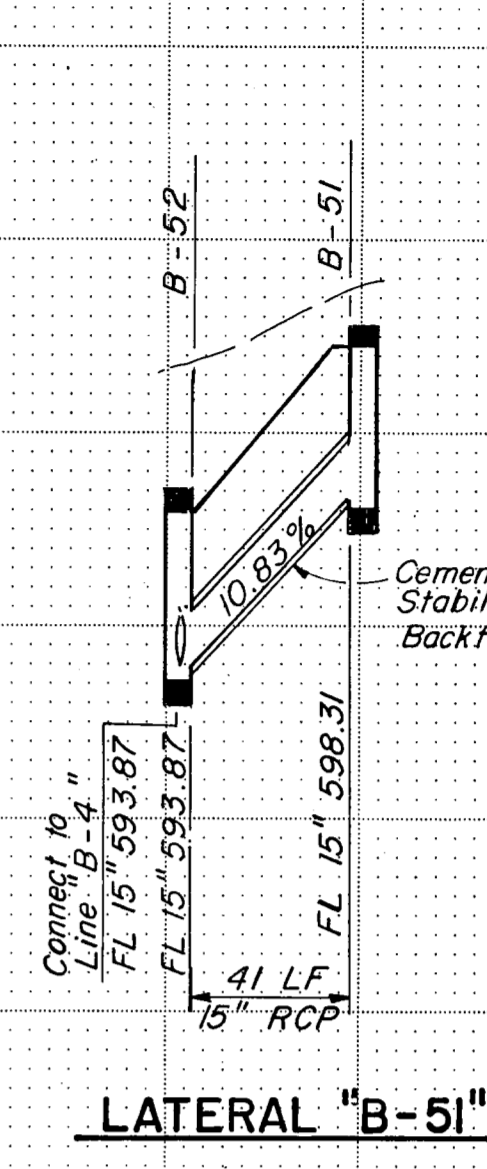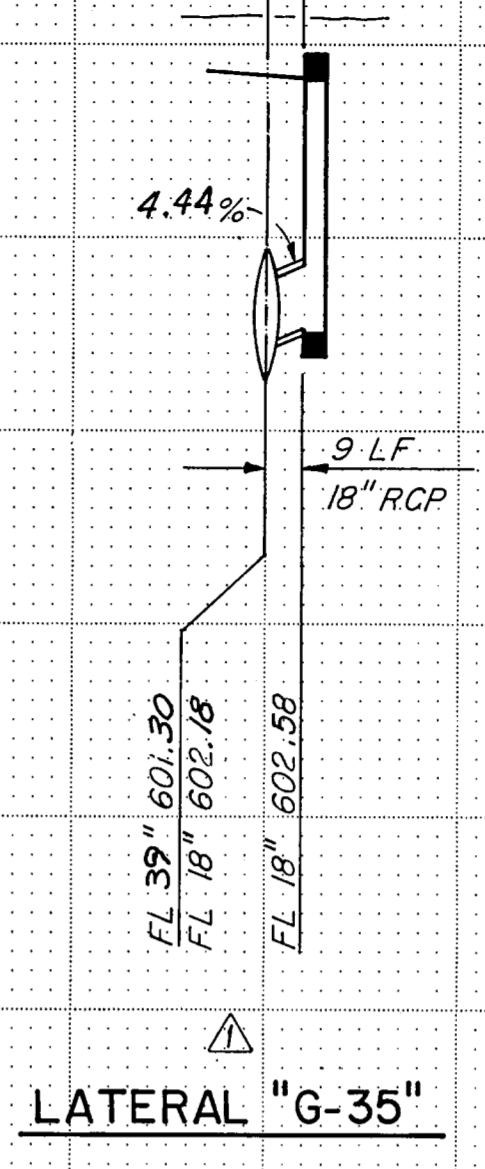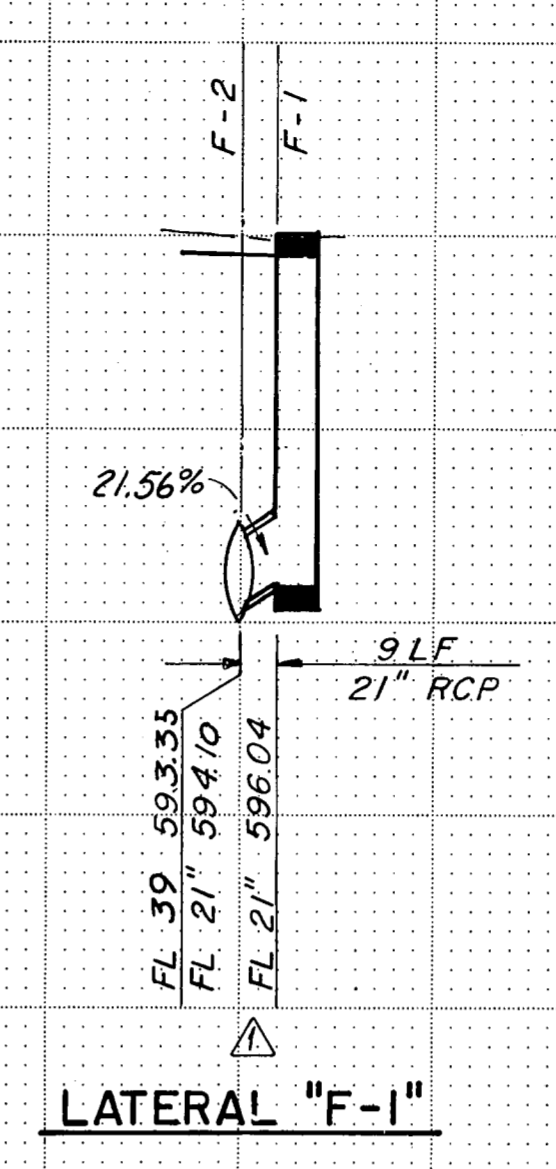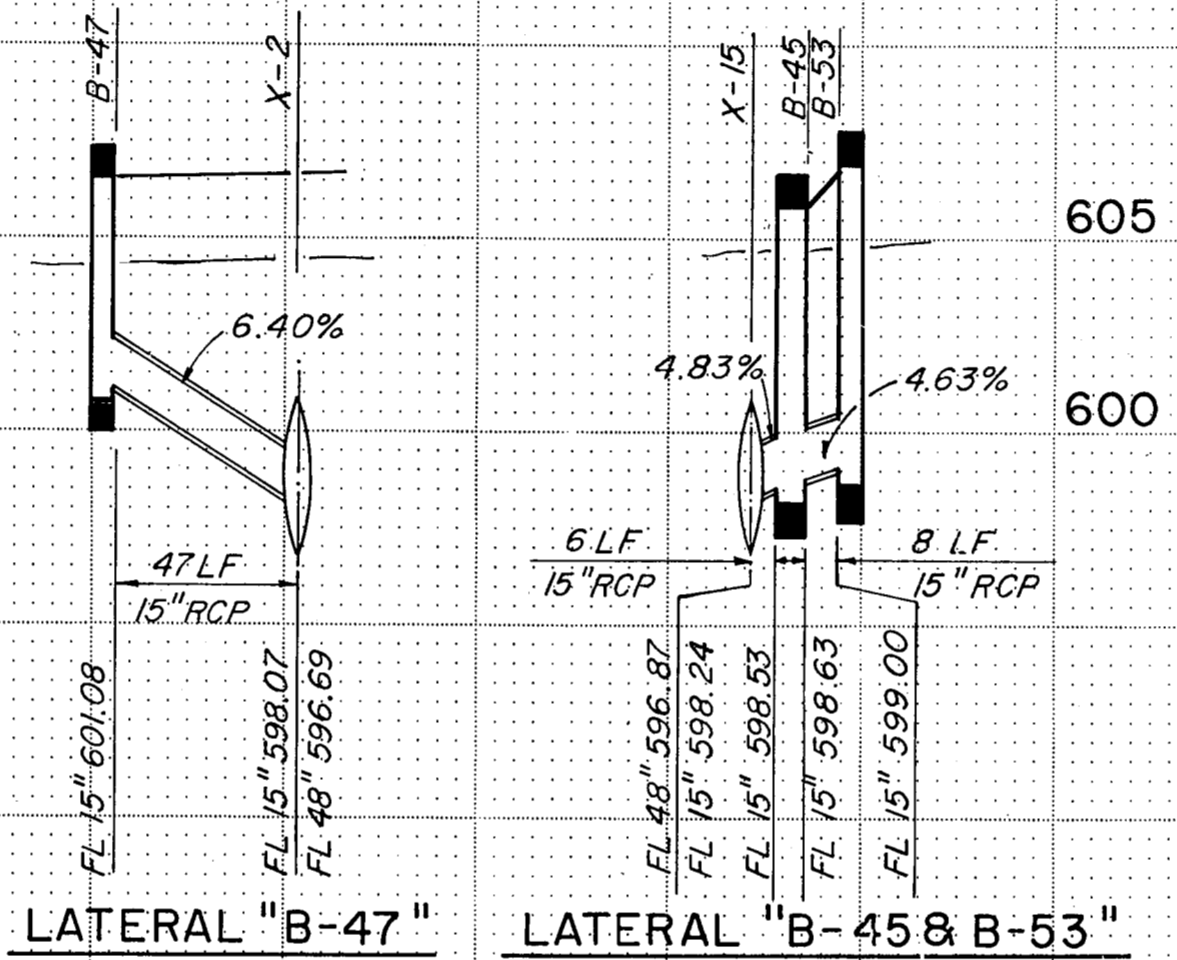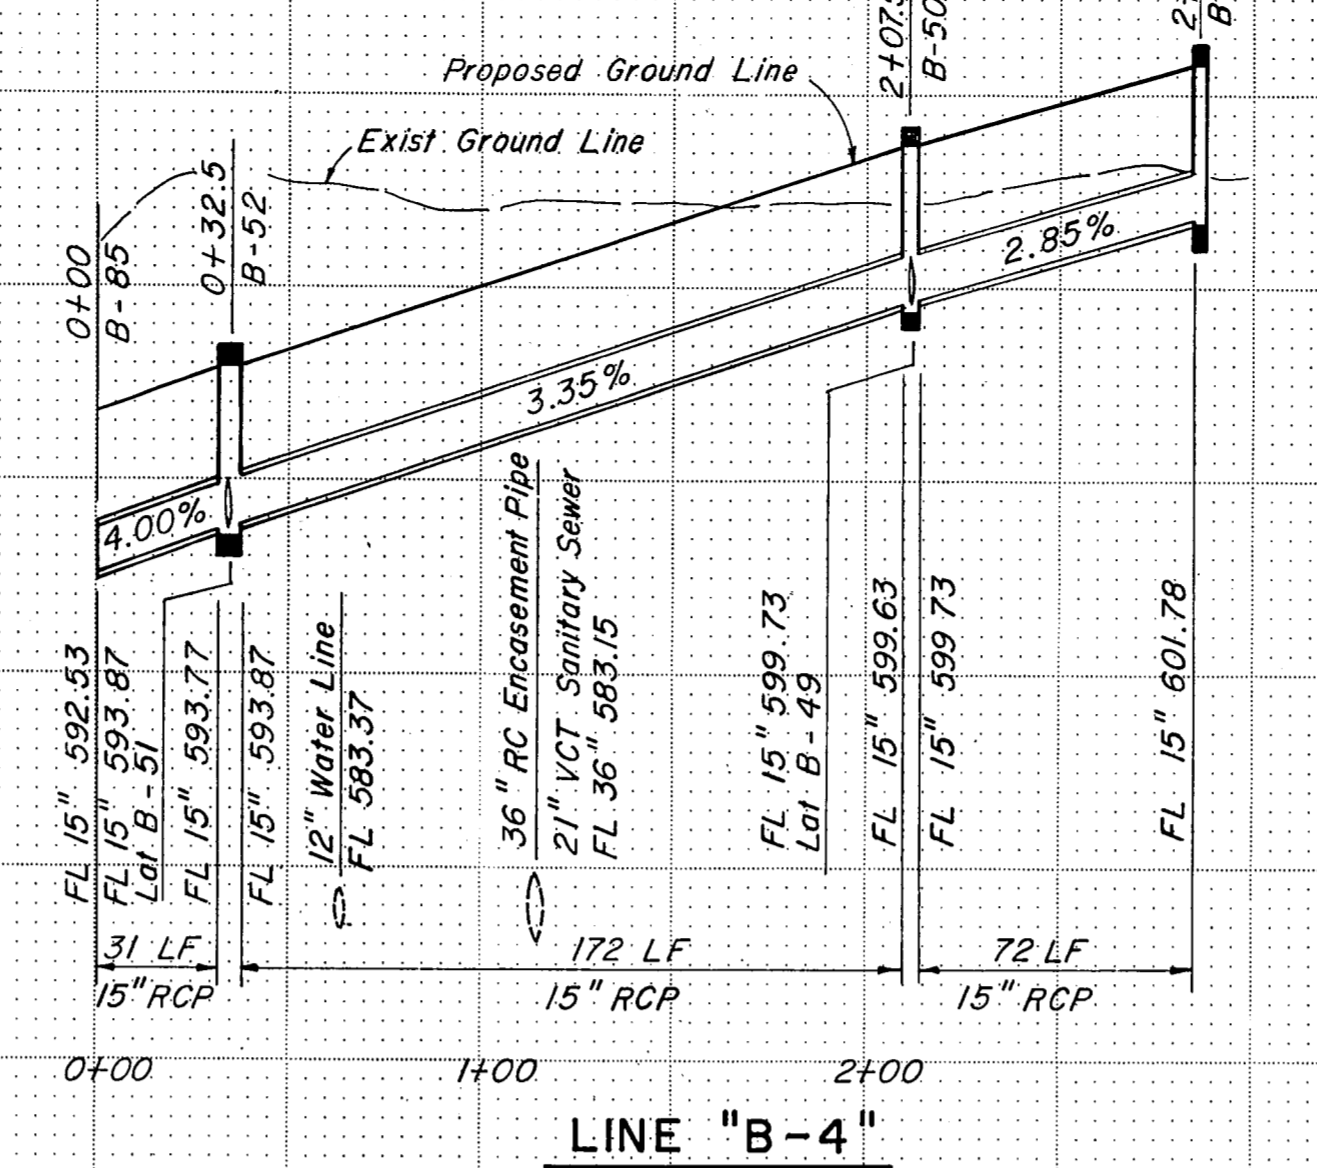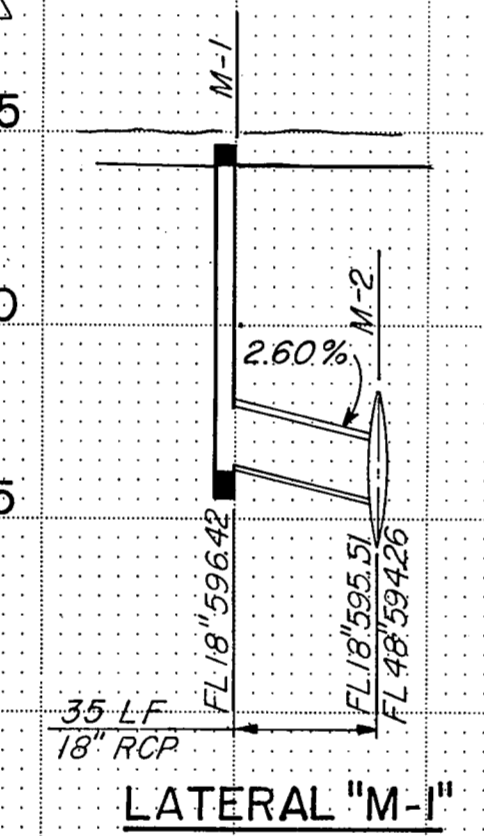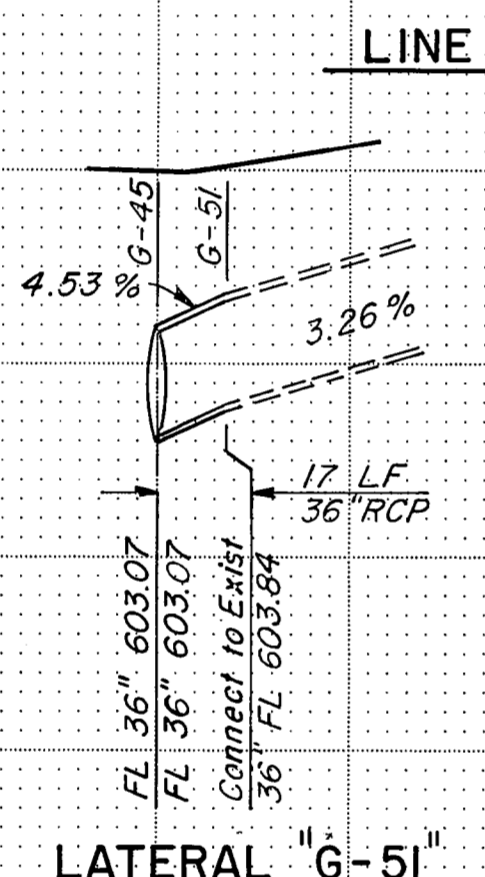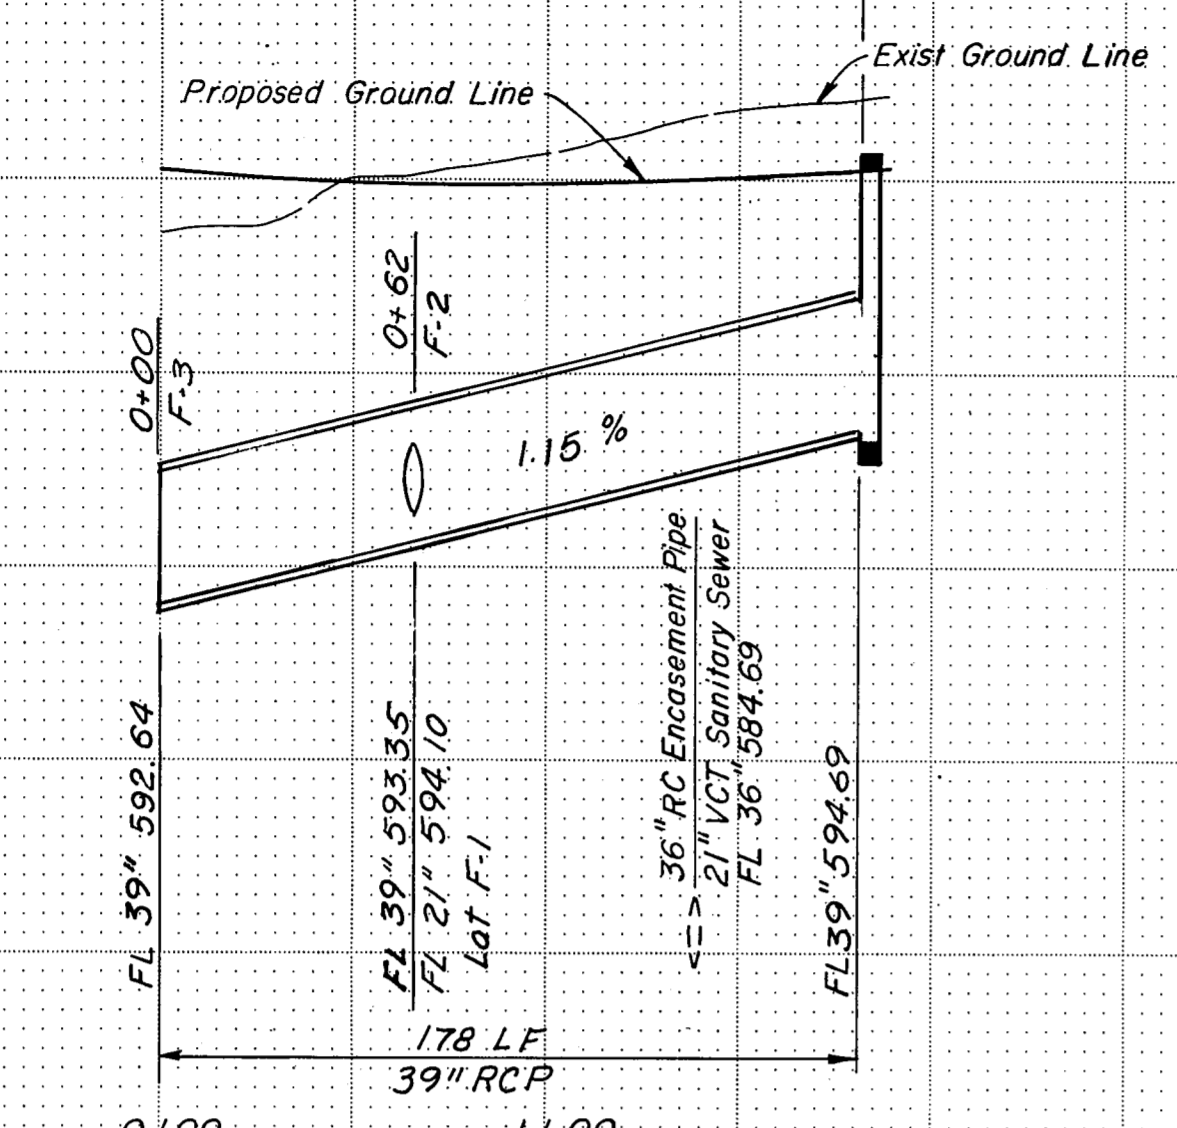


NOTES:  
1. Refer to Sheet R74 for depth of cement stabilized backfill.

STORM SEWER LINE: "G", "G-2", "B-4"  
LATERAL: "B-45 & B-53", "B-49", "B-51", "B-47", "F-1", "G-26", "G-35", "G-37", "G-38", "G-39", "G-51", "M-1"


**ASBUILT PLANS**

NO.	REVISION	BY	DATE
1	As Built	C.B.	
TEXAS TURNPIKE AUTHORITY DALLAS NORTH TOLLWAY			
STORM SEWER PROFILES			
<b>Gibbs &amp; Hill, Inc.</b>			
MADE A/E/L	DATE 1/84	TRACED A/E/L	DATE 1/84
CHECKED MGB	DATE 7/84	SCALE	1"=50'H 1"=5'V
CONTRACT NO. DNT-115 SHEET R50 OF R85			



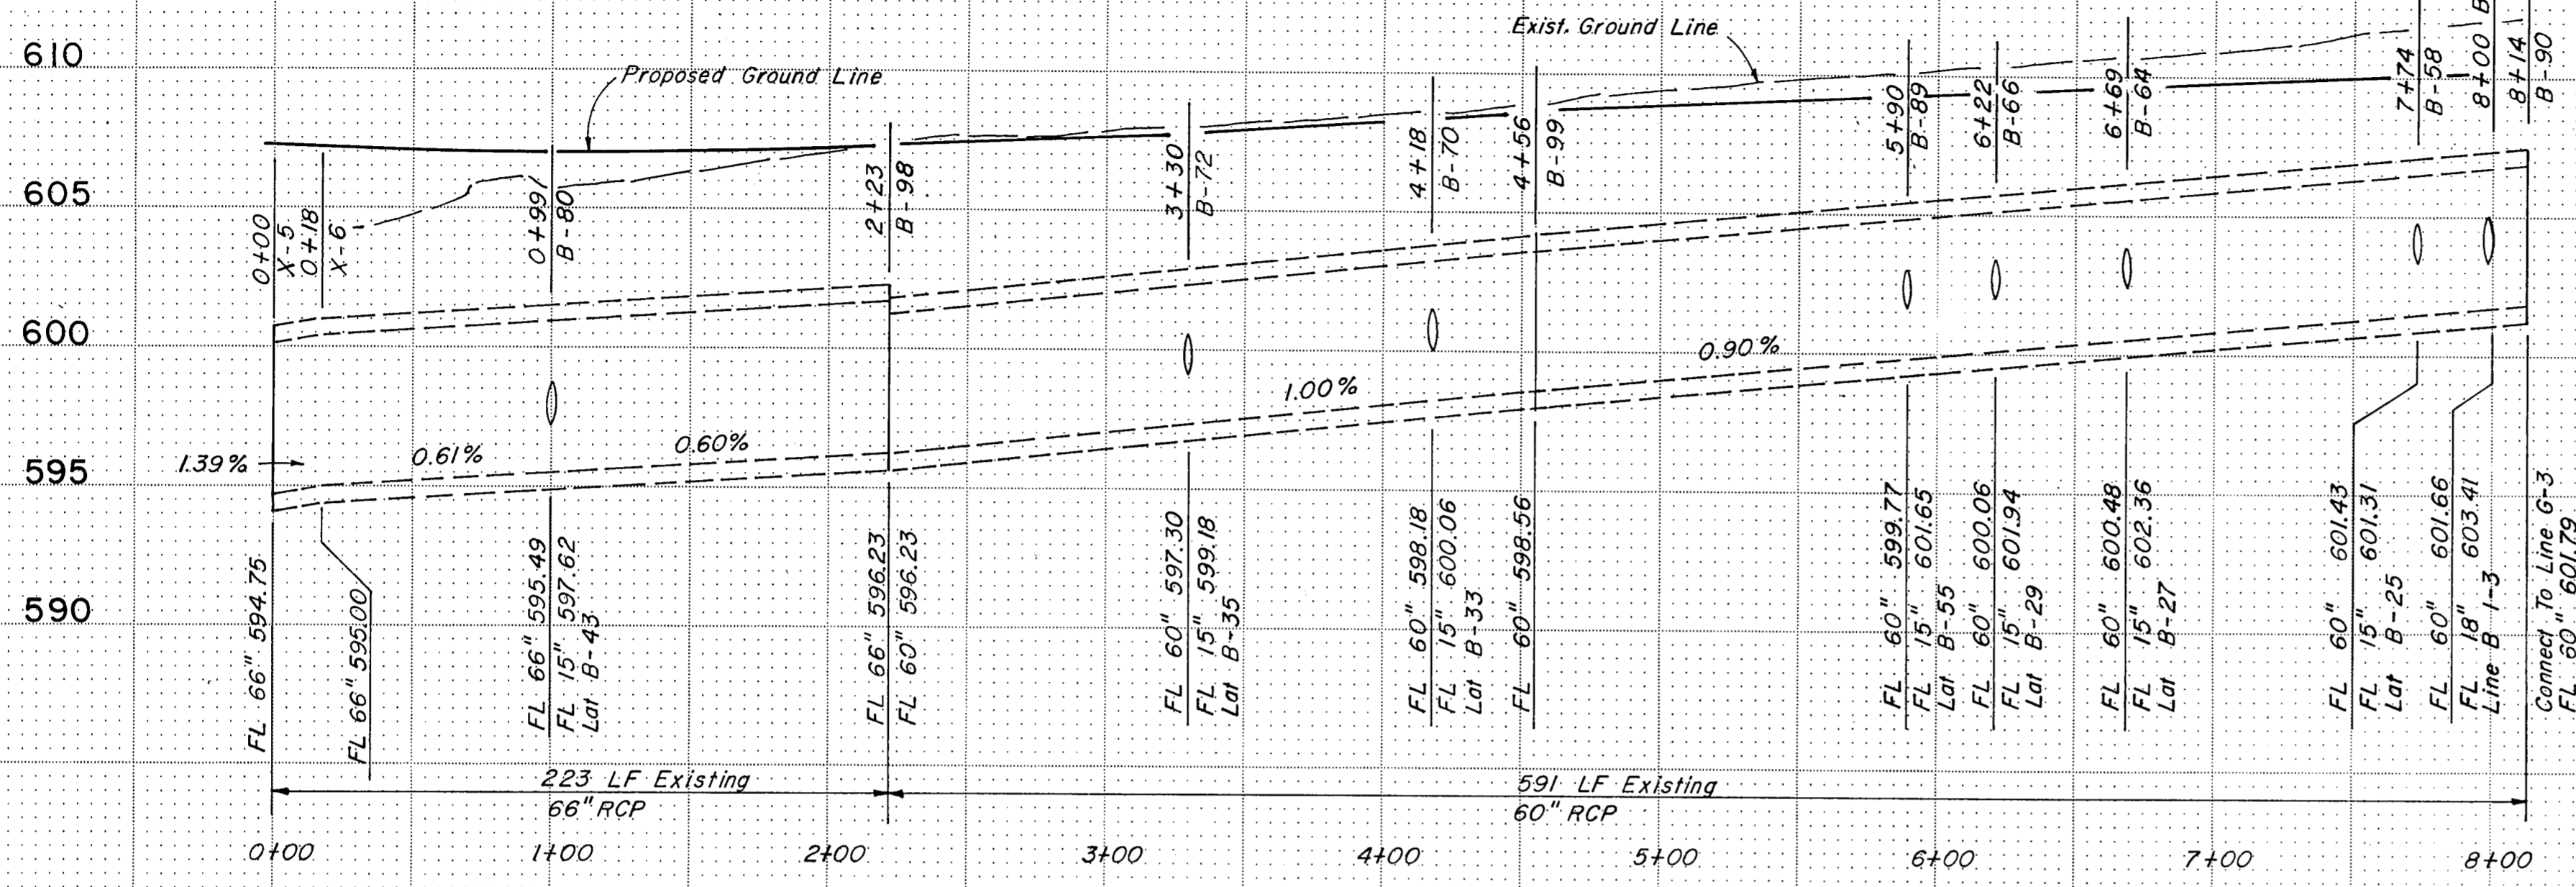

LINE "B-1"

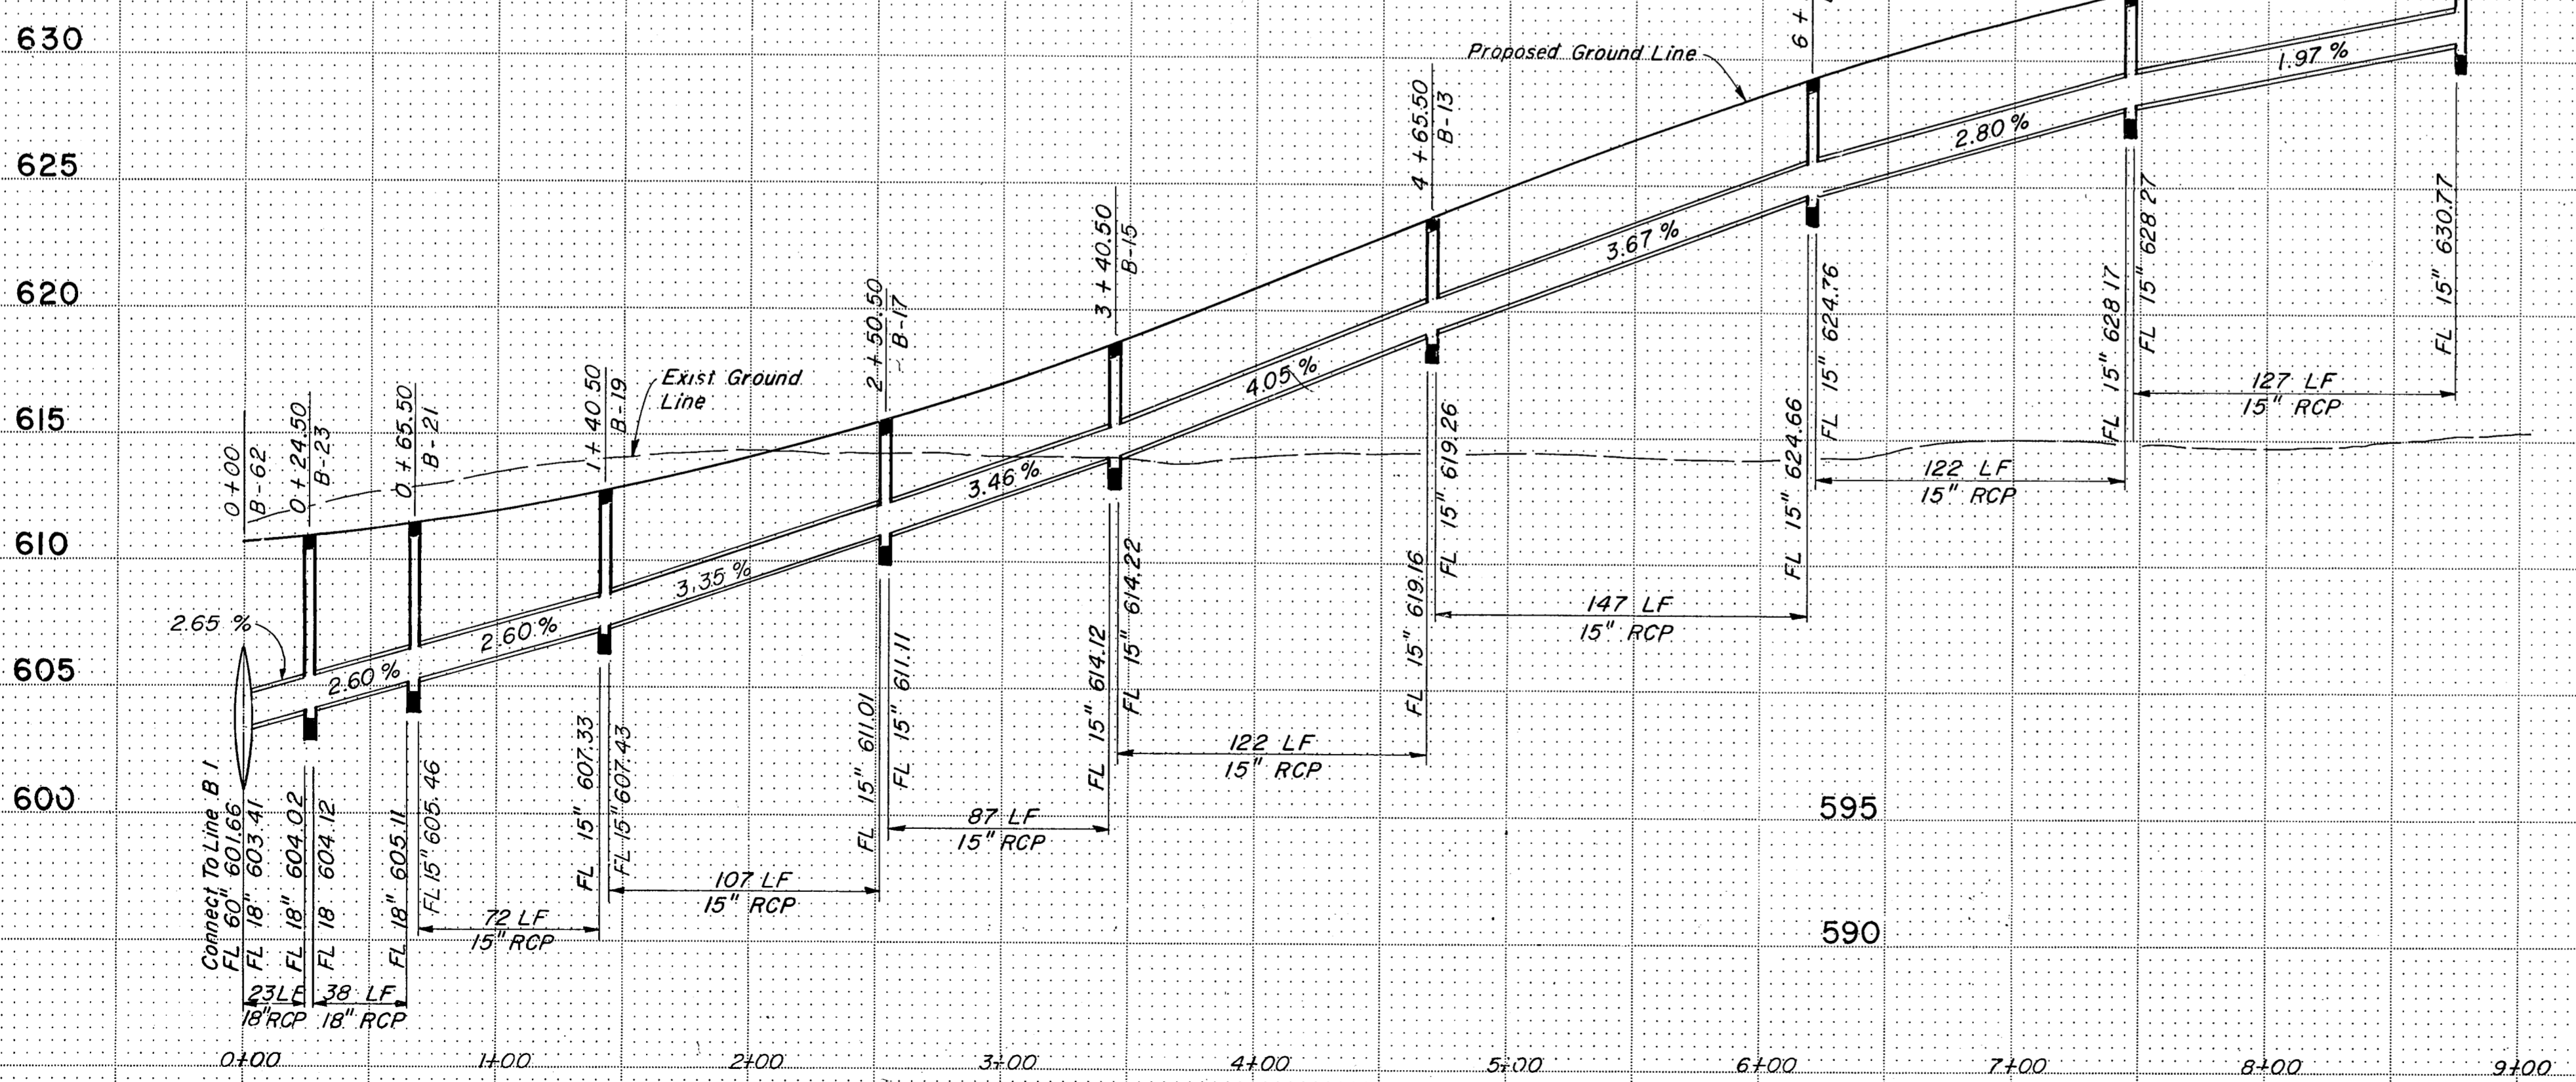

LINE "B-1-3"

LATERAL "B-43"

LATERAL "B-35"

LATERAL "B-33"

LATERAL "B-55"

LATERAL "B-29"

LATERAL "B-27"

LATERAL "B-25"



NOTES:  
1. Refer to Sheet R74 for depth of stabilized backfill.

STORM SEWER LINE: "B-1", "B-1-3"  
LATERAL: "B-25", "B-27", "B-29",  
"B-33", "B-35", "B-43",  
"B-55",

**ASBUILT PLANS**

NO.	REVISION	BY	DATE
TEXAS TURNPIKE AUTHORITY DALLAS NORTH TOLLWAY			
STORM SEWER PROFILES			
<b>Gibbs &amp; Hill, Inc.</b>			
MADE	ΔE/LT DATE 4/84	TRACED	ELB DATE 4/84
CHECKED	REW DATE 4/84	SCALE	1"=50'H 1"=5' V
CONTRACT NO. DNT-115 SHEET R51 OF R85			



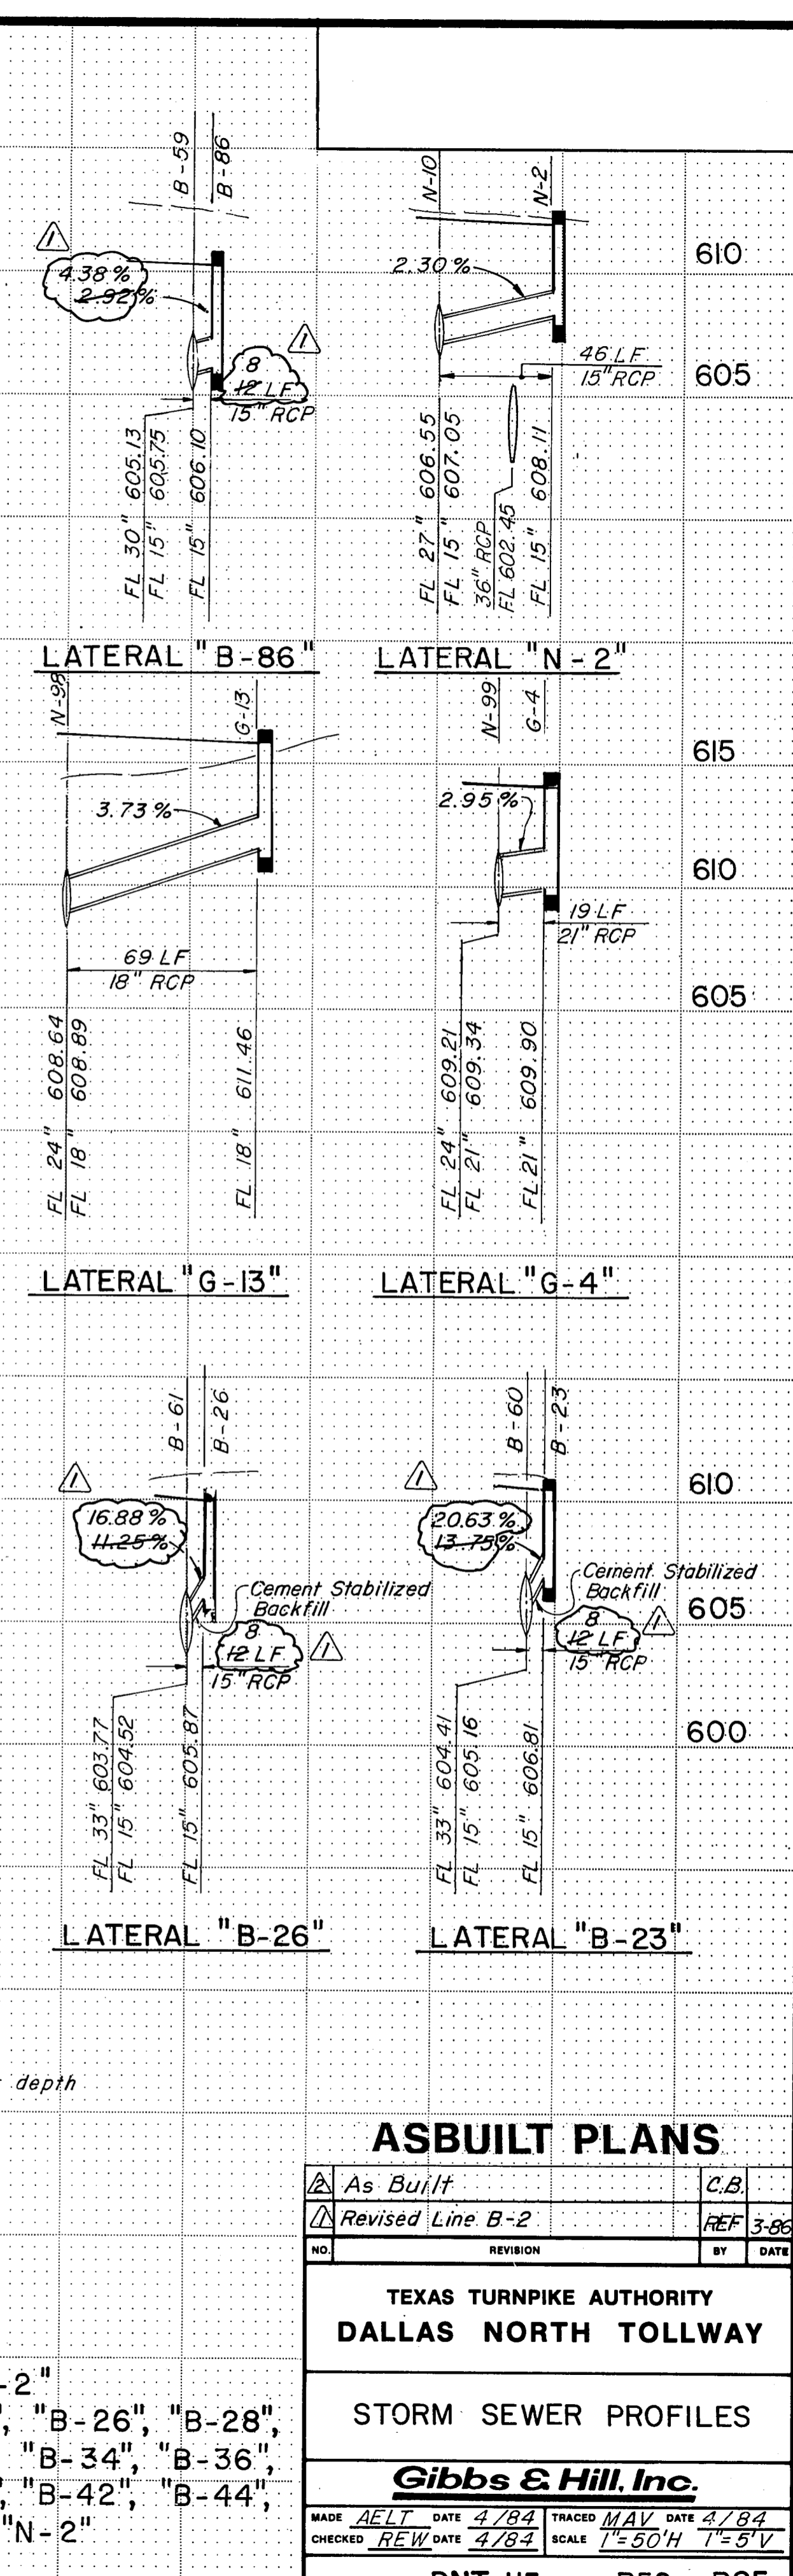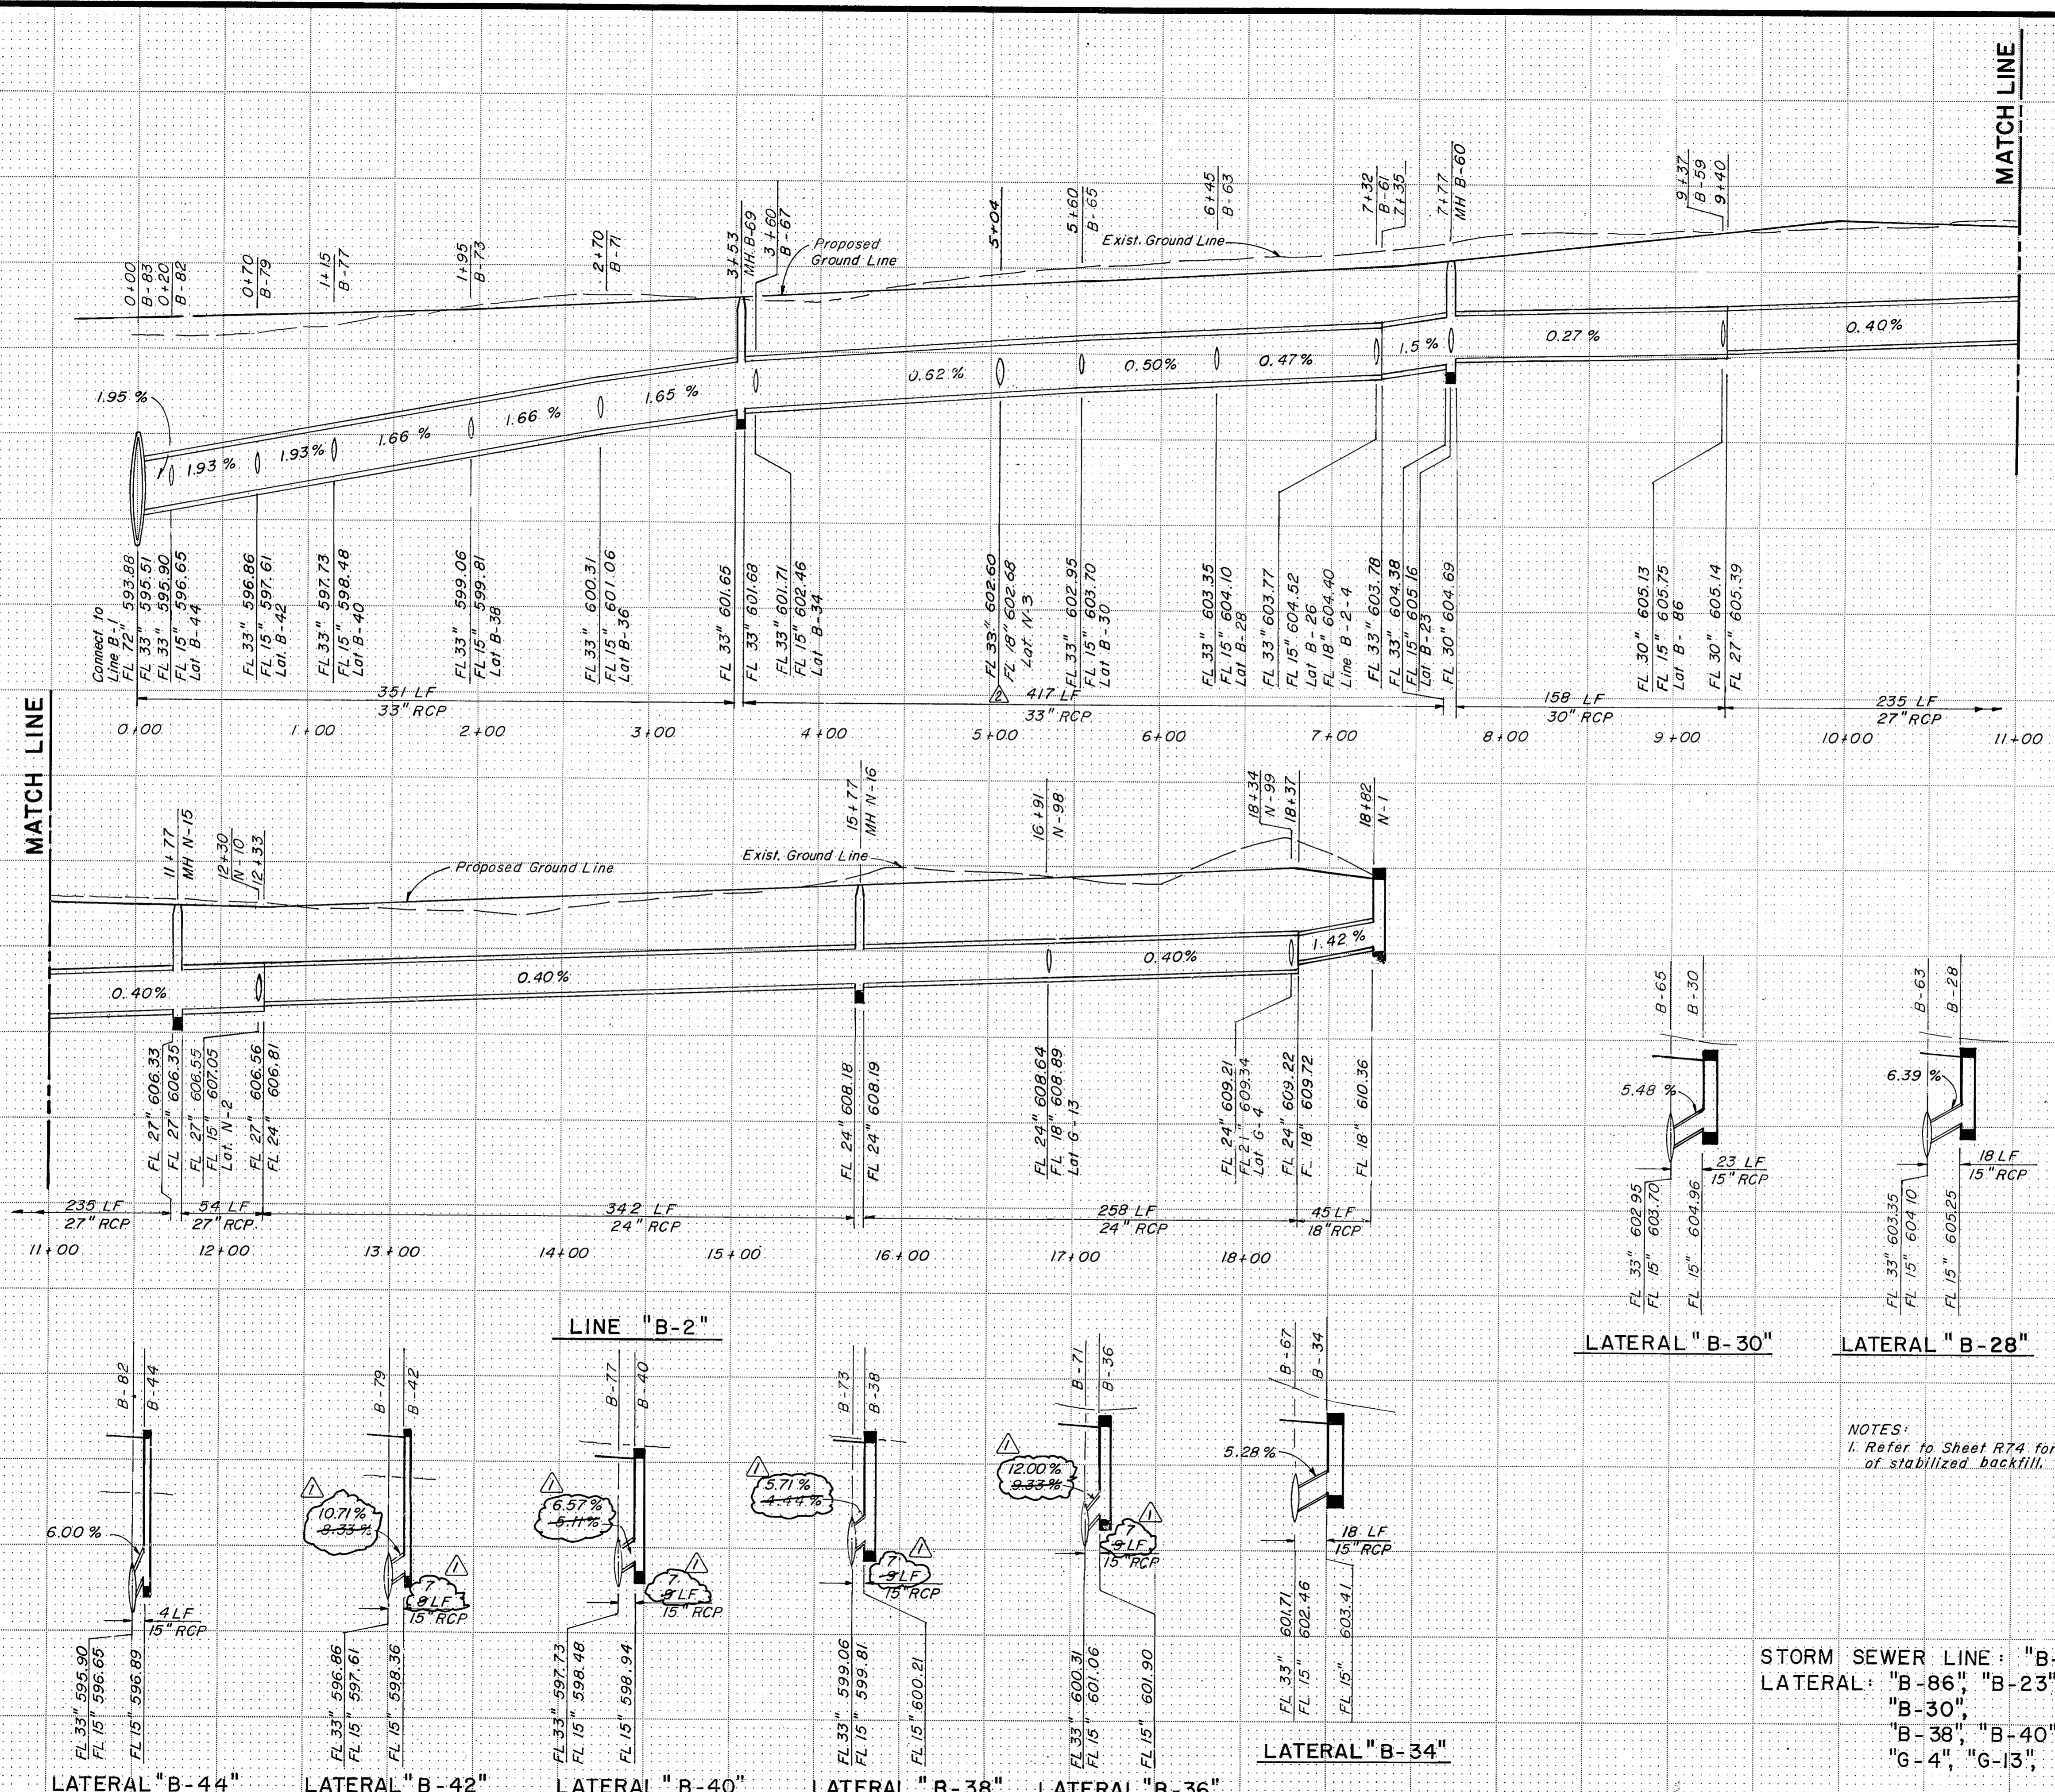

NOTES:  
1. Refer to Sheet R74 for depth of stabilized backfill.

STORM SEWER LINE: "B-2"  
LATERAL: "B-86", "B-23", "B-26", "B-28", "B-30", "B-34", "B-36", "B-38", "B-40", "B-42", "B-44", "G-4", "G-13", "N-2"

**ASBUILT PLANS**

As Built	C.B.
Revised Line B-2	REF 3-98
NO. _____	REVISION _____
BY _____	DATE _____




TEXAS TURNPIKE AUTHORITY  
DALLAS NORTH TOLLWAY

STORM SEWER PROFILES

**Gibbs & Hill, Inc.**  
MADE A/E/T DATE 4/84 TRACED M.A.V. DATE 4/84  
CHECKED R.E.W. DATE 4/84 SCALE 1"=50'H 1"=5'V

CONTRACT NO. DNT-115 SHEET R52 OF R85



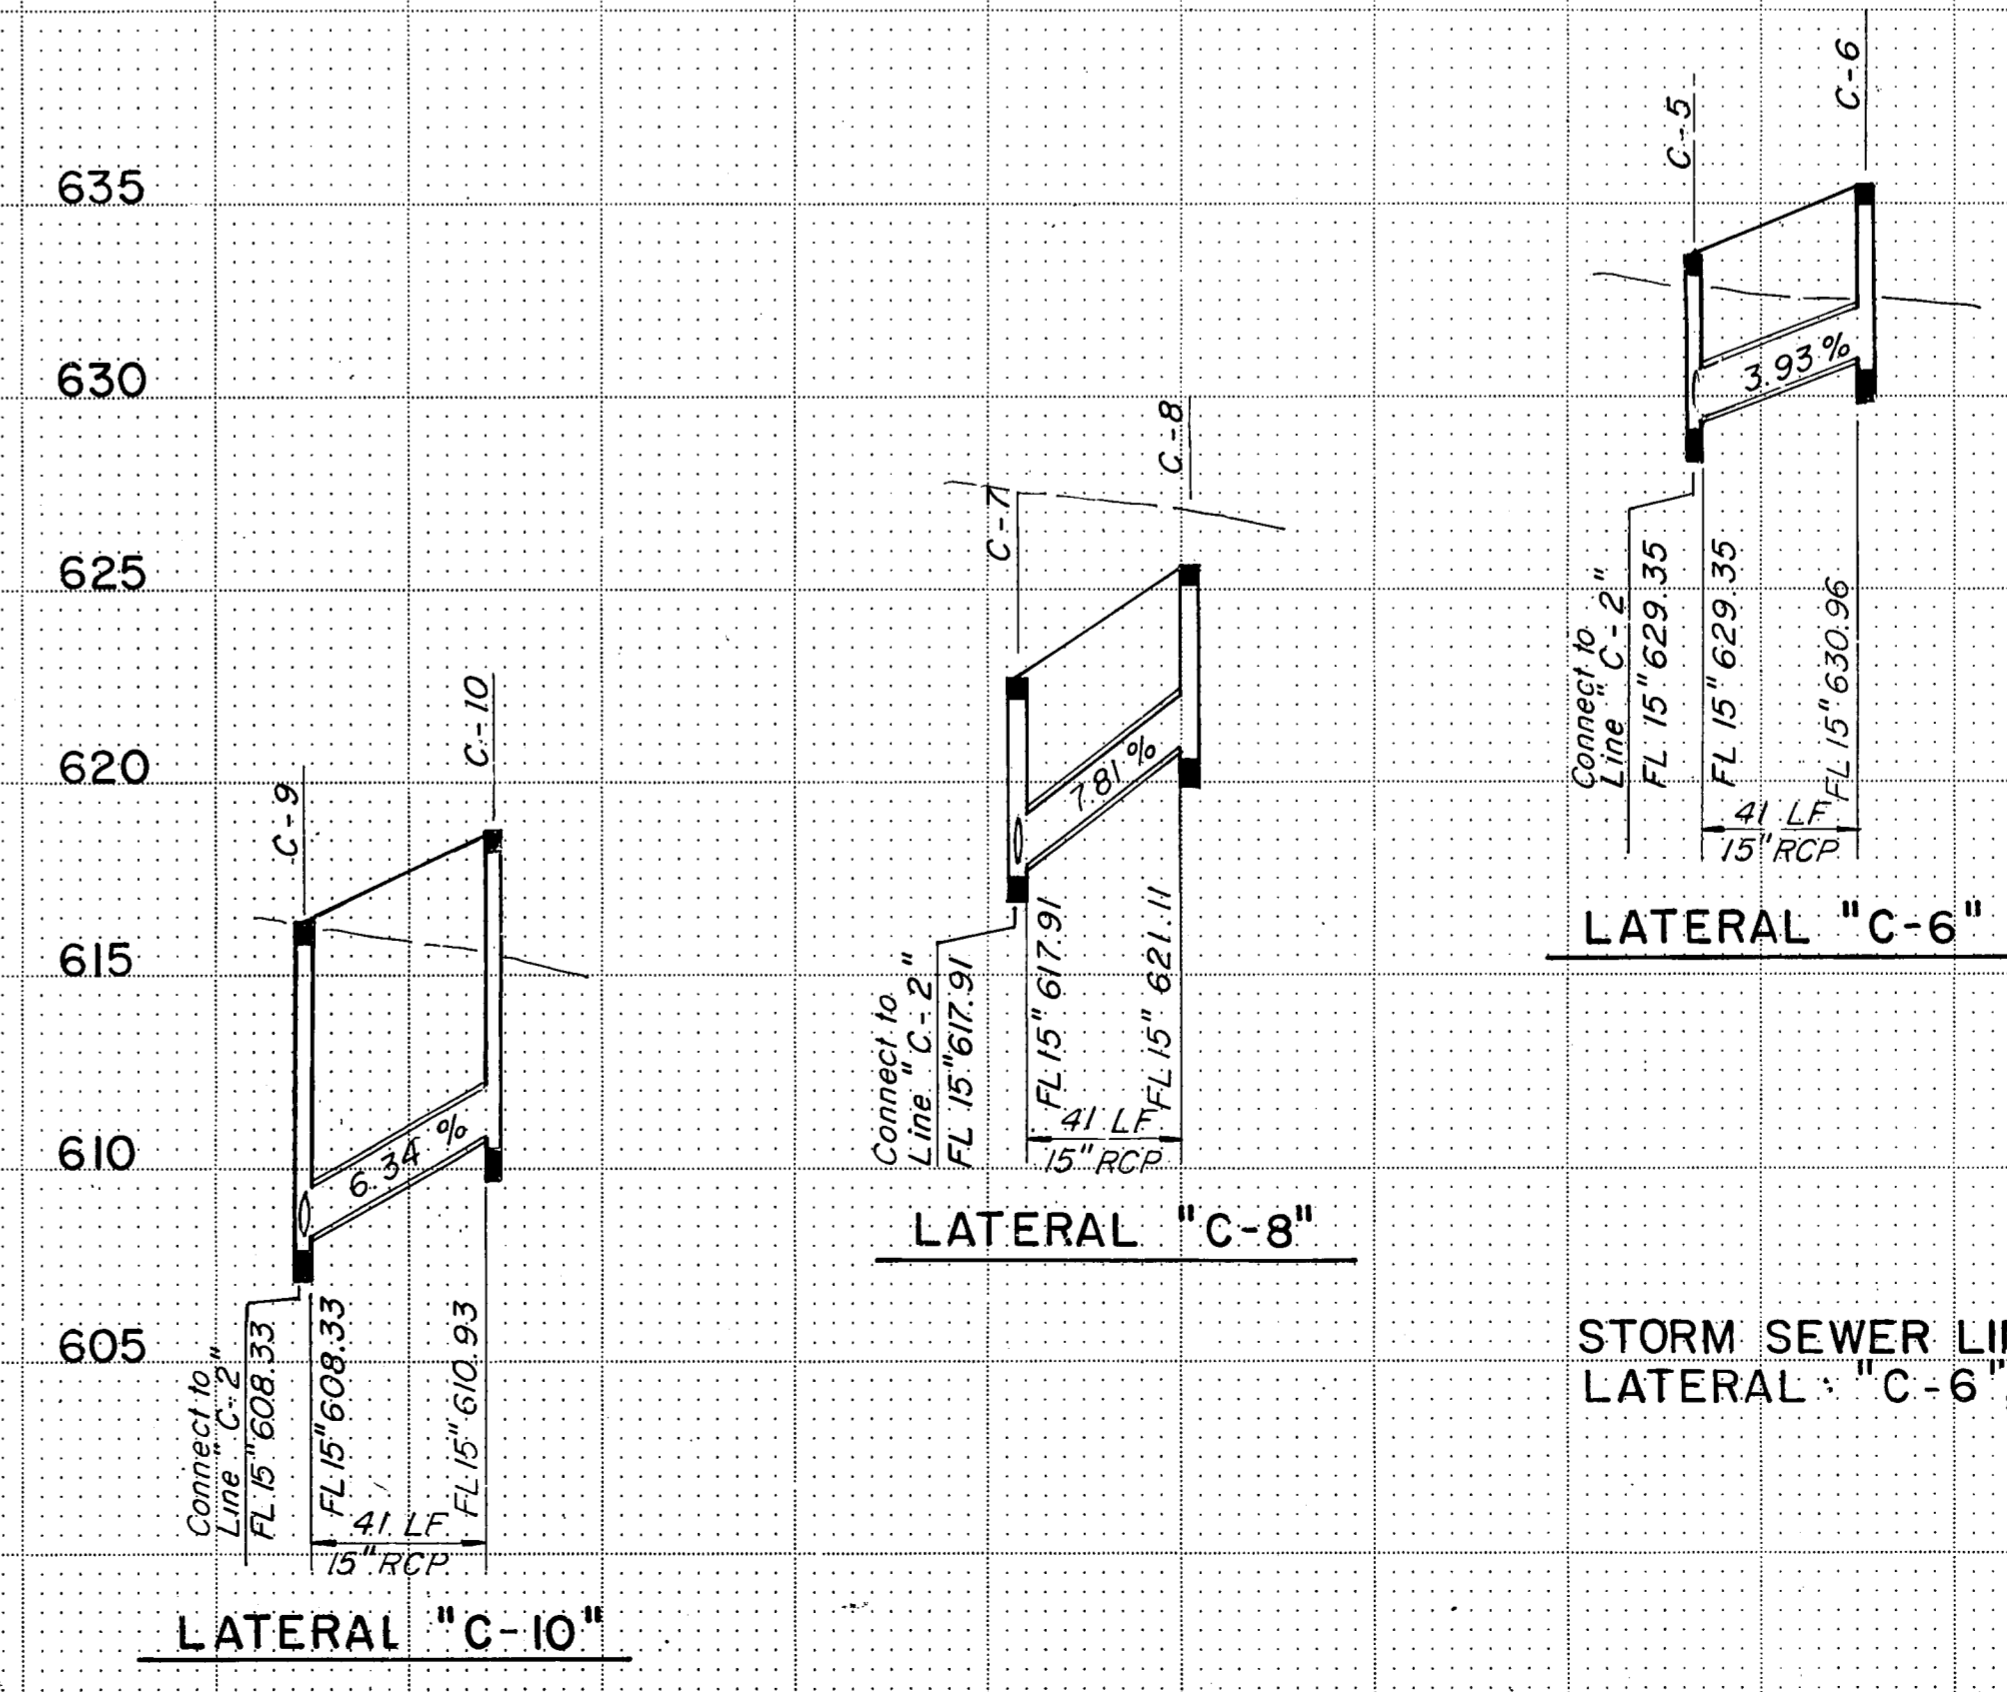
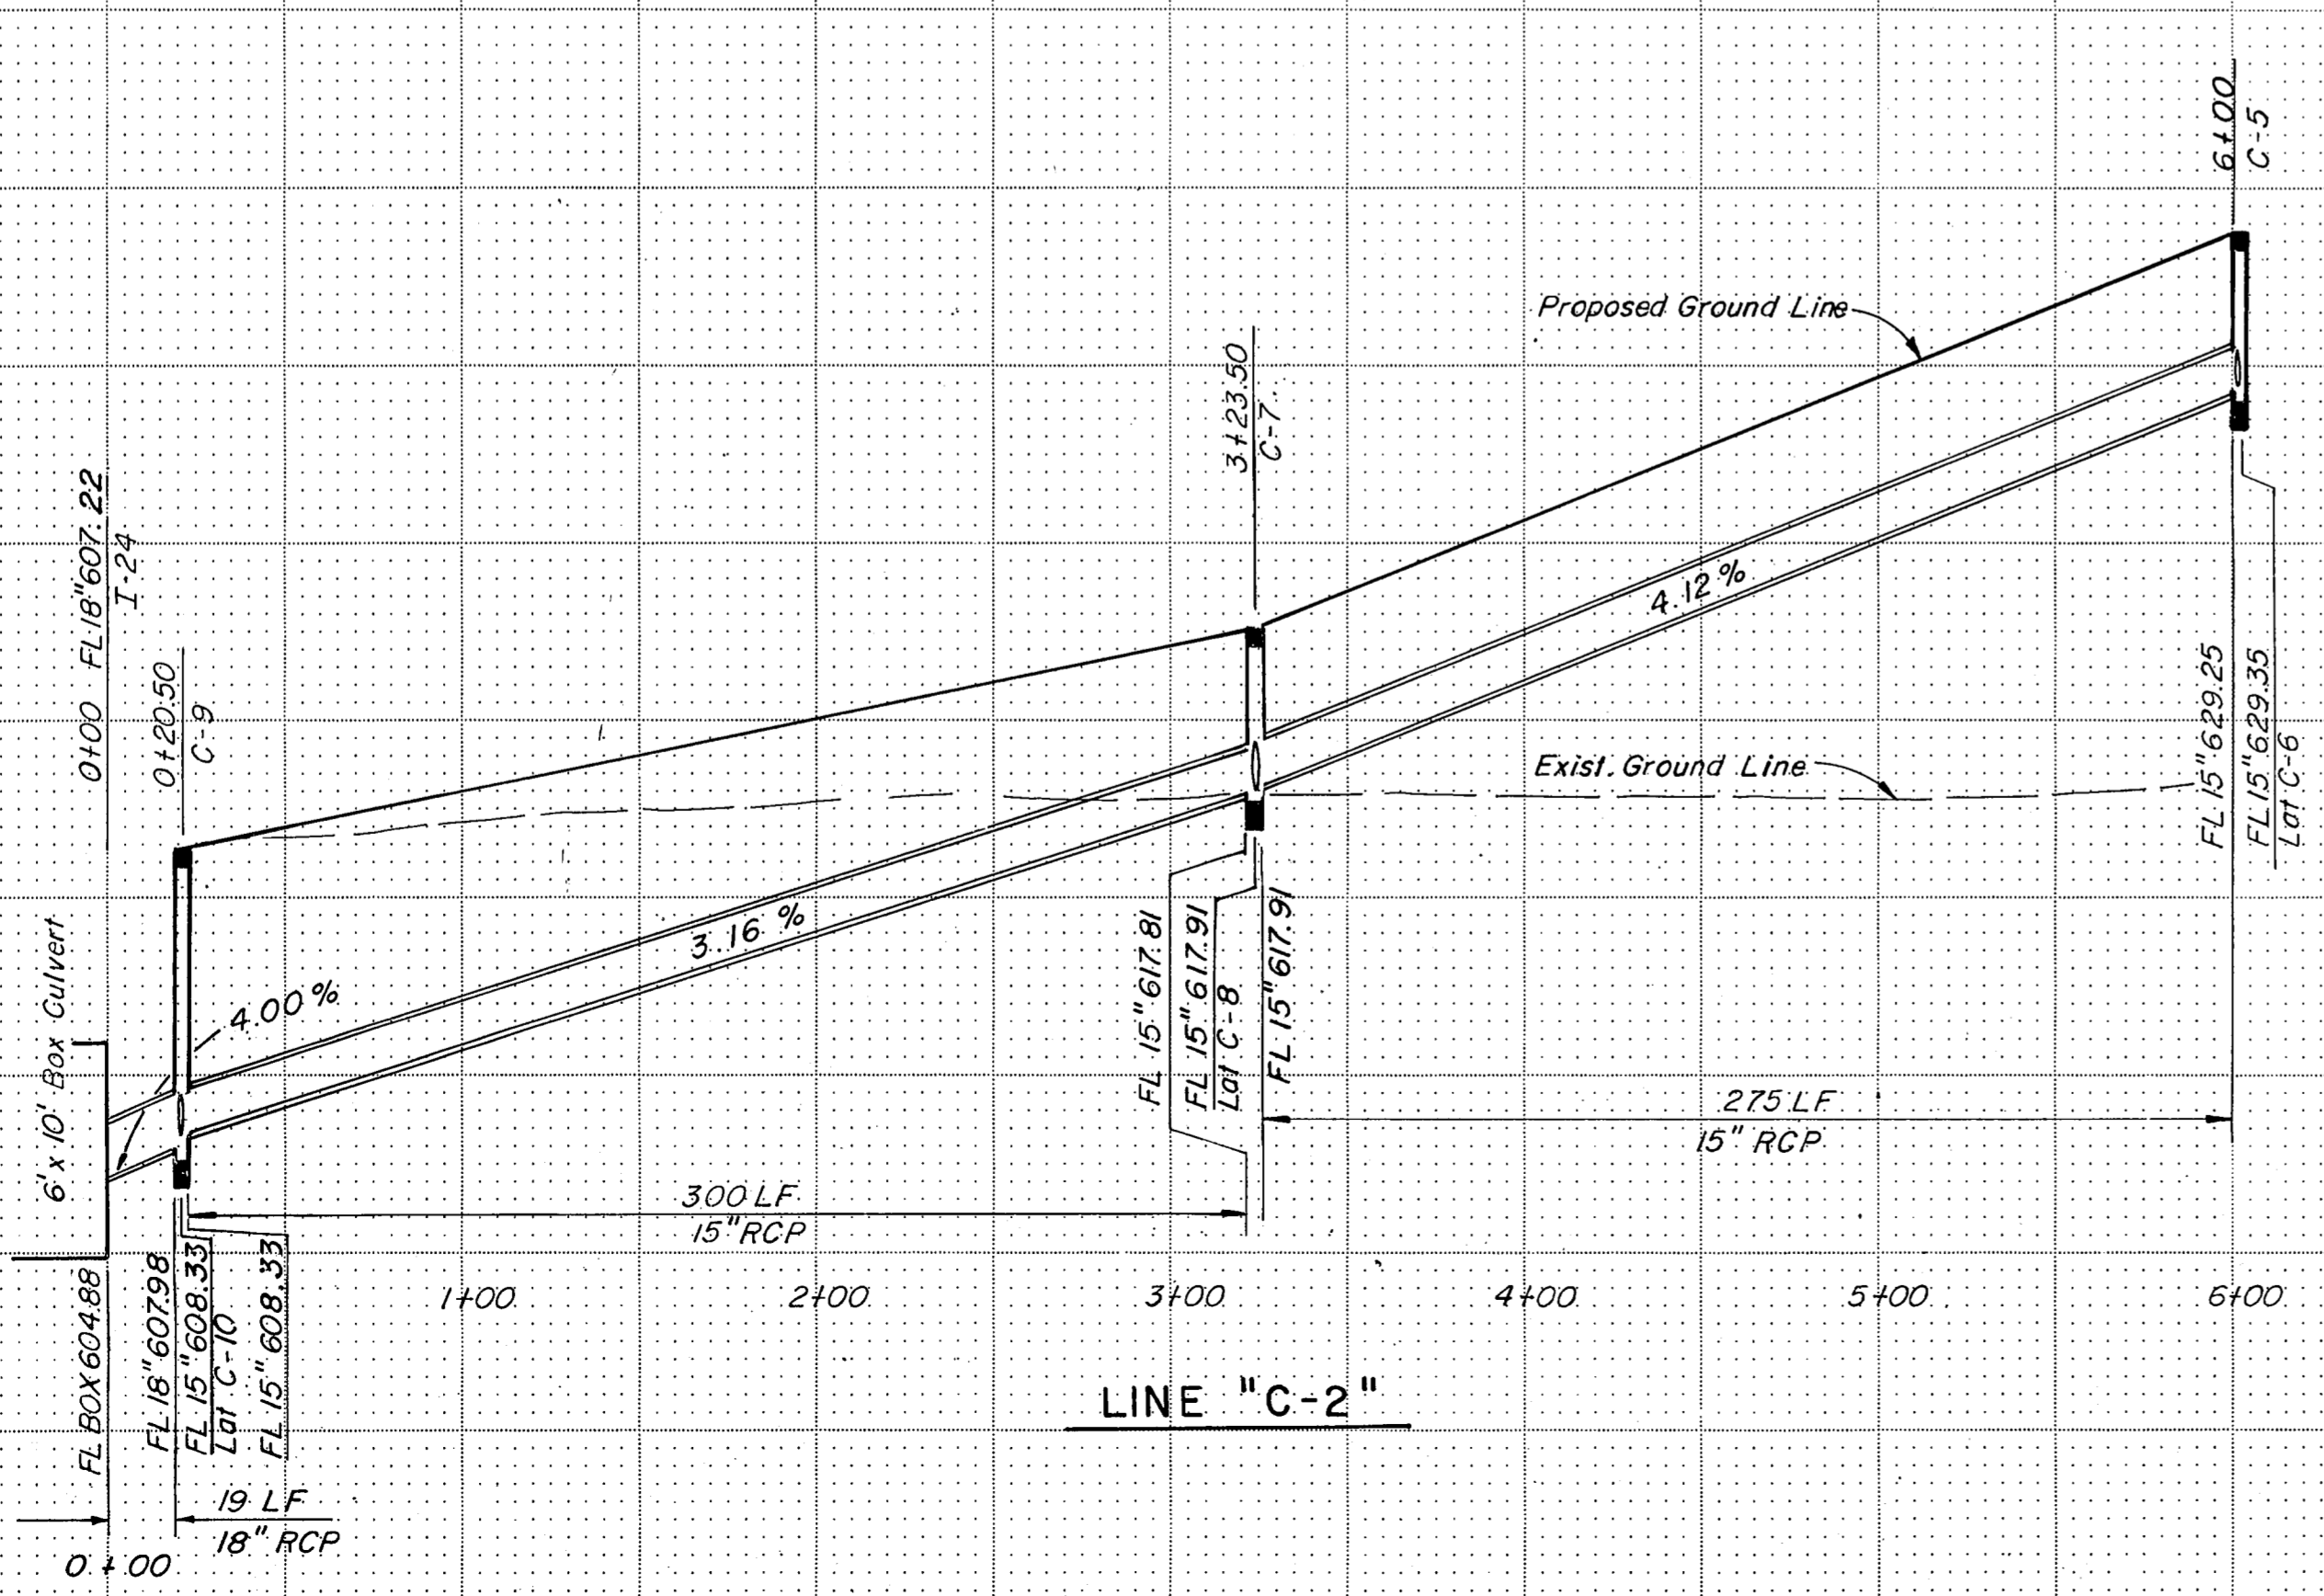
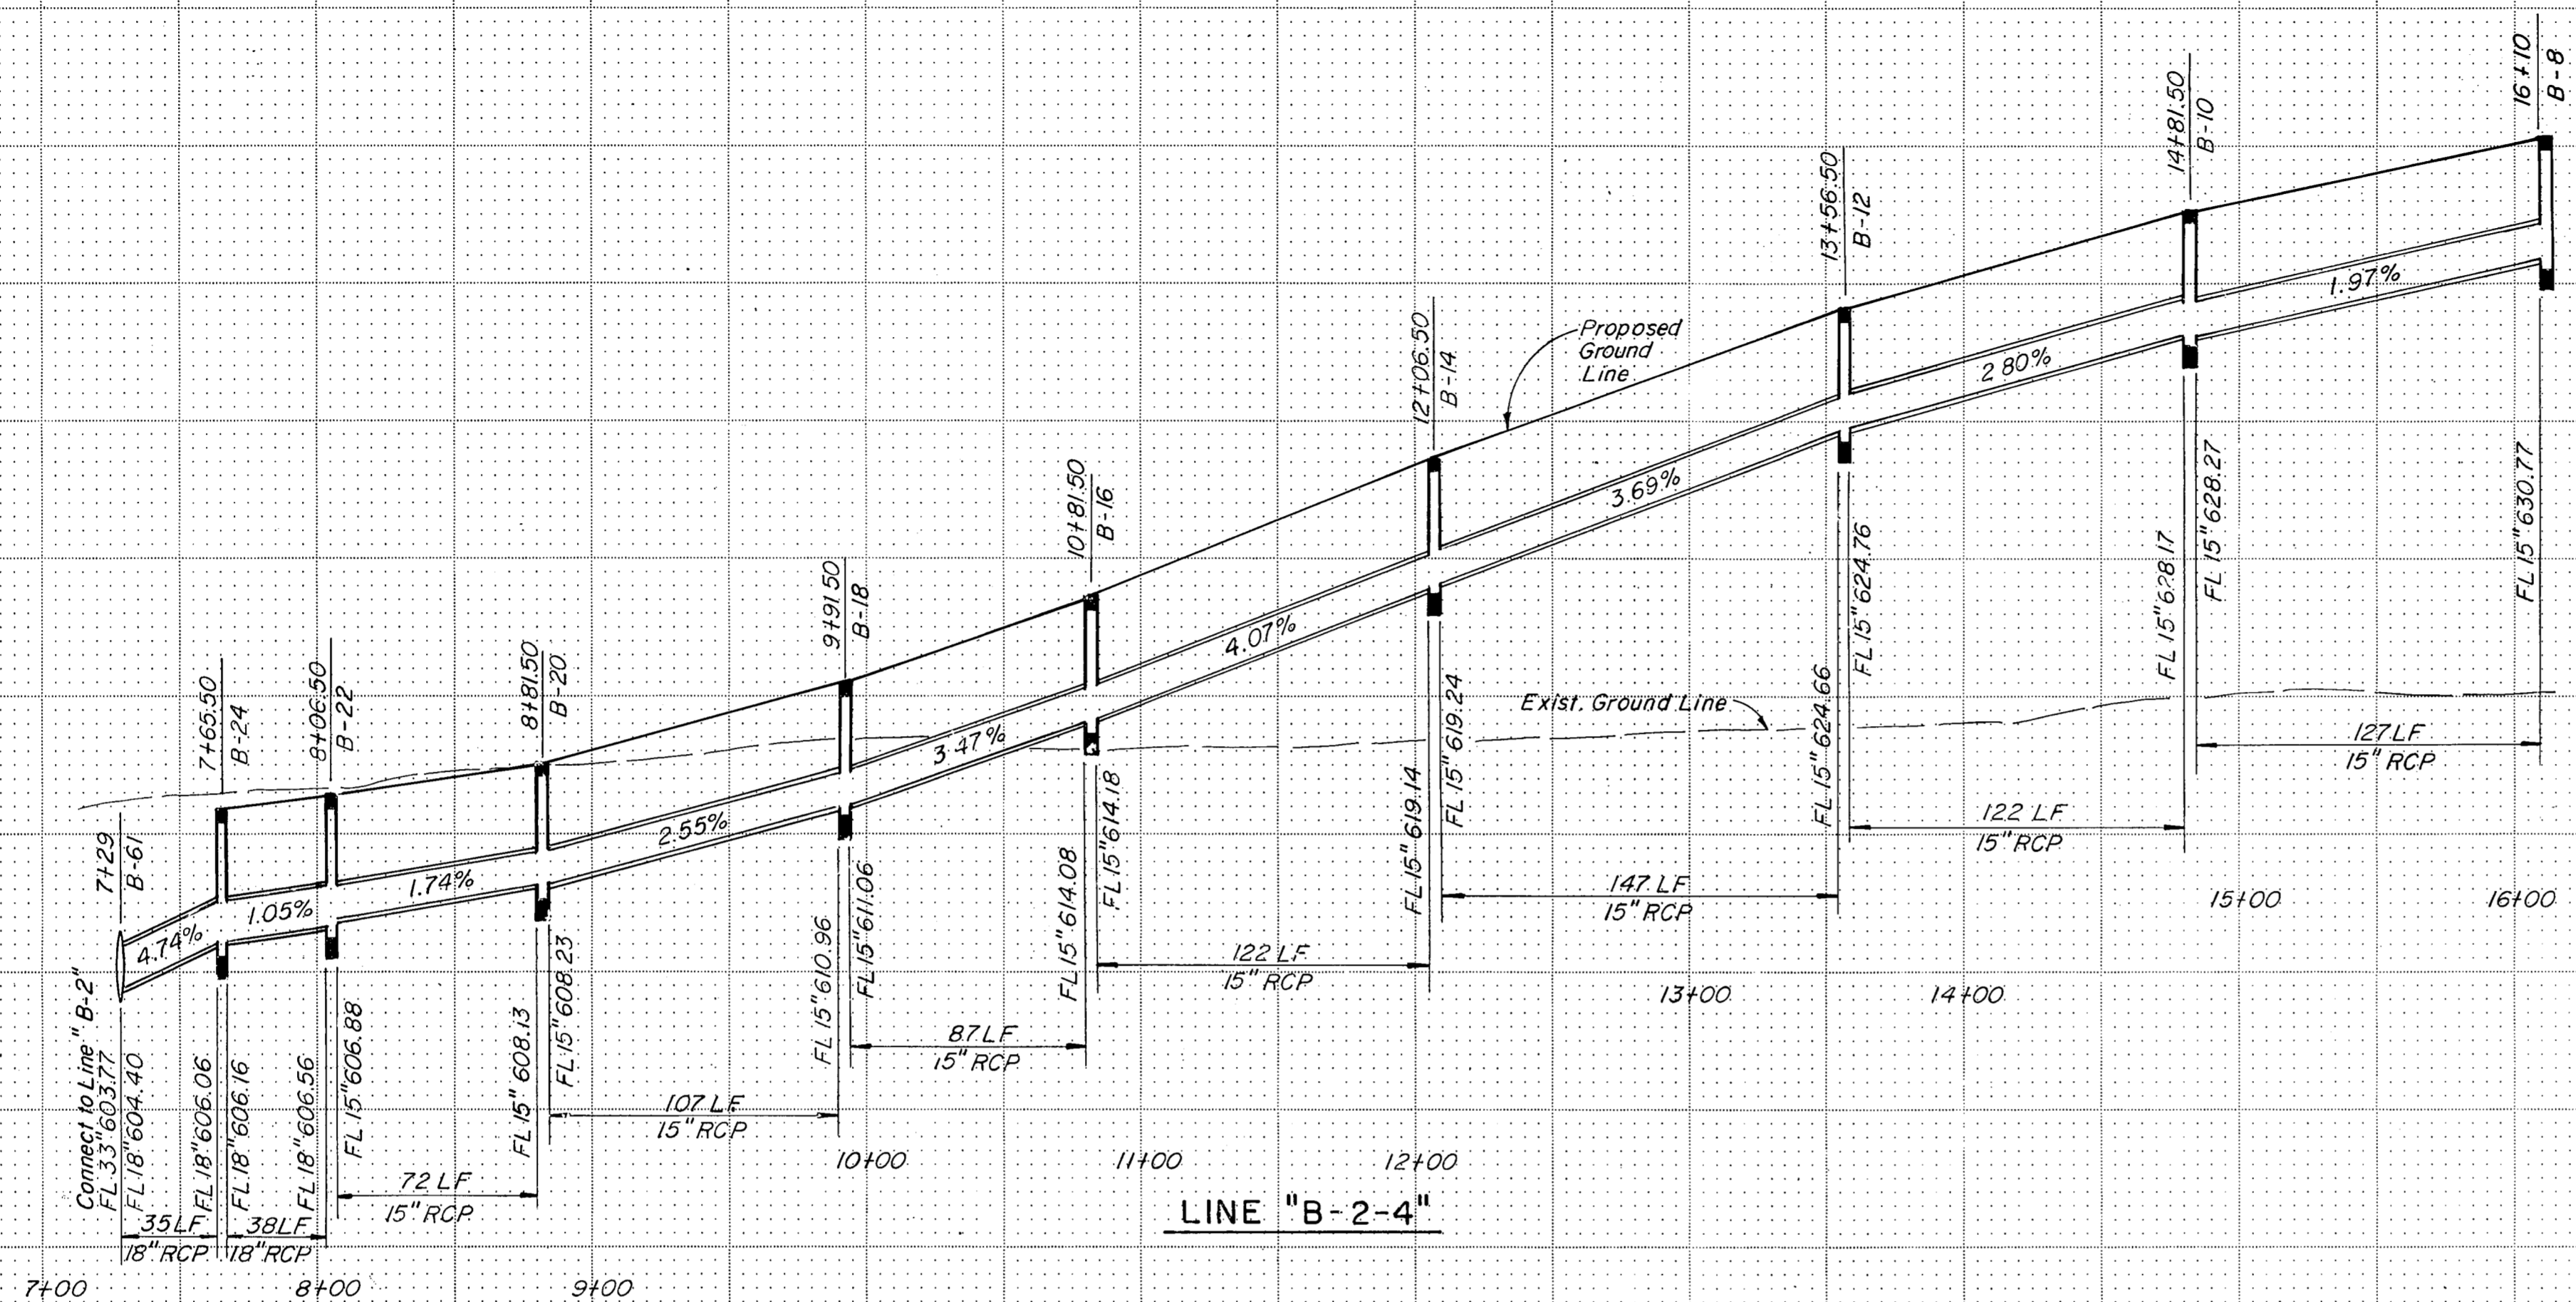


STORM SEWER LINE: "B-2-4", "C-2"  
 LATERAL: "C-6", "C-8", "C-10"

**ASBUILT PLANS**

NO.	REVISION	BY	DATE
TEXAS TURNPIKE AUTHORITY DALLAS NORTH TOLLWAY			
STORM SEWER PROFILES			
<b>Gibbs &amp; Hill, Inc.</b>			
MADE	AELT	DATE 12/83	TRACED
CHECKED	REW	DATE 4/84	SCALE 1"=50'H 1"=5'V
CONTRACT NO. DNT-115 SHEET R53 OF R85			



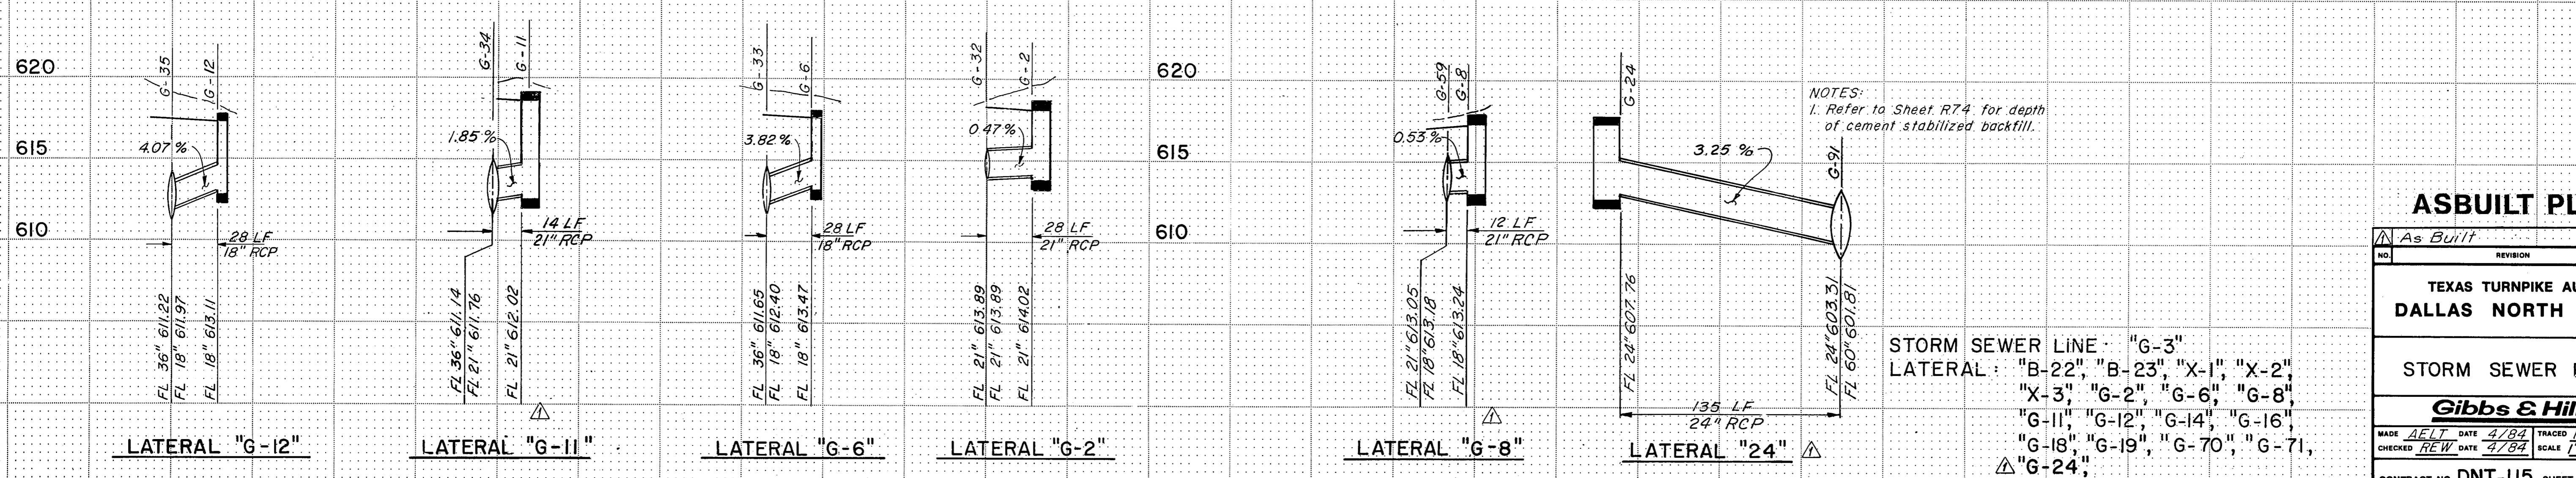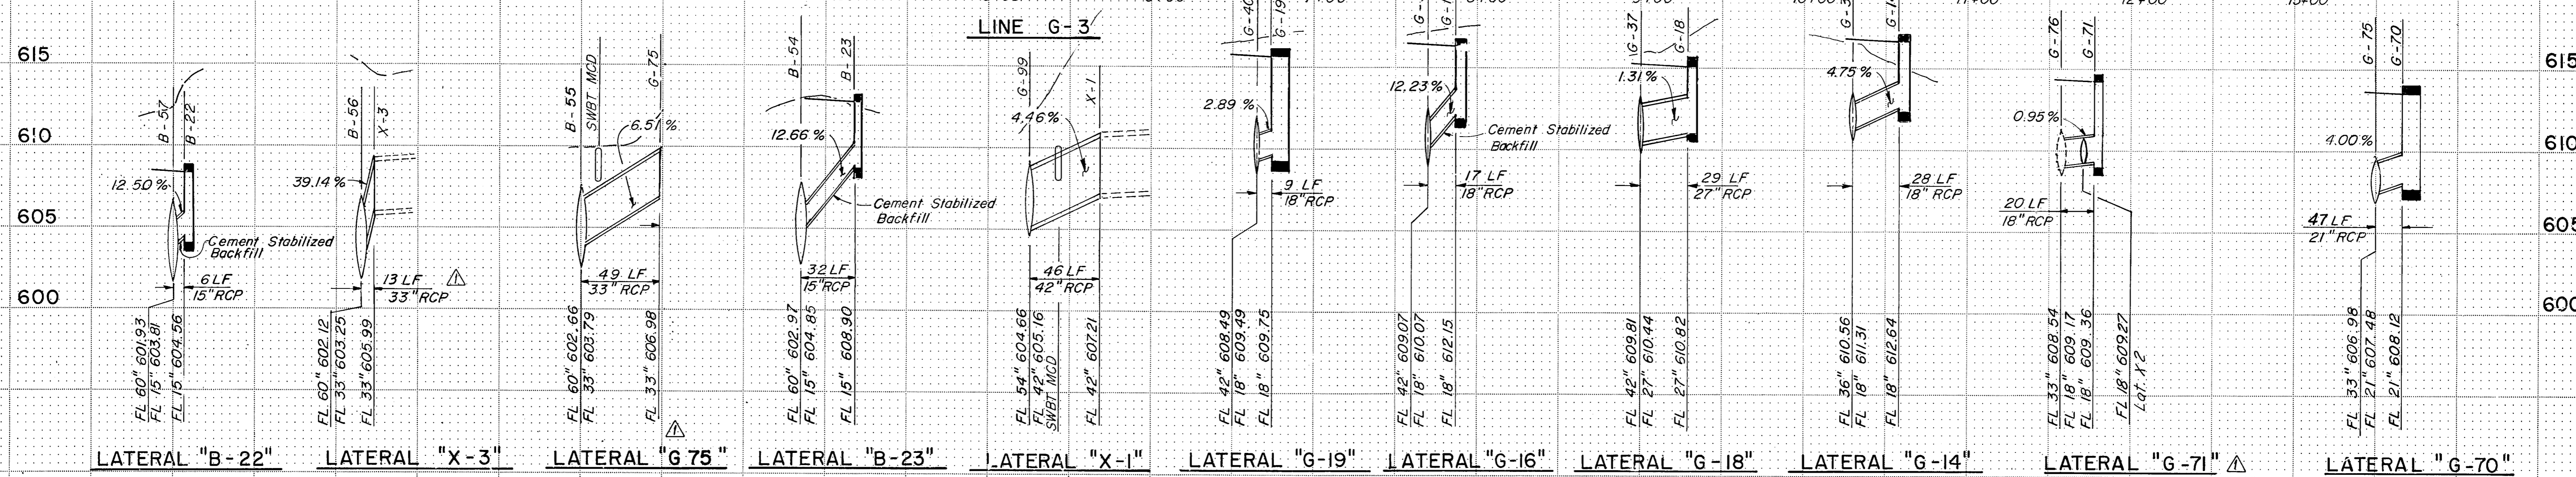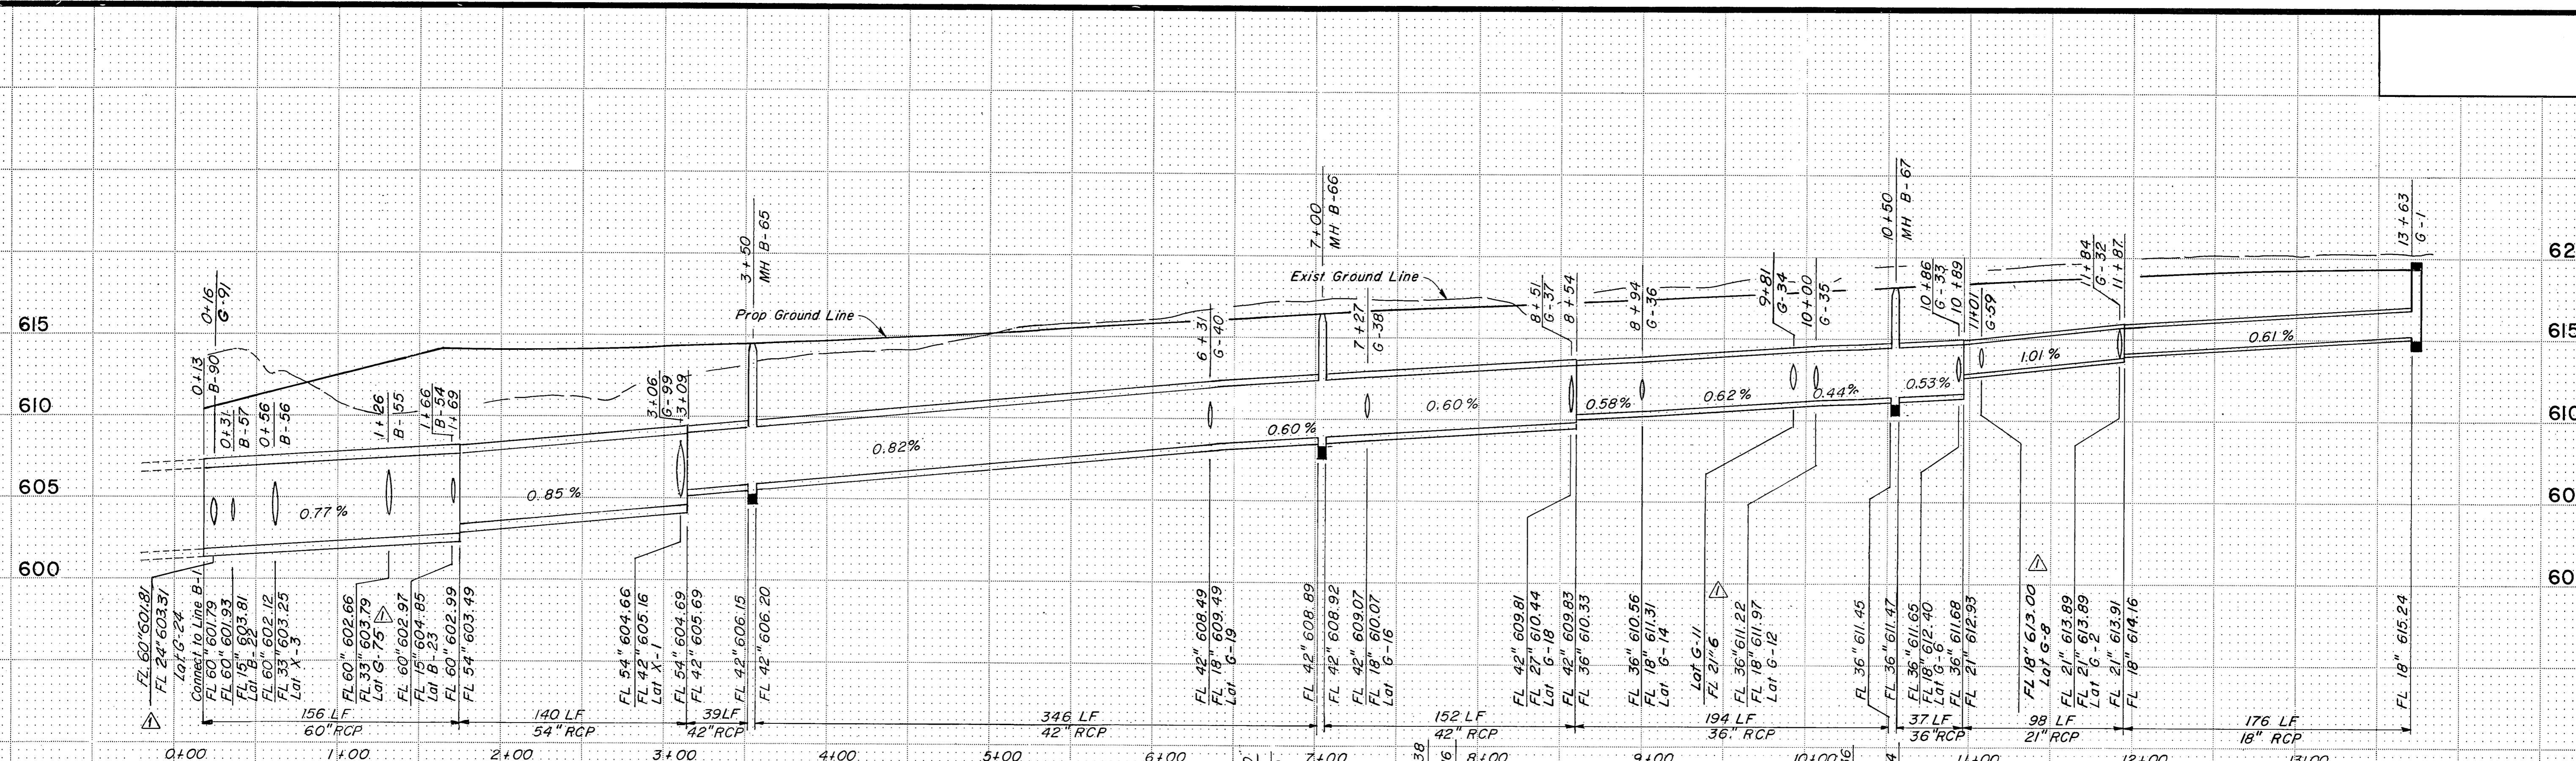


**ASBUILT PLANS**


As Built		CB
NO.	REVISION	BY, DATE
TEXAS TURNPIKE AUTHORITY DALLAS NORTH TOLLWAY		
STORM SEWER PROFILES		
<b>Gibbs &amp; Hill, Inc.</b>		
MADE A/E/LT DATE 4/84	TRACED DATE 4/84	MAV DATE 4/84
CHECKED REW DATE 4/84	SCALE 1"=50'H	1"=5'V
CONTRACT NO. DNT-115 SHEET R54 OF R85		

STORM SEWER LINE "G-3"  
 LATERAL: "B-22", "B-23", "X-1", "X-2",  
 "X-3", "G-2", "G-6", "G-8",  
 "G-11", "G-12", "G-14", "G-16",  
 "G-18", "G-19", "G-70", "G-71",  
 "G-24"



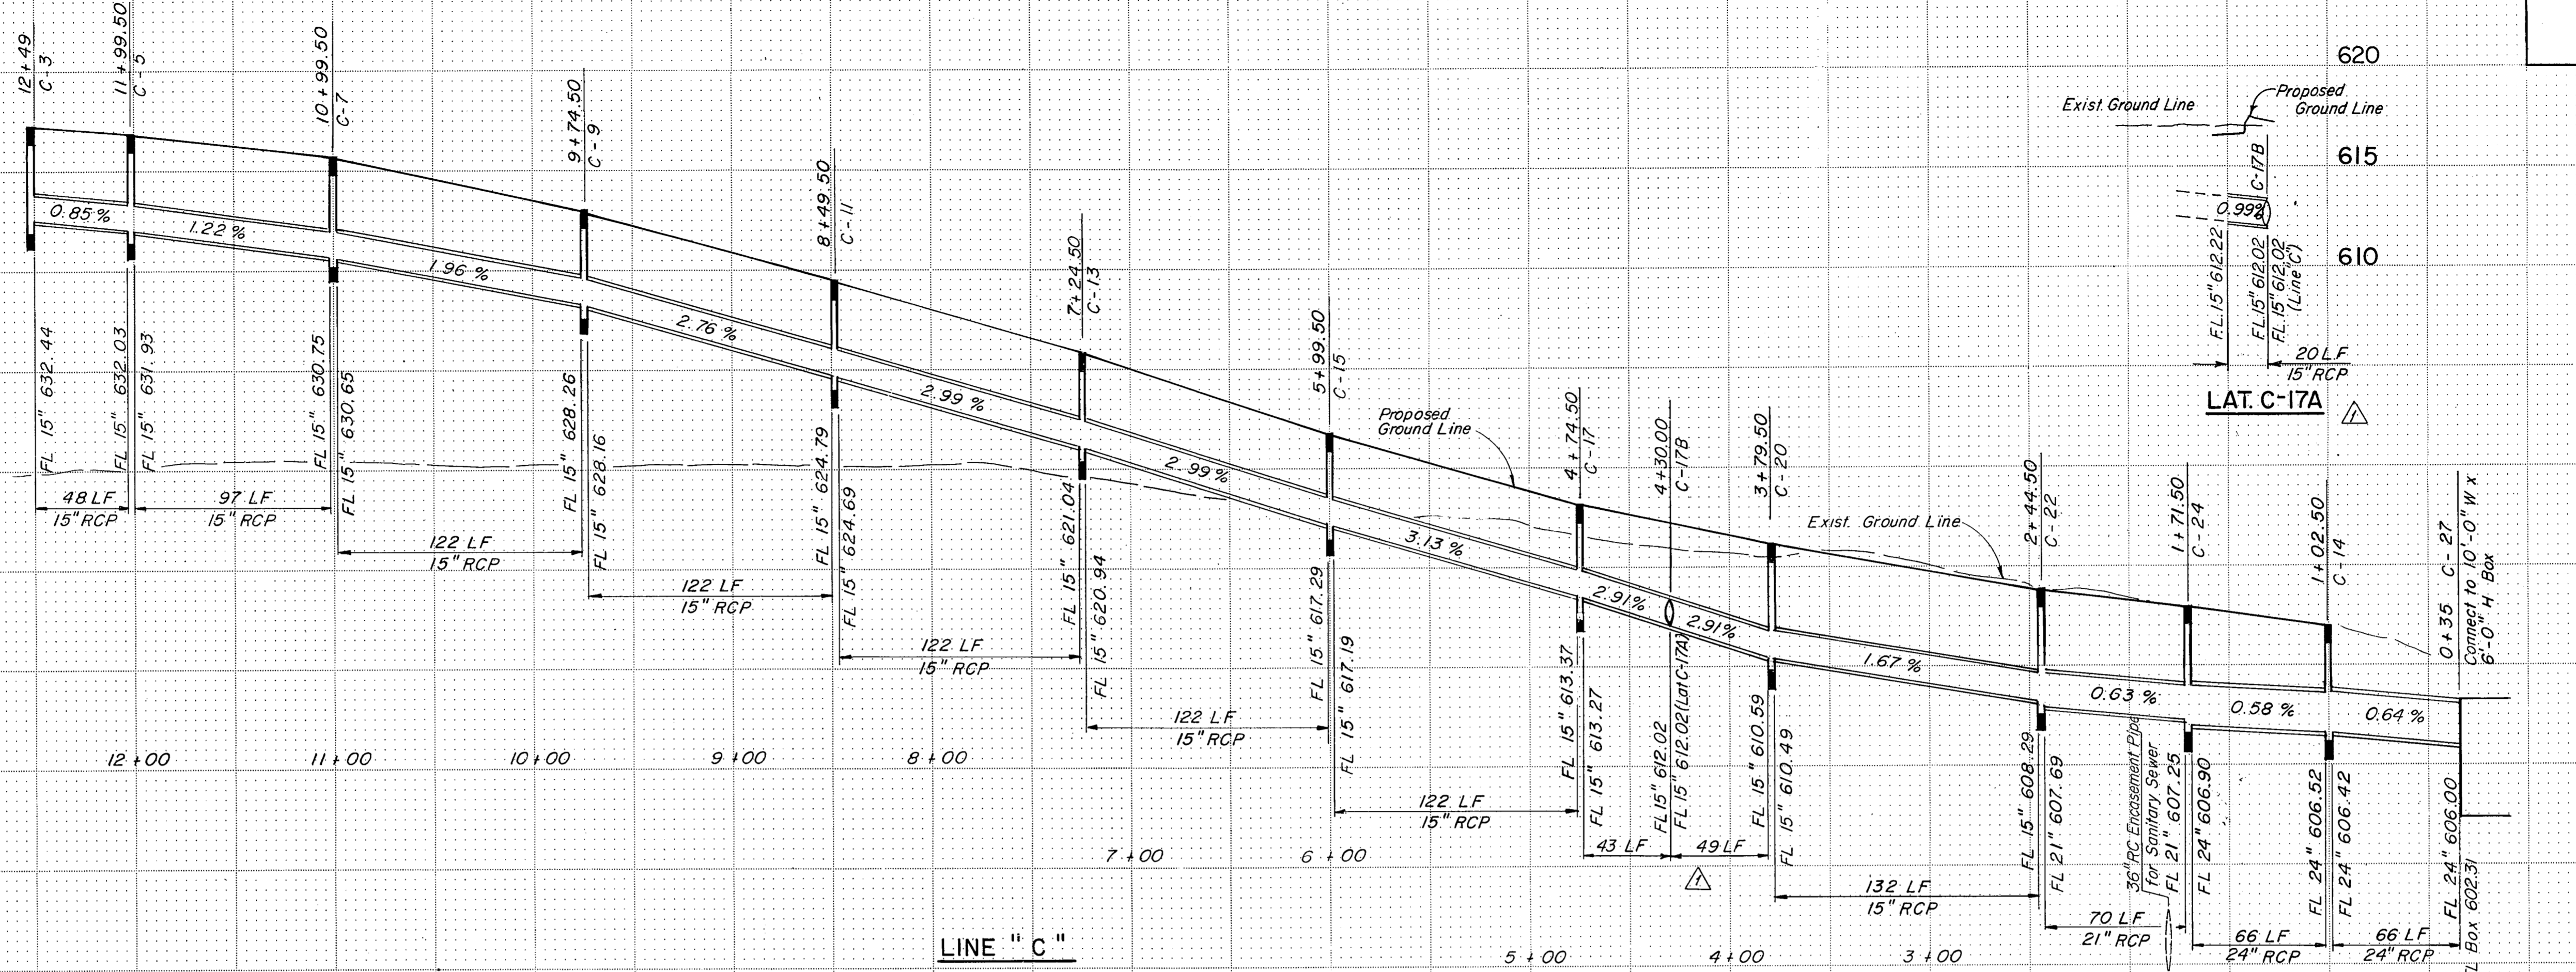

LINE "C"

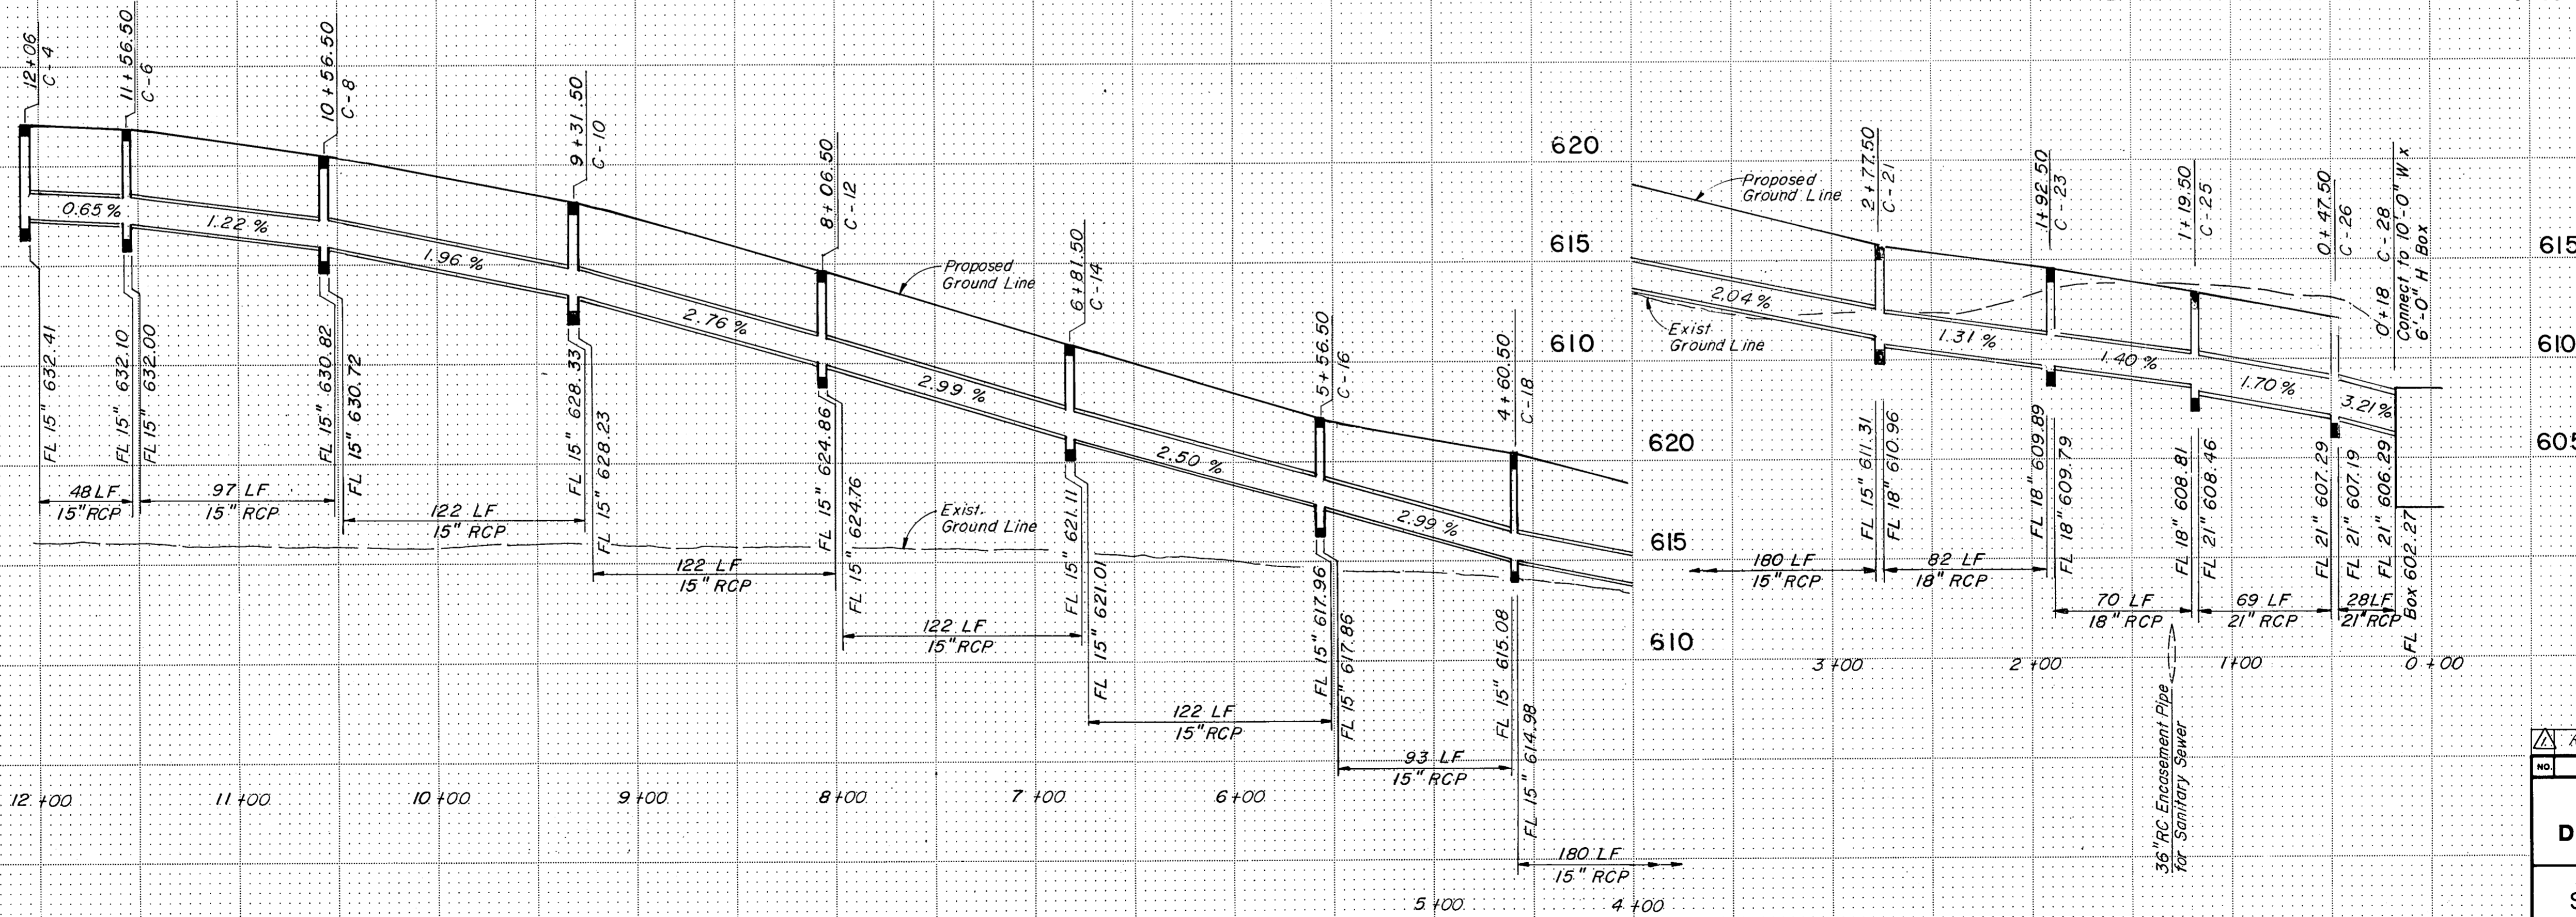

LINE "C-1"

STORM SEWER LINES: "C", "C-1"  
LATERAL: "C-17A"

**ASBUILT PLANS**

Revise Line "C", Add Lat. C-17A. 6/29/7/84

NO. REVISION BY DATE

TEXAS TURNPIKE AUTHORITY  
DALLAS NORTH TOLLWAY


STORM SEWER PROFILES

**Gibbs & Hill, Inc.**

MADE AELT DATE 4/84 TRACED MAV DATE 4/84  
CHECKED REW DATE 4/84 SCALE 1"=50'H 1"=5'V

CONTRACT NO. DNT-115 SHEET R55 OF R85



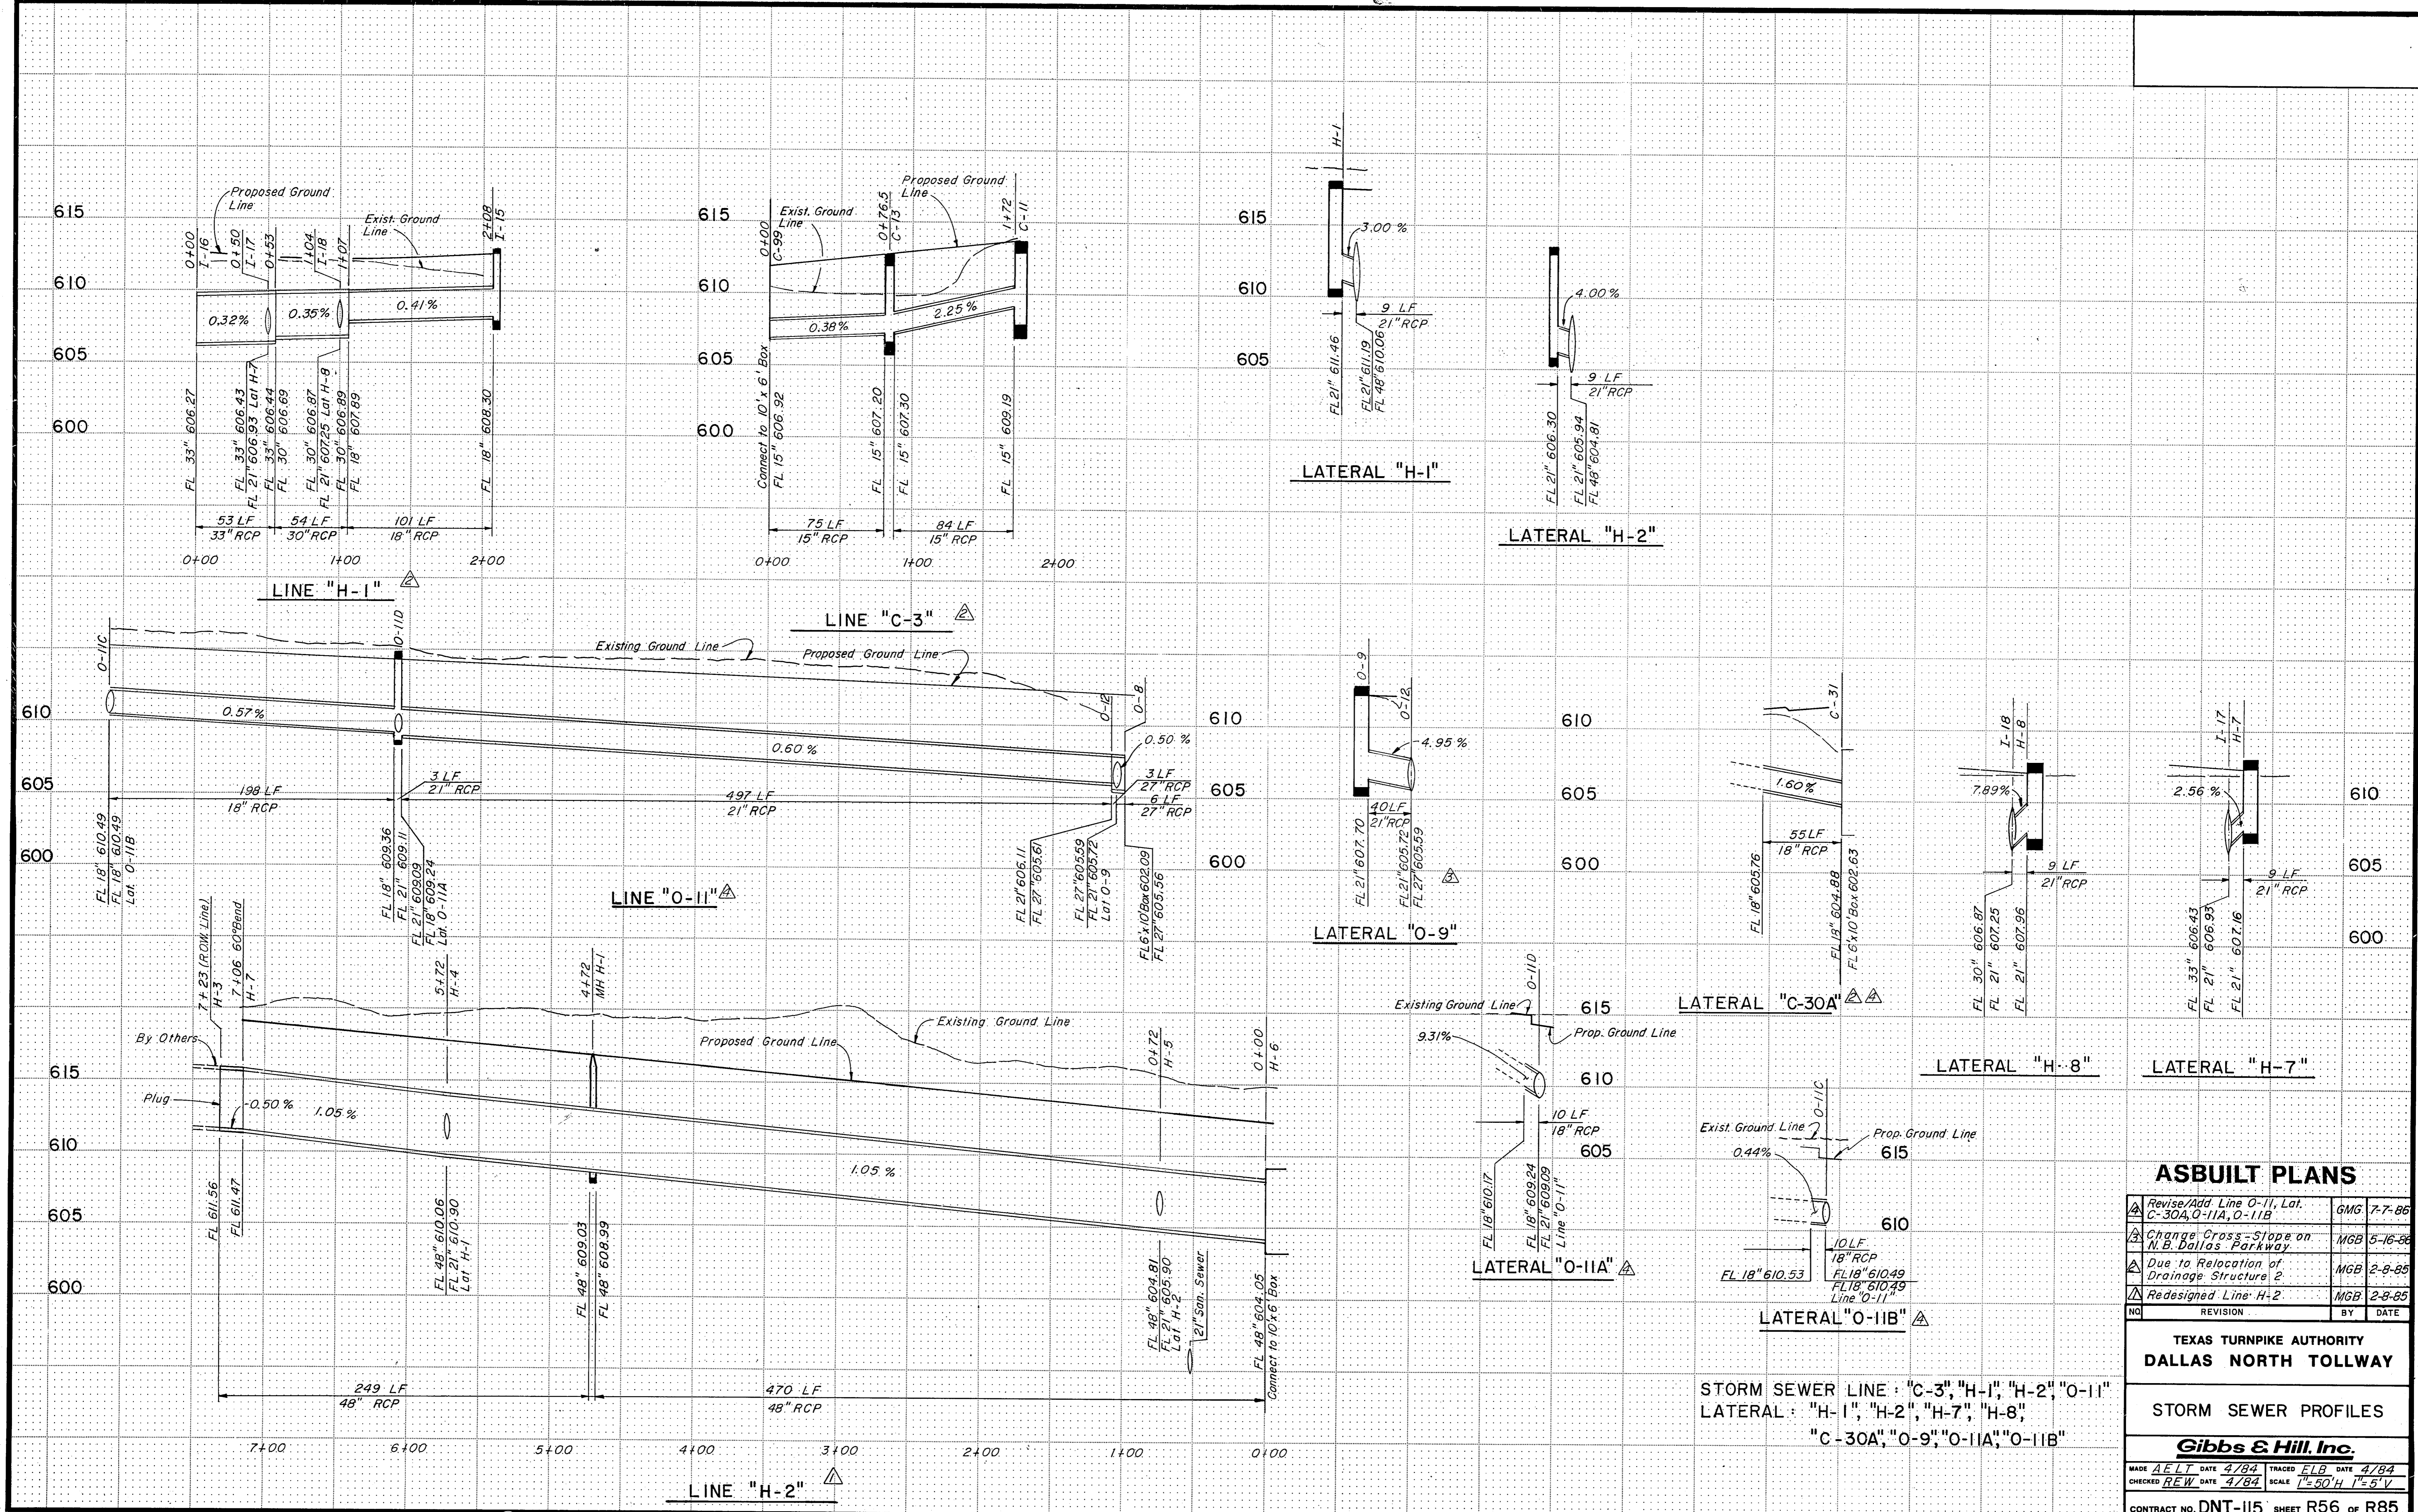

LATERAL "H-1"

LATERAL "H-2"

LATERAL "O-9"

LATERAL "C-30A"

LATERAL "H-8"

LATERAL "H-7"

LATERAL "O-11A"

LATERAL "O-11B"

STORM SEWER LINE : "C-3", "H-1", "H-2", "O-11"  
 LATERAL : "H-1", "H-2", "H-7", "H-8",  
 "C-30A", "O-9", "O-11A", "O-11B"

**ASBUILT PLANS**

△	Revise/Add Line O-11, Lat. C-30A, O-11A, O-11B	GMG	7-7-86
△	Change Cross-Slope on N.B. Dallas Parkway	MGB	5-16-86
△	Due to Relocation of Drainage Structure 2	MGB	2-8-85
△	Redesigned Line H-2	MGB	2-8-85
NO	REVISION	BY	DATE

TEXAS TURNPIKE AUTHORITY  
 DALLAS NORTH TOLLWAY



STORM SEWER PROFILES

**Gibbs & Hill, Inc.**

MADE A.E.L.T. DATE 4/84 TRACED E.L.B. DATE 4/84  
 CHECKED R.E.W. DATE 4/84 SCALE 1"=50'H 1"=5'V

CONTRACT NO. DNT-115 SHEET R56 OF R85



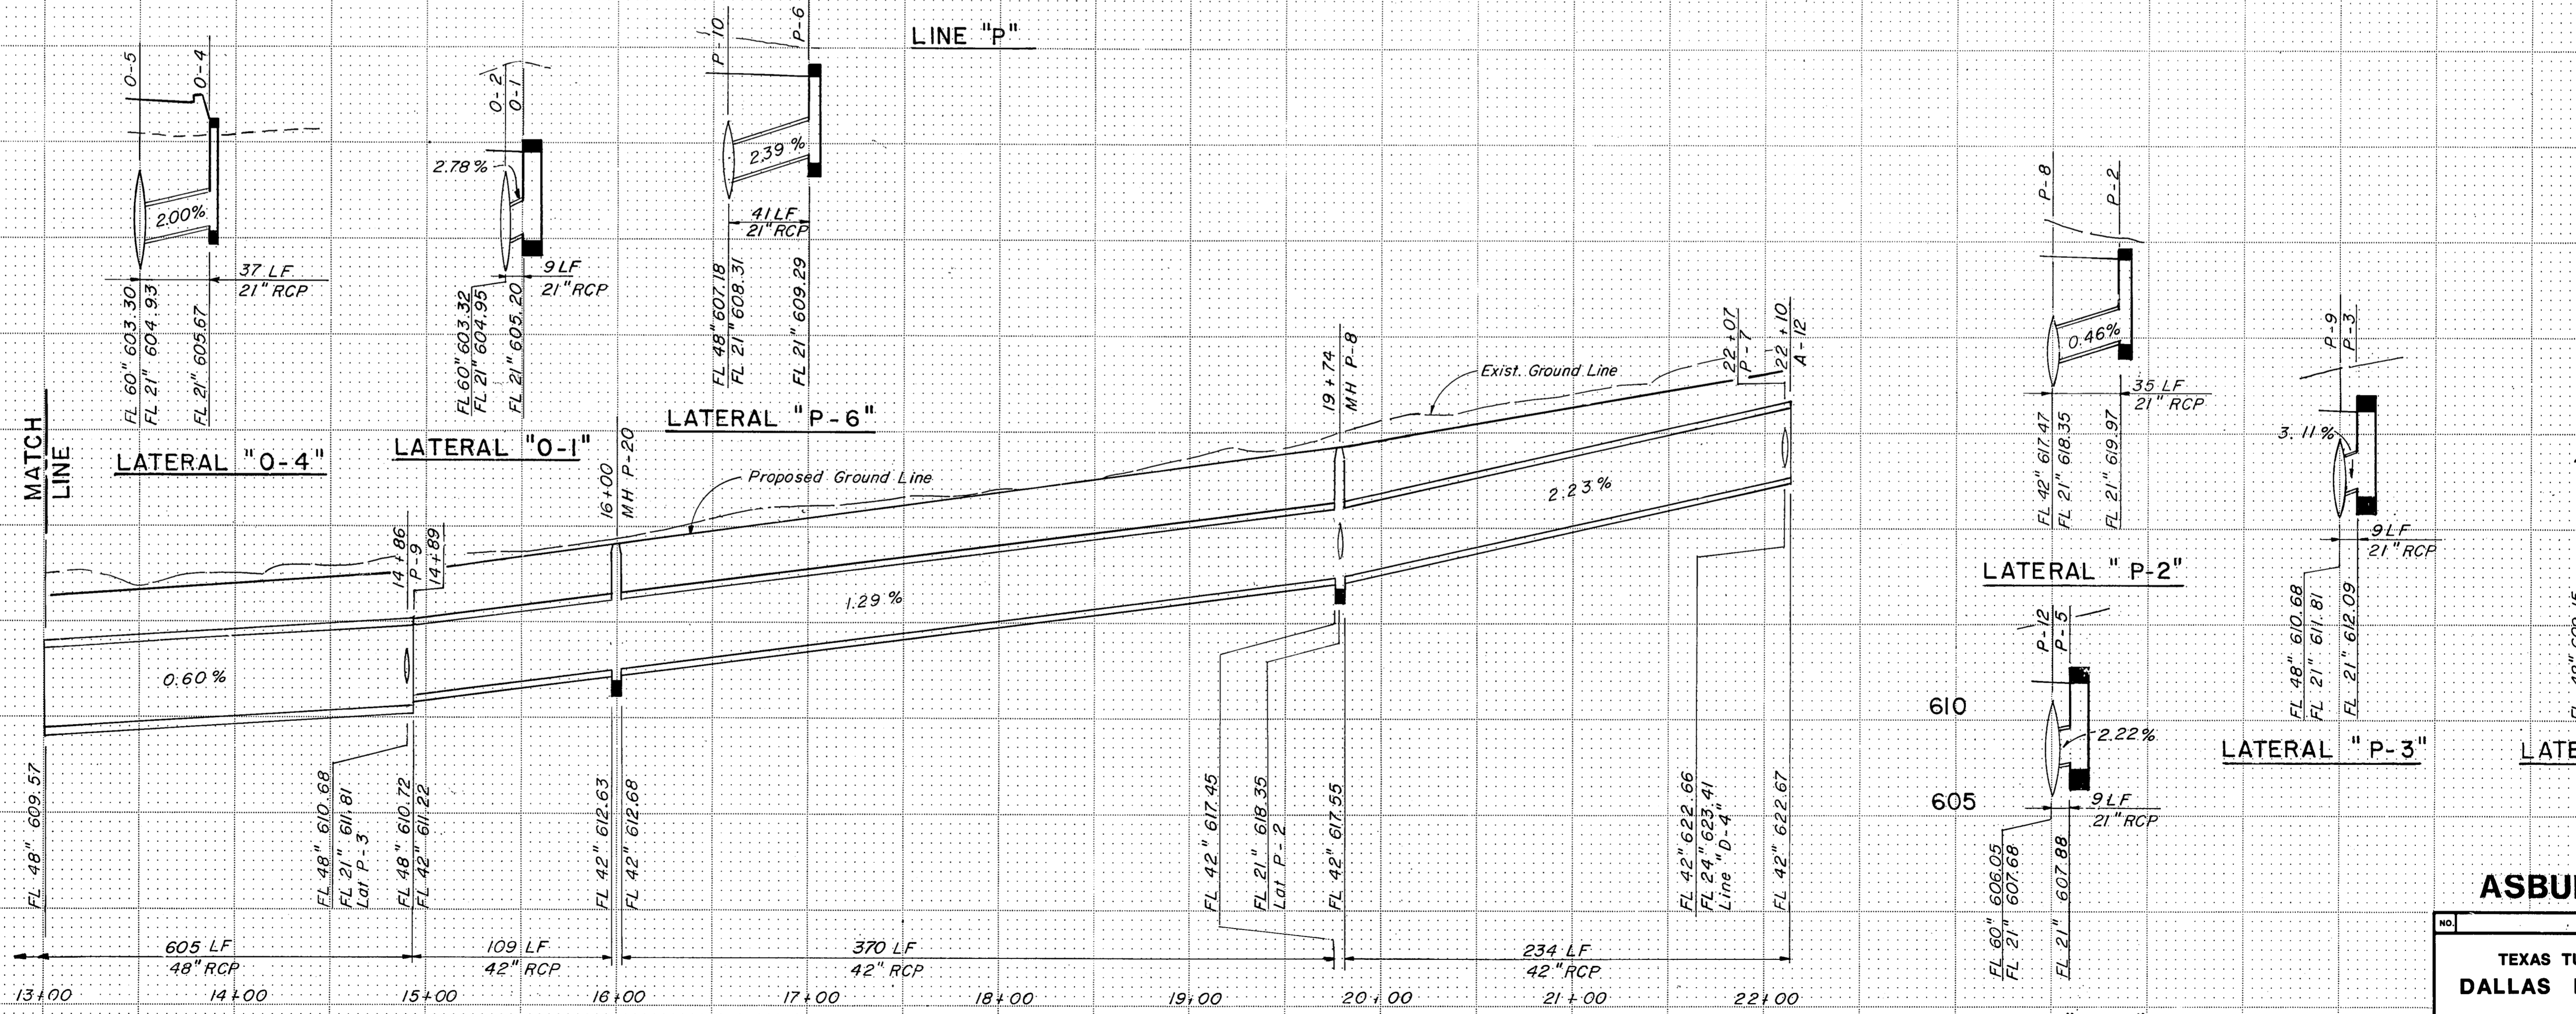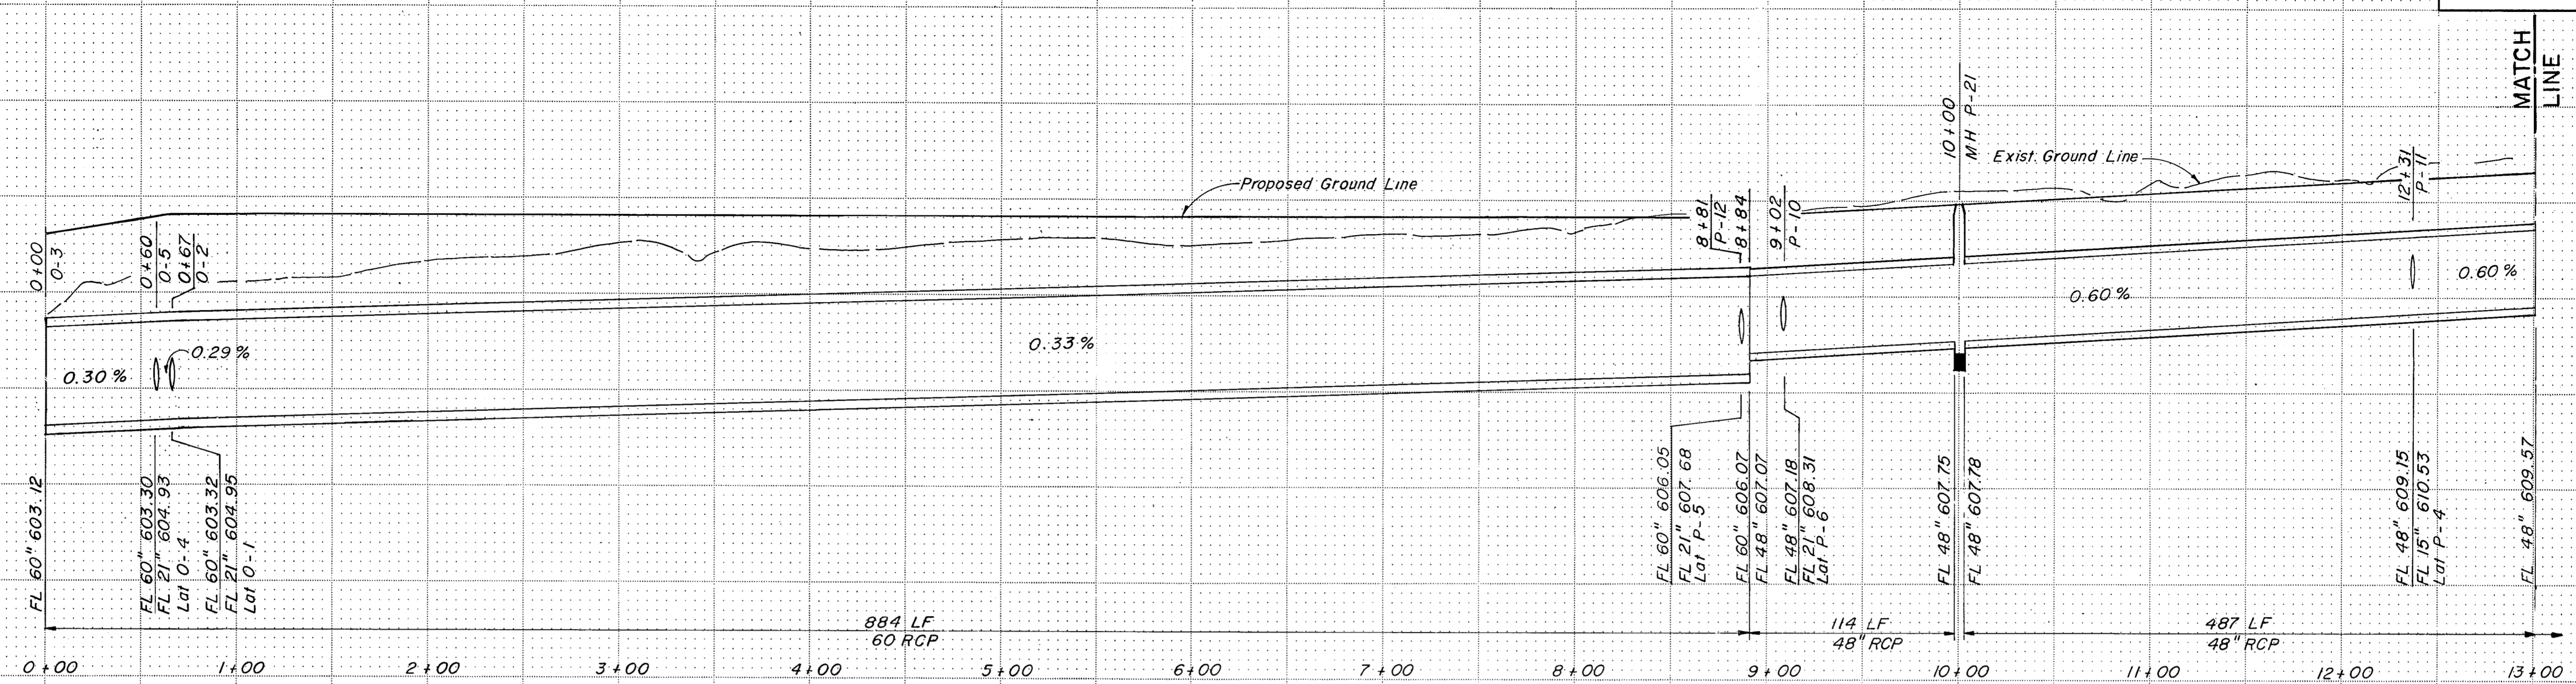






**ASBUILT PLANS**

NO.	REVISION	BY	DATE
TEXAS TURNPIKE AUTHORITY DALLAS NORTH TOLLWAY			
STORM SEWER PROFILES			
<b>Gibbs &amp; Hill, Inc.</b>			
MADE	AELT DATE 4/84	TRACED	MAV DATE 4/84
CHECKED	REW DATE 4/84	SCALE	1"=50'H T=5'V
CONTRACT NO. DNT-115 SHEET R57 OF R85			

STORM SEWER LINE : "P"  
 LATERAL : "O-4", "P-2", "P-3", "P-4", "P-5"  
 "O-1", "P-6"



Change Cross-Slope on N. B. Dallas Parkway		MGB	5-16-86
NO.	REVISION	BY	DATE

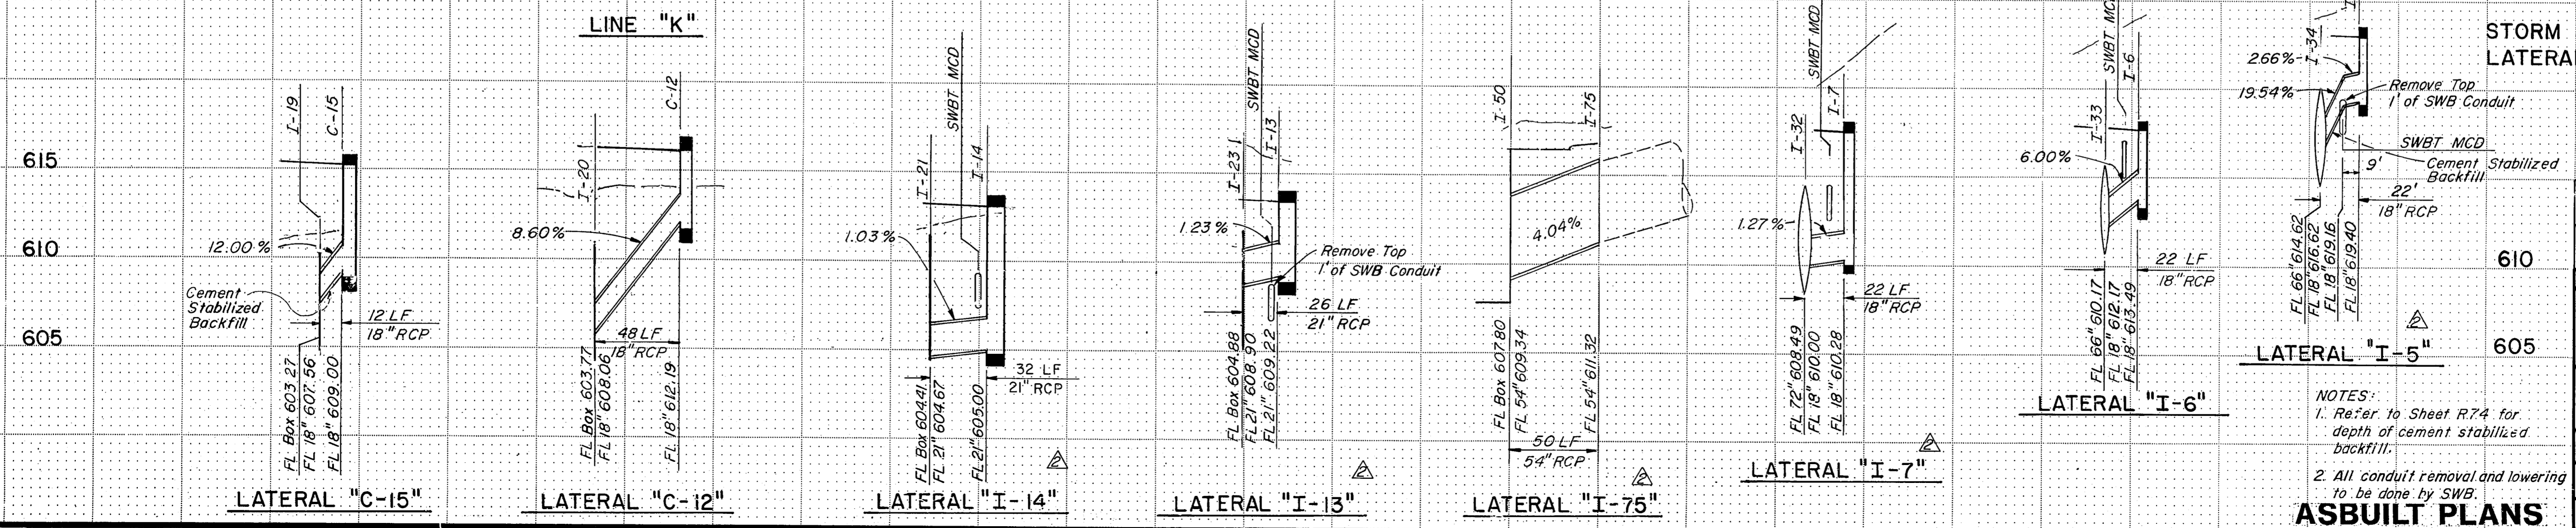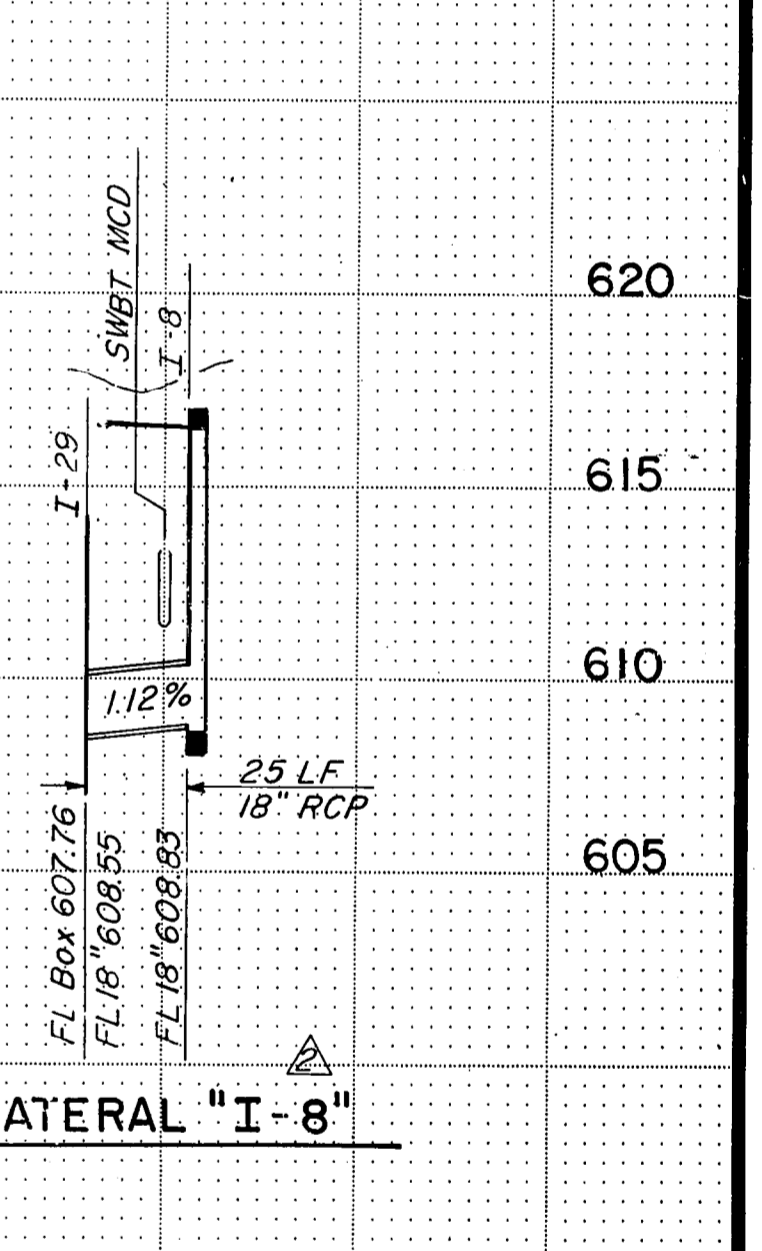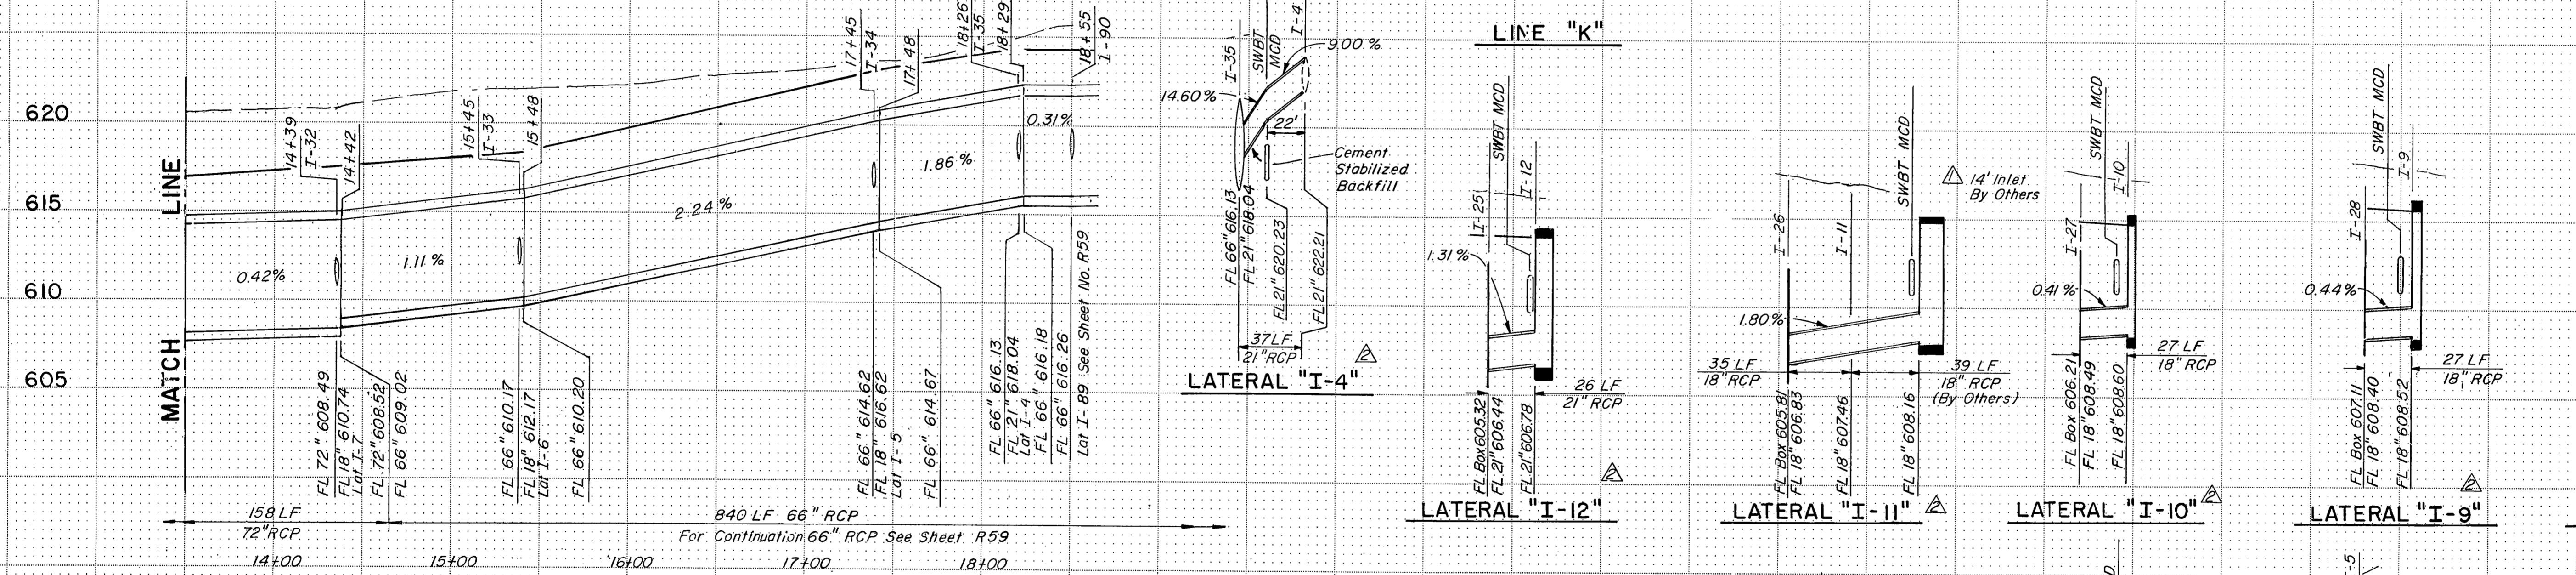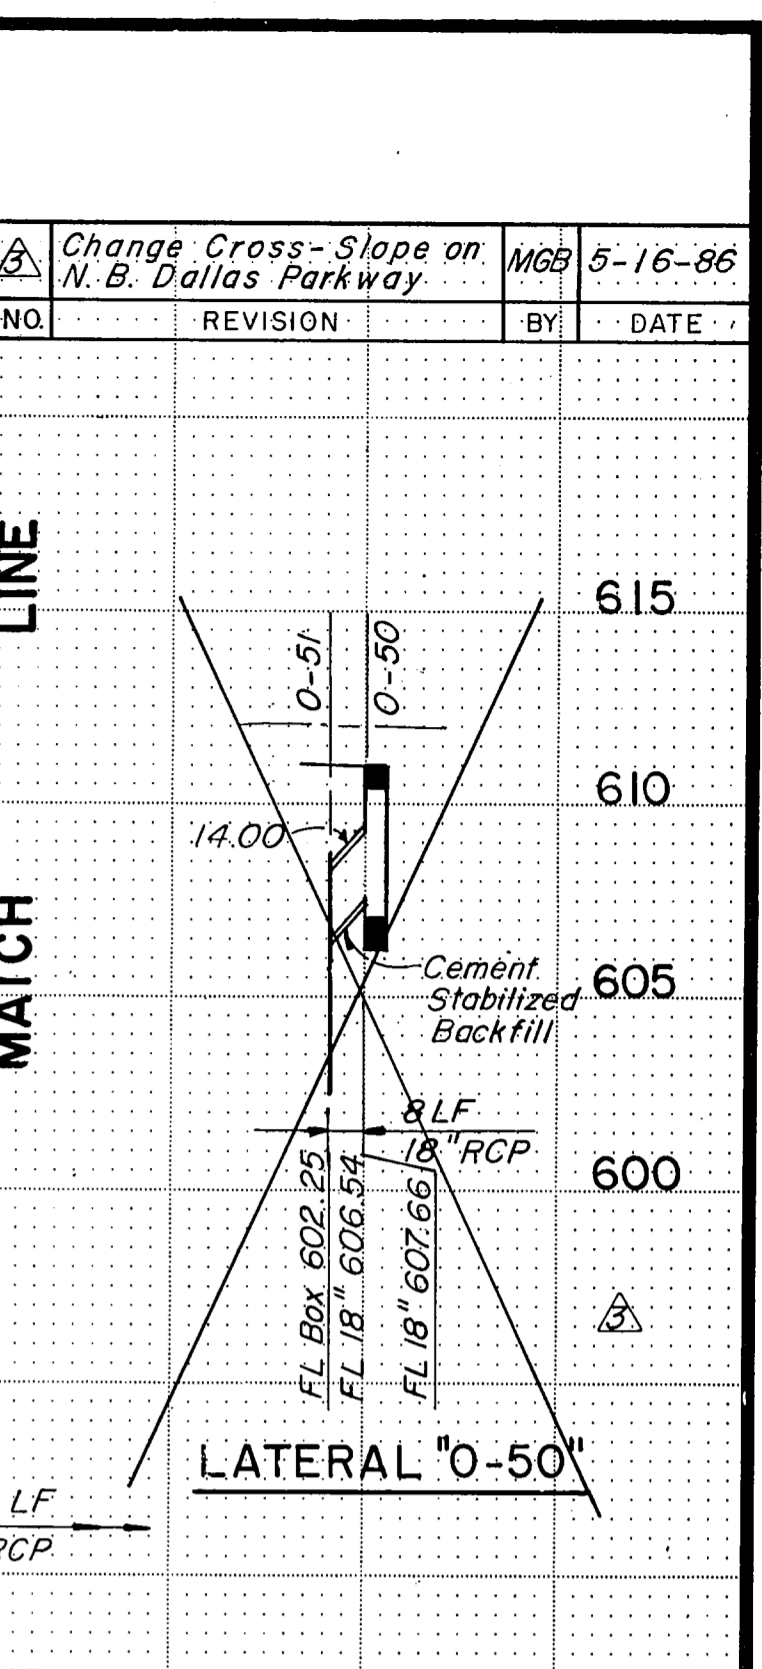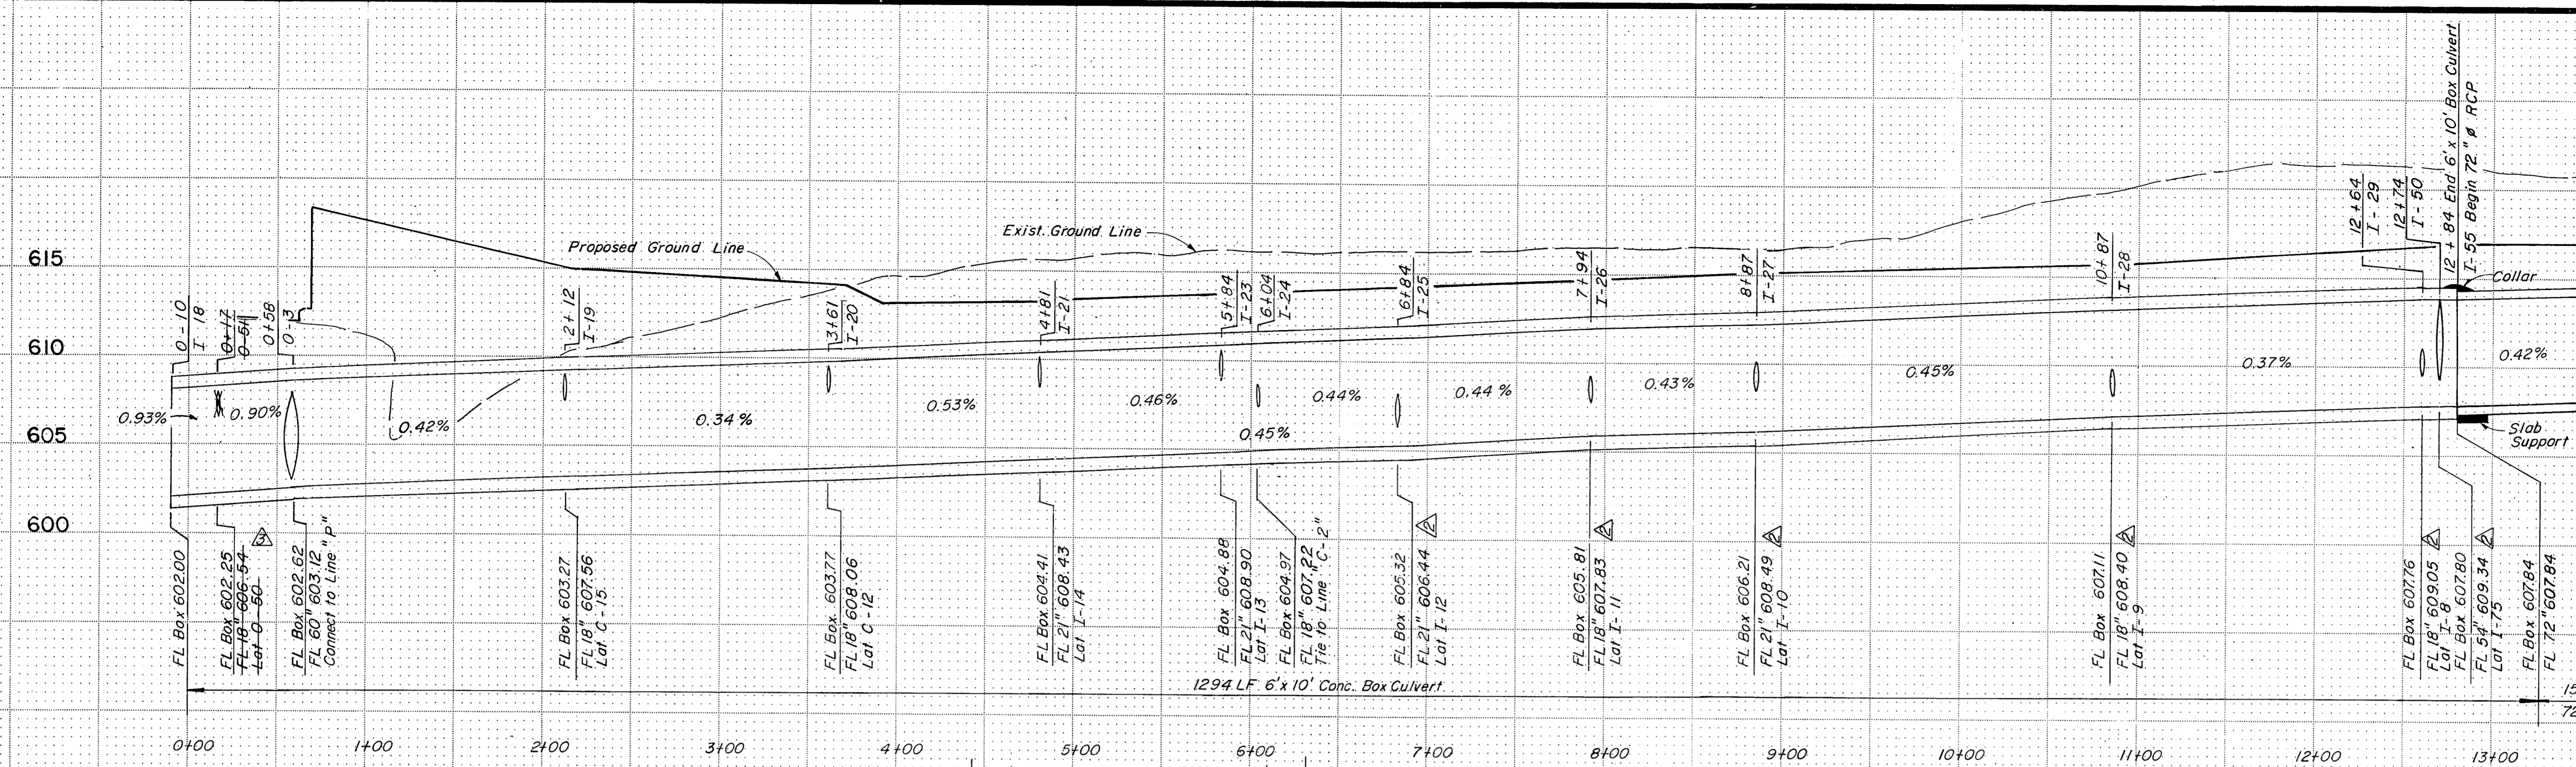

**STORM SEWER LINE: "K"**  
**LATERALS: "C-12", "C-15", "I-4", "I-5", "I-6", "I-7", "I-8", "I-9", "I-10", "I-11", "I-12", "I-13", "I-14", "I-75", "O-50", etc.**

Revised Due SWB Utility Conflict	MGB	3-14-85
Inlet I-11 Replaced By Inlet By Others	MGB	2-8-85

NO. REVISION BY DATE

**TEXAS TURNPIKE AUTHORITY**  
**DALLAS NORTH TOLLWAY**

**STORM SEWER PROFILES**

**Gibbs & Hill, Inc.**


MADE AELT DATE 12/83 TRACED GWK DATE 12/83  
 CHECKED REW DATE 4/84 SCALE 1"=50'H 1"=5'V

**ASBULT PLANS**

CONTRACT NO. DNT-115 SHEET R58 OF R85

**NOTES:**  
 1. Refer to Sheet R74 for depth of cement stabilized backfill.  
 2. All conduit removal and lowering to be done by SWB.



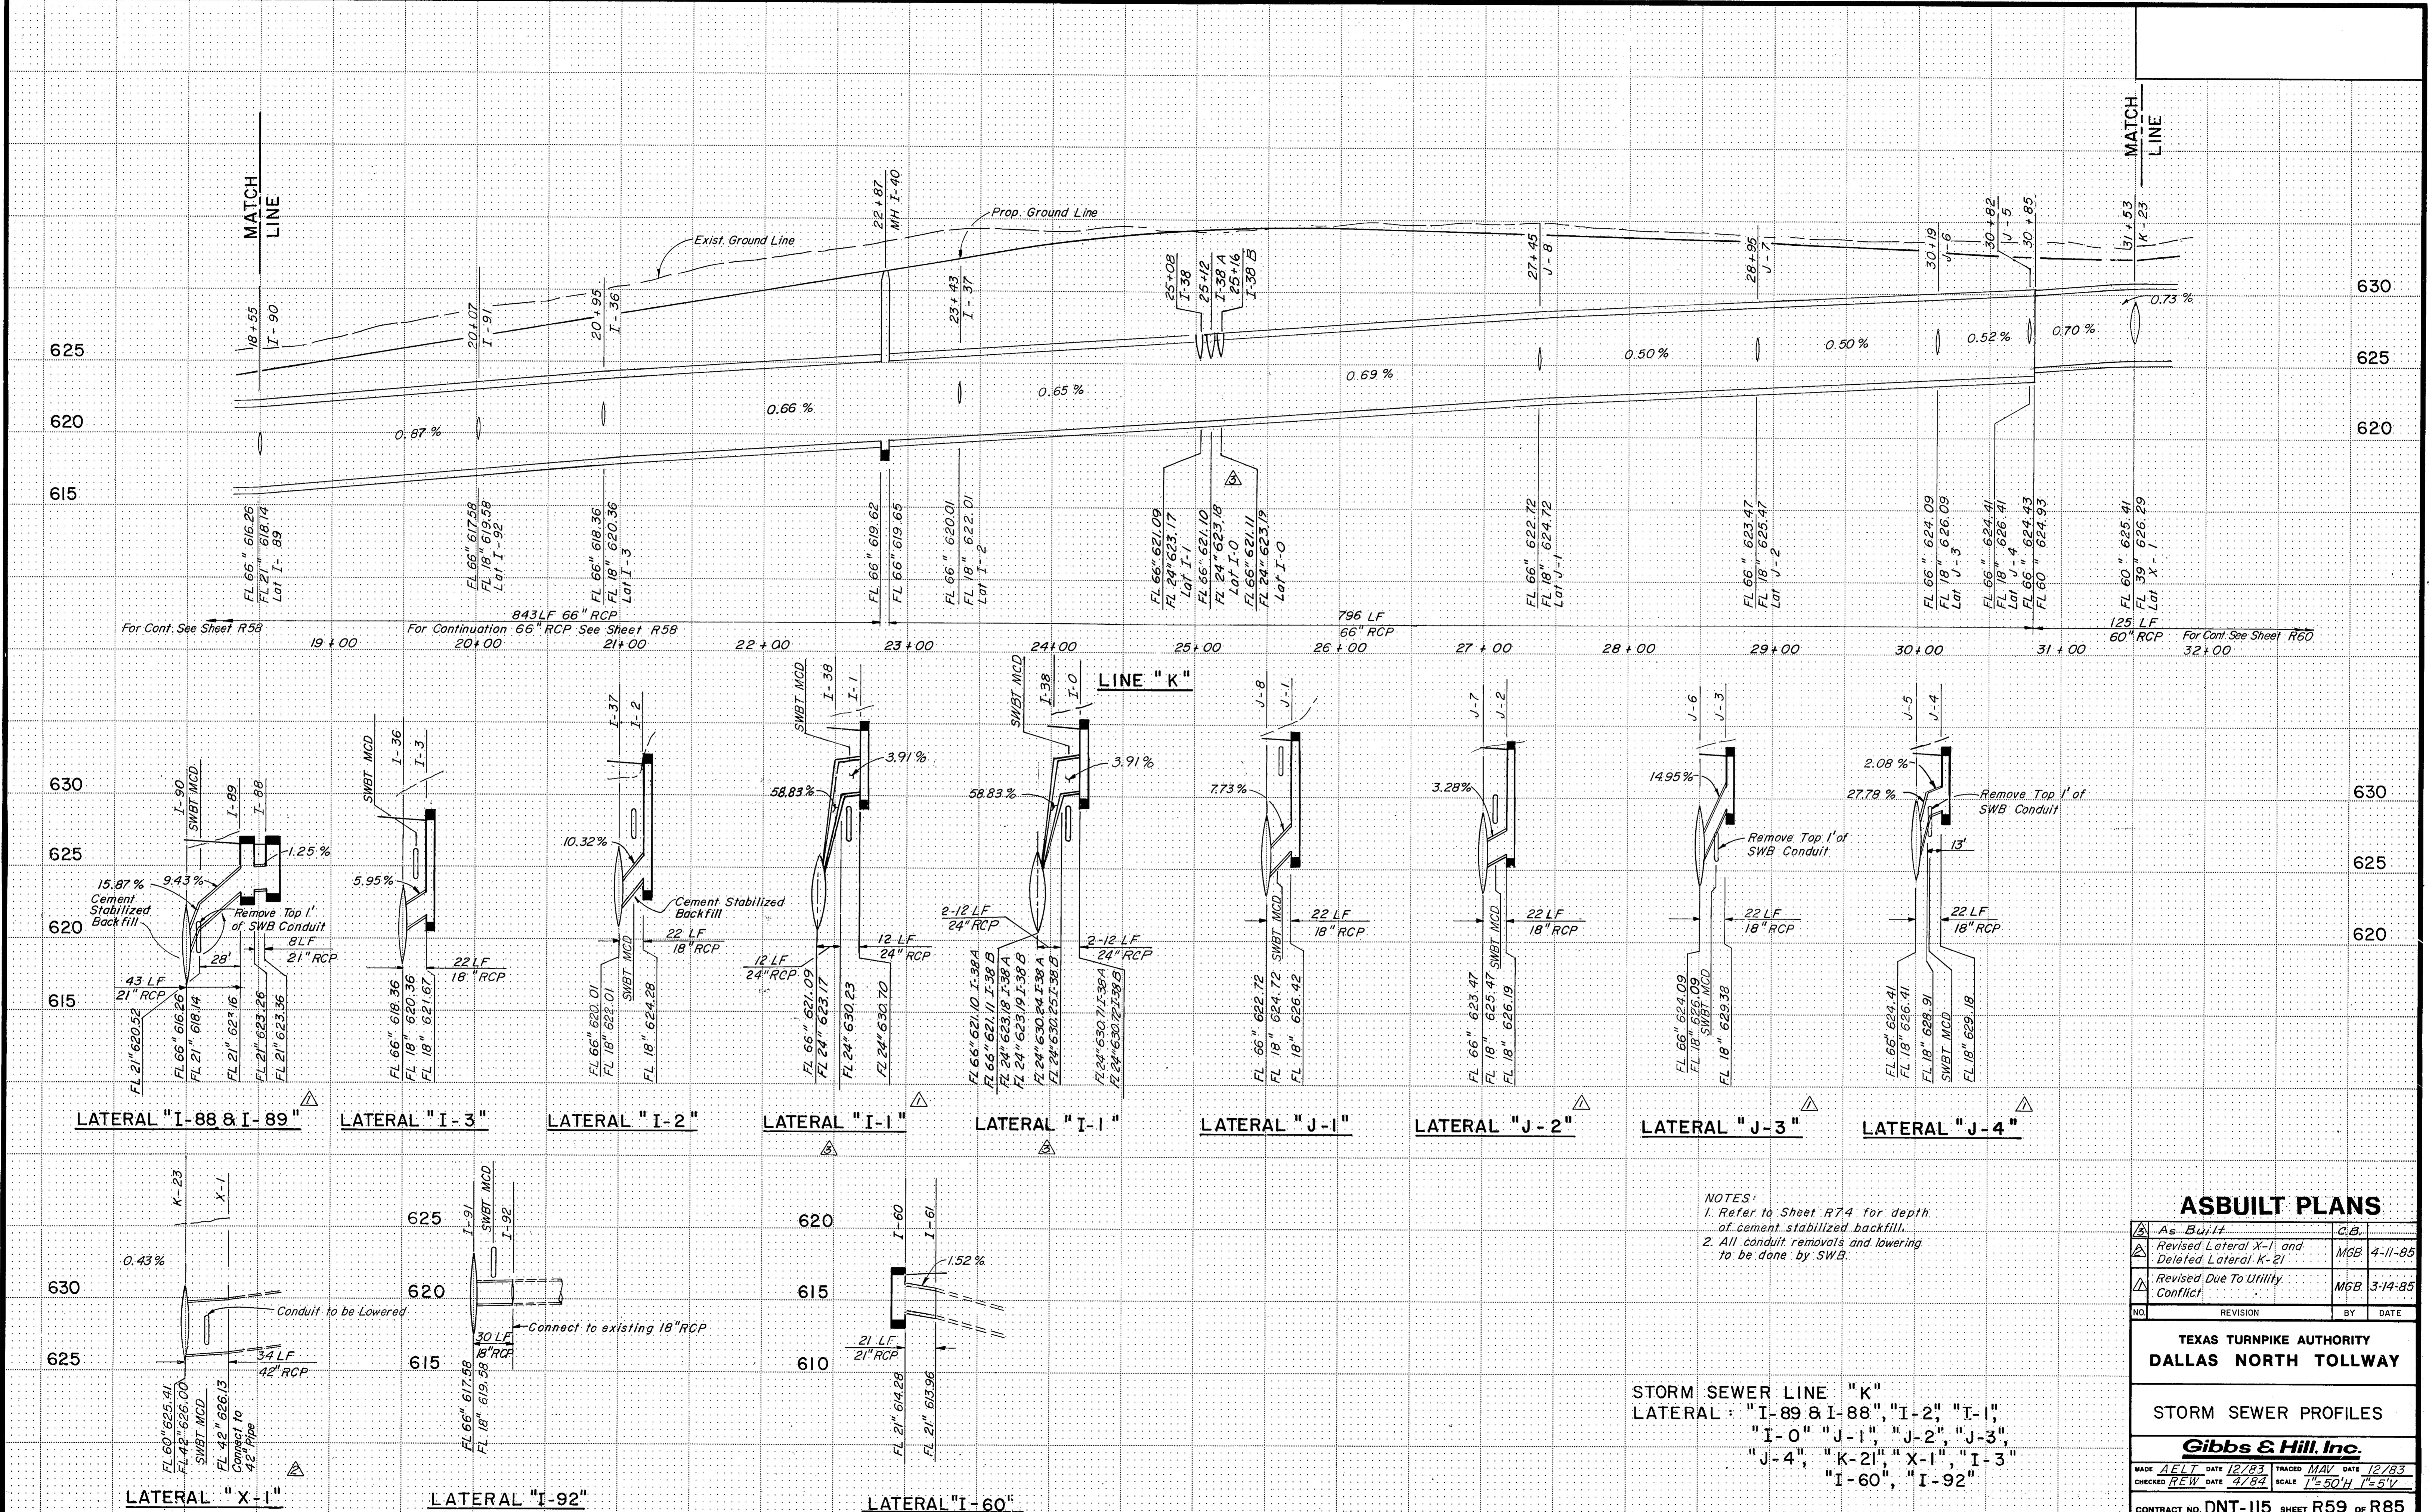

NOTES:  
 1. Refer to Sheet R74 for depth of cement stabilized backfill.  
 2. All conduit removals and lowering to be done by SWB.

**ASBUILT PLANS**

As Built	C.B.		
Revised Lateral X-1 and Deleted Lateral K-21	MGB 4-11-85		
Revised Due To Utility Conflict	MGB 3-14-85		
NO	REVISION	BY	DATE

TEXAS TURNPIKE AUTHORITY  
 DALLAS NORTH TOLLWAY

STORM SEWER PROFILES



**Gibbs & Hill, Inc.**

MADE A/E/T DATE 12/83 TRACED M/V DATE 12/83  
 CHECKED R/W DATE 4/84 SCALE 1"=50'H 1"=5'V

CONTRACT NO. DNT-115 SHEET R59 OF R85

STORM SEWER LINE "K"  
 LATERAL: "I-89 & I-88", "I-2", "I-1",  
 "I-0", "J-1", "J-2", "J-3",  
 "J-4", "K-21", "X-1", "I-3",  
 "I-60", "I-92"



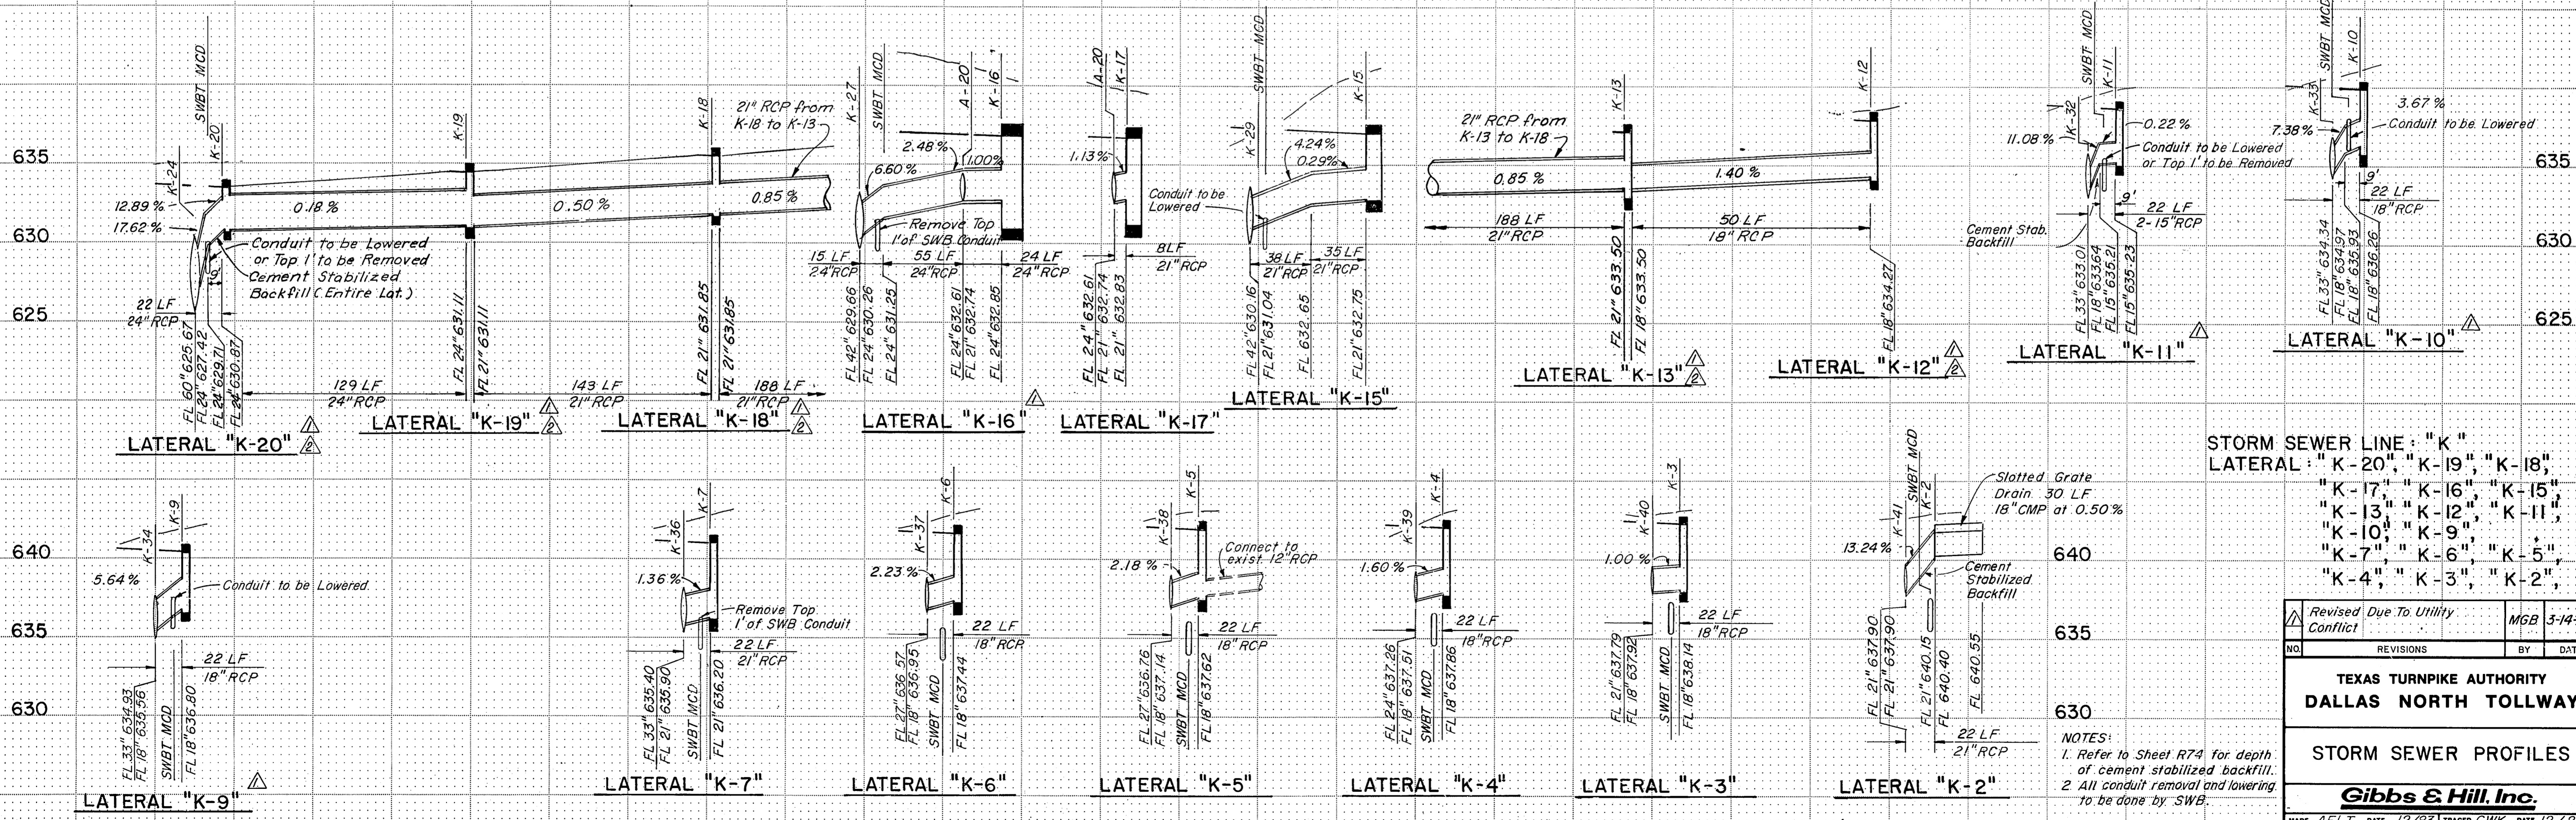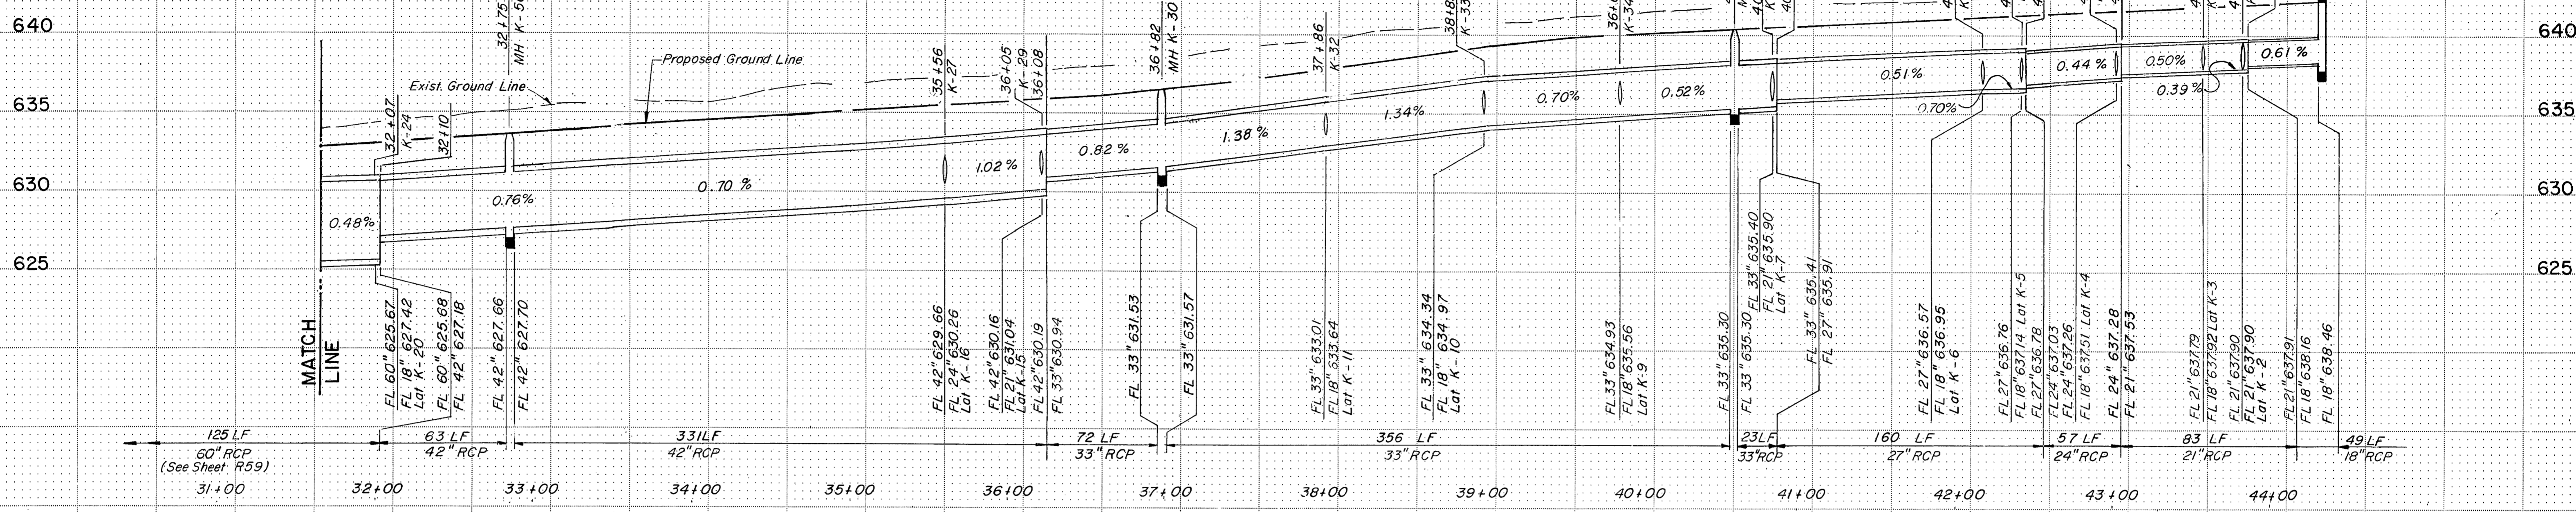

STORM SEWER LINE: "K"  
 LATERAL: "K-20", "K-19", "K-18",  
 "K-17", "K-16", "K-15",  
 "K-13", "K-12", "K-11",  
 "K-10", "K-9", "K-8",  
 "K-7", "K-6", "K-5",  
 "K-4", "K-3", "K-2".

Revised Due To Utility Conflict		MGB	3-14-85
NO.	REVISIONS	BY	DATE

TEXAS TURNPIKE AUTHORITY  
 DALLAS NORTH TOLLWAY

STORM SEWER PROFILES

Gibbs & Hill, Inc.

ASBUILT PLANS


MADE AELT DATE 12/83 TRACED GWK DATE 12/83  
 CHECKED REW DATE 4/84 SCALE 1"=50'H 1"=5'V

CONTRACT NO. DNT-115 SHEET R60 OF R85

As Built C.B.




640  
635  
630  
625  
620

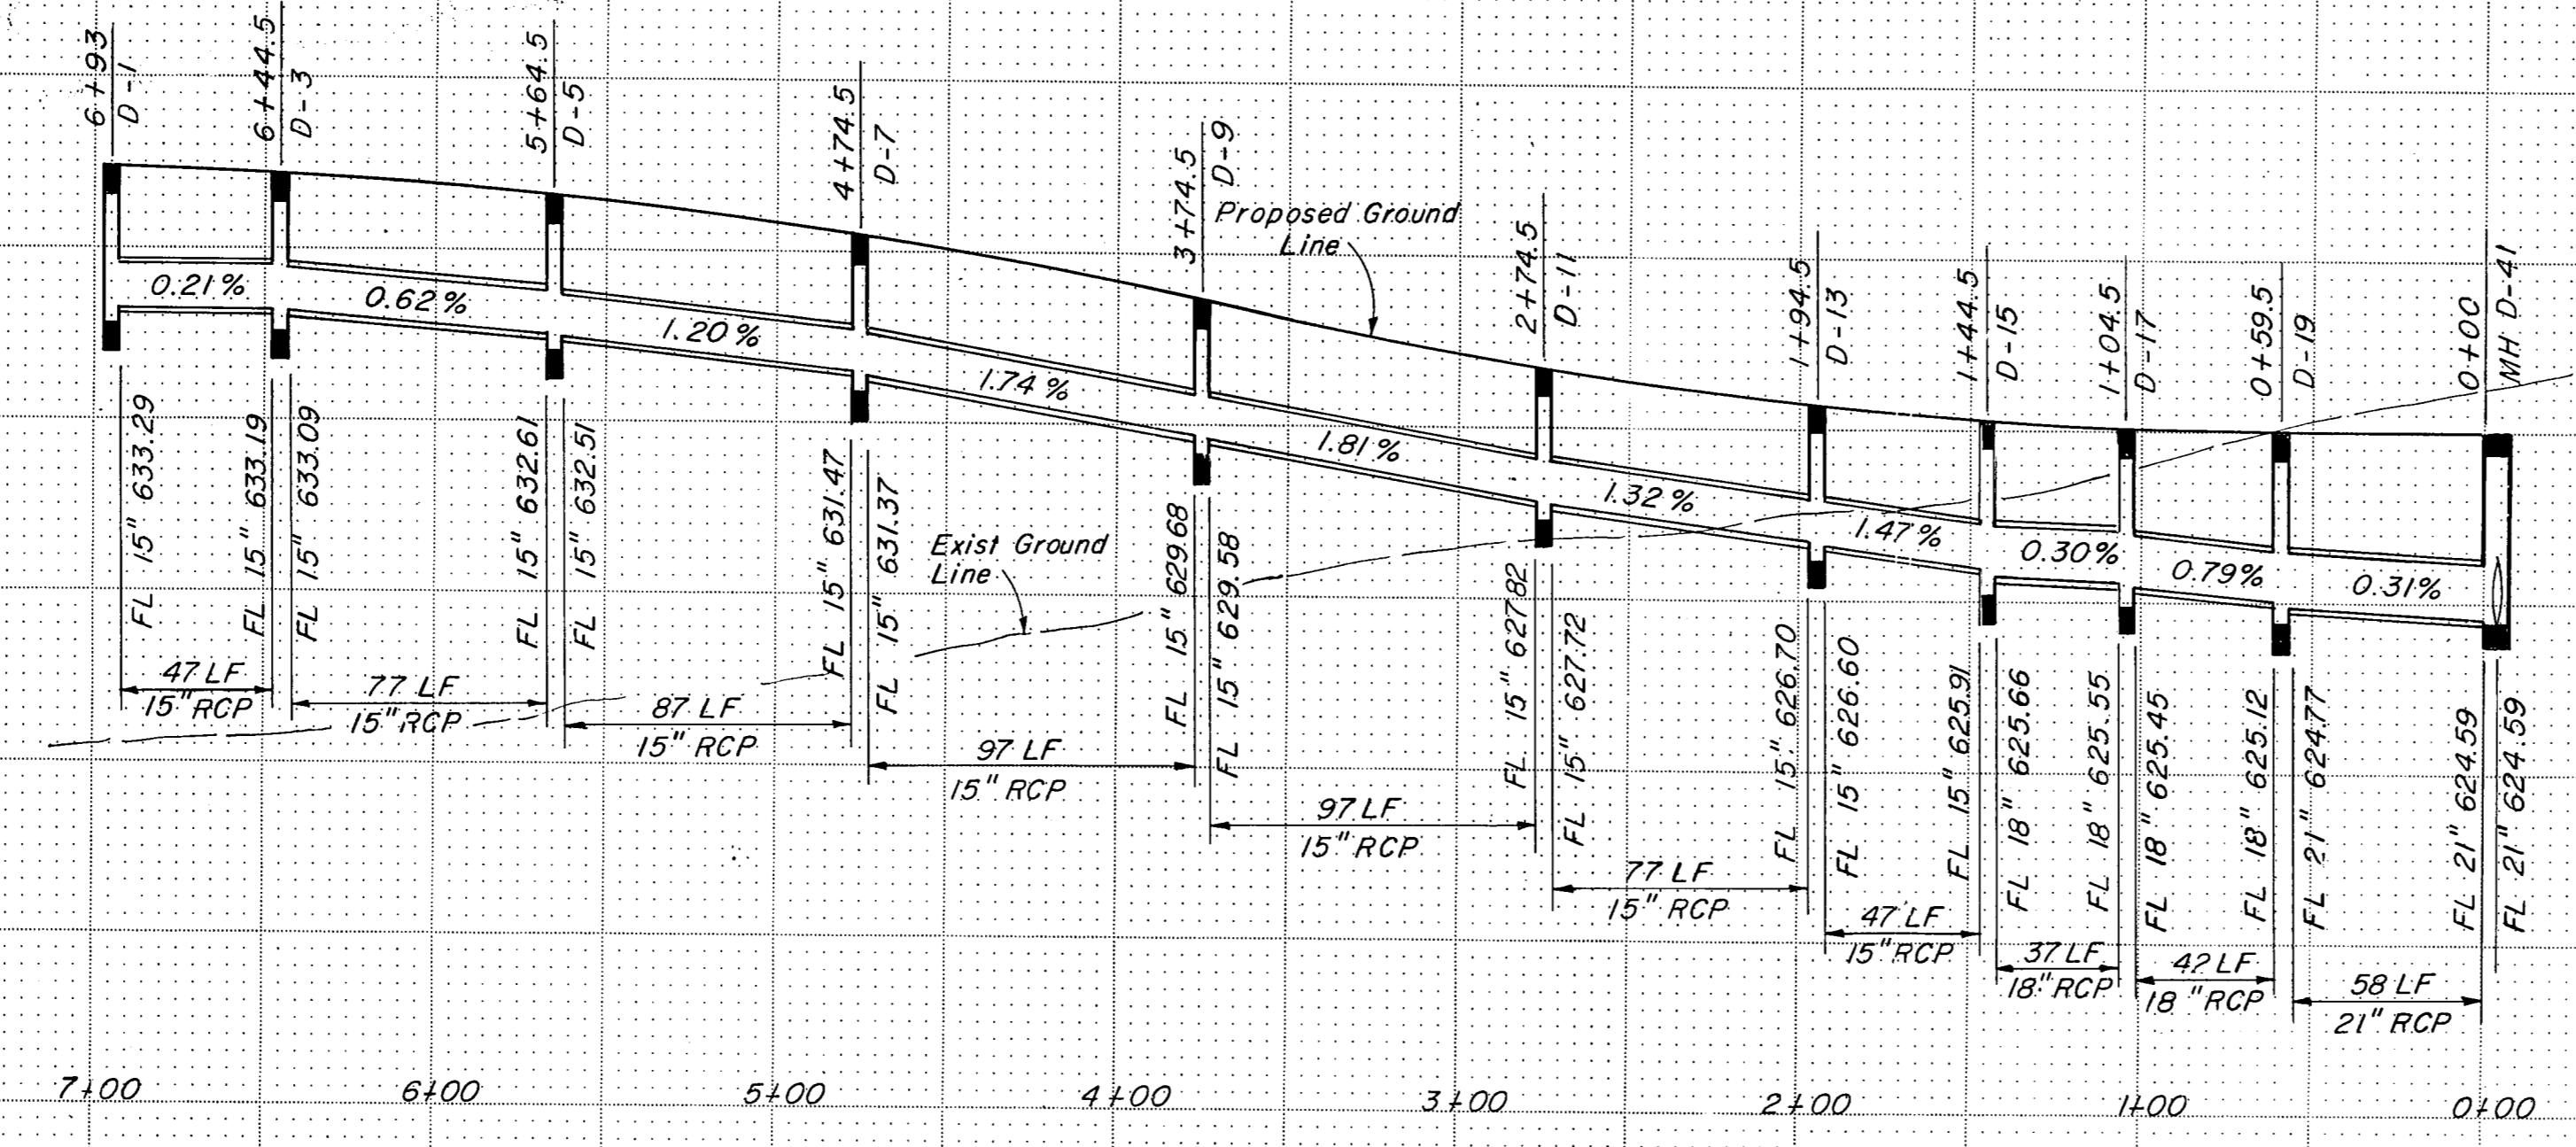

635  
630  
625  
620

LINE "D-1"

640  
635  
630  
625  
620

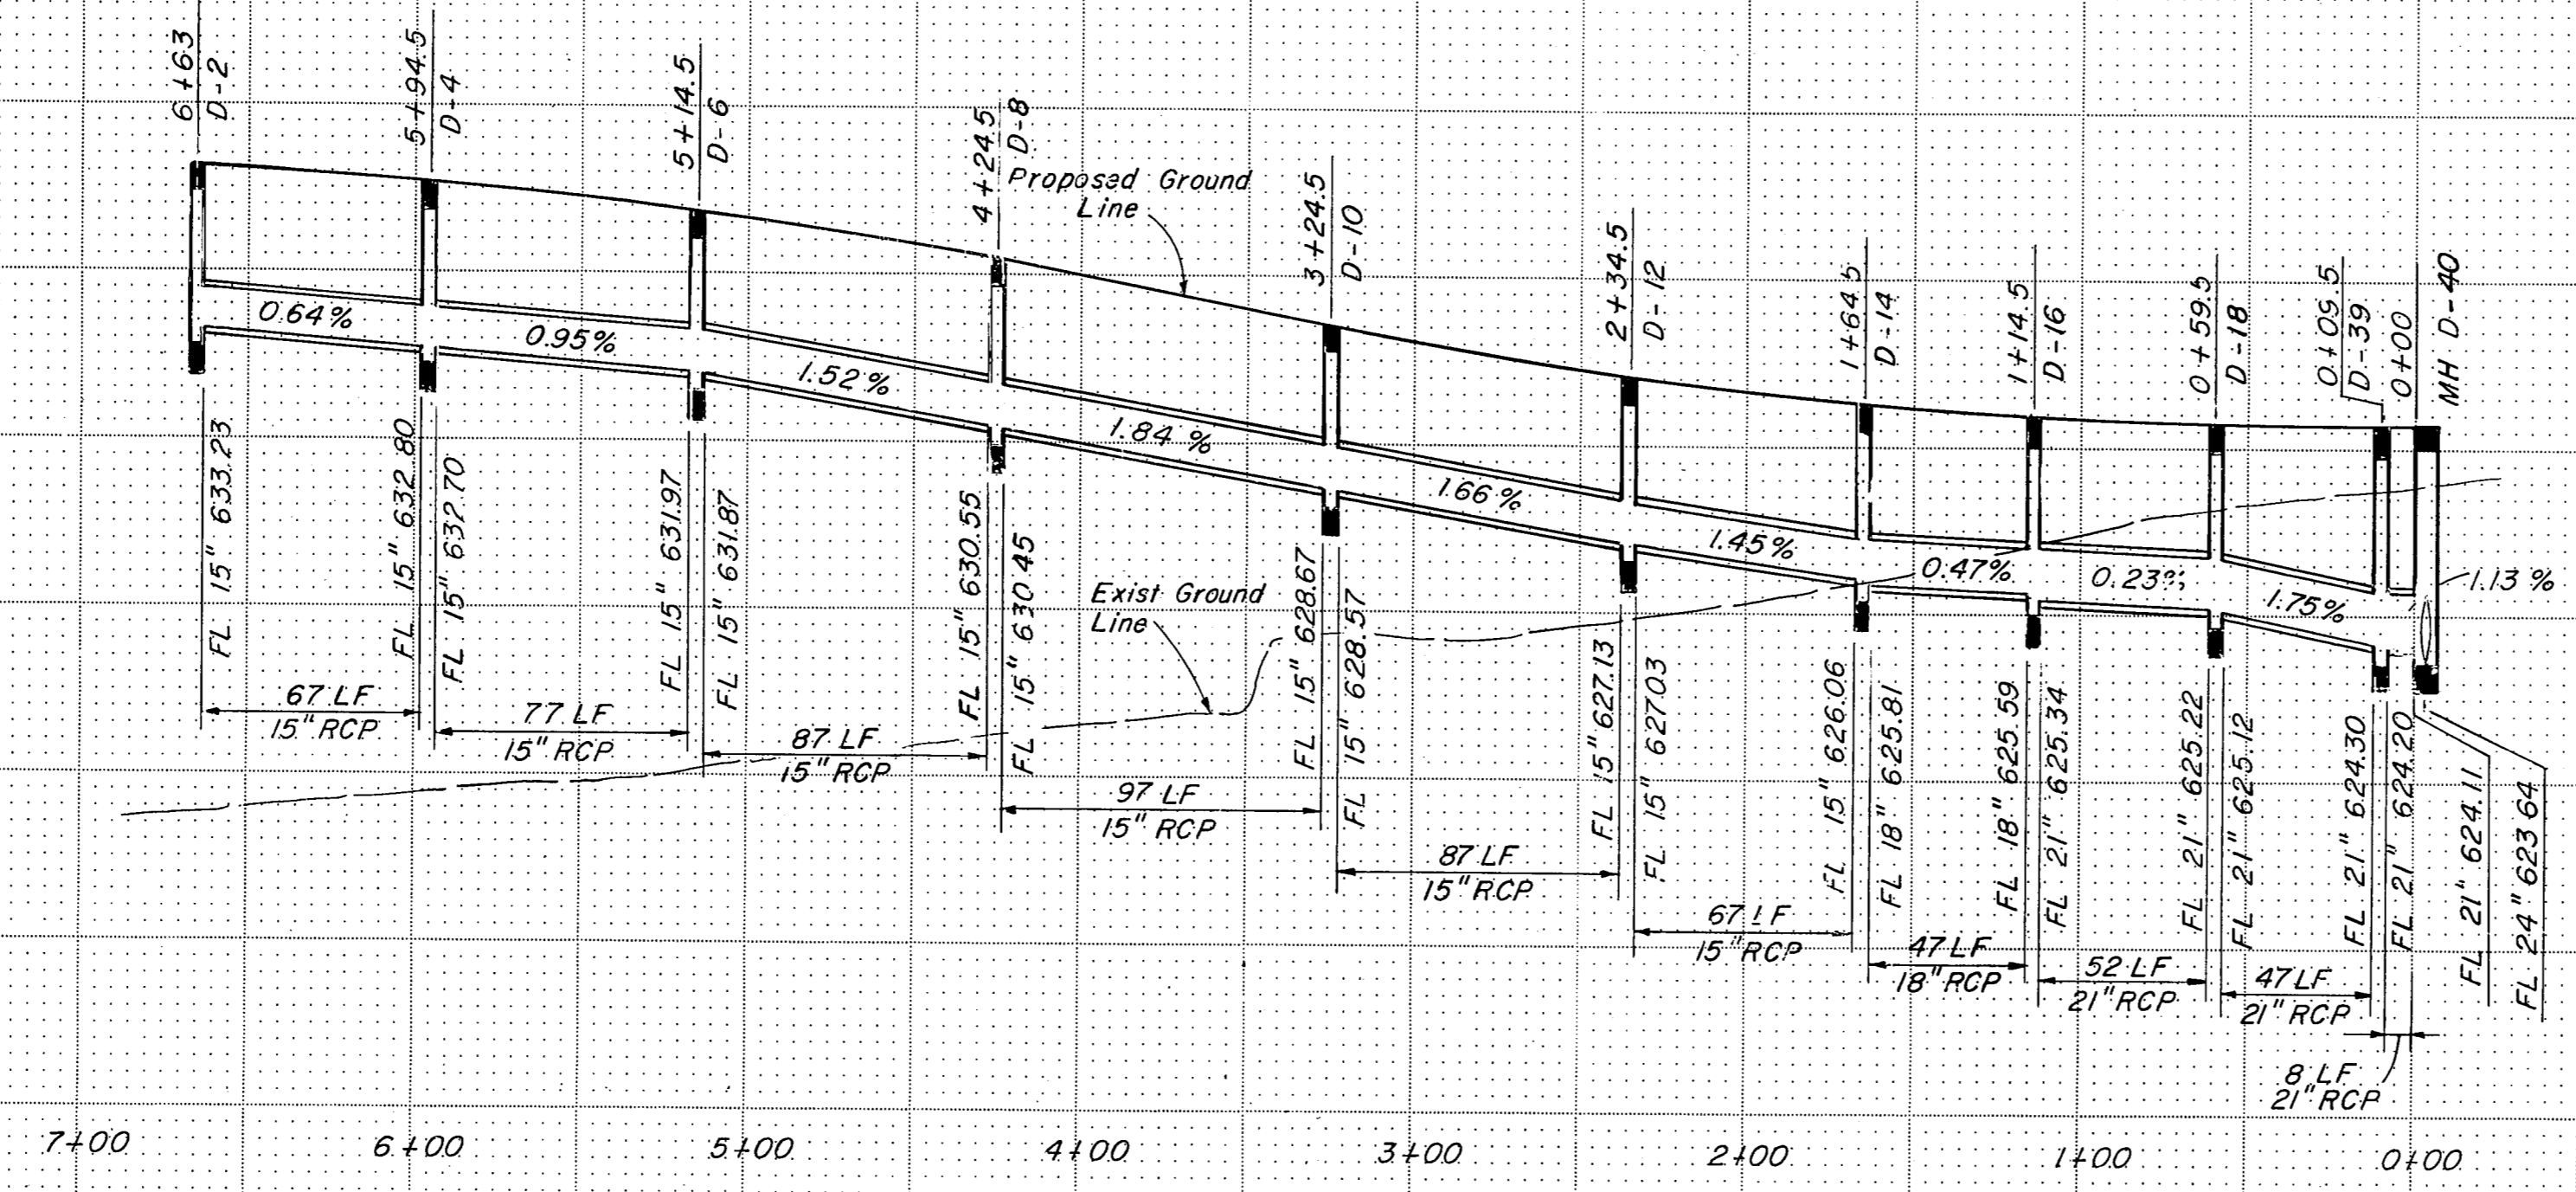

635  
630  
625  
620




LINE "D-2"

STORM SEWER LINE: "D-1", "D-2"

### ASBUILT PLANS

NO.	REVISION	BY	DATE
TEXAS TURNPIKE AUTHORITY DALLAS NORTH TOLLWAY			
STORM SEWER PROFILES			
<b>Gibbs &amp; Hill, Inc.</b>			
MADE	DATE 4/84	TRACED	DATE 4/84
CHECKED	DATE 4/84	SCALE	1"=50'H 1"=5'V
CONTRACT NO. DNT-115 SHEET R61 OF R85			




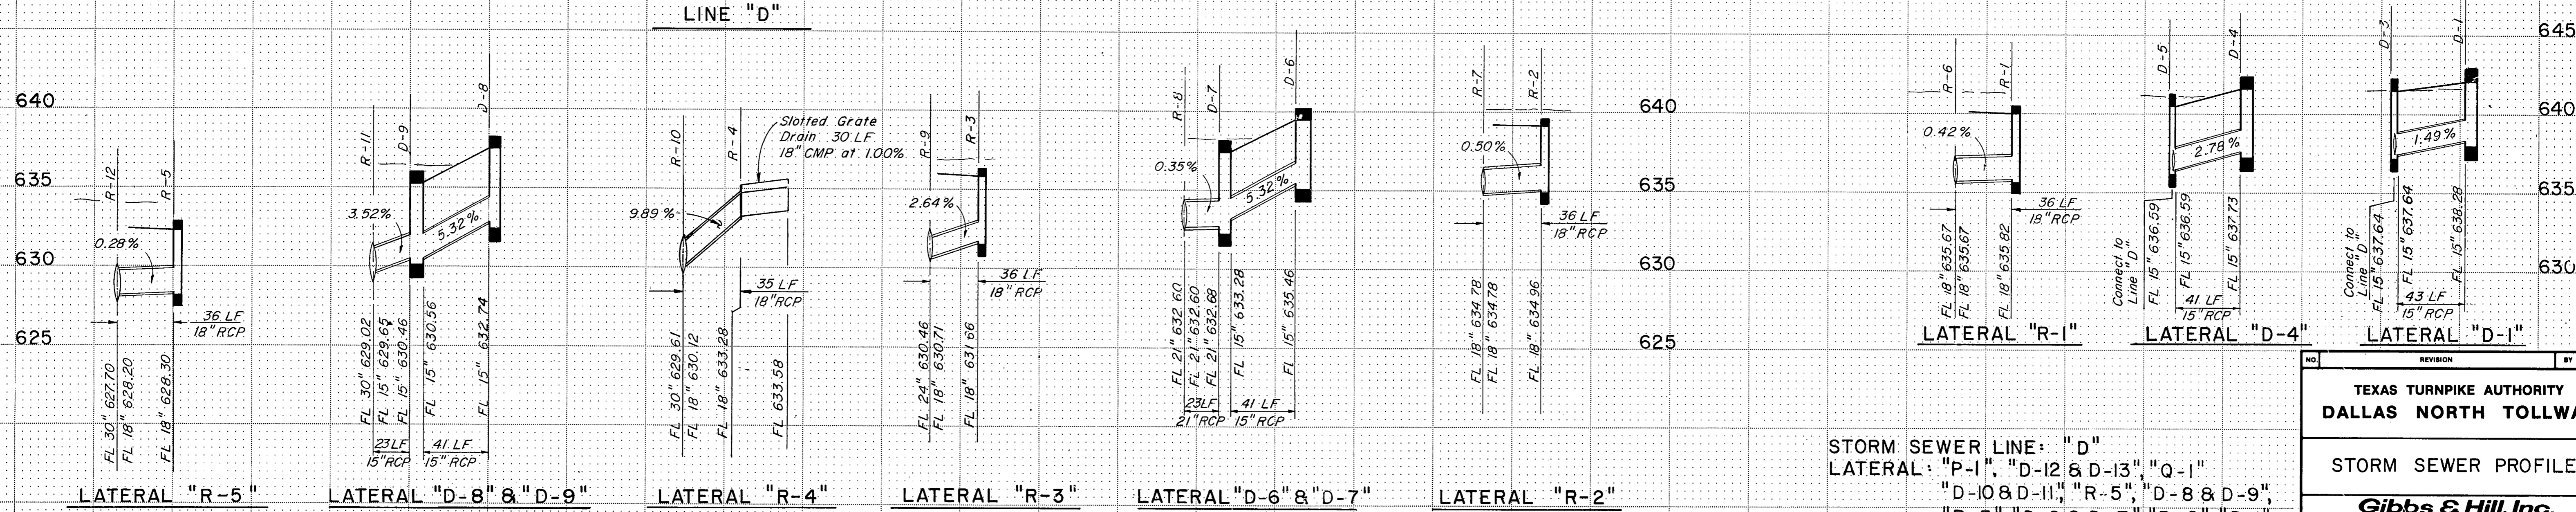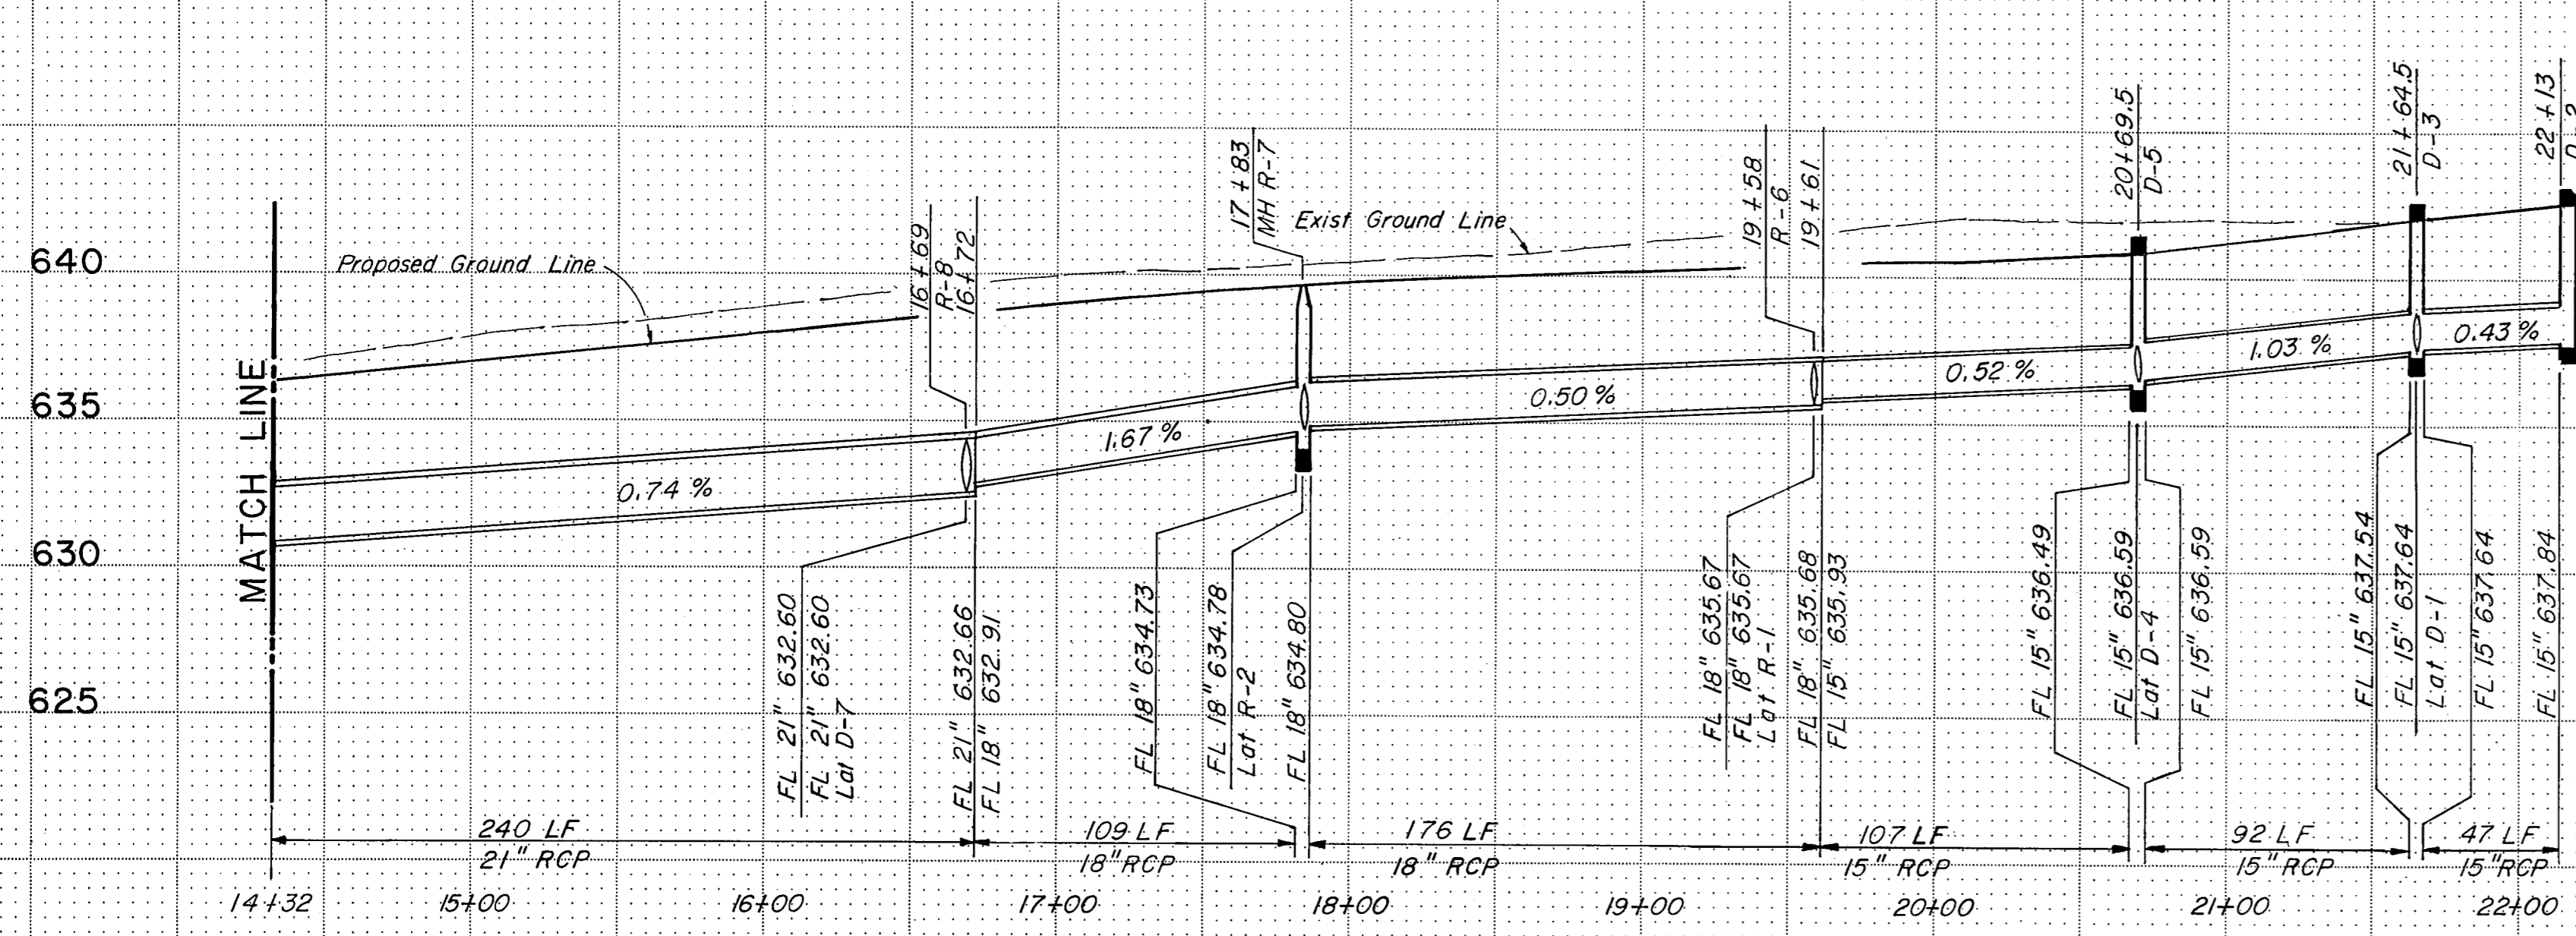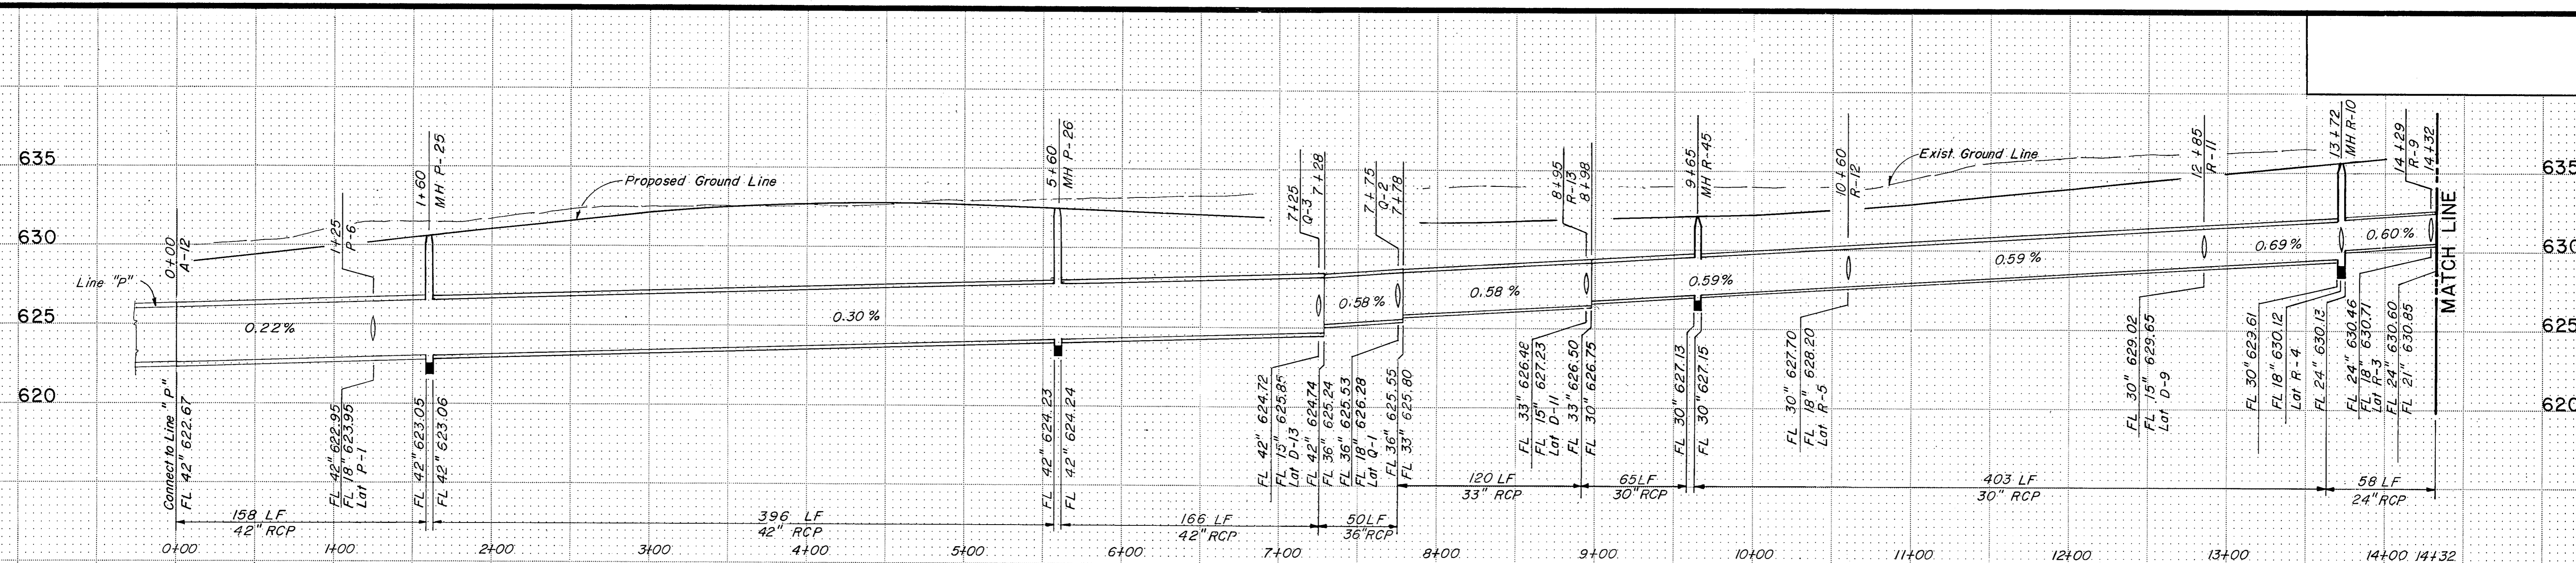


STORM SEWER LINE: "D"  
 LATERAL: "P-1", "D-12 & D-13", "Q-1",  
 "D-10 & D-11", "R-5", "D-8 & D-9",  
 "R-3", "D-6 & D-7", "R-2", "R-1",  
 "D-4", "D-1", "R-4"

NO.	REVISION	BY	DATE
TEXAS TURNPIKE AUTHORITY DALLAS NORTH TOLLWAY			
STORM SEWER PROFILES			
<b>Gibbs &amp; Hill, Inc.</b>			
MADE	A/E/T	DATE	4/84
TRACED	F/L/B	DATE	4/84
CHECKED	REV	DATE	4/84
SCALE	1"=50'H 1"=5'V		
ASBUILT PLANS			
CONTRACT NO. DNT-115 SHEET R62 OF R85			




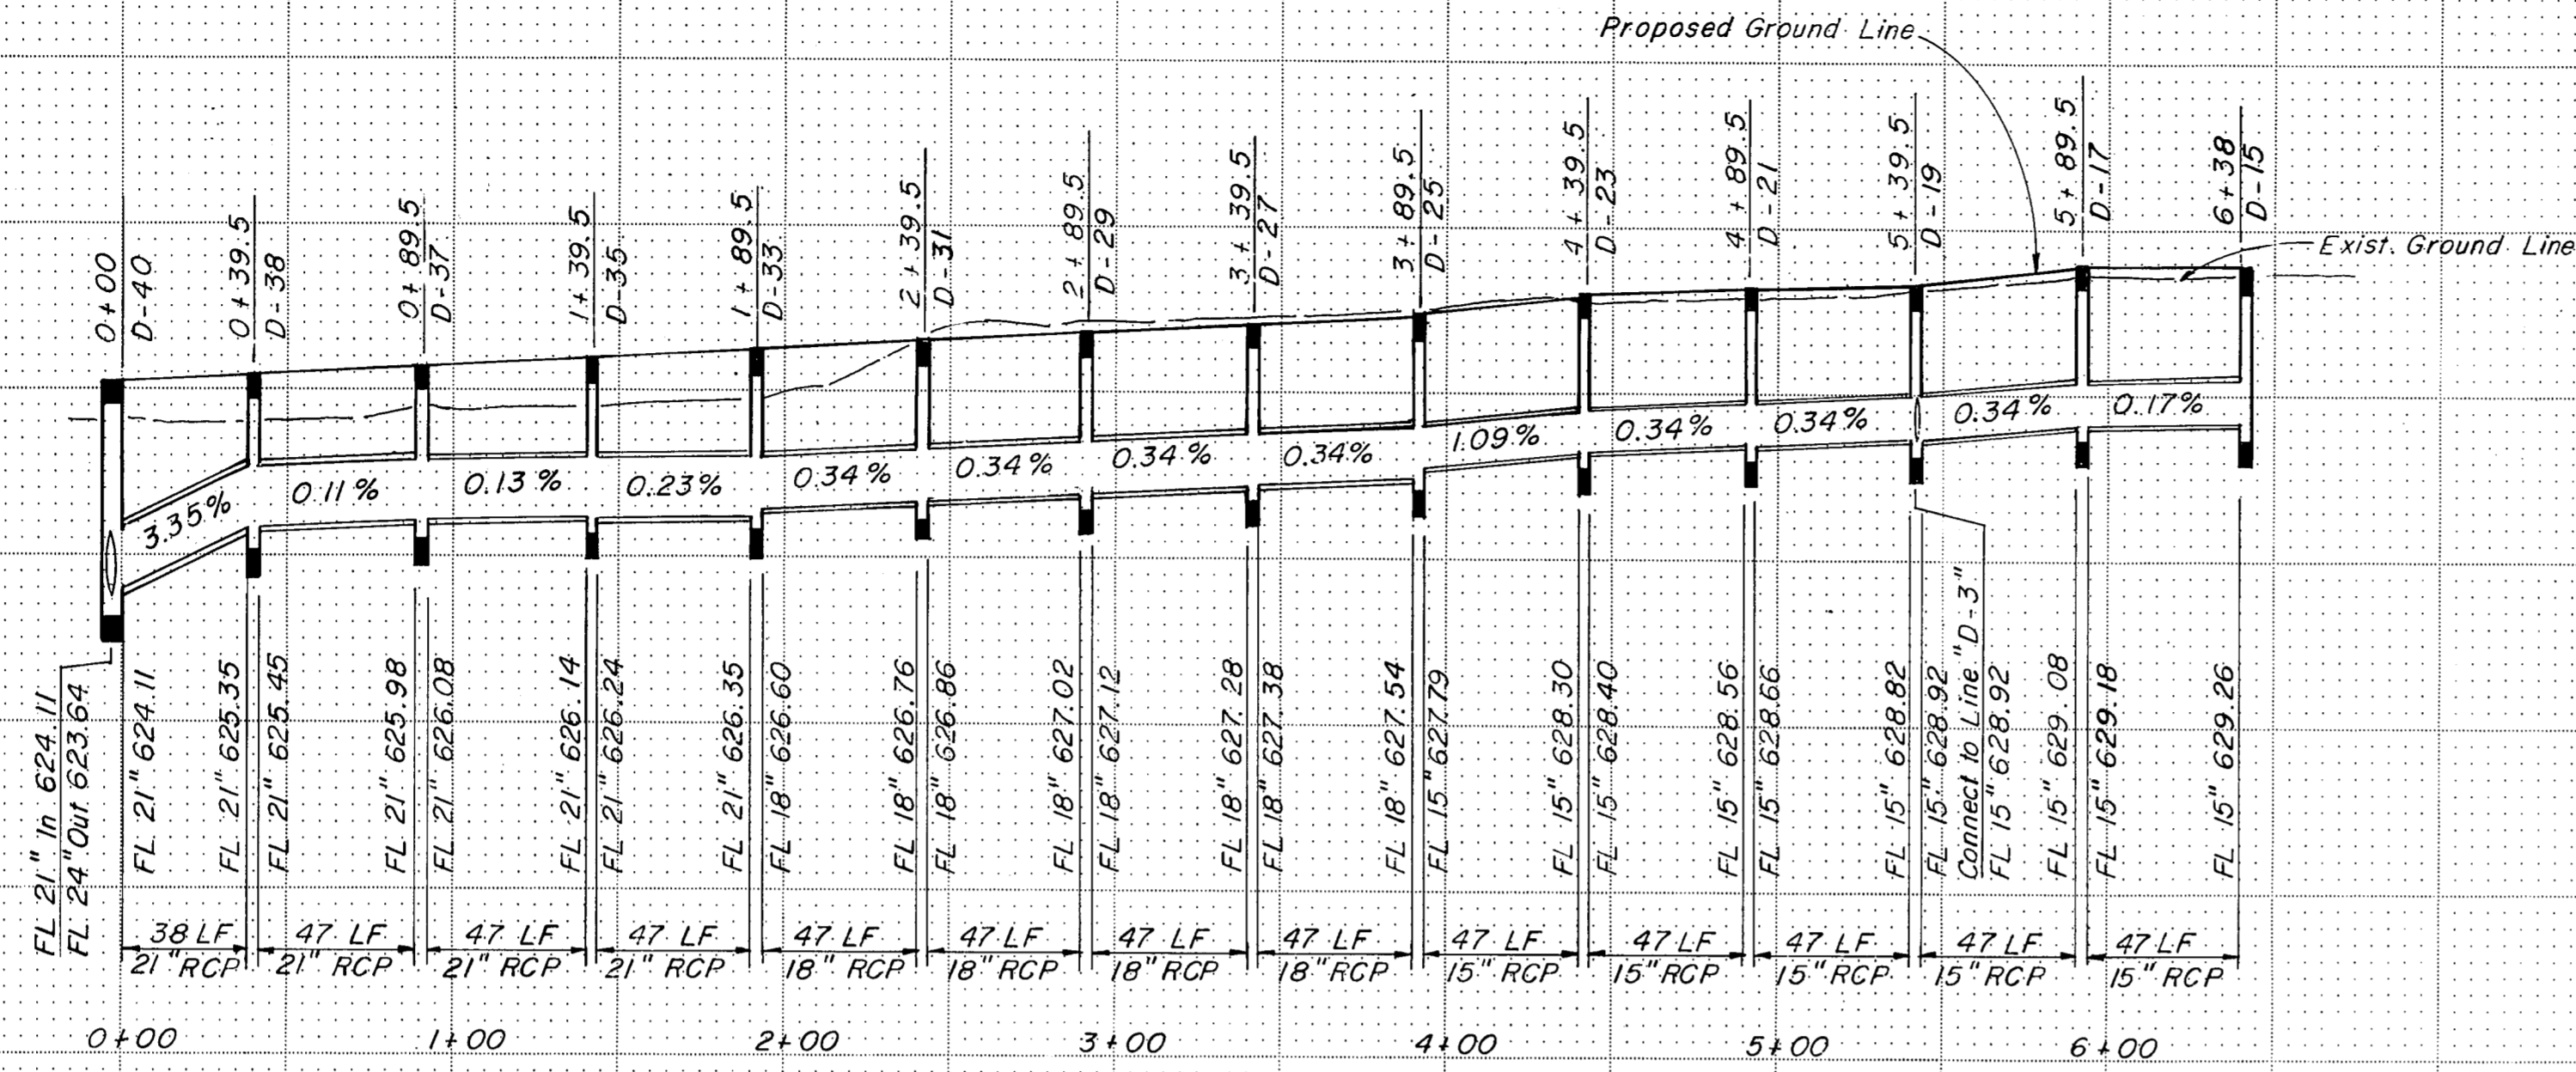

LINE "D-3"

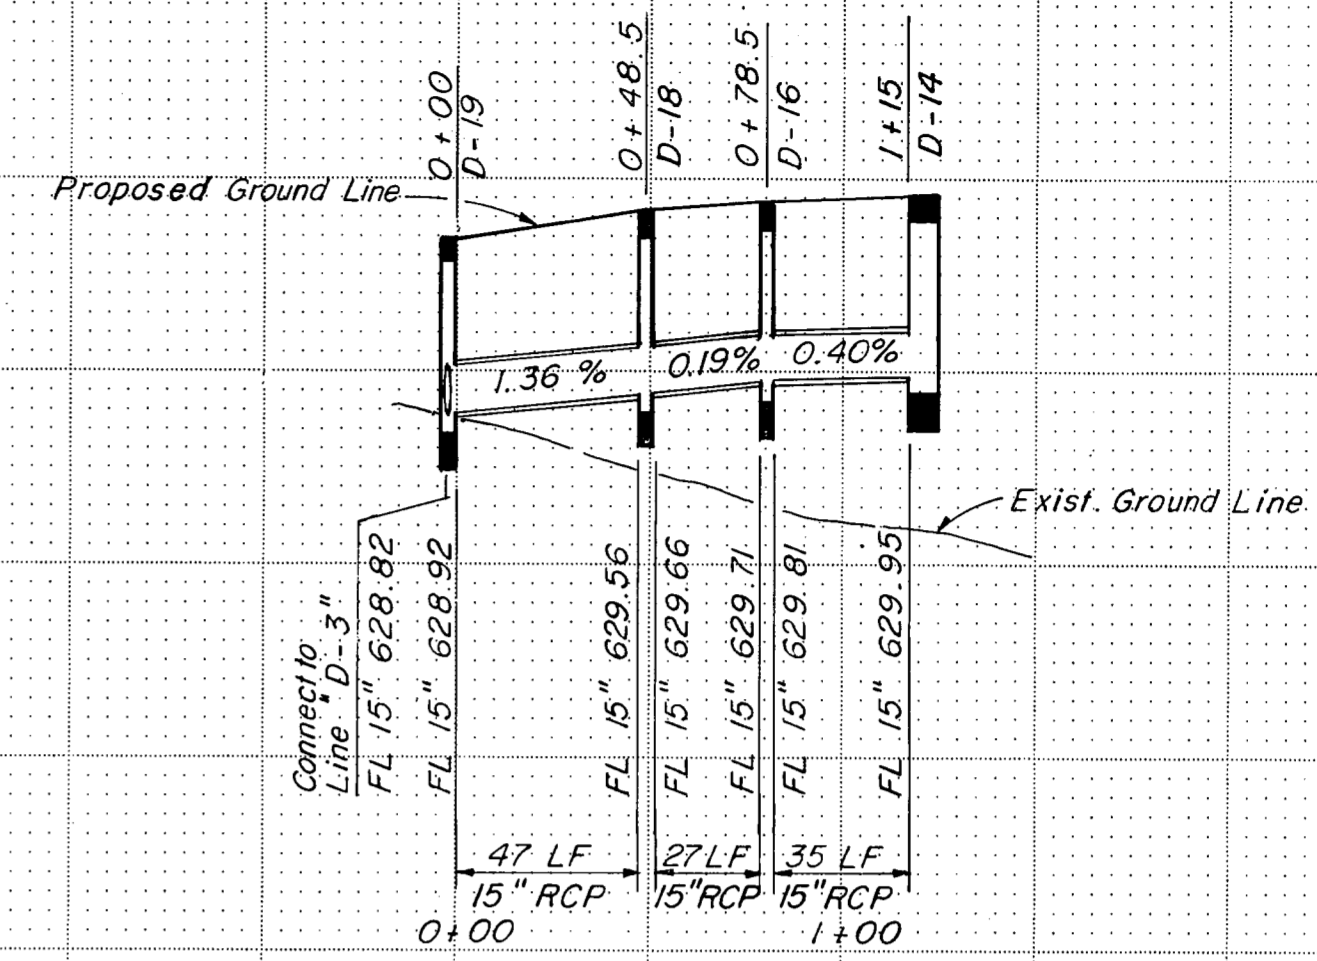

LATERAL "D-3"

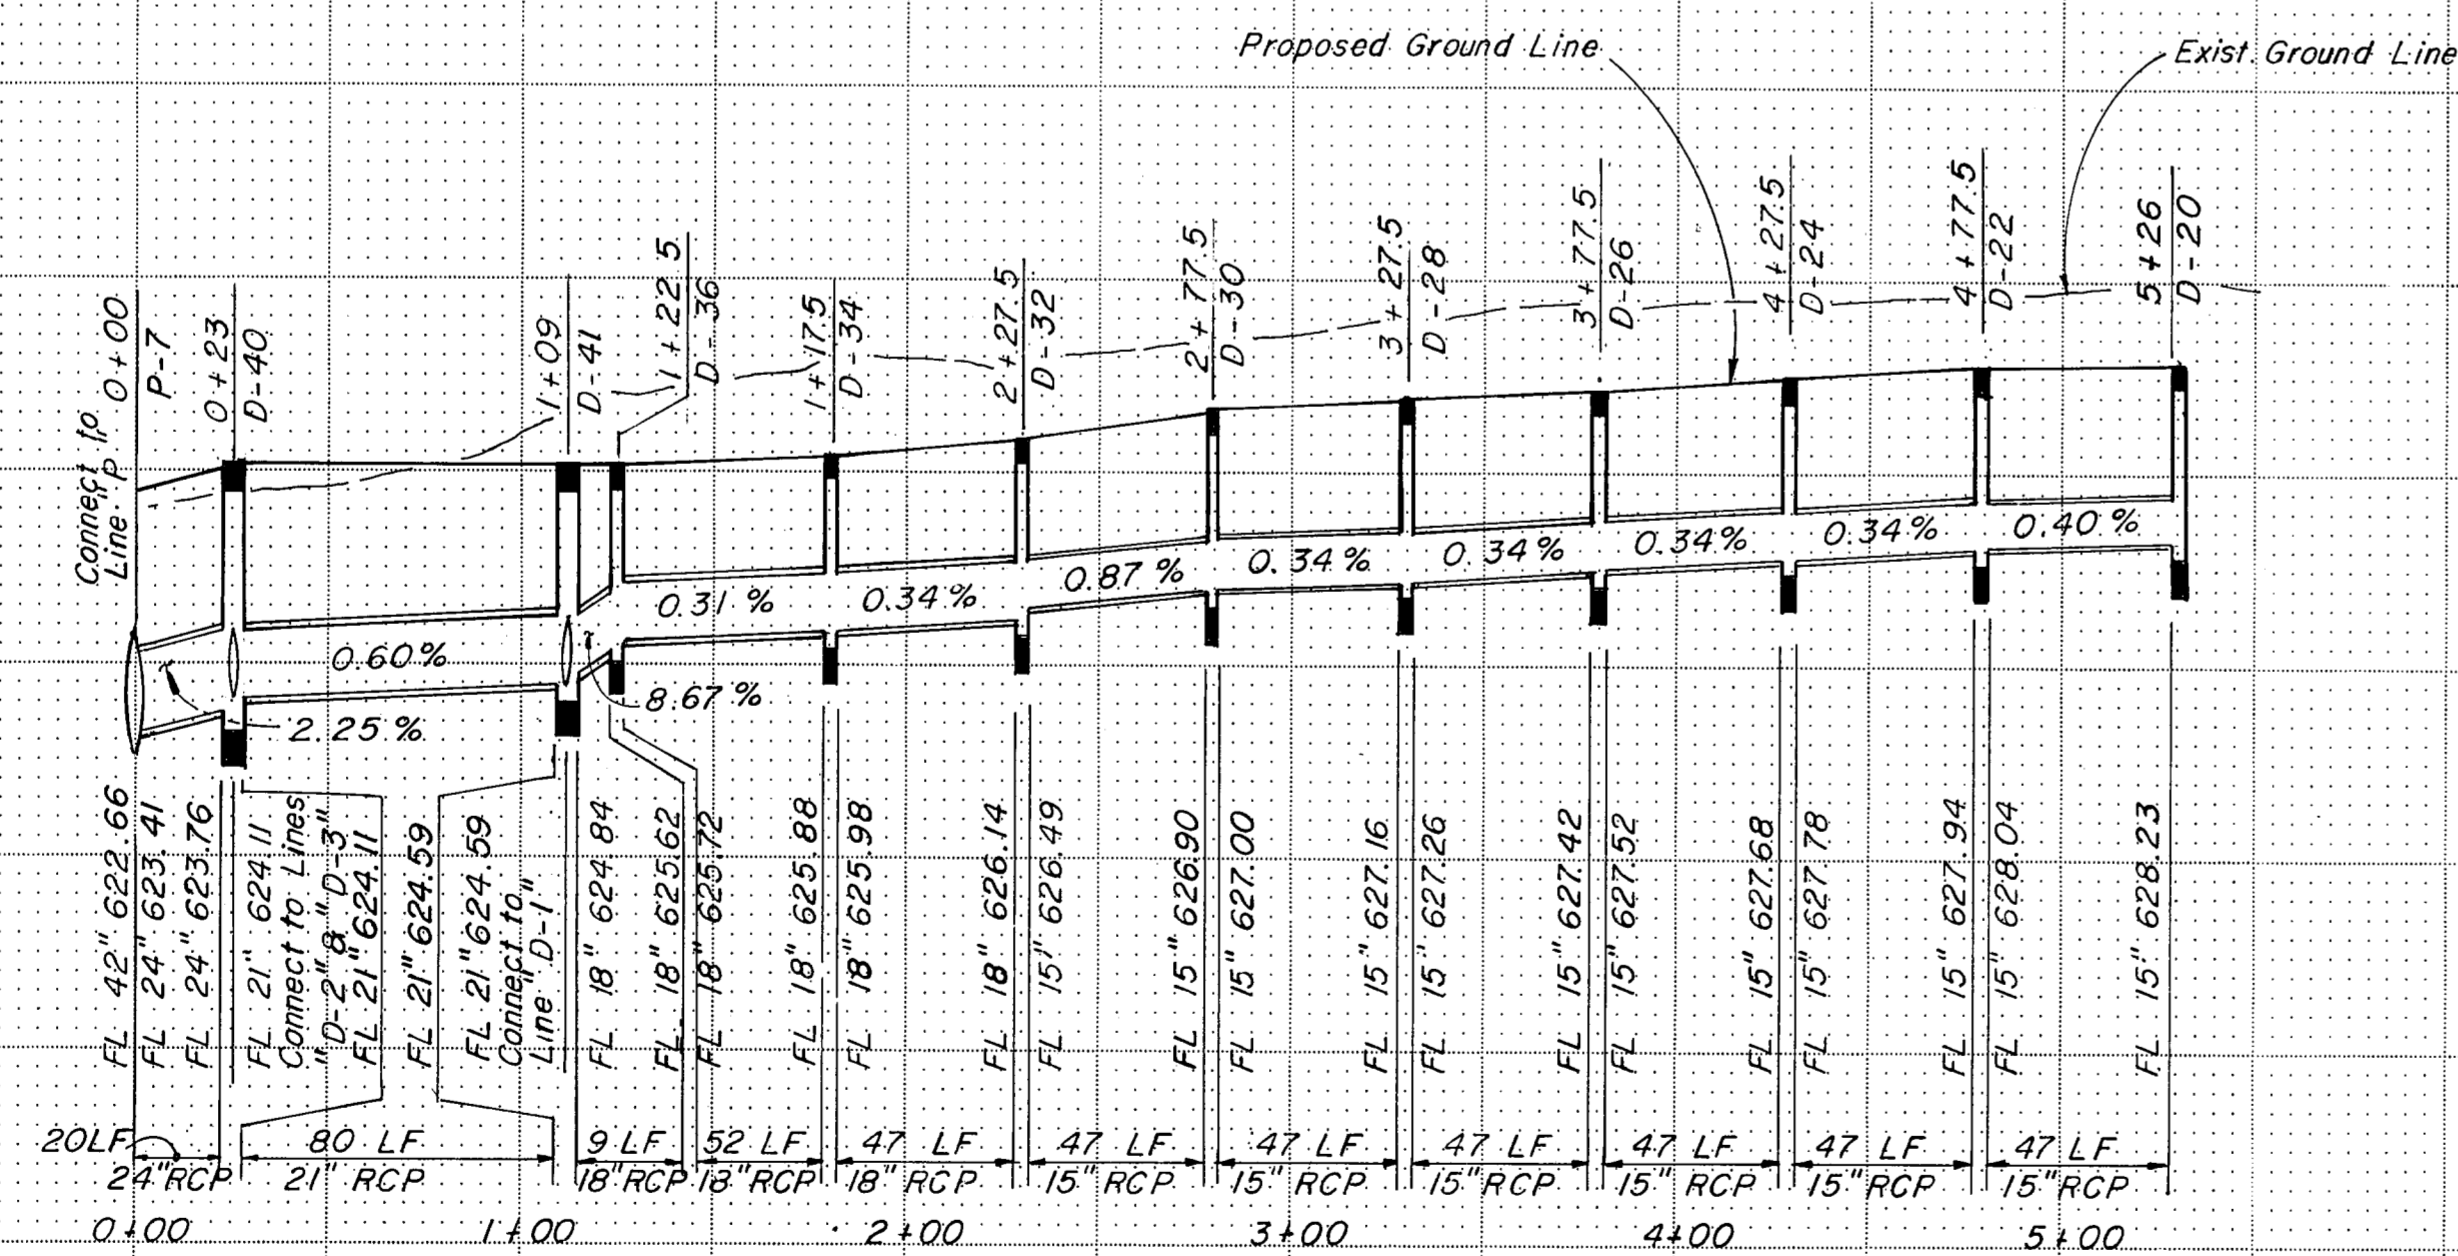


LINE "D-4"

STORM SEWER LINE: "D-3", "D-4"  
LATERAL: "D-3"

ASBUILT PLANS

NO.	REVISION	BY	DATE
TEXAS TURNPIKE AUTHORITY DALLAS NORTH TOLLWAY			
STORM SEWER PROFILES			
<b>Gibbs &amp; Hill, Inc.</b>			
MADE	AELT	DATE	4/84
CHECKED	REW	DATE	4/84
TRACED	MAV	DATE	4/84
		SCALE	1"=50'H 1"=5'V
CONTRACT NO. DNT-115 SHEET R63 OF R85			



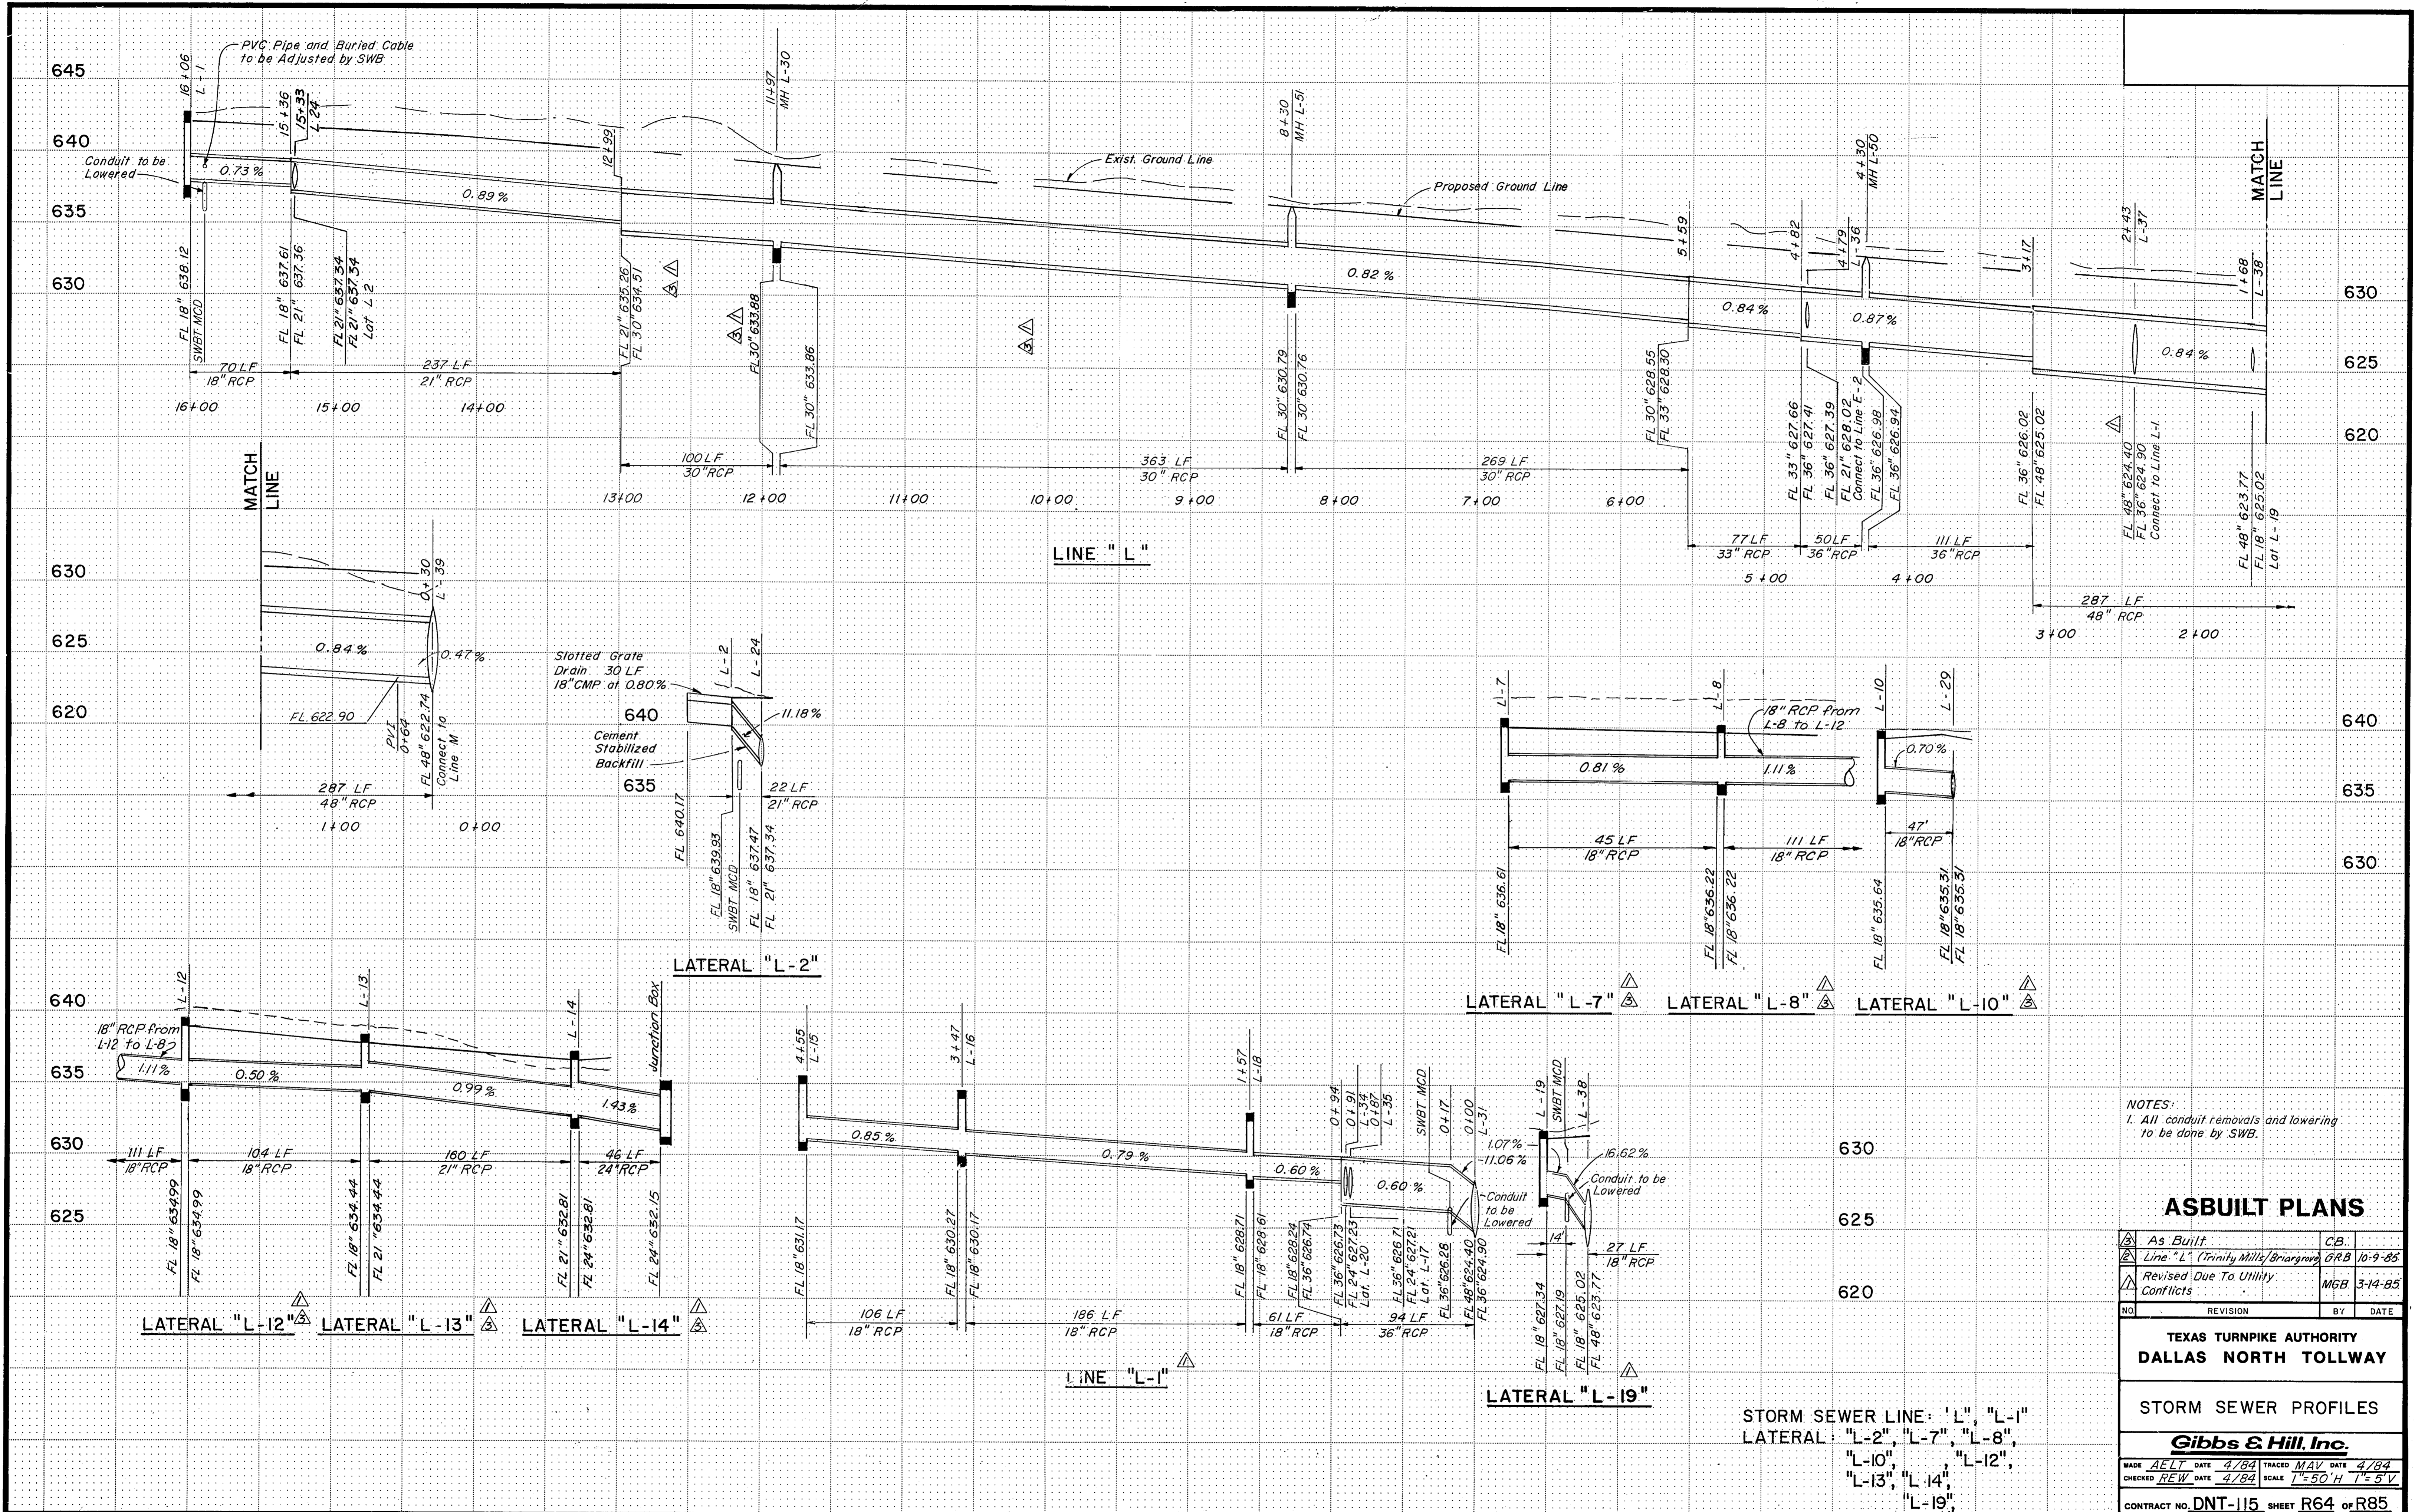

NOTES:  
1. All conduit removals and lowering to be done by SWB.

**ASBUILT PLANS**

As Built	CB
Line 'L' (Trinity Mills/Briarwood)	GRB 10-9-85
Revised Due To Utility Conflicts	MGB 3-14-85
NO	REVISION
	BY
	DATE

TEXAS TURNPIKE AUTHORITY  
DALLAS NORTH TOLLWAY

STORM SEWER PROFILES


**Gibbs & Hill, Inc.**

MADE AELT DATE 4/84 TRACED MAV DATE 4/84  
CHECKED REW DATE 4/84 SCALE 1"=50' H 1"=5' V

CONTRACT NO. DNT-115 SHEET R64 OF R85

STORM SEWER LINE: 'L', 'L-1'  
LATERAL: 'L-2', 'L-7', 'L-8',  
'L-10', 'L-12',  
'L-13', 'L-14',  
'L-19'



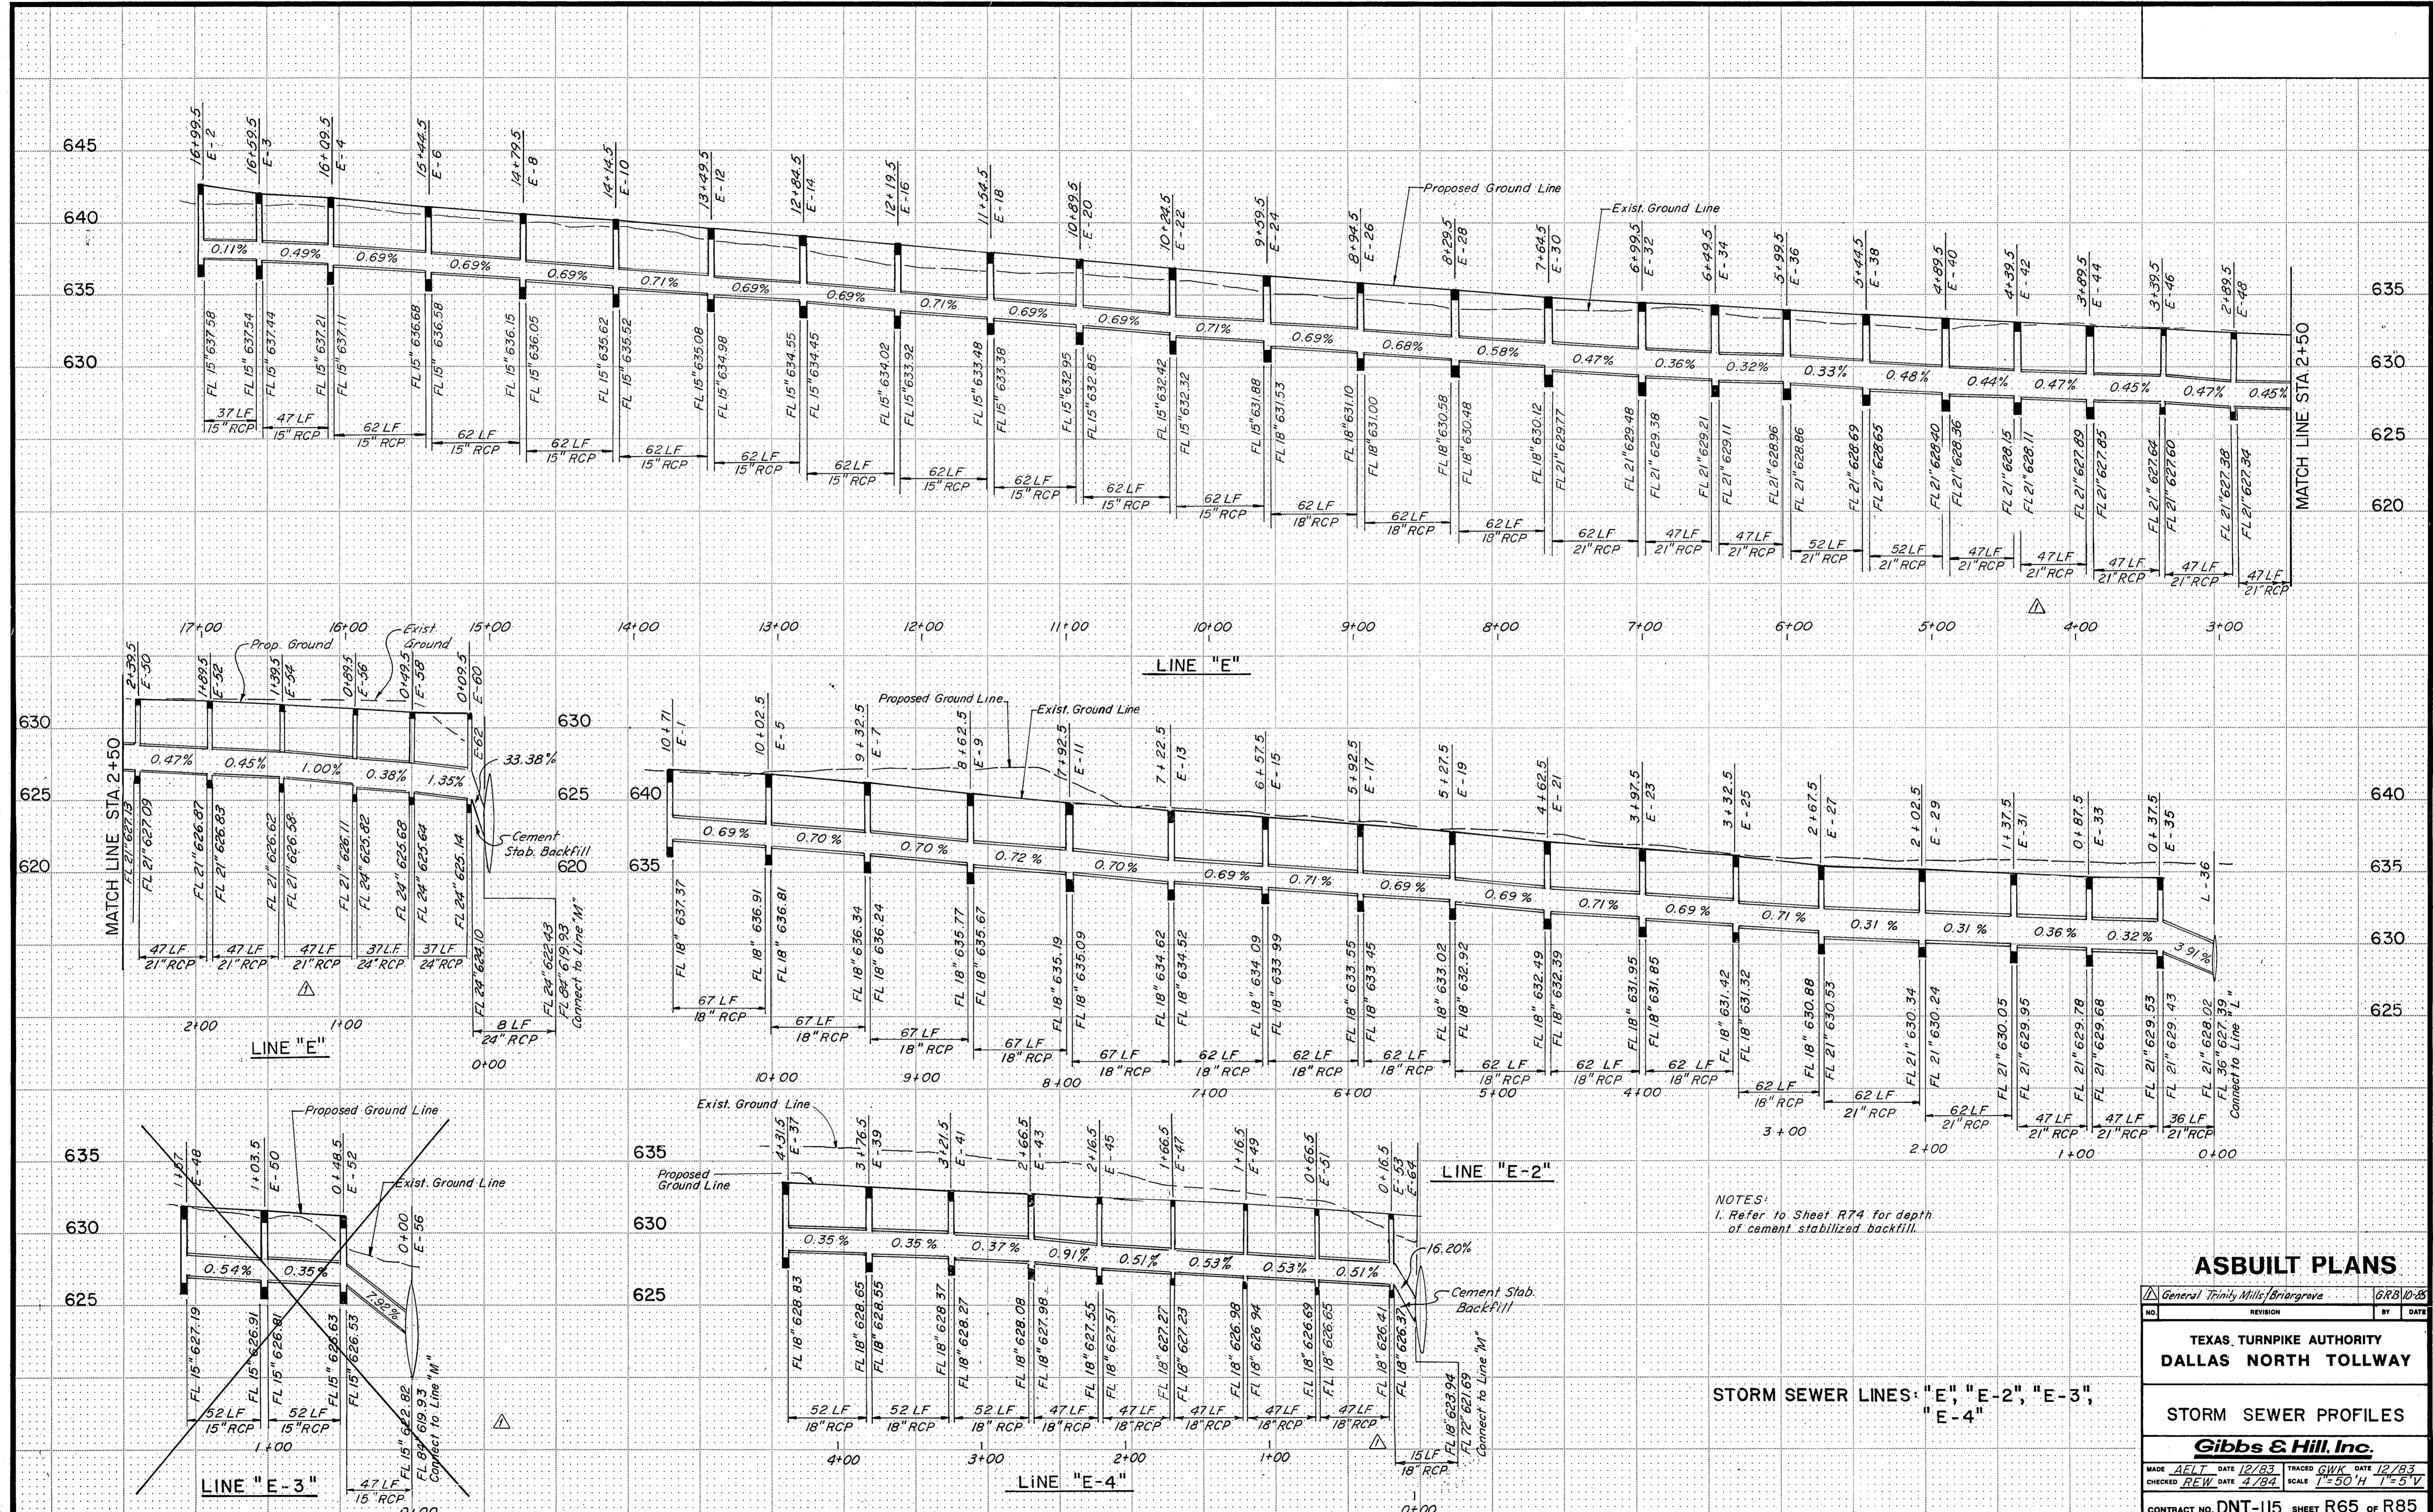

NOTES:  
 1. Refer to Sheet R74 for depth of cement stabilized backfill.

**ASBUILT PLANS**

General Trinity Mills/Briar Grove GRB 10-88

NO. REVISION BY DATE

TEXAS TURNPIKE AUTHORITY  
 DALLAS NORTH TOLLWAY

STORM SEWER LINES: "E", "E-2", "E-3",  
 "E-4"  
 STORM SEWER PROFILES


**Gibbs & Hill, Inc.**

MADE A/E/T DATE 12/83 TRACED G/W/K DATE 12/83  
 CHECKED R/W DATE 4/84 SCALE 1"=50' H 1"=5' V

CONTRACT NO. DNT-115 SHEET R65 OF R85



635  
630  
625  
620  
640  
635  
630  
635  
630  
635  
630  
625

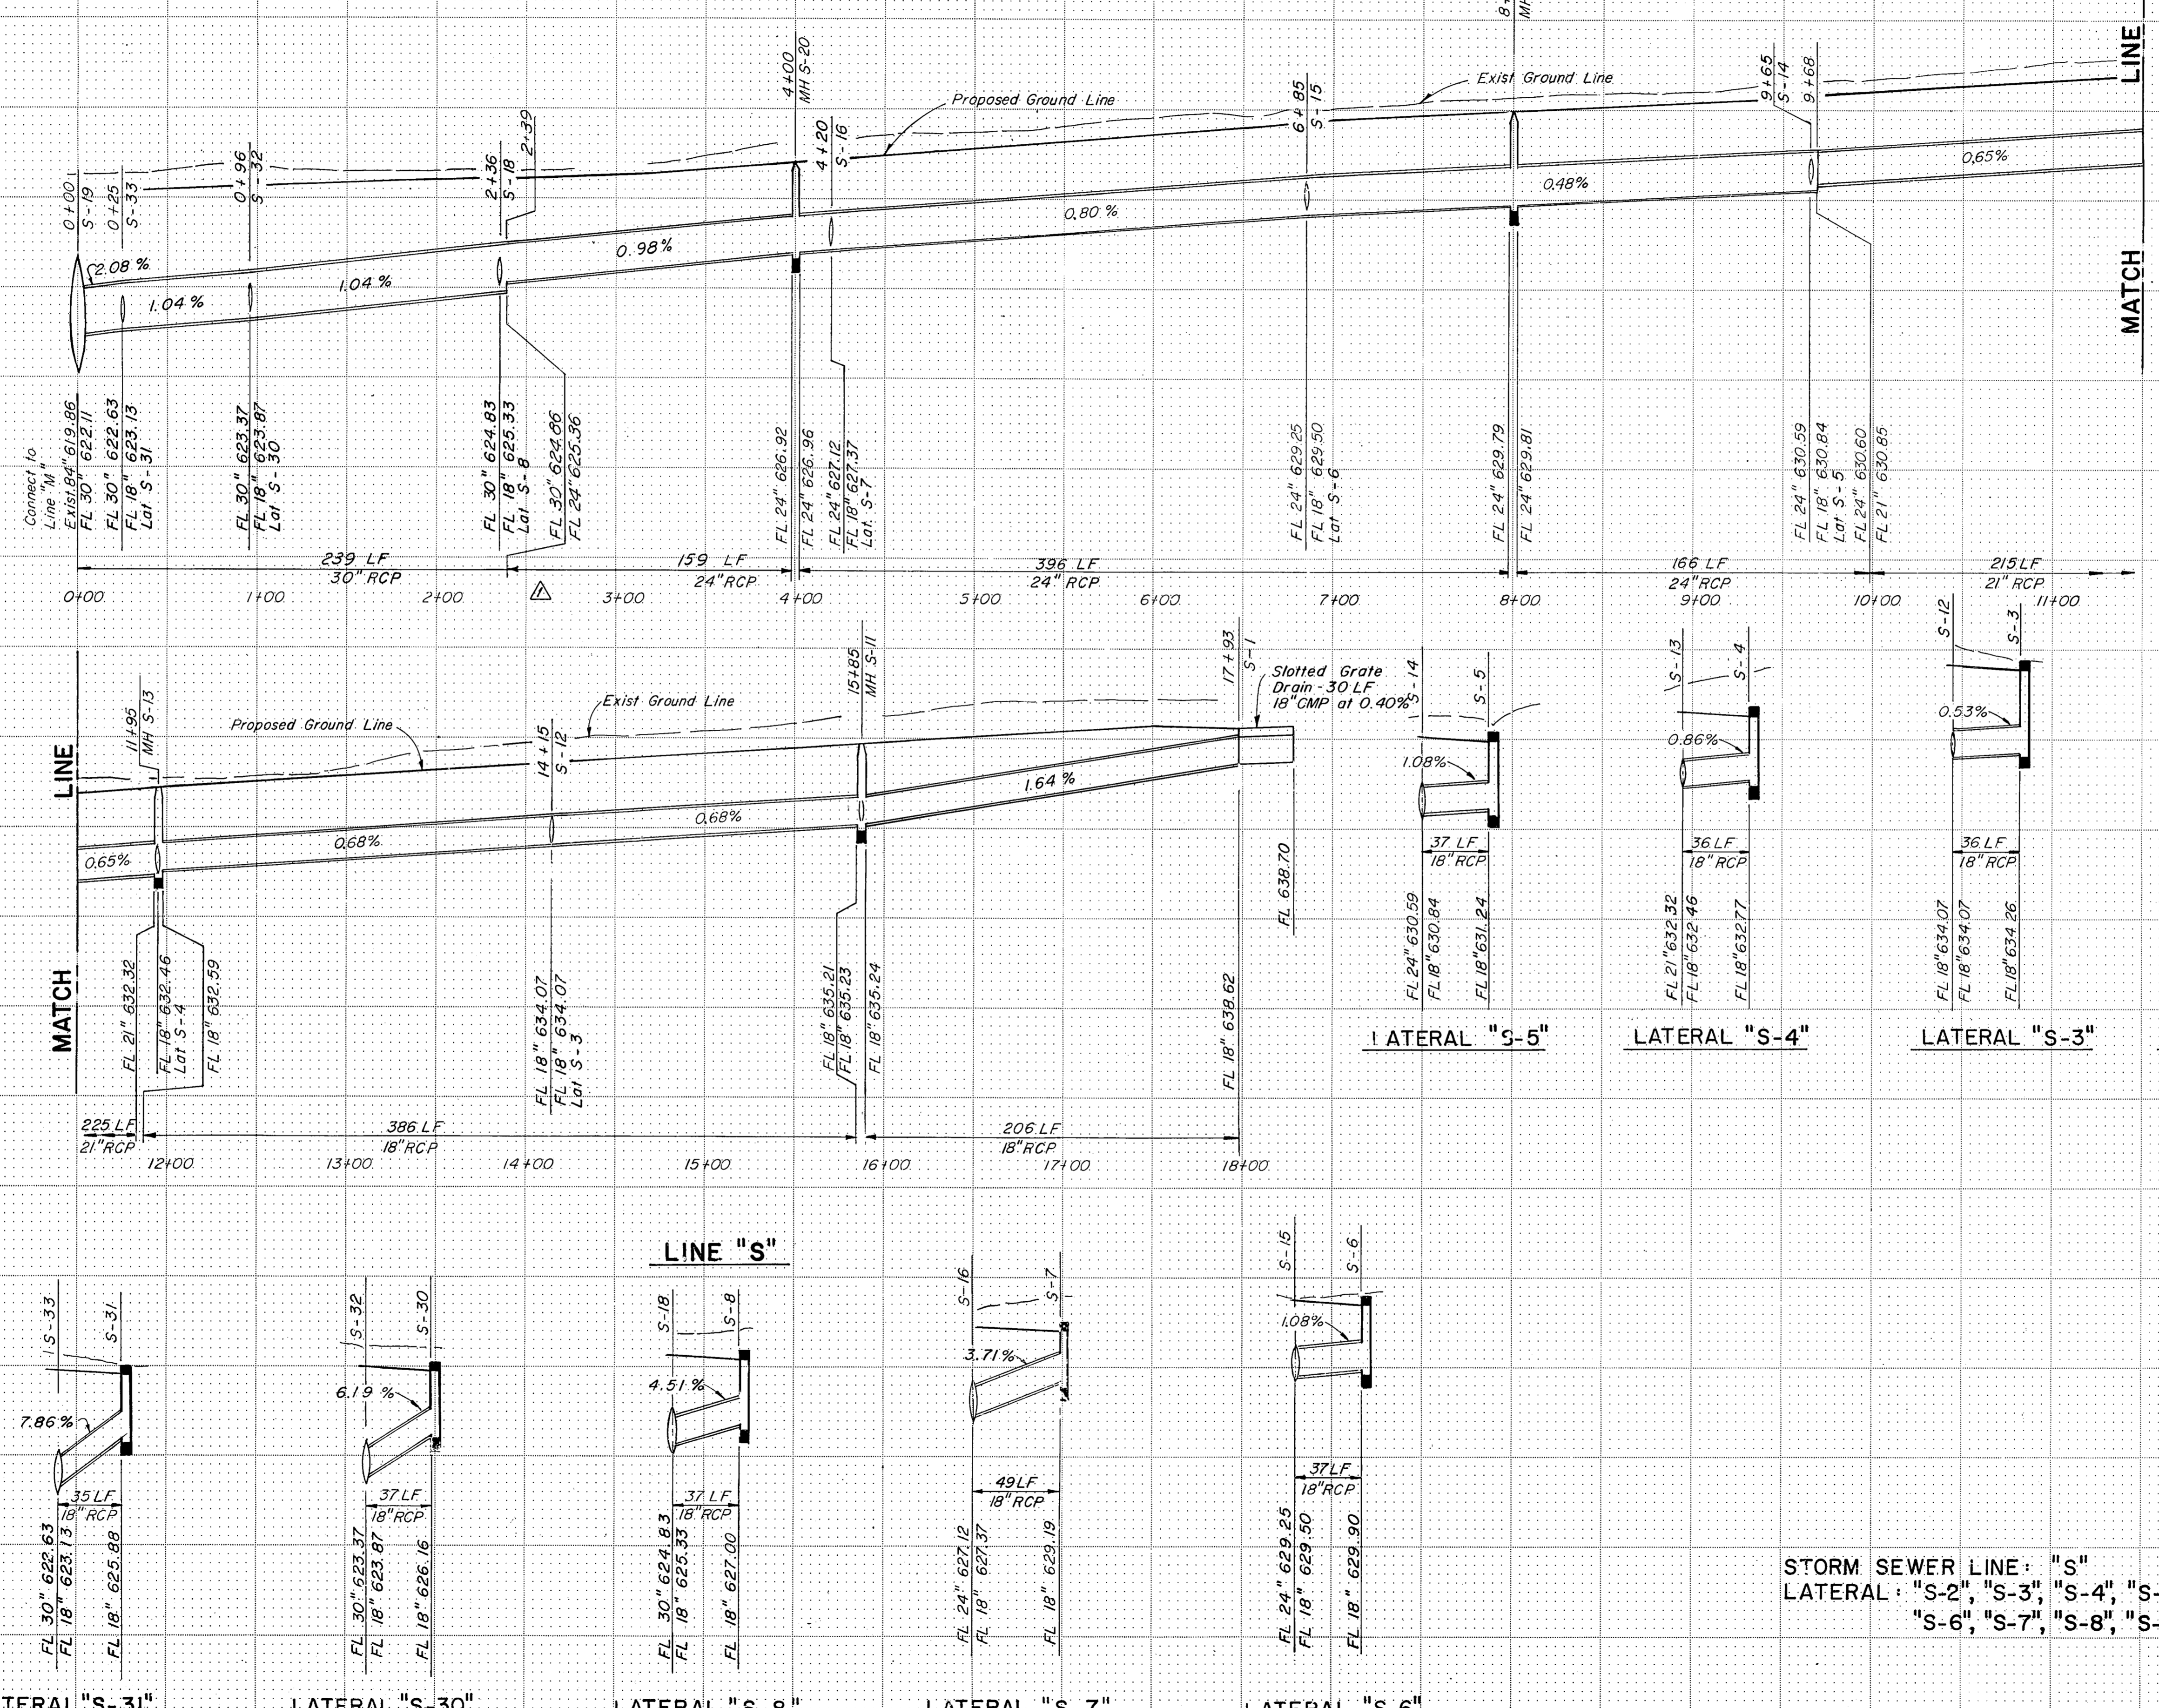

LATERAL "S-31"

LATERAL "S-30"

LATERAL "S-8"

LATERAL "S-7"

LATERAL "S-6"


STORM SEWER LINE: "S"  
LATERAL: "S-2", "S-3", "S-4", "S-5",  
"S-6", "S-7", "S-8", "S-30", "S-31"

**ASBUILT PLANS**

Gen. Trinity Mills/Briar Grove - Line "S" GRB 10/05	
NO.	DATE
REVISION	BY
TEXAS TURNPIKE AUTHORITY DALLAS NORTH TOLLWAY	
STORM SEWER PROFILES	
<b>Gibbs &amp; Hill, Inc.</b>	
MADE AELT DATE 12/83	TRACED GWK DATE 12/83
CHECKED REW DATE 4/84	SCALE 1"=50'H 1"=5' V
CONTRACT NO. DNT-115 SHEET R66 OF R85	




630  
625  
620  
615

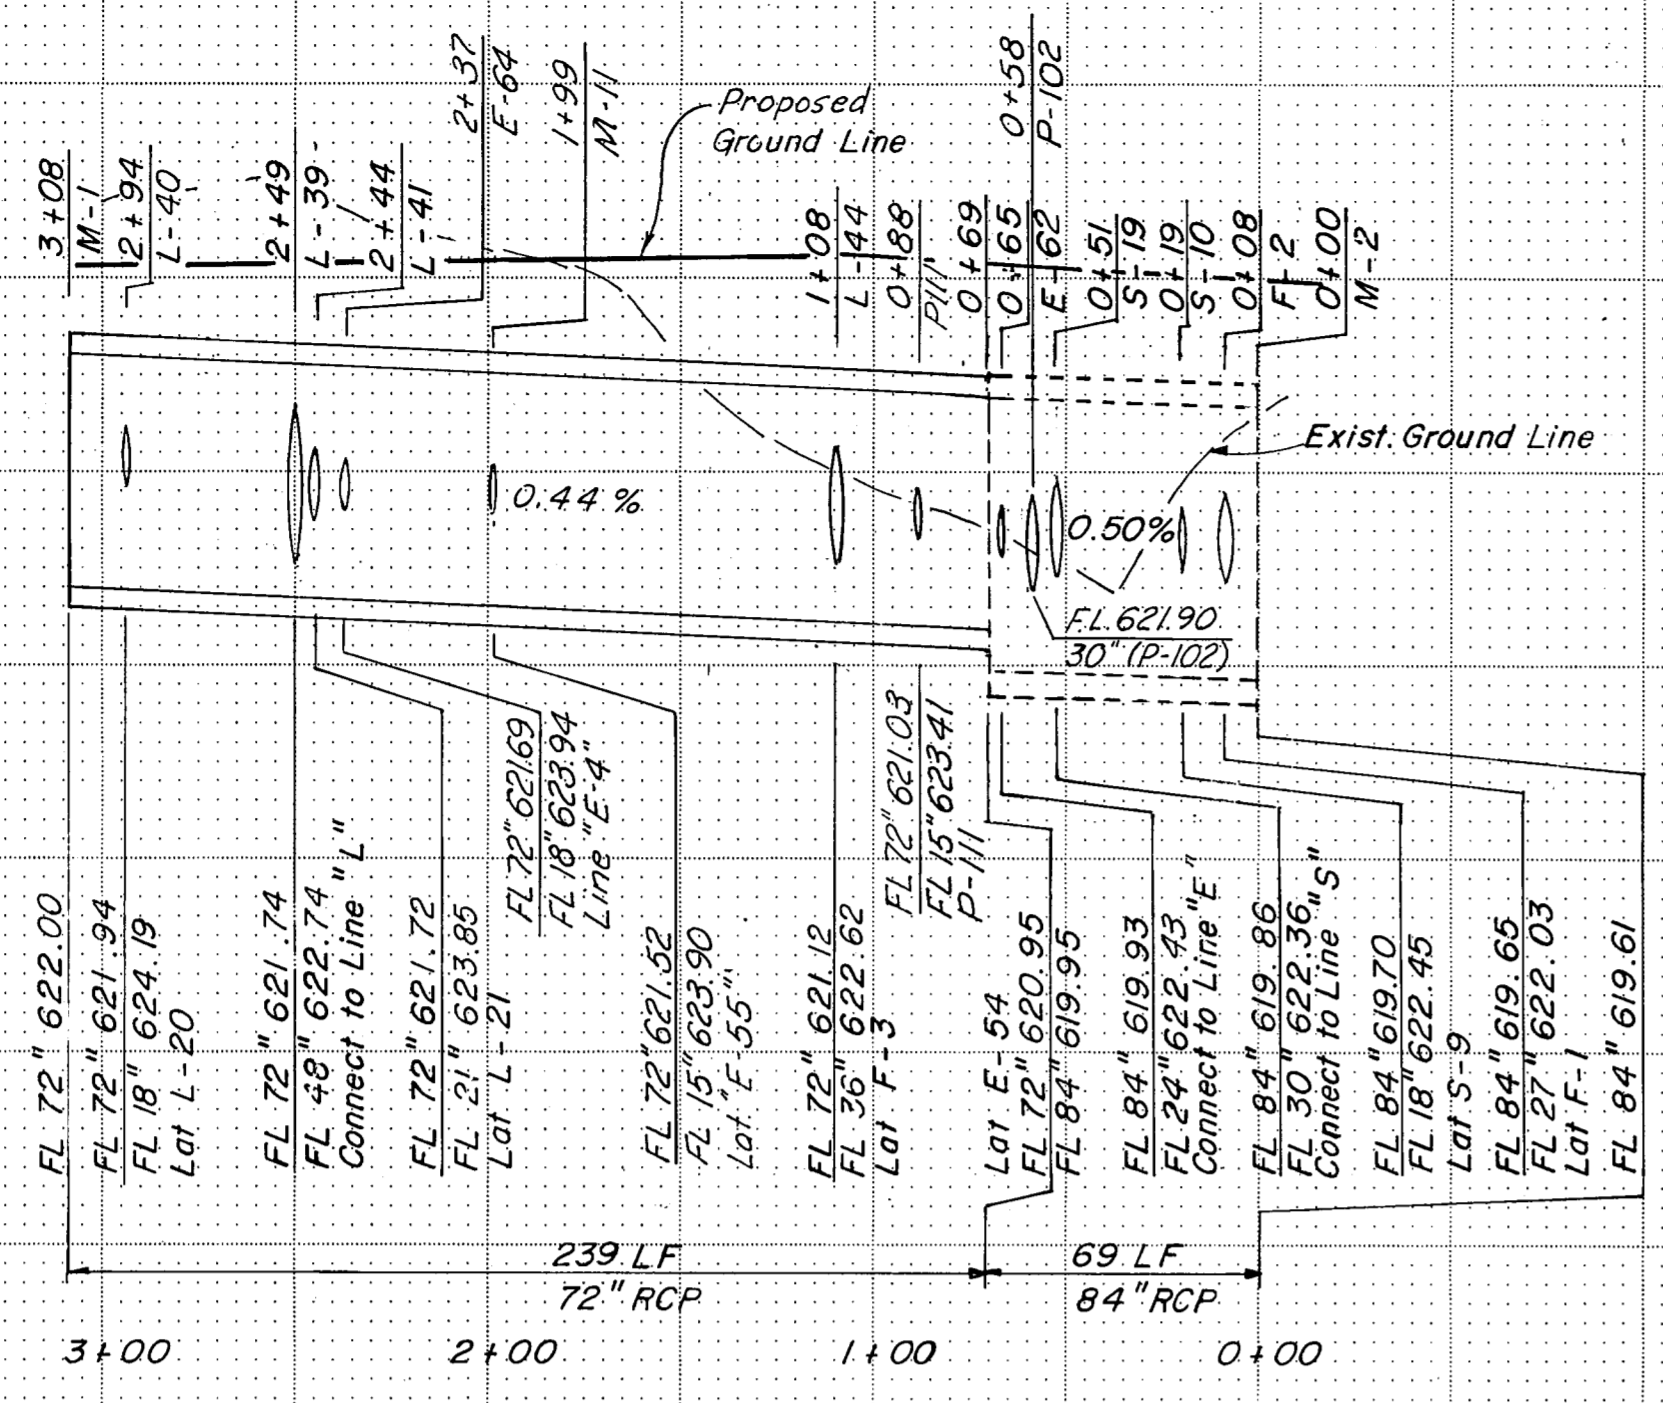


LINE "M"

630  
625  
620

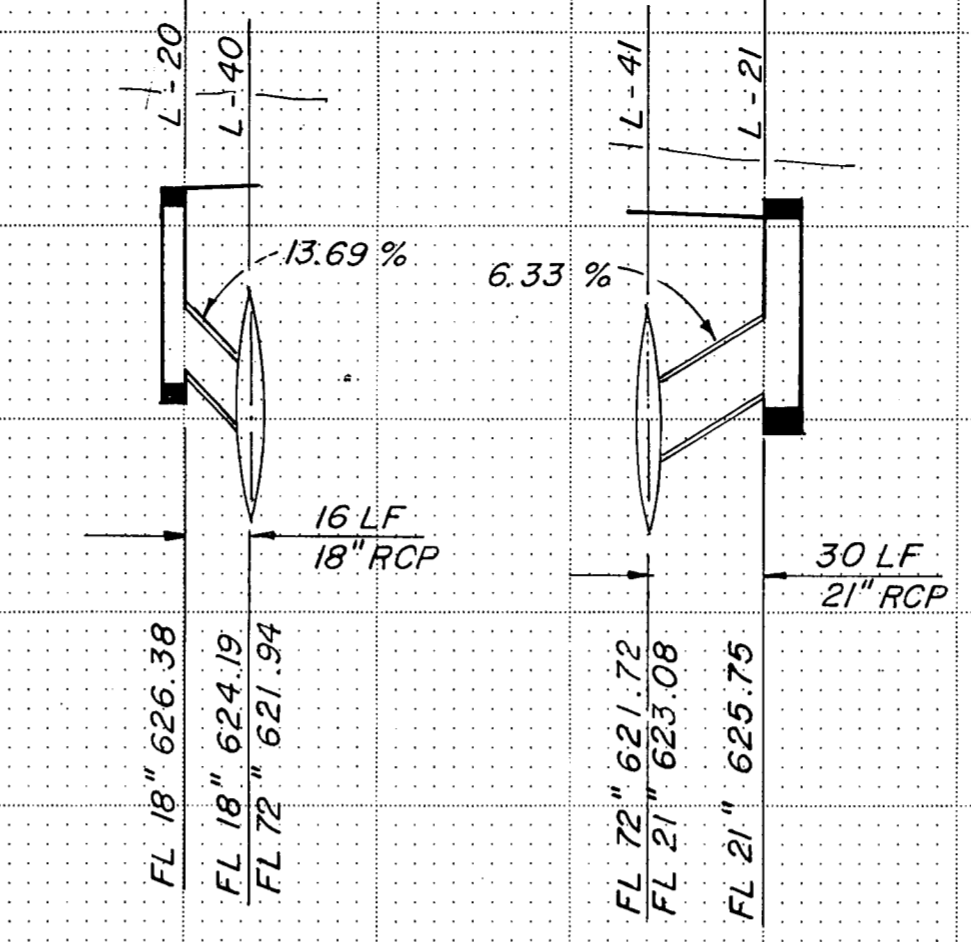


LATERAL "L-20" LATERAL "L-21"

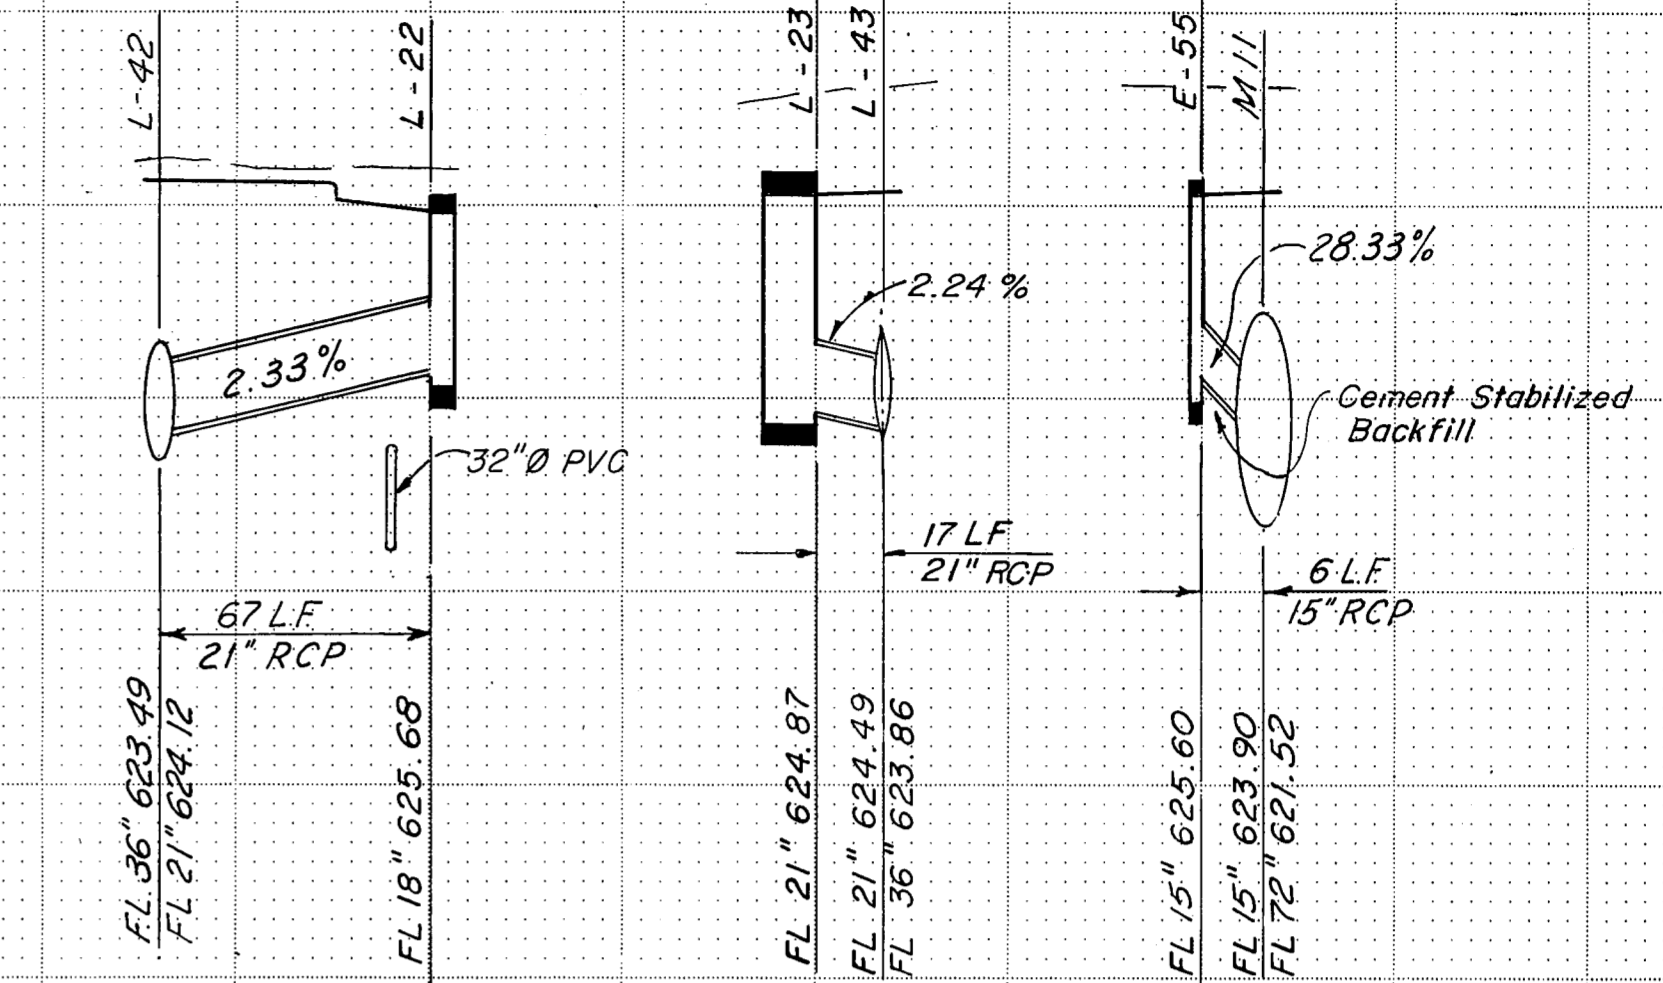


LATERAL "L-22" LATERAL "L-23" LATERAL "E-55"


630  
625  
620

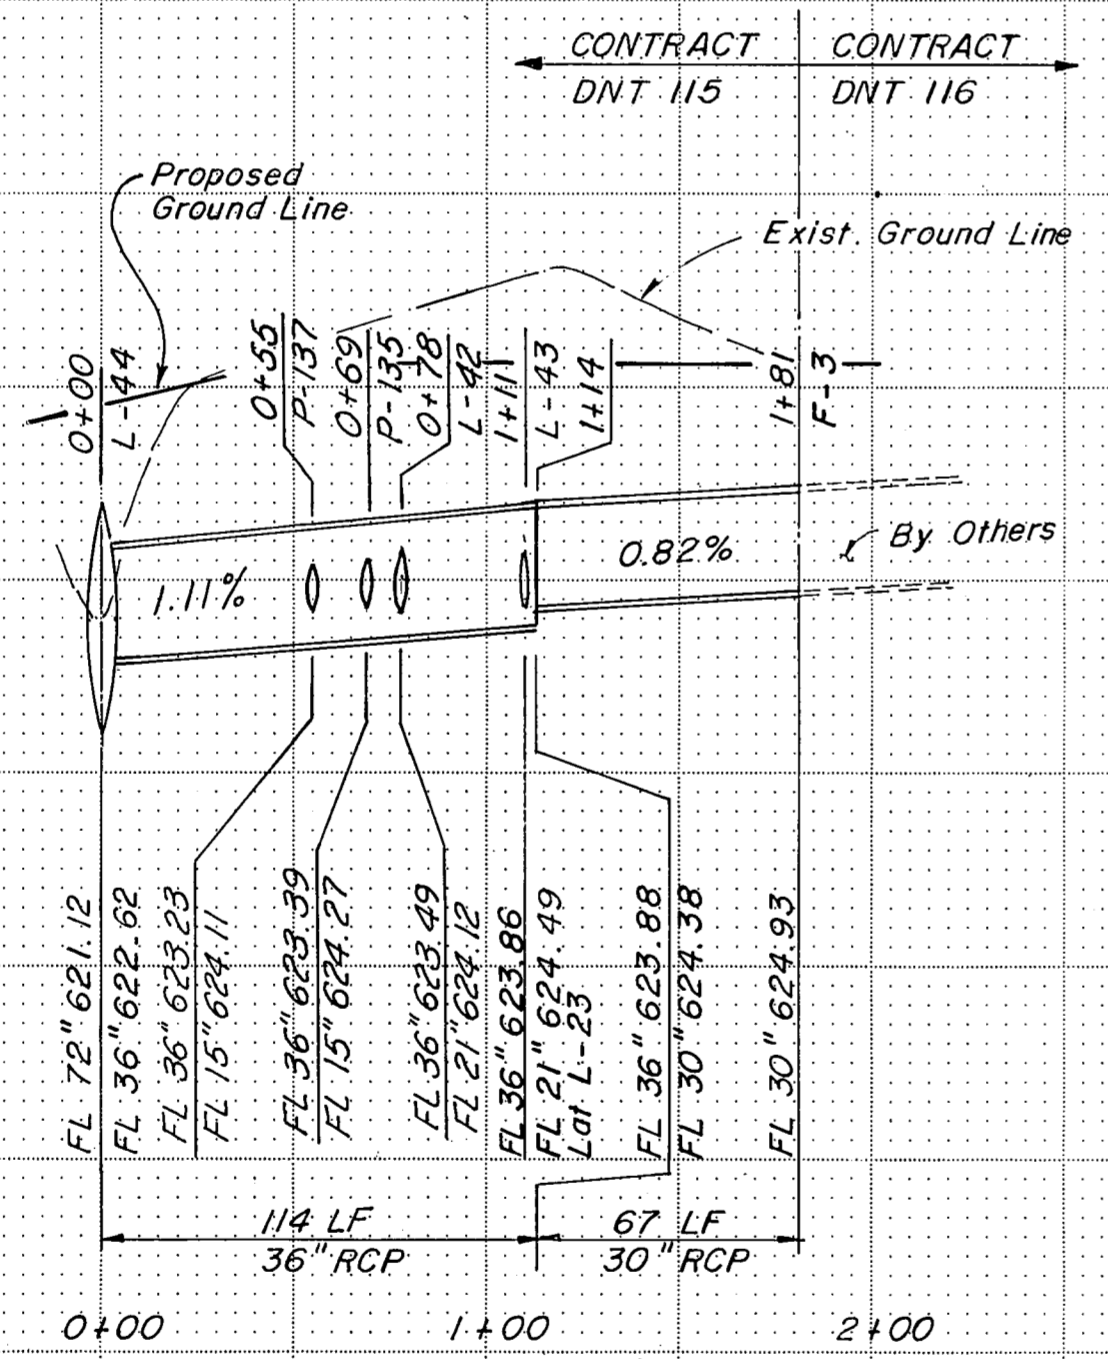


LATERAL "F-3"

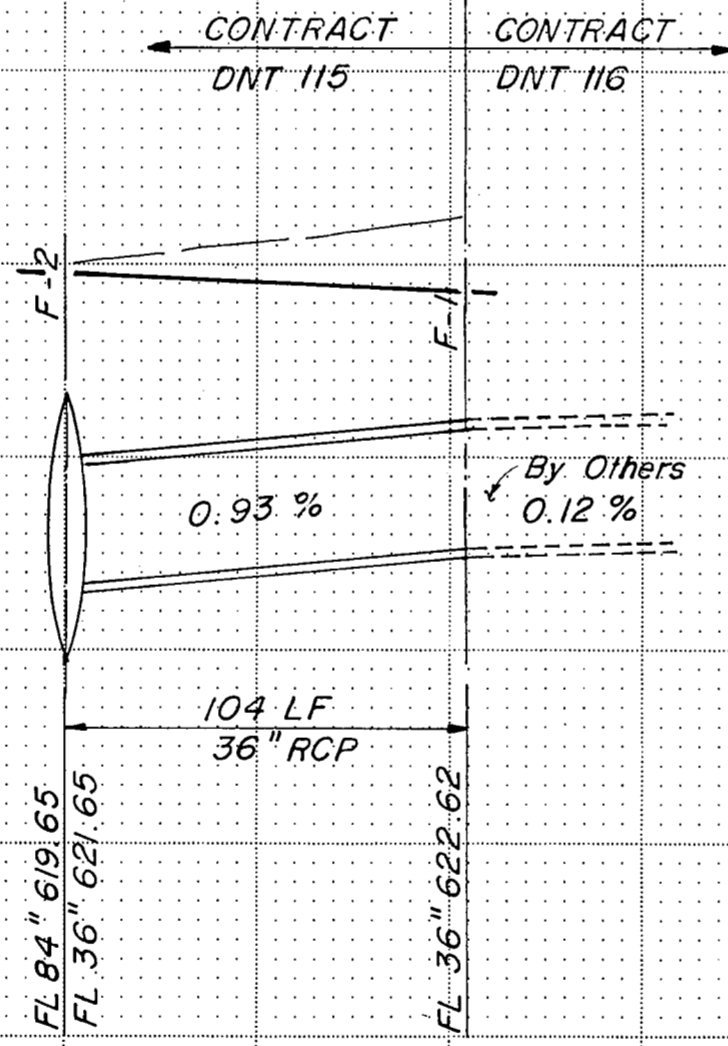

LATERAL "F-1"

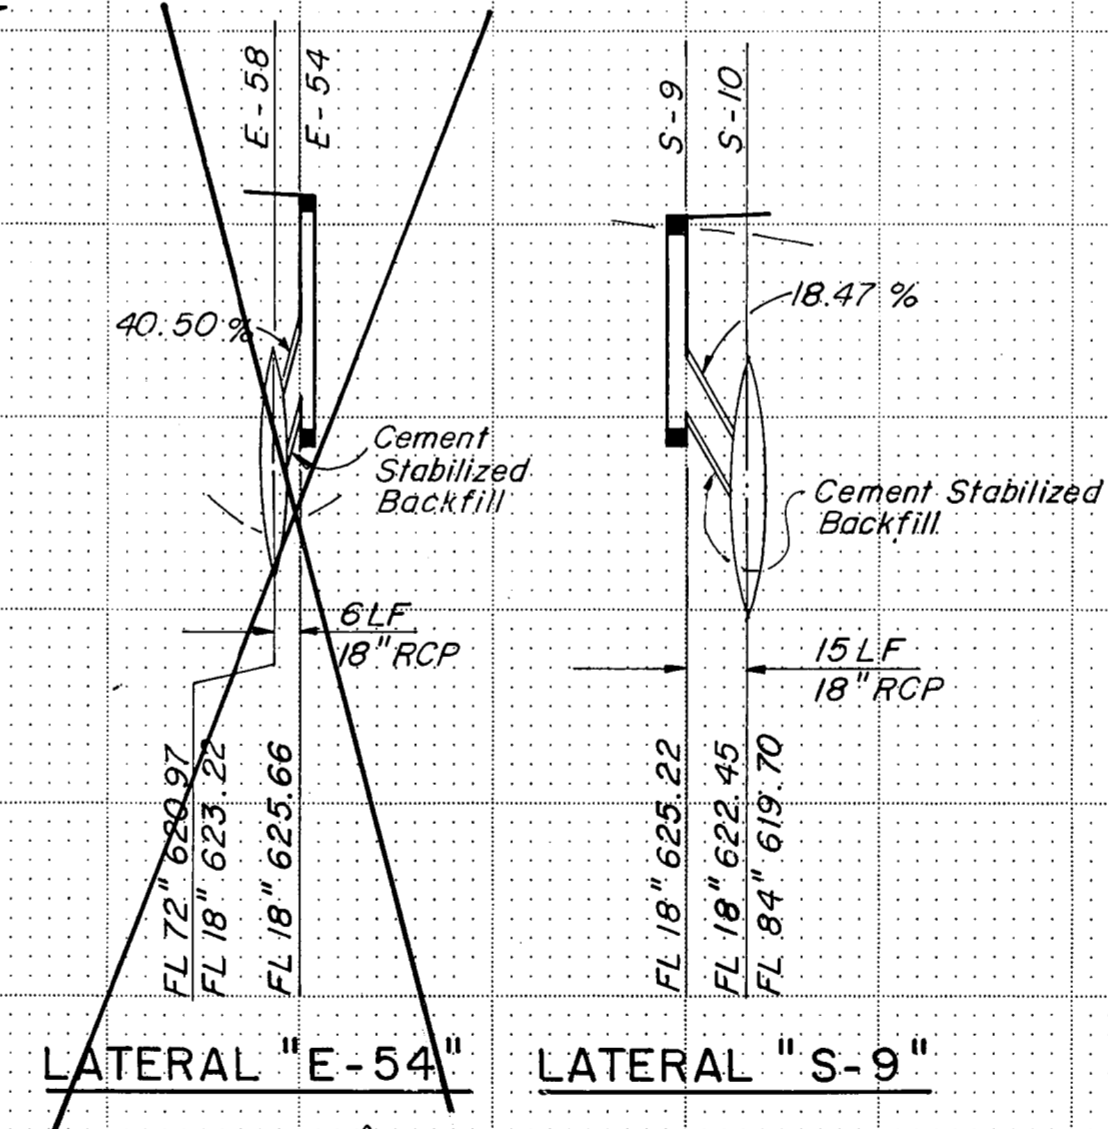

LATERAL "E-54" LATERAL "S-9"

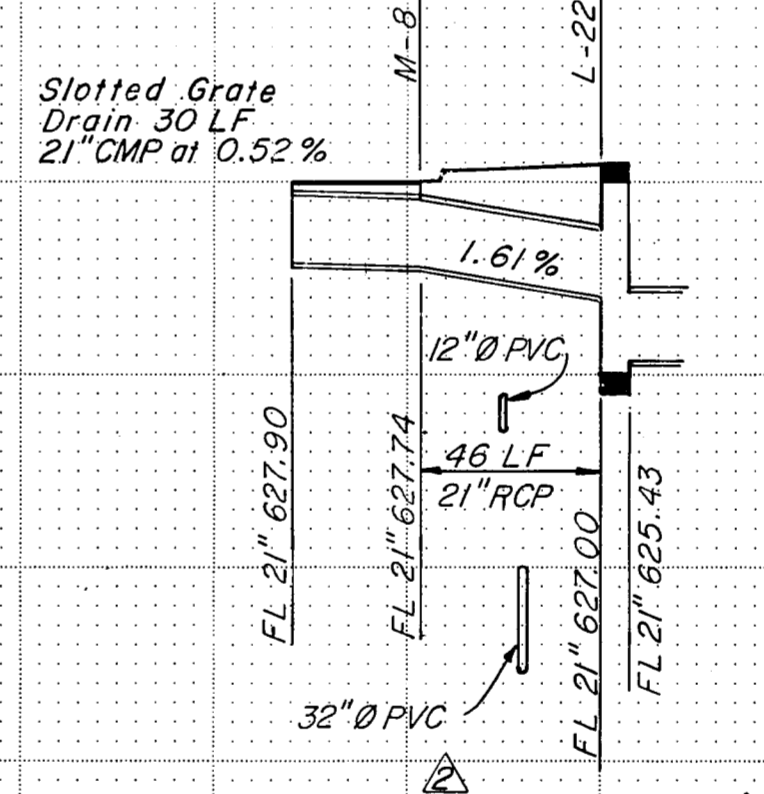

LATERAL "M-8"

NOTES:  
1. Refer to Sheet R74 for depth of cement stabilized backfill.

STORM SEWER LINE: "M"  
LATERAL: "L-20", "L-21", "L-22", "L-23",  
"E-55", "F-3", "F-1", "E-54",  
"S-9", "M-8"

ASBUILT PLANS

3	General Trinity Mills/Briar Grove	B&H 10-9-85
4	Added Location of 32" and 12" SWB Conduit	B&A 4-12-89
5	Replaced Inlet M-8 with Slotted Drain & Tie into Inlet L-22	B&A 2-5-88
NO	REVISION	BY DATE

TEXAS TURNPIKE AUTHORITY  
DALLAS NORTH TOLLWAY


STORM SEWER PROFILES

Gibbs & Hill, Inc.

MADE AELT DATE 4/84 TRACED MAV DATE 4/84  
CHECKED REW DATE 4/84 SCALE 1"=50'H 1"=5'V

CONTRACT NO. DNT-115 SHEET R67 OF R85



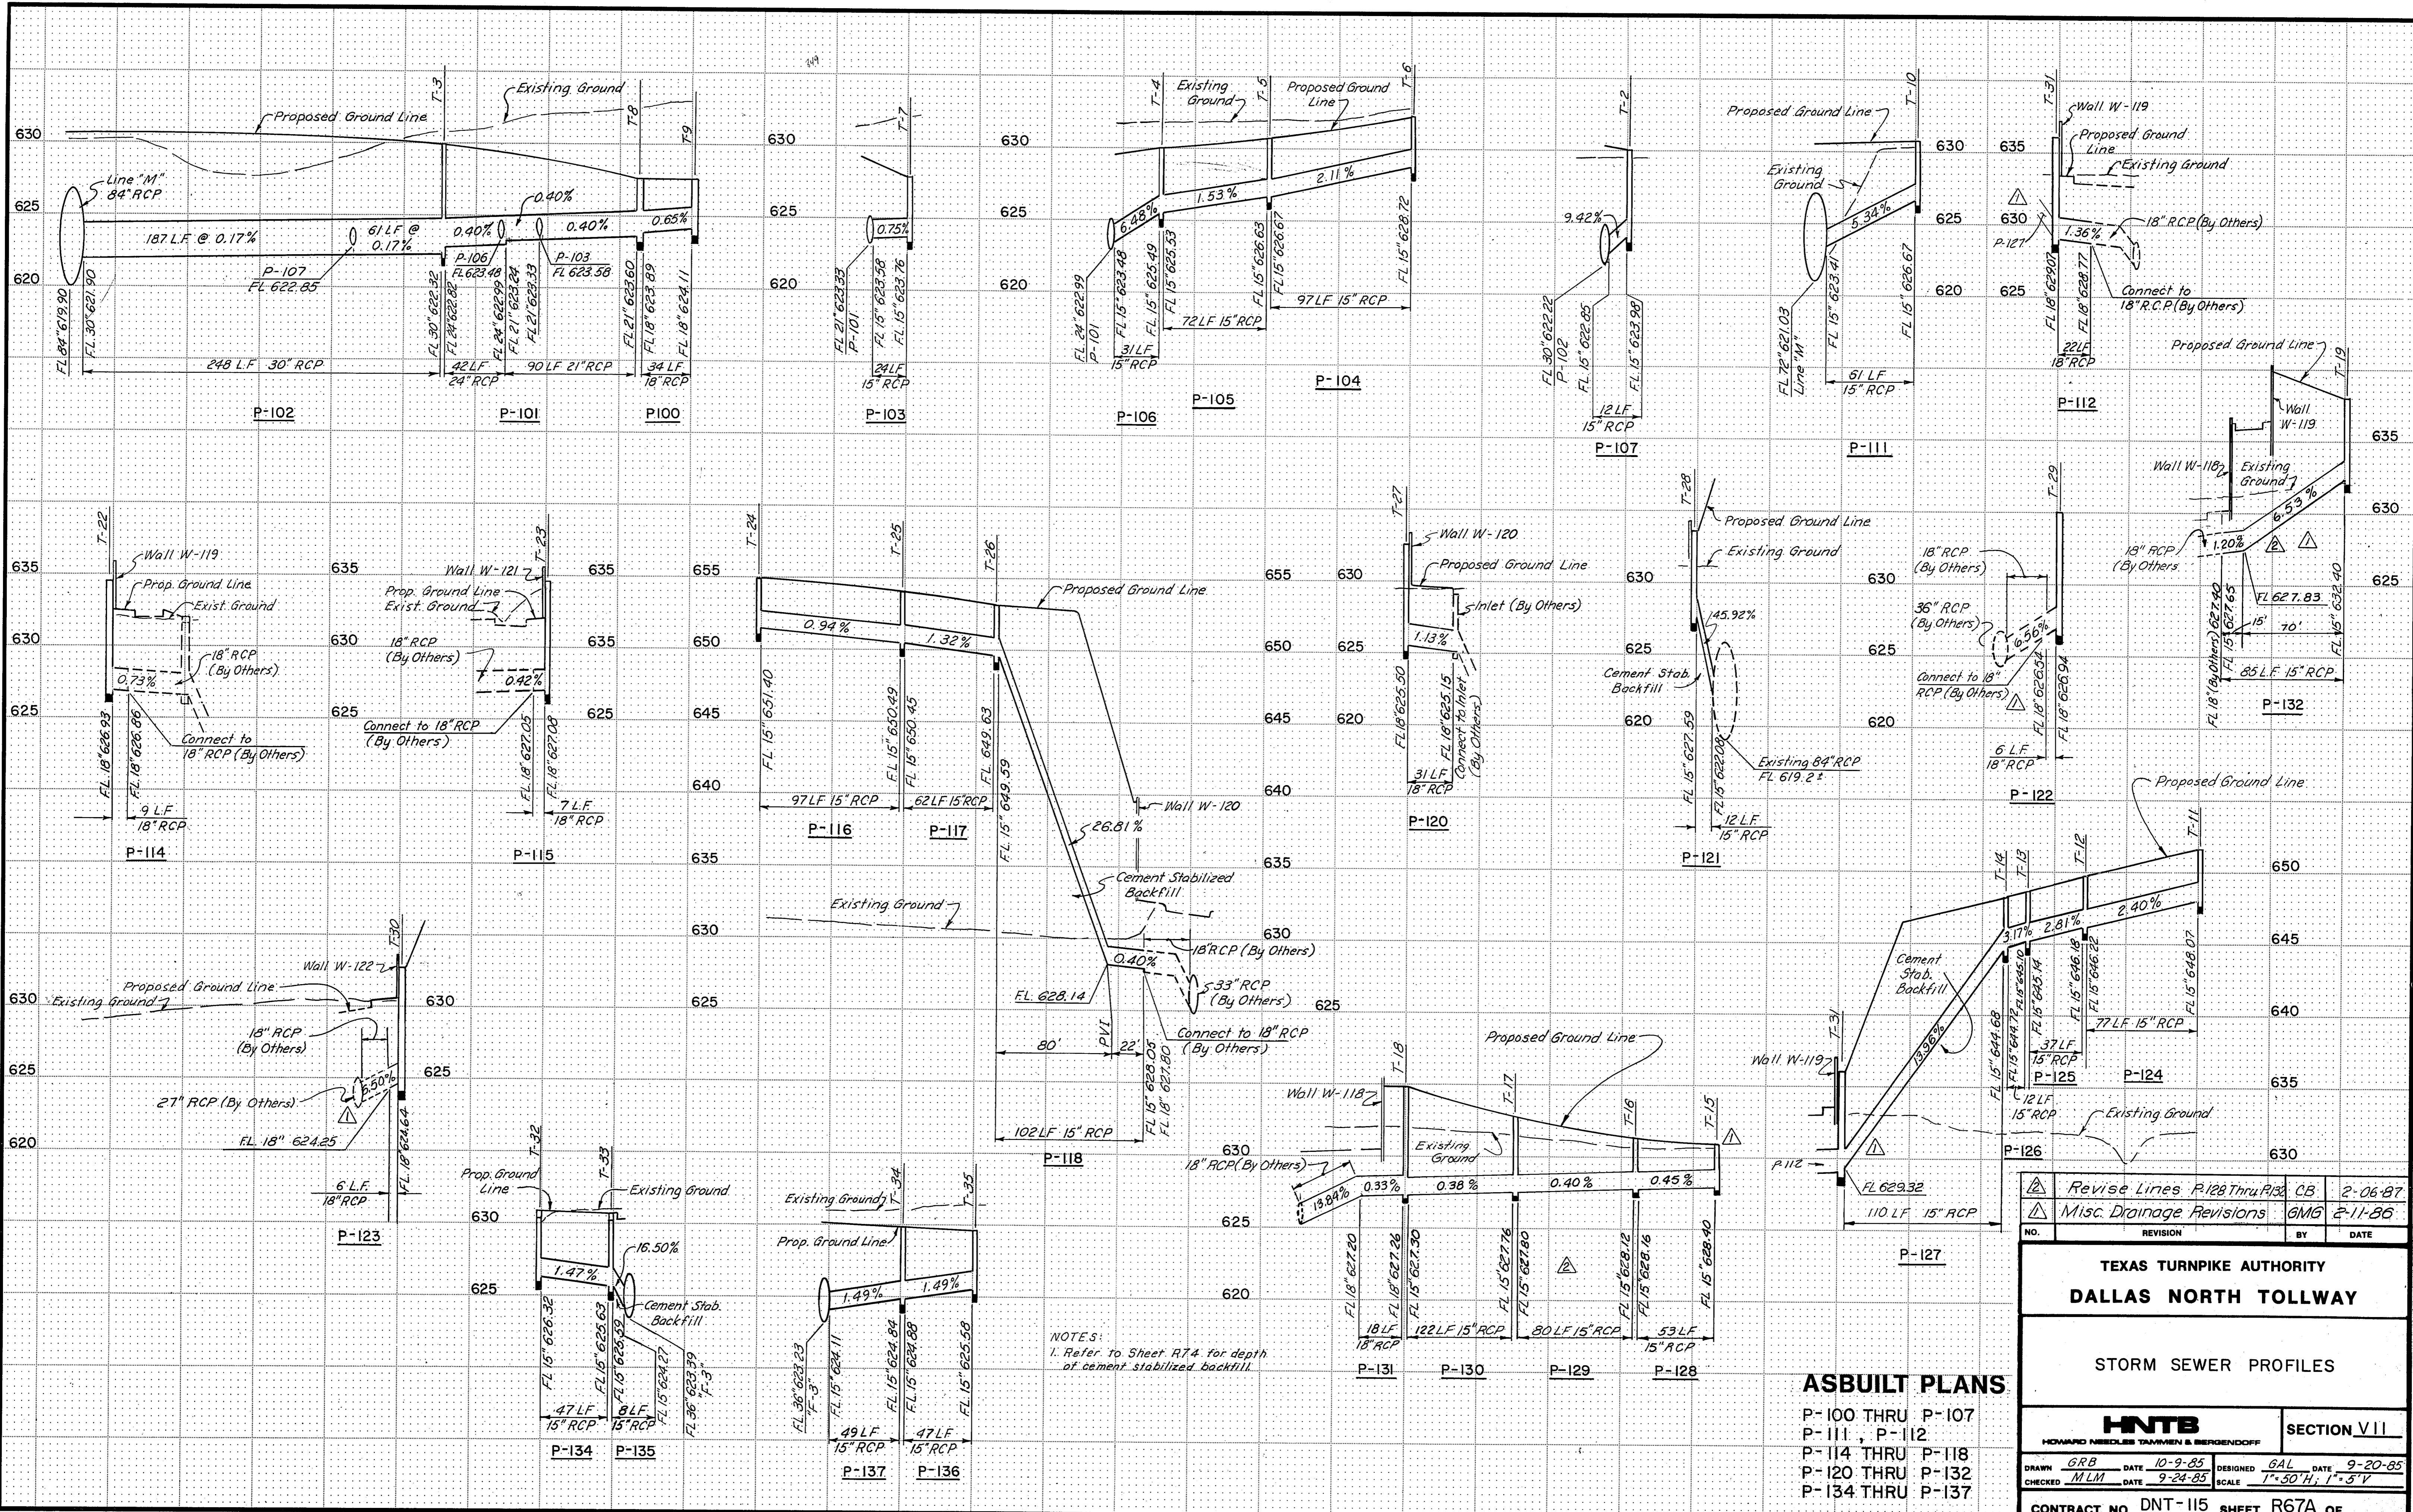

NOTES:  
 1. Refer to Sheet R74 for depth of cement stabilized backfill.

NO.	REVISION	BY	DATE
△	Revise Lines P-128 Thru P-132	CB	2-06-87
△	Misc. Drainage Revisions	GMG	2-11-86

TEXAS TURNPIKE AUTHORITY  
 DALLAS NORTH TOLLWAY


STORM SEWER PROFILES

ASBUILT PLANS


P-100 THRU P-107  
 P-111, P-112  
 P-114 THRU P-118  
 P-120 THRU P-132  
 P-134 THRU P-137

<b>HNTB</b> HOWARD NEEDLES TAMMEN & BERGENDOFF		SECTION V.11	
DRAWN GRB CHECKED MLM	DATE 10-9-85 DATE 9-24-85	DESIGNED GAL SCALE 1"=50'H; 1"=5'V	DATE 9-20-85
CONTRACT NO. DNT-115 SHEET R67A OF			



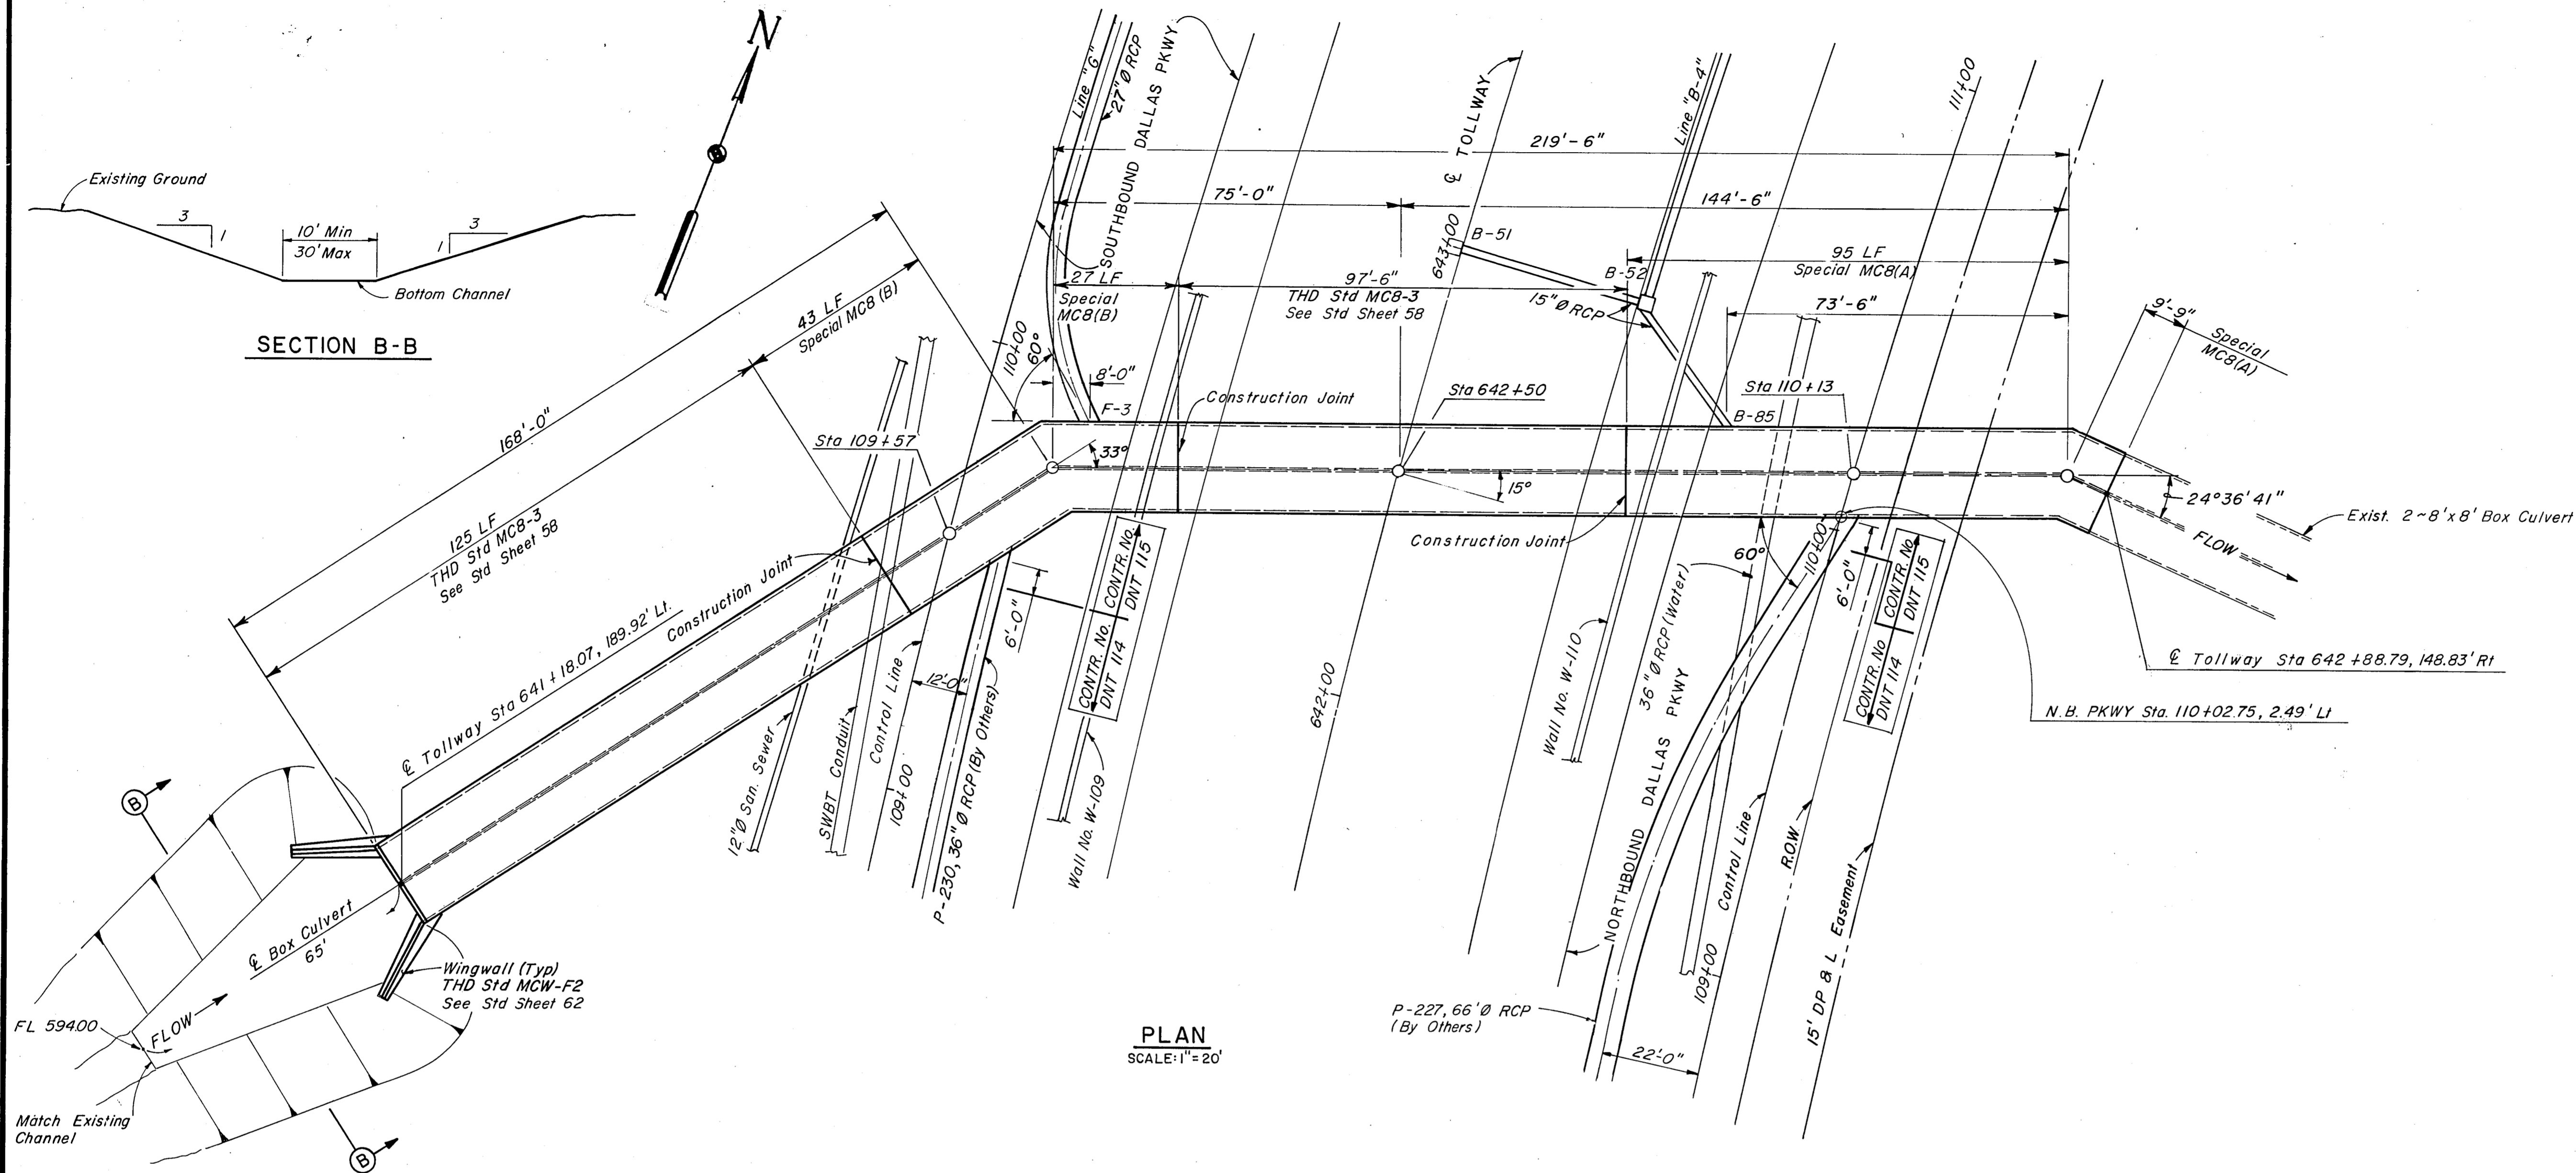

**PLAN**  
SCALE: 1" = 20'

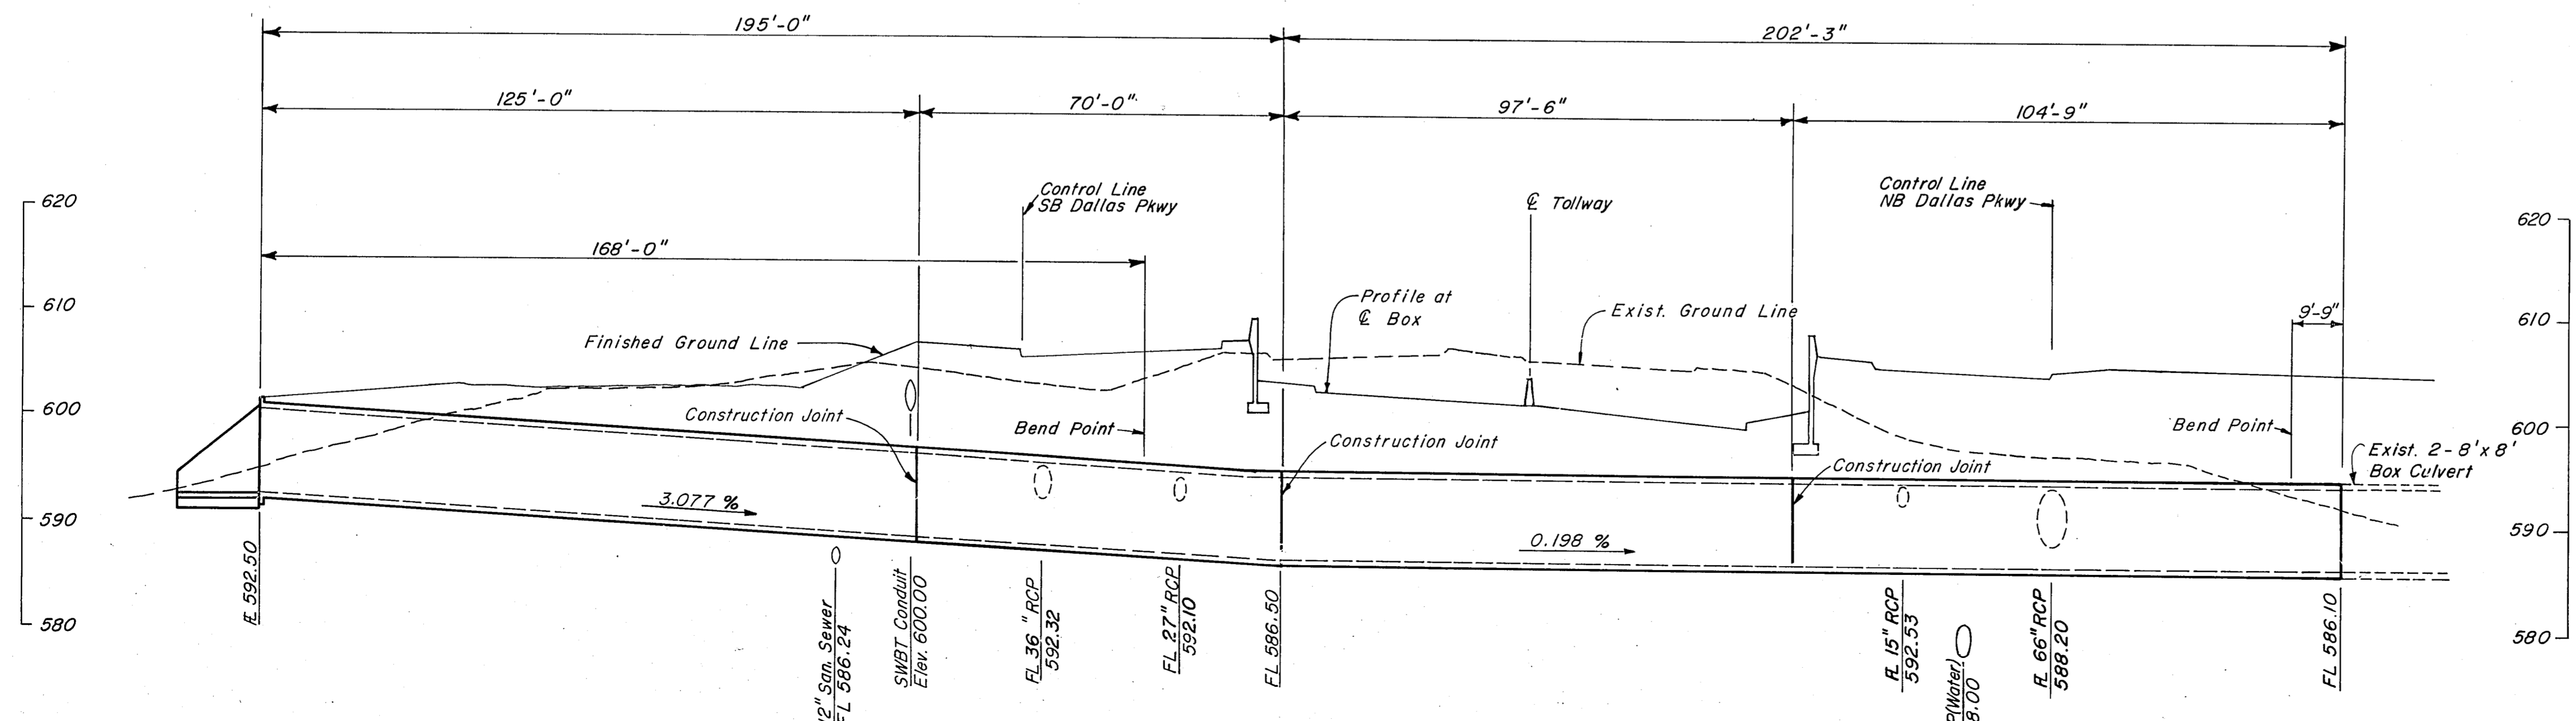


**PROFILE**  
SCALE: 1" = 20' HOR  
1" = 10' VERT

- NOTES:**
1. See Sheet R69 for Special MCB details.
  2. Contractor shall use extreme caution when excavating proposed box culvert because of close proximity to existing 12" sanitary sewer and 36" water line.
  3. All dimensions shown are measured along the centerline of the Box Culvert.
  4. All concrete shall be class "C".
  5. All reinforcing steel shall be ASTM A-615 grade 60.


**ASBUILT PLANS**

NO.	REVISION	BY	DATE
<b>TEXAS TURNPIKE AUTHORITY</b> <b>DALLAS NORTH TOLLWAY</b> <b>SPECIAL BOX CULVERT DETAILS</b> <b>STA 642+50</b>			
<b>Gibbs &amp; Hill, Inc.</b> <small>ENGINEERS DESIGNERS CONSTRUCTORS</small> <small>DALLAS</small>			<b>SECTION VII</b>
<small>DRAWN</small> VER <small>CHECKED</small> LSRa	<small>DATE</small> 7-5-83 <small>DATE</small> 7-6-83	<small>DESIGNED</small> LSRa <small>SCALE</small> As Shown	<small>DATE</small> 6-30-83
<small>CONTRACT NO. DNT-115 SHEET R68 OF R85</small>			




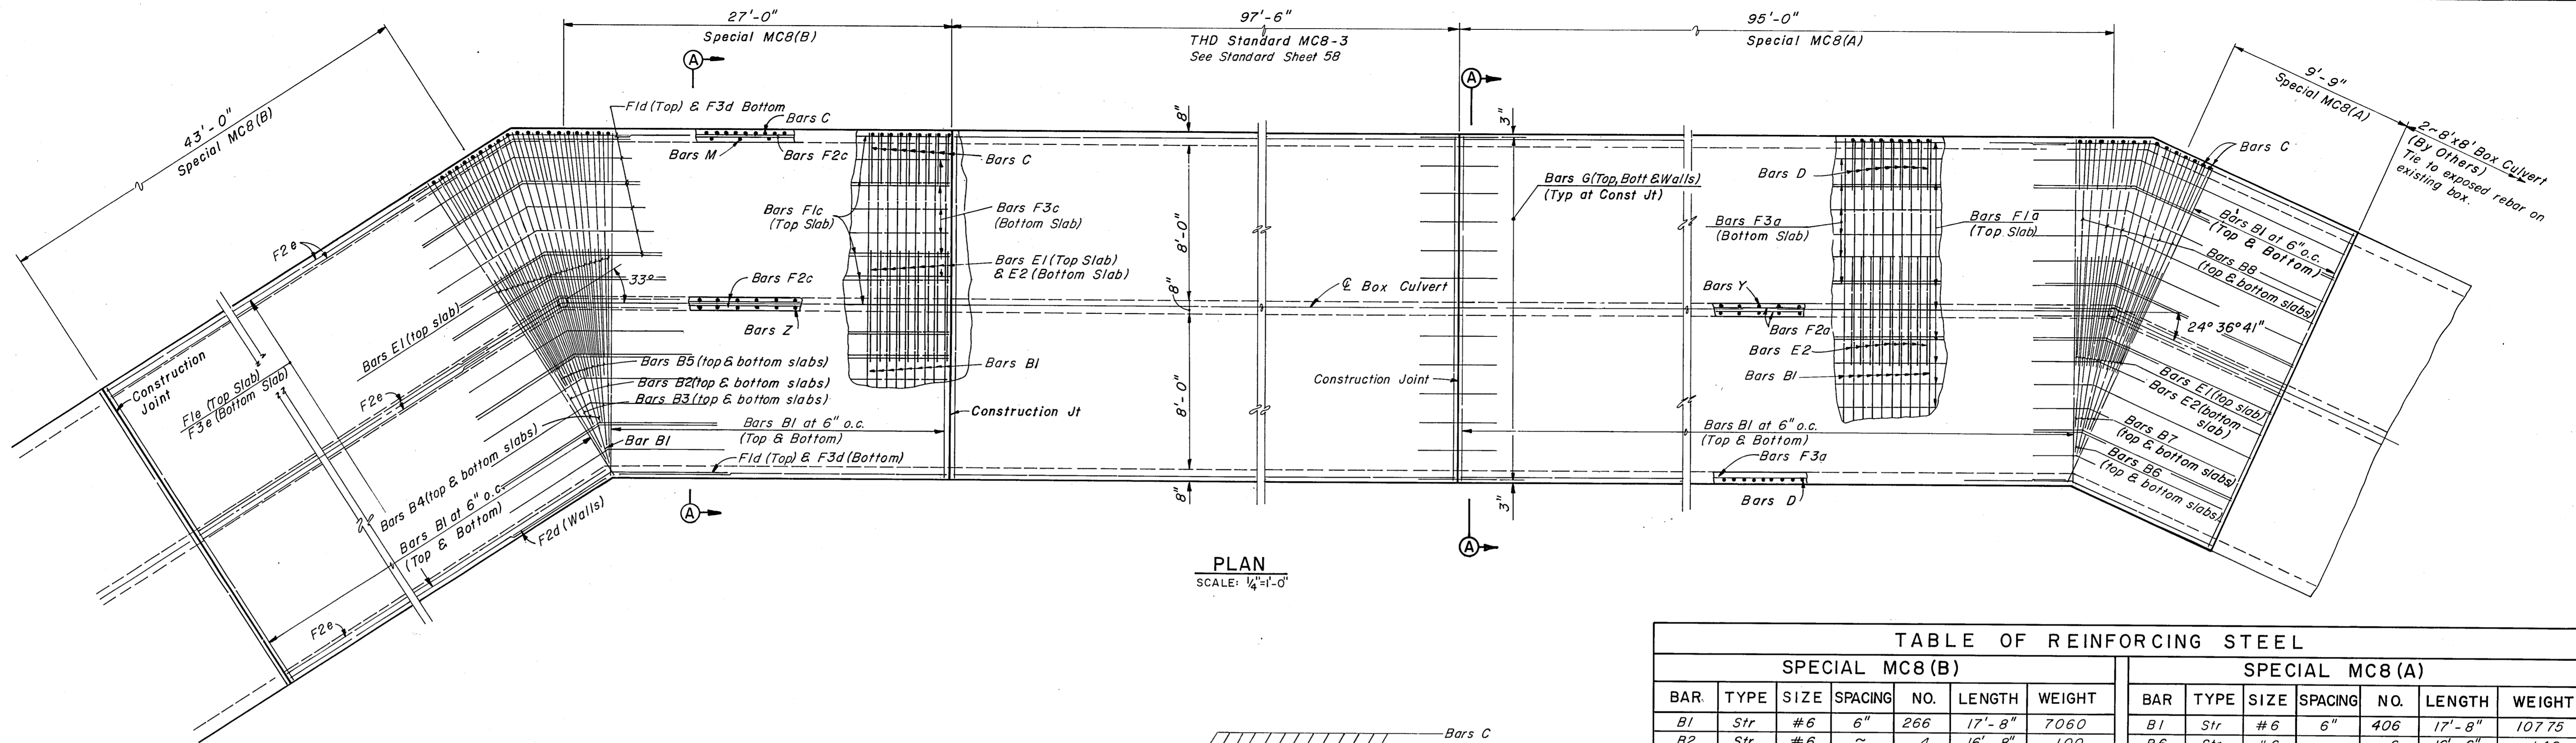

PLAN  
SCALE: 1/4"=1'-0"

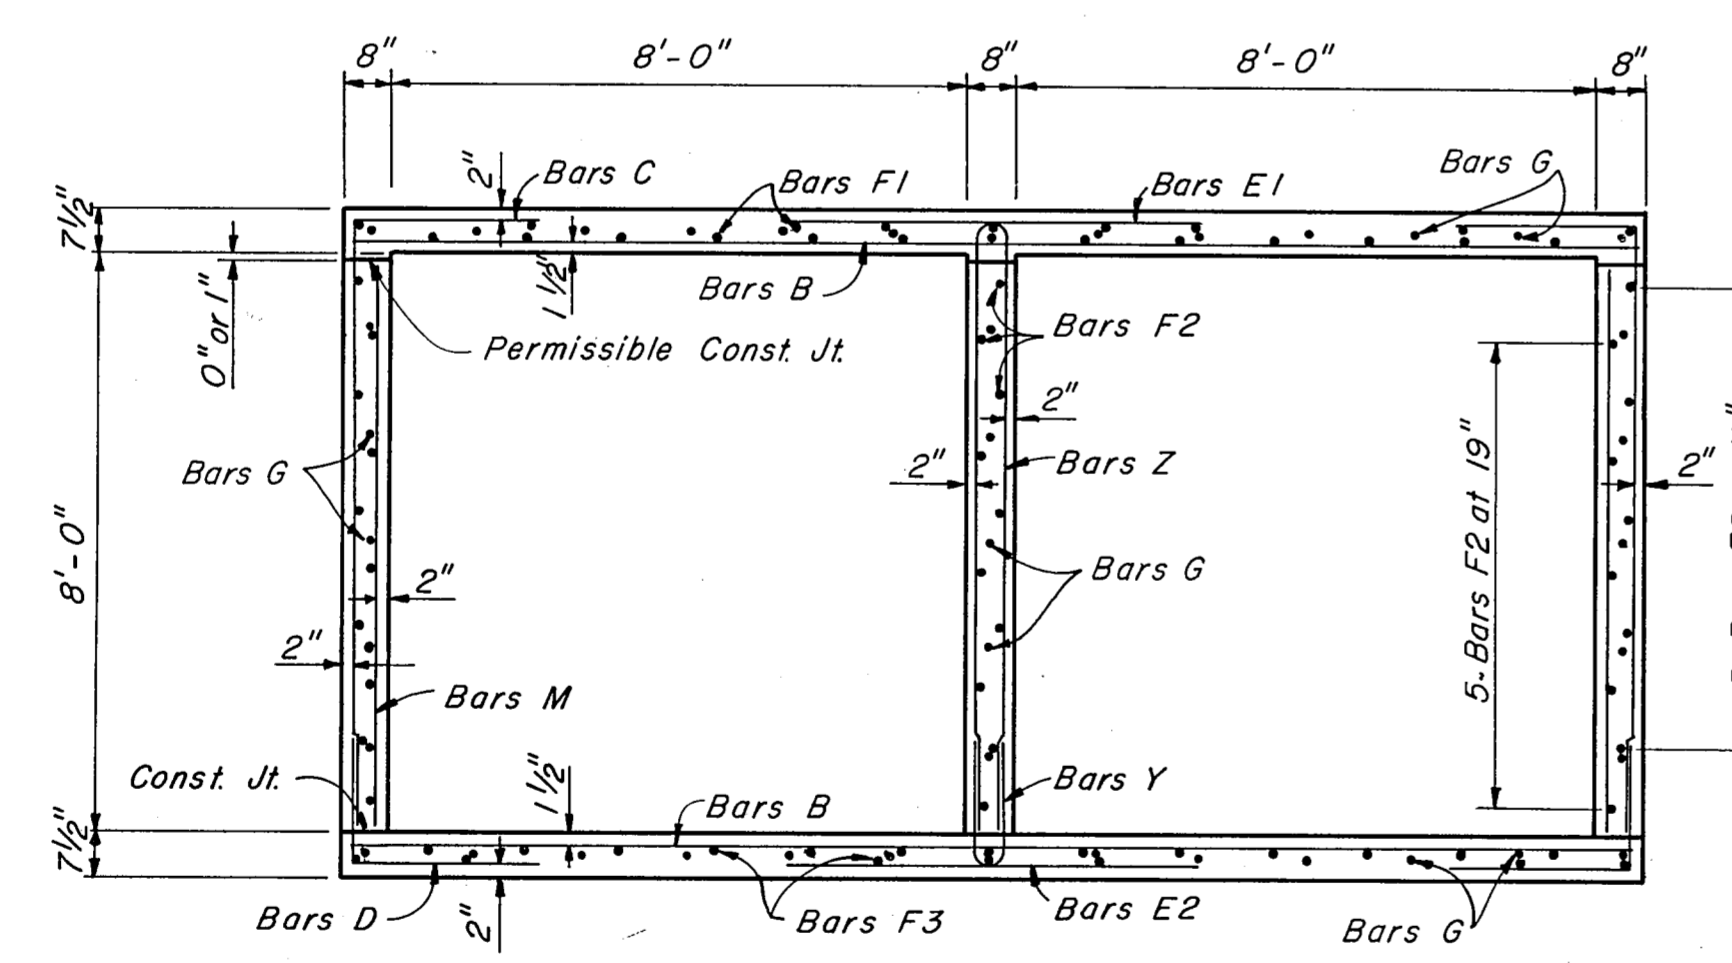

SECTION A-A  
SCALE: 3/8"=1'-0"

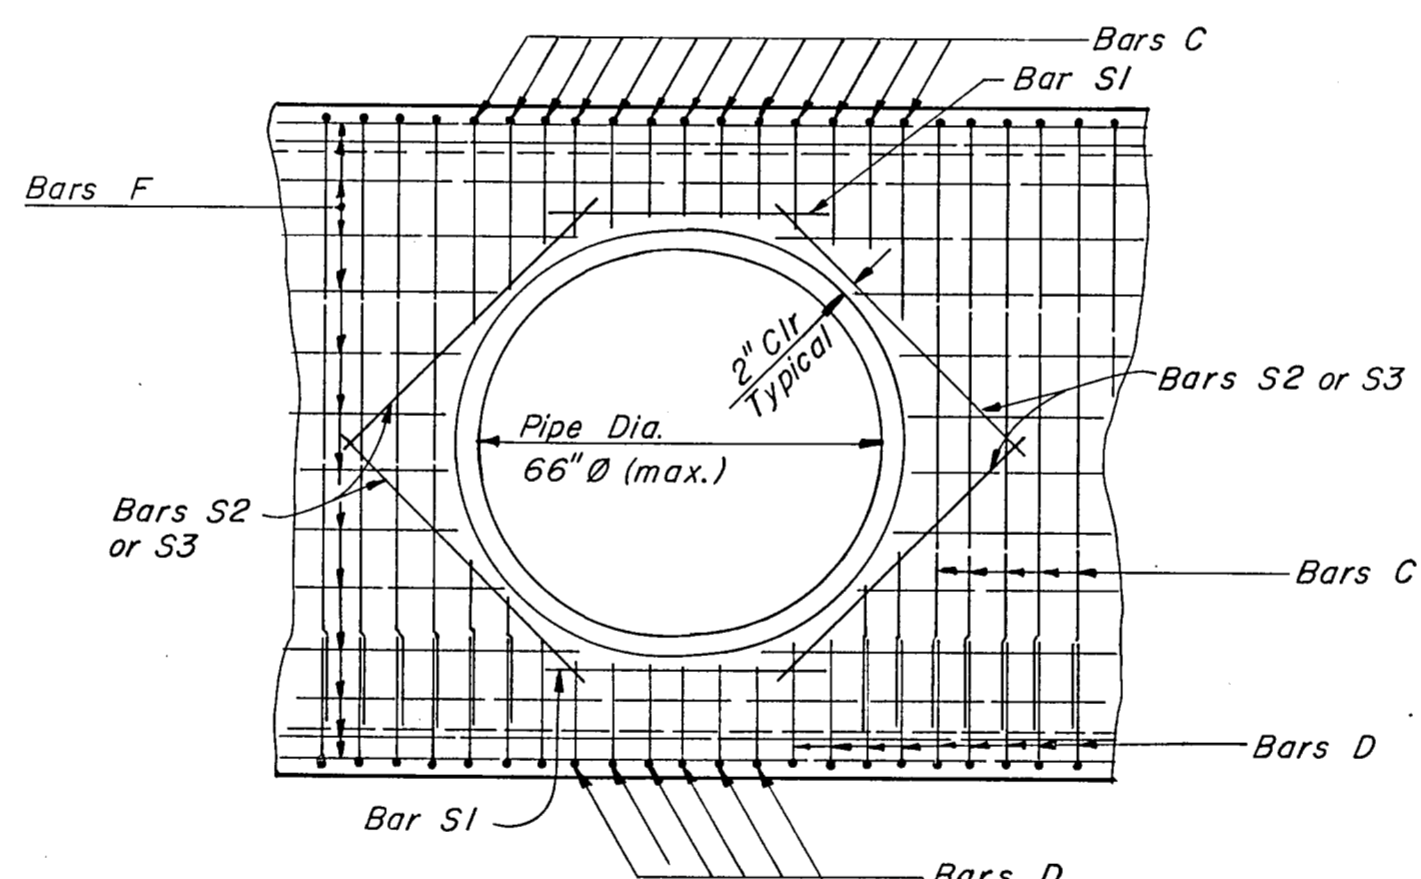


NOTES:  
1. Bars shall be cut to provide 2" clearance from outside diameter of pipe.  
2. See Sheet R68 for pipe entrance locations

TYPICAL PIPE ENTRANCE DETAIL  
NOT TO SCALE

SPECIAL MC8(B)							SPECIAL MC8(A)						
BAR	TYPE	SIZE	SPACING	NO.	LENGTH	WEIGHT	BAR	TYPE	SIZE	SPACING	NO.	LENGTH	WEIGHT
B1	Str	#6	6"	266	17'-8"	7060	B1	Str	#6	6"	406	17'-8"	10775
B2	Str	#6	~	4	16'-8"	100	B6	Str	#6	~	6	16'-6"	149
B3	Str	#6	~	4	16'-0"	96	B7	Str	#6	~	8	15'-0"	180
B4	Str	#6	~	4	15'-0"	90	B8	Str	#6	~	12	11'-6"	207
B5	Str	#6	~	24	12'-8"	457	C	Bent	#5	6"	420	10'-11"	4782
C	Bent	#5	6"	284	10'-11"	3234	D	Bent	#5	6"	420	4'-3"	2681
E1	Str	#6	6"	152	5'-8"	1294	E1	Str	#6	6"	211	5'-8"	1797
E2	Str	#6	6"	152	5'-8"	1294	E2	Str	#6	6"	211	5'-8"	1797
F1c	Str	#4	~	21	24'-0"	337	F1a	Str	#4	~	21	94'-3"	1322
F1d	Bent	#4	~	21	13'-0"	182	F1b	Bent	#4	19"	21	13'-8" Avg	192
F1e	Str	#4	~	21	40'-6"	568	F2a	Str	#4	~	30	94'-3"	1889
F2c	Str	#4	~	30	24'-0"	481	F2b	Bent	#4	~	30	13'-8" Avg	274
F2d	Bent	#4	19"	30	13'-0"	261	F3a	Str	#4	~	21	94'-3"	1322
F2e	Str	#4	~	30	40'-6"	812	F3b	Bent	#4	~	21	13'-8" Avg	192
F3c	Str	#4	~	19	24'-0"	305	G	Str	#5	17 1/2"	41	4'-0"	171
F3d	Bent	#4	~	19	13'-0"	165	M	Str	#4	18"	141	7'-11"	746
F3e	Str	#4	~	19	40'-6"	514	Y	Bent	#4	12"	106	3'-7"	254
G	Str	#5	17 1/2"	82	4'-0"	342	Z	Bent	#4	12"	106	17'-1"	1210
M	Str	#4	18"	96	7'-11"	508	S1	Str	#4	~	2	4'-0"	5
Y	Bent	#4	12"	71	3'-7"	170	S2	Str	#4	~	4	4'-9"	13
Z	Bent	#4	12"	71	17'-1"	810	S3	Str	#4	~	4	5'-0"	13
S3	Str	#4	~	8	5'-0"	27							

\* Quantities are for Contractor's information only.  
□ Bar length includes 1'-1"-6" lap.

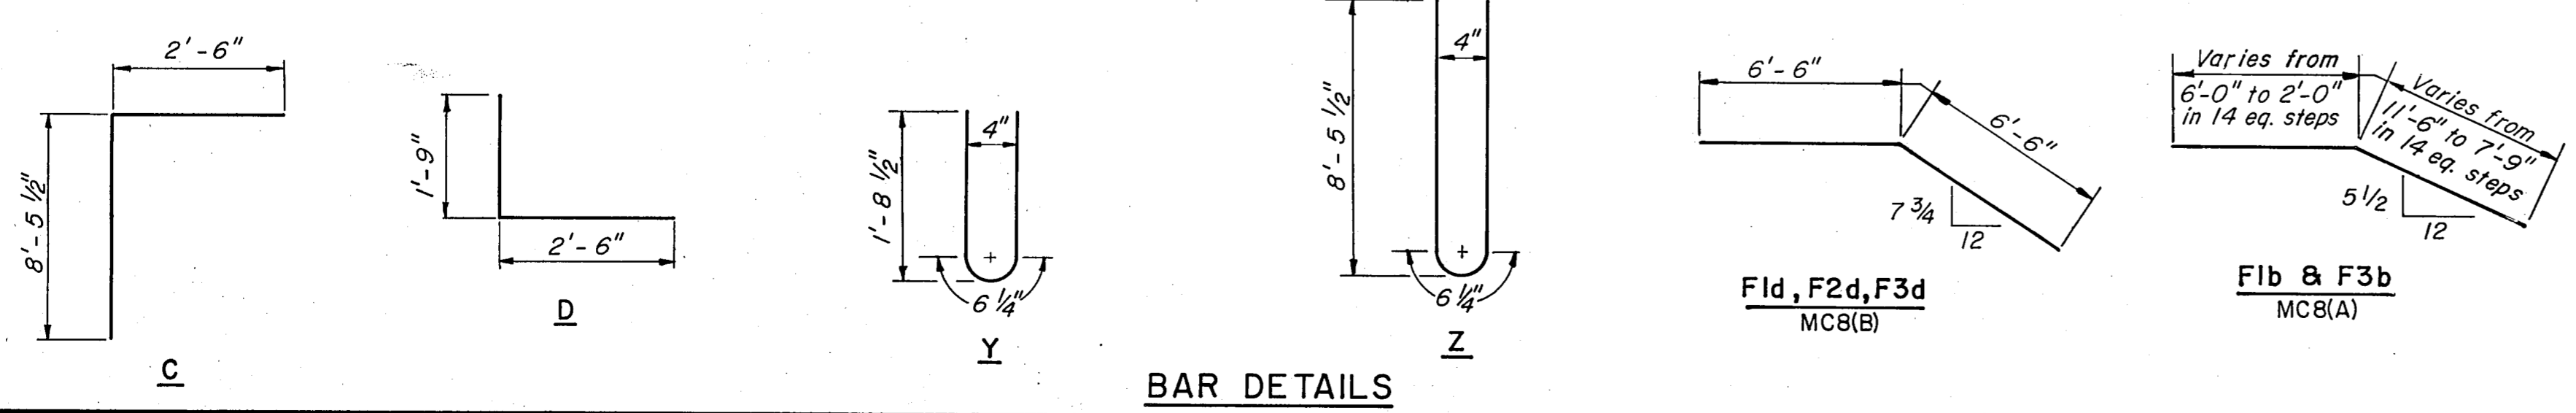


BAR DETAILS

ASBUILT PLANS


NO.	REVISION	BY	DATE
TEXAS TURNPIKE AUTHORITY DALLAS NORTH TOLLWAY			
SPECIAL BOX CULVERT DETAILS STA 642+50			
<b>Gibbs &amp; Hill, Inc.</b> ENGINEERS DESIGNERS CONSTRUCTORS DALLAS			SECTION VII
DRAWN	VER	DATE	12-19-83
DESIGNED	LSRa	DATE	6-3-83
CHECKED	REF	DATE	12-30-83
SCALE	As Shown		
CONTRACT NO. DNT-115 SHEET R69 OF R85			



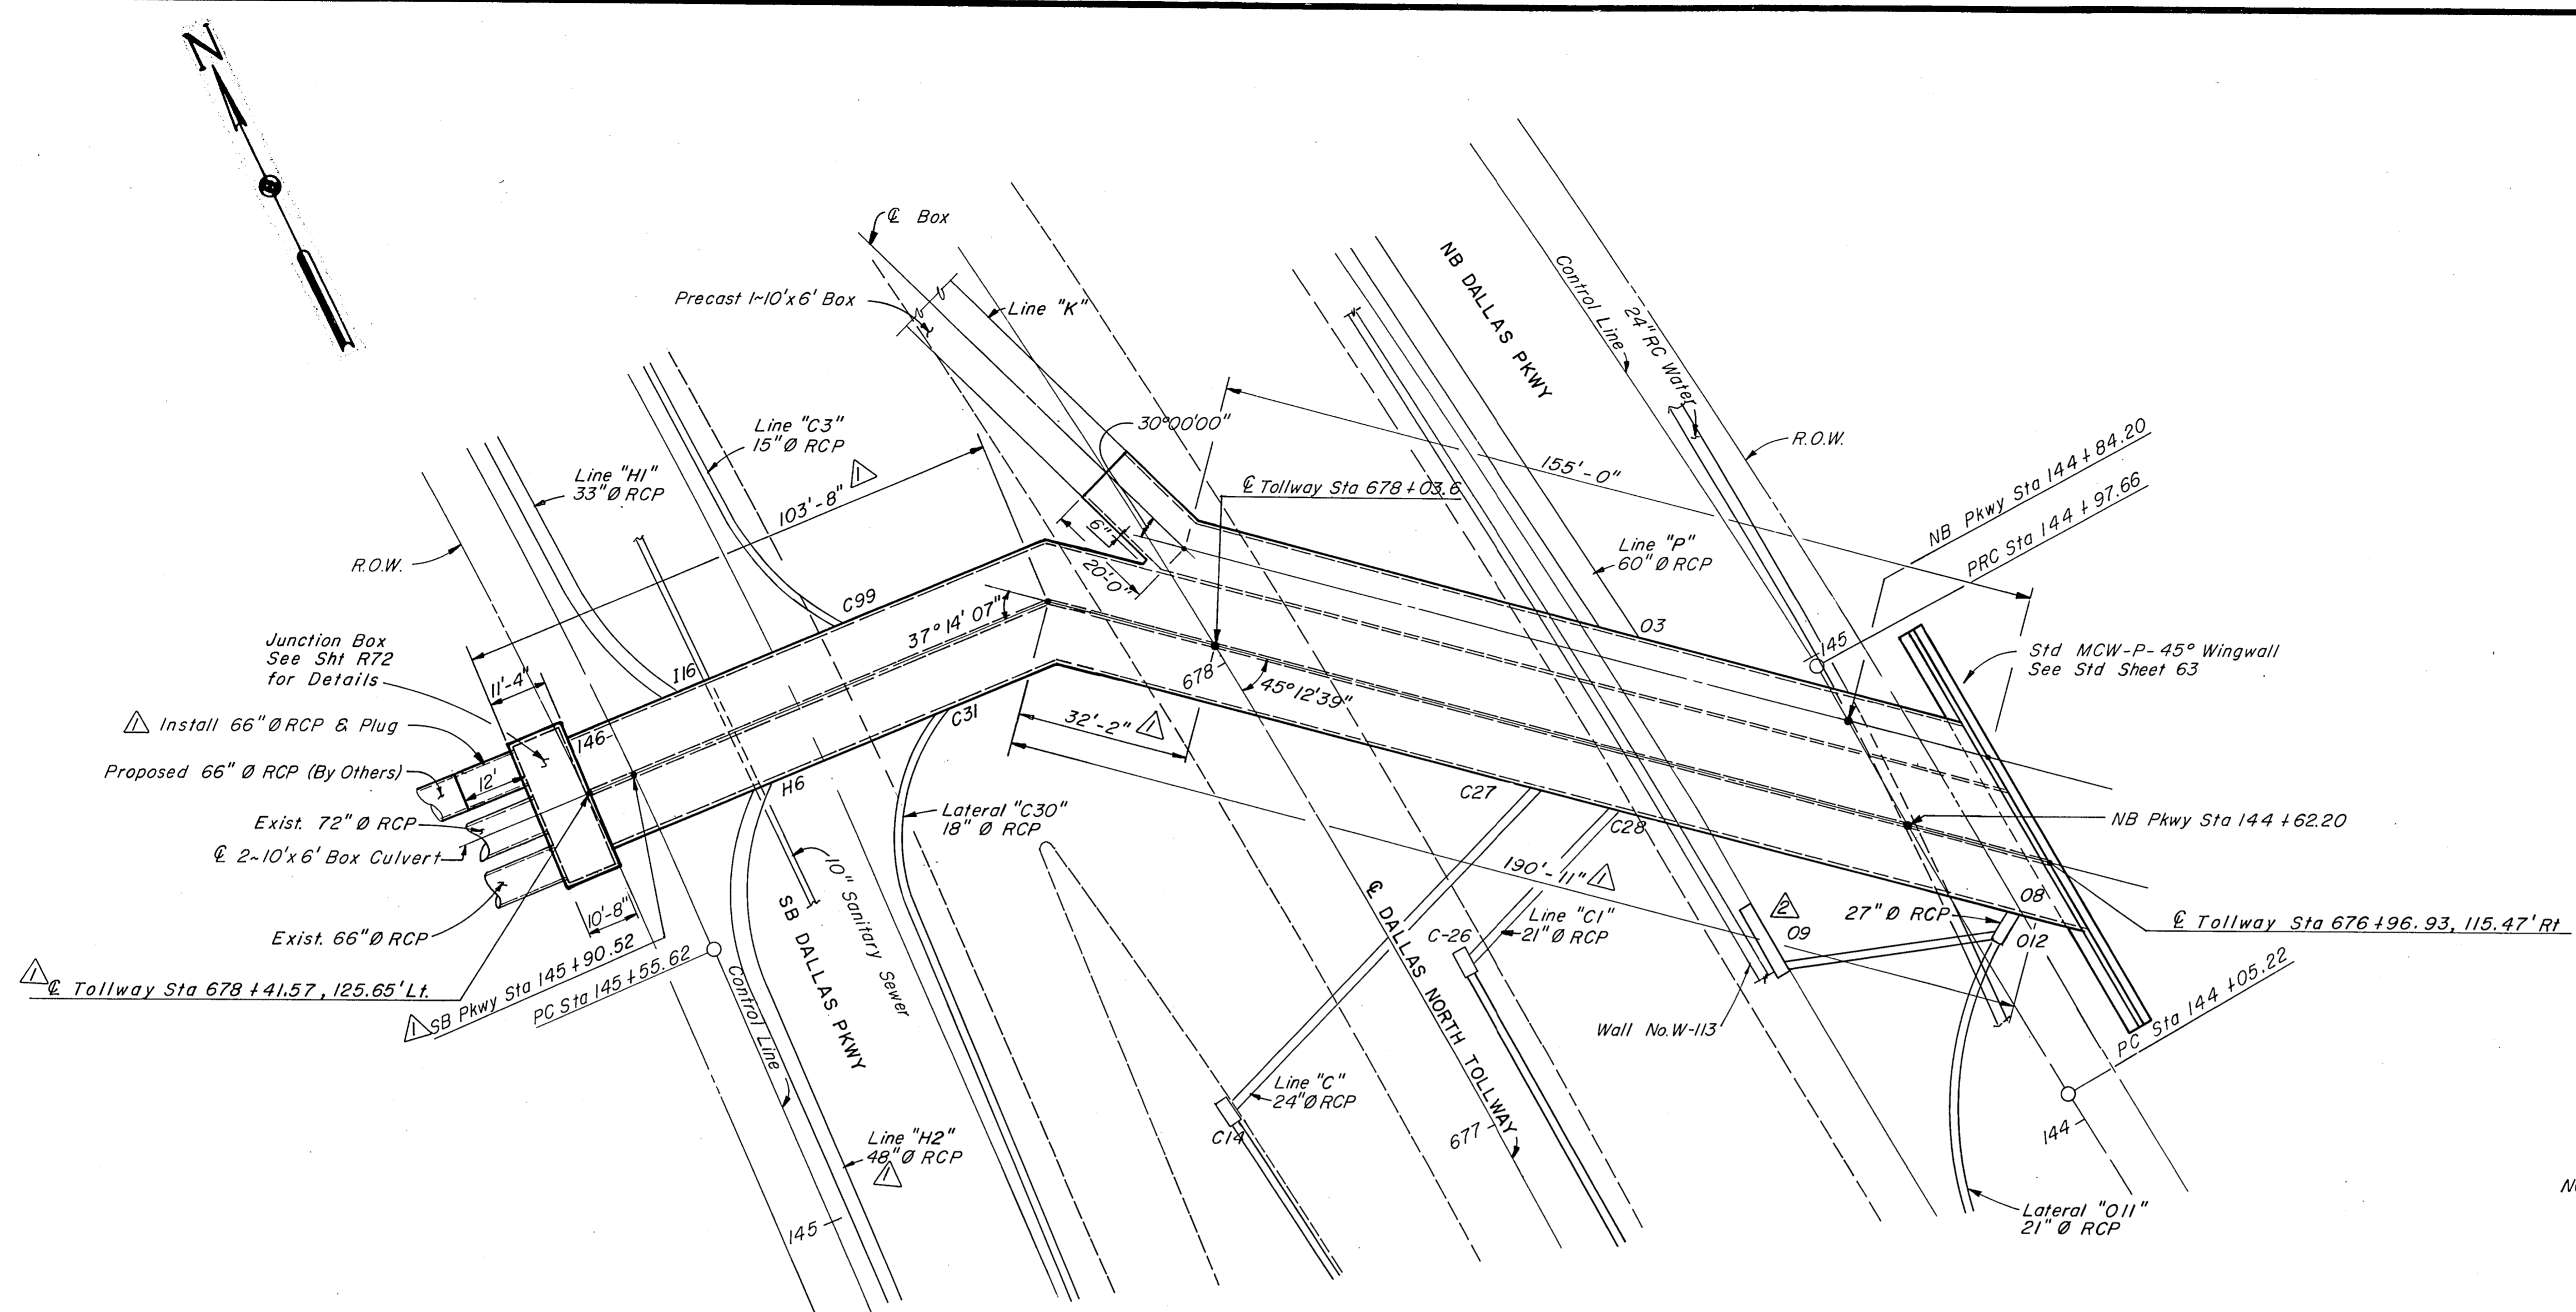

NOTES: 1. Contractor shall use extreme caution when excavating for proposed box culvert because of close proximity of existing 24" water line.  
 2. See Sheet R71 for wingwall details.

PLAN  
 SCALE: 1" = 20'

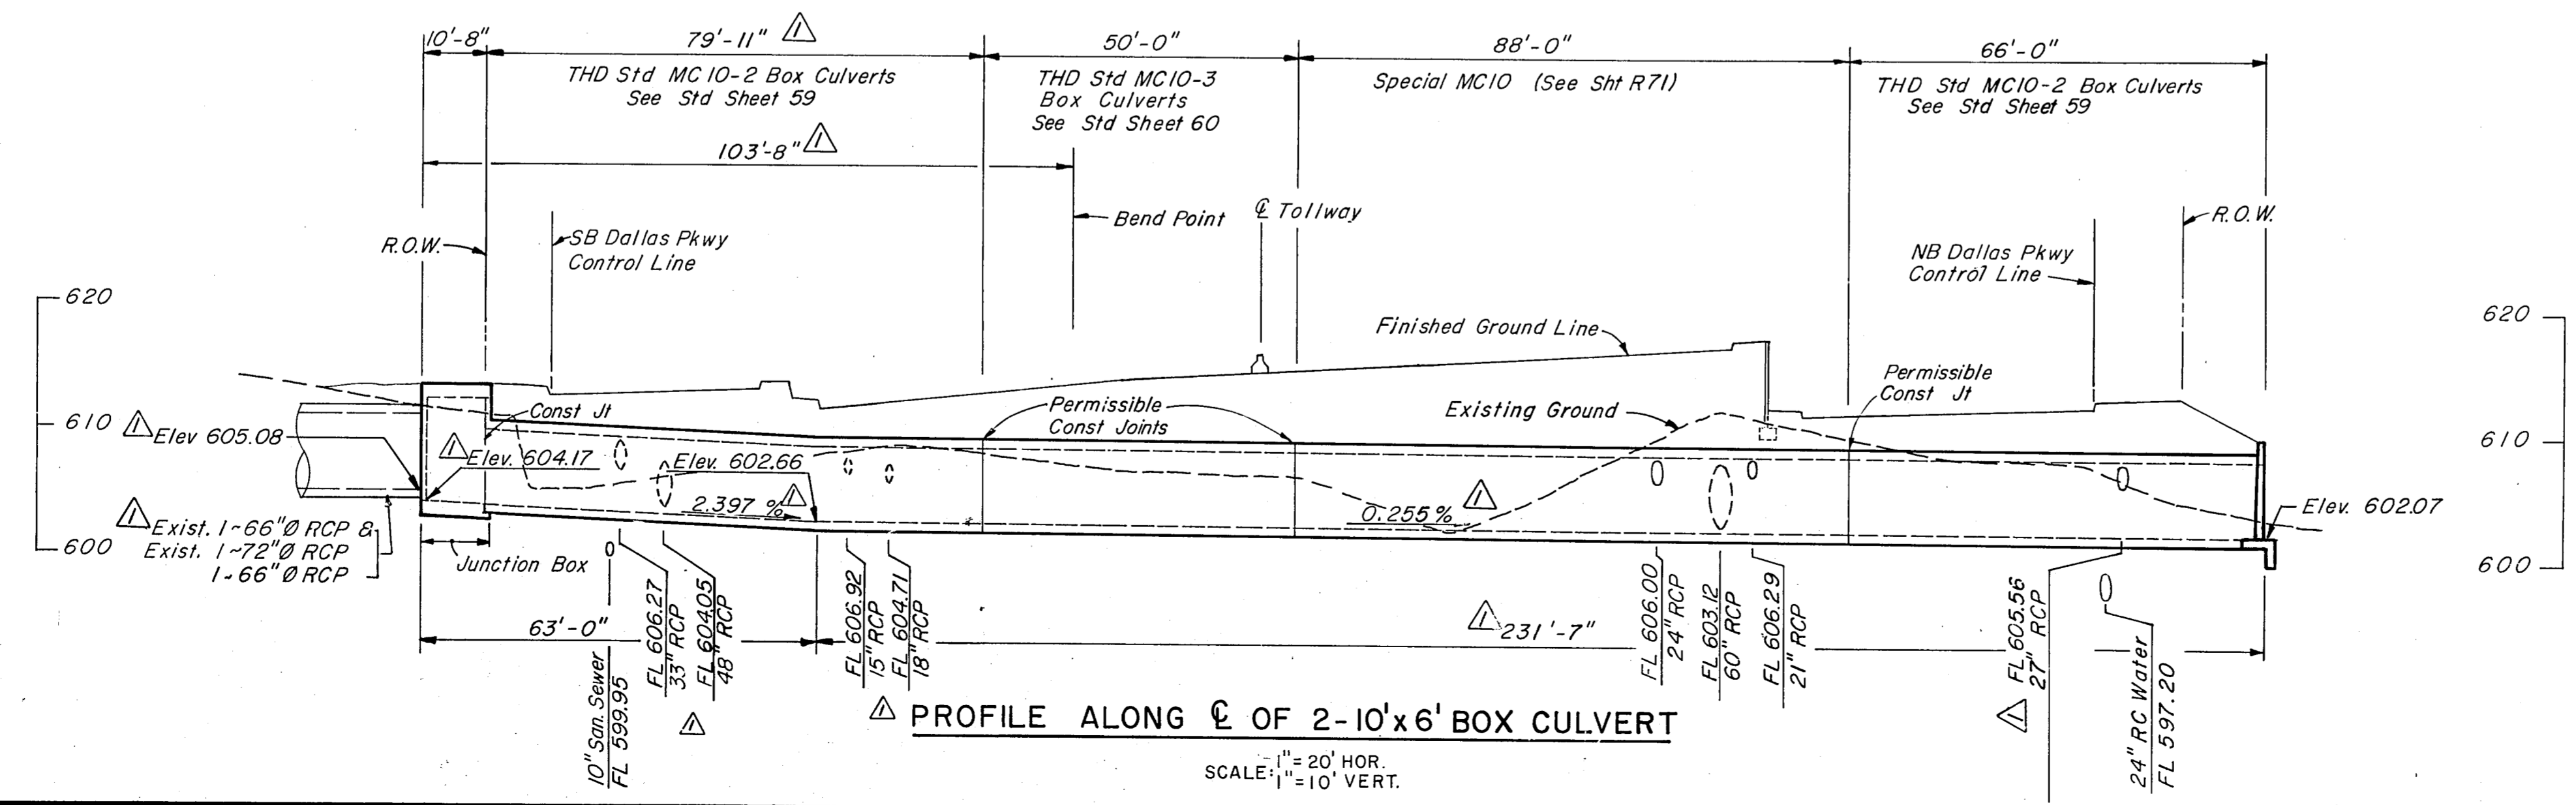

PROFILE ALONG C OF 2-10'x6' BOX CULVERT  
 SCALE: 1" = 20' HOR.  
 1" = 10' VERT.

ASBUILT PLANS


Change Cross-Slope on N. B. Dallas Parkway	MGB	5-16-86
Revised Length of 2-10'x6' Box Culvert & Width of Junction Box	B&A	2-5-85
NO.	REVISION	BY DATE

TEXAS TURNPIKE AUTHORITY  
 DALLAS NORTH TOLLWAY  
 BOX CULVERT LAYOUT  
 STA 678 + 20

Gibbs & Hill, Inc.  
 ENGINEERS DESIGNERS CONSTRUCTORS  
 DALLAS SECTION VII

DRAWN VER	DATE 1-27-84	DESIGNED REW	DATE 1-21-84
CHECKED REW	DATE 1-28-84	SCALE As Shown	



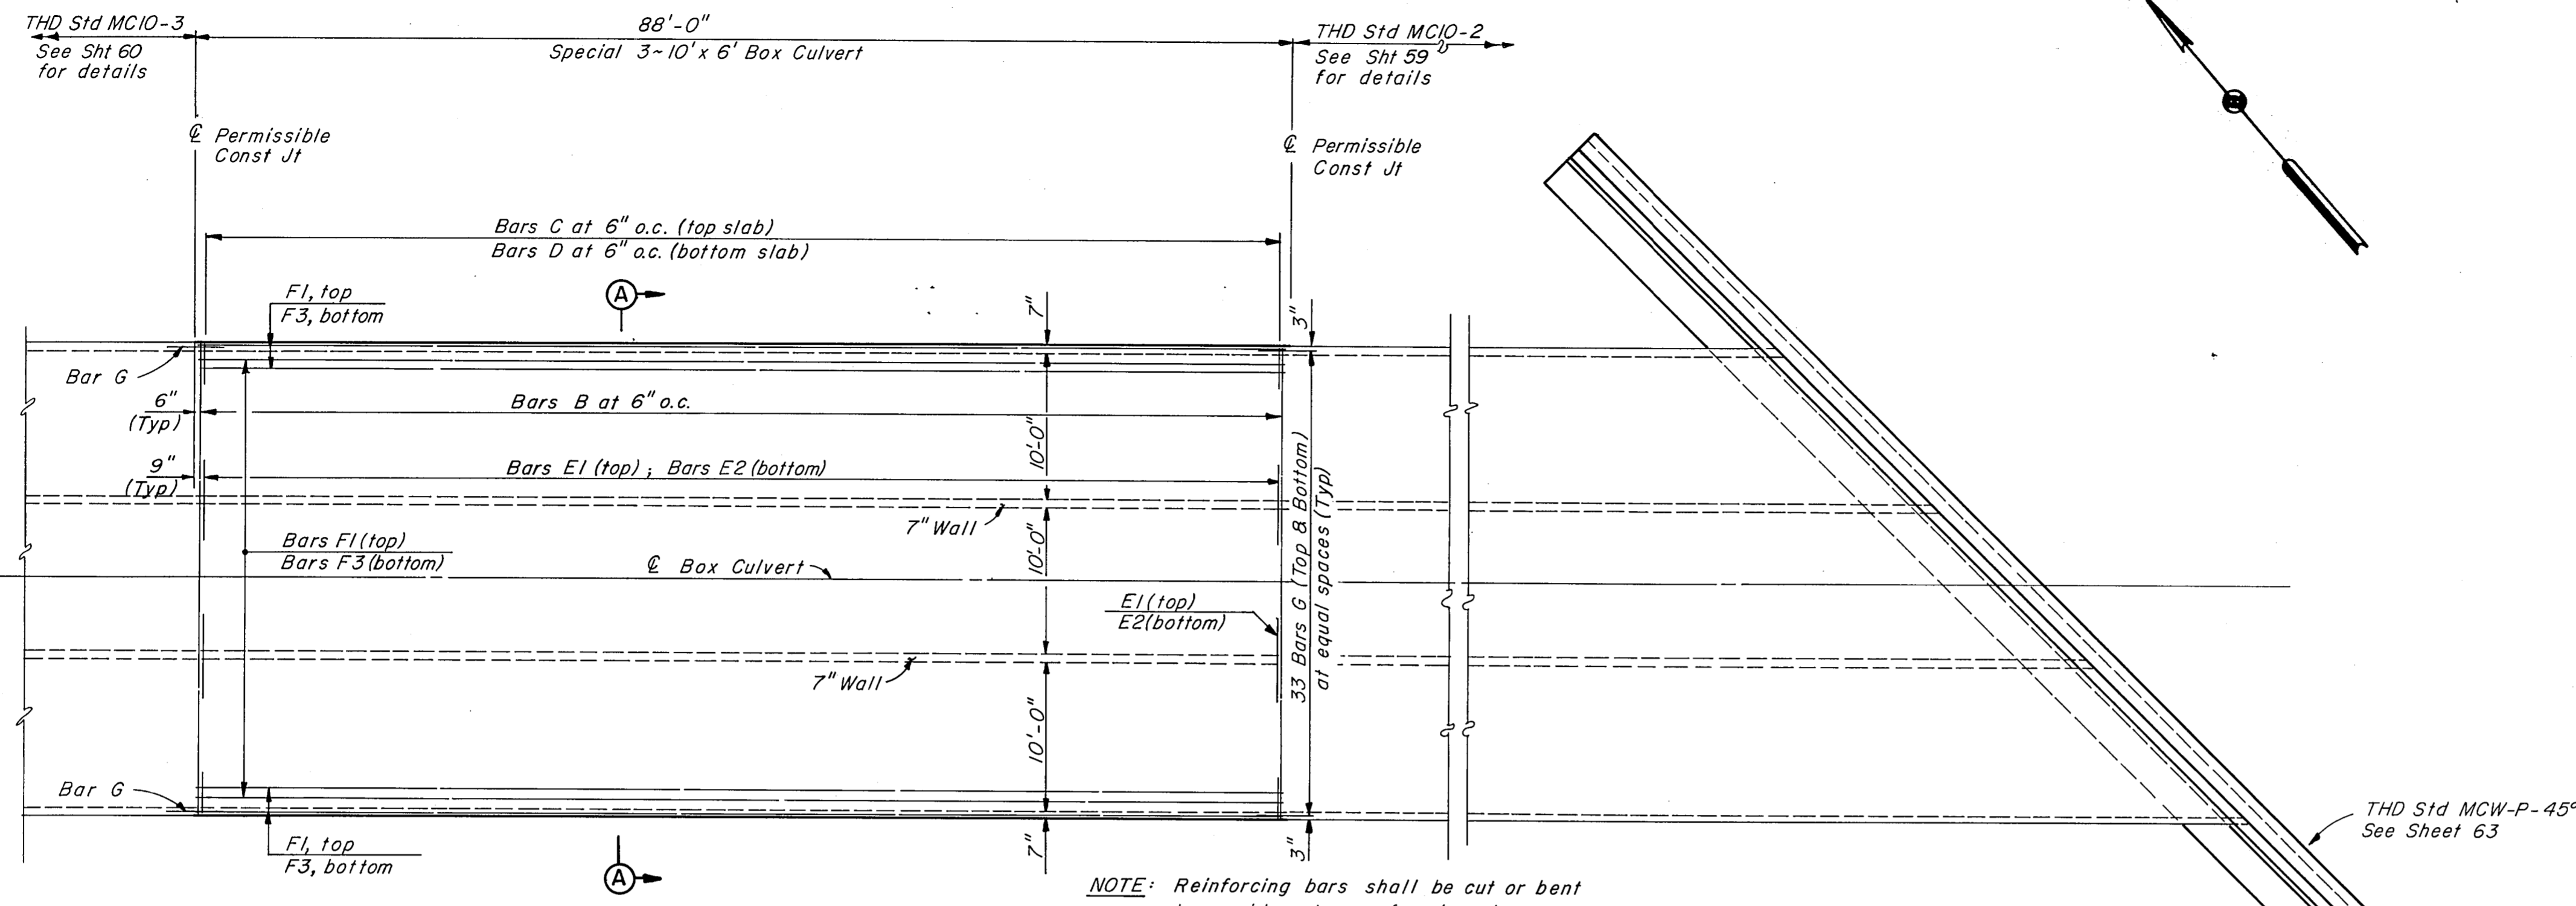


**PLAN**  
SCALE: 1/8"=1'

NOTE: Reinforcing bars shall be cut or bent to provide entrance for pipe where necessary.


TABLE OF REINFORCING STEEL						
BAR	TYPE	SIZE	SPACING	NO.	LENGTH	WEIGHT
B	Str	#5	6"	350	32'-0"	11682
C	Bent	#5	6"	350	9'-5"	3438
D	Str	#6	6"	350	5'-1"	2672
E1	Str	#6	6"	348	5'-8"	2962
E2	Str	#6	5 1/2"	380	5'-8"	3234
F1	Str	#4	~	35	89'-4"	2089
F2	Str	#4	9"	32	89'-4"	1910
F3	Str	#4	~	35	89'-4"	2089
M	Str	#4	15"	144	5'-11"	569
Y	Bent	#4	12"	176	3'-11"	460
Z	Bent	#4	12"	176	13'-5"	1577
G	Str	#4	12"	132	4'-0"	353

ESTIMATED QUANTITY SUMMARY			
ITEM NO.	DESCRIPTION	UNIT	QUANTITY
* 421	CLASS C CONCRETE	CY	212.5
* 440	REINFORCING STEEL	Lbs	33,035

Bar length includes one-1'-6" lap.  
Quantities are for Contractor's information only.

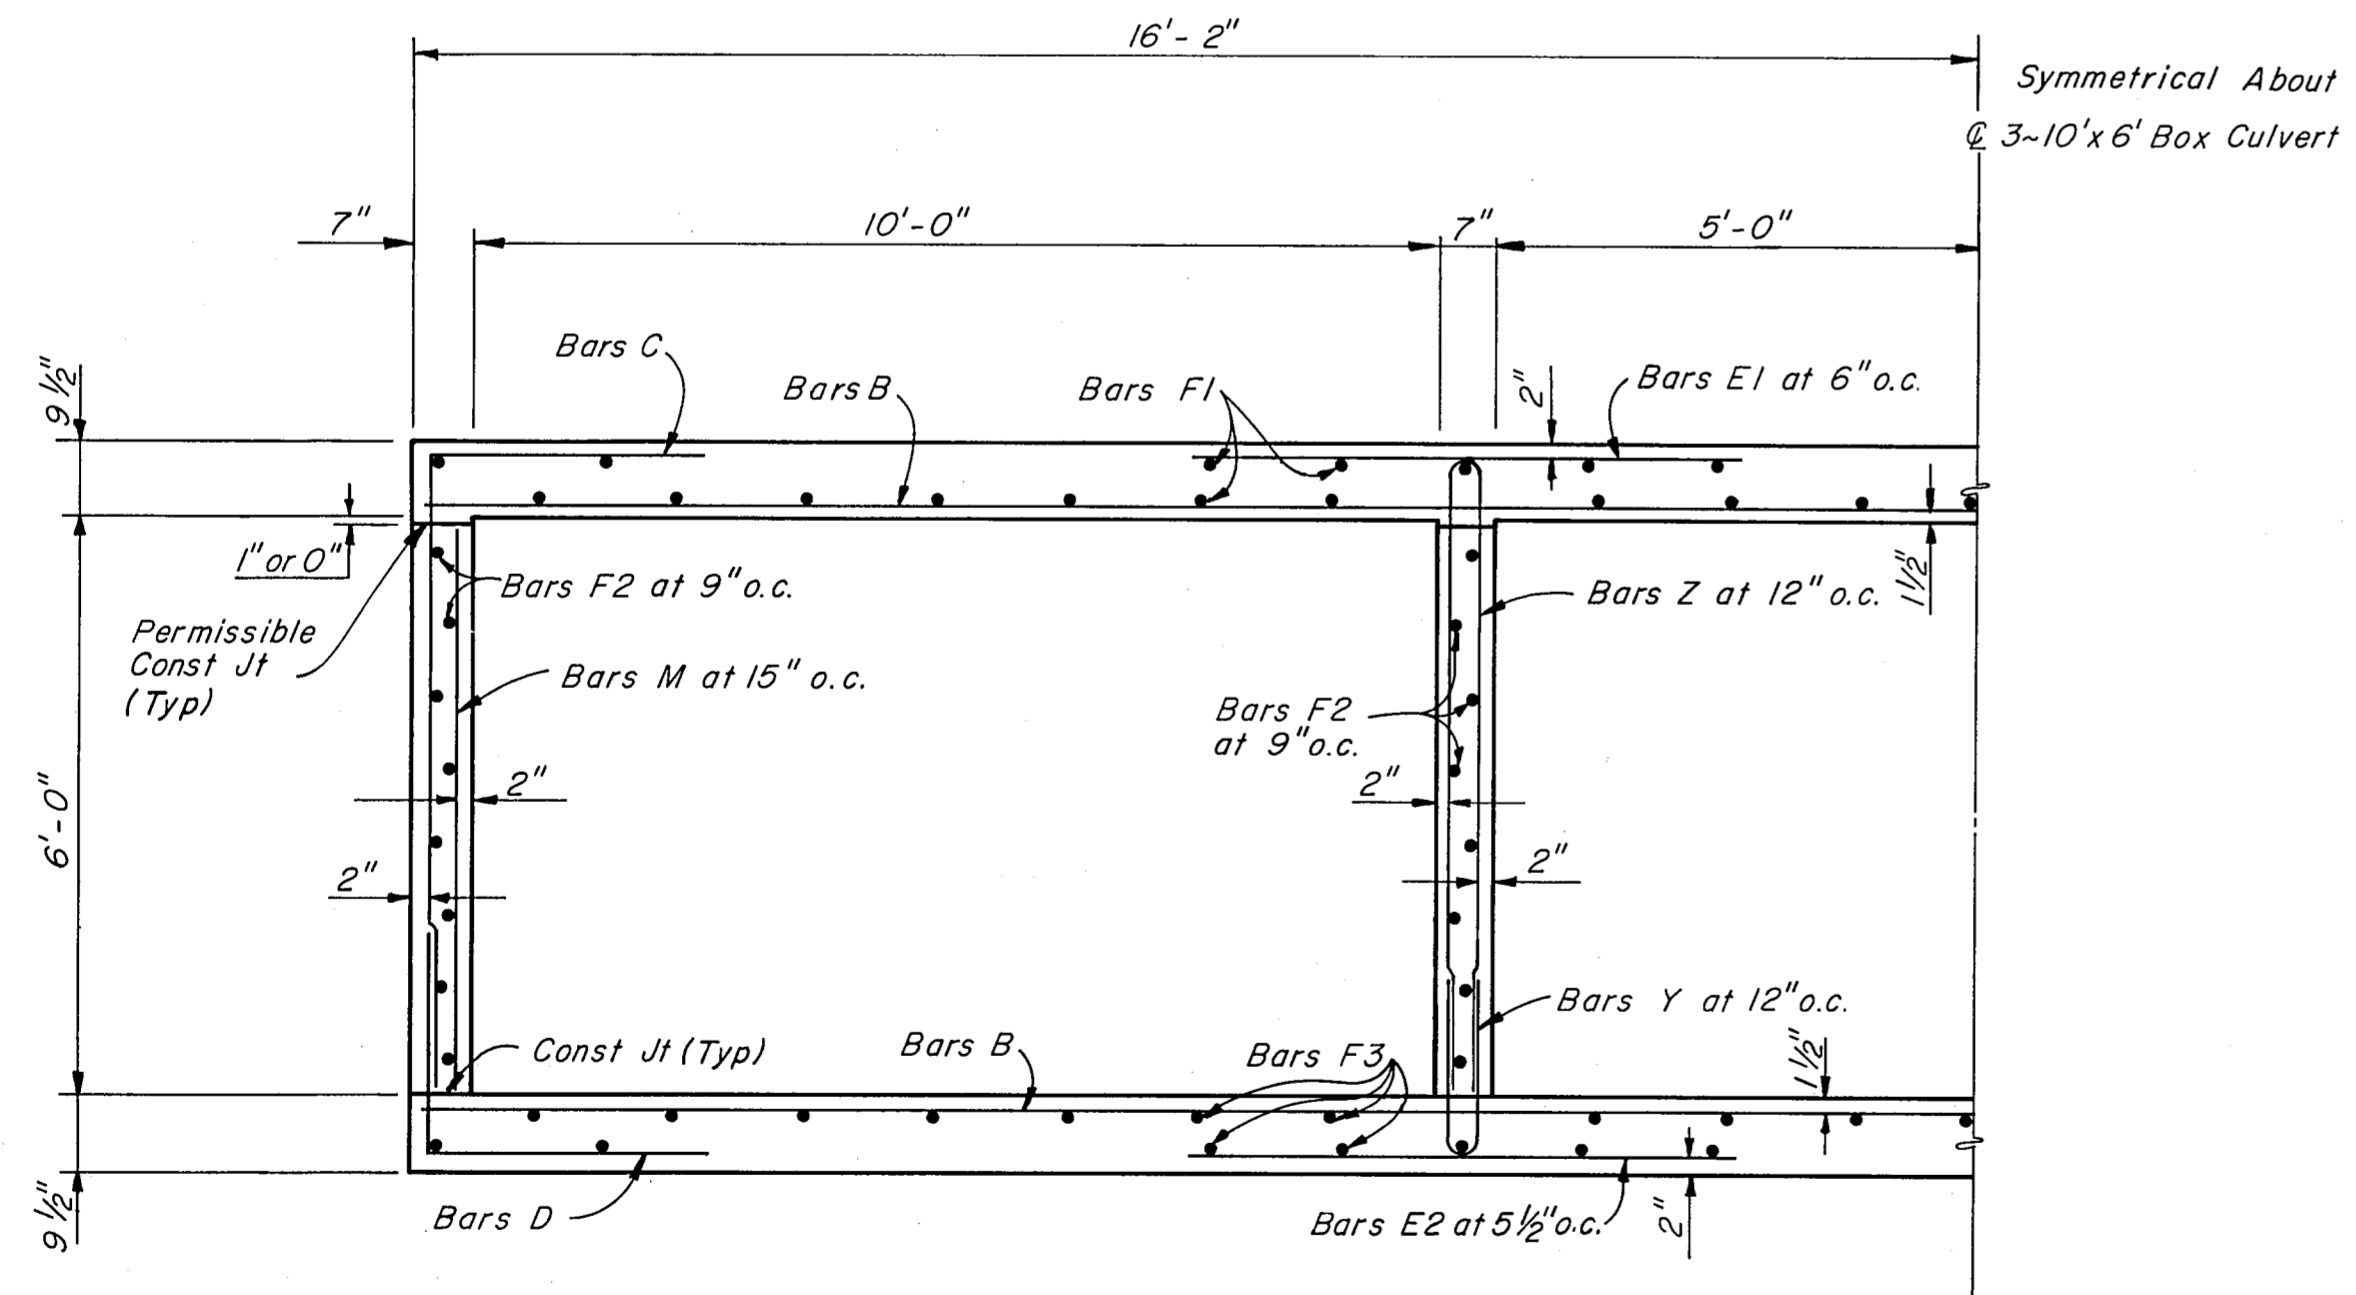

**HALF SECTION A-A**  
SCALE: 1/2"=1'

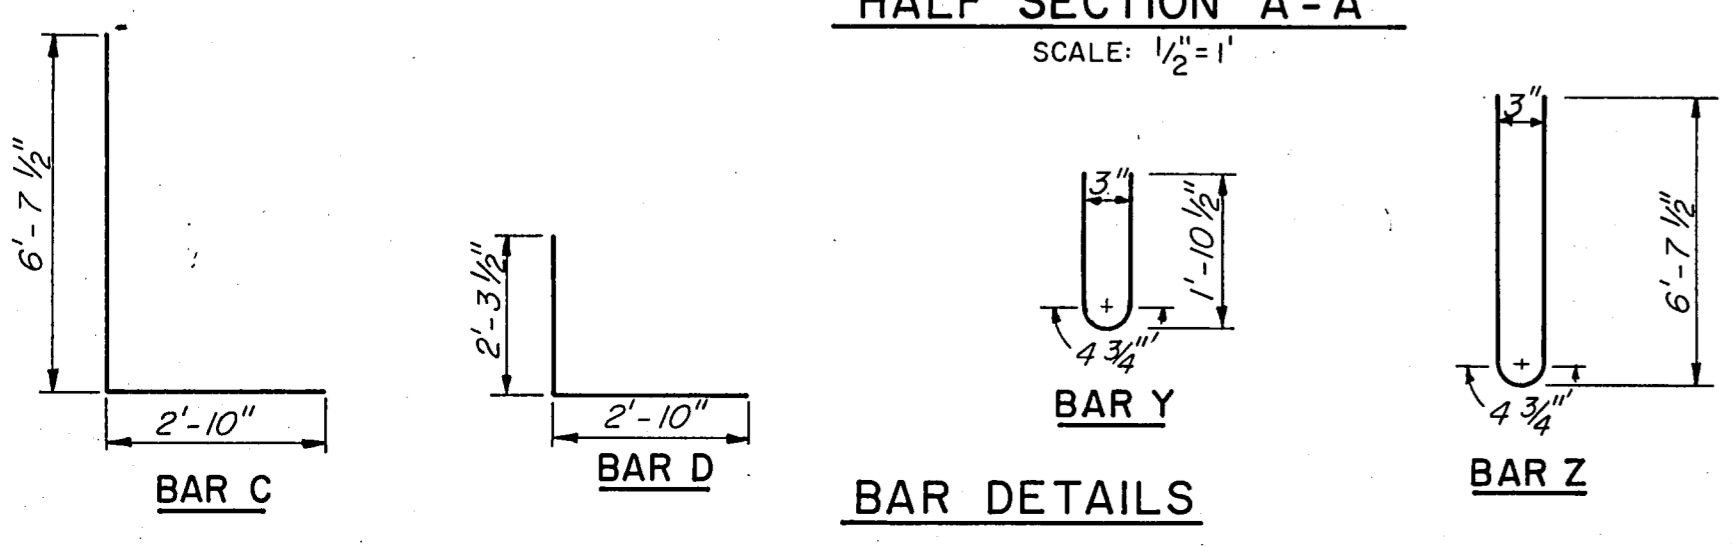

**ASBUILT PLANS**

NO.	REVISION	BY	DATE
TEXAS TURNPIKE AUTHORITY <b>DALLAS NORTH TOLLWAY</b> SPECIAL BOX CULVERT DETAILS STA 678 + 20			

**Gibbs & Hill, Inc.**  
ENGINEERS DESIGNERS CONSTRUCTORS DALLAS

SECTION VII

DRAWN VER DATE 2-6-84 DESIGNED HS DATE 2-1-84  
CHECKED REF DATE 2-6-84 SCALE As Shown













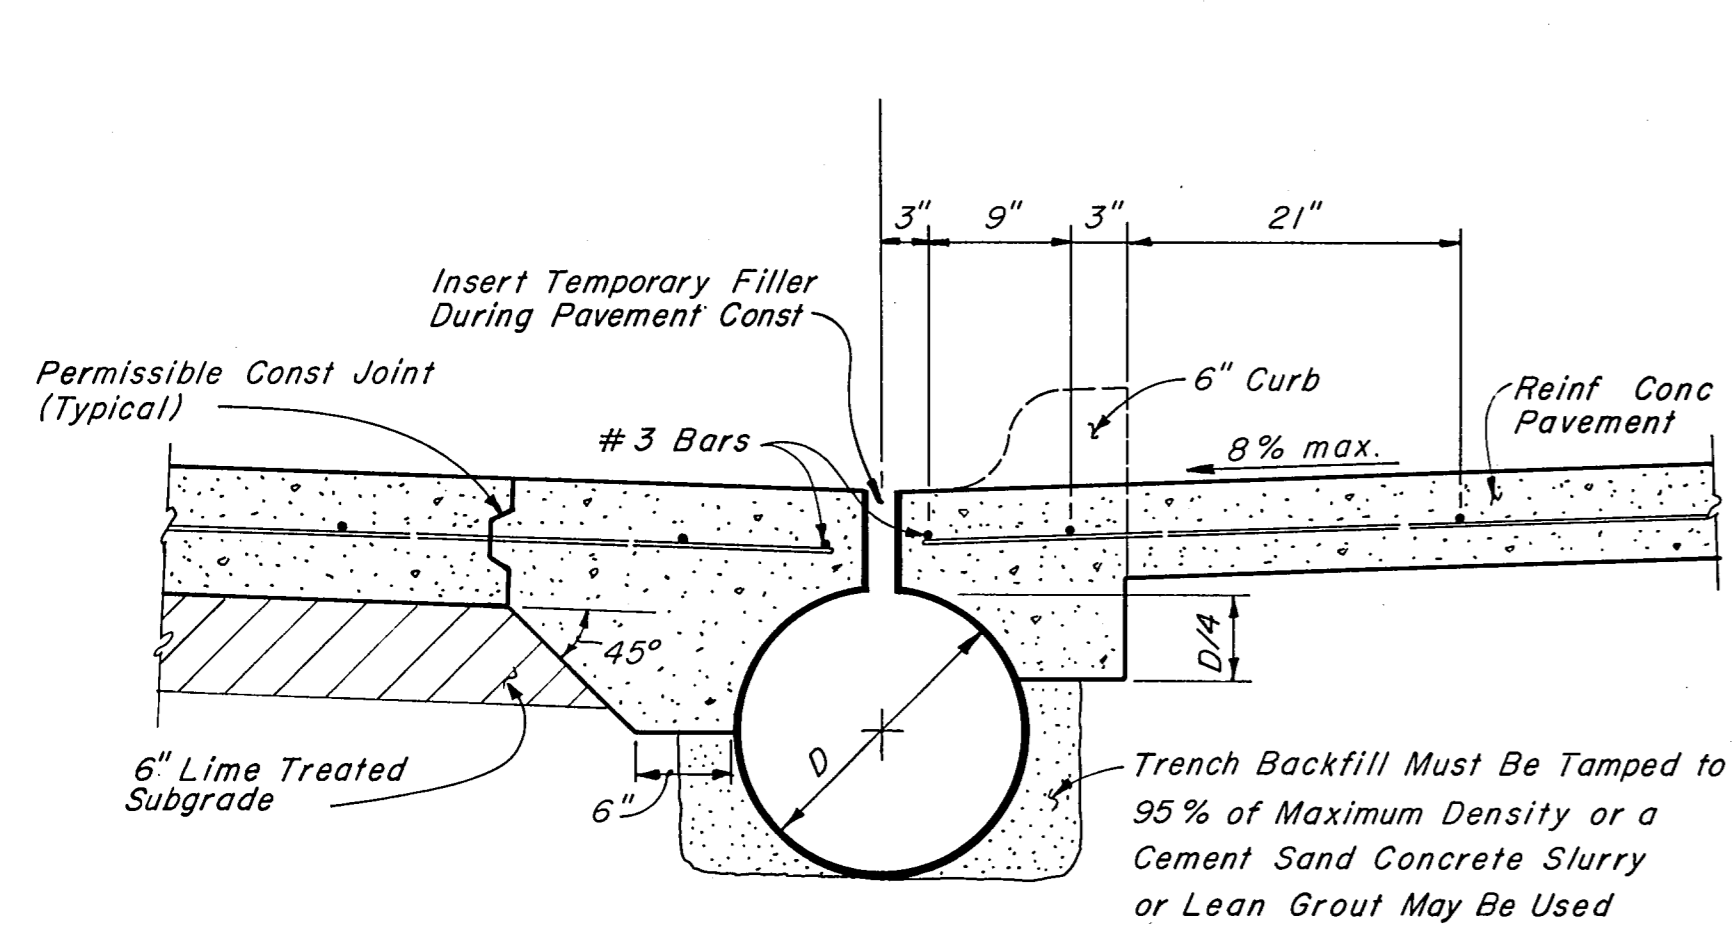

**SLOTTED DRAIN DETAIL FOR REINFORCED CONCRETE PAVEMENT**

NOTES: Slotted drain is manufactured in 20' lengths. Installations should be multiples of 20' or half-length sections of 10'. Slotted drains shall be connected to storm drain laterals by standard bends, connecting bands and the required length and size of corrugated metal pipe. The extra concrete for the thickened pavement shall be included in the cost of the drain. Paving details shown are for use with 6" deep grate on slotted drain. Heel plate shall be installed according to manufacturer's recommendations.

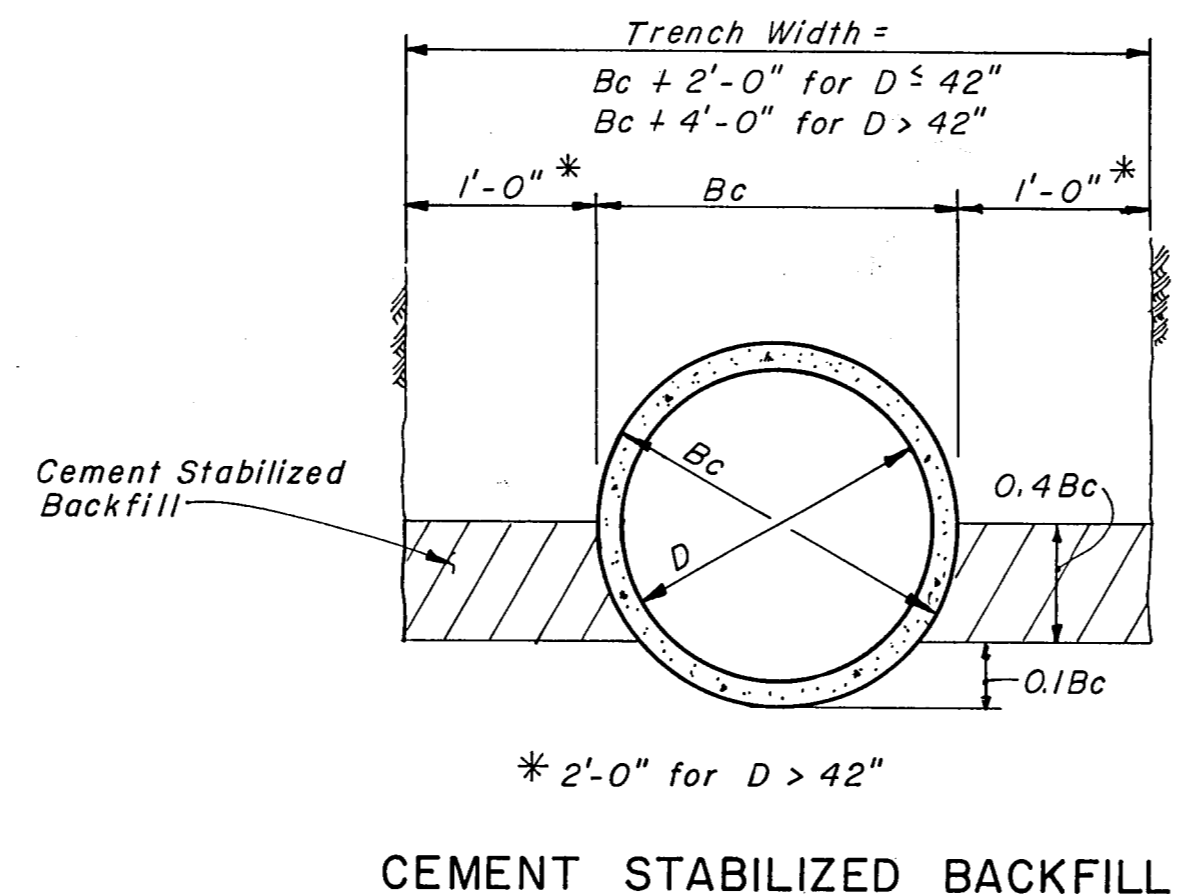

**CEMENT STABILIZED BACKFILL**

**LOCATIONS OF MEDIAN MOUNTED LIGHT POLES**

40 FT. MOUNTING HEIGHT	
639+82	693+28
642+14	695+78
644+46	698+28
646+78	700+78
655+78	703+28
658+28	705+78
660+78	707+92
663+28	710+06
665+78	712+20
668+28	714+34
670+78	716+48
673+28	718+62
675+78	720+78
678+28	723+28
680+78	725+78
682+78	728+28
684+78	730+78
686+78	733+28
688+78	735+78
690+78	

**LOCATIONS OF GROUND MOUNTED LIGHT POLES**


MAINLINE TERMINATION	
25 FT. MOUNTING HEIGHT	
734+50	NORTHBOUND
737+09	SOUTHBOUND
738+40	SOUTHBOUND

MAIN TOLL PLAZA	
35.0 FT. MOUNTING HEIGHT	
NORTHBOUND:	SOUTHBOUND:
648+49*	648+49*
650+19*	650+19*
652+37*	652+37*
654+07*	654+07*
3+04	3+15

\* WITH 2 FLOOD LIGHTS

NOTE: SEE STANDARD DRAWING NO. 32 FOR DETAILS OF MEDIAN MOUNTED LIGHT POLE LOCATIONS. MEDIAN LIGHT POLE LOCATIONS ARE SHOWN ONLY TO INDICATE LOCATIONS OF TYPE 2 CONCRETE TRAFFIC BARRIER. LIGHT POLES WILL BE INSTALLED BY OTHERS.

NOTE: LOCATIONS OF GROUND MOUNTED LIGHT POLES ARE SUPPLIED FOR CONTRACTOR'S INFORMATION ONLY. INSTALLATION WILL BE BY OTHERS.

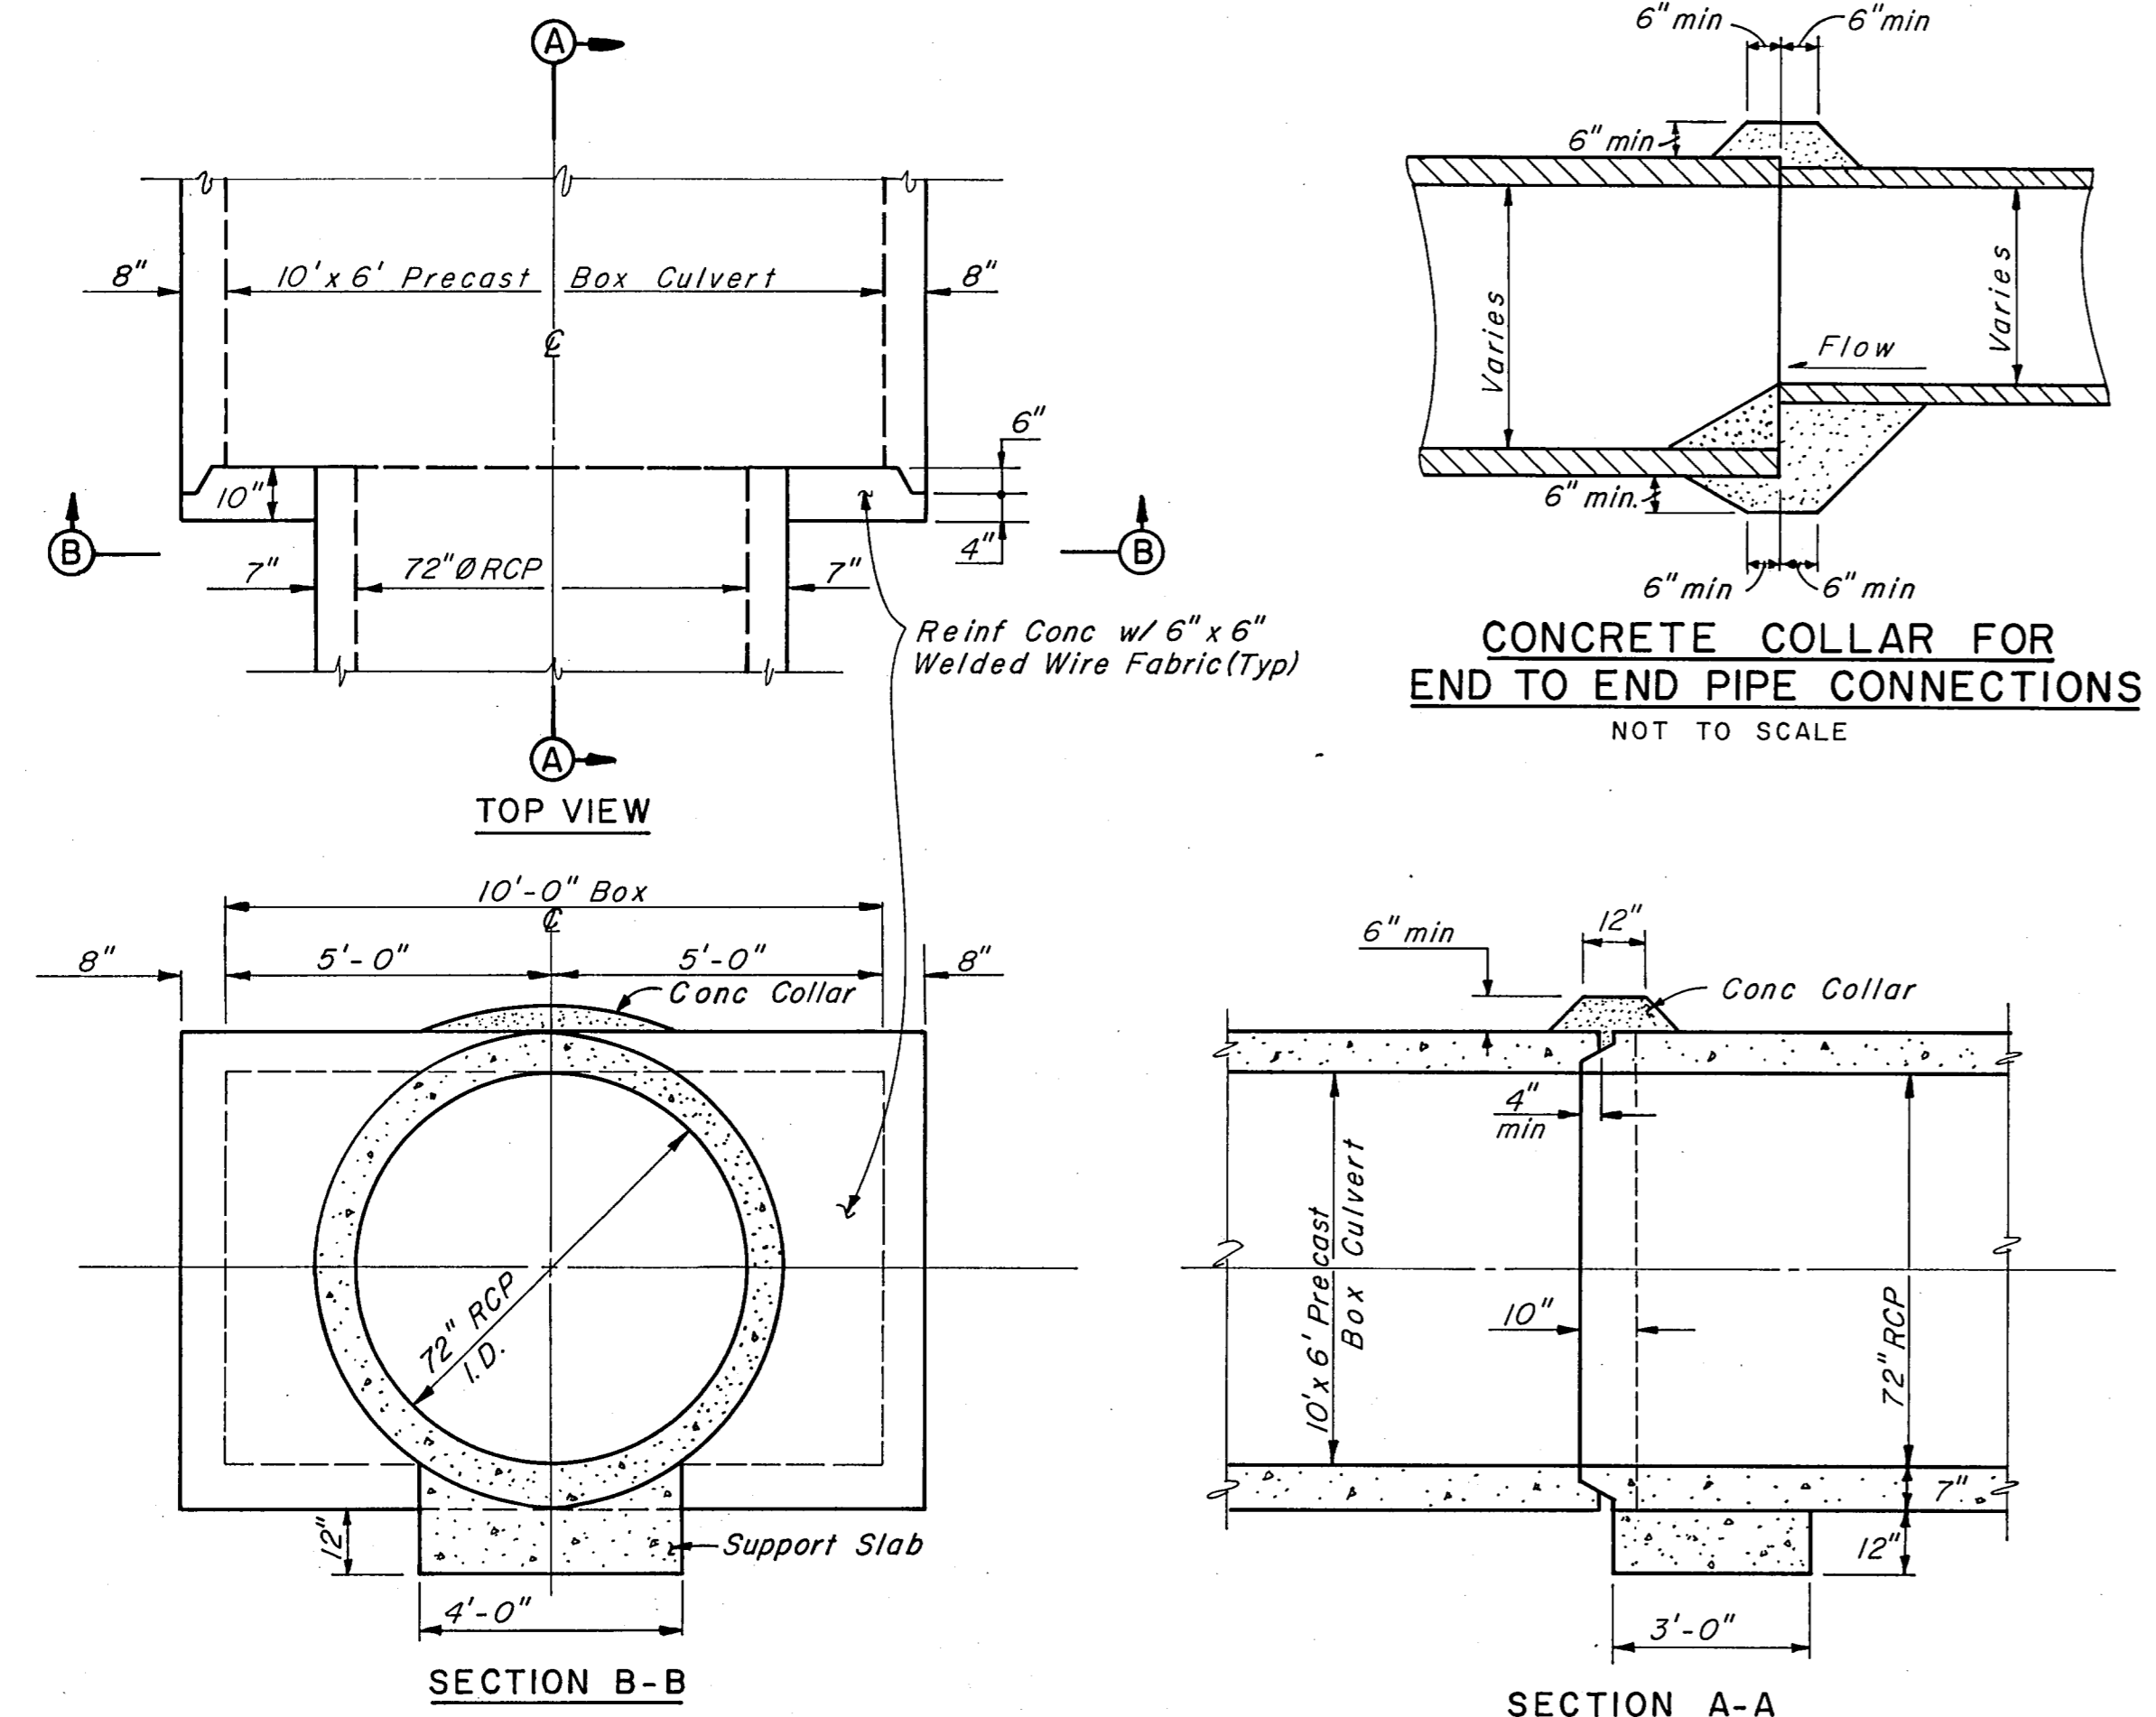



**PIPE TO BOX CULVERT CONNECTION**

SCALE: 3/8" = 1'-0"  
Note: See Sheets R10 & R58 For Location

**ASBUILT PLANS**

NO.	REVISION	BY	DATE
TEXAS TURNPIKE AUTHORITY DALLAS NORTH TOLLWAY			
MISCELLANEOUS DETAILS DRAINAGE & LIGHTING			
<b>Gibbs &amp; Hill, Inc.</b> ENGINEERS DESIGNERS CONSTRUCTORS DALLAS			SECTION VII
DRAWN	VER	DATE	4/21/84
CHECKED	DWC	DATE	5/8/84
DESIGNED	DWC	DATE	4/19/84
SCALE	As Shown		
CONTRACT NO. DNT-115 SHEET R74 OF R85			




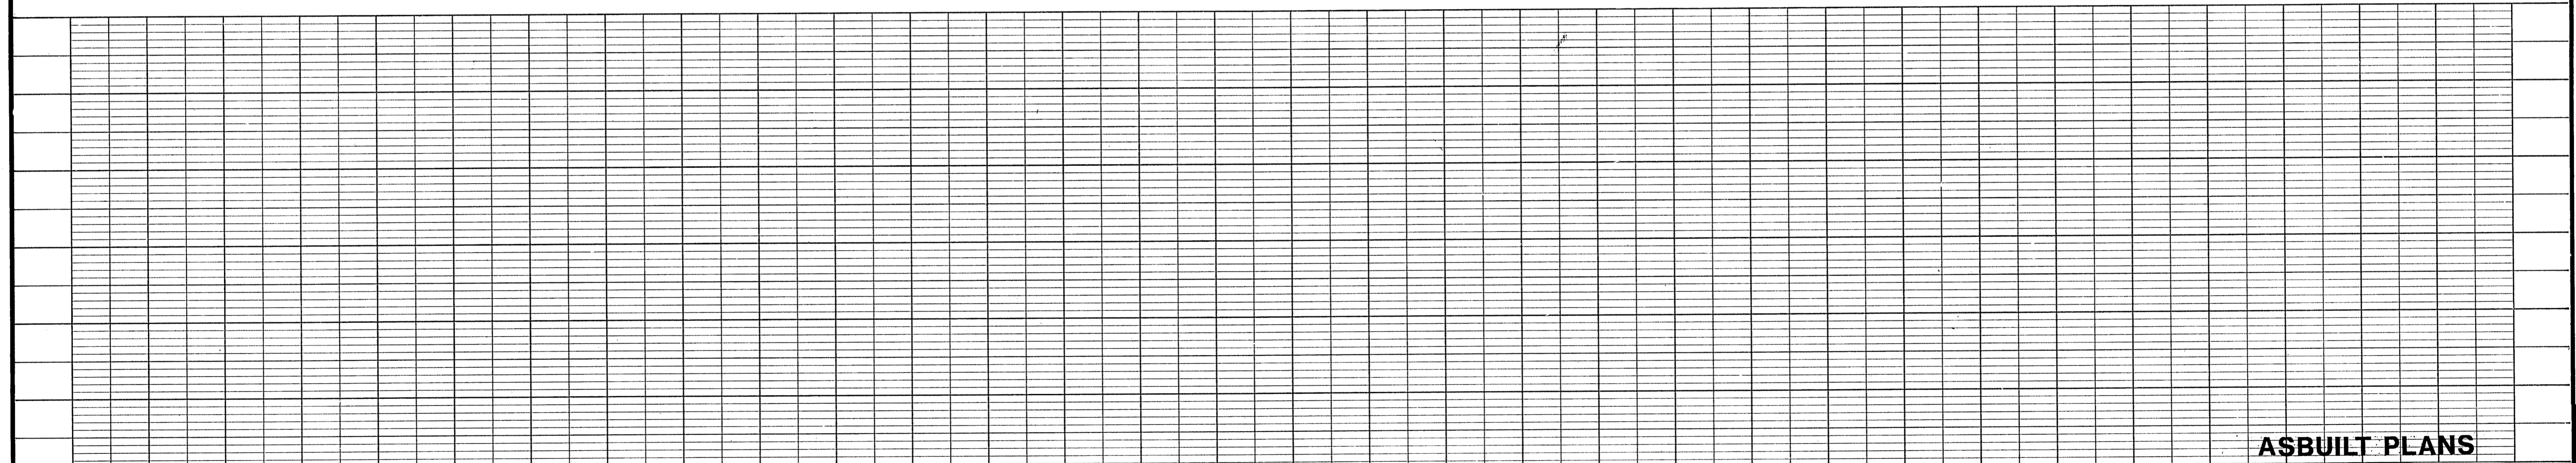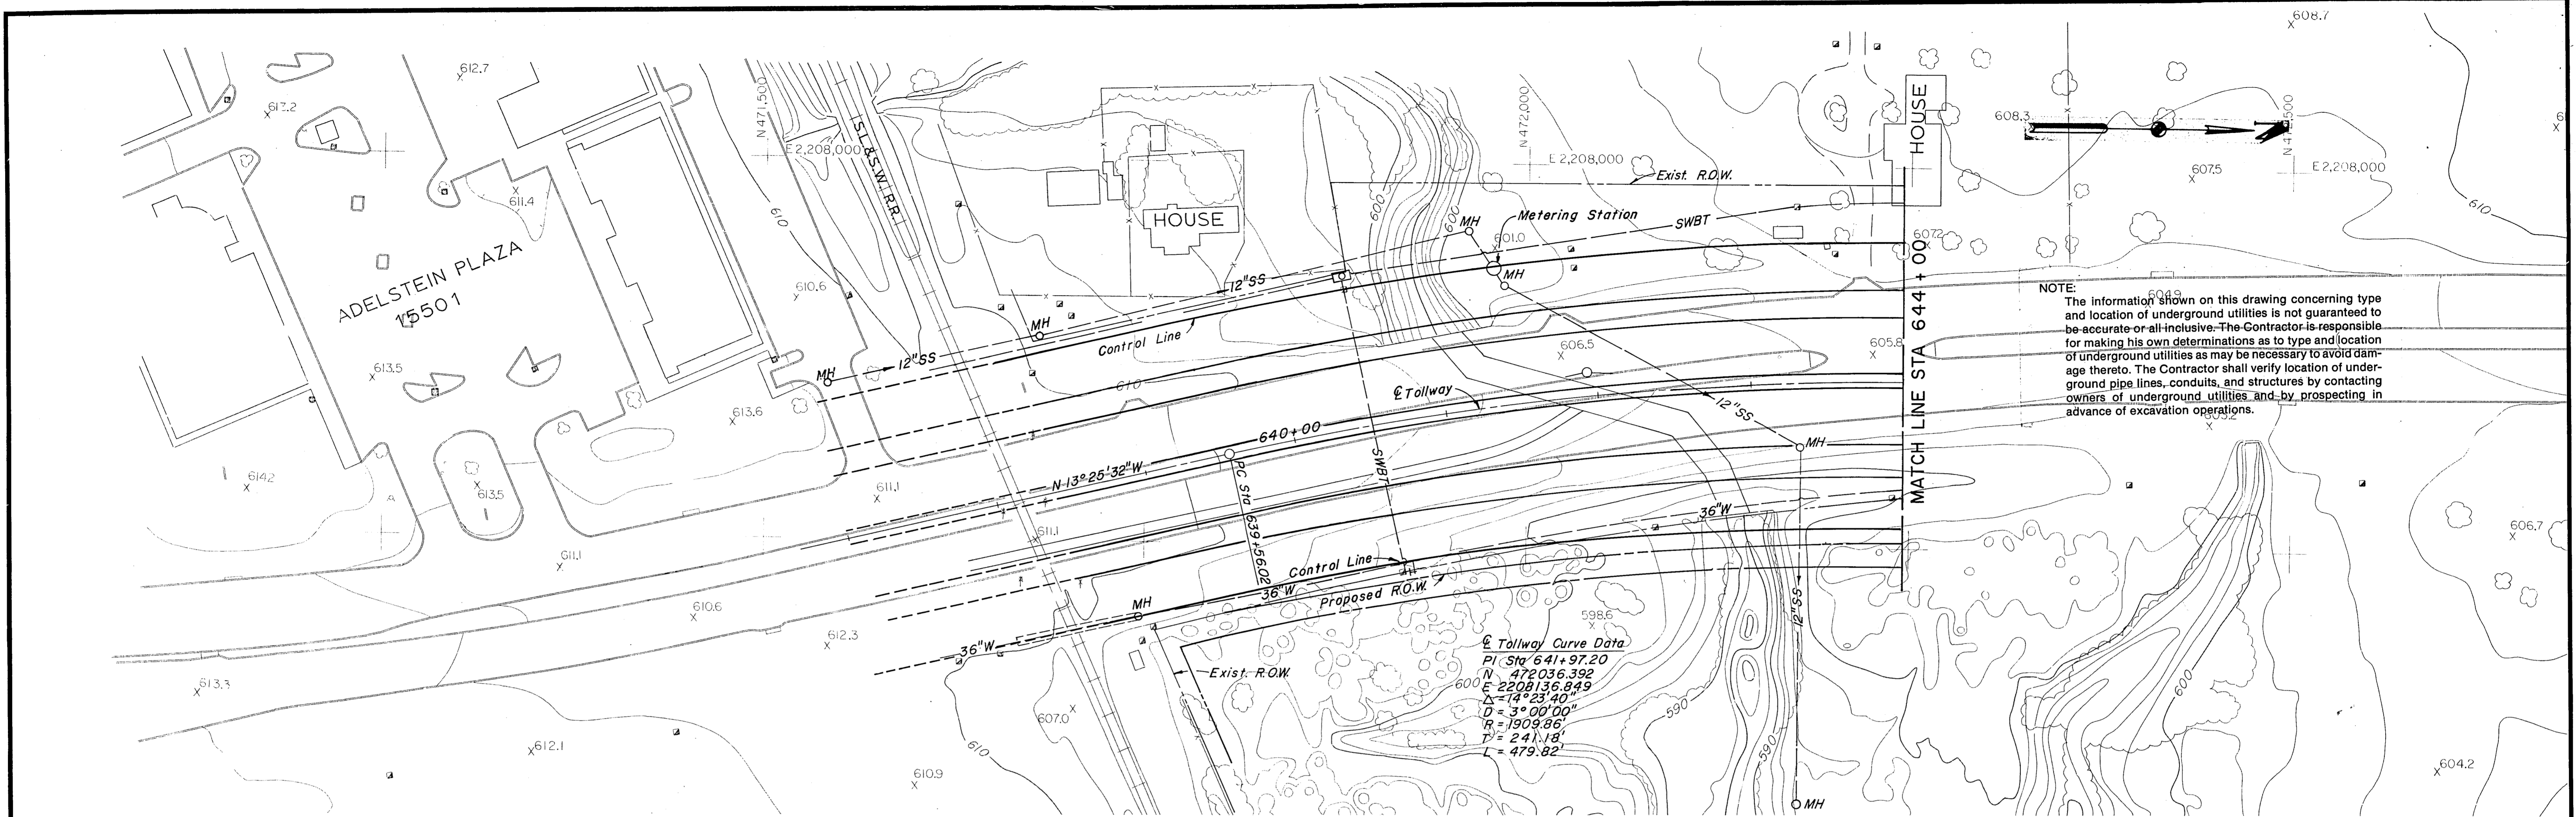

**ASBUILT PLANS**

NO.	REVISION	BY	DATE
<b>TEXAS TURNPIKE AUTHORITY</b> <b>DALLAS NORTH TOLLWAY</b>			
EXISTING UTILITIES STA 635+00 TO STA 644+00			
<b>Gibbs &amp; Hill, Inc.</b> <small>ENGINEERS DESIGNERS CONSTRUCTORS DALLAS</small>			<b>SECTION VII</b>
DRAWN <u>VER</u> DATE _____ CHECKED _____ DATE _____	DESIGNED _____ DATE _____ SCALE 1" = 50' Hor 1" = 5' Vert		
CONTRACT NO. <u>DNT-115</u> SHEET <u>R75</u> OF <u>R85</u>			




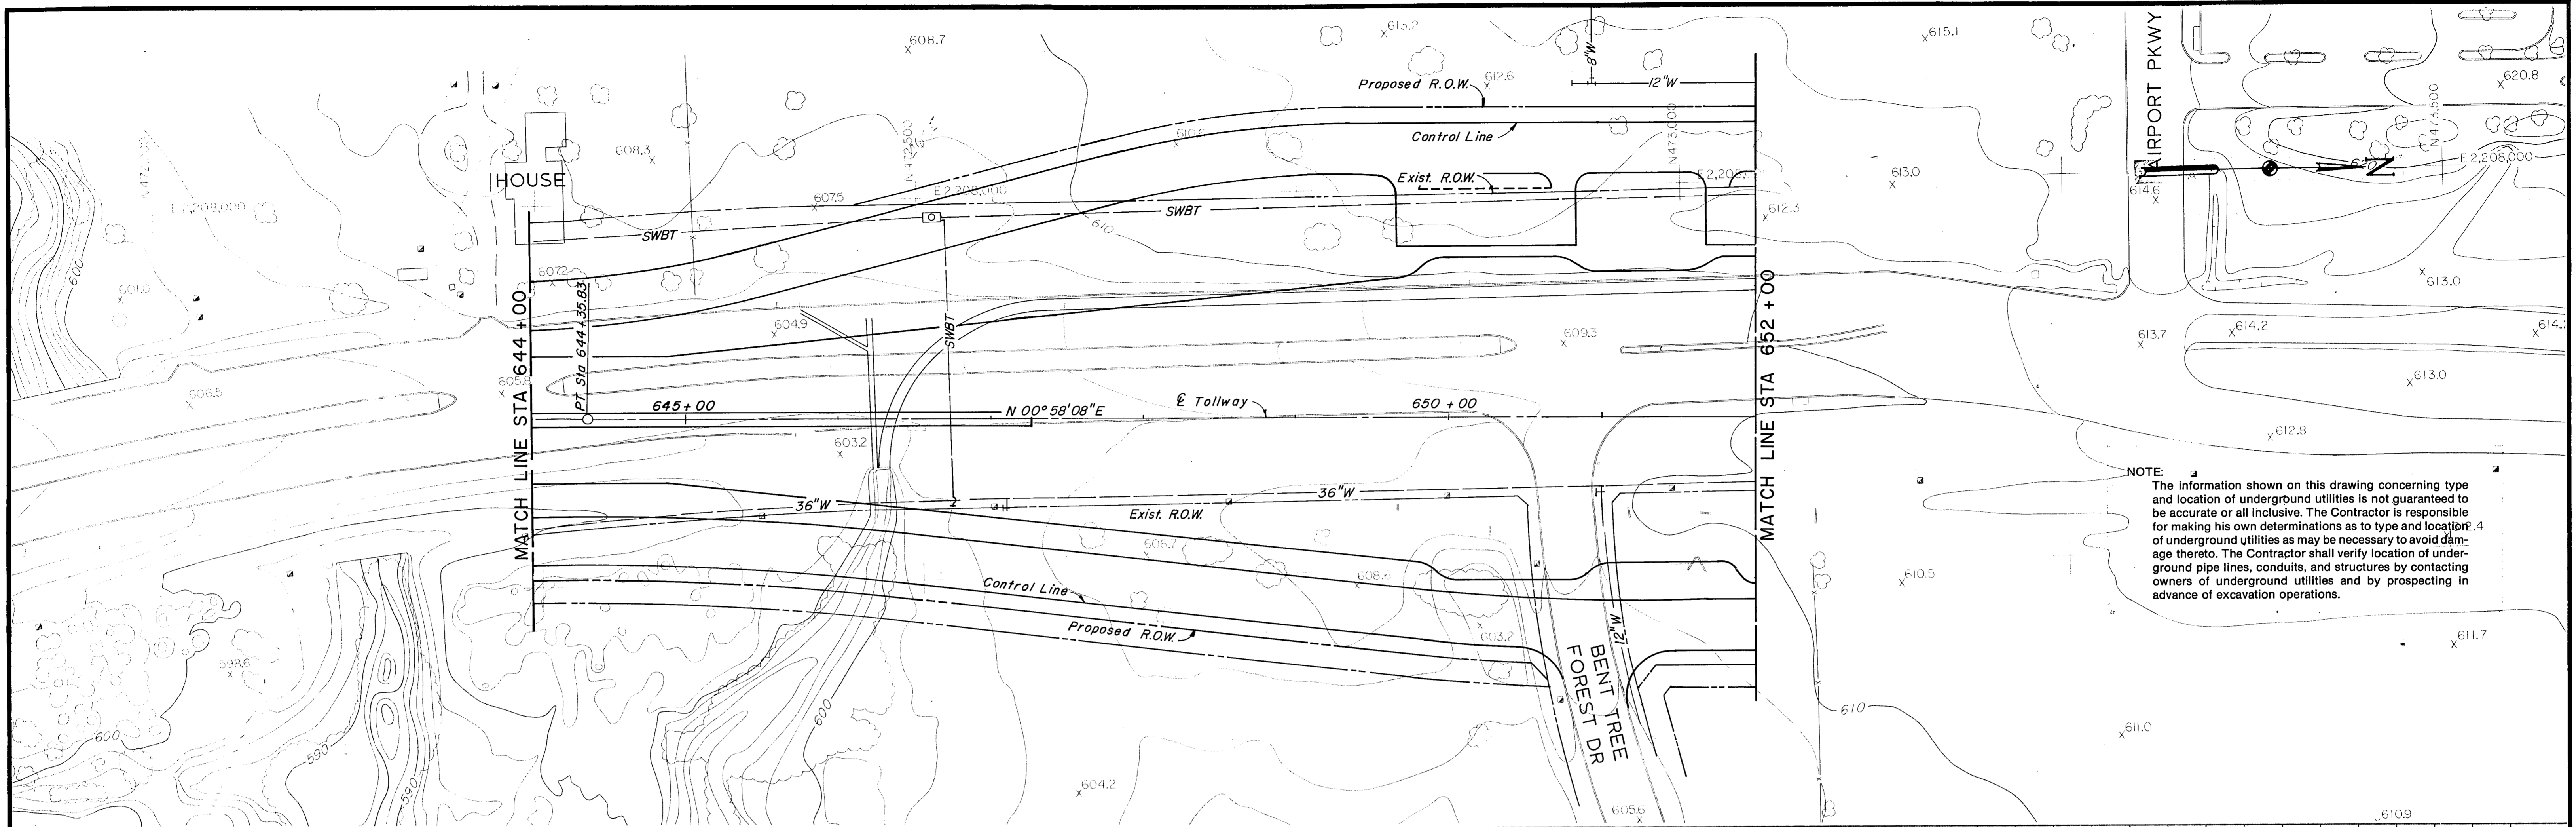



**NOTE:**  
 The information shown on this drawing concerning type and location of underground utilities is not guaranteed to be accurate or all inclusive. The Contractor is responsible for making his own determinations as to type and location of underground utilities as may be necessary to avoid damage thereto. The Contractor shall verify location of underground pipe lines, conduits, and structures by contacting owners of underground utilities and by prospecting in advance of excavation operations.

										<b>ASBUILT PLANS</b>									
										TEXAS TURNPIKE AUTHORITY DALLAS NORTH TOLLWAY									
<b>Gibbs &amp; Hill, Inc.</b> ENGINEERS DESIGNERS CONSTRUCTORS DALLAS										SECTION VII									
DRAWN <i>VER</i> DATE _____					DESIGNED _____ DATE _____					SCALE 1"=50' Hor 1"=5' Vert									
CHECKED _____ DATE _____					CONTRACT NO. DNT-115					SHEET R76 OF R85									



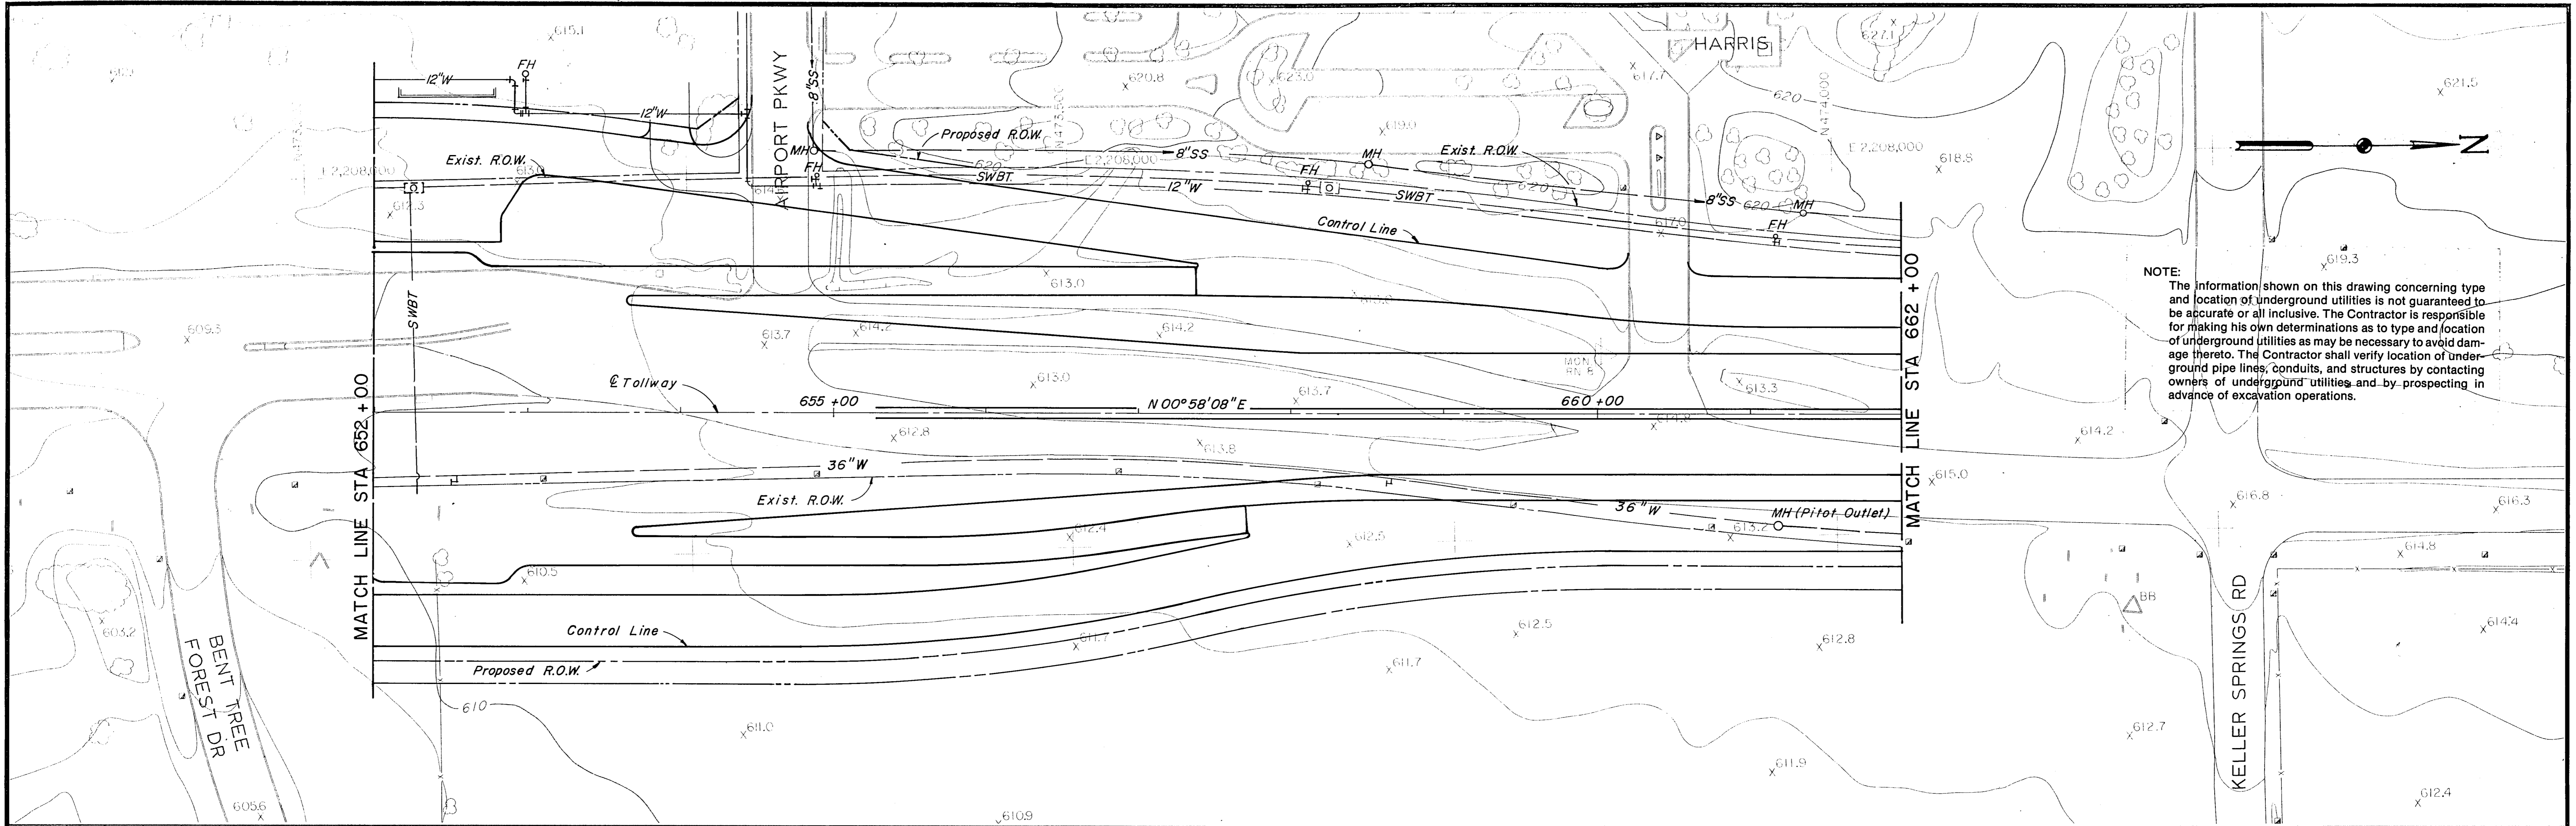


NOTE:  
 The information shown on this drawing concerning type and location of underground utilities is not guaranteed to be accurate or all inclusive. The Contractor is responsible for making his own determinations as to type and location of underground utilities as may be necessary to avoid damage thereto. The Contractor shall verify location of underground pipe lines, conduits, and structures by contacting owners of underground utilities and by prospecting in advance of excavation operations.

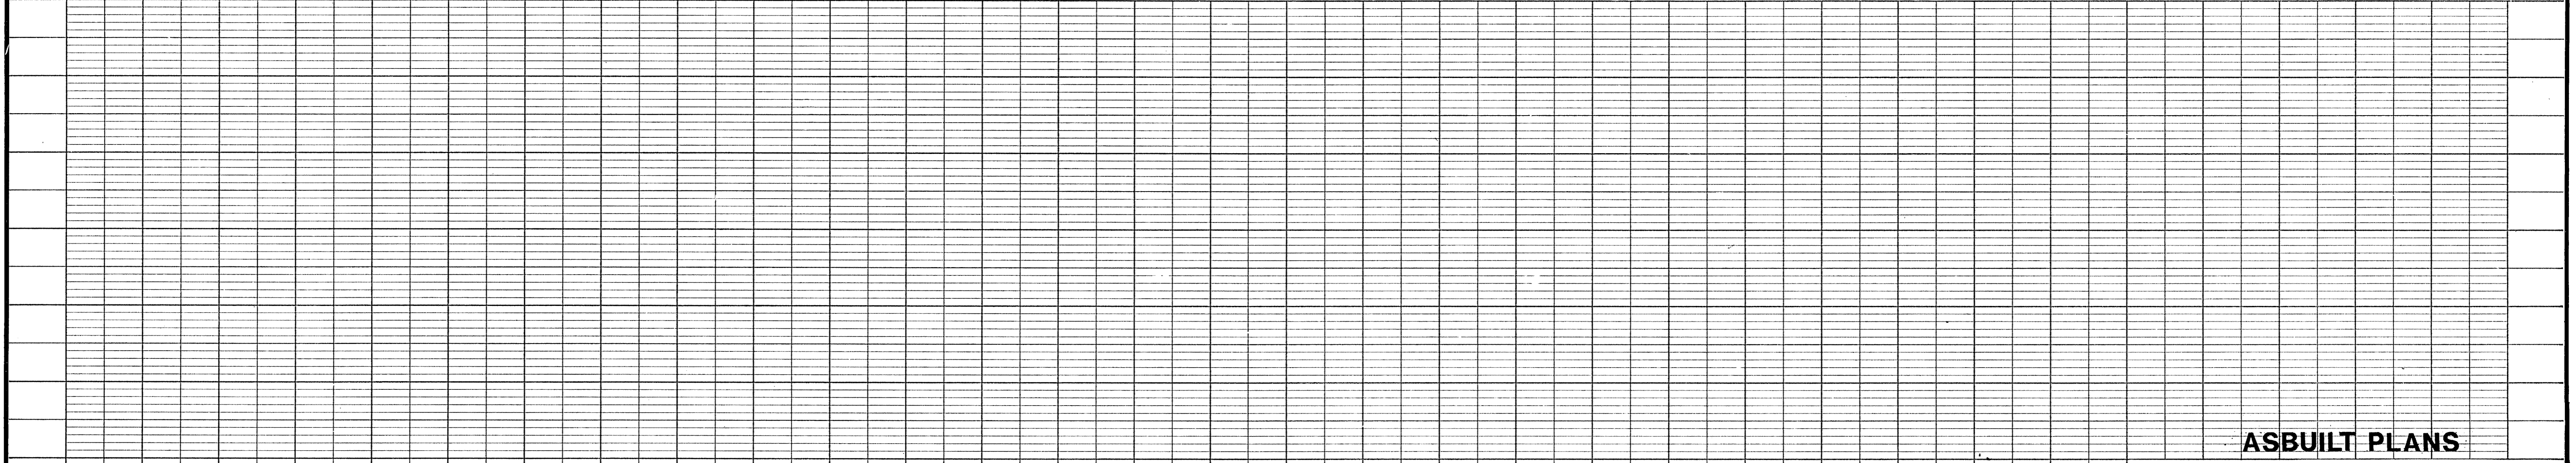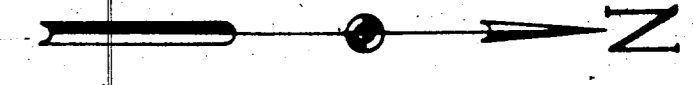


**ASBUILT PLANS**

NO.	REVISION	BY	DATE
<b>TEXAS TURNPIKE AUTHORITY</b> <b>DALLAS NORTH TOLLWAY</b>			
<b>EXISTING UTILITIES</b> STA 652 + 00 TO STA 662 + 00			
<b>Gibbs &amp; Hill, Inc.</b> <small>ENGINEERS DESIGNERS CONSTRUCTORS</small> <small>DALLAS</small>			<b>SECTION VII</b>
DRAWN <u>VER</u> DATE _____ CHECKED _____    DATE _____	DESIGNED _____    DATE _____ SCALE <u>1"=50'Hor</u> <u>1"=5'Vert</u>	<b>CONTRACT NO. DNT-115 SHEET R77 OF R85</b>	



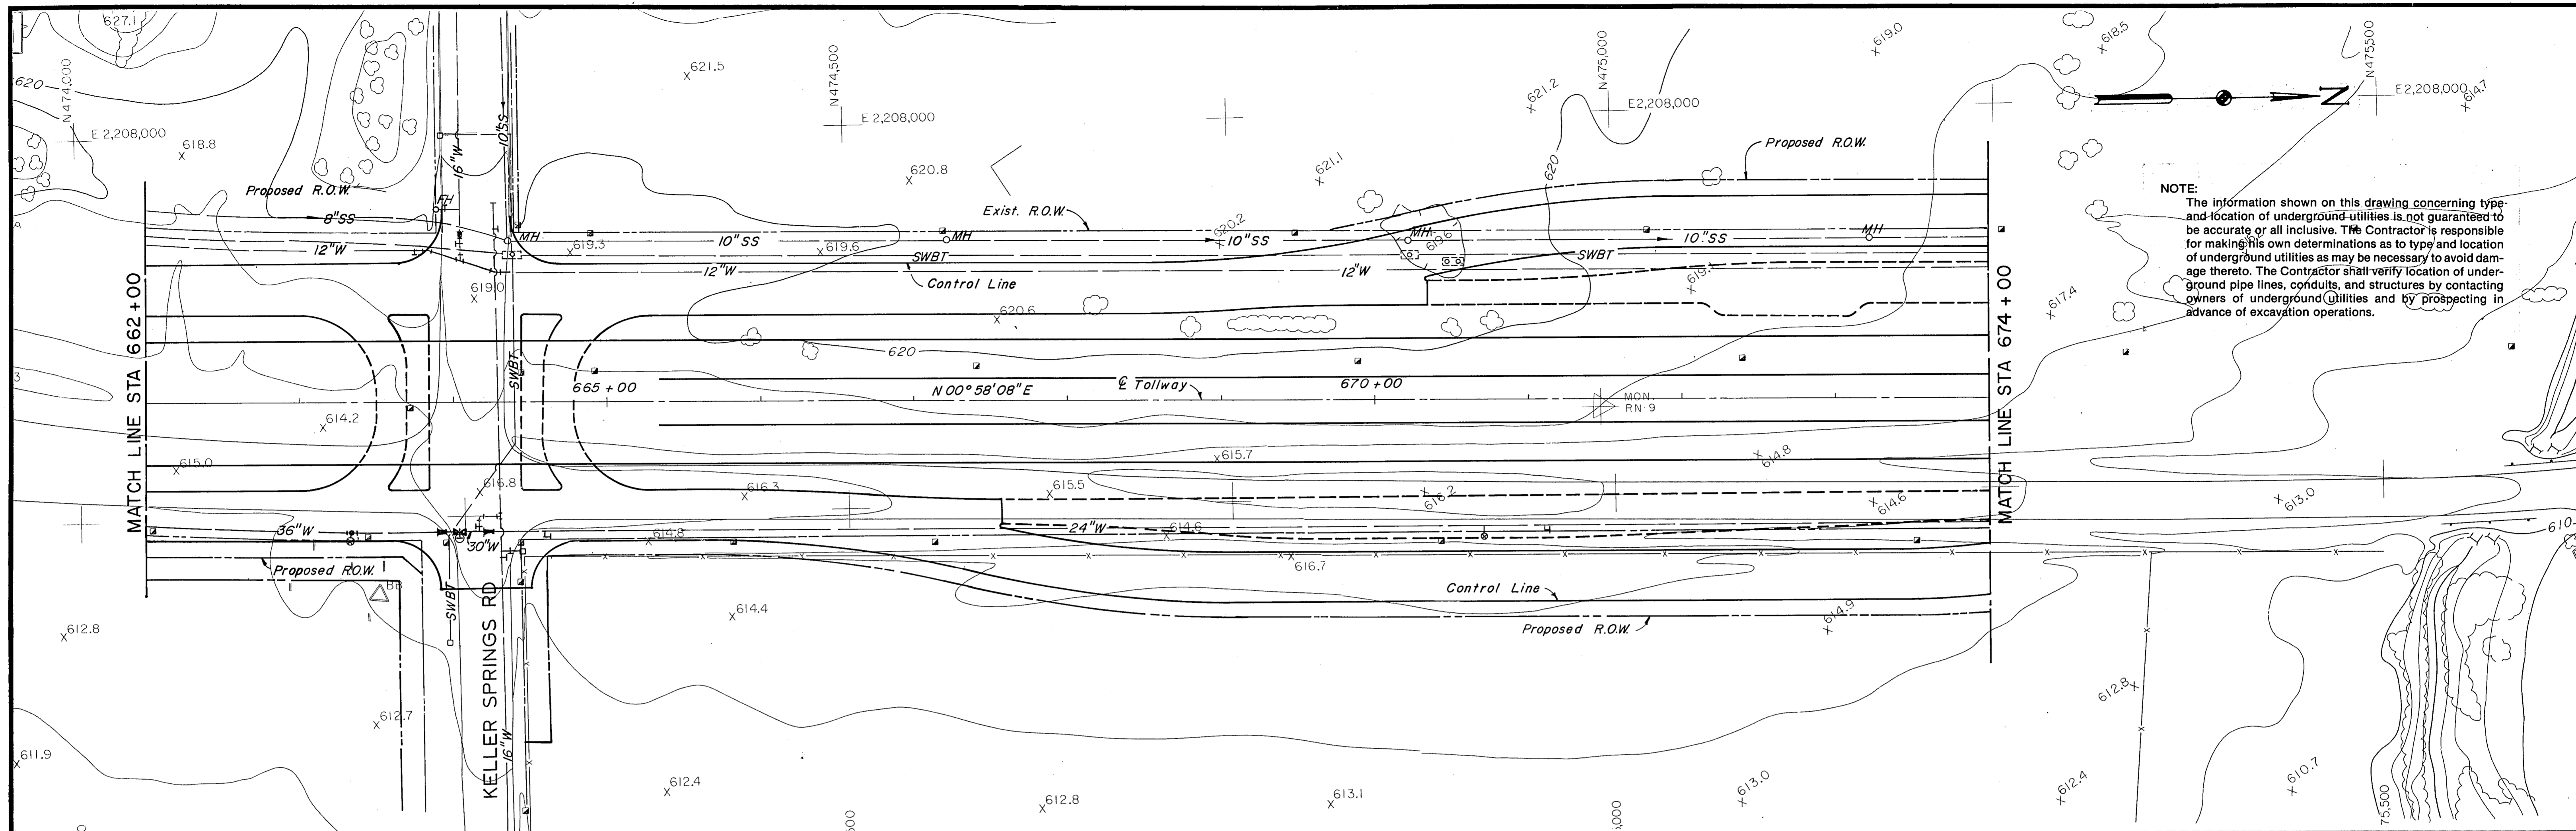

**NOTE:**  
 The information shown on this drawing concerning type and location of underground utilities is not guaranteed to be accurate or all inclusive. The Contractor is responsible for making his own determinations as to type and location of underground utilities as may be necessary to avoid damage thereto. The Contractor shall verify location of underground pipe lines, conduits, and structures by contacting owners of underground utilities and by prospecting in advance of excavation operations.

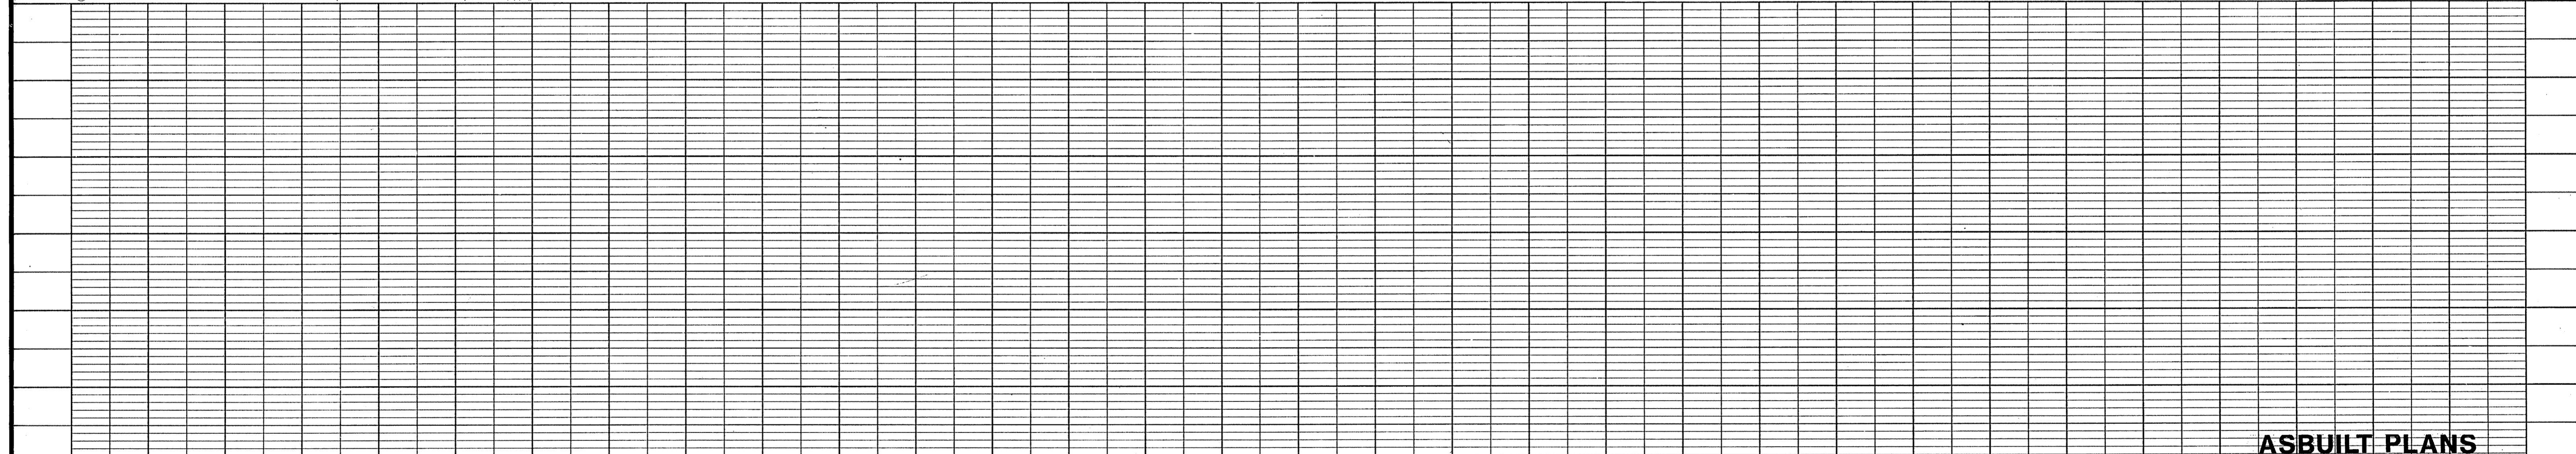


**ASBUILT PLANS**

NO.	REVISION	BY	DATE
<b>TEXAS TURNPIKE AUTHORITY DALLAS NORTH TOLLWAY</b>			
EXISTING UTILITIES STA 662 + 00 TO STA 674 + 00			
<b>Gibbs &amp; Hill, Inc.</b> ENGINEERS DESIGNERS CONSTRUCTORS DALLAS			SECTION VII
DRAWN VER	DATE	DESIGNED	DATE
CHECKED	DATE	SCALE 1"=50' Hor	1"=5' Vert
CONTRACT NO. DNT-115 SHEET R78 OF R85			




**☉ Tollway Curve Data**  
 PI Sta 678 + 10.96  
 N 475652.180  
 E 2208198.000  
 $\Delta = 16^\circ 37' 26''$   
 $D = 2^\circ 30' 26''$   
 $R = 2291.83'$   
 $T = 334.83'$   
 $L = 664.95'$

**☉ Tollway Curve Data**  
 PI Sta 682 + 76.95  
 N 476105.410  
 E 2208070.988  
 $\Delta = 13^\circ 31' 23''$   
 $D = 5^\circ 00' 00''$   
 $R = 1145.92'$   
 $T = 135.86'$   
 $L = 270.46'$

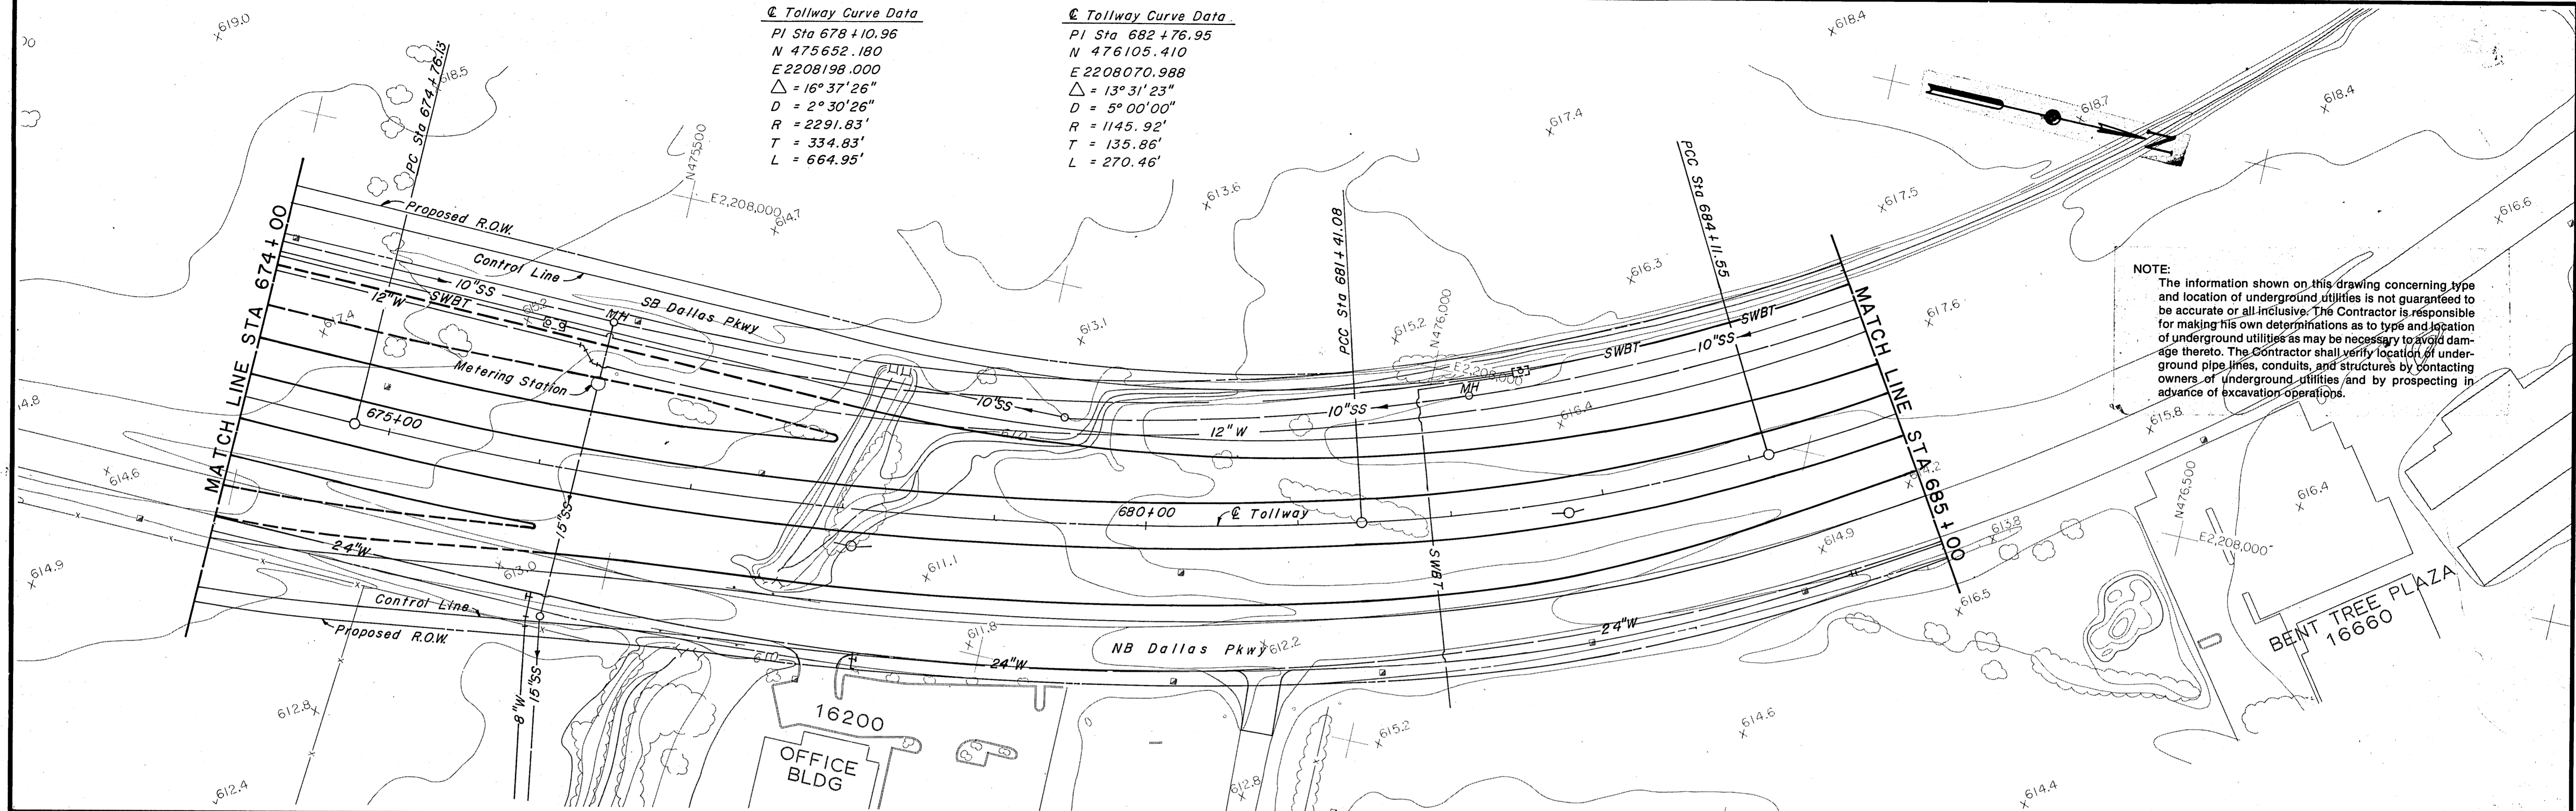


**NOTE:**  
 The information shown on this drawing concerning type and location of underground utilities is not guaranteed to be accurate or all inclusive. The Contractor is responsible for making his own determinations as to type and location of underground utilities as may be necessary to avoid damage thereto. The Contractor shall verify location of underground pipe lines, conduits, and structures by contacting owners of underground utilities and by prospecting in advance of excavation operations.

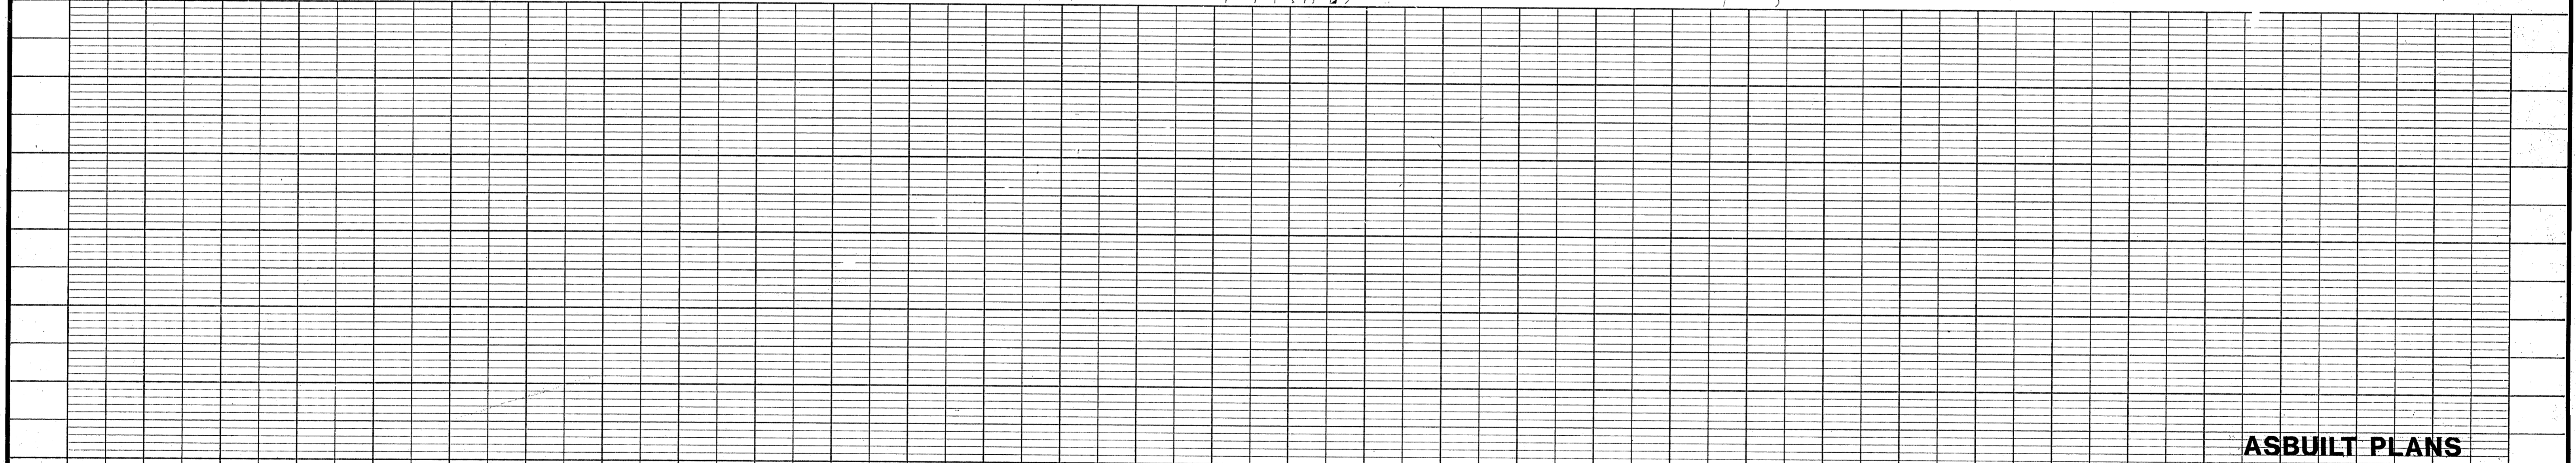

**ASBUILT PLANS**

NO.	REVISION	BY	DATE
<b>TEXAS TURNPIKE AUTHORITY</b> <b>DALLAS NORTH TOLLWAY</b>  EXISTING UTILITIES STA 674+00 TO STA 685+00  <b>Gibbs &amp; Hill, Inc.</b> <small>ENGINEERS DESIGNERS CONSTRUCTORS DALLAS</small>			
		<b>SECTION VII</b>	
DRAWN <i>VER</i> CHECKED _____	DATE <i>9-13-83</i> DATE _____	DESIGNED _____ SCALE <i>1"=50'</i>	DATE _____ DATE _____
<b>CONTRACT NO. DNT-115 SHEET R79 OF R85</b>			



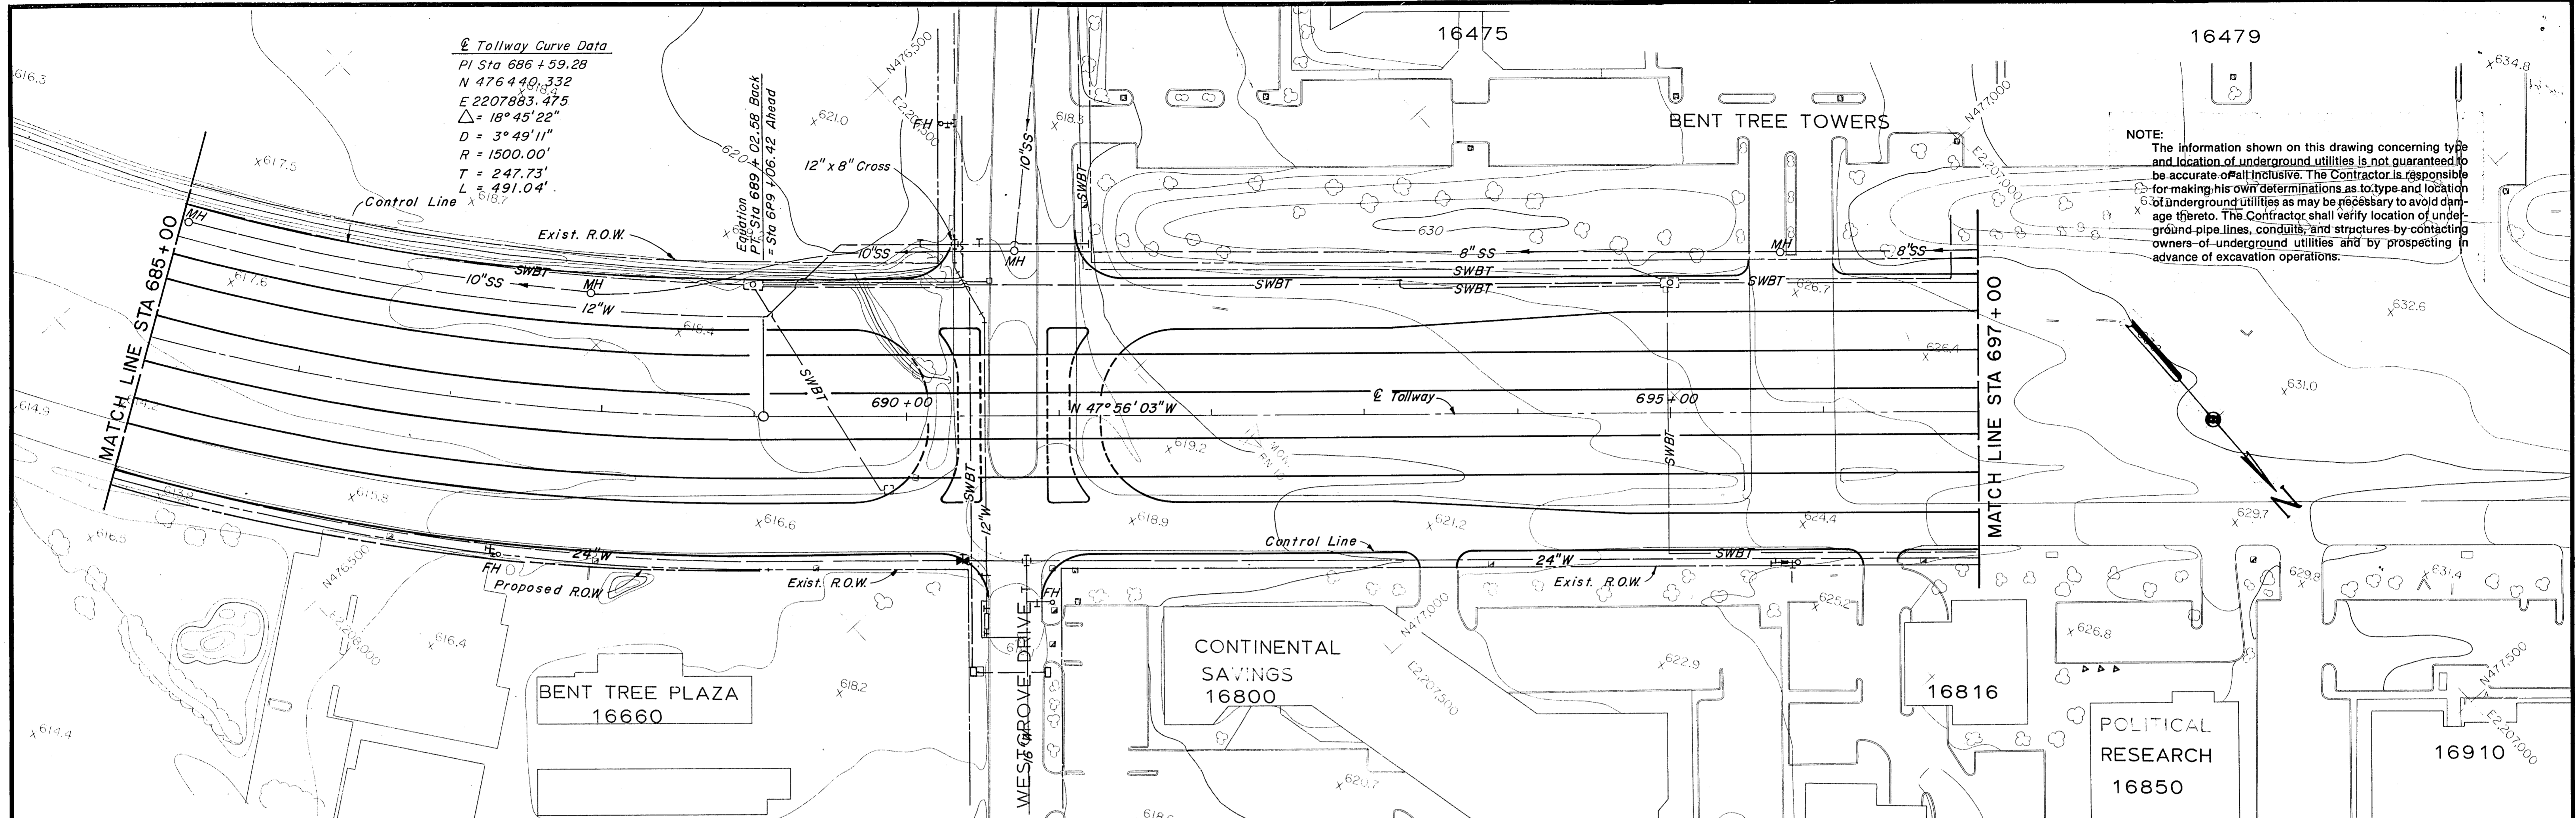


**⊙ Tollway Curve Data**  
 PI Sta 686 + 59.28  
 N 476 440.332  
 E 2207883.475  
 $\Delta = 18^\circ 45' 22''$   
 D = 3° 49' 11"  
 R = 1500.00'  
 T = 247.73'  
 L = 491.04'


**NOTE:**  
 The information shown on this drawing concerning type and location of underground utilities is not guaranteed to be accurate or full inclusive. The Contractor is responsible for making his own determinations as to type and location of underground utilities as may be necessary to avoid damage thereto. The Contractor shall verify location of underground pipe lines, conduits, and structures by contacting owners of underground utilities and by prospecting in advance of excavation operations.

<b>ASBUILT PLANS</b>			
NO.	REVISION	BY	DATE
<b>TEXAS TURNPIKE AUTHORITY DALLAS NORTH TOLLWAY</b>			
<b>EXISTING UTILITIES STA 685 + 00 TO STA 697 + 00</b>			
<b>Gibbs &amp; Hill, Inc.</b> ENGINEERS DESIGNERS CONSTRUCTORS DALLAS			SECTION VII
DRAWN VER	DATE	DESIGNED DATE	DATE
CHECKED	DATE	SCALE 1"=50' Hor 1"=5' Vert	
CONTRACT NO. DNT-115 SHEET R80 OF R85			



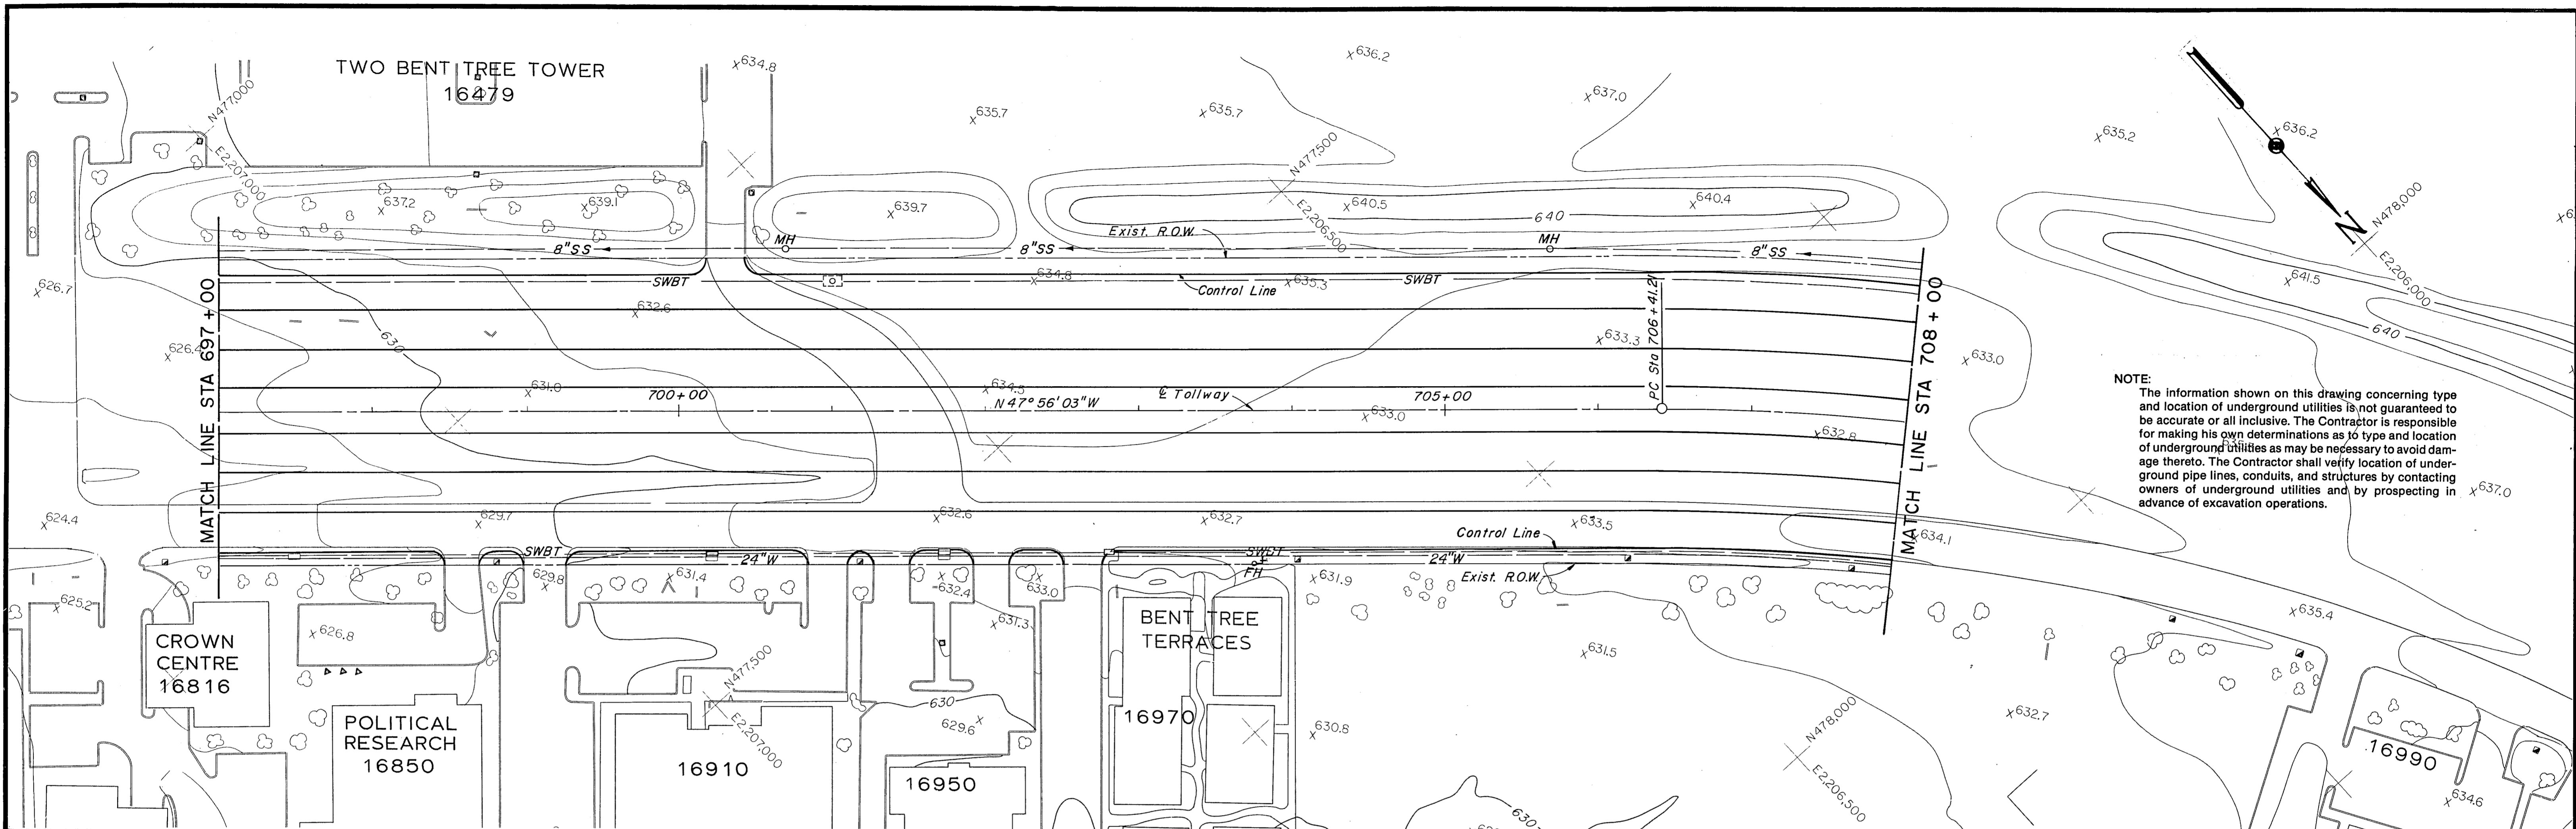


**NOTE:**  
 The information shown on this drawing concerning type and location of underground utilities is not guaranteed to be accurate or all inclusive. The Contractor is responsible for making his own determinations as to type and location of underground utilities as may be necessary to avoid damage thereto. The Contractor shall verify location of underground pipe lines, conduits, and structures by contacting owners of underground utilities and by prospecting in advance of excavation operations.

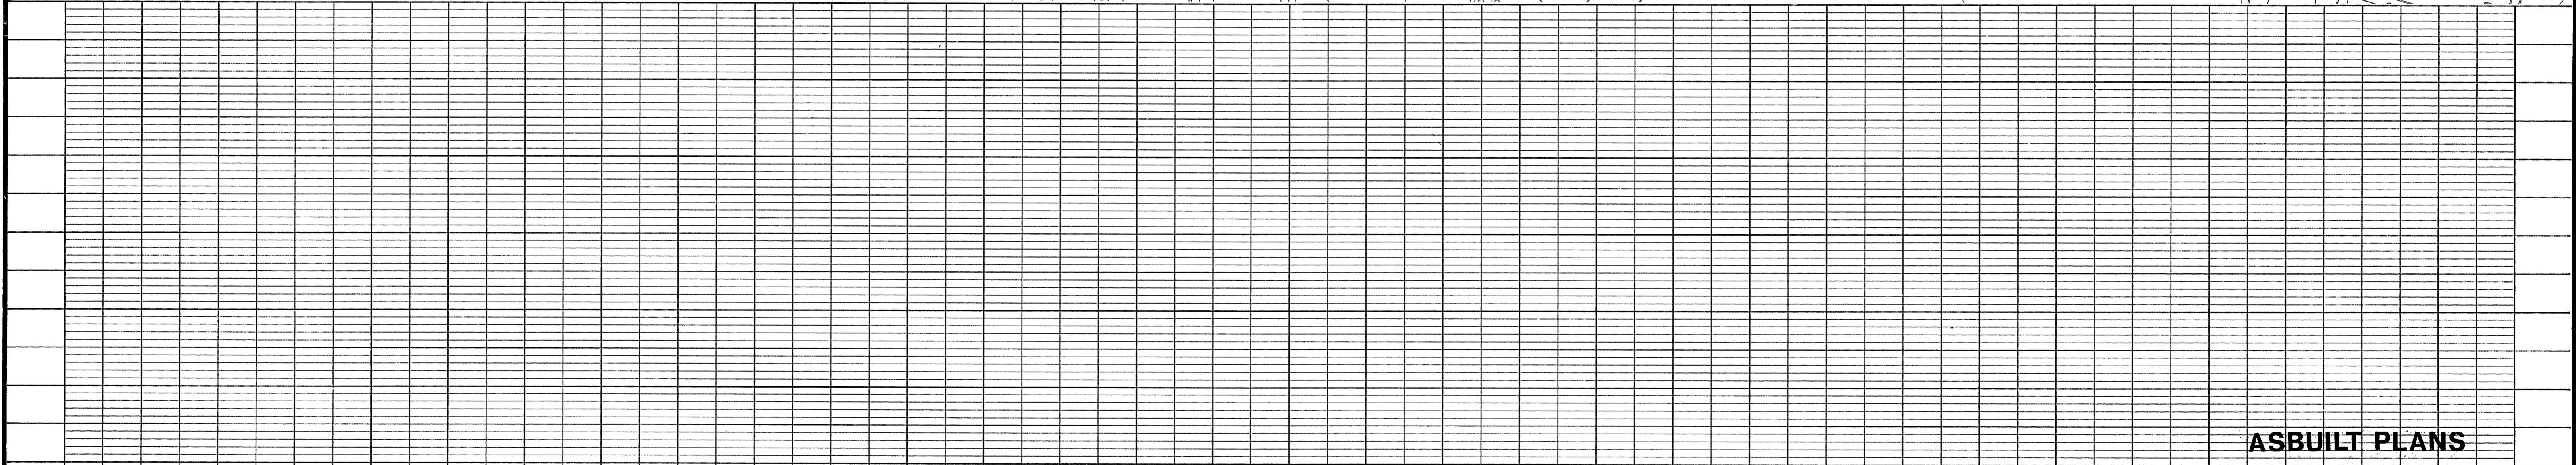

**ASBUILT PLANS**

NO.	REVISION	BY	DATE
<b>TEXAS TURNPIKE AUTHORITY</b> <b>DALLAS NORTH TOLLWAY</b>			
EXISTING UTILITIES STA 697+00 TO STA 708+00			
<b>Gibbs &amp; Hill, Inc.</b> <small>ENGINEERS DESIGNERS CONSTRUCTORS DALLAS</small>			<b>SECTION VII</b>
DRAWN <u>VER</u> DATE _____ CHECKED _____ DATE _____	DESIGNED _____ DATE _____ SCALE $1"=50'$ Hor $1"=5'$ Vert		
CONTRACT NO. <u>DNT-115</u> SHEET <u>R81</u> OF <u>R85</u>			



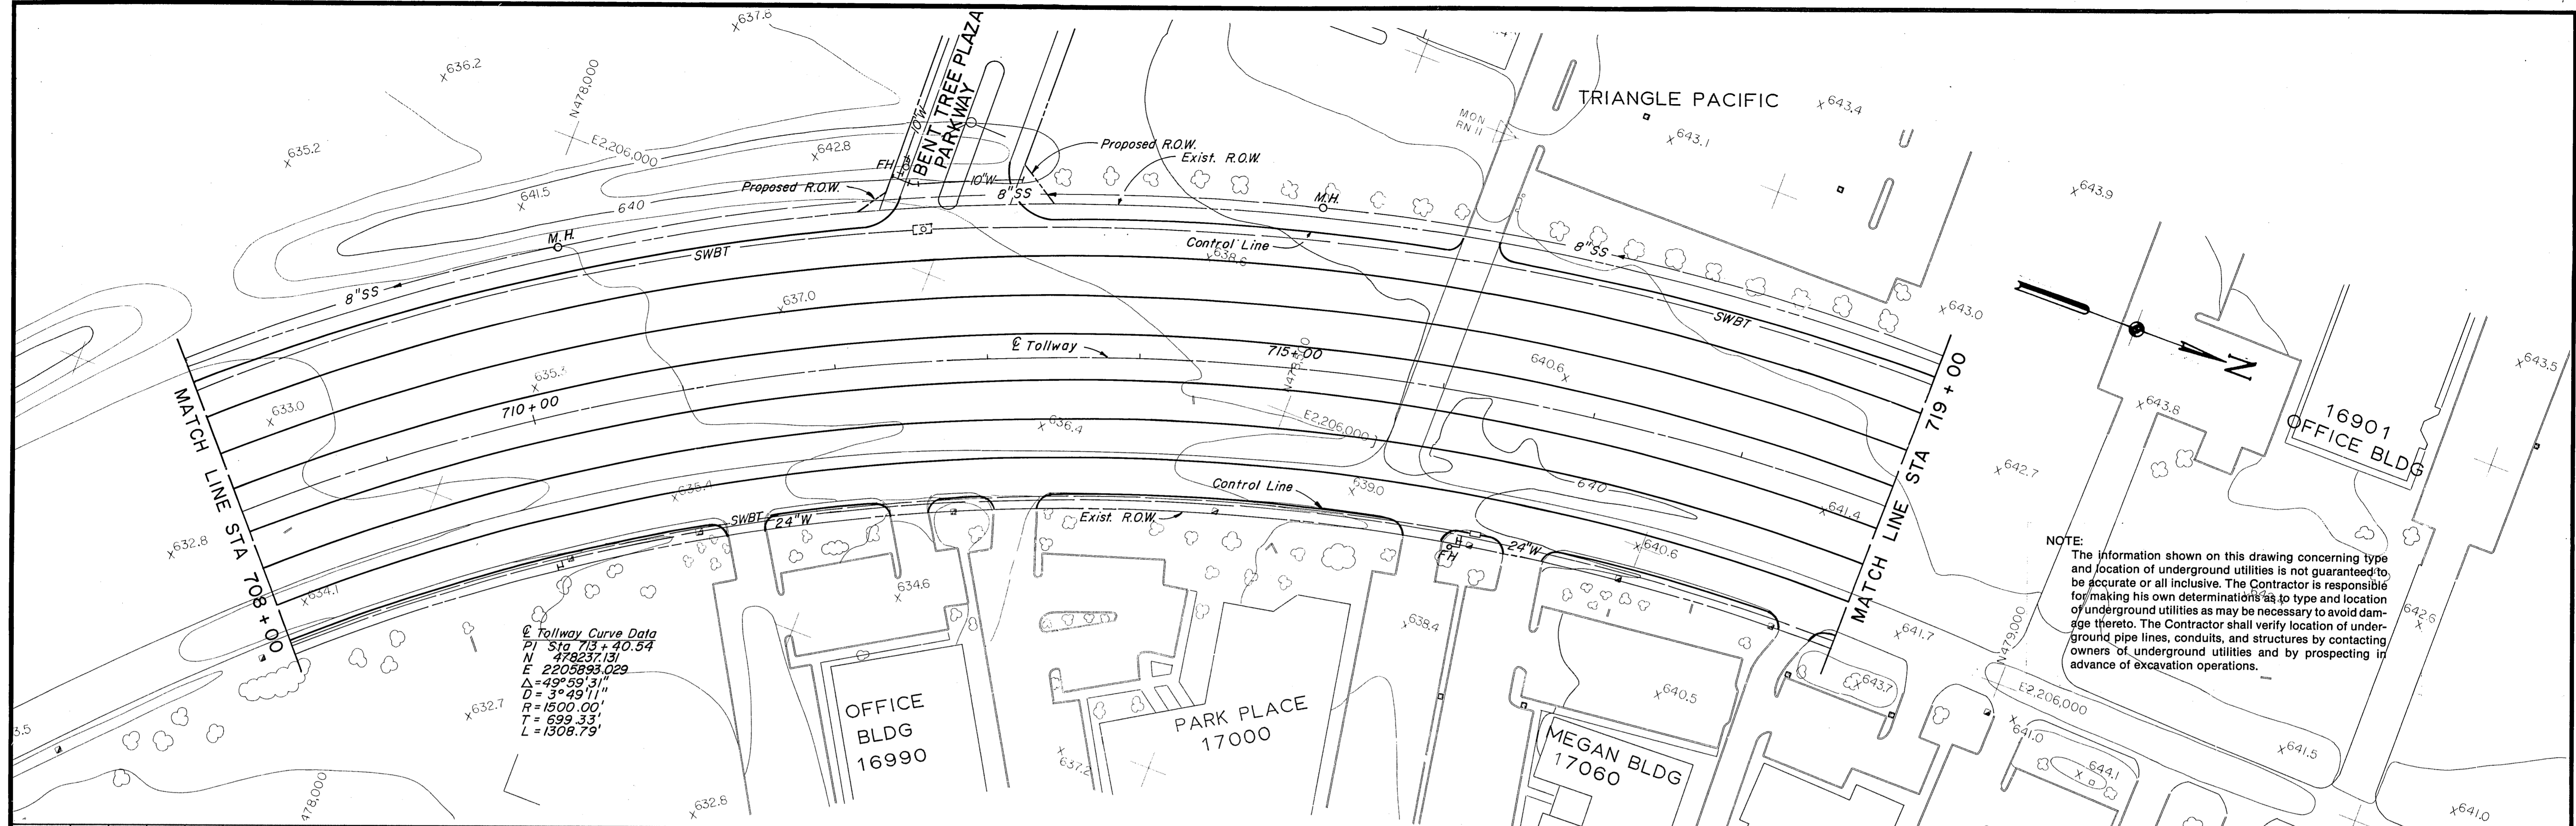


@ Tollway Curve Data  
 PI Sta 713+40.54  
 N 478237.13'  
 E 2205893.029'  
 $\Delta = 49^{\circ}59'31''$   
 $D = 3^{\circ}49'11''$   
 $R = 1500.00'$   
 $T = 699.33'$   
 $L = 1308.79'$

**NOTE:**  
 The information shown on this drawing concerning type and location of underground utilities is not guaranteed to be accurate or all inclusive. The Contractor is responsible for making his own determinations as to type and location of underground utilities as may be necessary to avoid damage thereto. The Contractor shall verify location of underground pipe lines, conduits, and structures by prospecting in advance of excavation operations.

**ASBUILT PLANS**

NO.	REVISION	BY	DATE
<b>TEXAS TURNPIKE AUTHORITY</b> <b>DALLAS NORTH TOLLWAY</b>			
EXISTING UTILITIES STA 708+00 TO STA 719+00			
<b>Gibbs &amp; Hill, Inc.</b> <small>ENGINEERS DESIGNERS CONSTRUCTORS DALLAS</small>			<b>SECTION VII</b>
<small>DRAWN</small> VER <small>CHECKED</small> _____	<small>DATE</small> _____	<small>DESIGNED</small> _____ <small>SCALE</small> 1"=50' Hor 1"=5' Vert	<small>DATE</small> _____
<b>CONTRACT NO. DNT-115 SHEET R82 OF R85</b>			



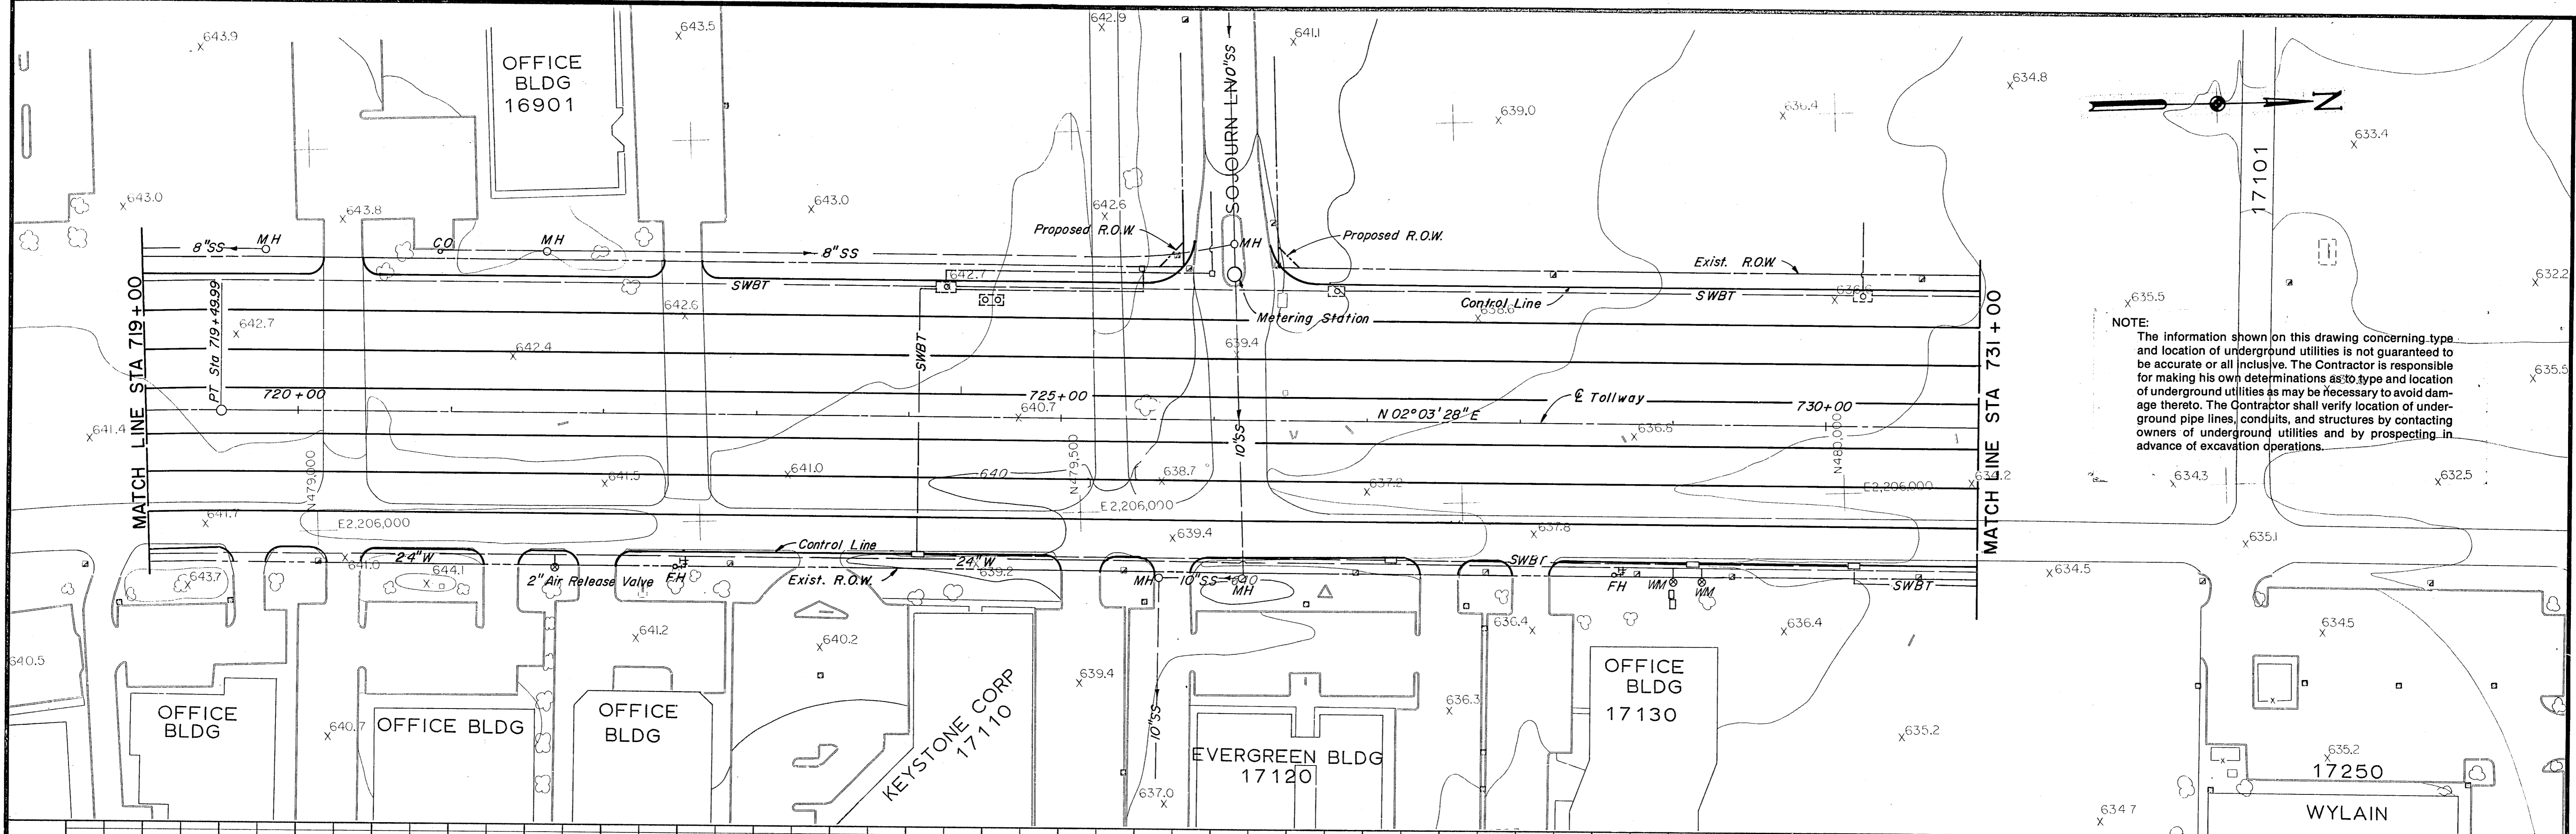


**NOTE:**  
 The information shown on this drawing concerning type and location of underground utilities is not guaranteed to be accurate or all inclusive. The Contractor is responsible for making his own determinations as to type and location of underground utilities as may be necessary to avoid damage thereto. The Contractor shall verify location of underground pipe lines, conduits, and structures by contacting owners of underground utilities and by prospecting in advance of excavation operations.


**ASBUILT PLANS**

NO.	REVISION	BY	DATE
<b>TEXAS TURNPIKE AUTHORITY</b> <b>DALLAS NORTH TOLLWAY</b>			
EXISTING UTILITIES STA 719 + 00 TO STA 731 + 00			
<b>Gibbs &amp; Hill, Inc.</b> <small>ENGINEERS DESIGNERS CONSTRUCTORS</small> <small>DALLAS</small>			<b>SECTION VII</b>
<small>DRAWN</small> VER <small>CHECKED</small> _____	<small>DATE</small> _____ <small>DATE</small> _____	<small>DESIGNED</small> _____ <small>SCALE</small> 1"=50' Hor 1"=5' Vert	<small>DATE</small> _____
<b>CONTRACT NO. DNT-115 SHEET R83 OF R85</b>			



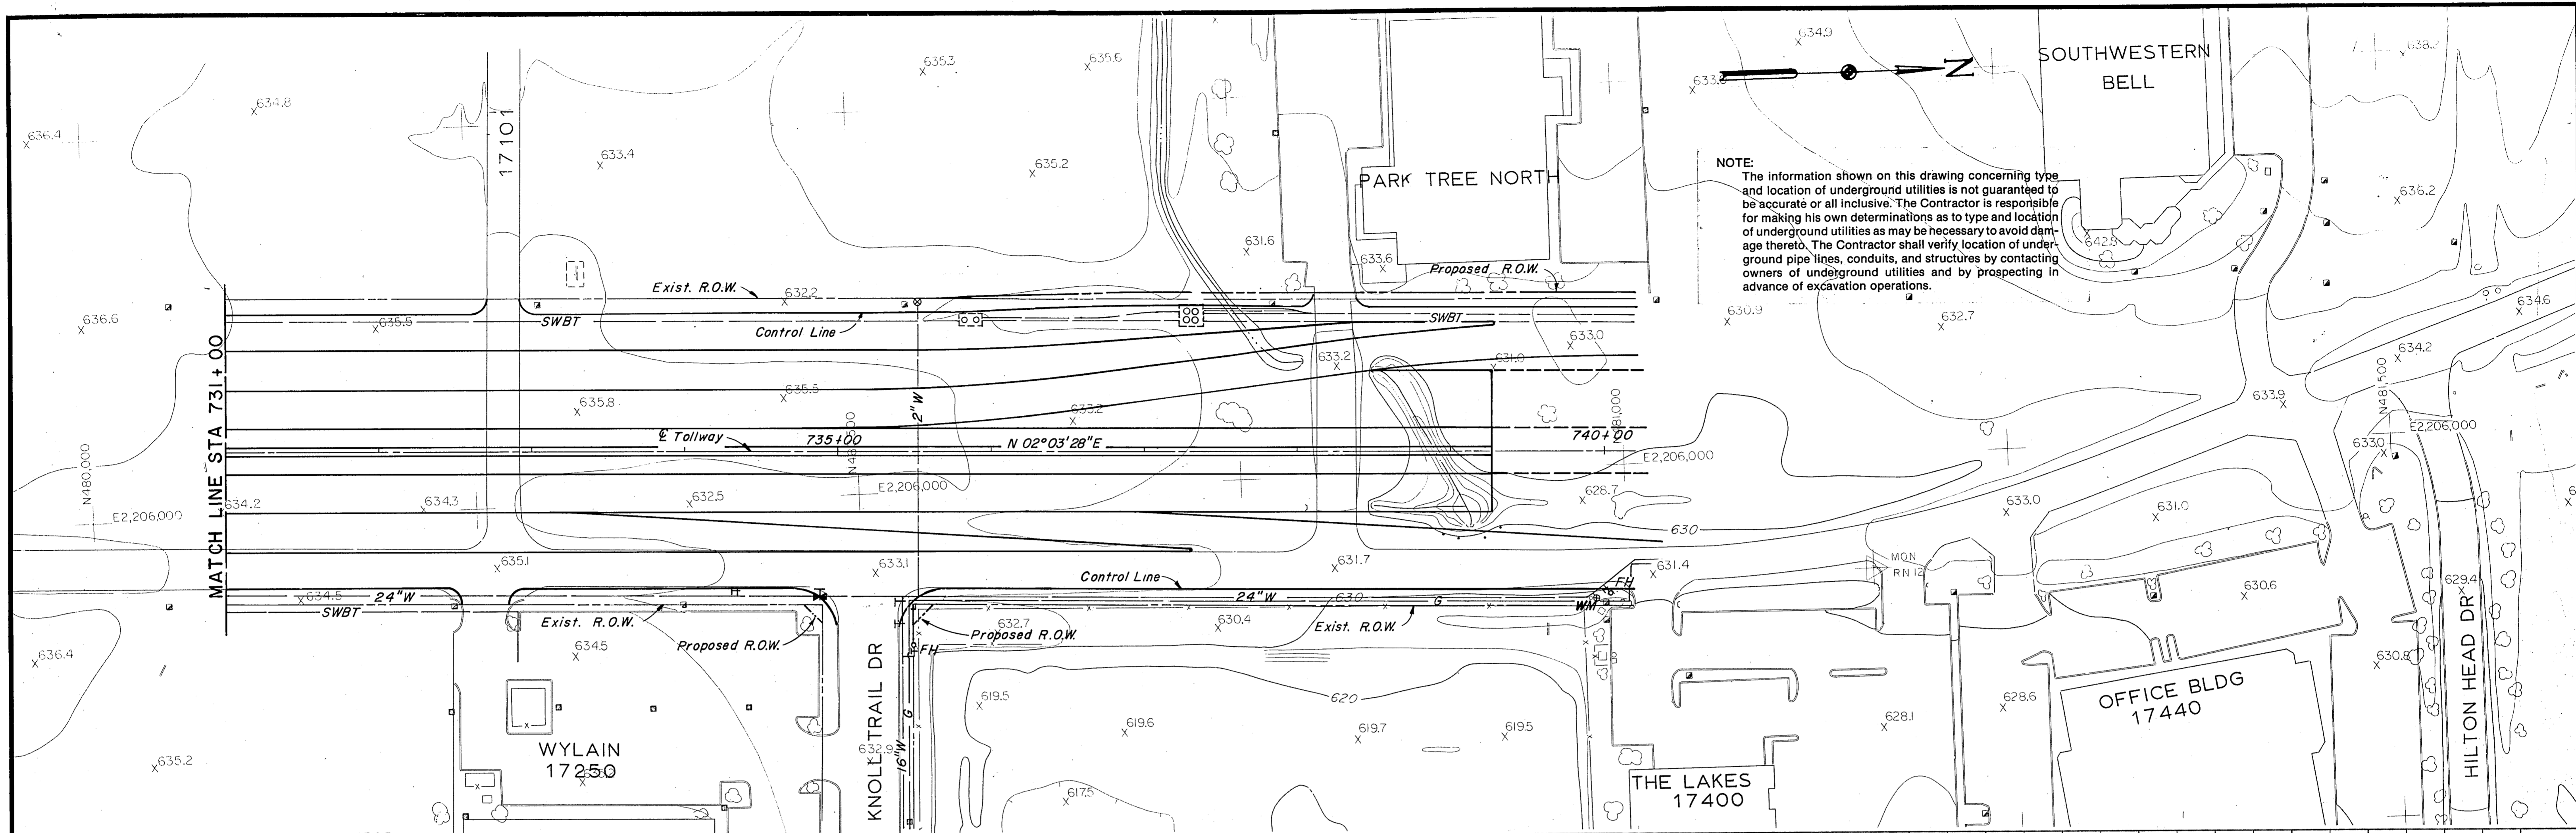


NOTE:  
 The information shown on this drawing concerning type and location of underground utilities is not guaranteed to be accurate or all inclusive. The Contractor is responsible for making his own determinations as to type and location of underground utilities as may be necessary to avoid damage thereto. The Contractor shall verify location of underground pipe lines, conduits, and structures by contacting owners of underground utilities and by prospecting in advance of excavation operations.

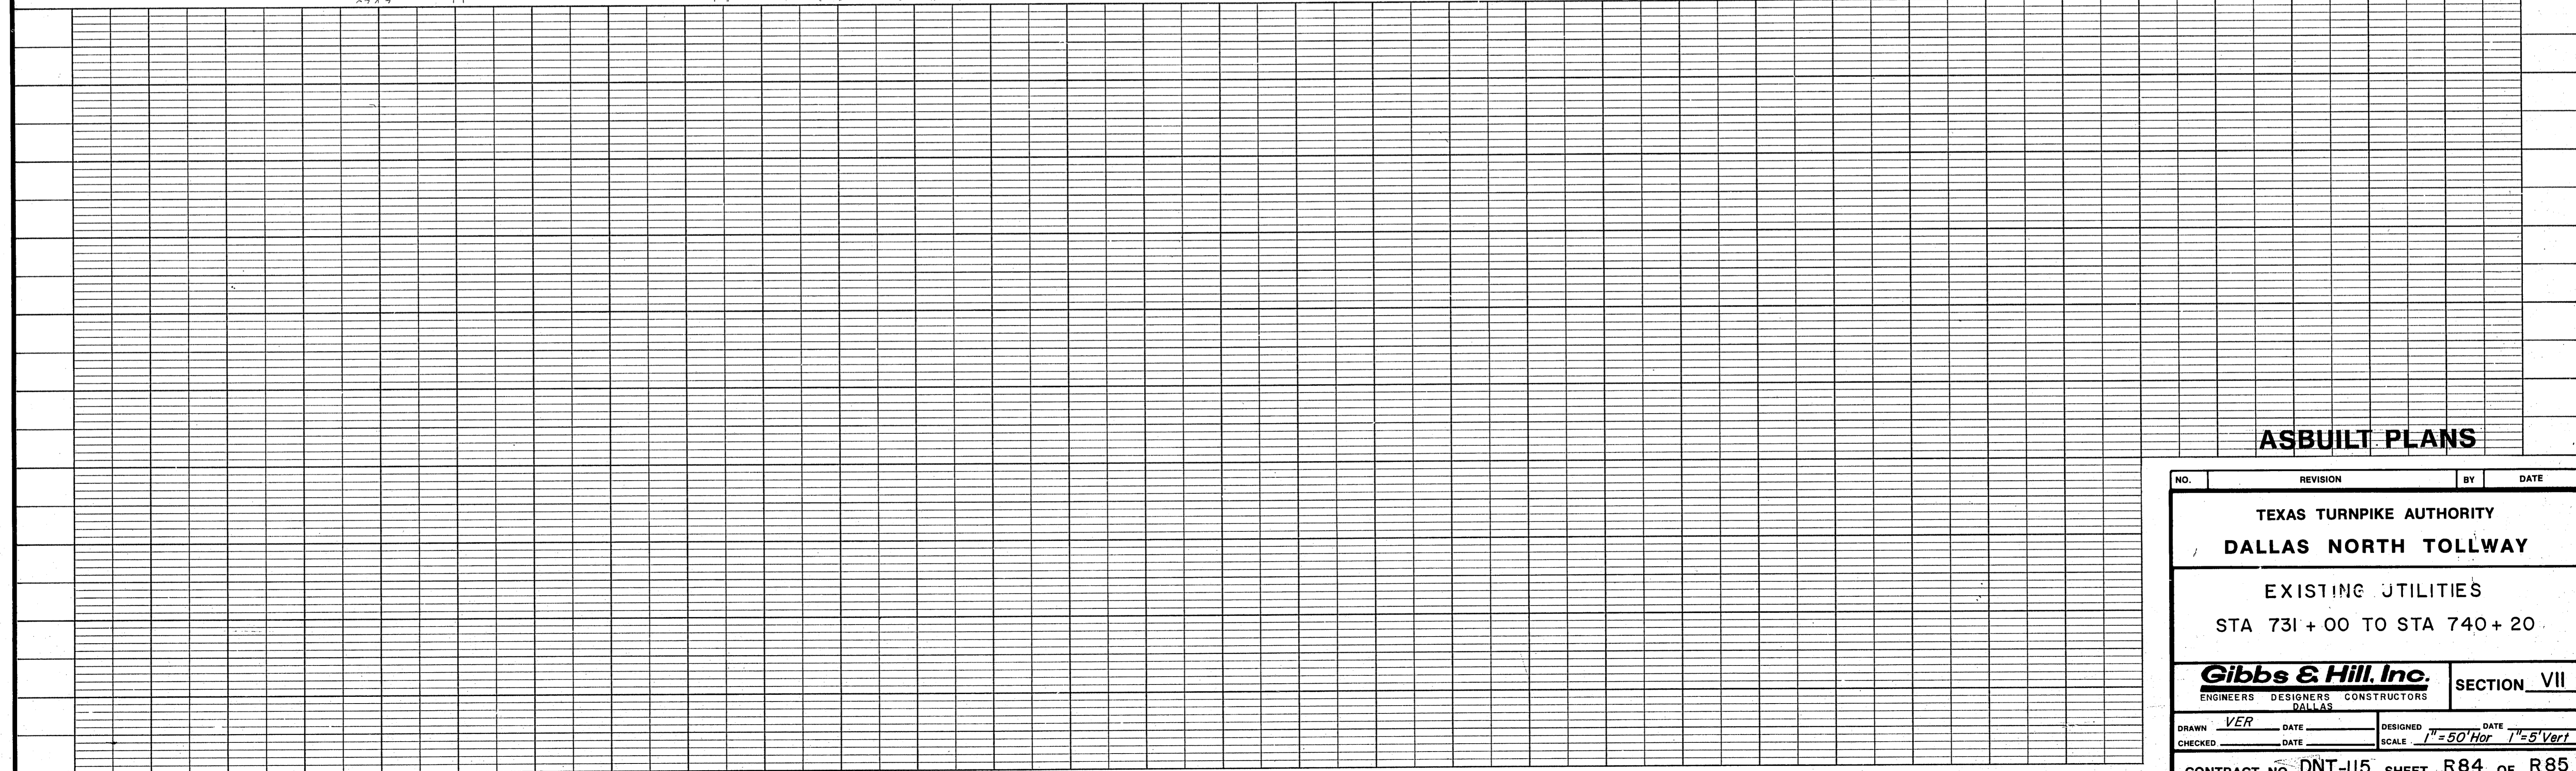

**ASBUILT PLANS**


NO.	REVISION	BY	DATE
<b>TEXAS TURNPIKE AUTHORITY</b> <b>DALLAS NORTH TOLLWAY</b>			
<b>EXISTING UTILITIES</b> <b>STA 731 + 00 TO STA 740 + 20</b>			
<b>Gibbs &amp; Hill, Inc.</b> <small>ENGINEERS DESIGNERS CONSTRUCTORS DALLAS</small>			<b>SECTION VII</b>
<small>DRAWN</small> VER <small>CHECKED</small>	<small>DATE</small> <small>DATE</small>	<small>DESIGNED</small> <small>SCALE</small> 1"=50' Hor 1"=5' Vert	<small>DATE</small>
<b>CONTRACT NO. DNT-115 SHEET R84 OF R85</b>			



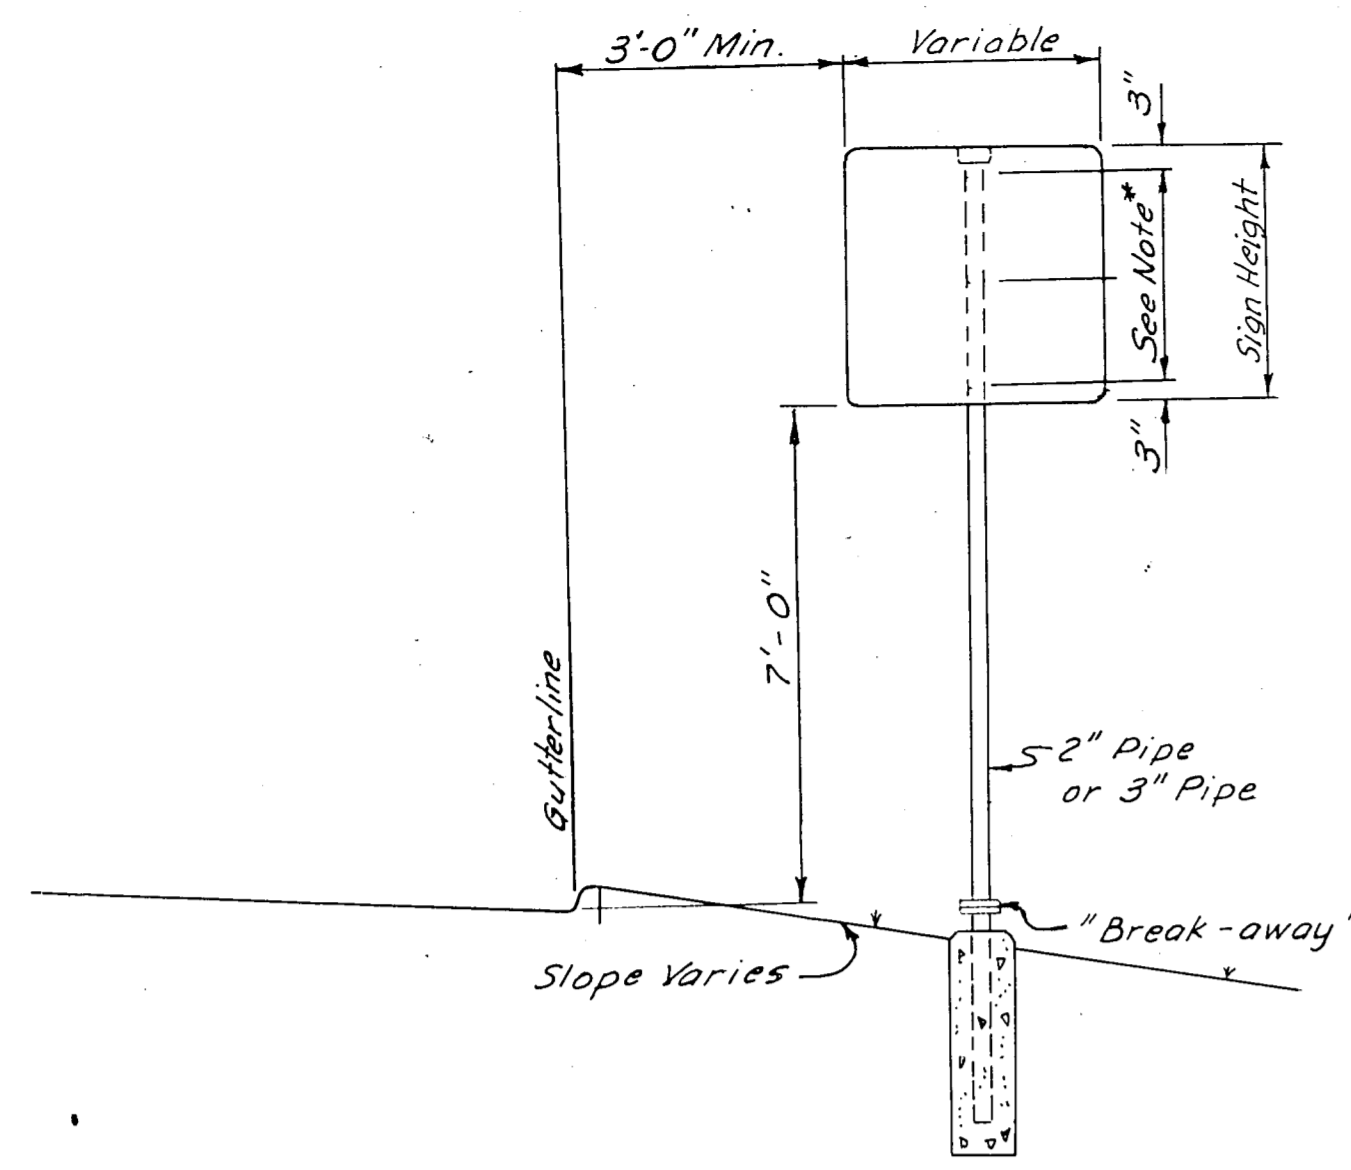


TYPICAL GROUND ANCHORED PIPE MOUNTING

Note: Typical Pavement Marking Details Are Shown For General Purposes Only. The Contractor Shall Place Pavement Markings, As Shown, In Accordance With, The "Texas Manual On Uniform Traffic Control Devices For Streets And Highways" And As Directed By The Engineer And/Or The Jurisdictional City.

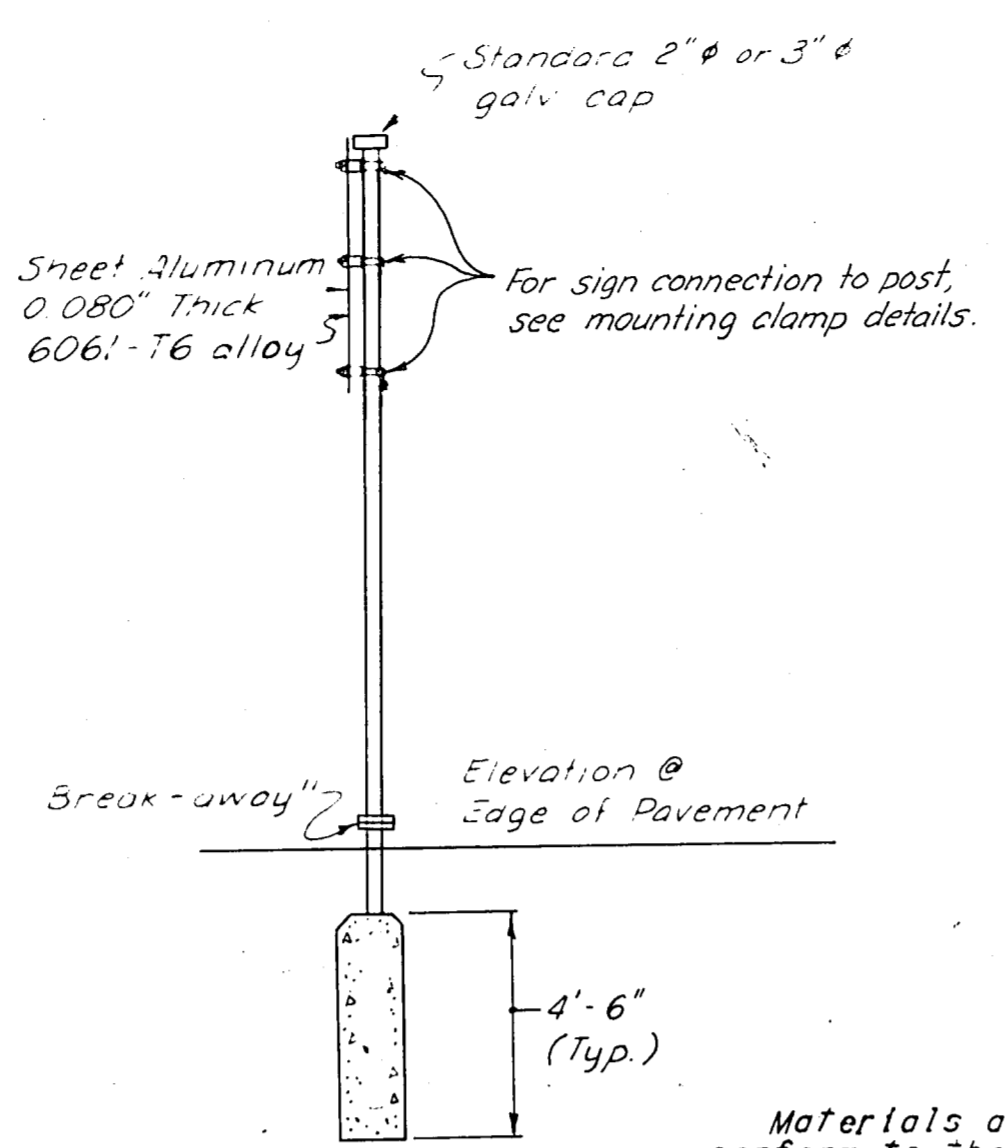


Materials and Fabrication shall conform to the requirements of Texas Highway Dept. Standard Specifications and Special Specifications. All Structural Steel shall conform to ASTM-A441. All Sheet and Plate Aluminum shall conform to ASTM-B209 alloy 6061-T6. All extruded aluminum shall conform to ASTM-B221 alloy 6061-T6. Cast Aluminum post clamps shall conform to ASTM-B26 alloy SG704-T6, ASTM-B108 SG704-T6, ASTM-B26 alloy 2C81A, or ASTM-B108 alloy 2C81B. All high strength bolts, nuts and washers shall conform to ASTM-A325. All bolts other than high strength bolts shall conform to ASTM-A307, Class A. All structural steel bolts, nuts, and washers shall be galvanized as per Item 442 of the Standard Specifications except as noted. Structural steel to be galvanized after fabrication except as noted.

Notes: When height of sign is over 21'-0", the ridge bolt assembly shall be used. This bolt shall be approx. 1/2" but in no case will it be an letters or in between letters of the sign text.

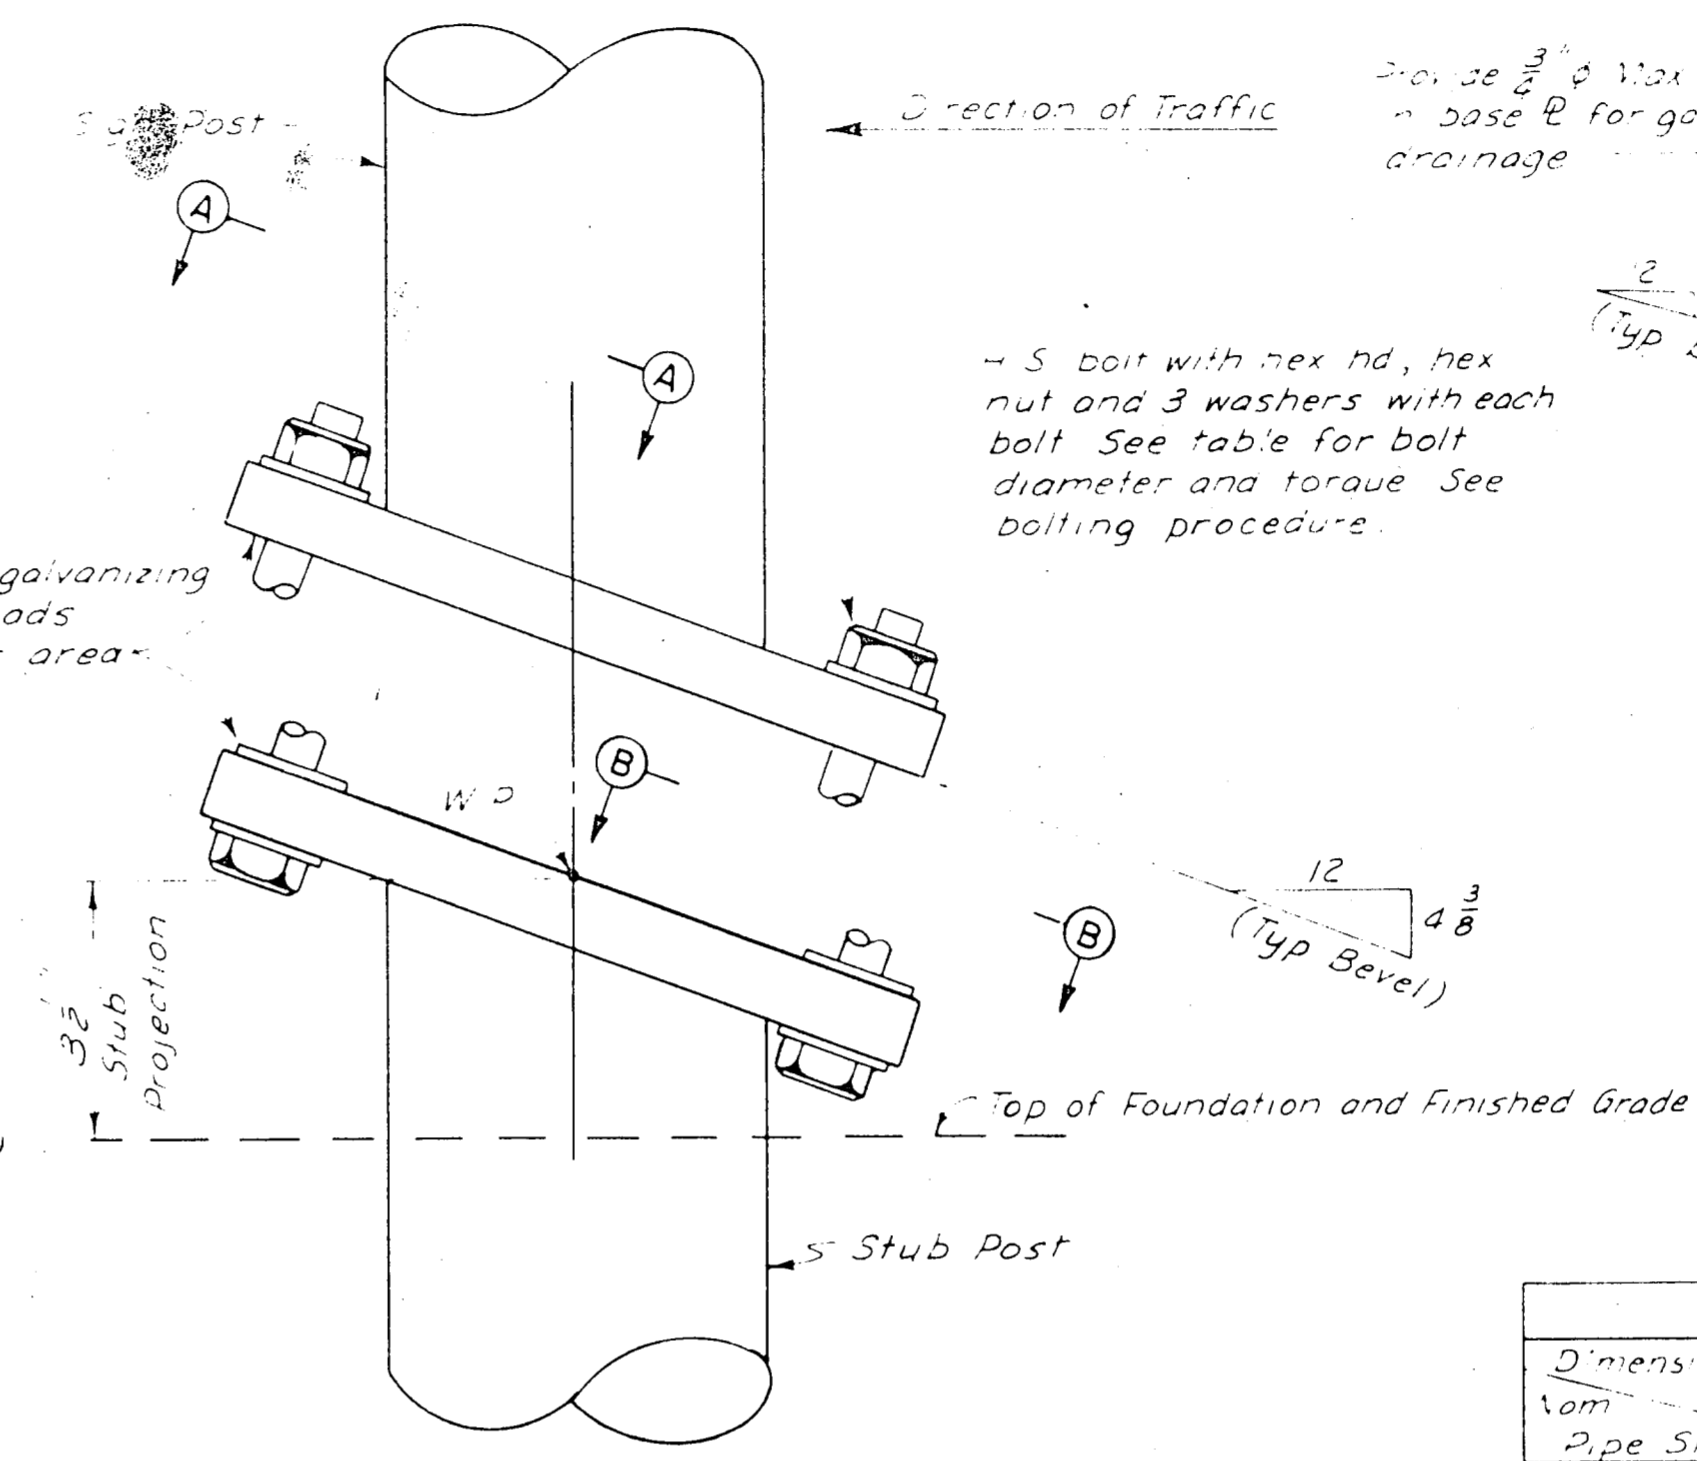

ELEVATION SIGN POST AND STUB POST

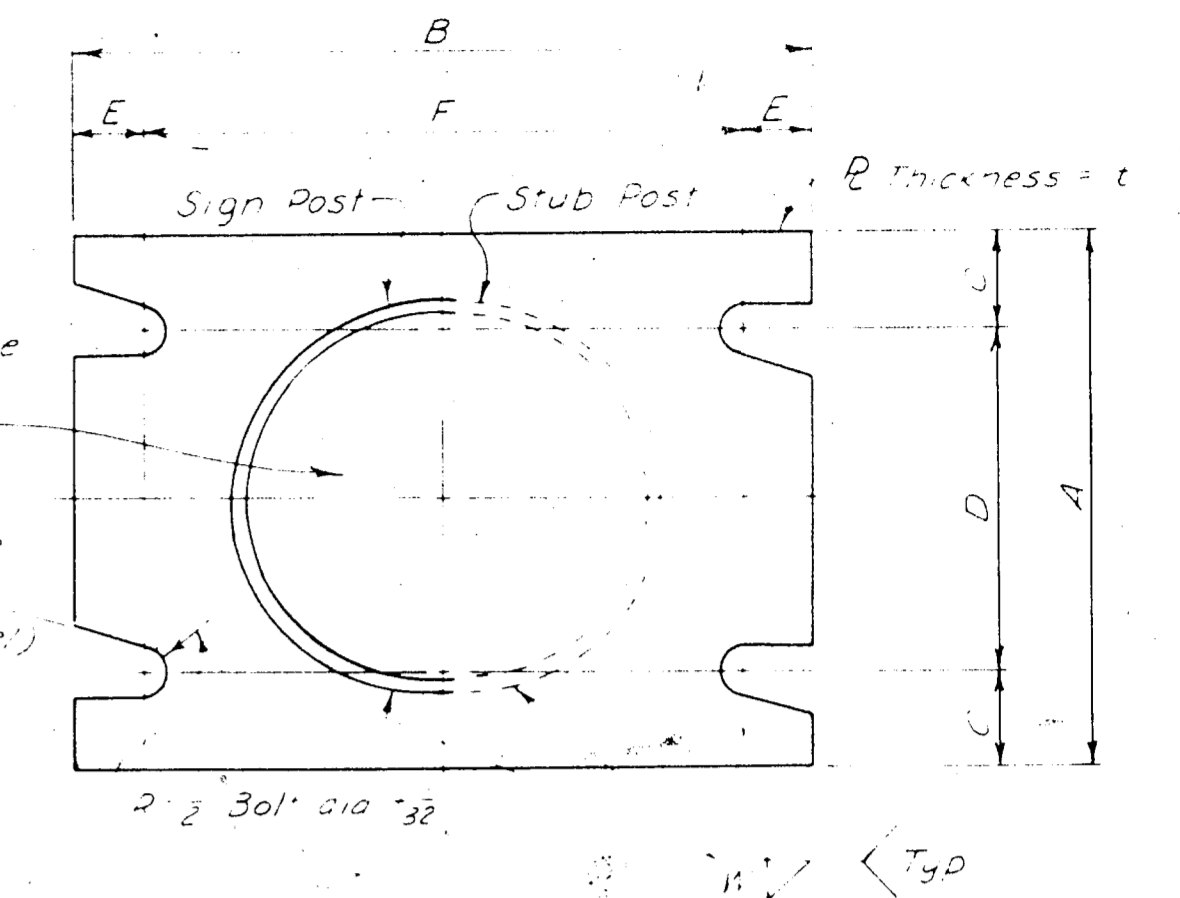


SECTION A-A SECTION B-B (See Table for Dimensions) Sections shown are for installations on right shoulder and in gore. Plate sloe bevels are opposite hand from that shown for installations on left shoulder. Plates shall conform with the requirements of ASTM A36.


BASE CONNECTION DATA TABLE								
Dimensions Nom	Bolt Size & Torque	A	B	C	D	E	F	t W
2" Ø	5/8" x 8" Torque 200'ft	4 1/2"	6 1/2"	1"	2 1/2"	3 1/2"	4 1/2"	1/2" 1"
3" Ø	1" x 10" Torque 200'ft	4 1/2"	7"	1"	2 1/2"	3 1/2"	5 1/2"	3/4" 1 1/2"

PROCEDURE FOR ASSEMBLY OF BASE CONNECTION

1. Assemble post to stub with bolts and WITH ONE FLAT WASHER BETWEEN PLATES
2. Shim as required to plumb post.
3. Tighten all bolts the maximum possible with 12" to 15" wrench to bed washers and to clean bolt threads then loosen.
4. Retighten bolts in a systematic order to prescribed torque see Table
5. Loosen each bolt and retighten to prescribed torque in the same order as in the retightening.
6. Run threads at junction with nut using a center punch to prevent nut loosening.

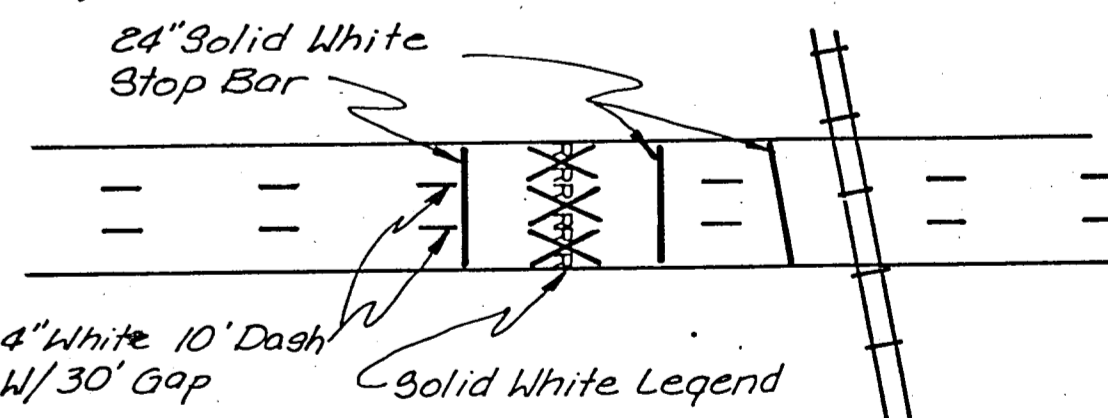


TYPICAL PAVEMENT MARKING DETAILS S.S.W. RAILWAY Scale: 1" = 50'

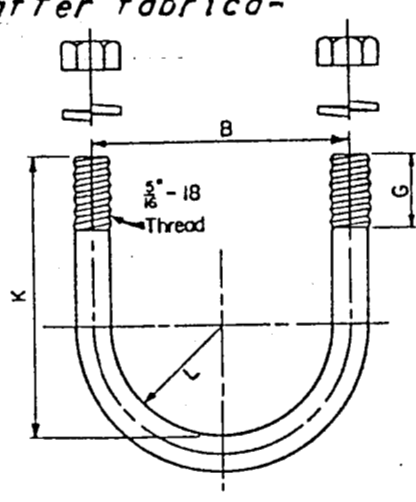

U-Bolt to be made in accordance with standard manufacturing procedure. 3/8" Dia. stock is permissible. Amer. Standard regular semi-finished hex nuts & spring lock washers.


Standard Pipe Size	Dimensions for Mounting Clamp													
	A	B	C	D	E	F	G	H	I	J	K	L	R <sub>1</sub>	R <sub>2</sub>
1 1/2"	3 1/2"	2 1/4"	1 1/4"	1 1/4"	1 1/4"	1 1/4"	1 1/4"	1 1/4"	1 1/4"	1 1/4"	1 1/4"	1 1/4"	1 1/4"	1 1/4"
2"	3 3/4"	2 1/2"	1 1/2"	1 1/2"	1 1/2"	1 1/2"	1 1/2"	1 1/2"	1 1/2"	1 1/2"	1 1/2"	1 1/2"	1 1/2"	1 1/2"
2 1/2"	4 1/4"	3 1/4"	2 1/4"	1 3/4"	1 3/4"	1 3/4"	1 3/4"	1 3/4"	1 3/4"	1 3/4"	1 3/4"	1 3/4"	1 3/4"	1 3/4"
3"	4 3/4"	3 3/4"	2 3/4"	2"	2"	2"	2"	2"	2"	2"	2"	2"	2"	2"

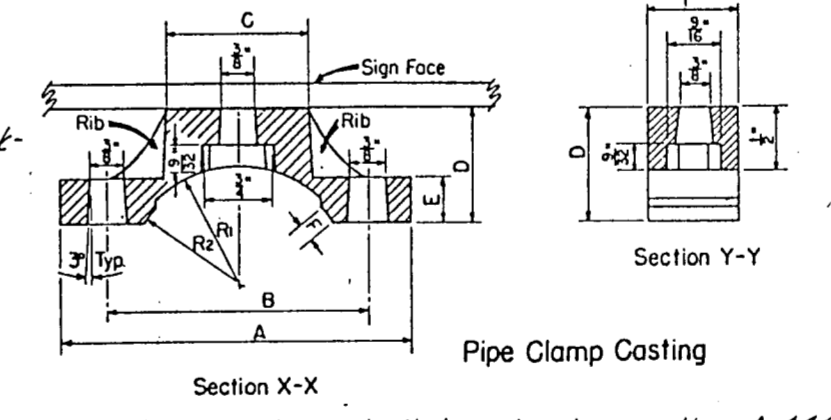

Pipe clamp casting shall be aluminum alloy A 444.0 or 356.0-F. All sign mounting clamp parts not made from aluminum shall be stainless steel or galvanized steel in conformance with the item "Metal for Structures".

MOUNTING CLAMP DETAILS

SIGN SUPPORT AND STRIPING ESTIMATED QUANTITY SUMMARY			
ITEM NO.	DESCRIPTION	UNIT	QUANTITY
646 & SP	Roadside Traffic Sign Support (Ground Anchored, 2" Ø Pipe)	Lin. Ft.	714
670 & SP	Pavement Marking (Reflectorized Paint, 4" White)	Lin. Ft.	9000
670 & SP	Pavement Marking (Reflectorized Paint, 4" Yellow)	Lin. Ft.	1000
670 & SP	Pavement Marking (Reflectorized Paint, 24" White)	Lin. Ft.	700
670 & SP	Pavement Messages and Arrows (Reflectorized Paint, White)	Sq. Ft.	600
676	Traffic Button (Type I-C) (White)	Ea.	60
676	Traffic Button (Type I-C) (Yellow)	Ea.	30

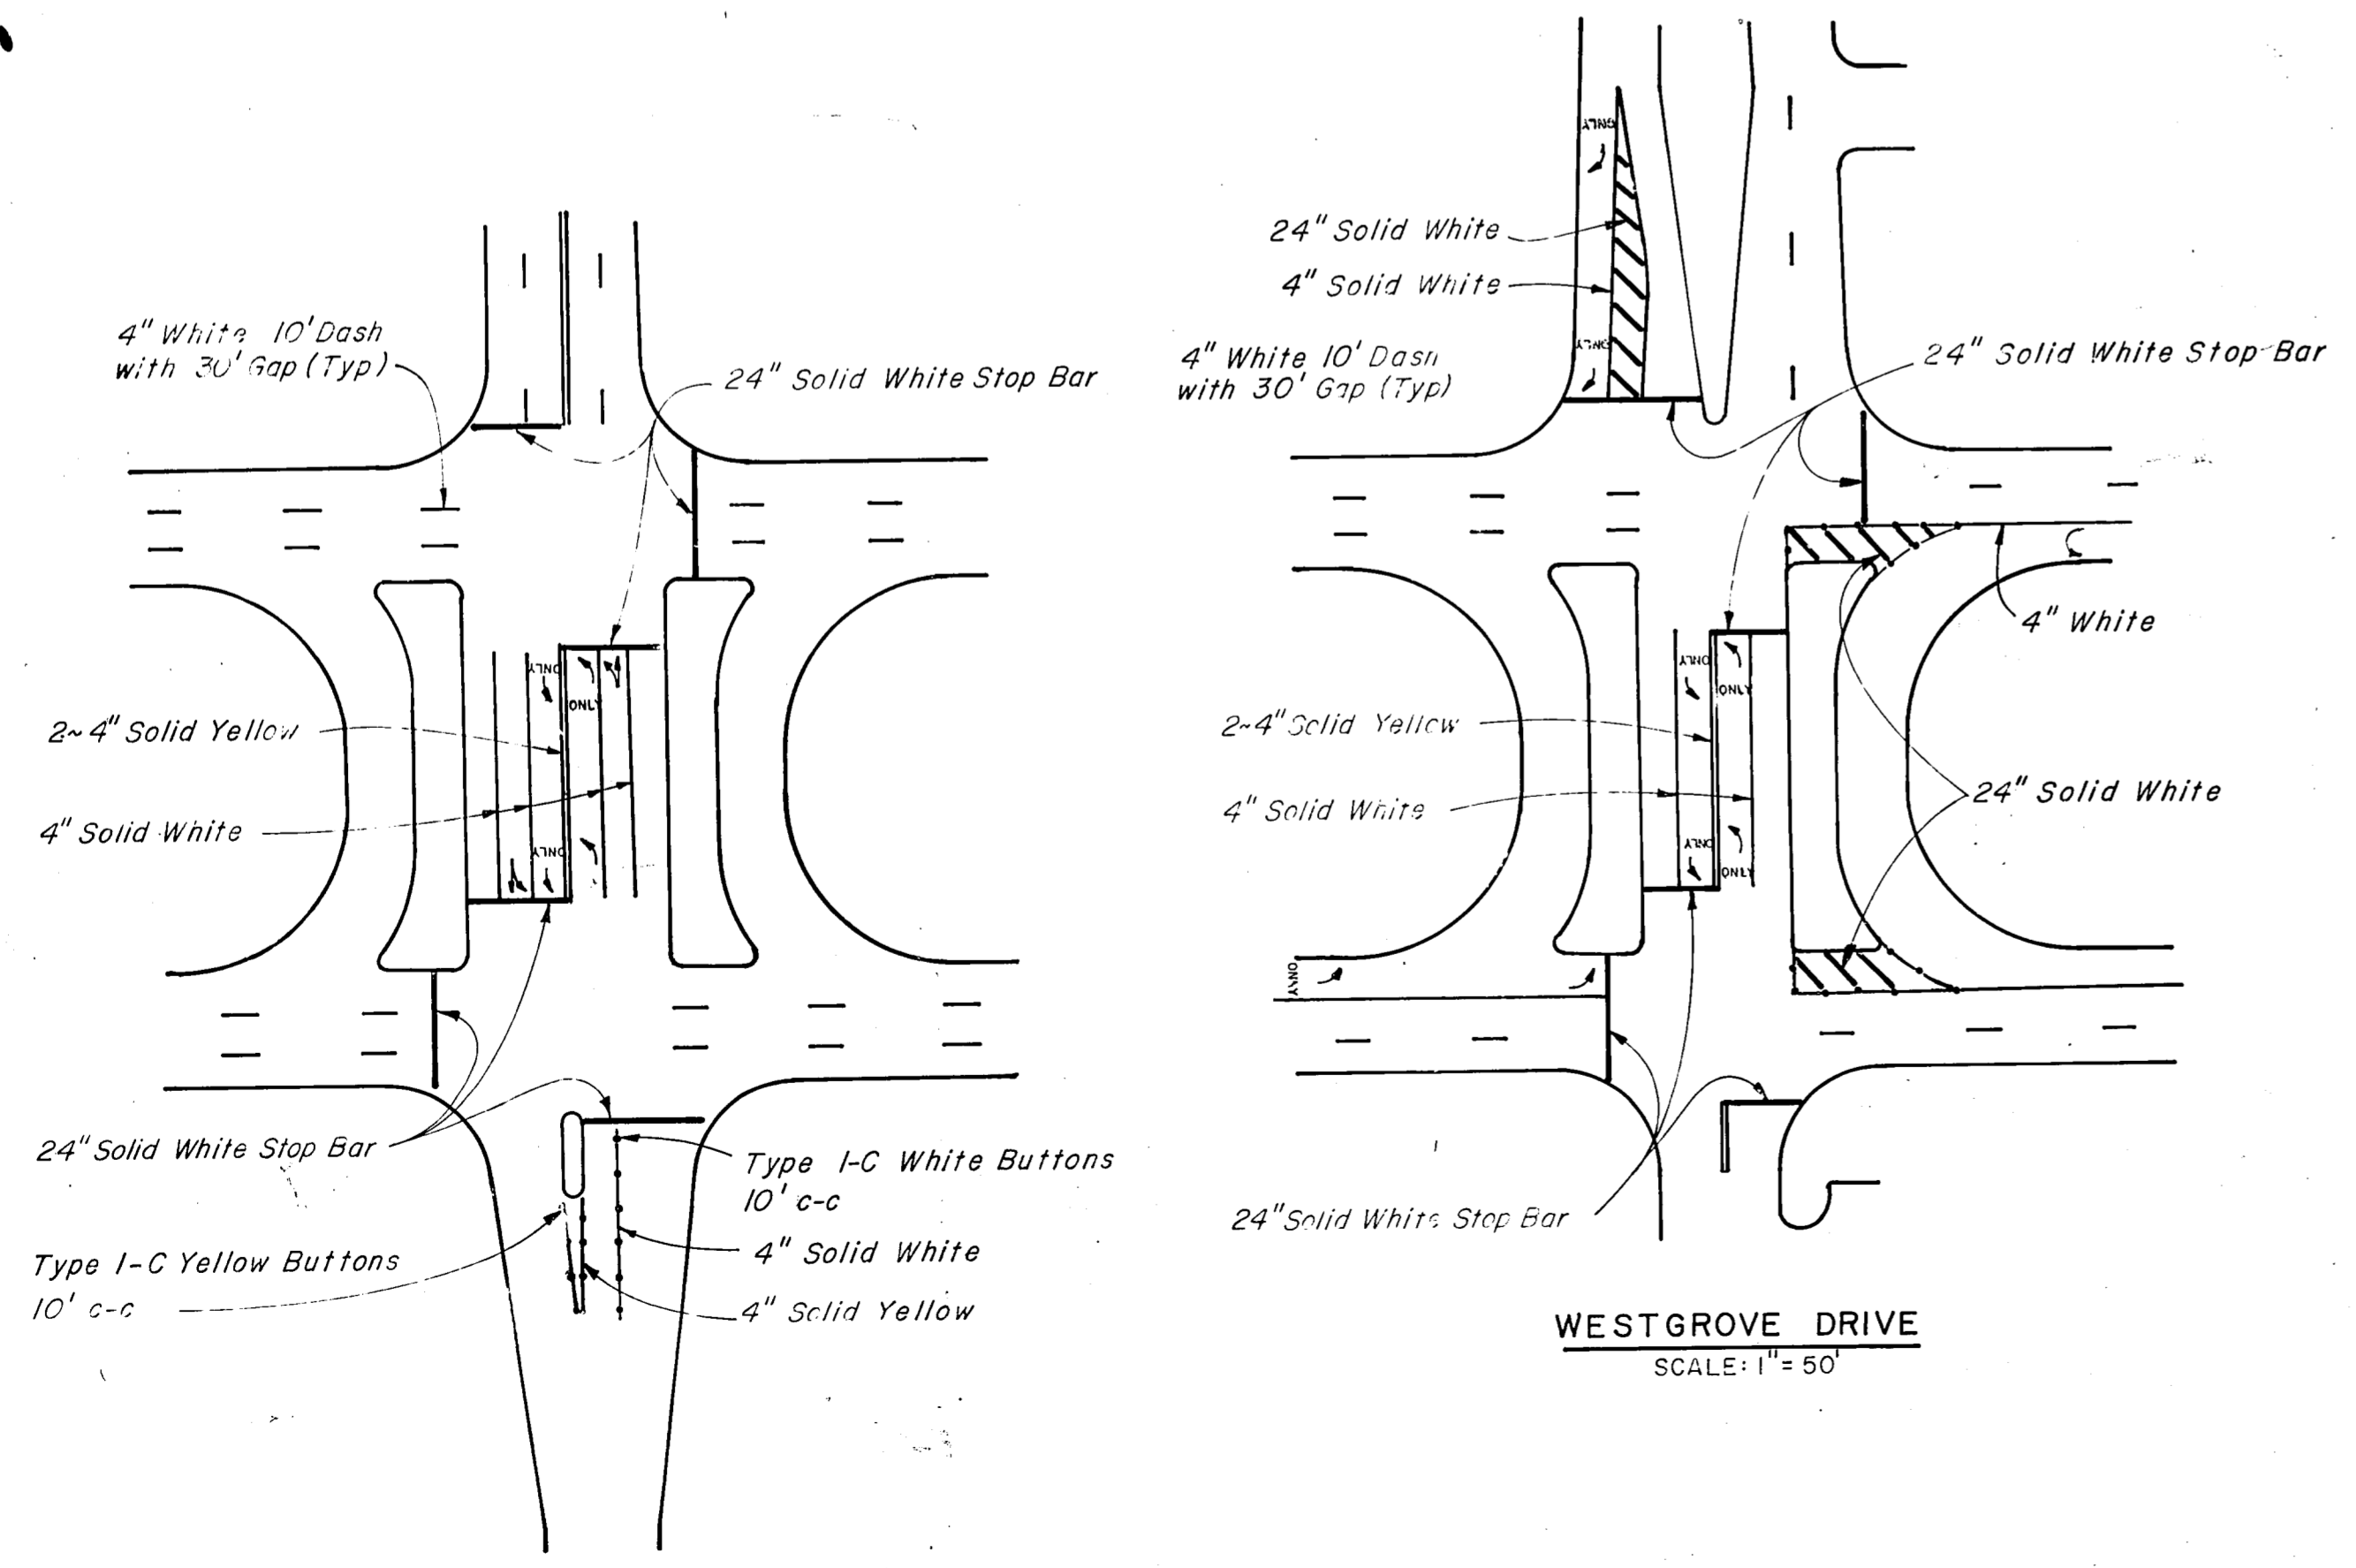

KELLER SPRINGS ROAD SCALE: 1" = 50'

WESTGROVE DRIVE SCALE: 1" = 50'

TYPICAL PERMANENT PAVEMENT MARKING DETAILS

NO.	REVISION	BY	DATE
TEXAS TURNPIKE AUTHORITY DALLAS NORTH TOLLWAY			
MISCELLANEOUS DETAILS SIGNING & STRIPING			
<b>Gibbs &amp; Hill, Inc.</b> ENGINEERS DESIGNERS CONSTRUCTORS DALLAS			SECTION VII
DRAWN	VER	DATE	DESIGNED
CHECKED	DWC	DATE	SCALE
CONTRACT NO. DNT-115 SHEET R85 OF R85			