


LEGEND

- ▲ Drainage Structures to be constructed under Phase III
- Drainage Structures constructed under Phase I & II
- Existing Drainage Structures

See Sheet R34 for Definition of Phases I, II, & III.

Bench Mark #7
Chiseled "o" on southwest corner of inlet on north side of Bent Tree Forest Drive, 500' east of Dallas Parkway.
Elevation: 604.23

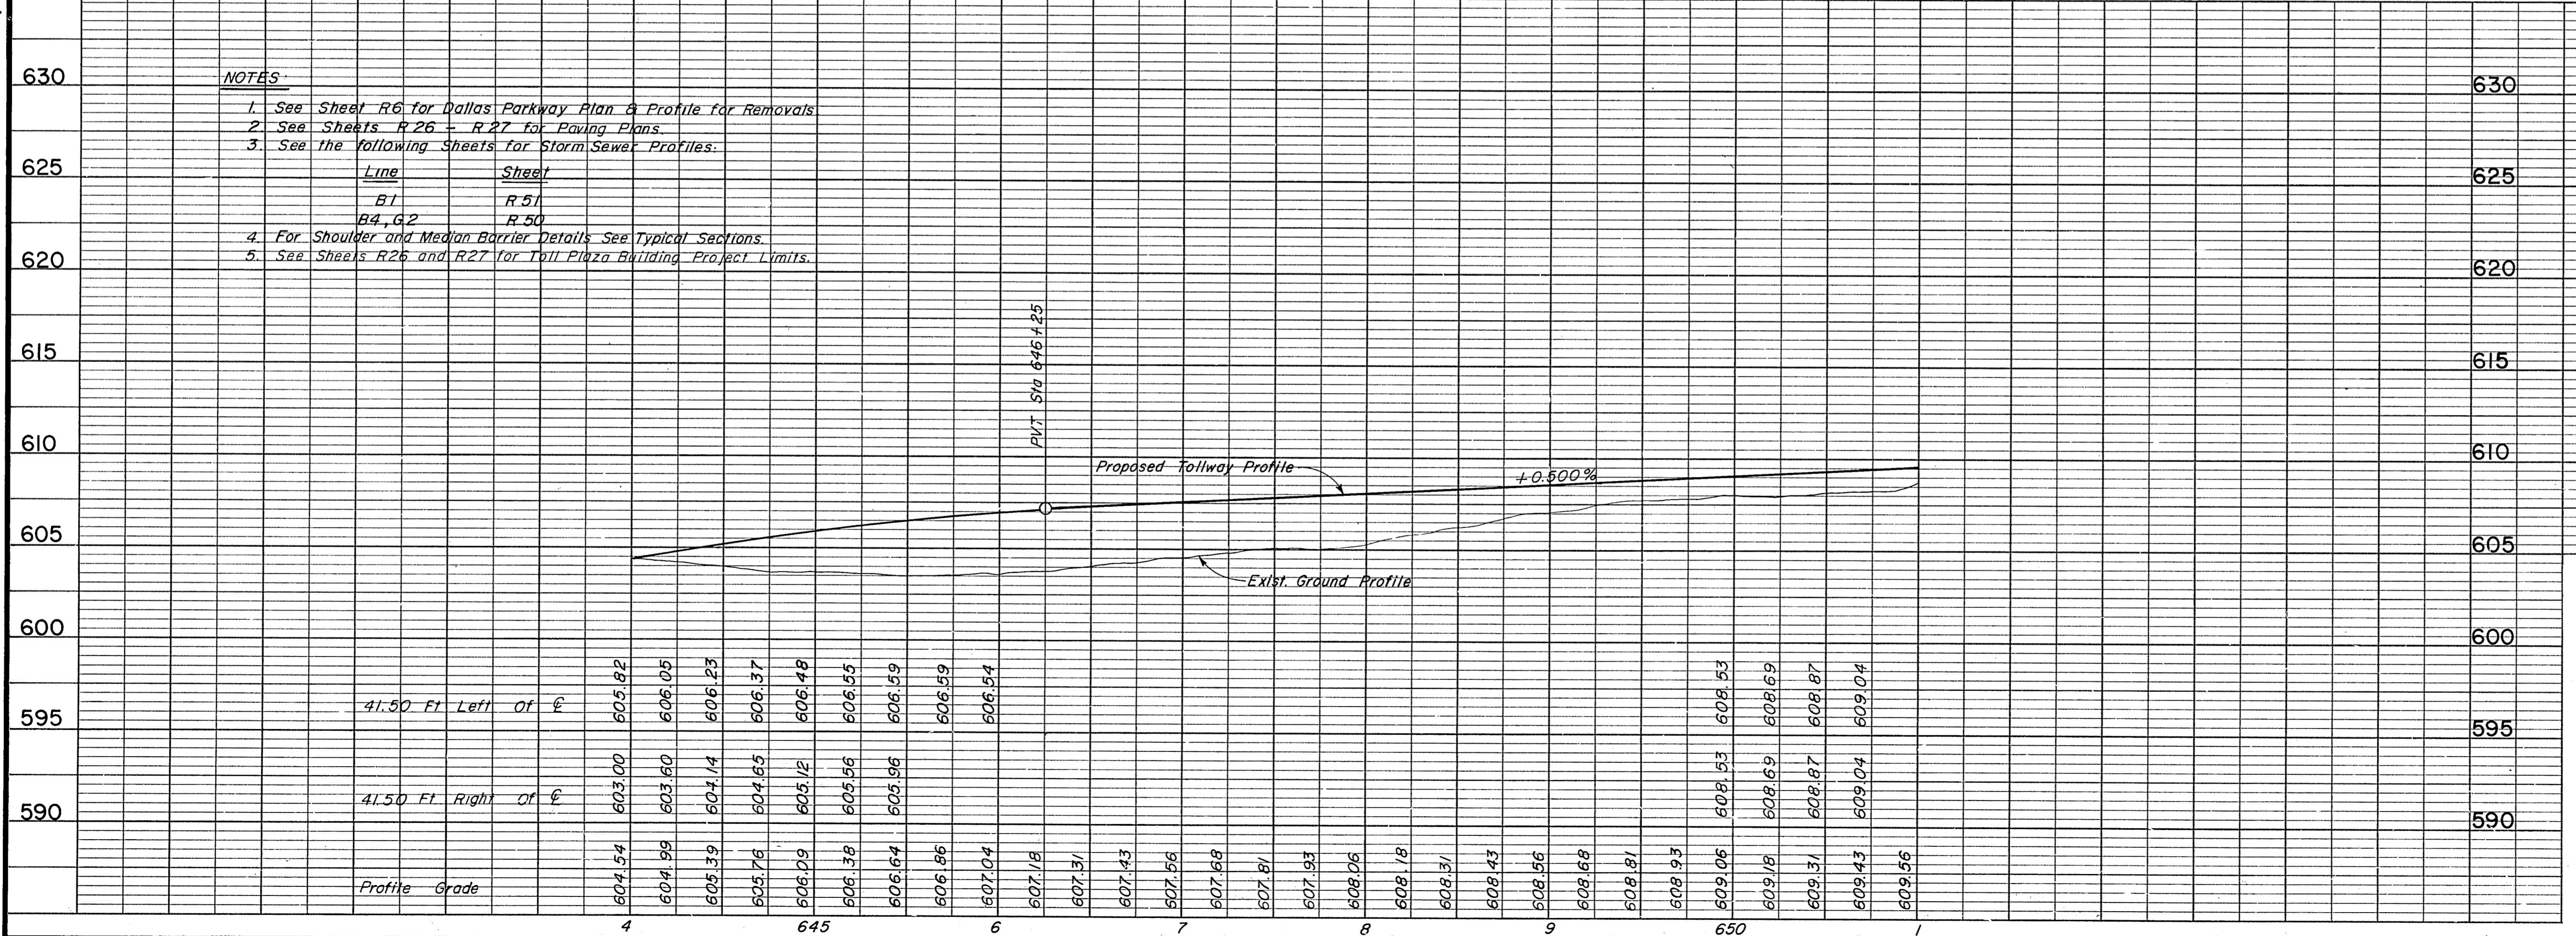

ASBUILT PLANS

▲ Added Conduit

NO.	REVISION	BY	DATE
		JJK	2-19-86

TEXAS TURNPIKE AUTHORITY
DALLAS NORTH TOLLWAY

PAVING AND GRADING
TOLLWAY
STA 644+00 TO STA 651+00

Gibbs & Hill, Inc.
ENGINEERS DESIGNERS CONSTRUCTORS DALLAS

SECTION VII

DRAWN VER	DATE 7/8/83	DESIGNED DWC	DATE 6/30/83
CHECKED DWC	DATE 5/7/84	SCALE 1" = 50' Hor 1" = 5' Vert	

CONTRACT NO. DNT-115 SHEET R16 OF R85