


**LEGEND**

- Drainage Structures to be constructed under Phase III
- Drainage Structures constructed under Phase I & II
- Existing Drainage Structures

See Sheet R37 for Definition of Phases I, II & III.

Bench Mark #10  
 Chiseled "o" on center of inlet on west side on Knoll Trail Drive, 1850' north of Westgrove Drive, 20' south of power pole (#14N-2W 68) and 400' east of Dallas Parkway.  
 Elevation: 630.40

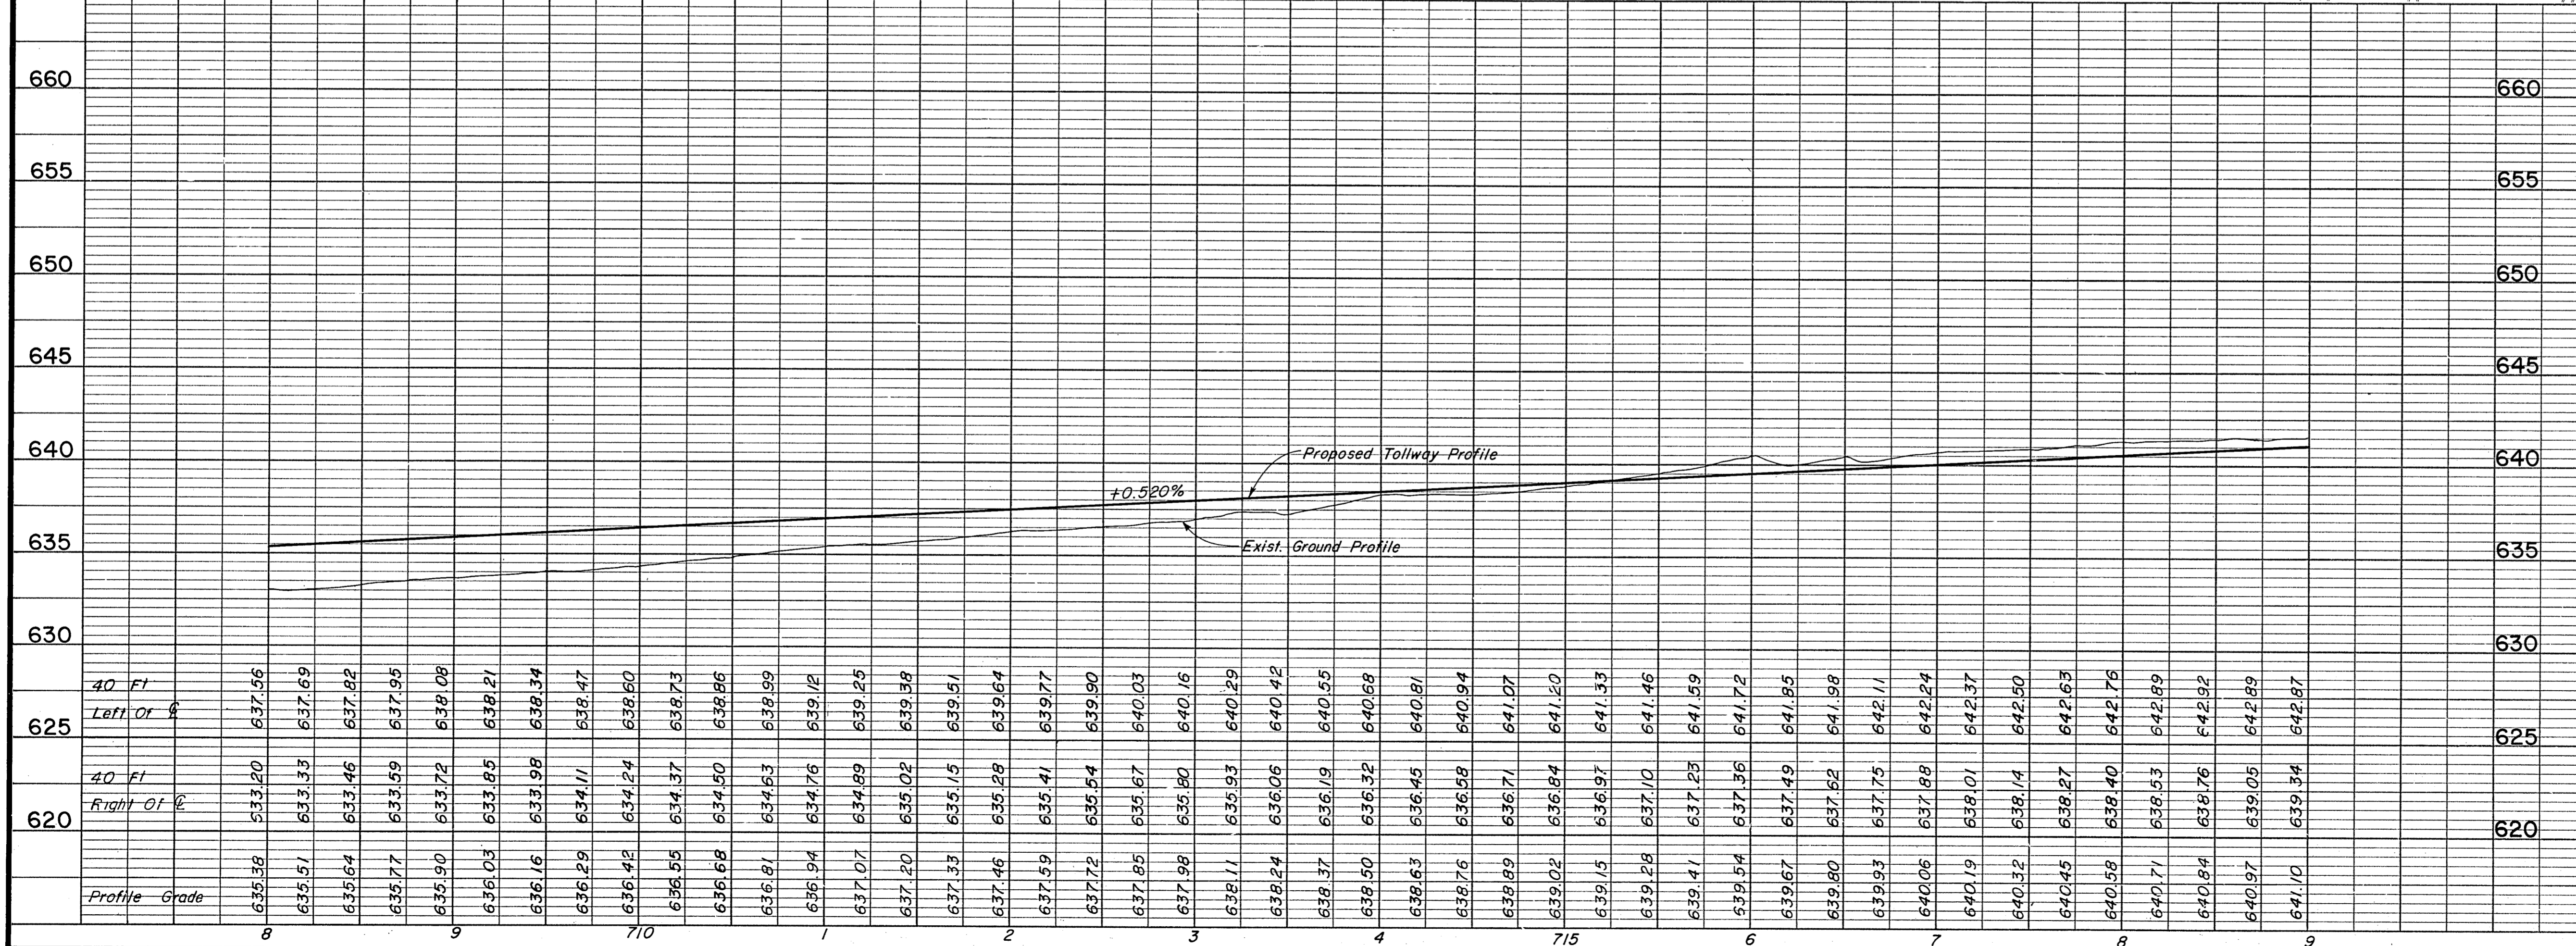

**NOTES**

1. See Sheet R-12 for Dallas Parkway Plan & Profile for Removals.
2. See Sheet W-12 for Retaining Wall Details.
3. See Sheet R-62 for Storm Sewer Details.
4. For Shoulder and Median Barrier Details See Typical Sections.

**ASBUILT PLANS**

NO.	REVISION	BY	DATE
<b>TEXAS TURNPIKE AUTHORITY</b>			
<b>DALLAS NORTH TOLLWAY</b>			
PAVING AND GRADING TOLLWAY STA 708+00 TO STA 719+00			
<b>Gibbs &amp; Hill, Inc.</b>			<b>SECTION VII</b>
<small>ENGINEERS DESIGNERS CONSTRUCTORS DALLAS</small>			
<small>DRAWN</small> VER	<small>DATE</small> 7/8/83	<small>DESIGNED</small> DWC	<small>DATE</small> 6/30/83
<small>CHECKED</small> DWC	<small>DATE</small> 5/4/84	<small>SCALE</small> 1"=50' Hor 1"=5' Vert	
<b>CONTRACT NO. DNT-115 SHEET R22 OF R85</b>			