

CURVE TM-S 4
 PI Sta 9+79.490
 N 481222.811
 E 2205949.271
 $\Delta = 8^\circ 12' 54.7''$
 $D = 5^\circ 00' 00.0''$
 $R = 1145.916'$
 $T = 82.293'$
 $L = 164.304'$


CURVE TM-S 3
 PI Sta 8+08.324
 N 481393.819
 E 2205930.823
 $\Delta = 13^\circ 31' 50.4''$
 $D = 7^\circ 34' 36.6''$
 $R = 756.198'$
 $T = 89.707'$
 $L = 178.580'$

CURVE TM-S 2
 PI Sta 5+48.952
 N 481638.108
 E 2205843.412
 $\Delta = 5^\circ 52' 09.0''$
 $D = 6^\circ 00' 00.0''$
 $R = 954.930'$
 $T = 48.952'$
 $L = 97.819'$

End Wall W-119
 Sta. 4+27.59 Ramp TM-S
 Ctr. I/R @ Ramp TM-S Sta 5+00.00
 @ S.B. Dallas Pkwy Sta 747+00.00, 34' RT.

LEGEND

- Drainage Structures to be constructed under Phase III
 - Drainage Structures constructed under Phase I & II
 - Existing Drainage Structures
- See Sheet R38 for Definition of Phases I, II, & III.

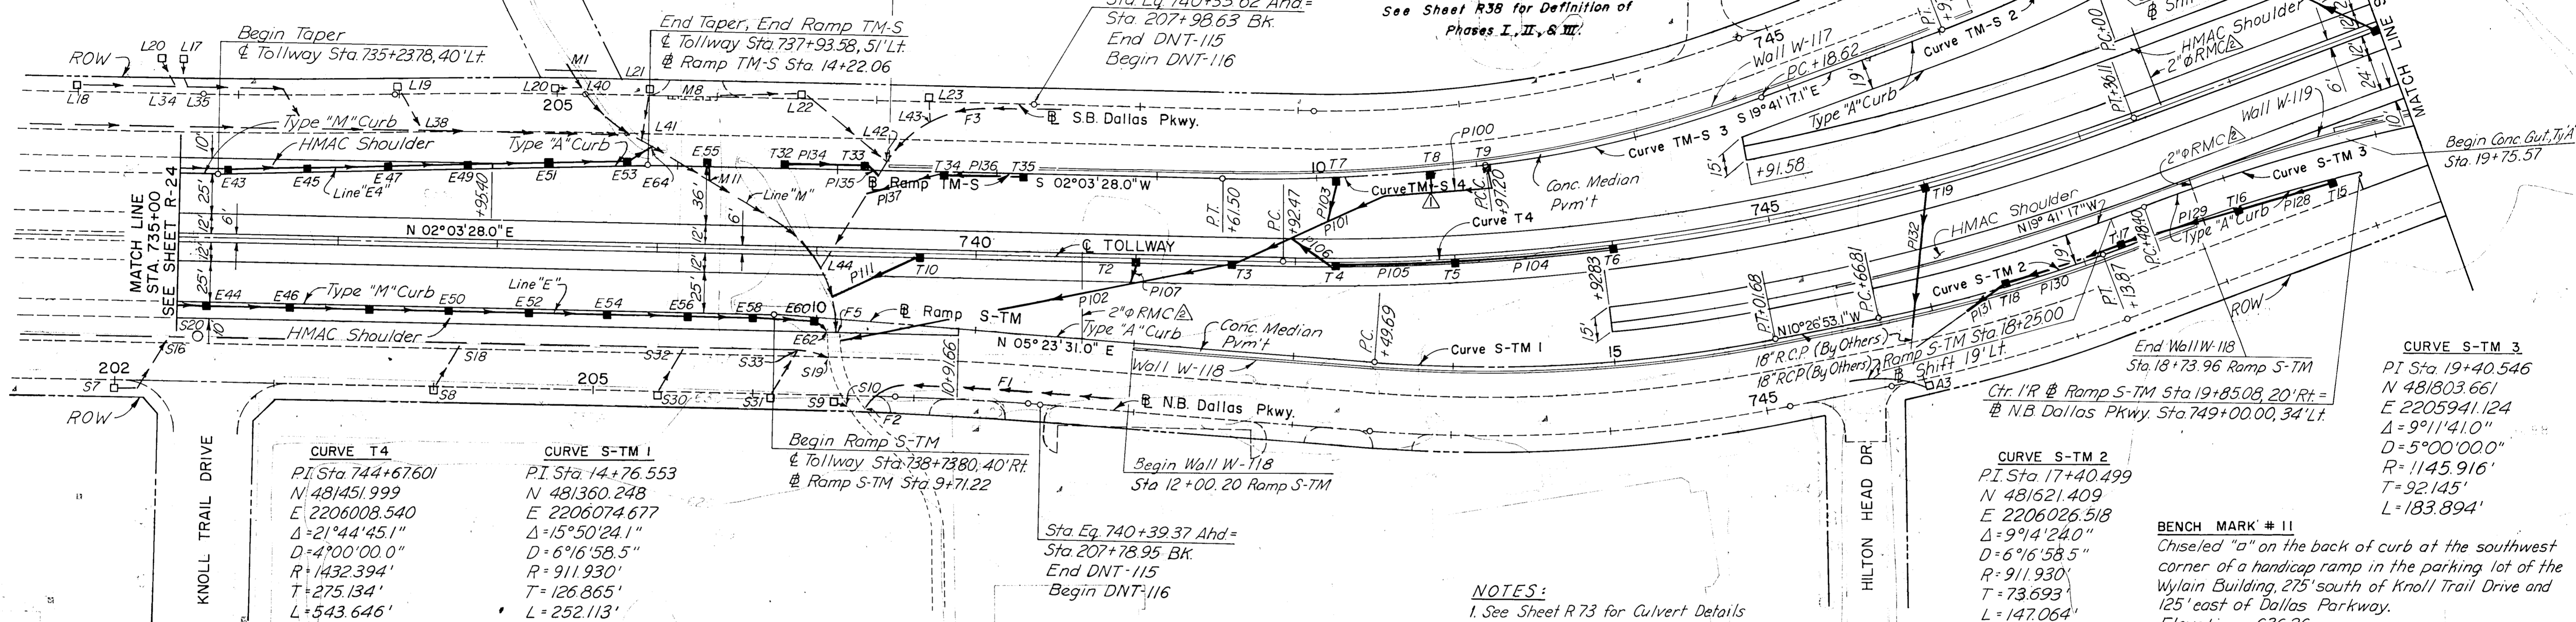

CURVE T4
 PI Sta 744+67601
 N 481451.999
 E 2206008.540
 $\Delta = 21^\circ 44' 45.1''$
 $D = 4^\circ 00' 00.0''$
 $R = 1432.394'$
 $T = 275.134'$
 $L = 543.646'$

CURVE S-TM 1
 PI Sta 14+76.553
 N 481360.248
 E 2206074.677
 $\Delta = 15^\circ 50' 24.1''$
 $D = 6^\circ 16' 58.5''$
 $R = 911.930'$
 $T = 126.865'$
 $L = 252.113'$

CURVE S-TM 2
 PI Sta 17+40.499
 N 481521.409
 E 2206026.518
 $\Delta = 9^\circ 14' 24.0''$
 $D = 6^\circ 16' 58.5''$
 $R = 911.930'$
 $T = 73.693'$
 $L = 147.064'$

CURVE S-TM 3
 PI Sta 19+40.546
 N 481803.661
 E 2205941.124
 $\Delta = 9^\circ 11' 41.0''$
 $D = 5^\circ 00' 00.0''$
 $R = 1145.916'$
 $T = 92.145'$
 $L = 183.894'$


NOTES:

1. See Sheet R 73 for Culvert Details
2. See Sheet R 65 & R 67A for Storm Sewer Profiles.
3. See Typical Sections for Shoulder and Median Details
4. Curb Detail for left side of Ramps S-TM and TM-S at the Gate with the Tollway is similar to Curb Detail at Railroad as shown on Standard Drawing No. 15.
5. See Sheet R 25A for Ramp Profiles.

BENCH MARK # 11
 Chiseled "a" on the back of curb at the southwest corner of a handicap ramp in the parking lot of the Wylain Building, 275' south of Knoll Trail Drive and 125' east of Dallas Parkway. Elevation 636.26.

BENCH MARK # 12
 Railroad Spike in South Side of Power Pole (15N2W99) 50' North of Addison Rd - Trinity Mills Rd Intersection, 500' West of Dallas Parkway. Elev: 638.11.

▲	Added Conduit	JTK	2-20-86
▲	Misc. Drainage Revisions	GMG	2-11-86
No	Revision	By	Date

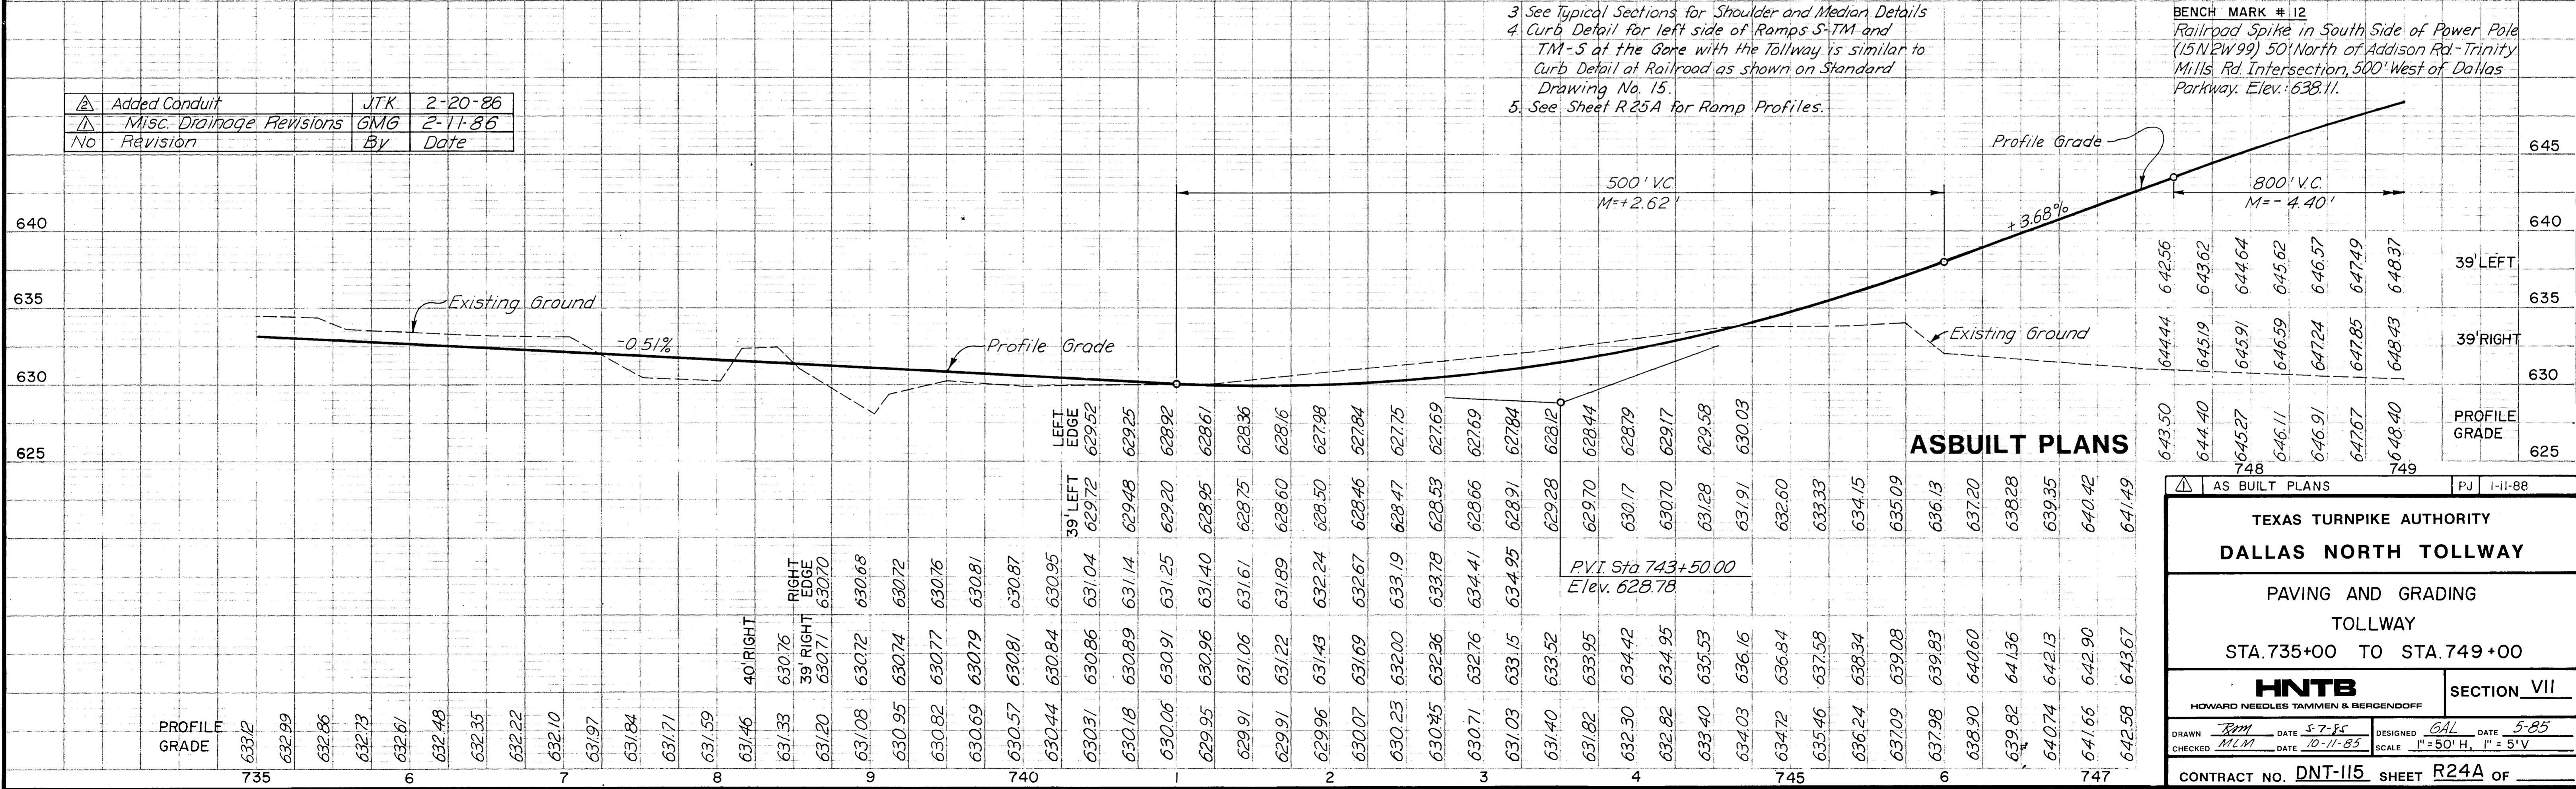

ASBUILT PLANS

STATION	LEFT EDGE	RIGHT EDGE	PROF. GRADE
735	629.72	630.76	633.12
736	629.72	630.76	632.99
737	629.72	630.76	632.86
738	629.72	630.76	632.73
739	629.72	630.76	632.61
740	629.72	630.76	632.48
741	629.72	630.76	632.35
742	629.72	630.76	632.22
743	629.72	630.76	632.10
744	629.72	630.76	631.97
745	629.72	630.76	631.84
746	629.72	630.76	631.71
747	629.72	630.76	631.59
748	629.72	630.76	631.46
749	629.72	630.76	631.33
750	629.72	630.76	631.20
751	629.72	630.76	631.08
752	629.72	630.76	630.95
753	629.72	630.76	630.82
754	629.72	630.76	630.69
755	629.72	630.76	630.57
756	629.72	630.76	630.44
757	629.72	630.76	630.31
758	629.72	630.76	630.18
759	629.72	630.76	630.06
760	629.72	630.76	629.95
761	629.72	630.76	629.82
762	629.72	630.76	629.69
763	629.72	630.76	629.57
764	629.72	630.76	629.44
765	629.72	630.76	629.31
766	629.72	630.76	629.18
767	629.72	630.76	629.06
768	629.72	630.76	628.95
769	629.72	630.76	628.82
770	629.72	630.76	628.70
771	629.72	630.76	628.57
772	629.72	630.76	628.44
773	629.72	630.76	628.31
774	629.72	630.76	628.18
775	629.72	630.76	628.06
776	629.72	630.76	627.93
777	629.72	630.76	627.80
900	629.72	630.76	611.81

AS BUILT PLANS PJ I-II-88

TEXAS TURNPIKE AUTHORITY
DALLAS NORTH TOLLWAY
 PAVING AND GRADING
 TOLLWAY
 STA. 735+00 TO STA. 749+00

HNTB
 HOWARD NEEDLES TAMMEN & BERGENDOFF

SECTION VII

DRAWN *RJM* DATE 5-7-85 DESIGNED *GAL* DATE 5-85
 CHECKED *MLM* DATE 10-11-85 SCALE 1"=50' H, 1"=5' V

CONTRACT NO. DNT-115 SHEET R24A OF