


MATCH LINE C SEE SHEET R 43

MATCH LINE D SEE SHEET R 43

MATCH LINE B SEE SHEET R 41

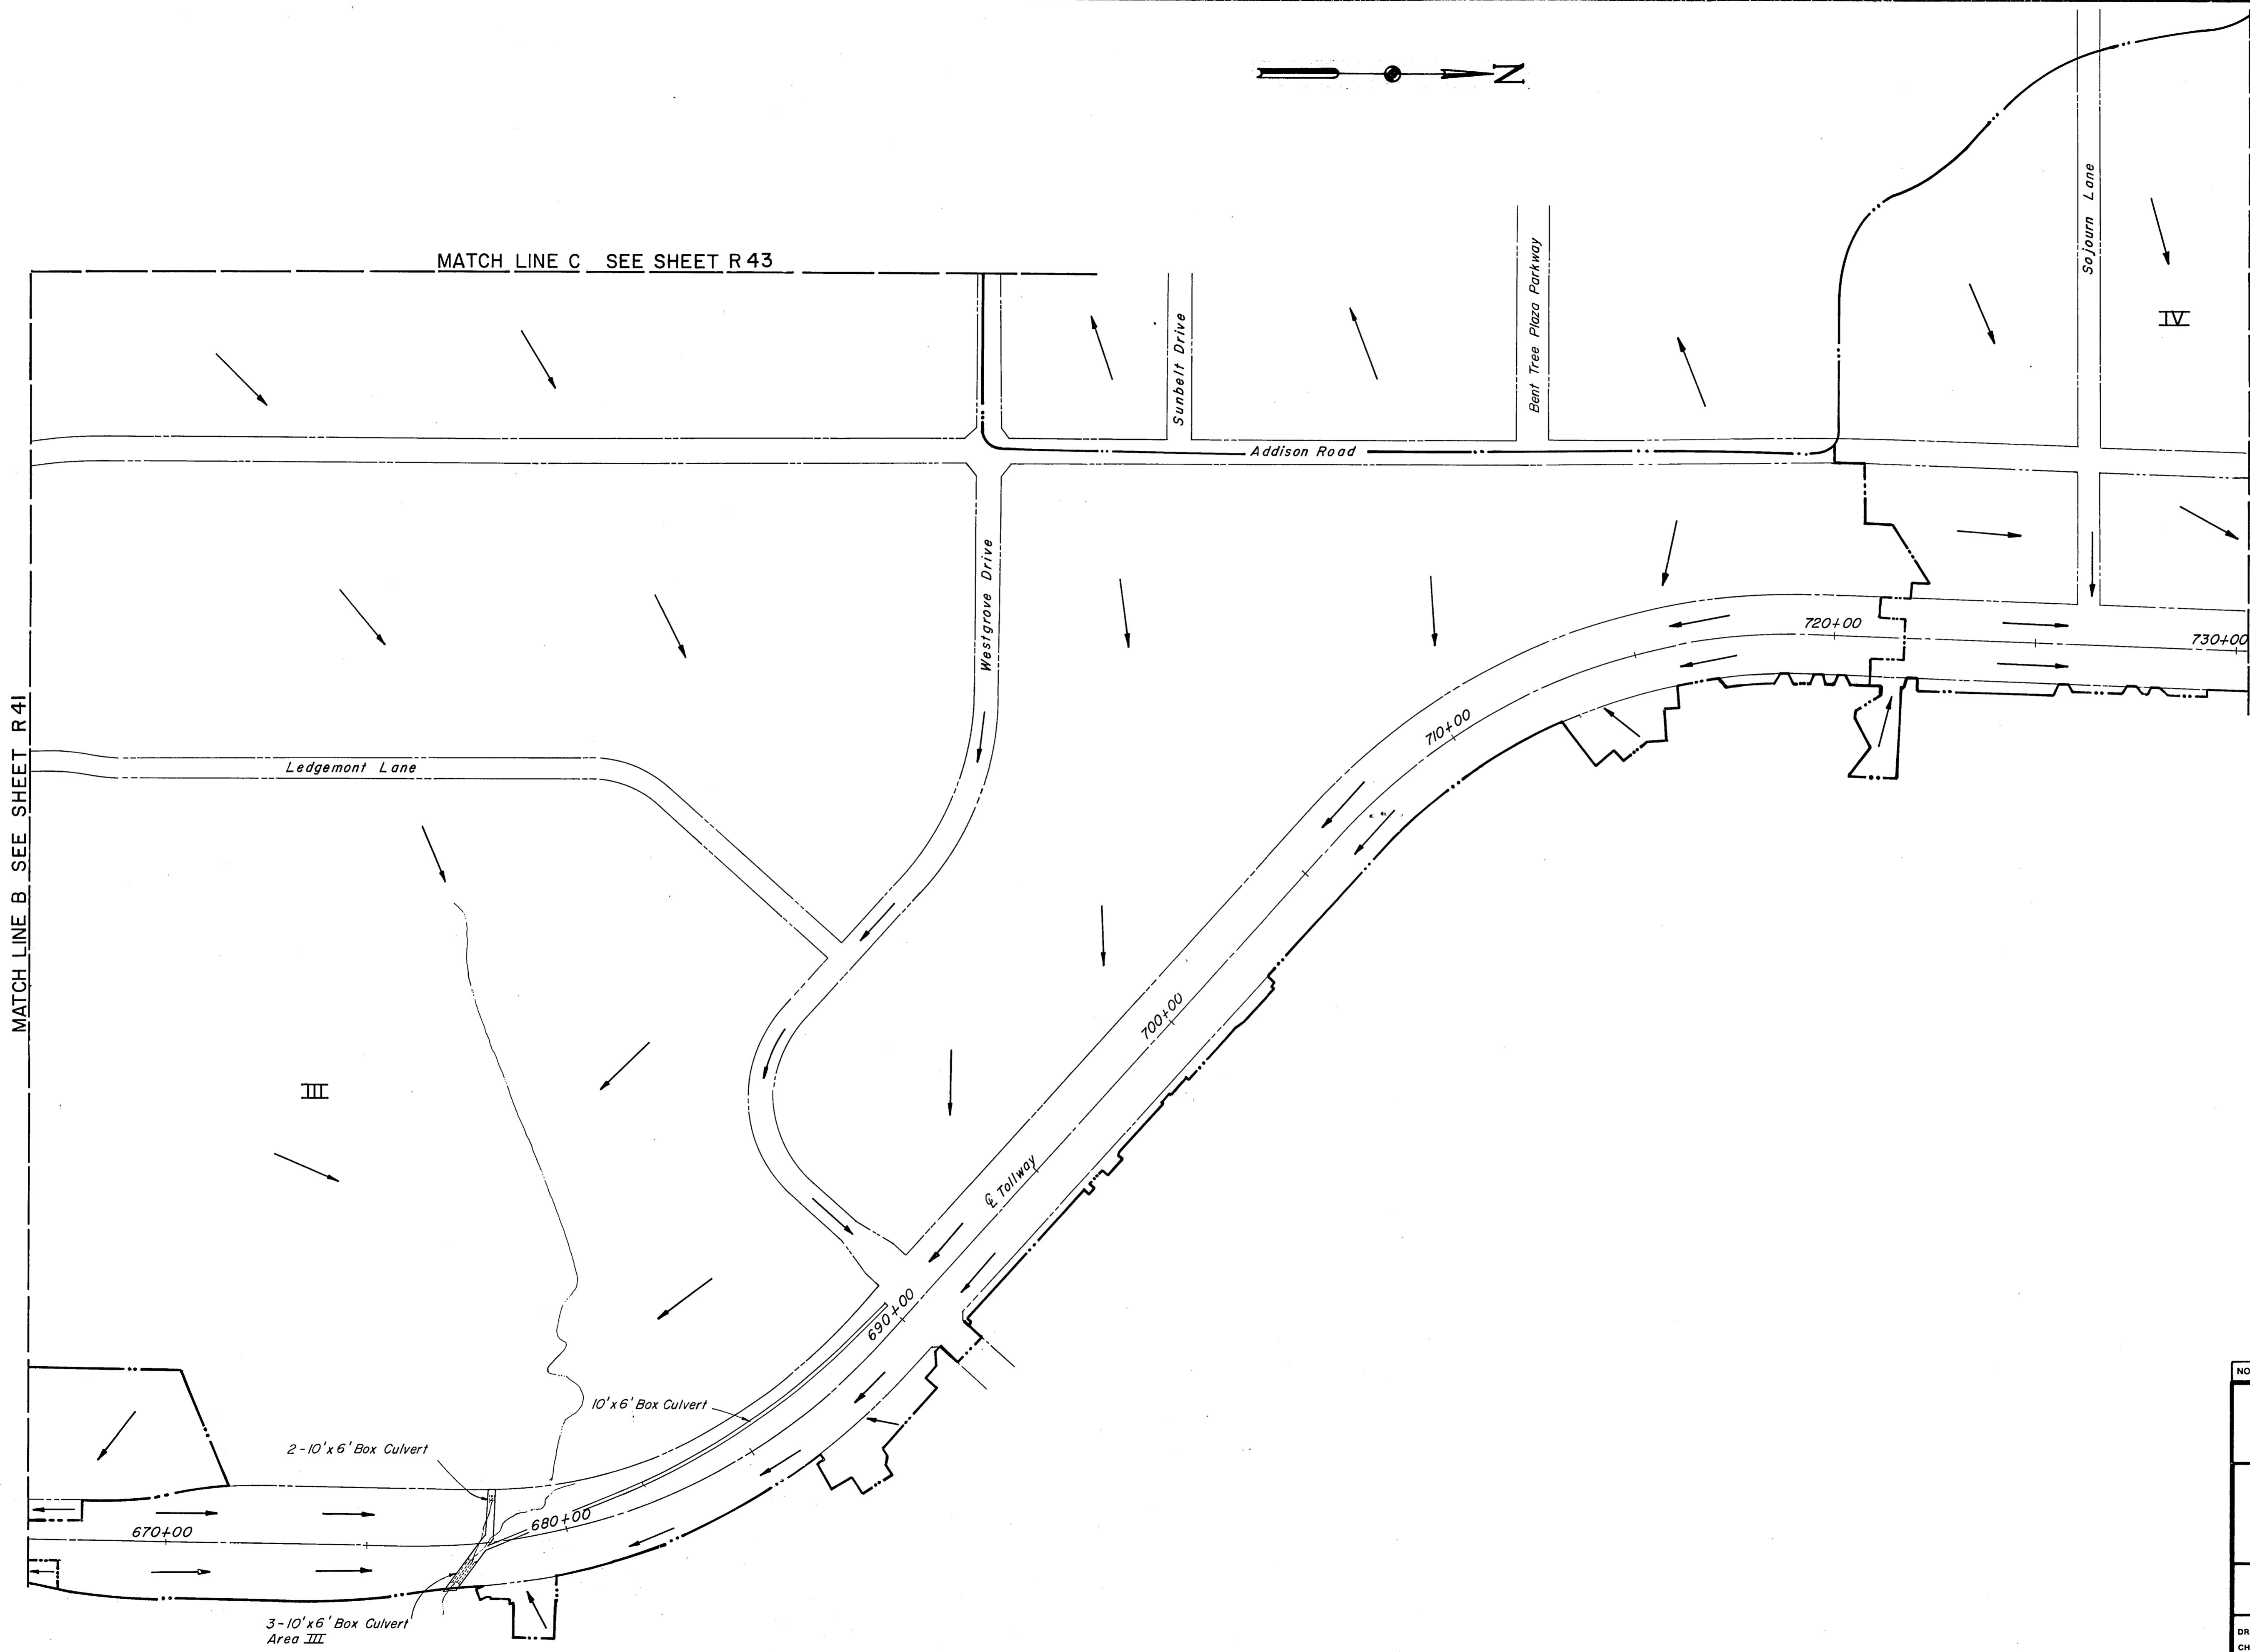

ASBUILT PLANS

NO.	REVISION	BY	DATE

TEXAS TURNPIKE AUTHORITY
DALLAS NORTH TOLLWAY

DRAINAGE AREA MAP

Gibbs & Hill, Inc.
ENGINEERS DESIGNERS CONSTRUCTORS
DALLAS

SECTION VII

DRAWN <i>CJB/VER</i>	DATE <i>5/9/83</i>	DESIGNED <i>KJ</i>	DATE <i>4/15/83</i>
CHECKED <i>DWC</i>	DATE <i>5/8/84</i>	SCALE <i>1" = 200'</i>	

CONTRACT NO. **DNT-115** SHEET **R 42** OF **R85**