


LINE "B-1"

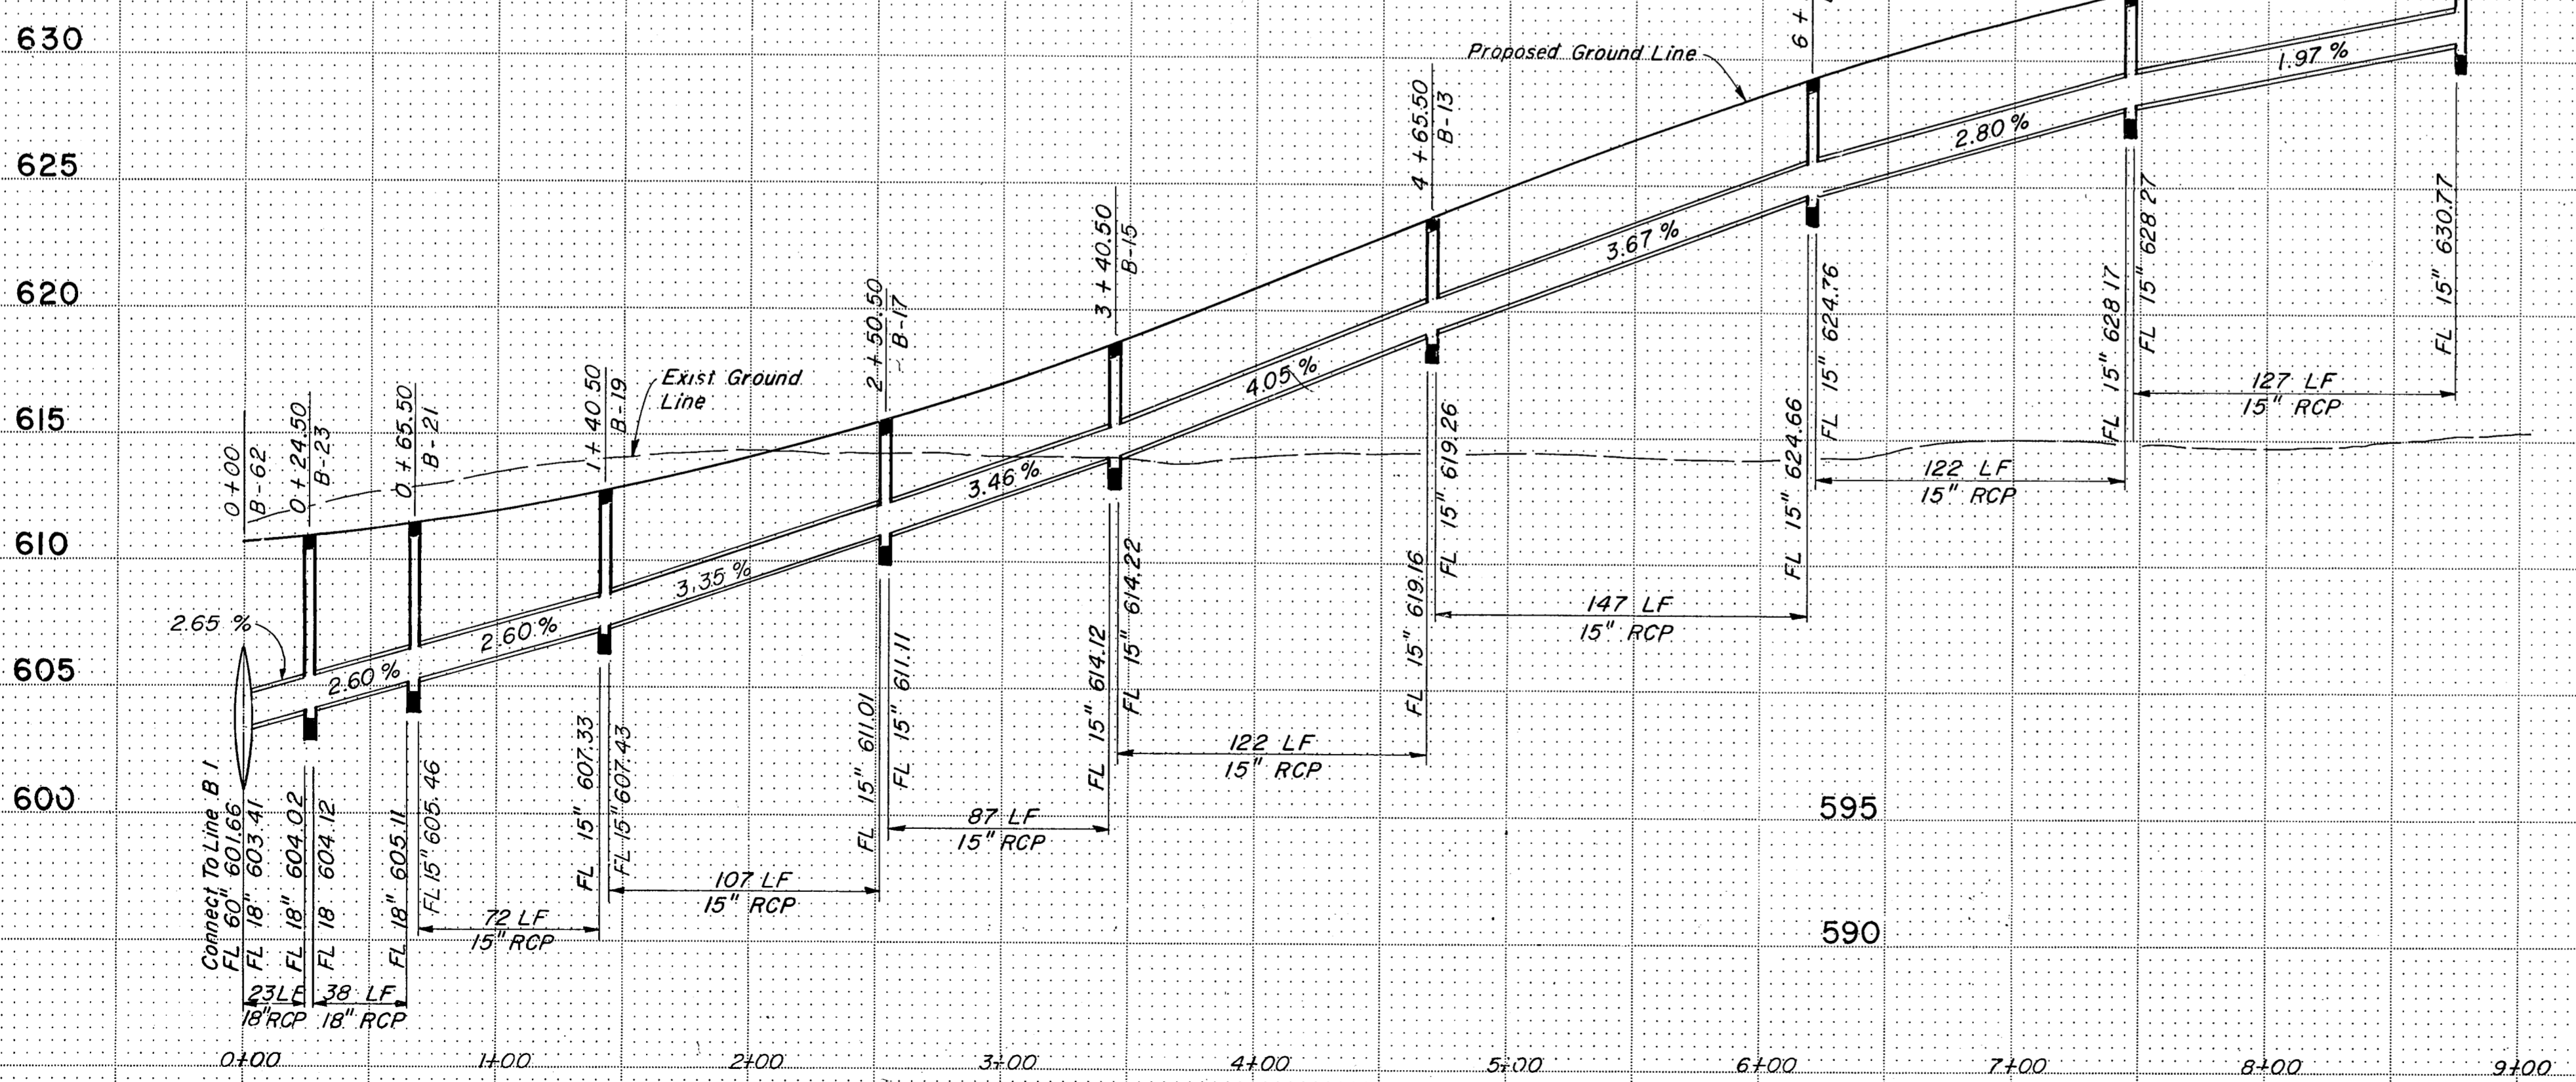

LINE "B-1-3"

LATERAL "B-43"

LATERAL "B-35"

LATERAL "B-33"

LATERAL "B-55"

LATERAL "B-29"

LATERAL "B-27"

LATERAL "B-25"

NOTES:  
1. Refer to Sheet R74 for depth of stabilized backfill.

STORM SEWER LINE: "B-1", "B-1-3"  
LATERAL: "B-25", "B-27", "B-29",  
"B-33", "B-35", "B-43",  
"B-55",

**ASBUILT PLANS**

NO.	REVISION	BY	DATE
TEXAS TURNPIKE AUTHORITY DALLAS NORTH TOLLWAY			
STORM SEWER PROFILES			
<b>Gibbs &amp; Hill, Inc.</b>			
MADE	DEL	DATE	TRACED
4/78	4/78	4/78	4/78
CHECKED	REW	DATE	SCALE
4/84	4/84	4/84	1"=50'H 1"=5' V
CONTRACT NO. DNT-115 SHEET R51 OF R85			