




LINE "B-2-4"

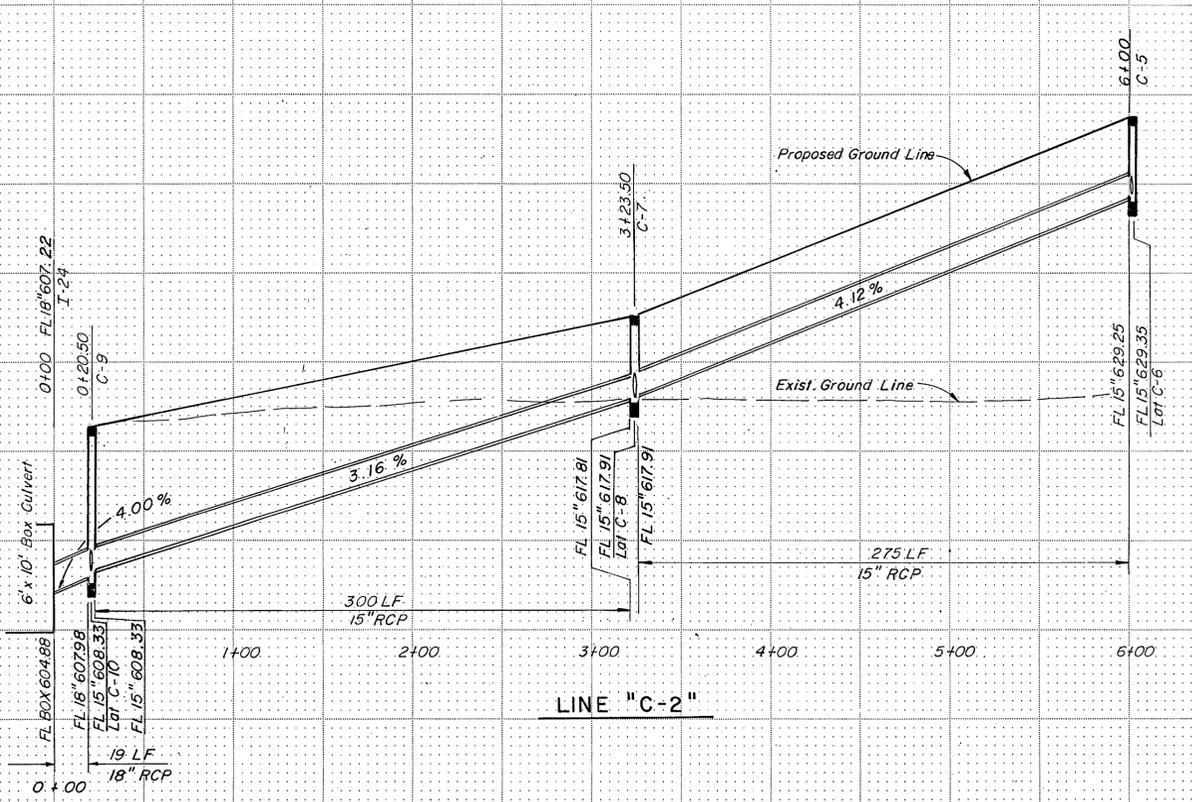


LINE "C-2"

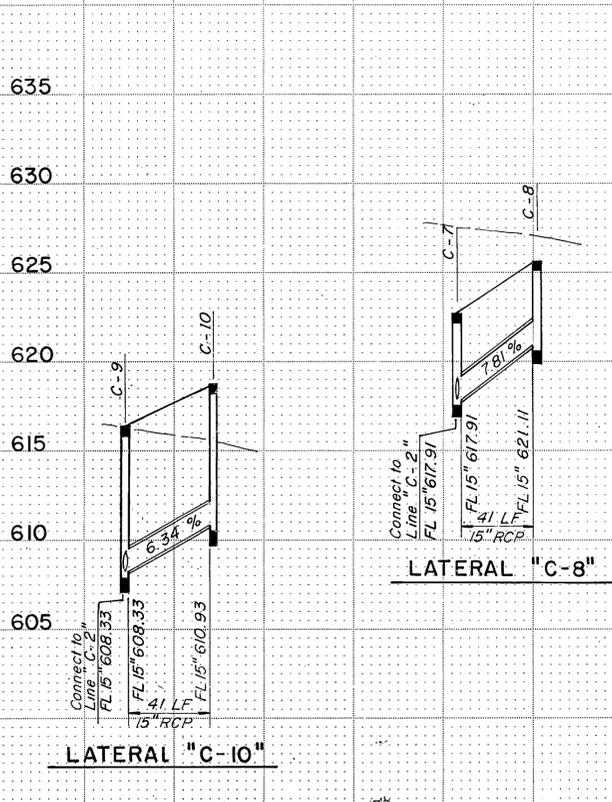

LATERAL "C-10"

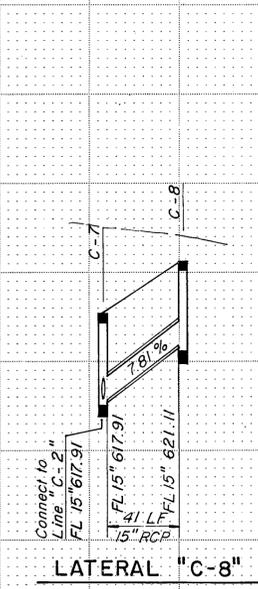

LATERAL "C-8"

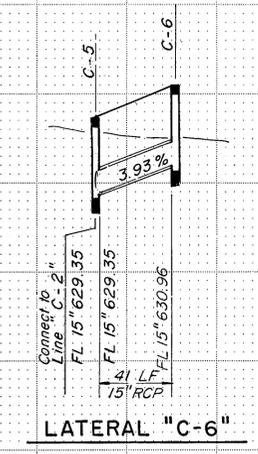

LATERAL "C-6"

STORM SEWER LINE: "B-2-4", "C-2"
LATERAL: "C-6", "C-8", "C-10"

ASBUILT PLANS

NO.	REVISION	BY	DATE
TEXAS TURNPIKE AUTHORITY DALLAS NORTH TOLLWAY			
STORM SEWER PROFILES			
Gibbs & Hill, Inc.			
MADE	AELT	DATE	12/83
CHECKED	REW	DATE	4/84
SCALE		1"=50'H 1"=5'V	
CONTRACT NO. DNT-115 SHEET R53 OF R85			