


LINE "C"

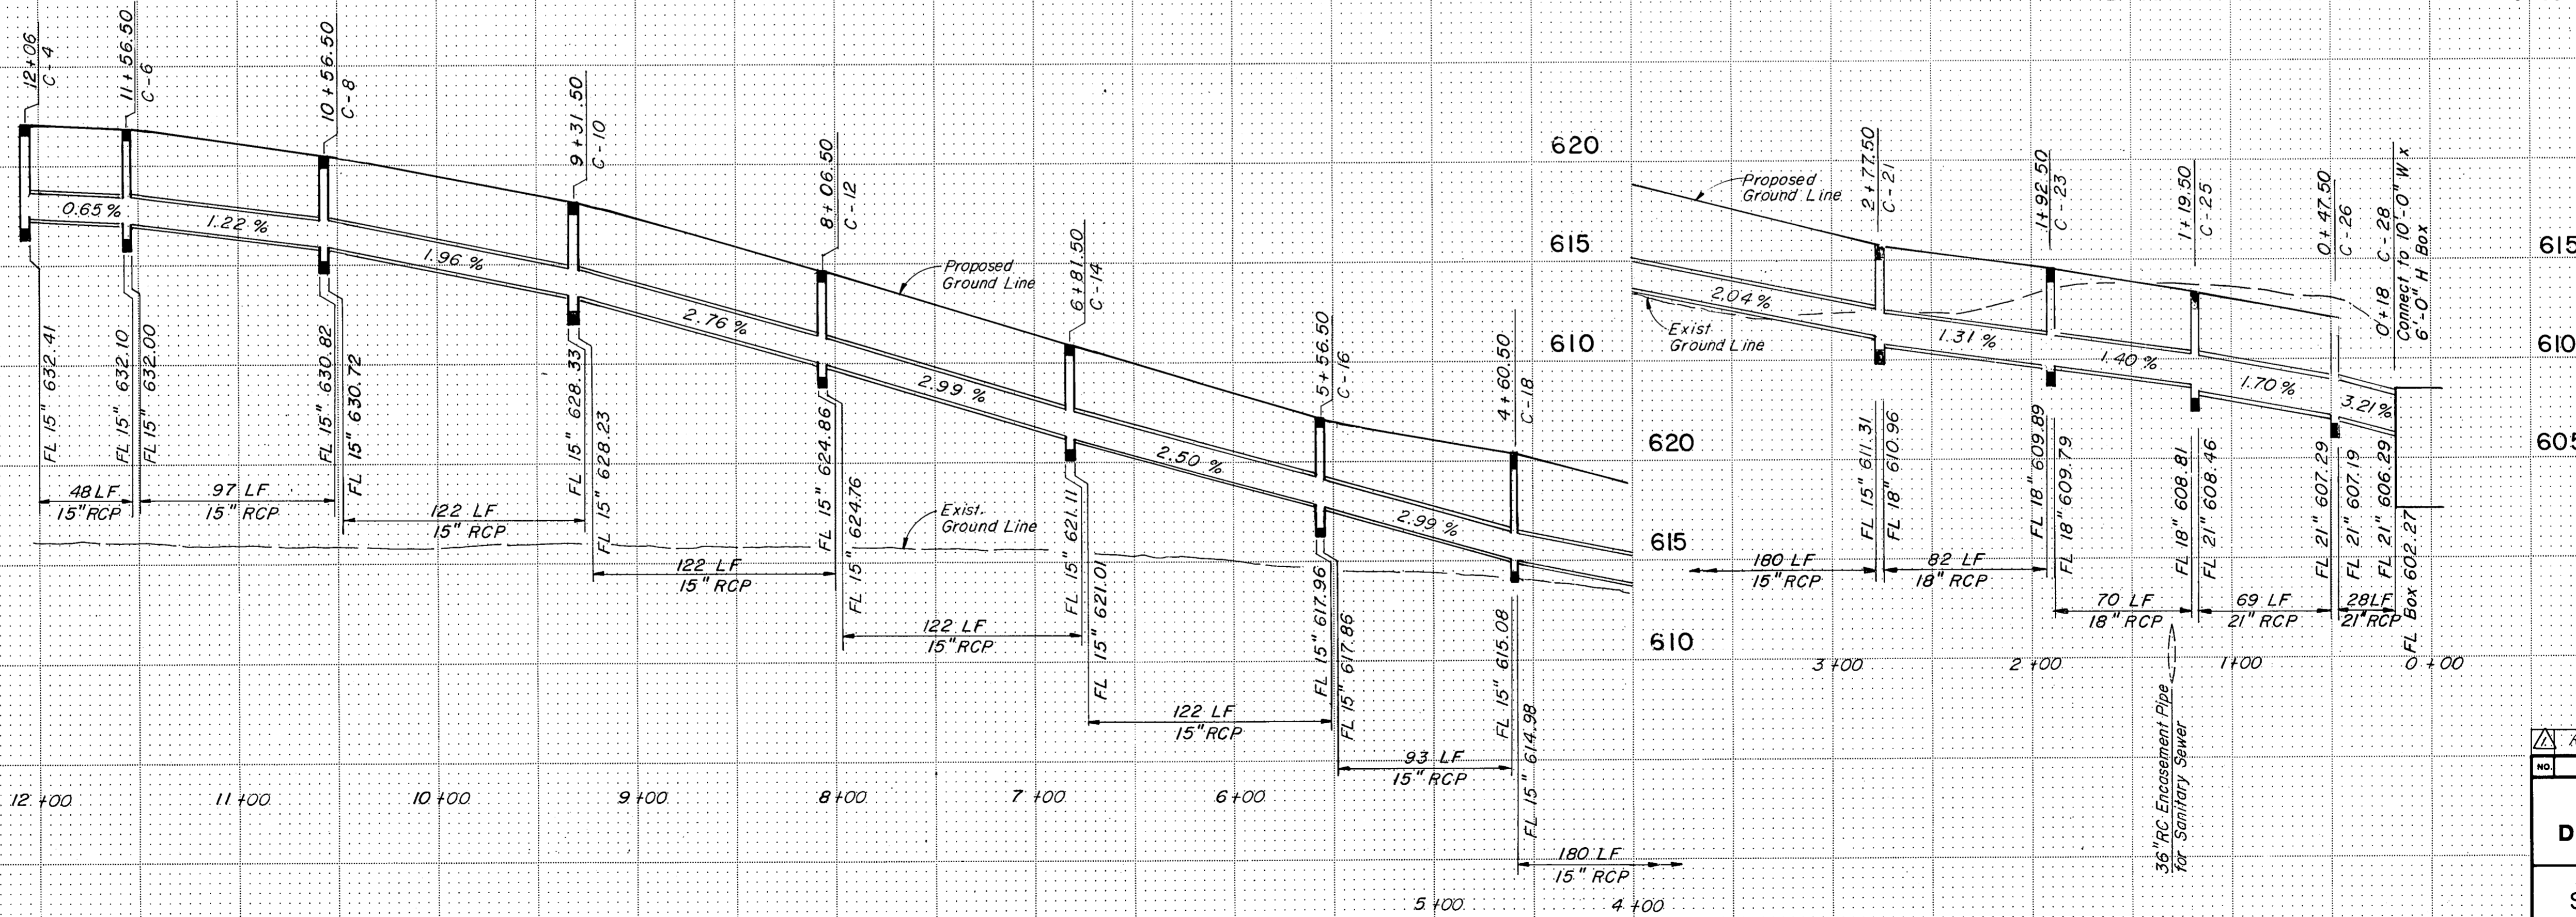

LINE "C-1"

STORM SEWER LINES: "C", "C-1"  
LATERAL: "C-17A"

**ASBUILT PLANS**

Revise Line "C", Add Lat. C-17A. 6/29/78

NO. REVISION BY DATE

TEXAS TURNPIKE AUTHORITY  
DALLAS NORTH TOLLWAY

STORM SEWER PROFILES

**Gibbs & Hill, Inc.**

MADE AELT DATE 4/84 TRACED MAV DATE 4/84  
CHECKED REW DATE 4/84 SCALE 1"=50'H 1"=5'V

CONTRACT NO. DNT-115 SHEET R55 OF R85