
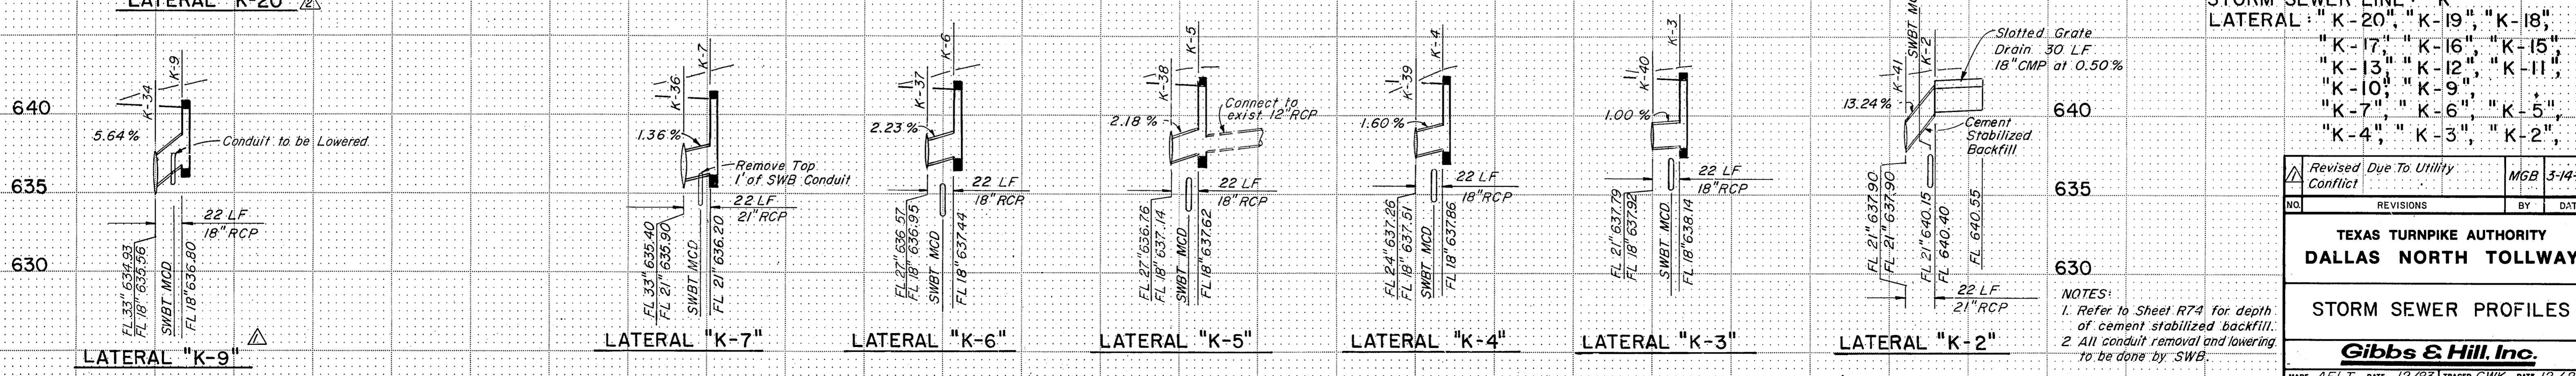


LINE "K"

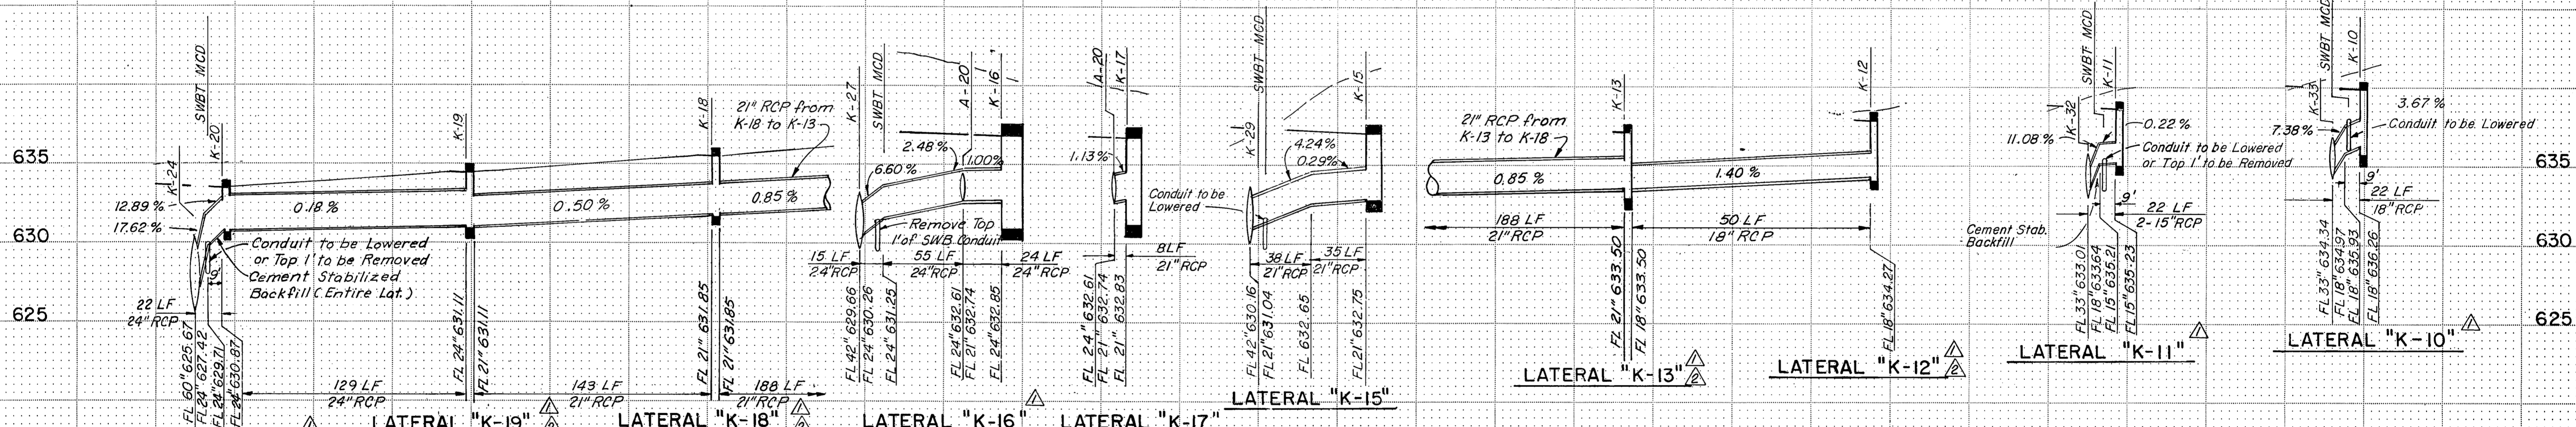

STORM SEWER LINE: "K"
LATERAL: "K-20", "K-19", "K-18",
"K-17", "K-16", "K-15",
"K-13", "K-12", "K-11",
"K-10", "K-9", "K-5",
"K-4", "K-3", "K-2",

Revised Due To Utility Conflict		MGB	3-14-85
NO.	REVISIONS	BY	DATE

TEXAS TURNPIKE AUTHORITY
DALLAS NORTH TOLLWAY

STORM SEWER PROFILES

Gibbs & Hill, Inc.

ASBUILT PLANS

MADE AELT DATE 12/83 TRACED GWK DATE 12/83
CHECKED REW DATE 4/84 SCALE 1"=50'H 1"=5'V

CONTRACT NO. DNT-115 SHEET R60 OF R85

As Built

C.B.