



640
635
630
625
620

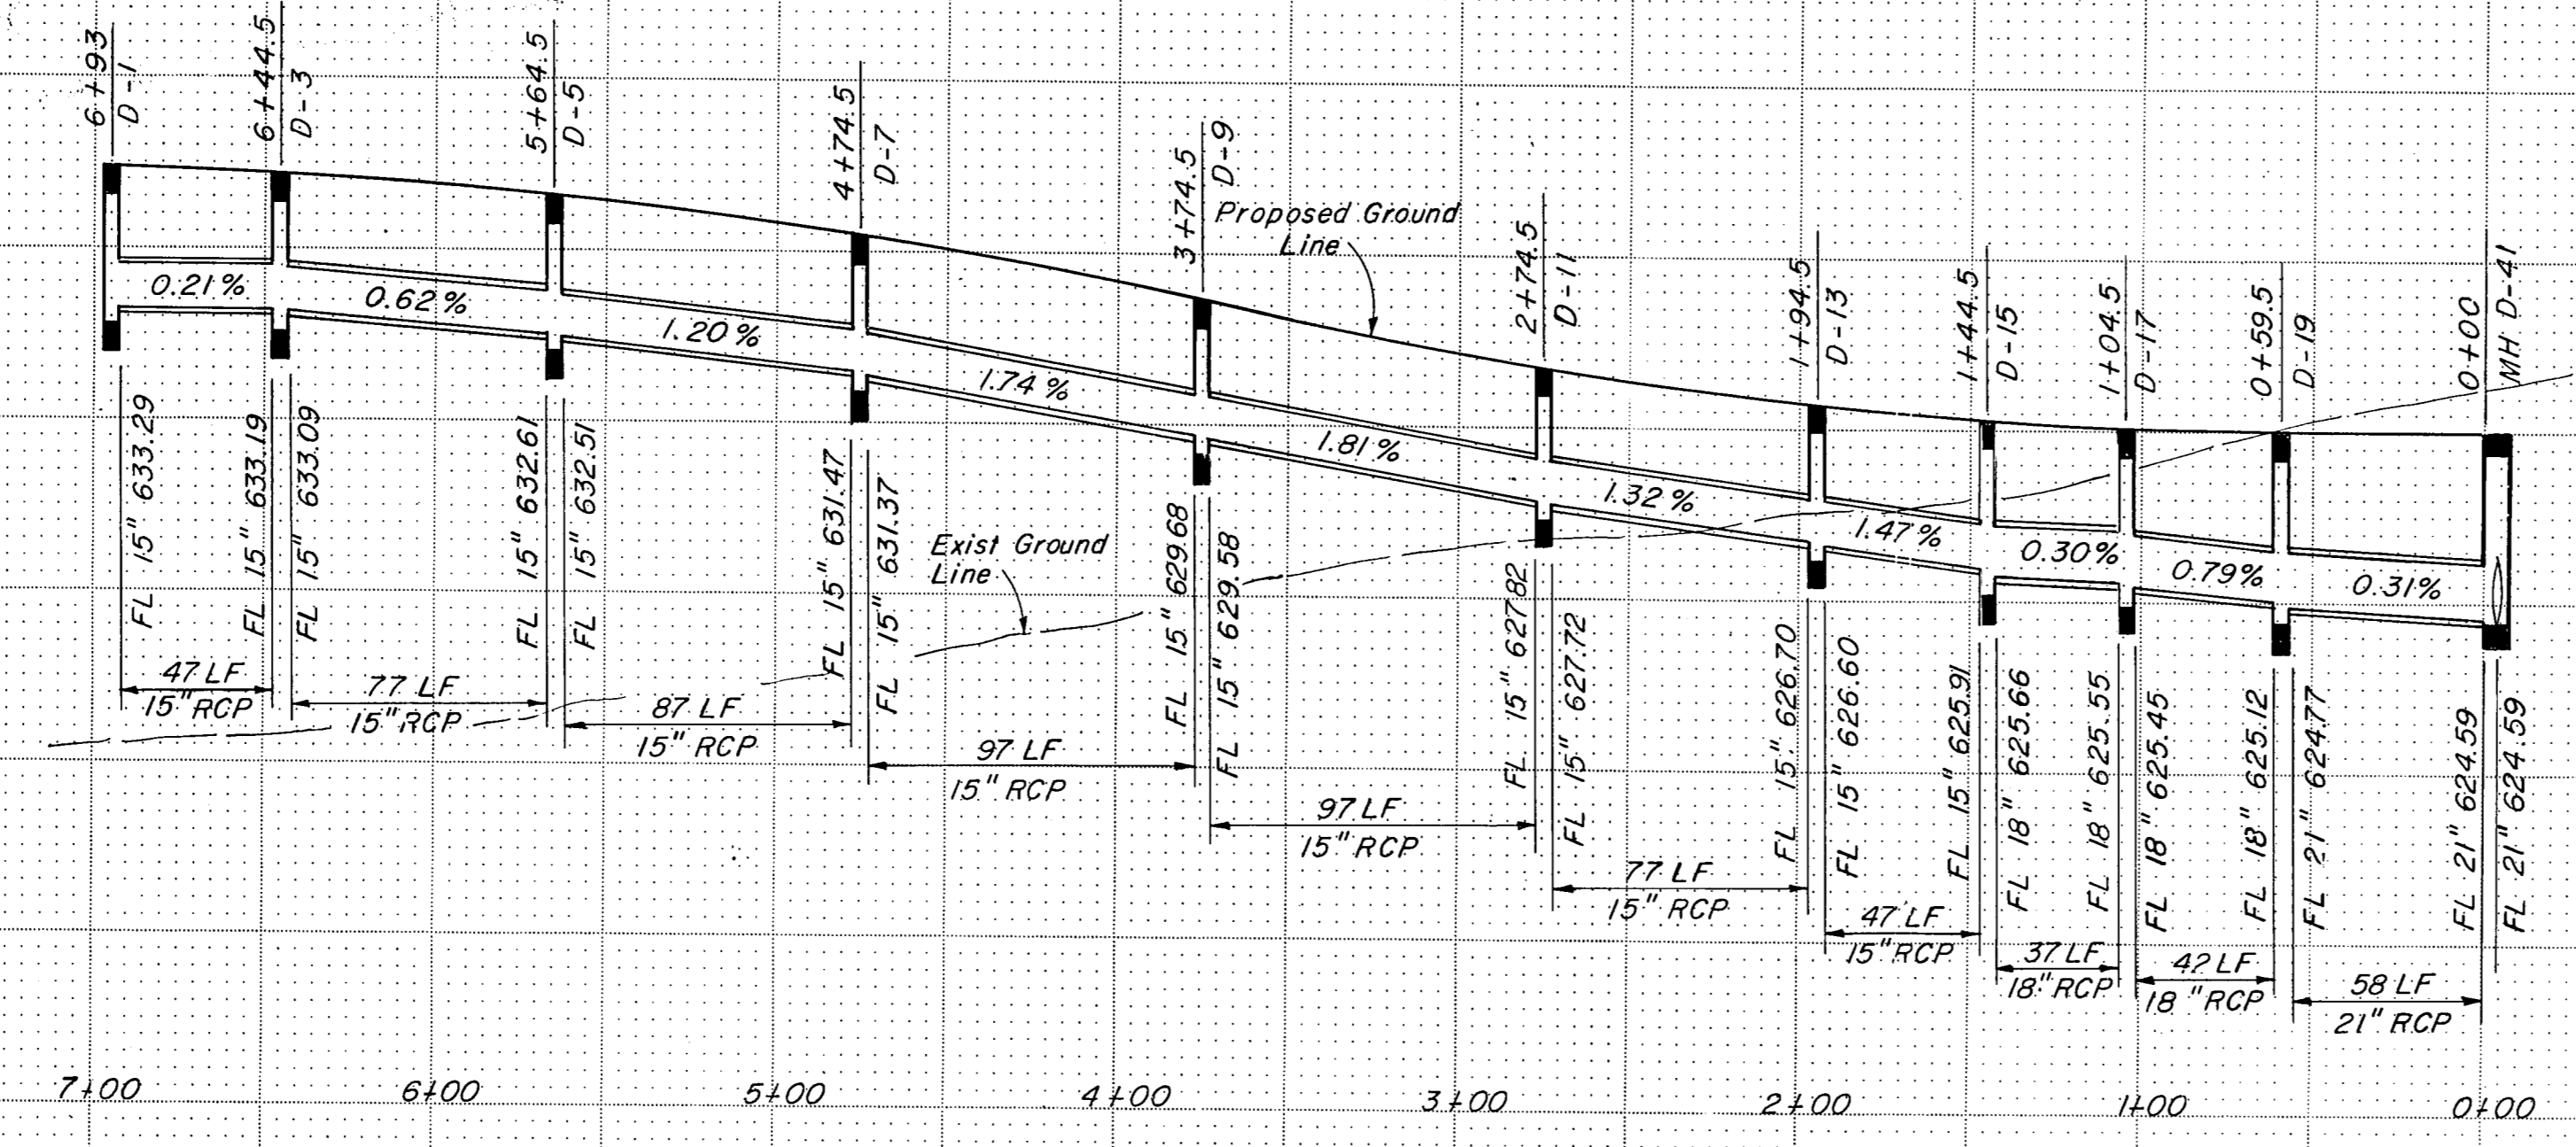

635
630
625
620

LINE "D-1"

640
635
630
625
620

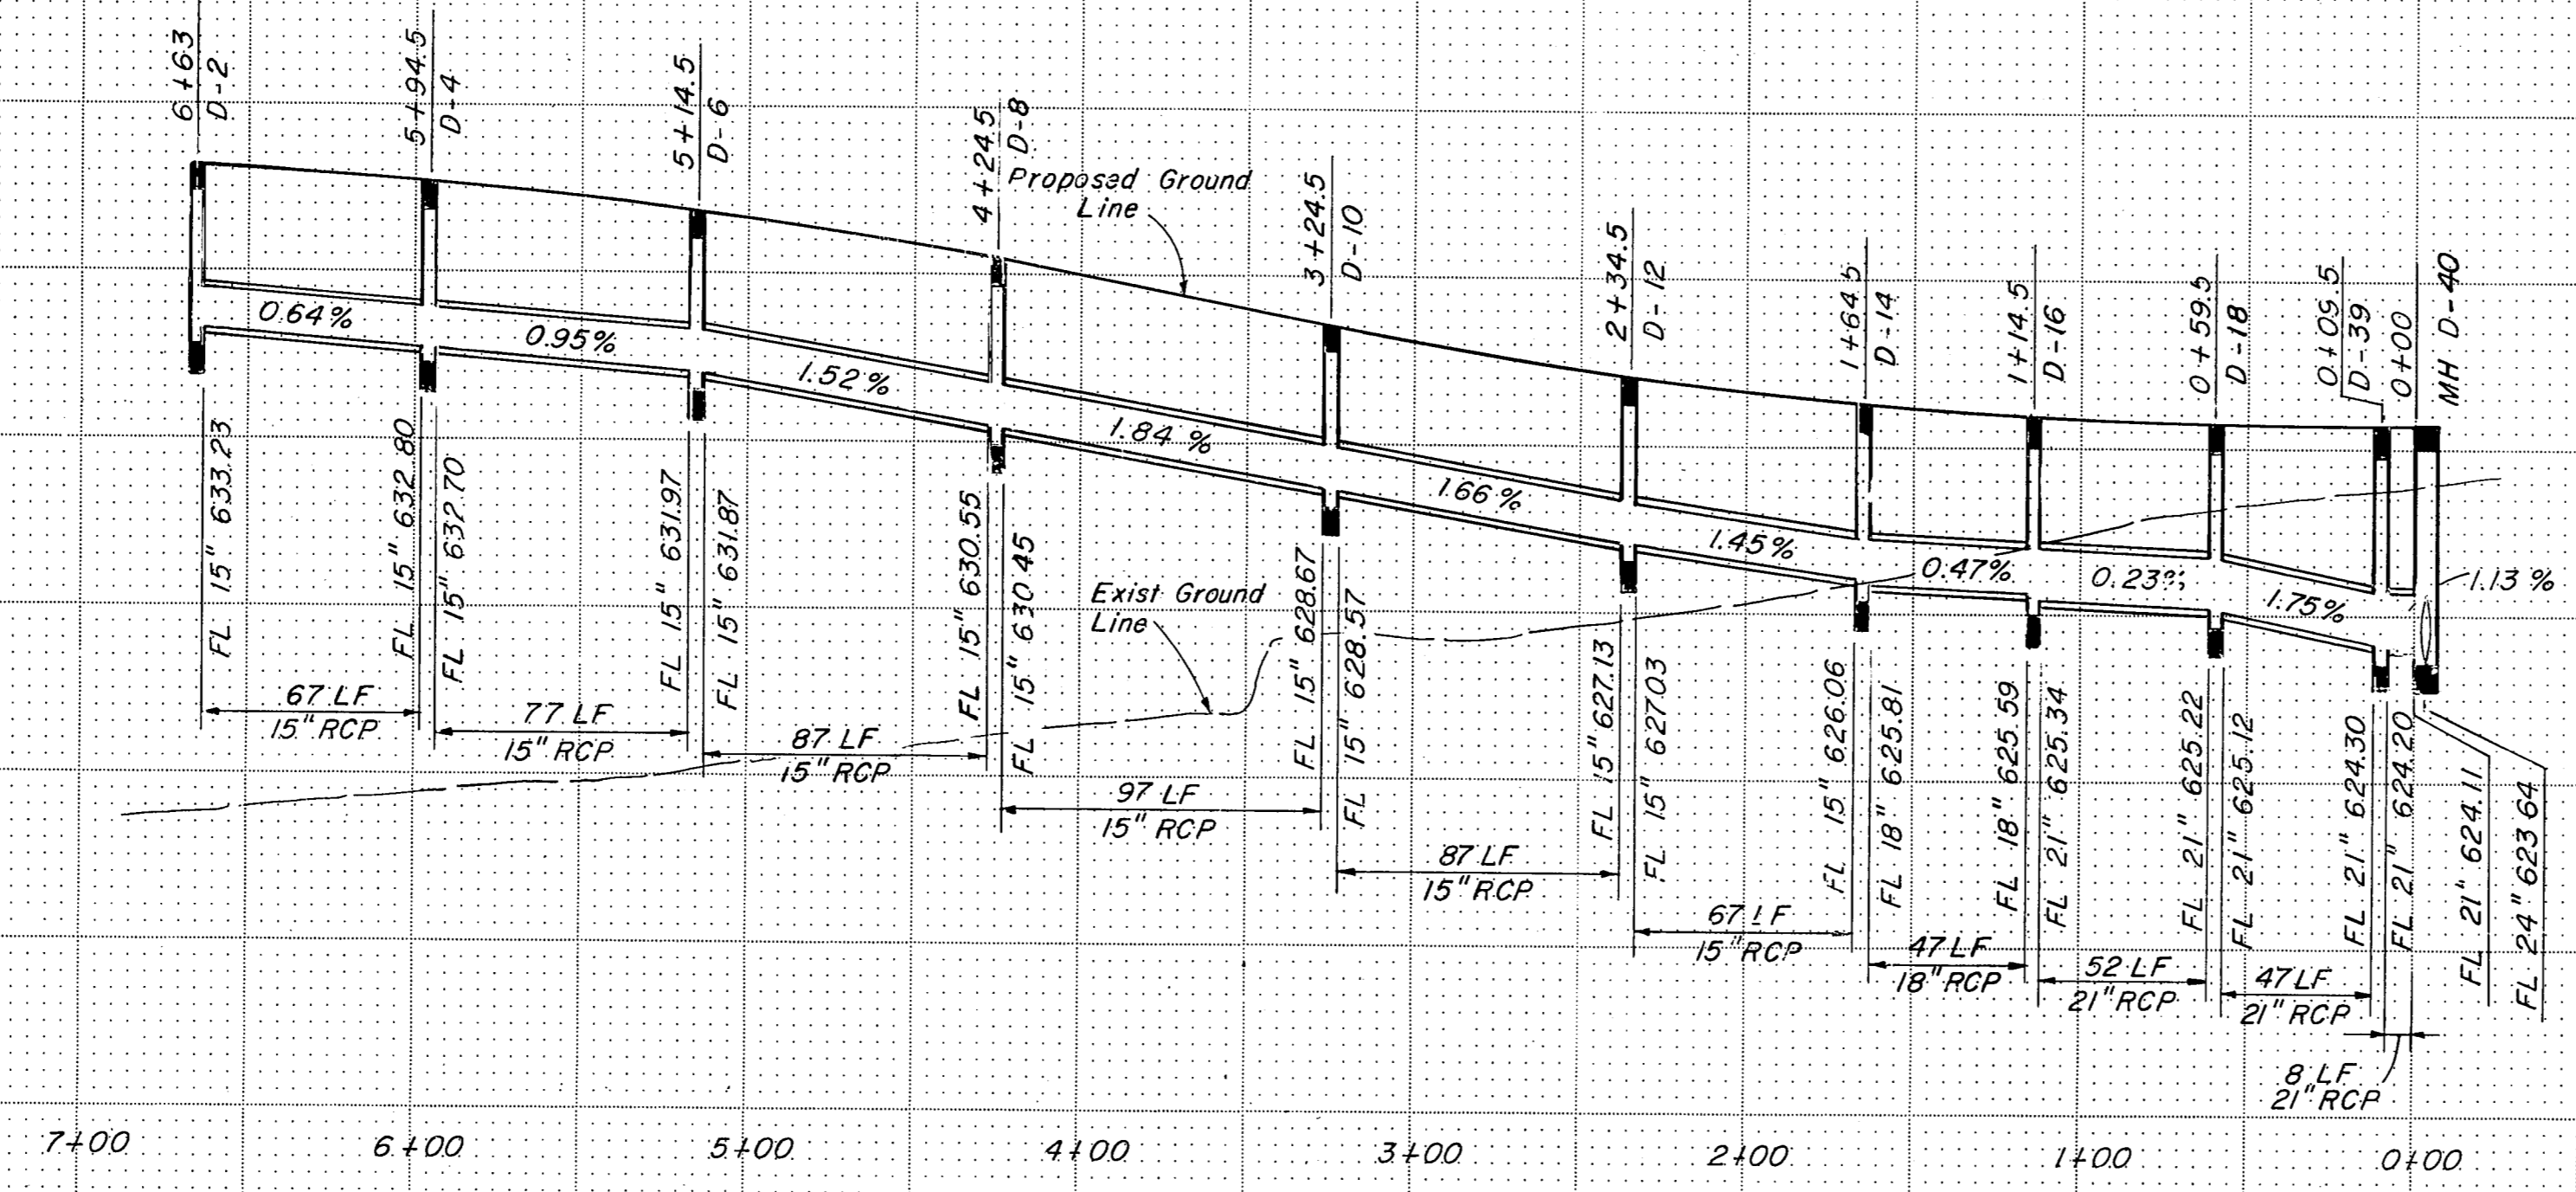

635
630
625
620

LINE "D-2"

STORM SEWER LINE: "D-1", "D-2"

ASBUILT PLANS

NO.	REVISION	BY	DATE
TEXAS TURNPIKE AUTHORITY DALLAS NORTH TOLLWAY			
STORM SEWER PROFILES			
Gibbs & Hill, Inc.			
MADE	DATE 4/84	TRACED	DATE 4/84
CHECKED	DATE 4/84	SCALE	1"=50'H 1"=5'V
CONTRACT NO. DNT-115 SHEET R61 OF R85			