



LINE "D-3"

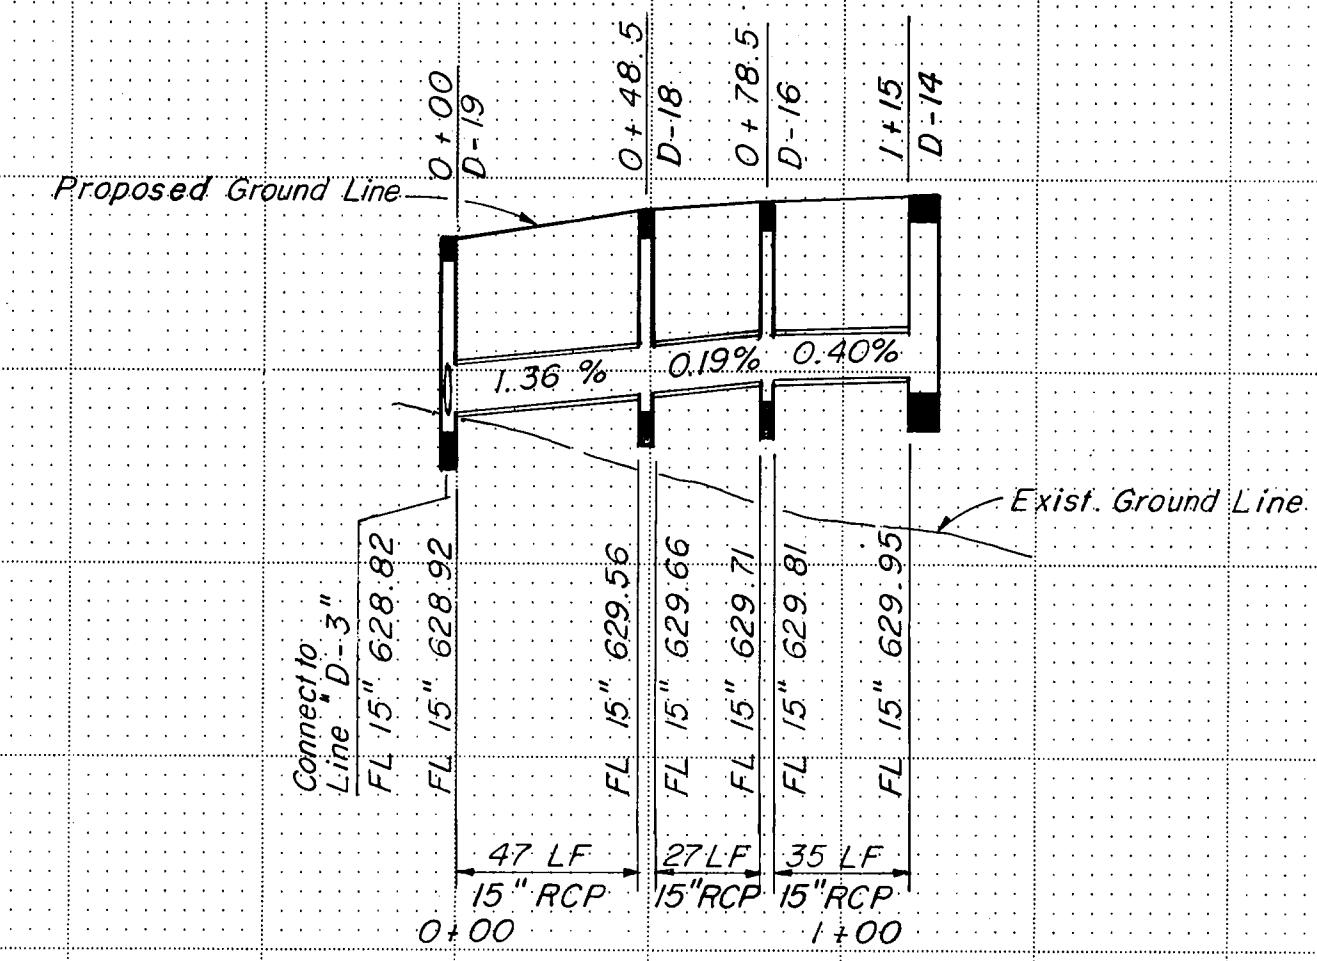

LATERAL "D-3"

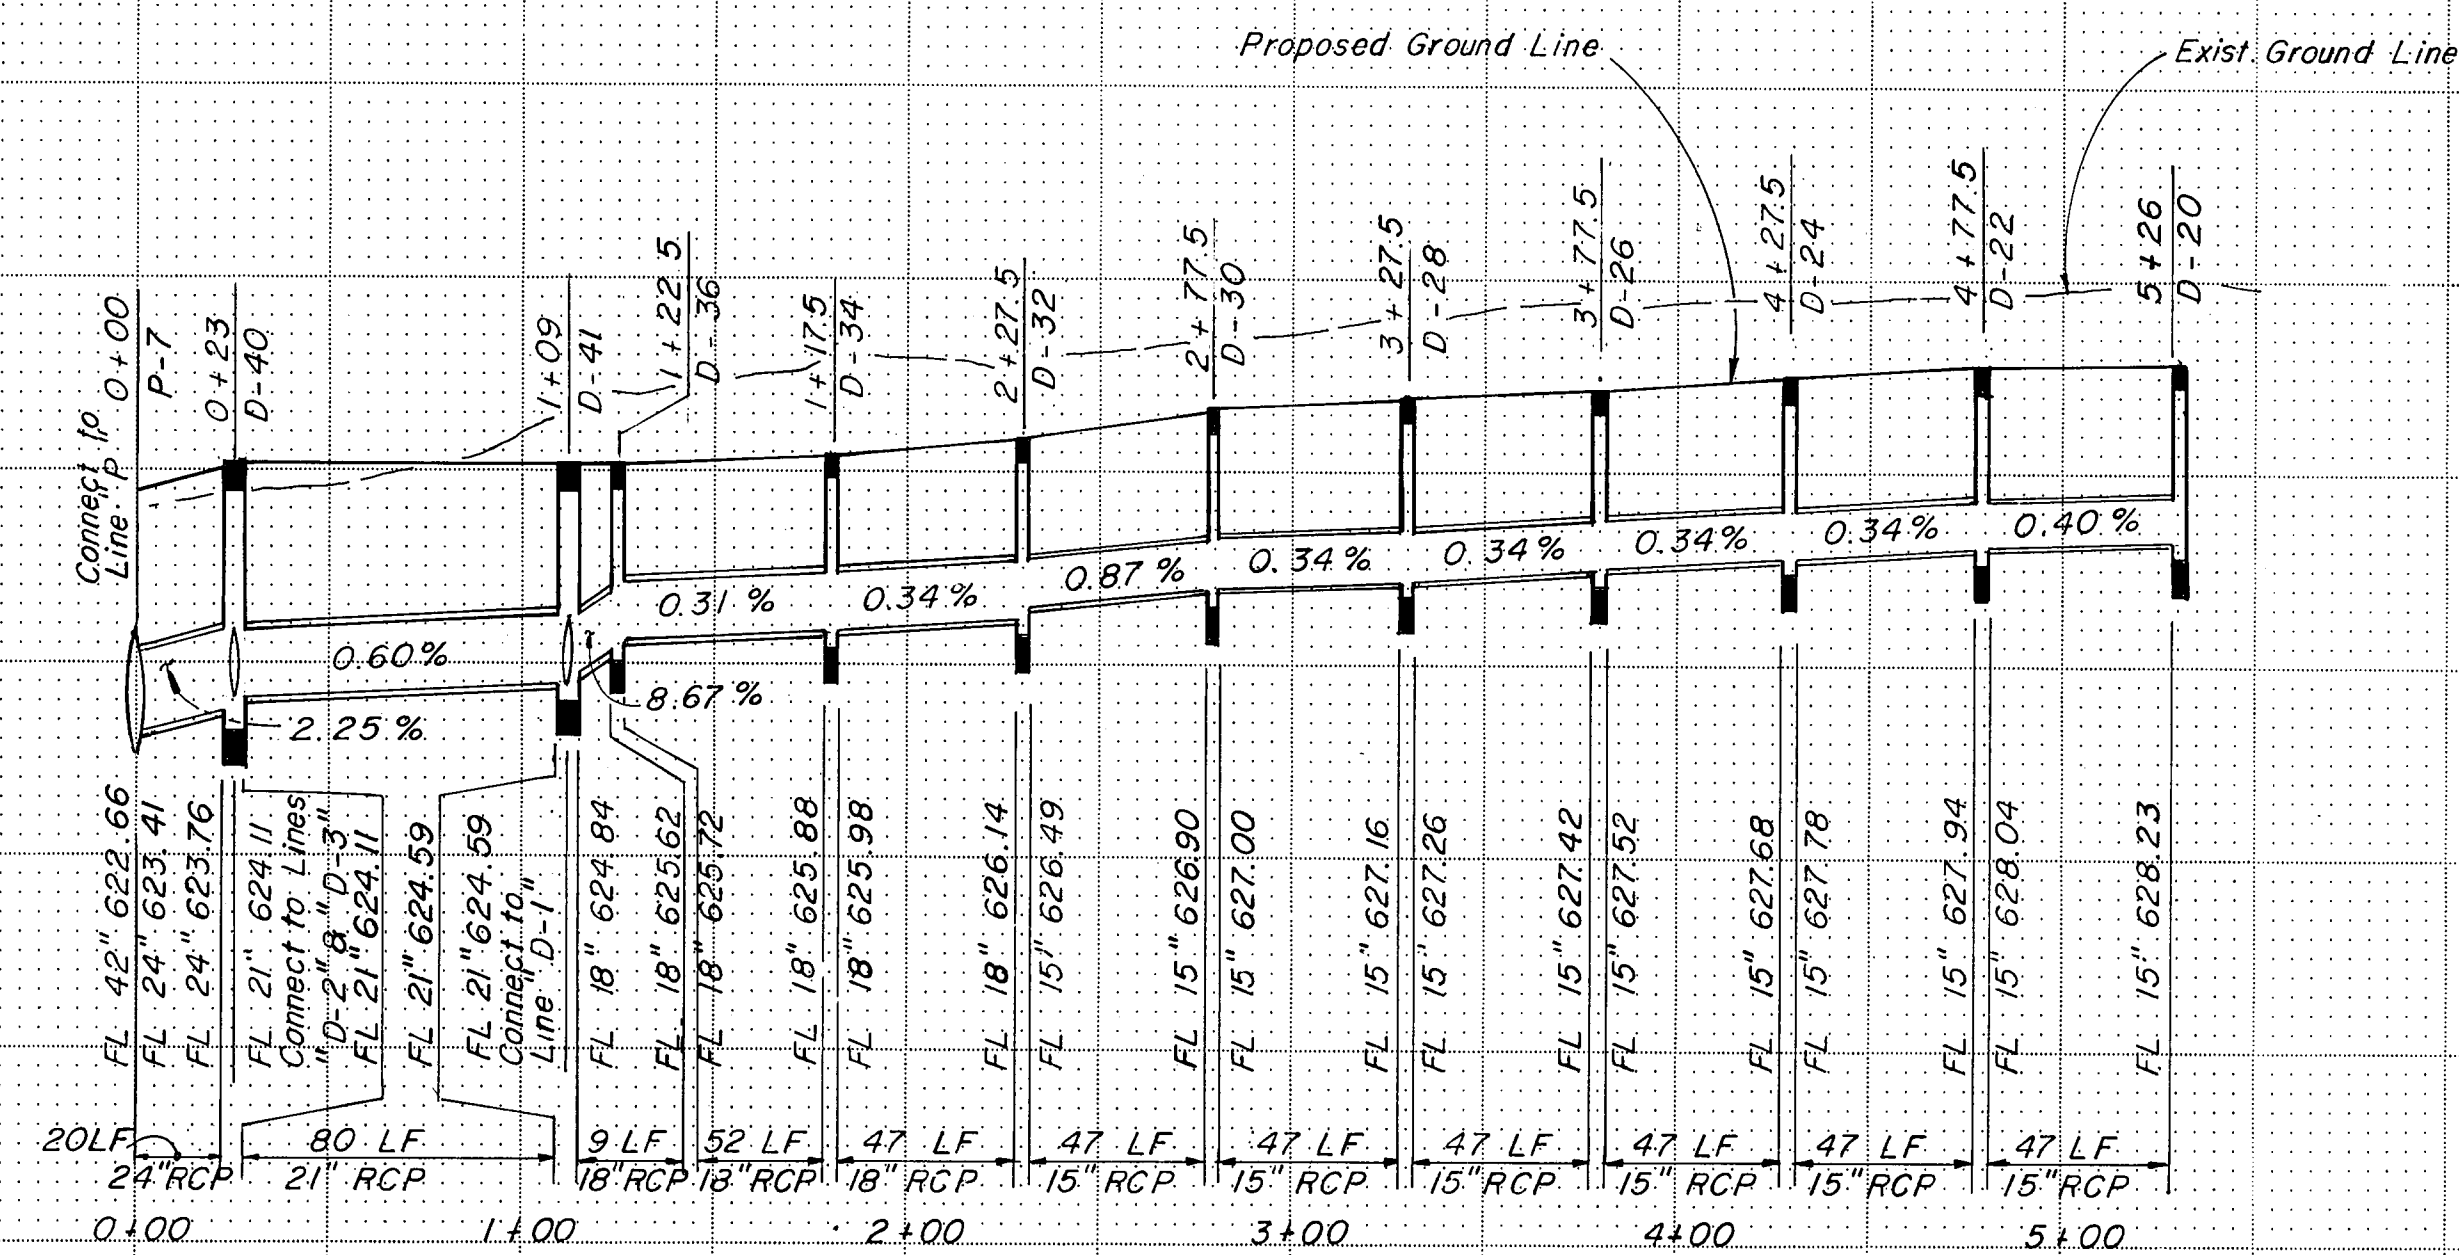

LINE "D-4"

STORM SEWER LINE: "D-3", "D-4"  
LATERAL: "D-3"

ASBUILT PLANS

NO.	REVISION	BY	DATE
TEXAS TURNPIKE AUTHORITY DALLAS NORTH TOLLWAY			
STORM SEWER PROFILES			
<b>Gibbs &amp; Hill, Inc.</b>			
MADE	AELT	DATE	4/84
CHECKED	REW	DATE	4/84
TRACED	MAV	DATE	4/84
		SCALE	1"=50'H 1"=5'V
CONTRACT NO. DNT-115 SHEET R63 OF R85			