


PLAN
SCALE: 1" = 20'

NOTES: 1. Contractor shall use extreme caution when excavating for proposed box culvert because of close proximity of existing 24" water line.
2. See Sheet R71 for wingwall details.

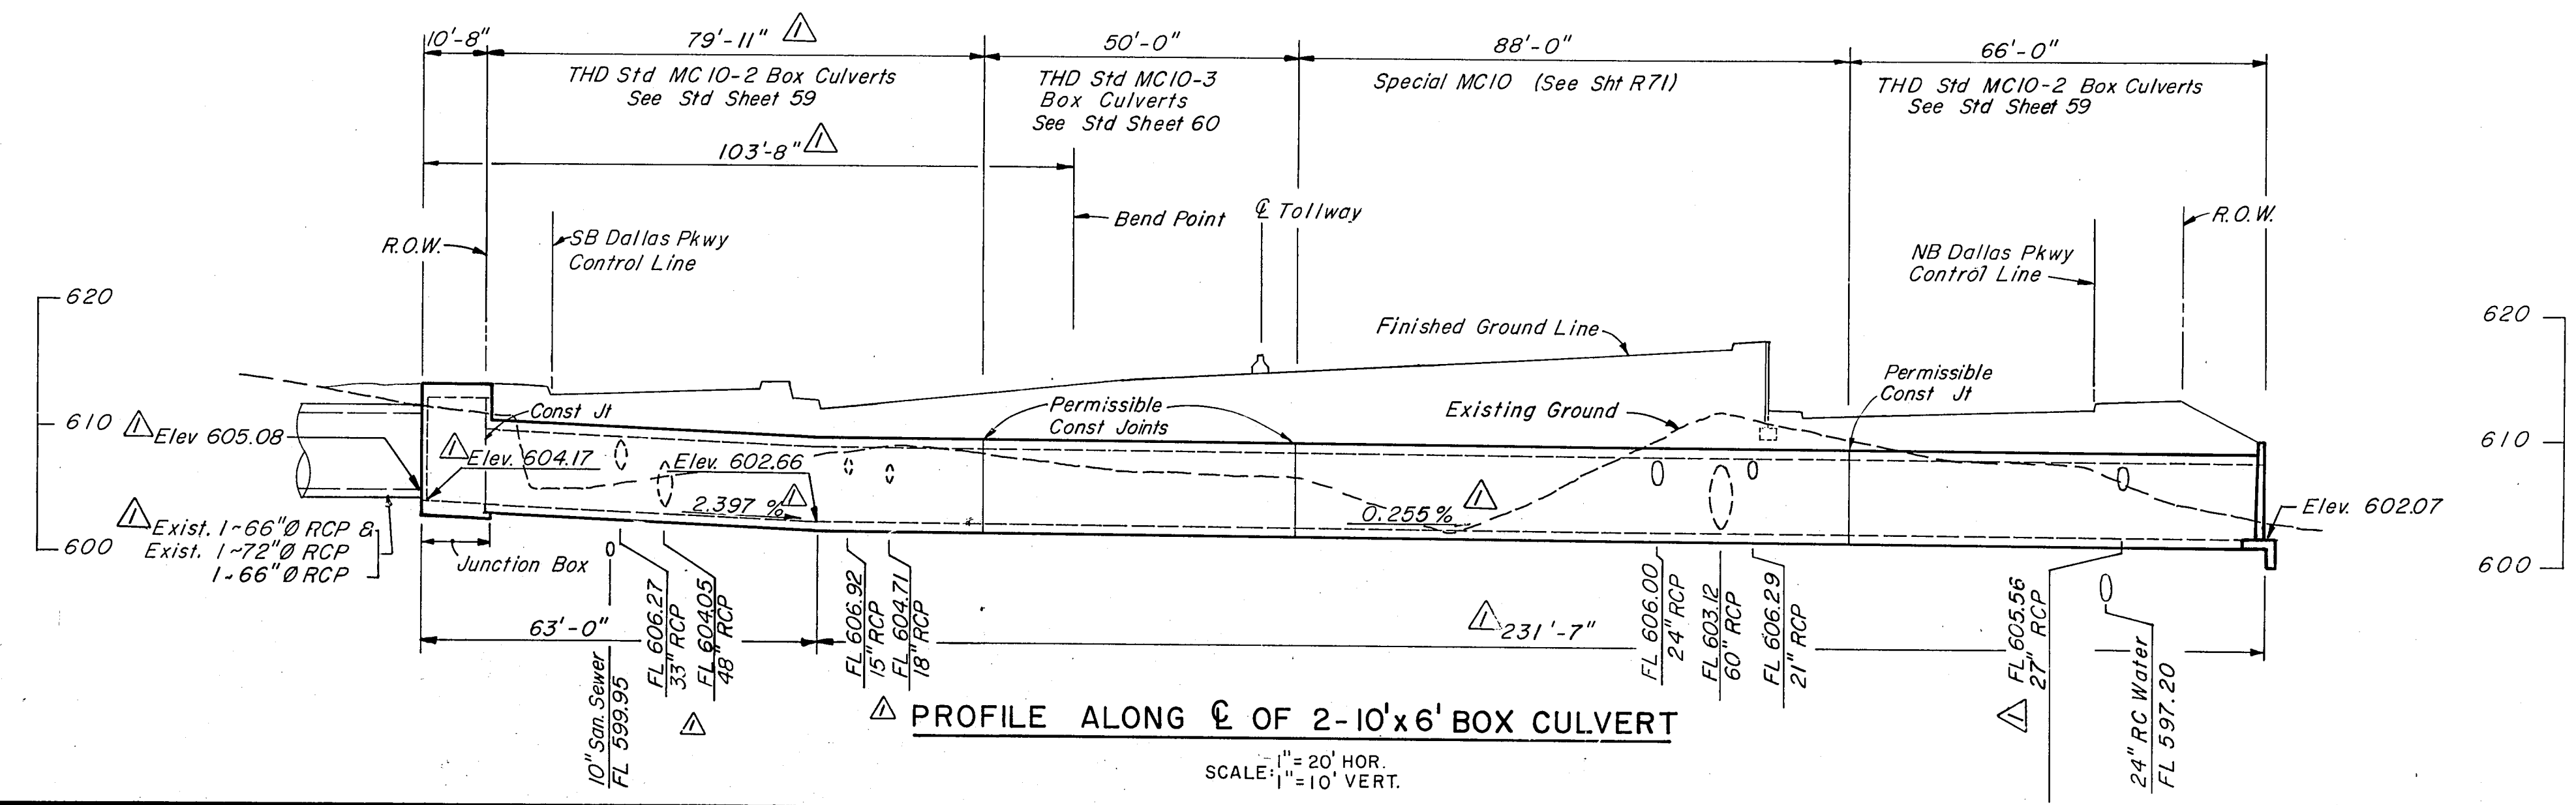

PROFILE ALONG C OF 2-10'x6' BOX CULVERT
SCALE: 1" = 20' HOR.
1" = 10' VERT.

ASBUILT PLANS

Change Cross-Slope on N. B. Dallas Parkway	MGB	5-16-86
Revised Length of 2-10'x6' Box Culvert & Width of Junction Box	B&A	2-5-85
NO.	REVISION	BY DATE

TEXAS TURNPIKE AUTHORITY
DALLAS NORTH TOLLWAY
BOX CULVERT LAYOUT
STA 678 + 20

Gibbs & Hill, Inc.
ENGINEERS DESIGNERS CONSTRUCTORS
DALLAS SECTION VII

DRAWN VER	DATE 1-27-84	DESIGNED REW	DATE 1-21-84
CHECKED REW	DATE 1-28-84	SCALE As Shown	