


NOTE:
 The information shown on this drawing concerning type and location of underground utilities is not guaranteed to be accurate or all inclusive. The Contractor is responsible for making his own determinations as to type and location of underground utilities as may be necessary to avoid damage thereto. The Contractor shall verify location of underground pipe lines, conduits, and structures by contacting owners of underground utilities and by prospecting in advance of excavation operations.

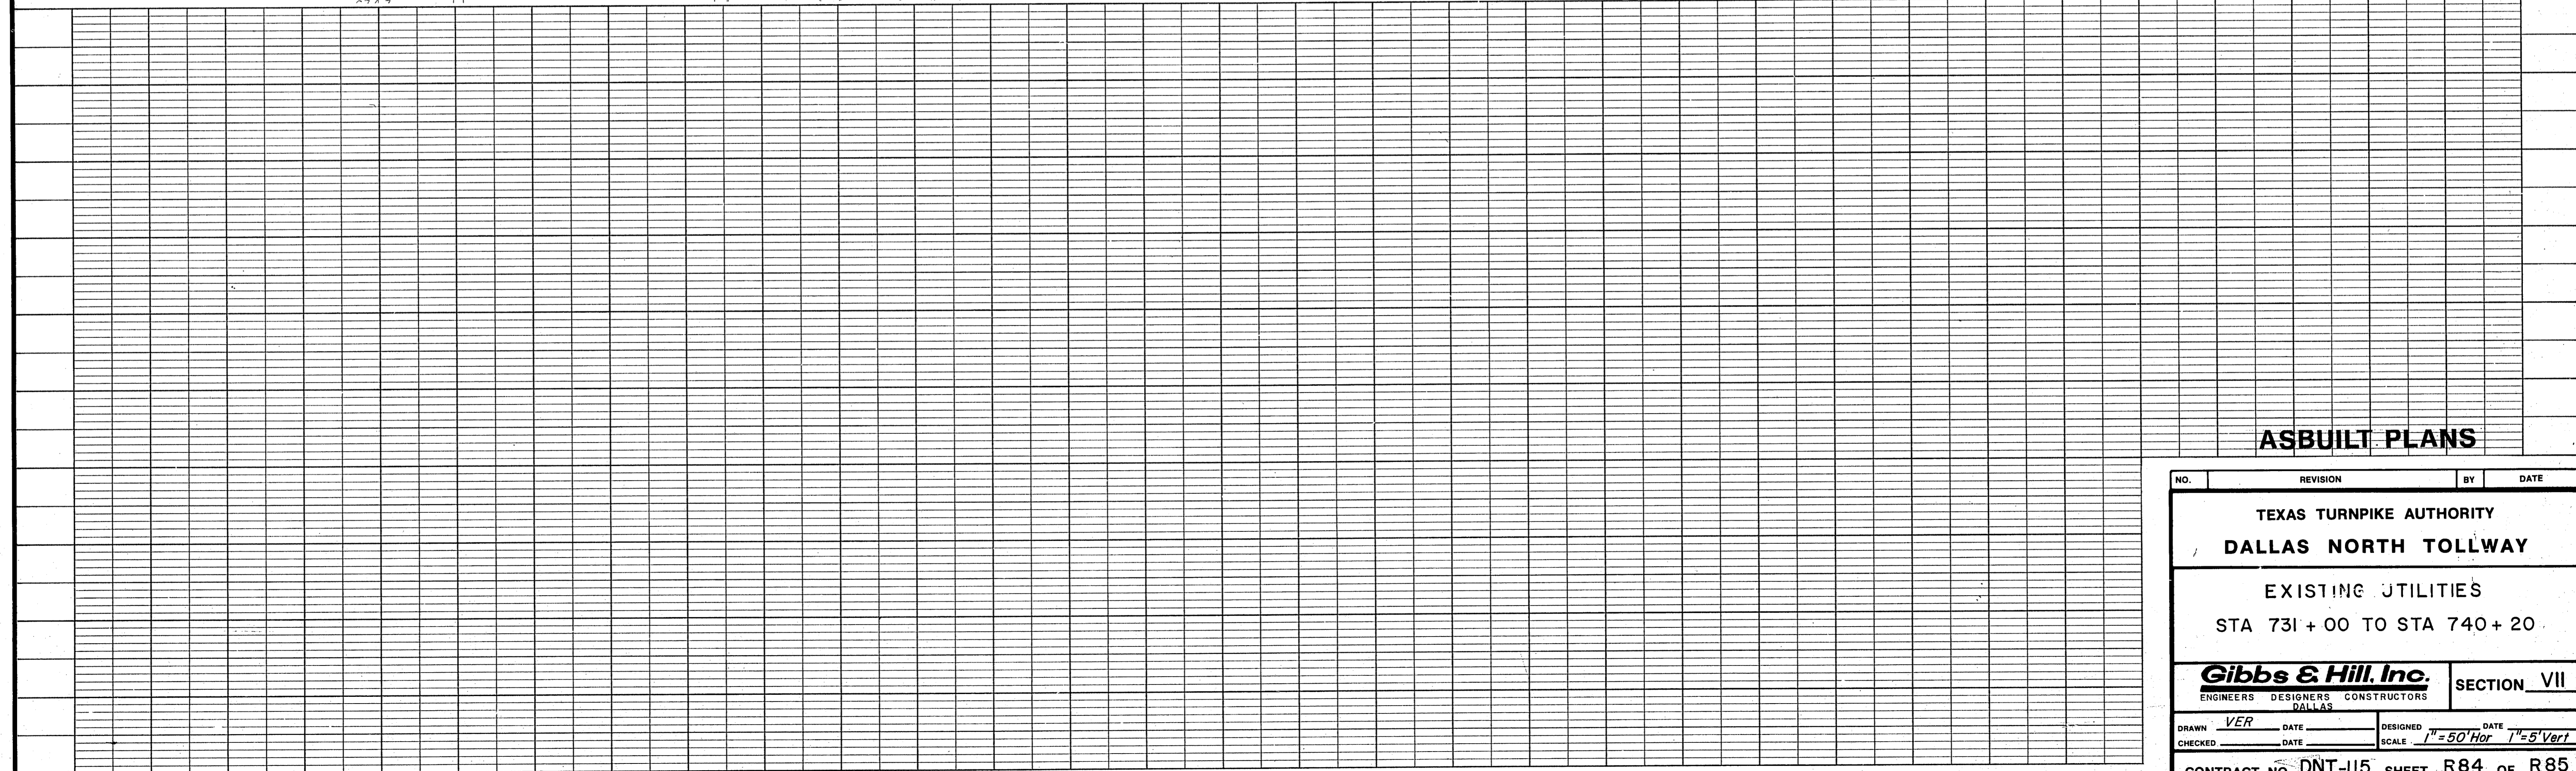

ASBUILT PLANS

NO.	REVISION	BY	DATE
TEXAS TURNPIKE AUTHORITY DALLAS NORTH TOLLWAY			
EXISTING UTILITIES STA 731 + 00 TO STA 740 + 20			
Gibbs & Hill, Inc. <small>ENGINEERS DESIGNERS CONSTRUCTORS DALLAS</small>			SECTION VII
DRAWN <u>VER</u> DATE _____ CHECKED _____ DATE _____	DESIGNED _____ DATE _____ SCALE <u>1"=50' Hor</u> <u>1"=5' Vert</u>		
CONTRACT NO. <u>DNT-115</u> SHEET <u>R84</u> OF <u>R85</u>			